

Green Hill Solar Farm

EN010170

Location Plan

Revision A (Tracked)

Prepared by: Lanpro

Date: ~~May~~ November 2025


Document Reference: CR1~~APP~~/GH2.1 A

APFP Regulation 5(2)(o)



[Schedule of Changes](#)

Figure Reference	Page	Description of Changes	Reason for Revision
[cover]		Updated document reference to Revision A	As required for submission of Change Application.
Sheet 1	3	Updated document references and annotations	As required for submission of Change Application.
Sheet 1	3	Order Limits extended and extended	Presentation of Changes 1, 3, 6, 7, 8 and 9 requested in Change Application [EN010170/CR1/GH9.2]

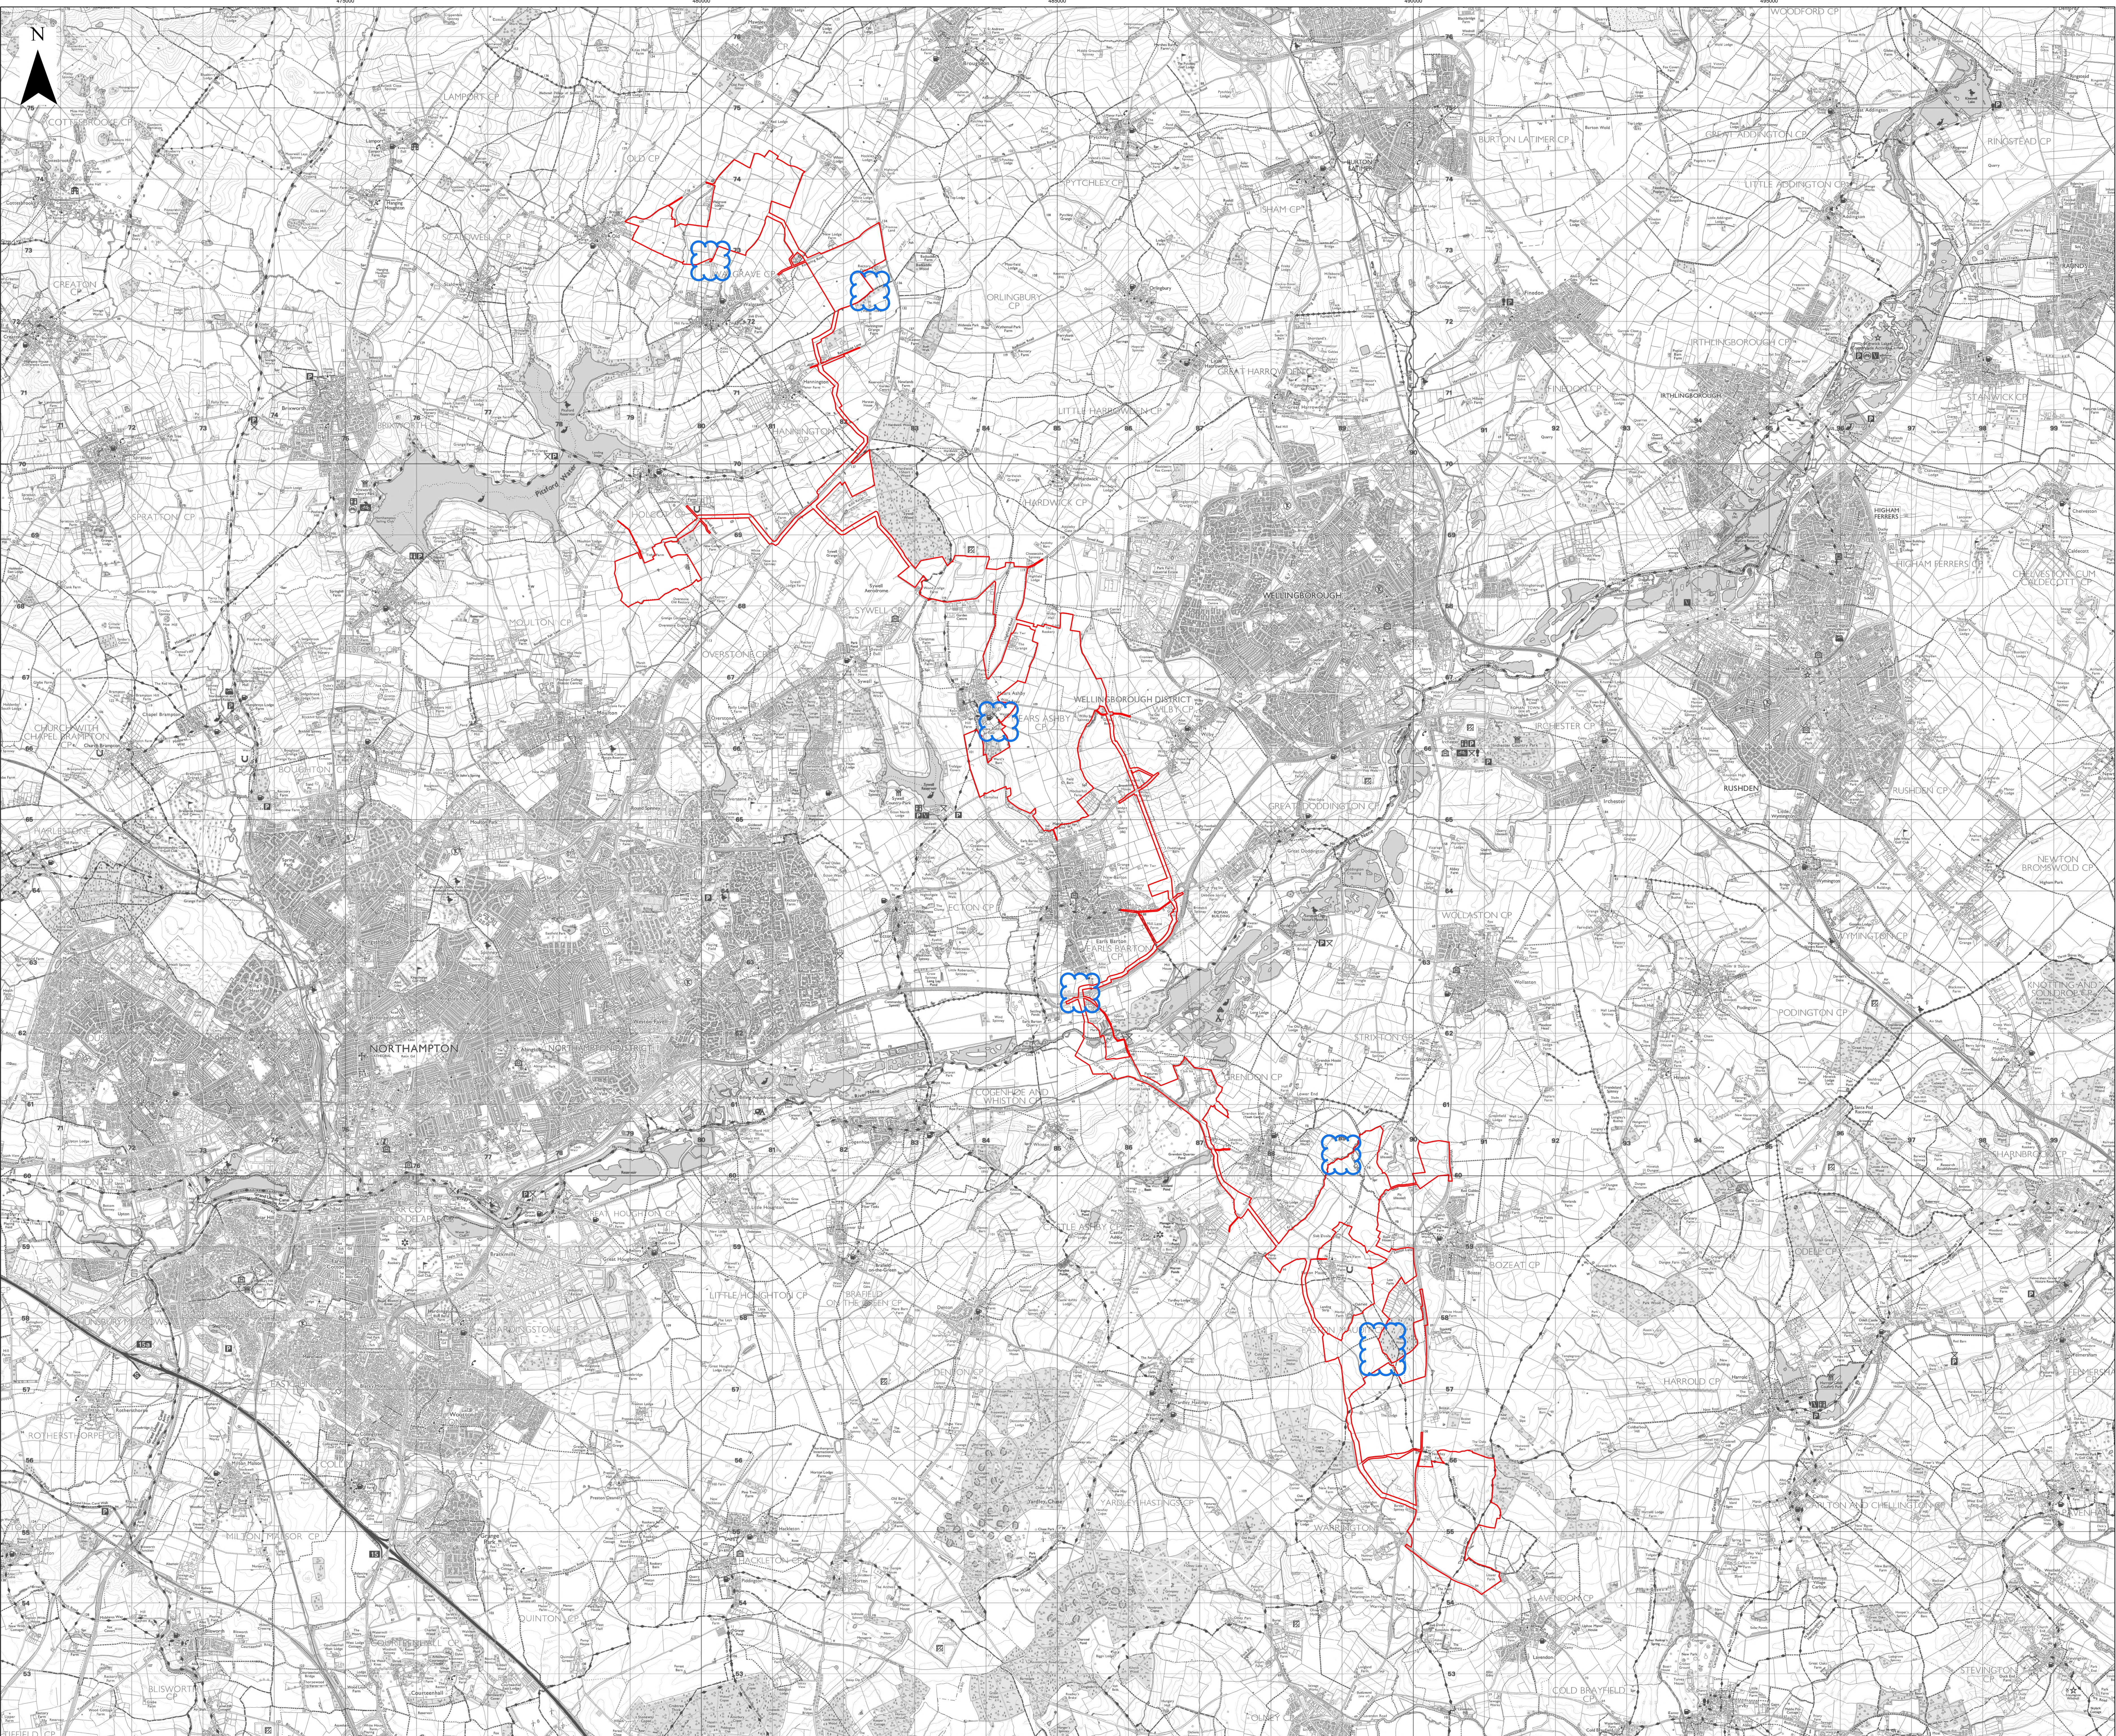

Key
Order Limits

Layers: Lanpro, 2025; GSI, 2025
Base map: Reproduced from Ordnance Survey digital map data © Crown copyright 2025. All rights reserved. License number 0100031673



APFP Regulation: 5(2)(o)	Application Doc No. CR1/GH2.1_B
Ref: P3535_LPR_ZZ_XX_DR_Z_0273	Date: 05/11/2025
Drawn by: BH	Checked by: JC

Location Plan (Change Application Version)
Revision B

