

Green Hill Solar Farm

EN010170

Location Plan

Revision B (Tracked)

Prepared by: Lanpro

Date: ~~May~~ December 2025


Document Reference: ~~APPEX3~~ GH2.1 B

APFP Regulation 5(2)(o)



Schedule of Changes

<u>Figure Reference</u>	<u>Page</u>	<u>Description of Changes</u>	<u>Reason for Revision</u>
[cover]		Updated document reference to Revision B	As required for submission of Change Application [CR1-039].
Sheet 1	3	Updated document references and annotations	As required for submission of Change Application [CR1-039].
Sheet 1	3	Extensions and reductions to Order Limits	Presentation of Changes 1, 3, 6, 7, 8 and 9 requested in Change Application and Consultation Report [CR1-039]

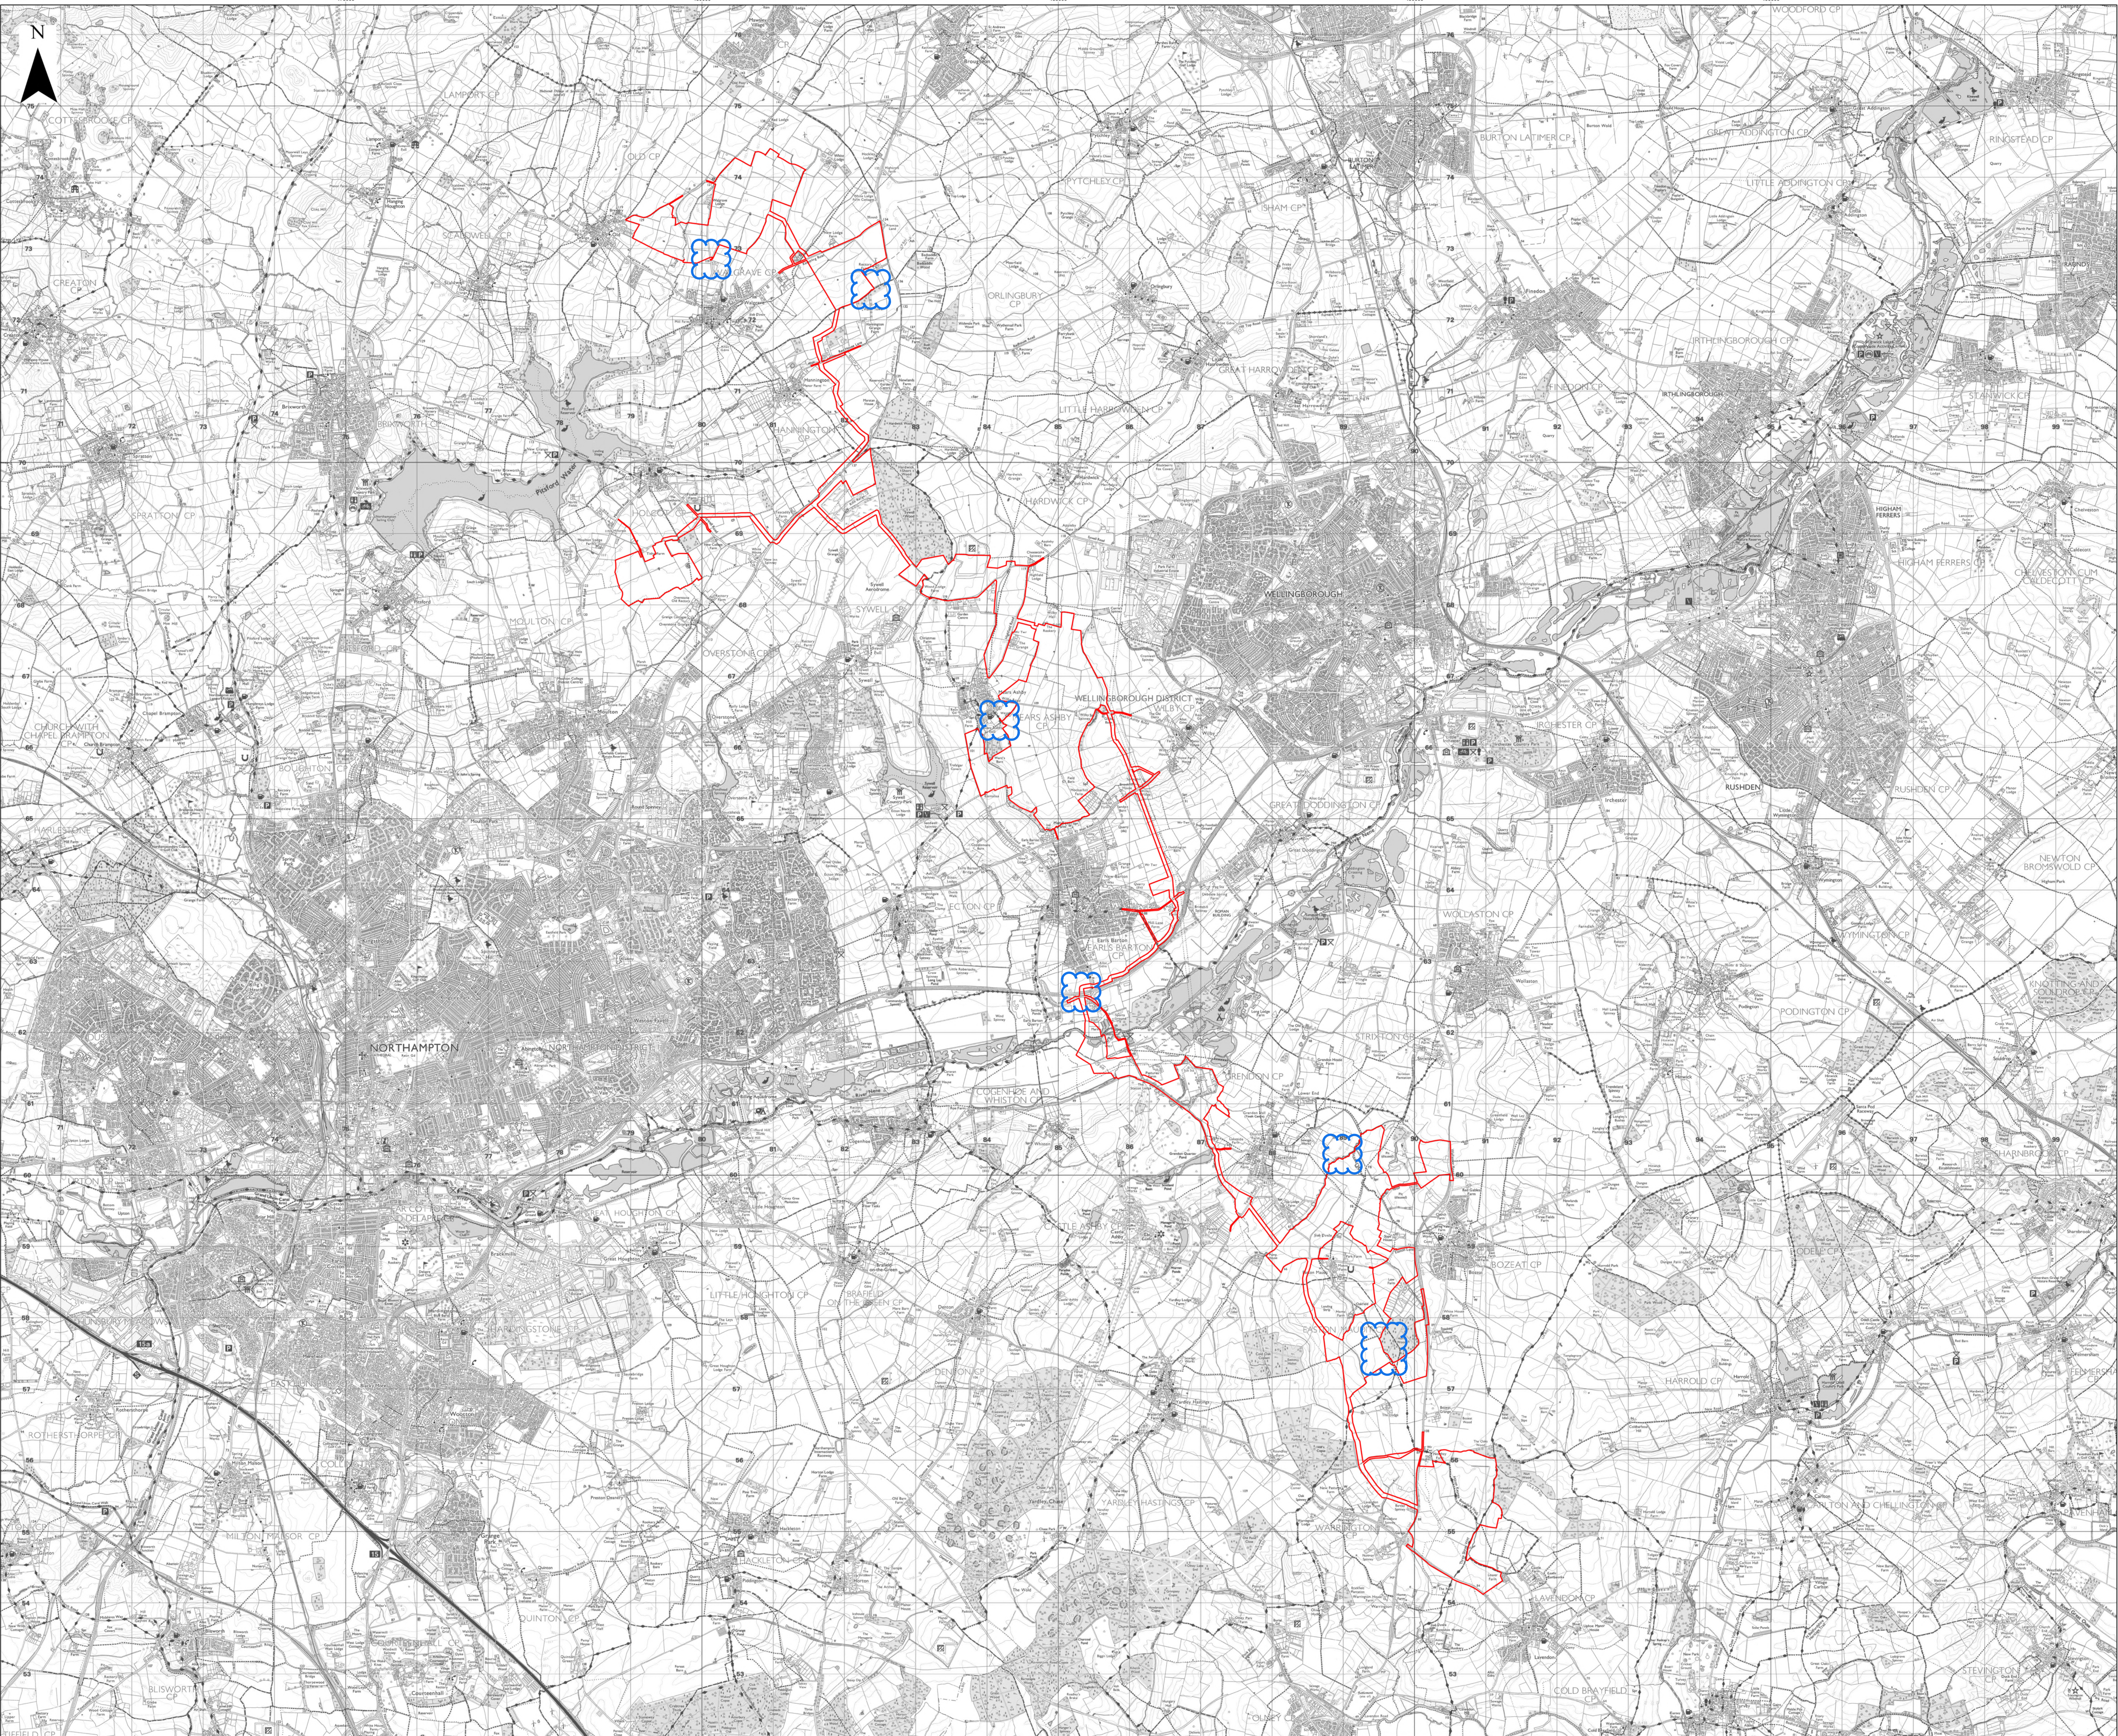



Key

 Order Limits

Layers: Lanpro, 2025; GIP, 2025
Base map: Reproduced from Ordnance Survey digital map data © Crown copyright 2025. All rights reserved. License number 0100031673

0 1 2 3 4 Kilometers

Scale: 1:30,000@ A0

APFP Regulation: 5(2)(o)	Application Doc No. EX3/GH2.1_B
Ref: P3535_LPR_ZZ_XX_DR_Z_0273	Date: 15/12/2025
Drawn by: BH	Checked by: JC

Location Plan
Revision B

