

Green Hill Solar Farm

EN010170

Works Plan

Revision ~~BD~~ (Tracked)

Prepared by: Lanpro

Date: ~~November~~ December 2025


Document Reference: ~~EX4~~ EX3/GH2.4_ ~~BD~~ (Tracked)

APFP Regulation 5(2)(j)



Schedule of Changes

Figure Reference	Page	Description of Changes	Reason for Revision
[cover]		Updated document reference to Revision D	As required for submission of Change Application.
All Sheets	3-21	Updated document references and annotations	As required for submission of Change Application.
Sheet 1	4	Order Limits extended Update to extents of Works Nos. 6, 8B and 10B	Presentation of Change 1 requested in Change Application and Consultation Report [CR1-039].
Sheet 3	6	Order Limits extended Update to extents of Works Nos. 1(d), 5B, 6 and 10B	Presentation of Changes 2 and 3 requested in Change Application and Consultation Report [CR1-039].
Sheet 8	11	Order Limits extended Update to extents of Works Nos. 1(d), 5B, 6 and 10B	Presentation of Changes 5 and 6 requested in Change Application and Consultation Report [CR1-039].
Sheet 9	12	Order Limits extended Update to extents of Works Nos. 6 and 10B	Presentation of Change 6 requested in Change Application and Consultation Report [CR1-039].
Sheet 10	13	Update to extents of Works Nos. 1(d) and 5B	Presentation of Change 5 requested in Change Application and Consultation Report [CR1-039].
Sheet 12	15	Order Limits extended Update to extents of Works No. 5A	Presentation of Change 7 requested in Change Application and Consultation Report [CR1-039].
Sheet 13	16	Update to extents of Works No. 6 and Work No. 9	Clarification in response to commentary made by the Examining Authority at Issue Specific Hearing 2.
Sheet 15	18	Order Limits reduced Update to extents of Works No. 9	Presentation of Change 8 requested in Change Application and Consultation Report [CR1-039].
Sheet 16	19	Order Limits reduced Update to extents of Works Nos. 1(d), 6 and 8B	Presentation of Change 9 requested in Change Application and Consultation Report [CR1-039].
Sheet 17	20	Order Limits reduced Update to extents of Works Nos. 1(d) and 6	Presentation of Change 9 requested in Change Application and Consultation Report [CR1-039].

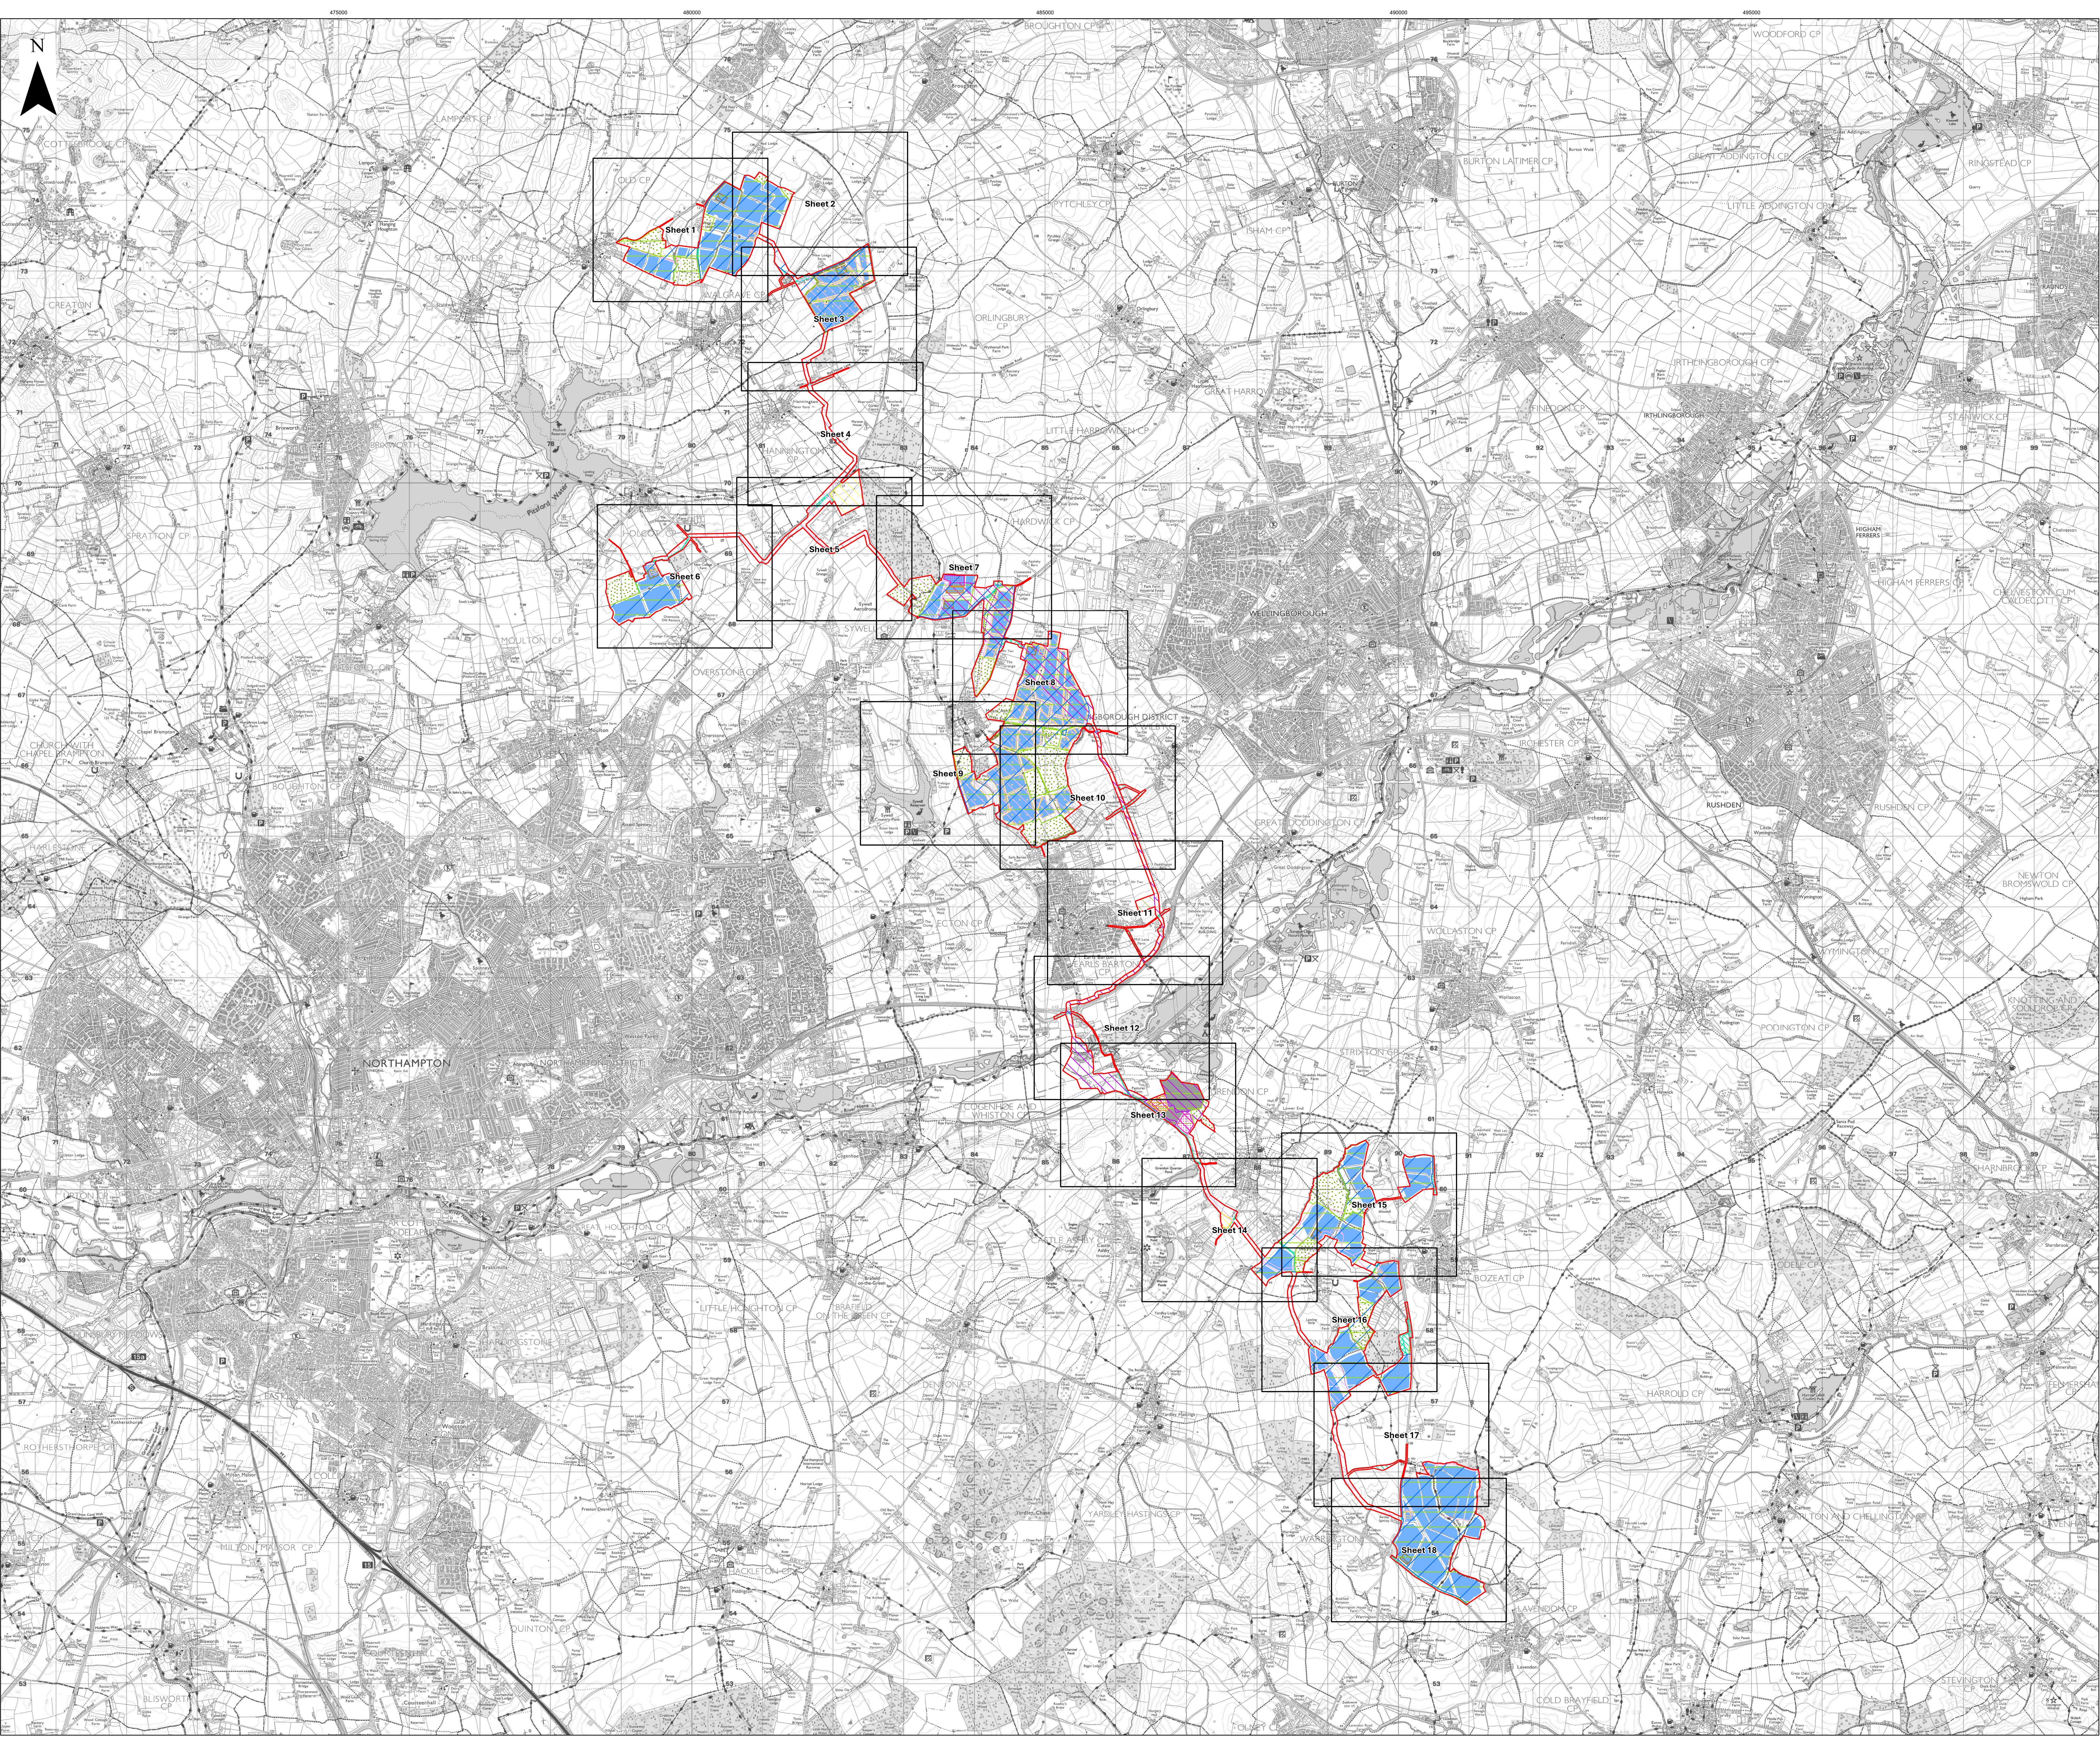

- Key**
- Order Limits
 - Index Sheet
 - Works Number
 - 1
 - 1(d)
 - 2
 - 3A
 - 3B
 - 3C
 - 4
 - 5
 - 5A
 - 5A(v)
 - 5B
 - 5B(v)
 - 6
 - 7
 - 8A
 - 8B
 - 9
 - 10A
 - 10B


Layers: Lanpro, 2025; G5, 2025
Base map: Reproduced from Ordnance Survey digital map data © Crown copyright 2025. All rights reserved. License number 0100031673



APFP Regulation: 5(2)(j)	Application Doc No. EX3/GH2.4_D
Ref: P3535_LPR_ZZ_XX_DR_Z_0274	Date: 15/12/2025
Drawn by: AZ	Checked by: JC

Works Plan
Index Sheet
Revision D



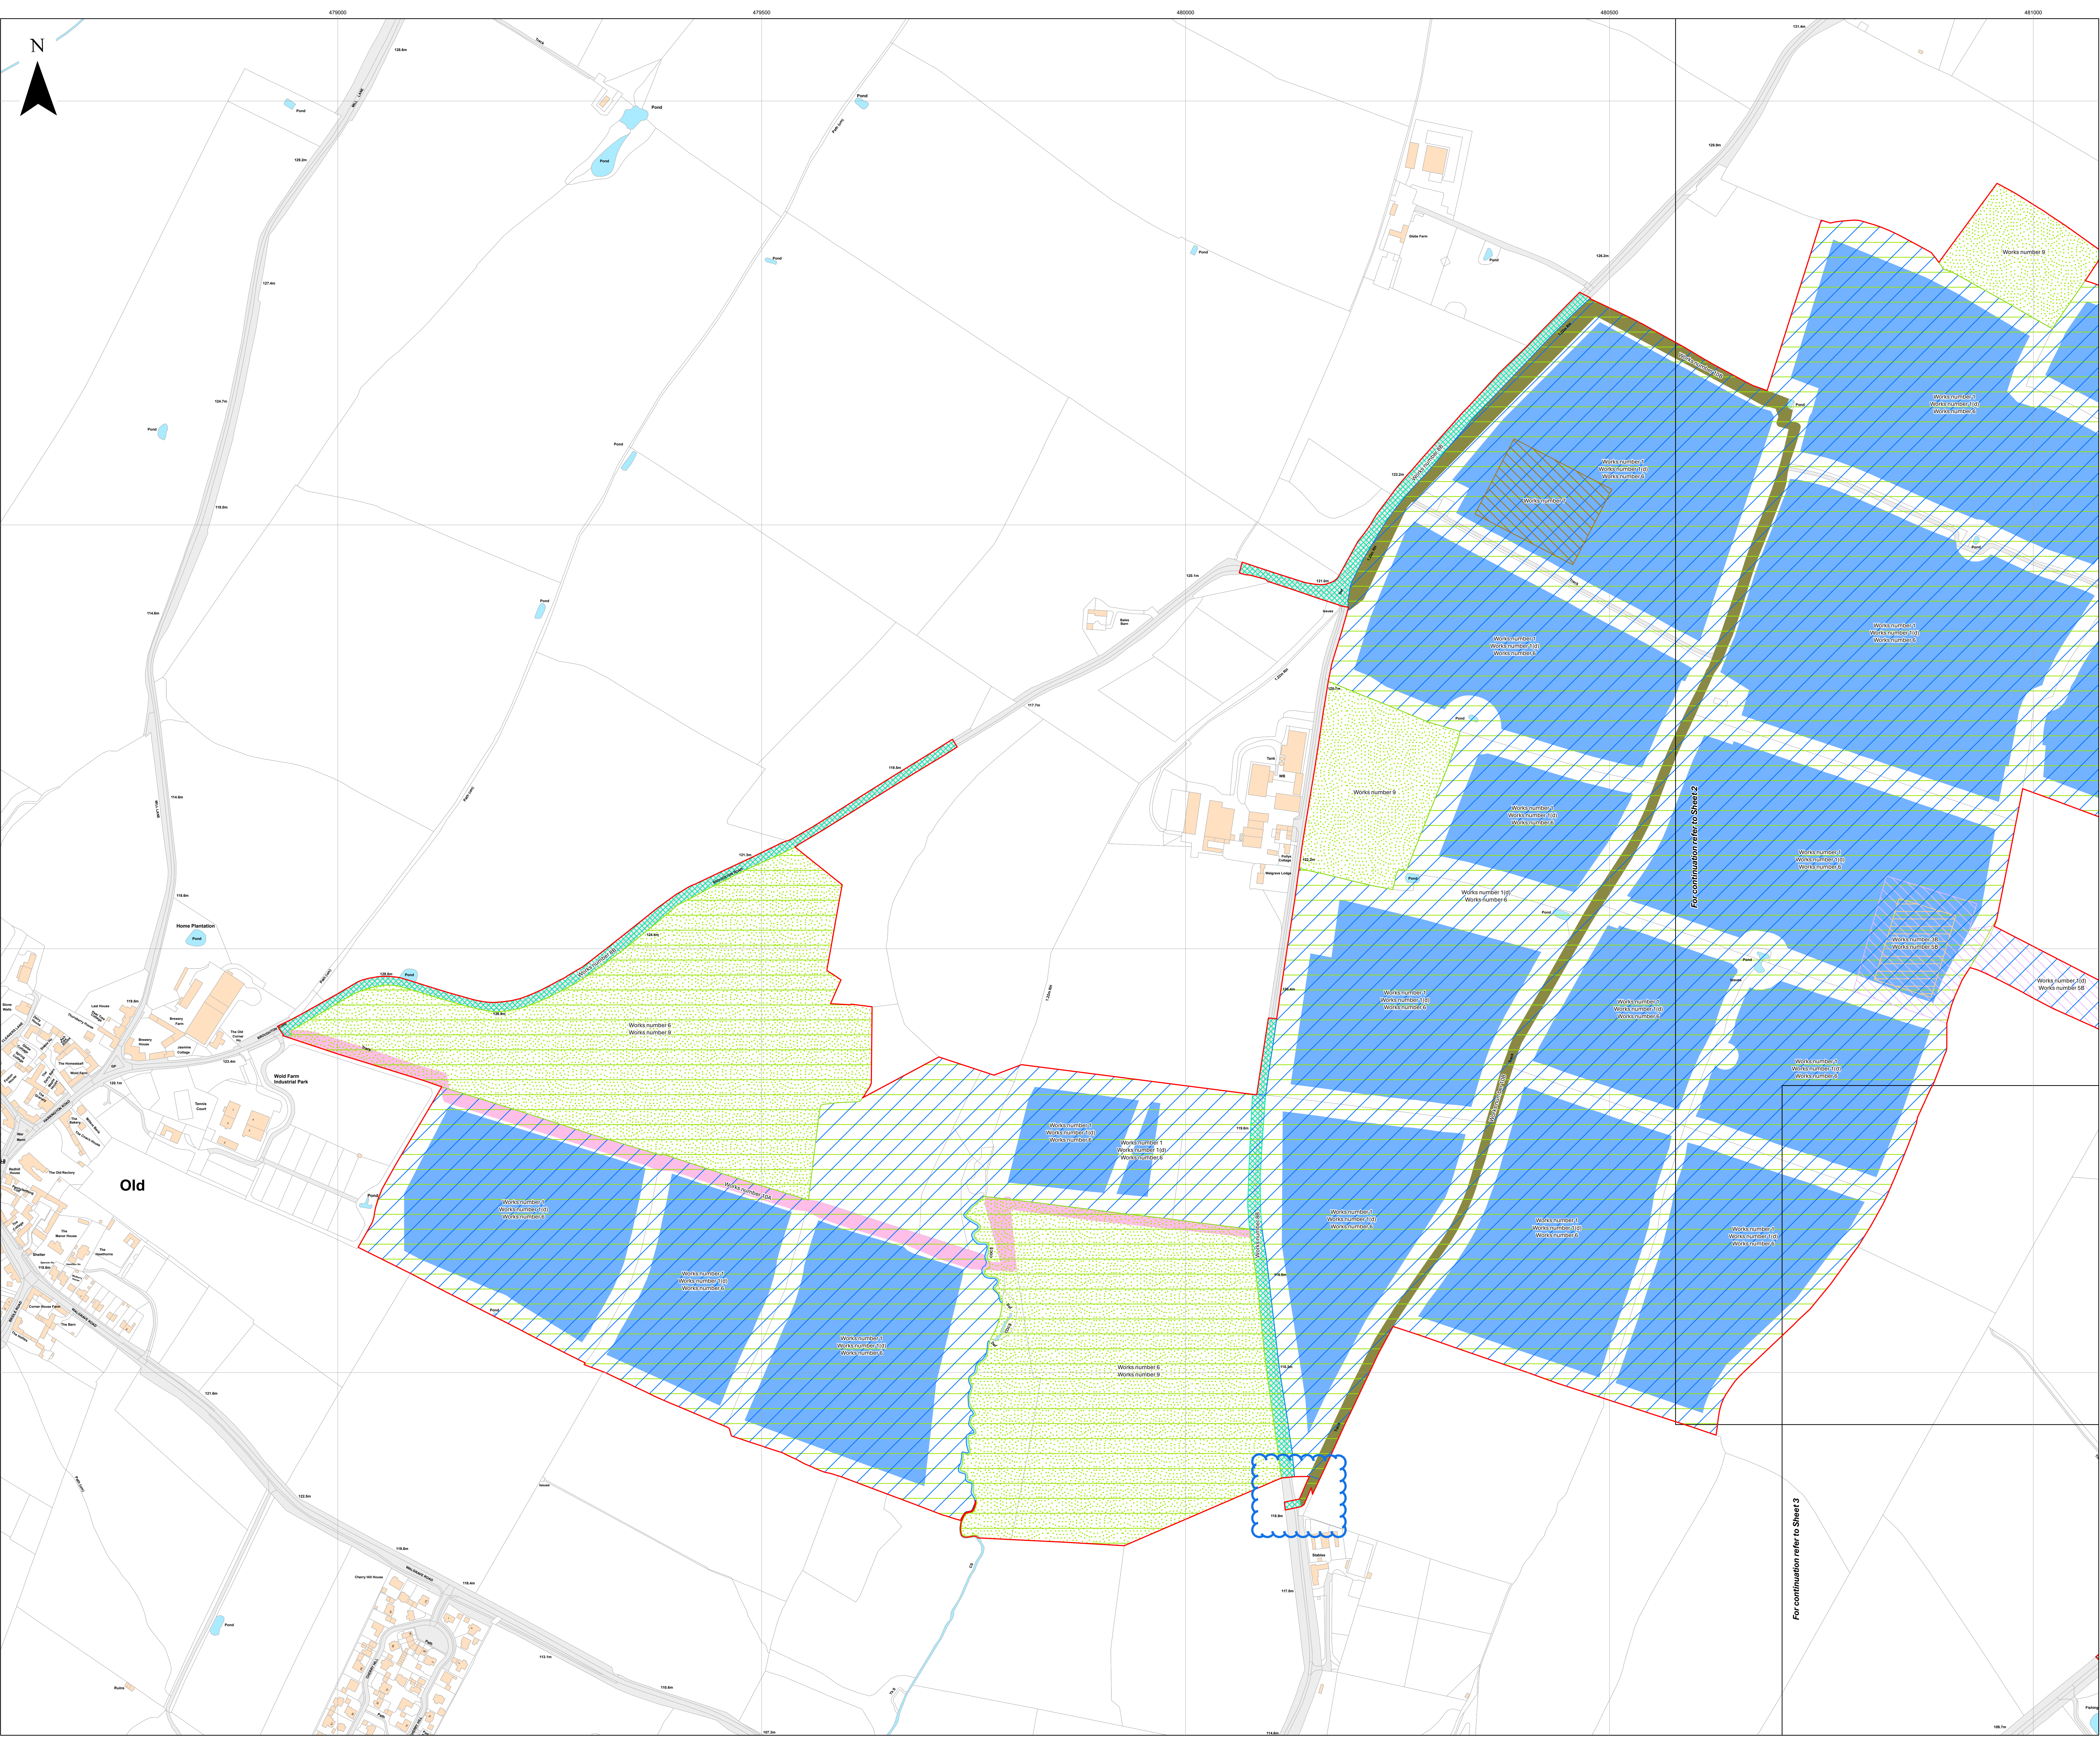



Key

- Order Limits
- Index Sheet
- Works Number**
- 1
- 1(d)
- 3B
- 5B
- 6
- 7
- 8A
- 8B
- 9
- 10A
- 10B

Layers: Lanpro, 2025; KIP, 2025
Base map: Reproduced from Ordnance Survey digital map data © Crown copyright 2025. All rights reserved. License number 0100031673

0100031673

0 100 200 300 Meters

Scale: 1:2,500@ A0


APFP Regulation: 5(2)(j)	Application Doc No. EX3/GH2.4_D
Ref: P3535_LPR_ZZ_XX_DR_Z_0274	Date: 15/12/2025
Drawn by: AZ	Checked by: JC

Works Plan

Sheet 1 of 18

Revision D



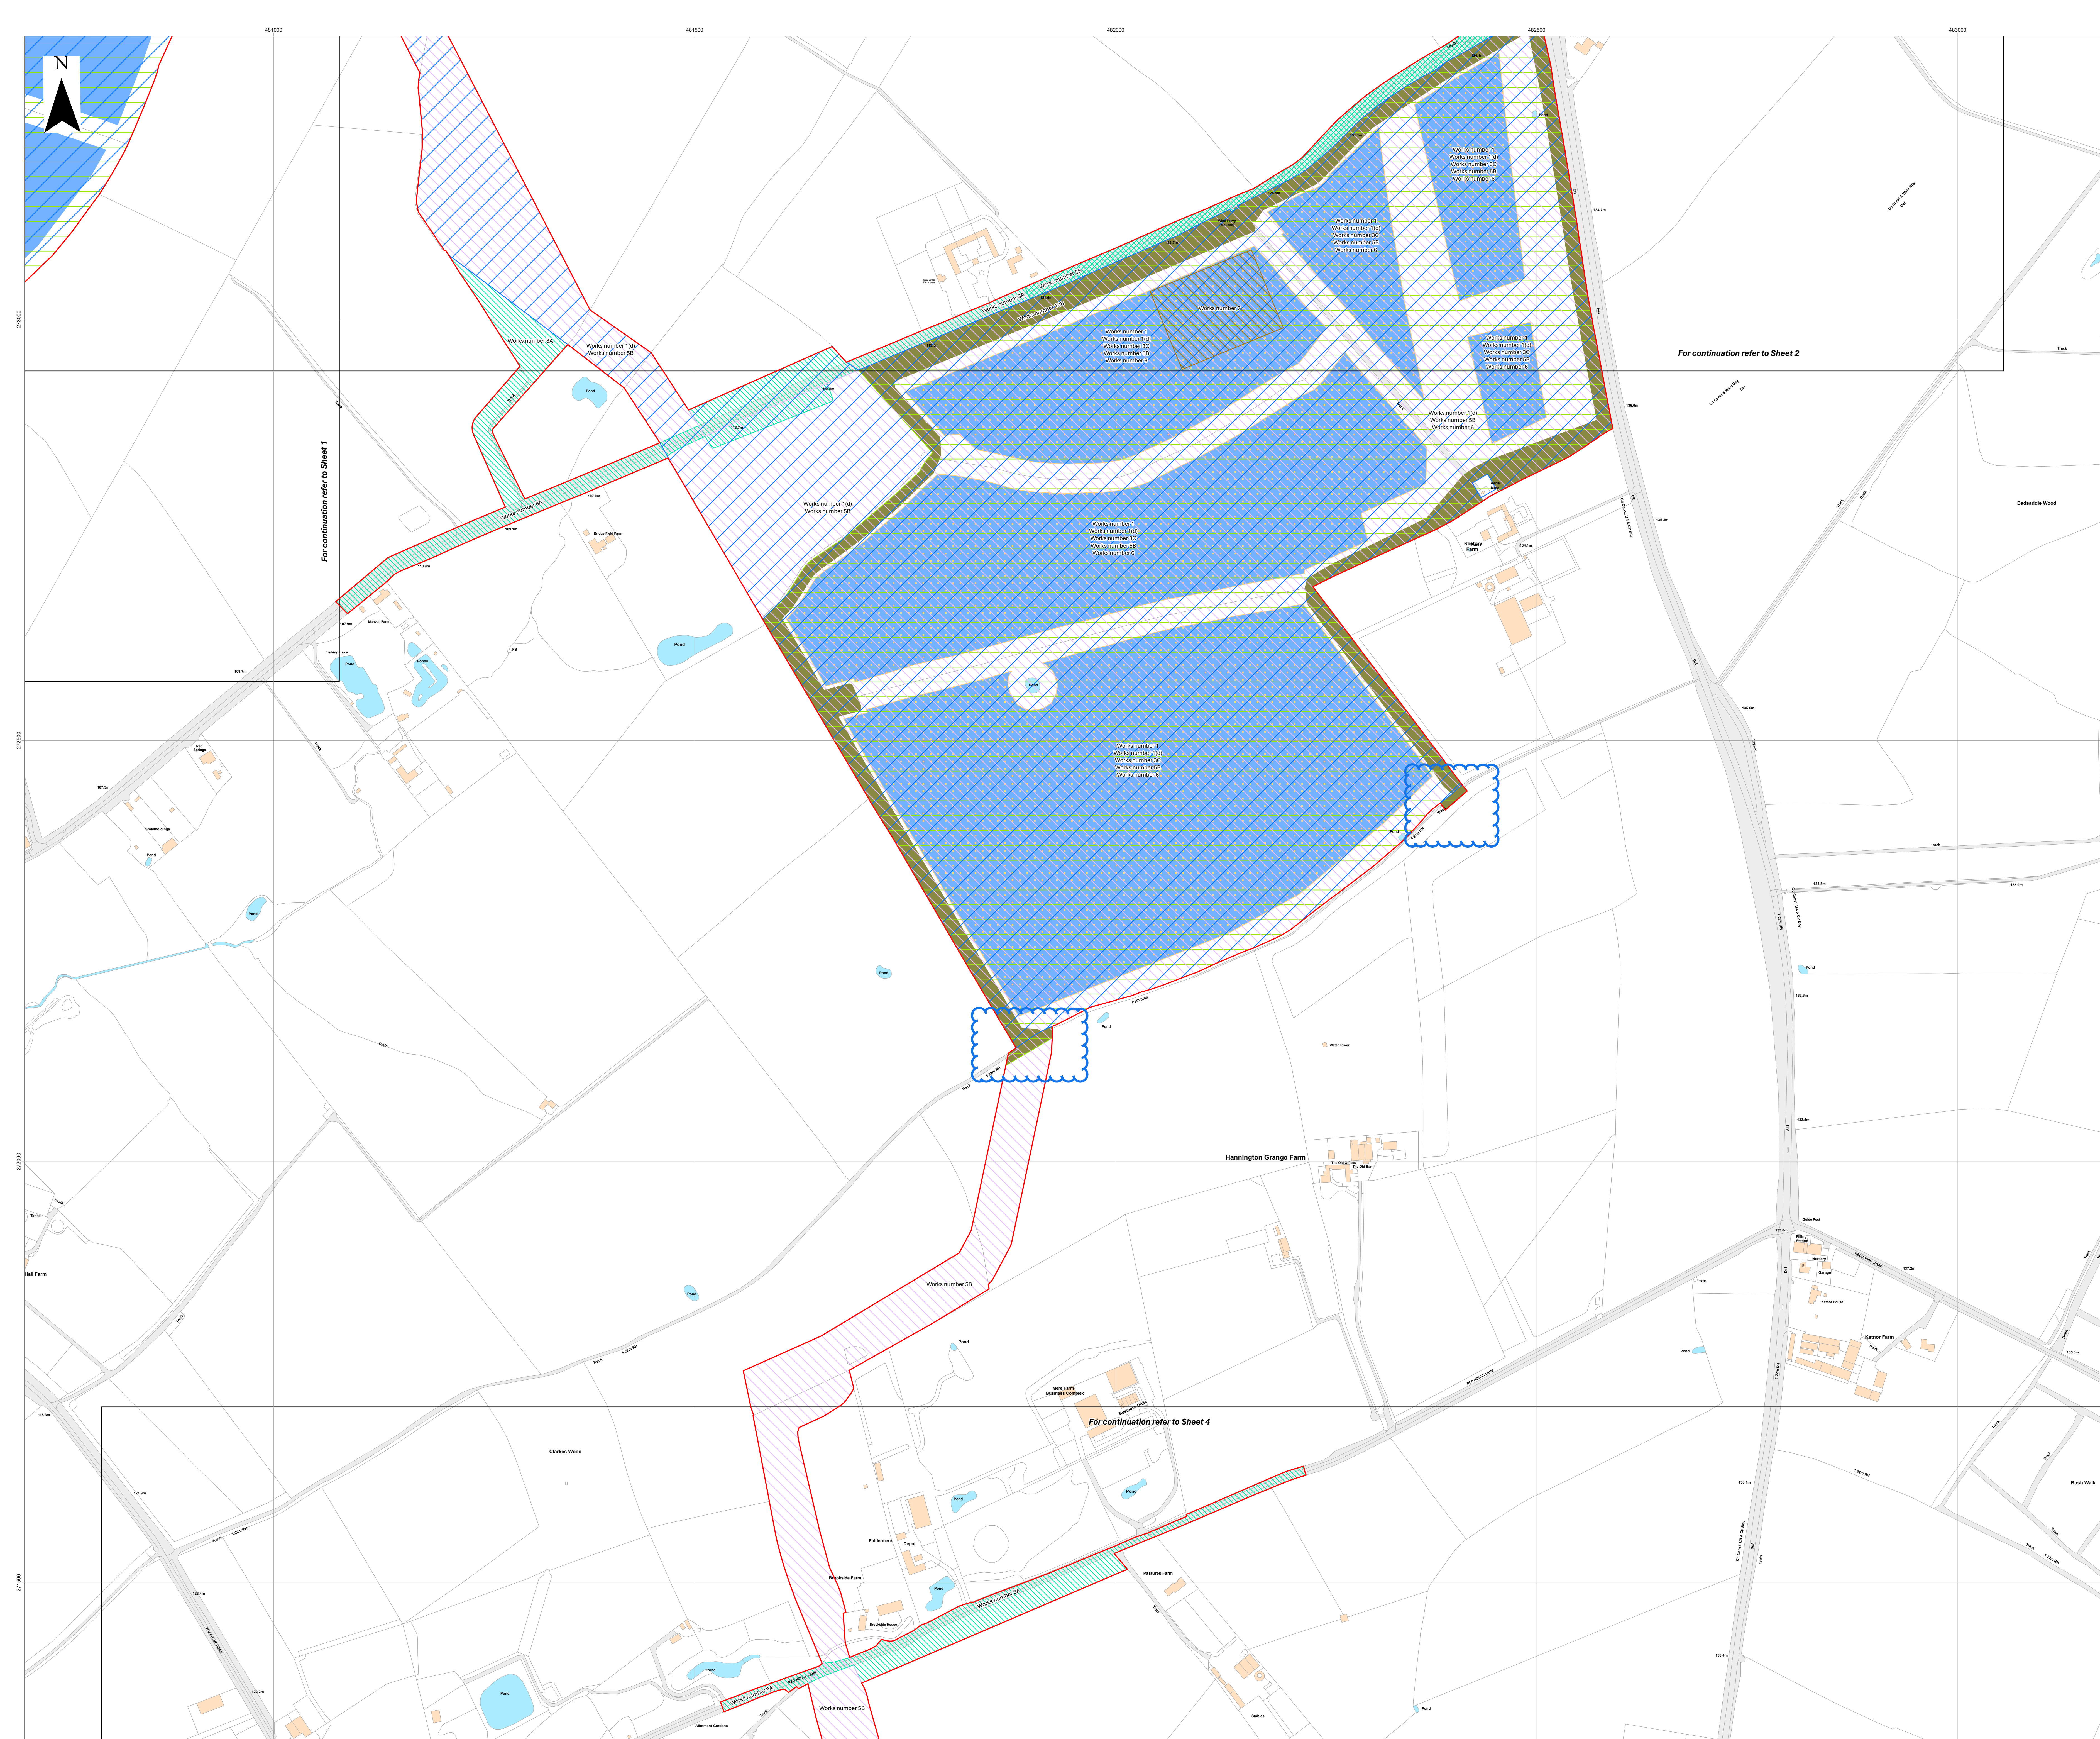

Key

- ☐ Order Limits
 - ☐ Index Sheet

Works Number

- | | |
|---|------|
|  | 1 |
|  | 1(d) |
|  | 3C |
|  | 5B |
|  | 6 |
|  | 7 |
|  | 8A |
|  | 8B |
|  | 10B |

Base map: Reproduced from Ordnance Survey digital map data © Crown copyright 2025. All rights reserved. License number 0100031673




Scale: 1:2,500@ A0

APFP Regulation: 5(2)(j)	Application Doc No. EX3/GH2.4_D
Ref: P3535_LPR_ZZ_XX_DR_Z_0274	Date: 15/12/2025
Drawn by: AZ	Checked by: JC

Works Plan
Sheet 3 of 18
Revision D



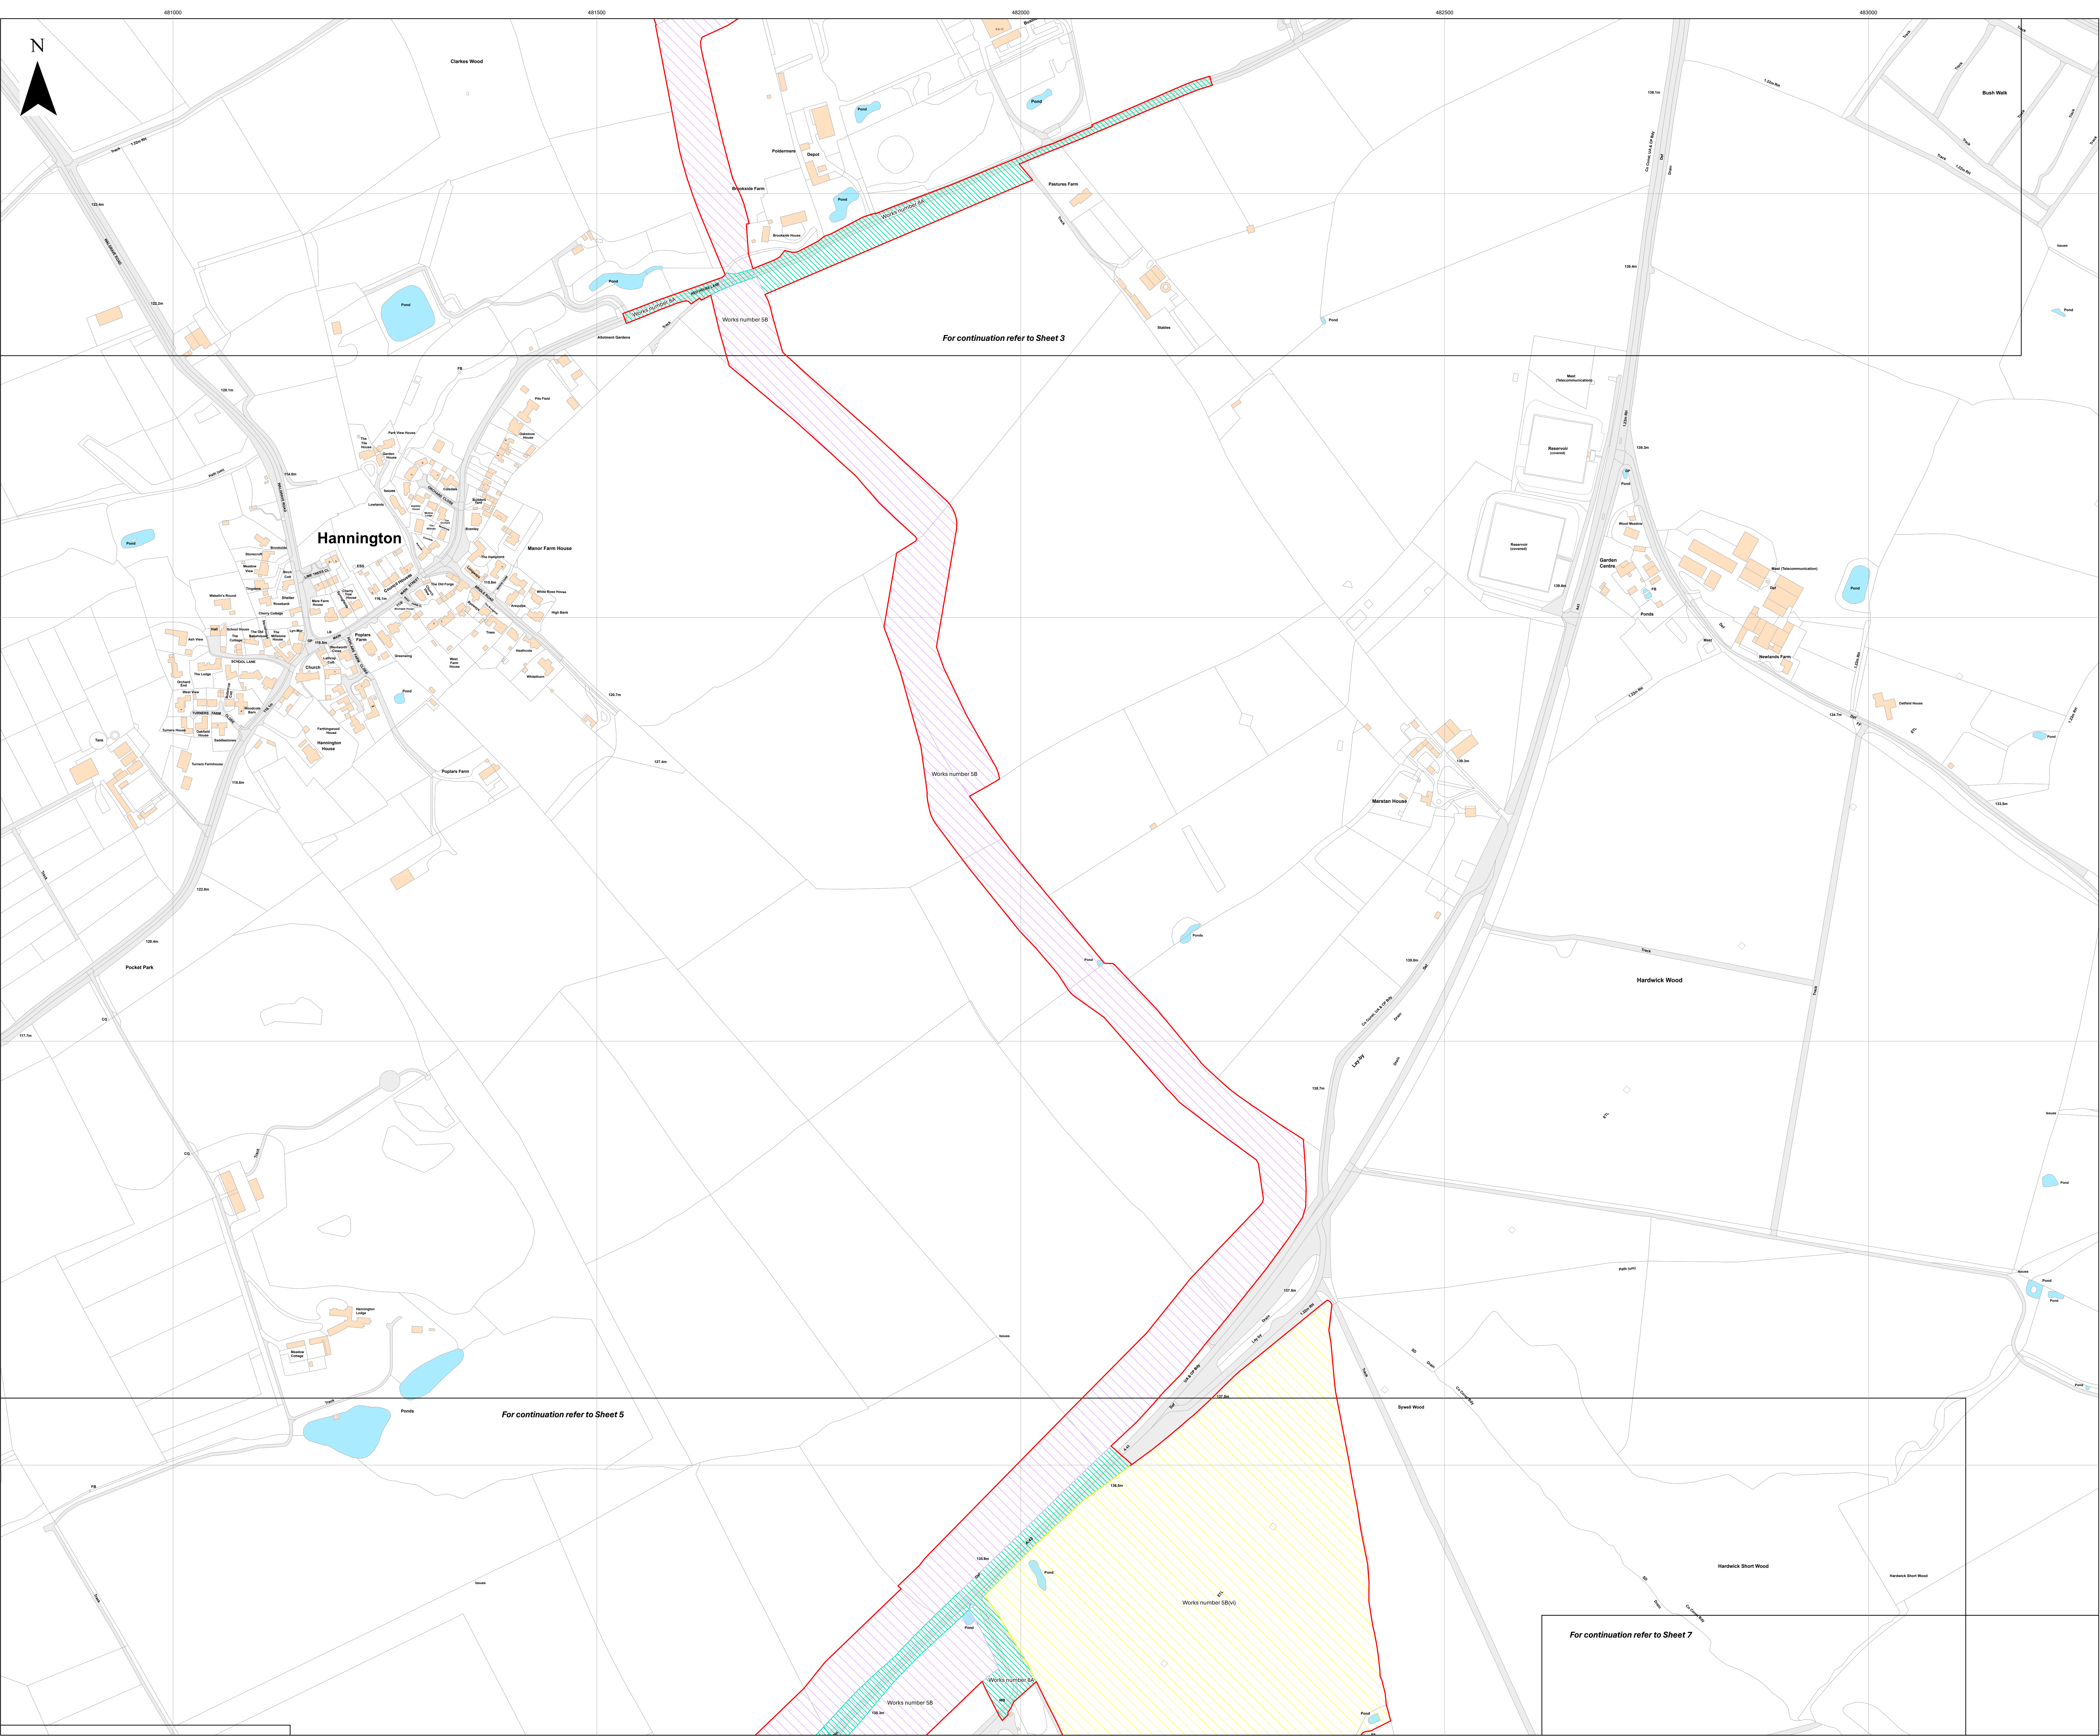



Key

- Order Limits
- Index Sheet
- Works Number**
- 5B
- 5B(vi)
- 5A

Layers: Lanpro, 2025; KIP, 2025
Base map: Reproduced from Ordnance Survey digital map data © Crown copyright 2025. All rights reserved. License number 0100031673


0 100 200 300 Meters

Scale: 1:2,500@A0

APFP Regulation: 5(2)(j)	Application Doc No. EX3/GH2.4_D
Ref: P3535_LPR_ZZ_XX_DR_Z_0274	Date: 15/12/2025
Drawn by: AZ	Checked by: JC

Works Plan
Sheet 4 of 18
Revision D



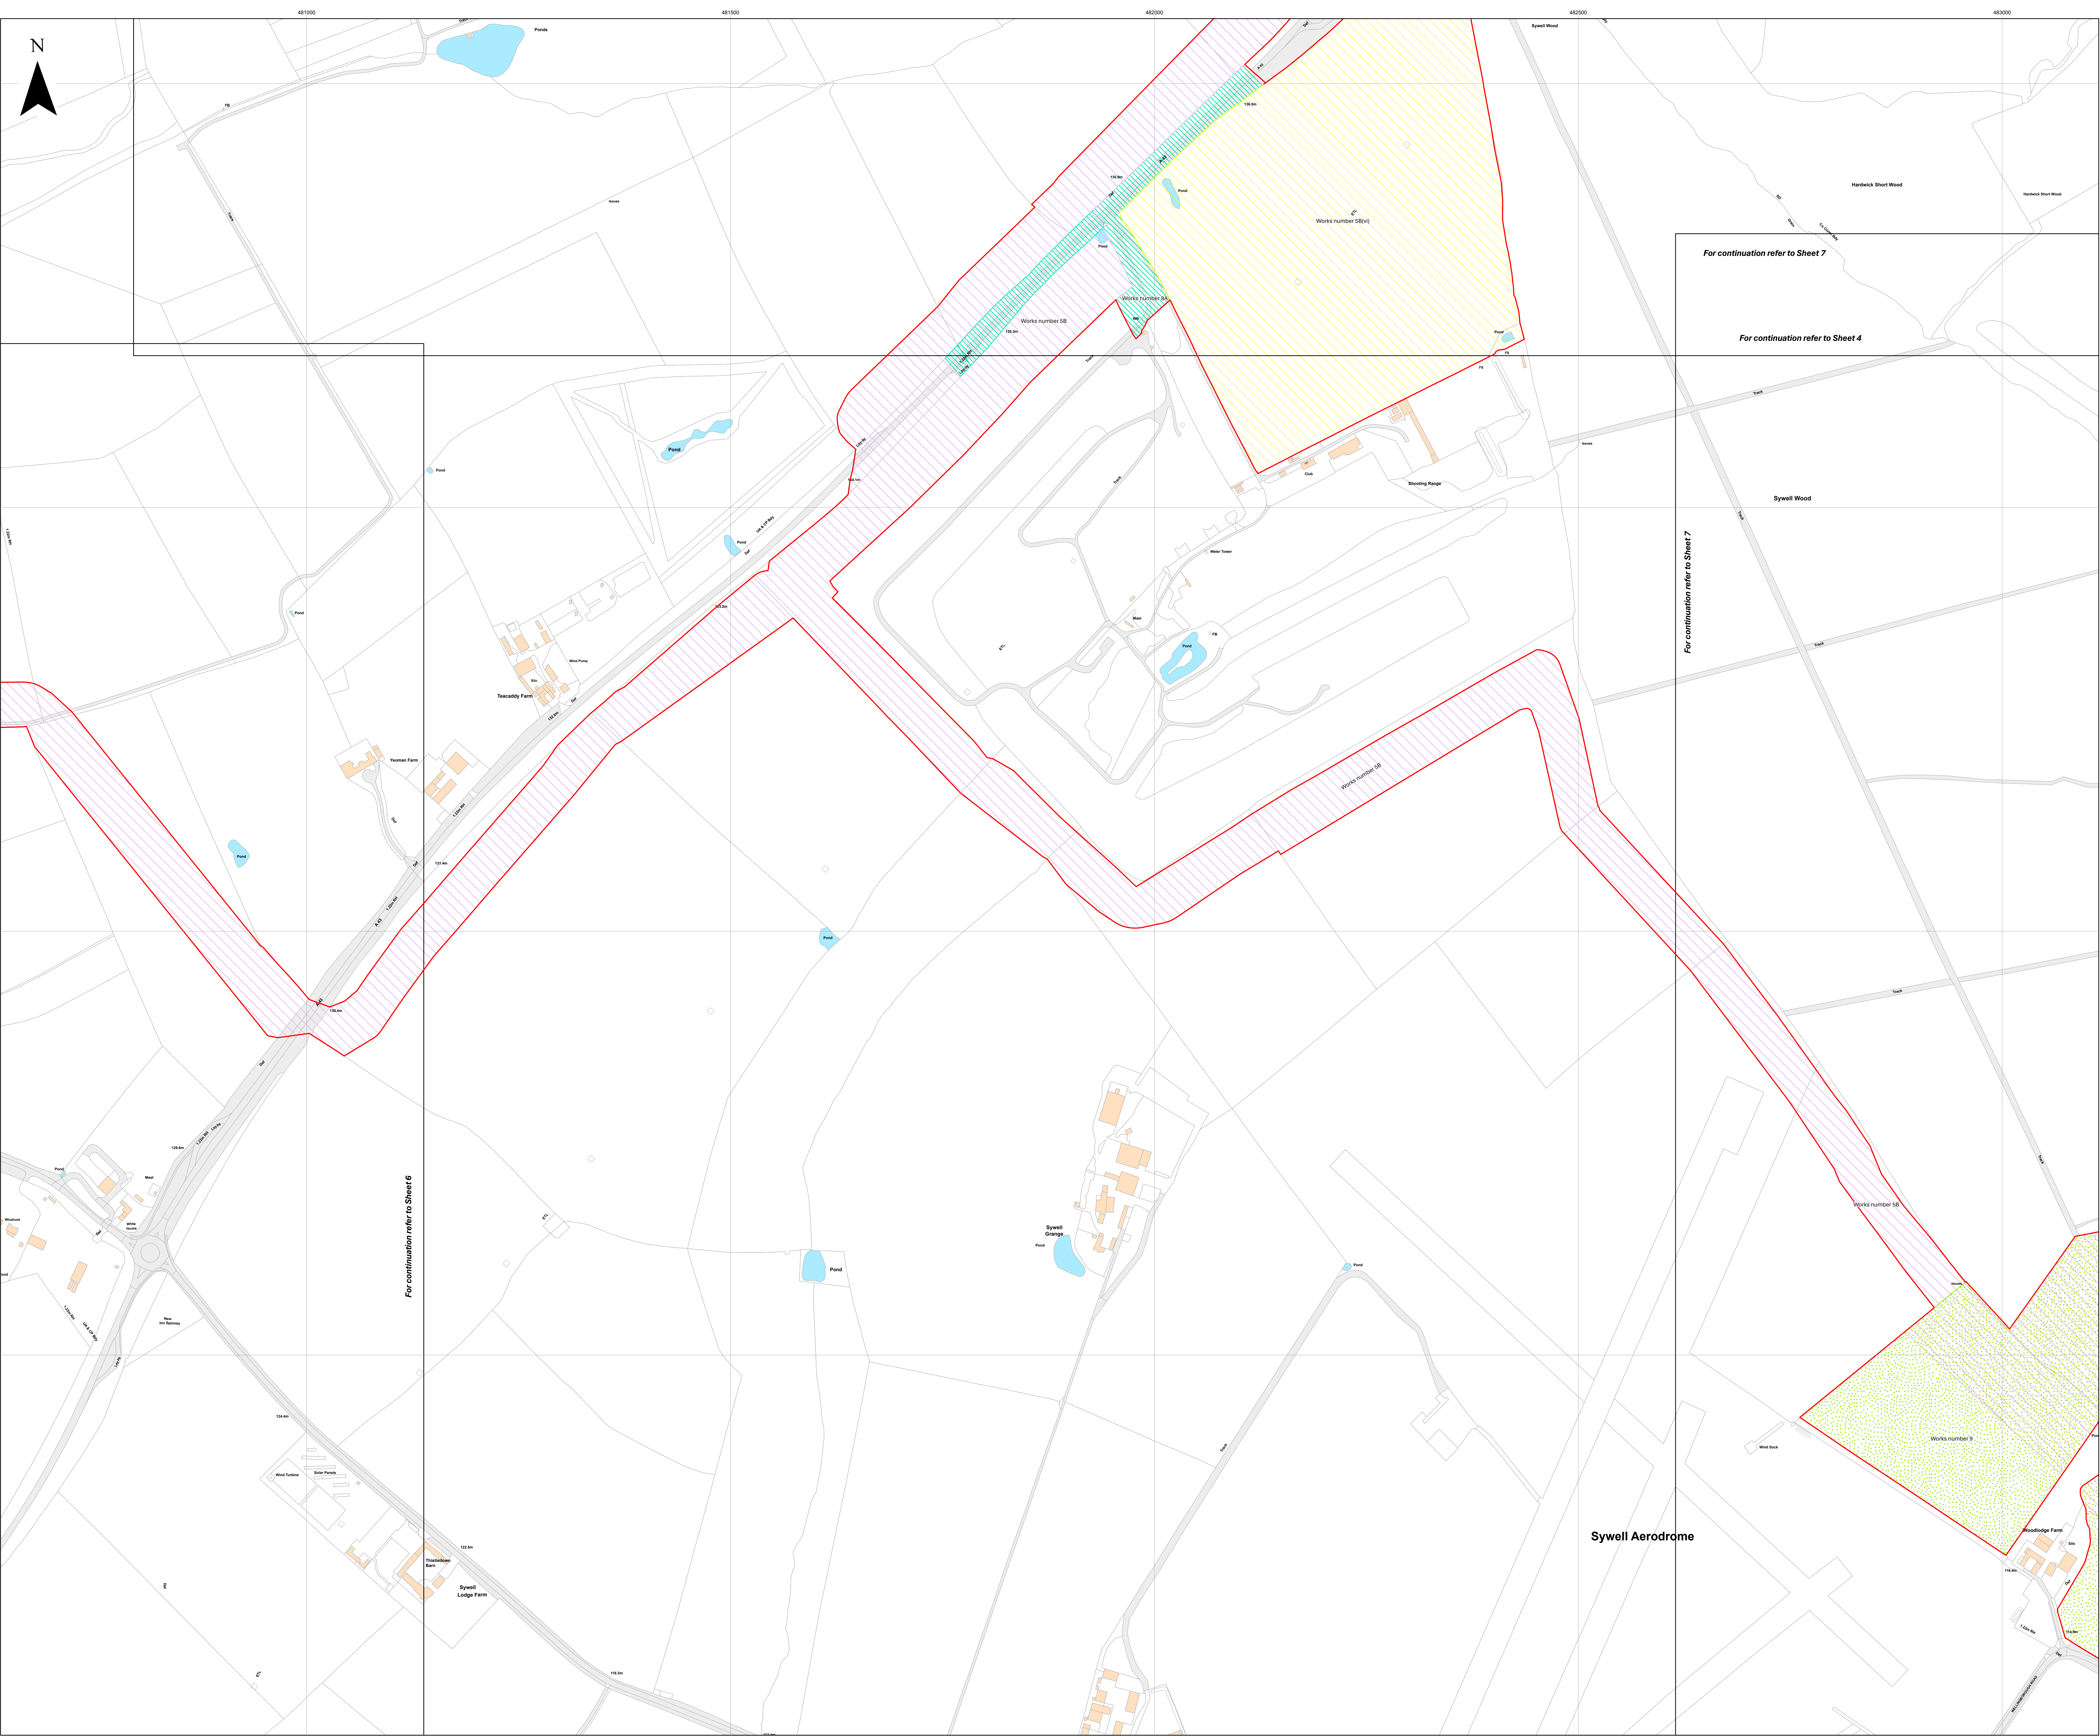



Key

- Order Limits
- Index Sheet
- Works Number
 - SB
 - SB(vi)
 - 8A
 - 9

Layers: Lanpro, 2025; KIP, 2025
Base map: Reproduced from Ordnance Survey digital map data © Crown copyright 2025. All rights reserved. License number 0100031673

0100031673

0 100 200 300 Meters

Scale: 1:2,500@ A0


APFP Regulation: 5(2)(j)	Application Doc No. EX3/GH2.4_D
Ref: P3535_LPR_ZZ_XX_DR_Z_0274	Date: 15/12/2025
Drawn by: AZ	Checked by: JC

Works Plan

Sheet 5 of 18

Revision D



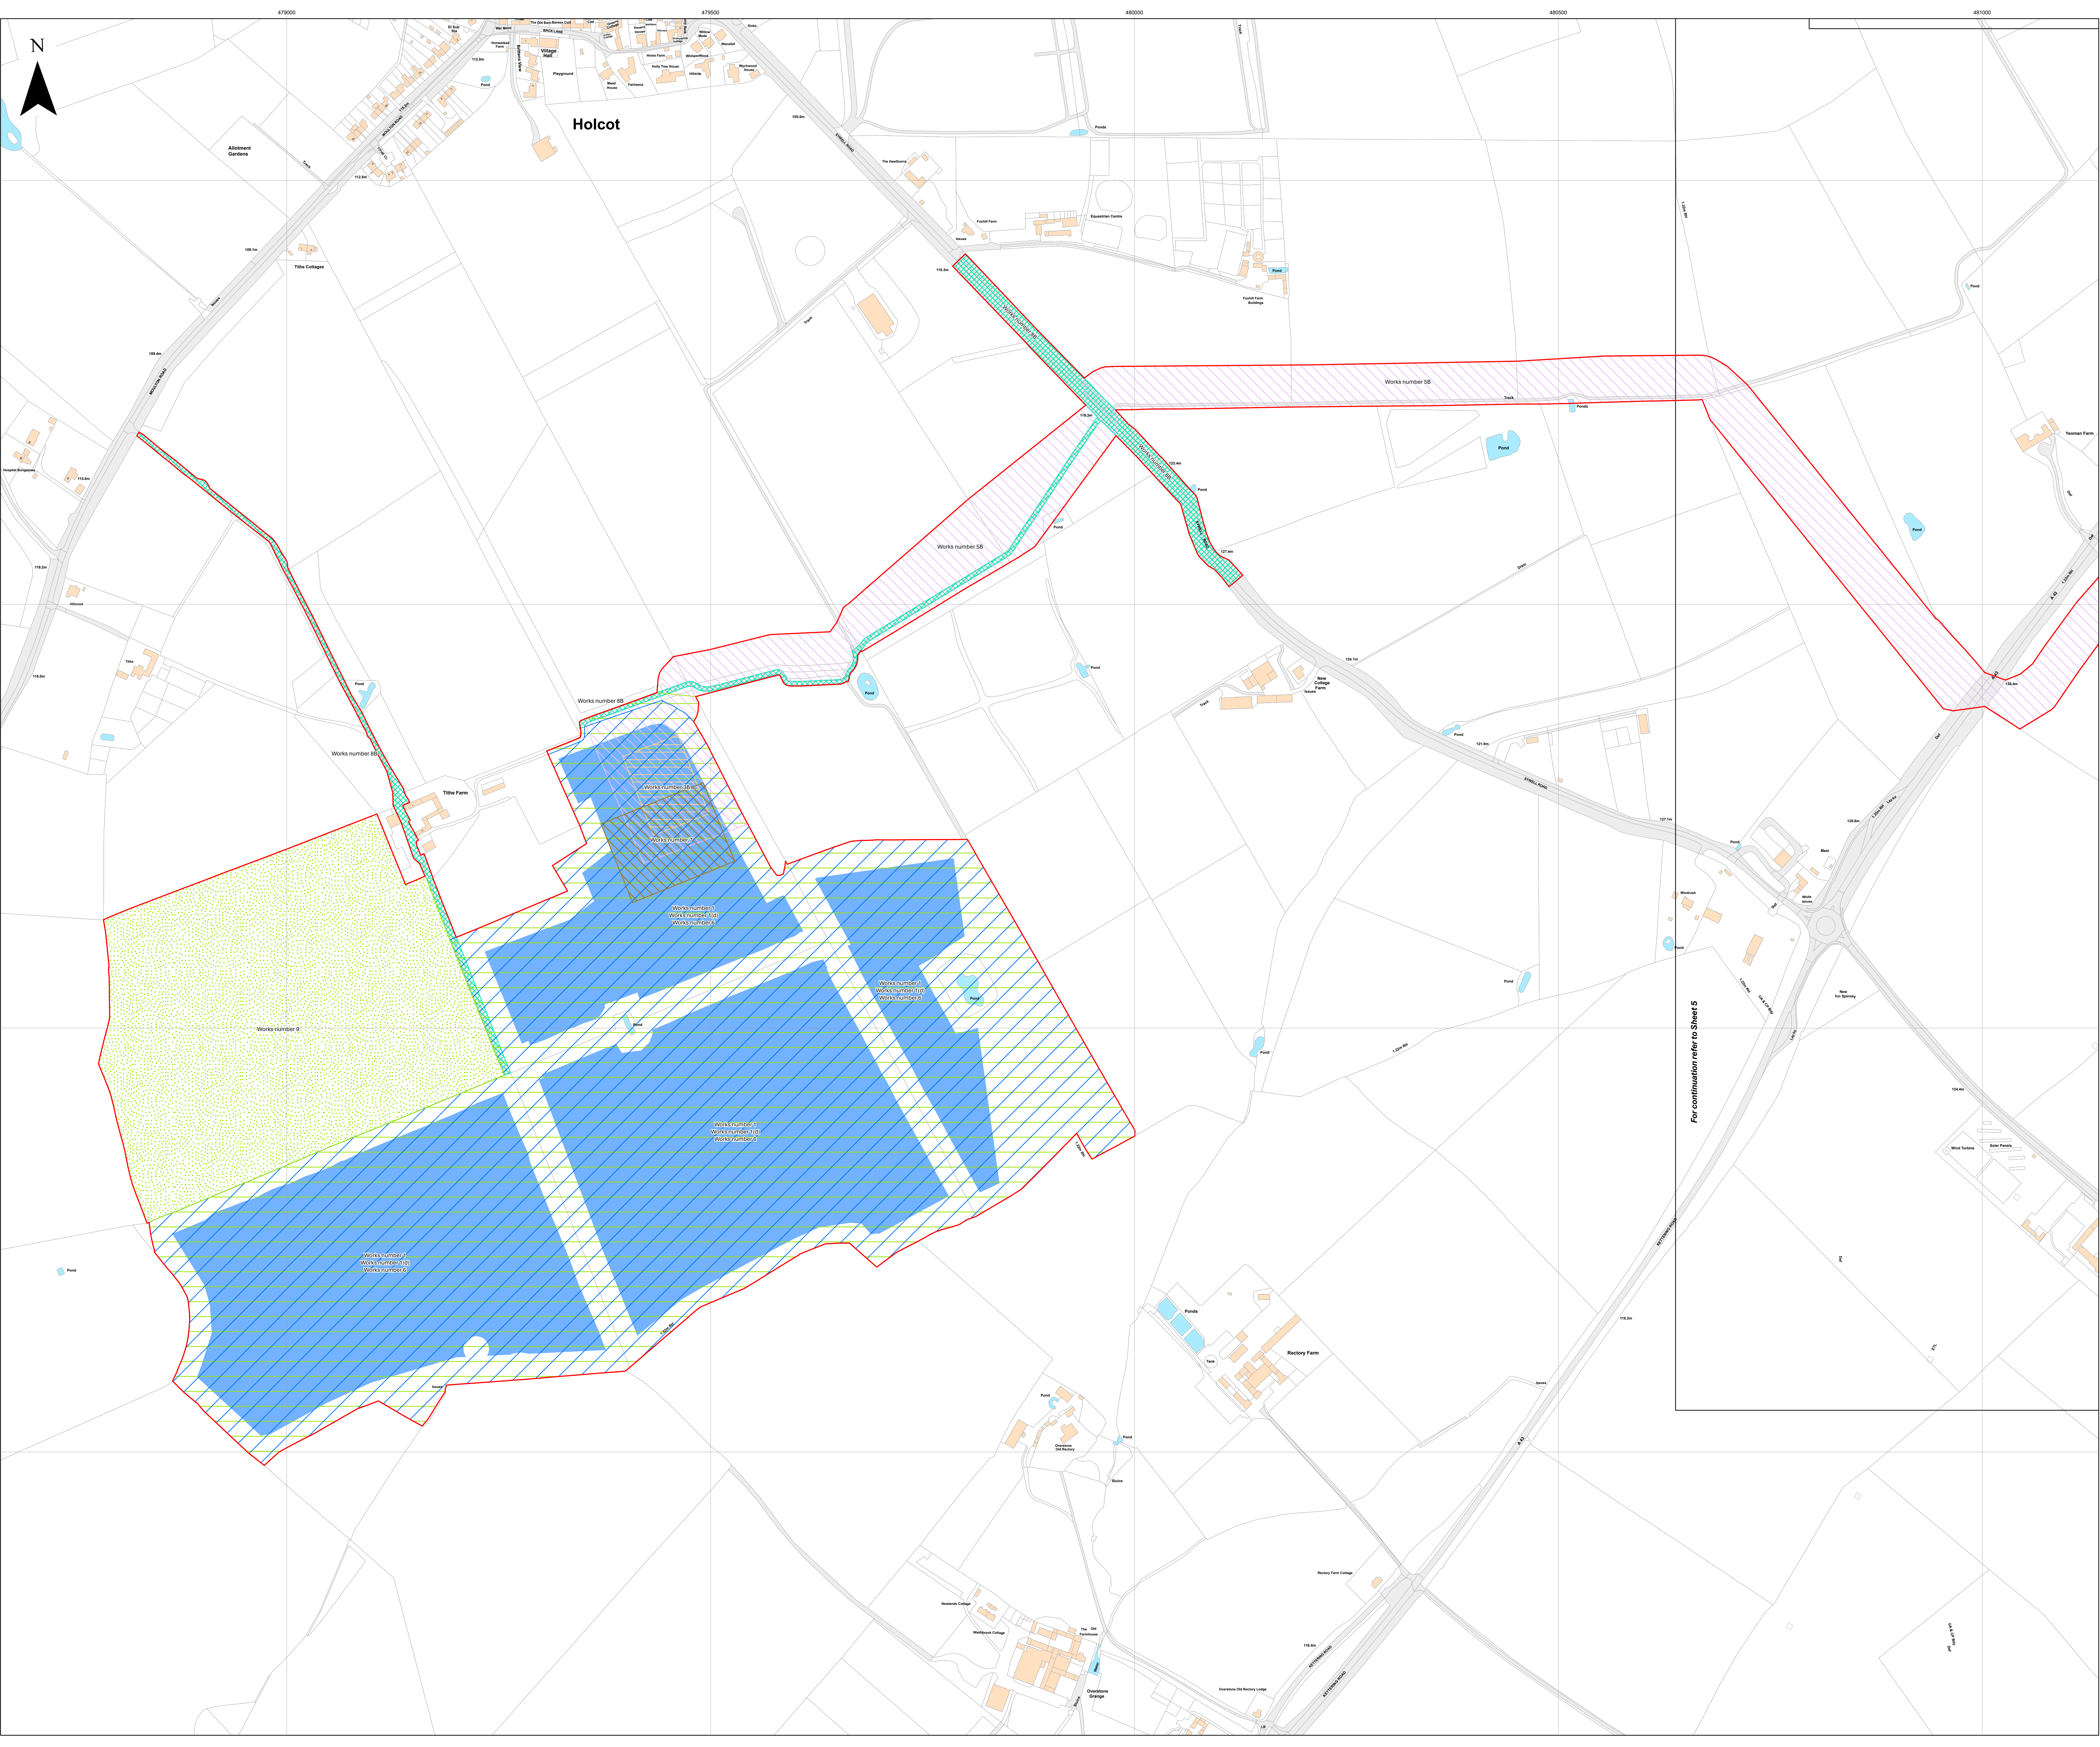



Key

- Order Limits
- Index Sheet
- Works Number**
- 1
- 1(d)
- 3B
- 5B
- 6
- 7
- 8B
- 9

Layers: Lanpro, 2025; KPR, 2025
Base map: Reproduced from Ordnance Survey digital map data © Crown copyright 2025. All rights reserved. License number 0100031673

0100031673

0

100

200

300 Meters

Scale: 1:2,500@ A0


APFP Regulation: 5(2)(j)	Application Doc No. EX3/GH2.4_D
Ref: P3535_LPR_ZZ_XX_DR_Z_0274	Date: 15/12/2025
Drawn by: AZ	Checked by: JC

Works Plan

Sheet 6 of 18

Revision D



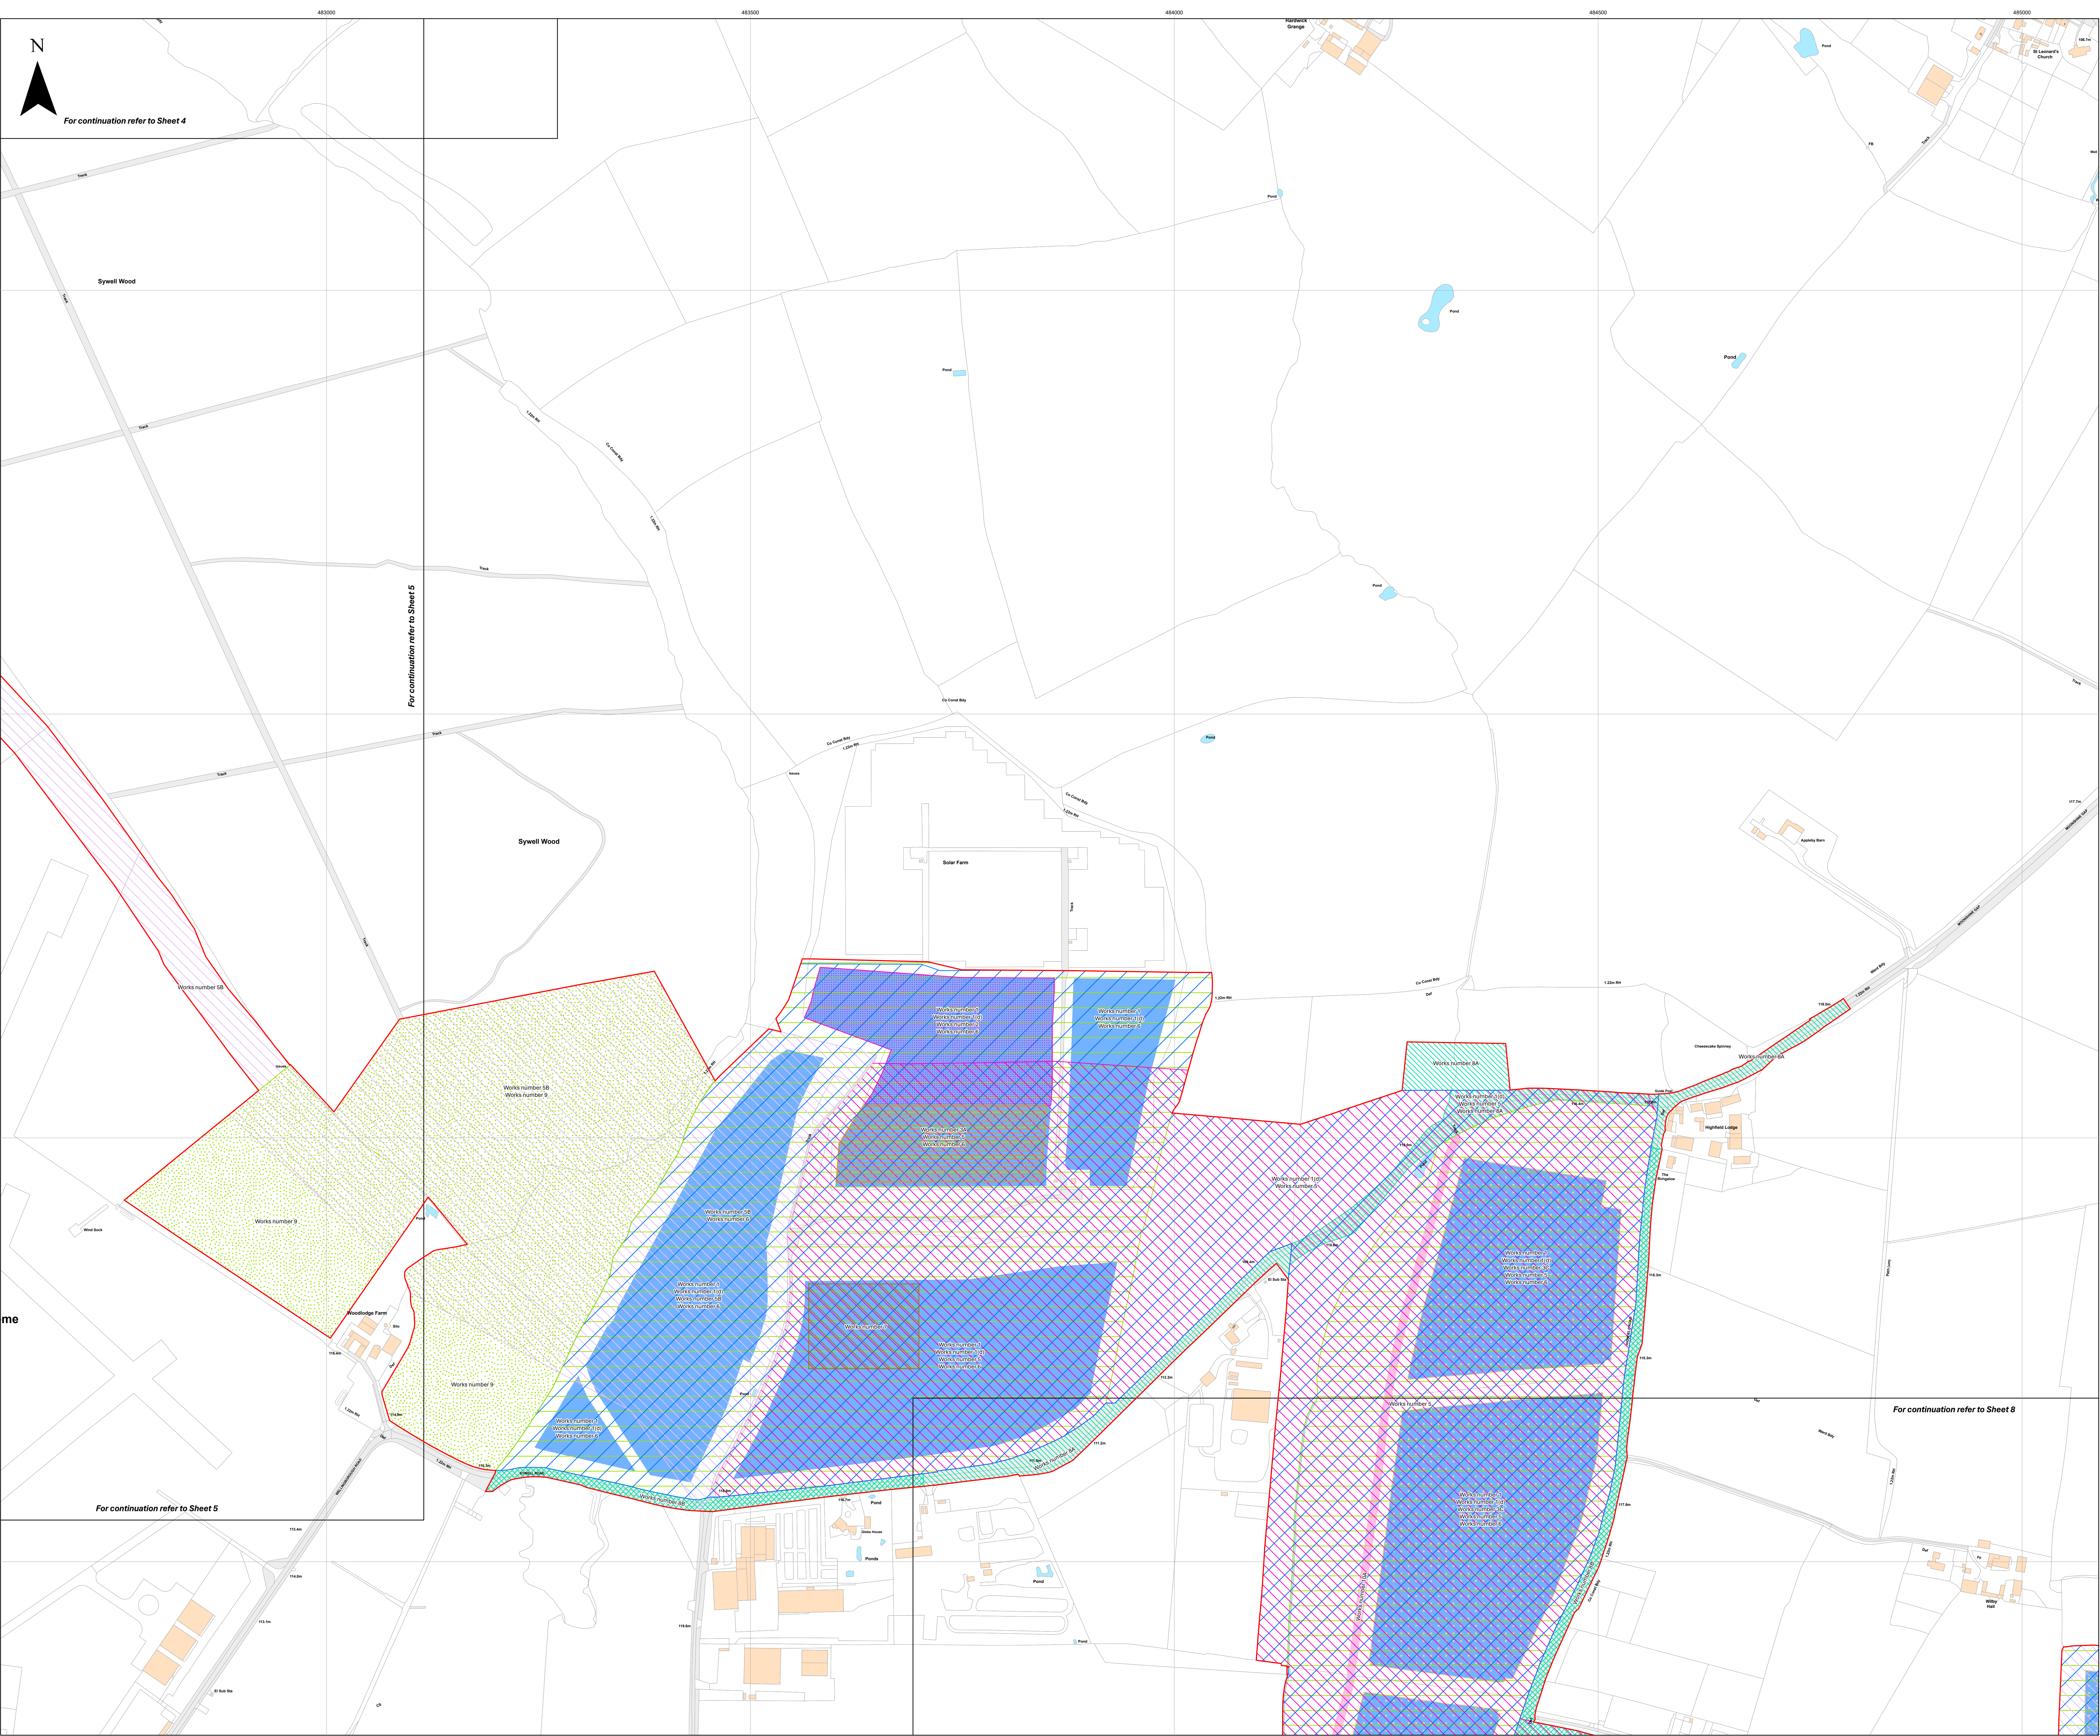



Key

- Order Limits
- Index Sheet
- Works Number**
- 1
- 1(d)
- 2
- 3A
- 3C
- 5
- 5B
- 6
- 7
- 8A
- 8B
- 9
- 10A

Layers: Lanpro, 2025; KPR, 2025
Base map: Reproduced from Ordnance Survey digital map data © Crown copyright 2025. All rights reserved. License number 0100031673


0 100 200 300 Meters


Scale: 1:2,500@ A0

APFP Regulation: 5(2)(j)	Application Doc No. EX3/GH2.4_D
Ref: P3535_LPR_ZZ_XX_DR_Z_0274	Date: 15/12/2025
Drawn by: AZ	Checked by: JC

Works Plan
Sheet 7 of 18
Revision D



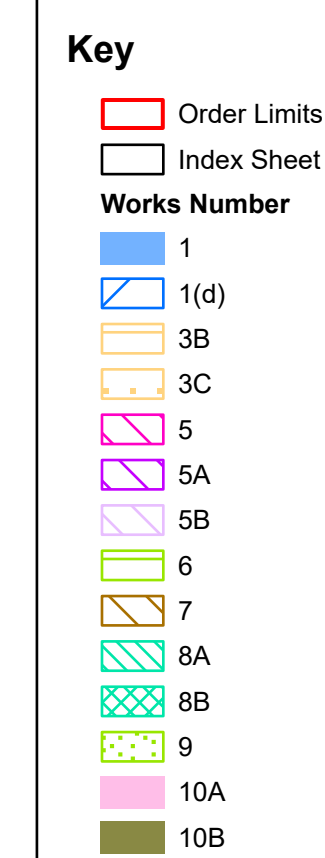

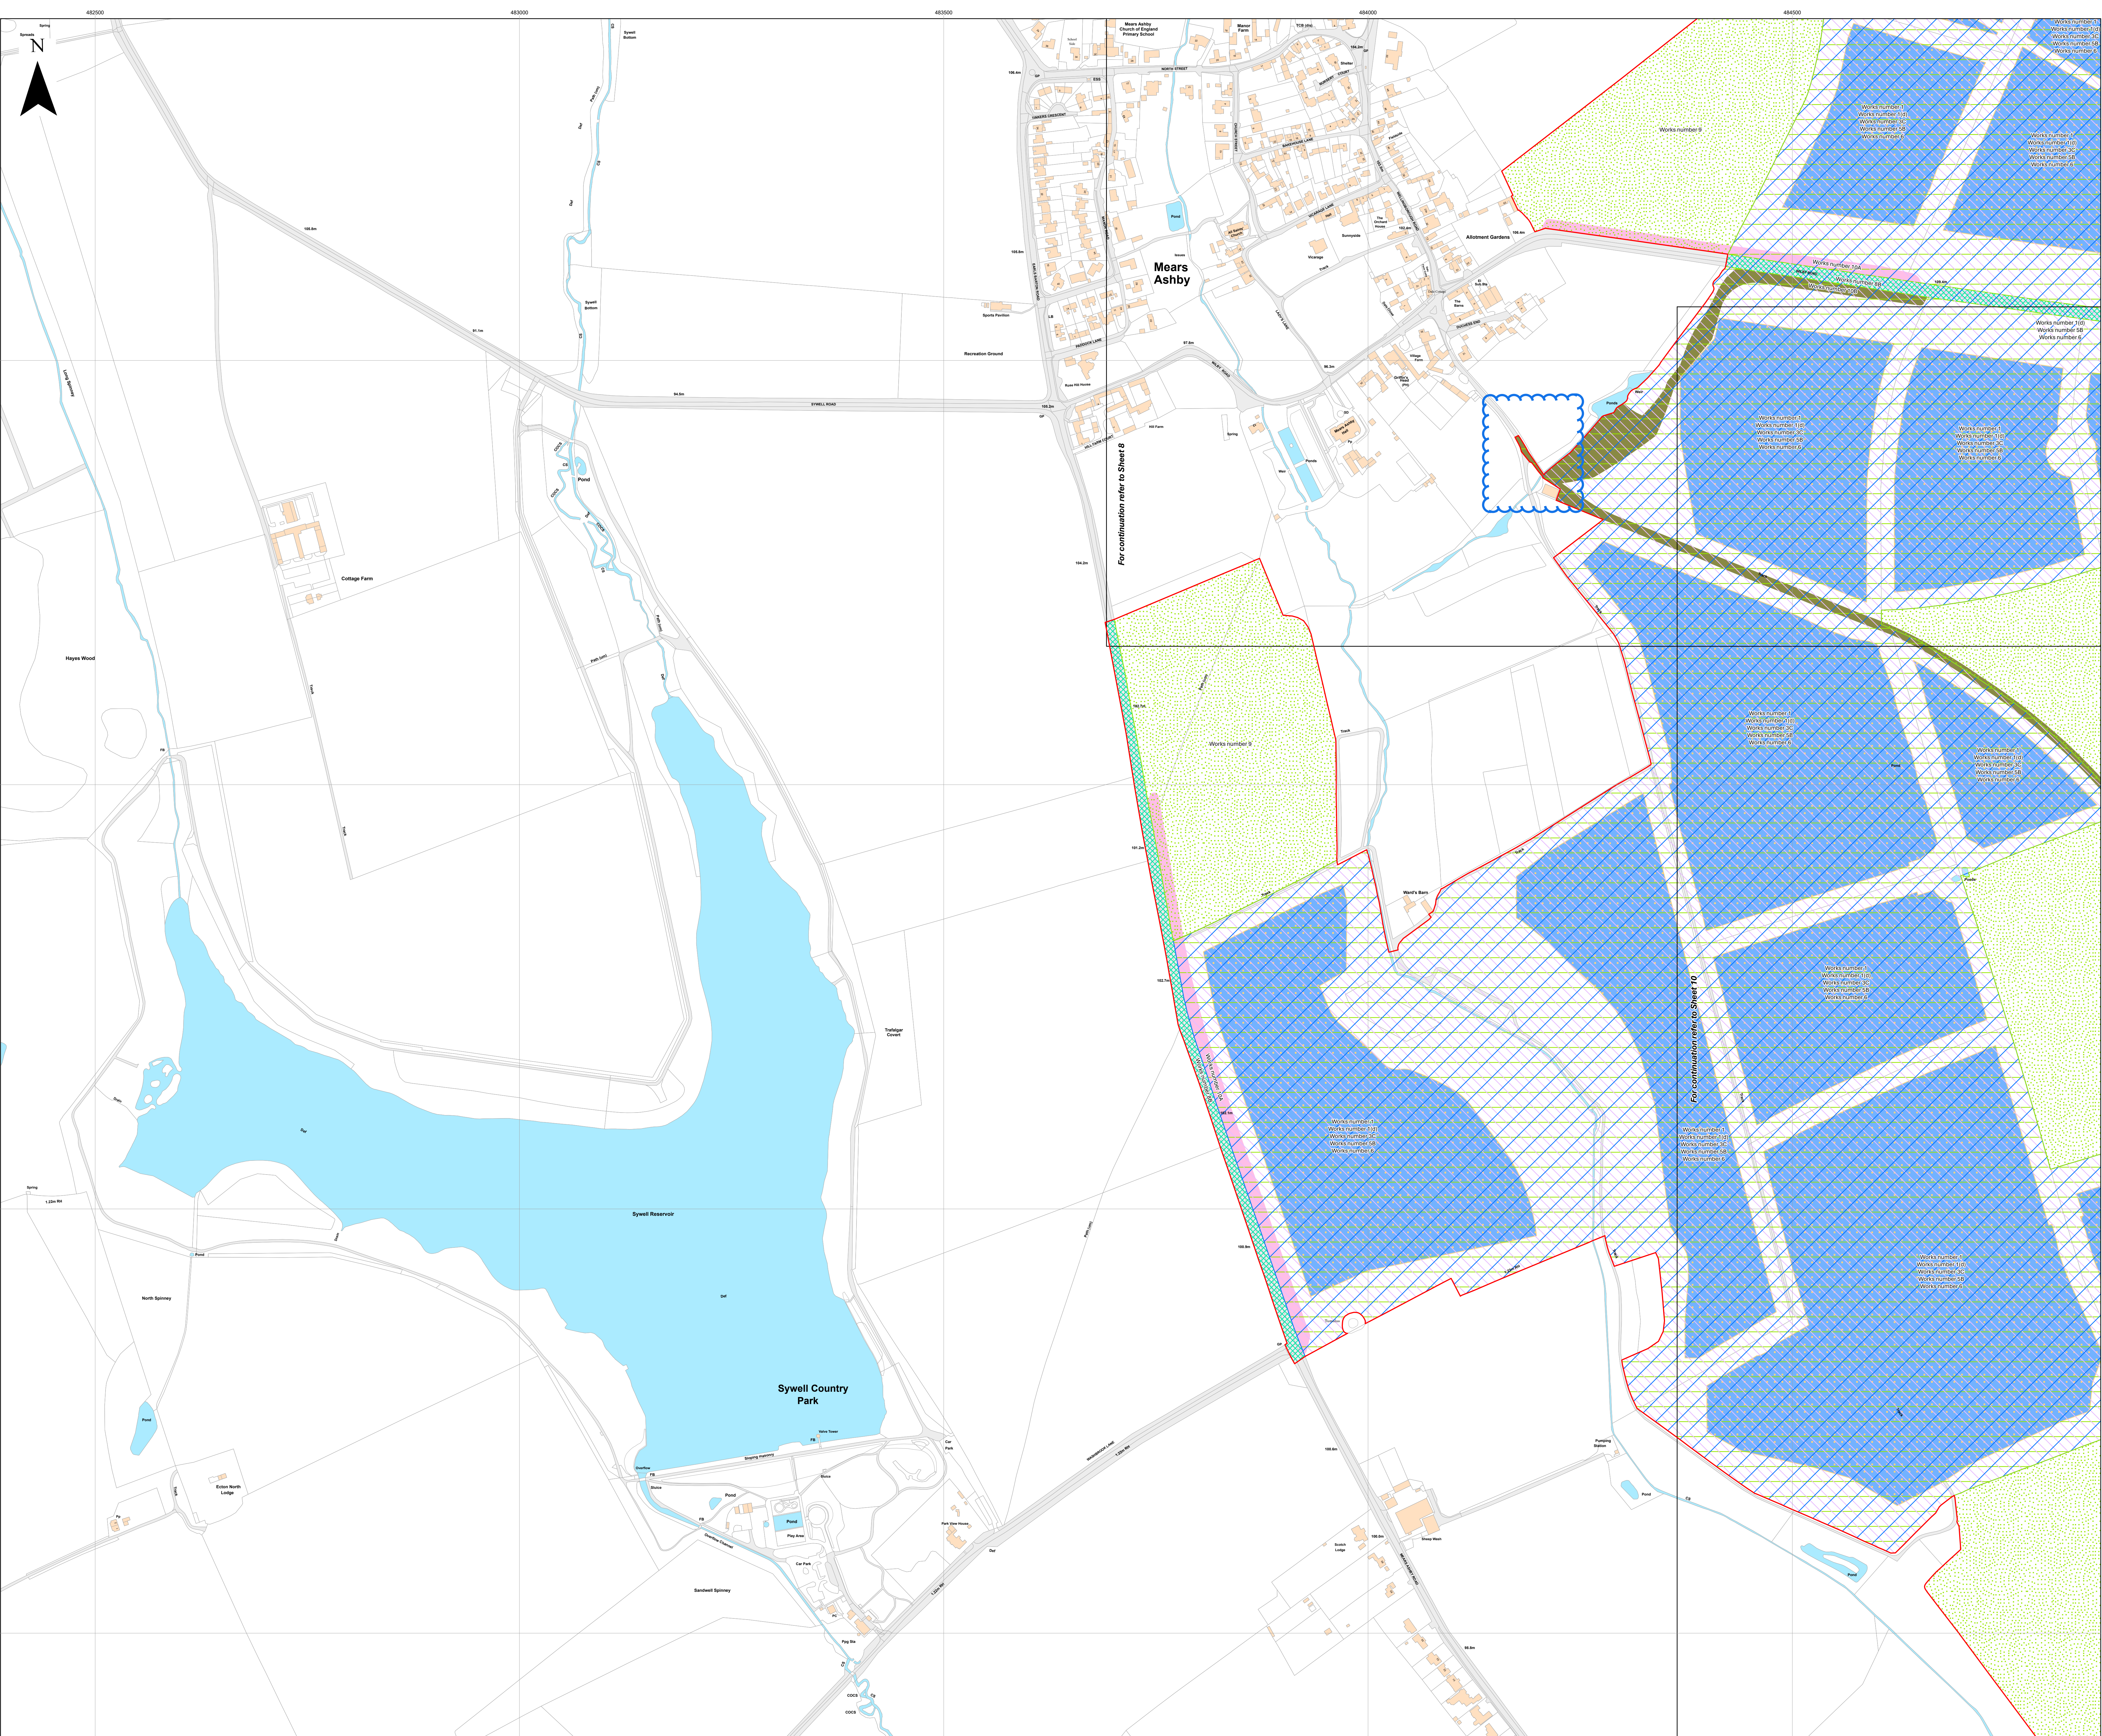



Key

- Order Limits
- Index Sheet
- Works Number**
- 1
- 1(d)
- 3C
- 5B
- 6
- 8B
- 9
- 10A
- 10B

Layers: Lanpro, 2025: KPR, 2025
Base map: Reproduced from Ordnance Survey digital map data © Crown copyright 2025. All rights reserved. License number 0100031673


0 100 200 300 Meters

Scale: 1:2,500@ A0

APFP Regulation: 5(2)(j)	Application Doc No. EX3/GH2.4_D
Ref: P3535_LPR_ZZ_XX_DR_Z_0274	Date: 15/12/2025
Drawn by: AZ	Checked by: JC

Works Plan
Sheet 9 of 18
Revision D



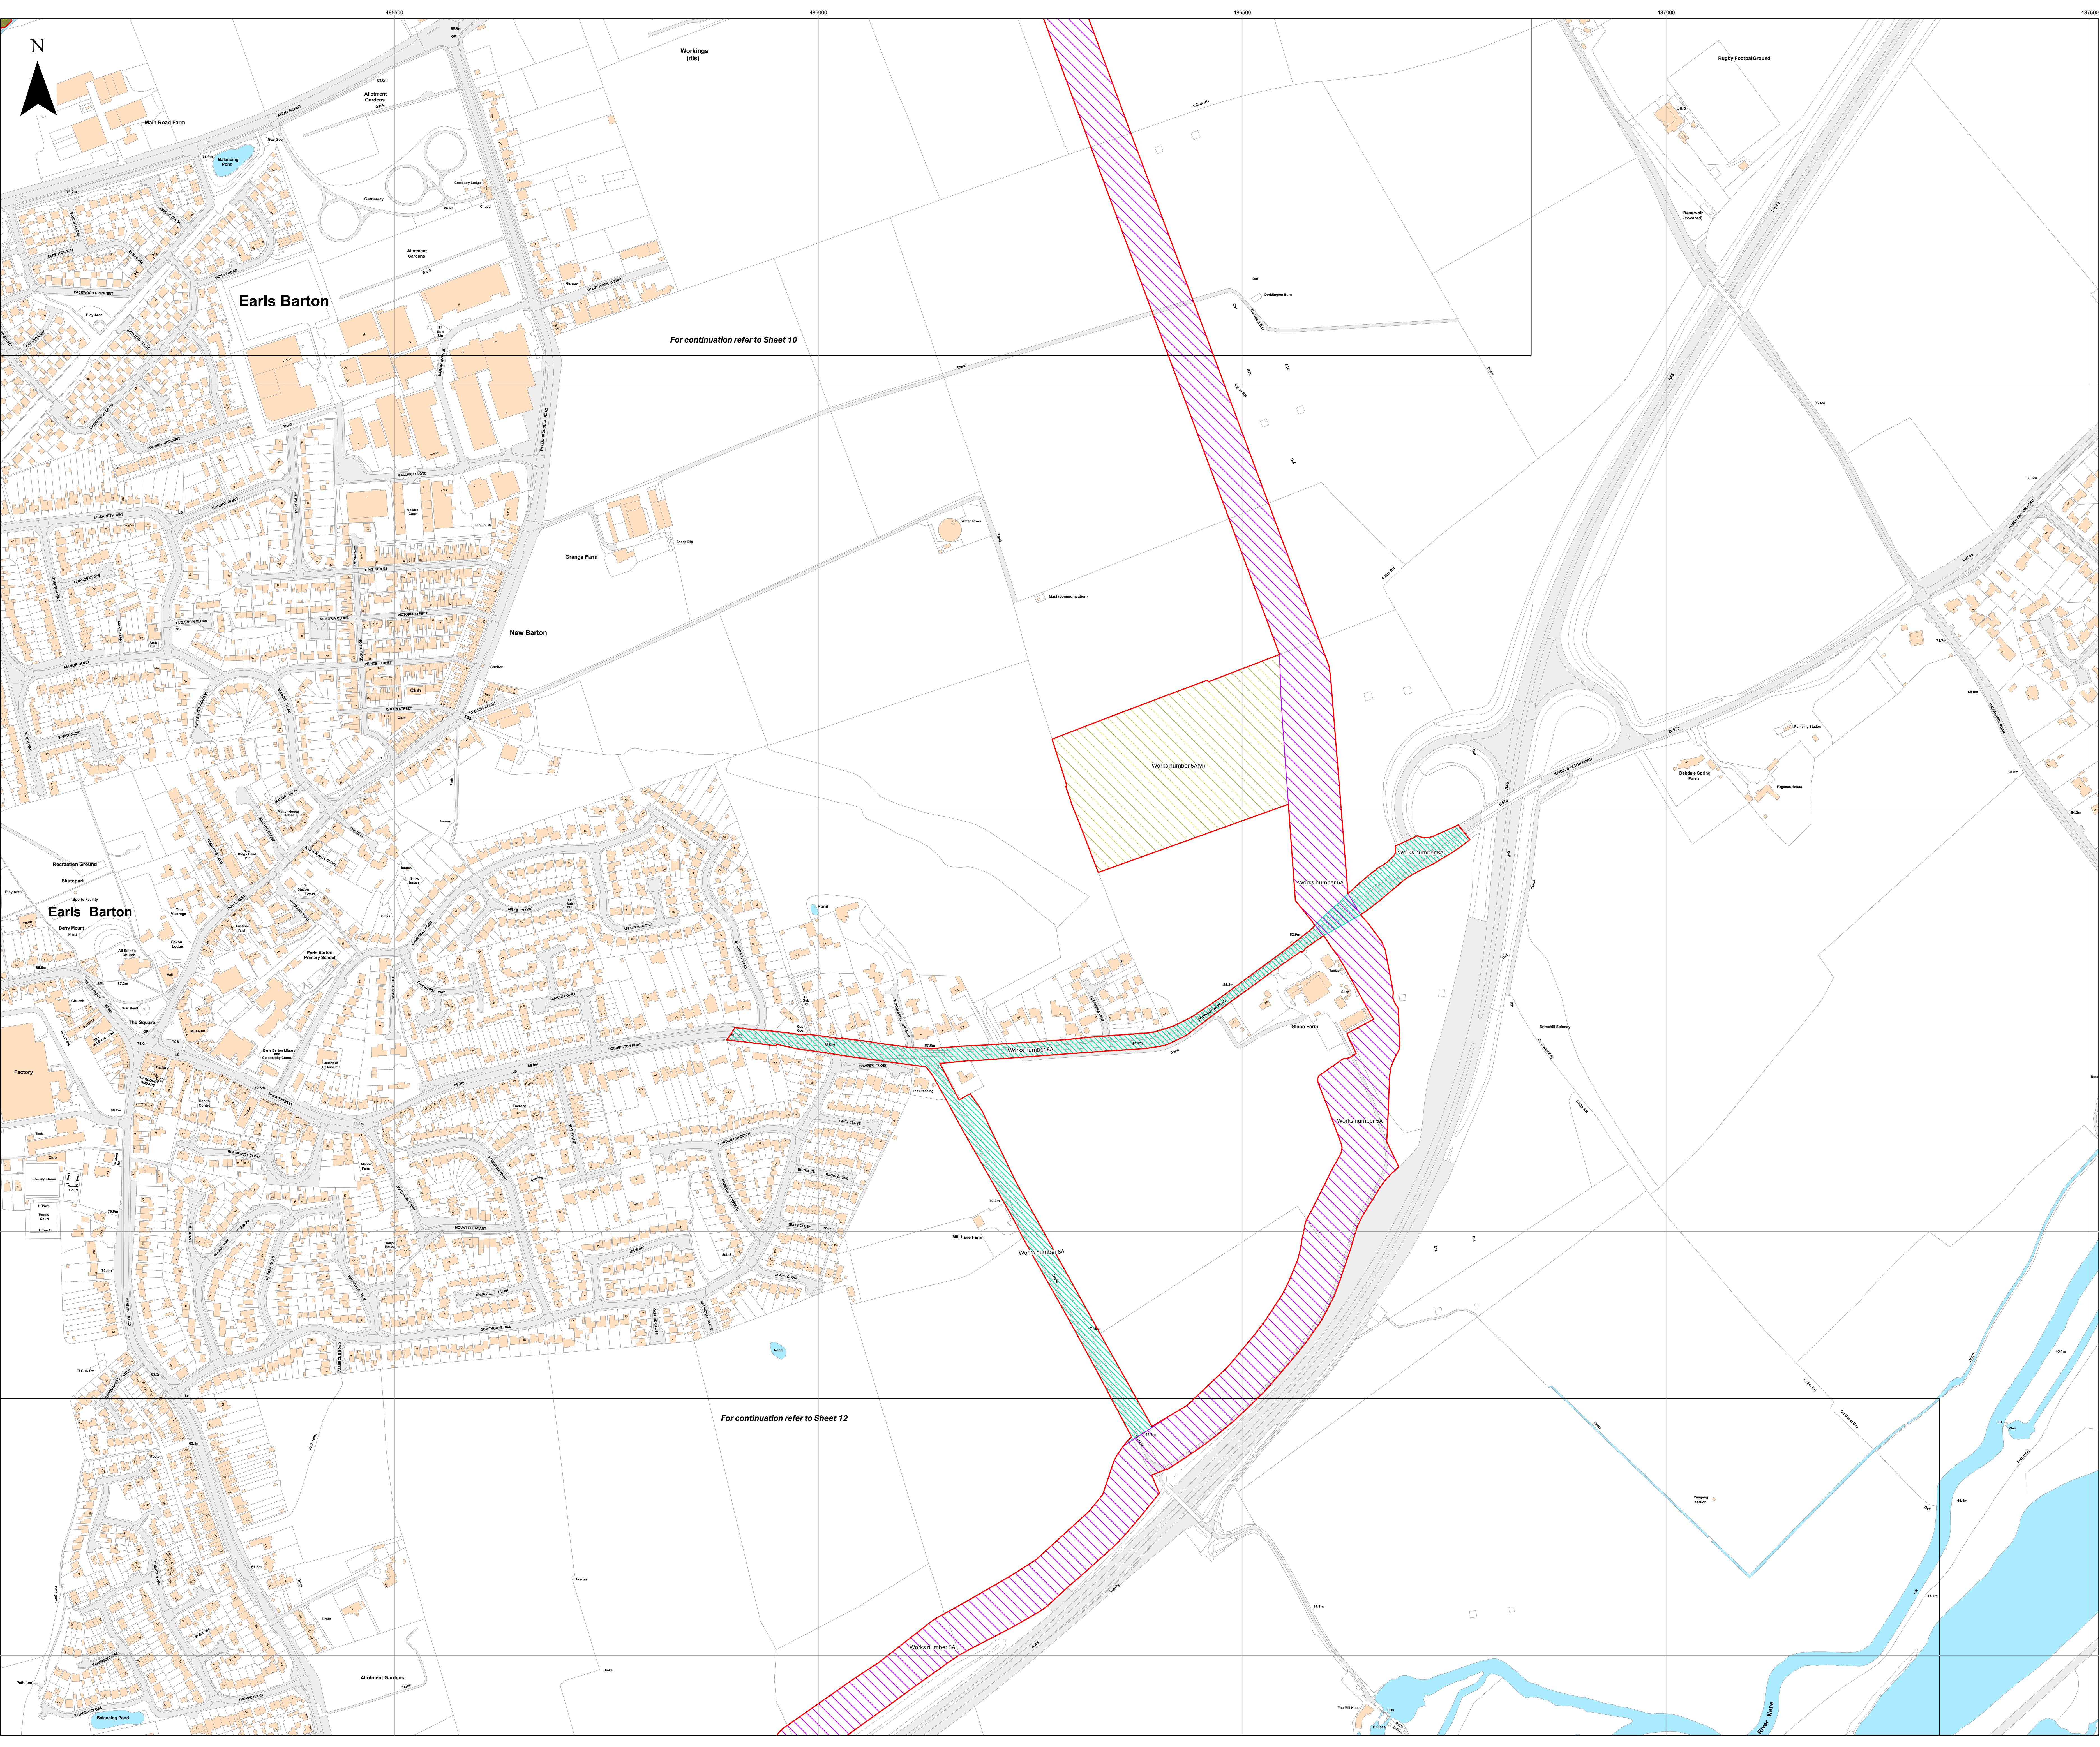



Key

- Order Limits
- Index Sheet
- Works Number
 - 5A
 - 5A(vi)
 - 8A
 - 9
 - 10B

Layers: Lanpro, 2025; KPR, 2025
Base map: Reproduced from Ordnance Survey digital map data © Crown copyright 2025. All rights reserved. License number 0100031673


0 100 200 300 Meters

Scale: 1:2,500@ A0

APFP Regulation: 5(2)(j)	Application Doc No. EX3/GH2.4_D
Ref: P3535_LPR_ZZ_XX_DR_Z_0274	Date: 15/12/2025
Drawn by: AZ	Checked by: JC

Works Plan
Sheet 11 of 18
Revision D



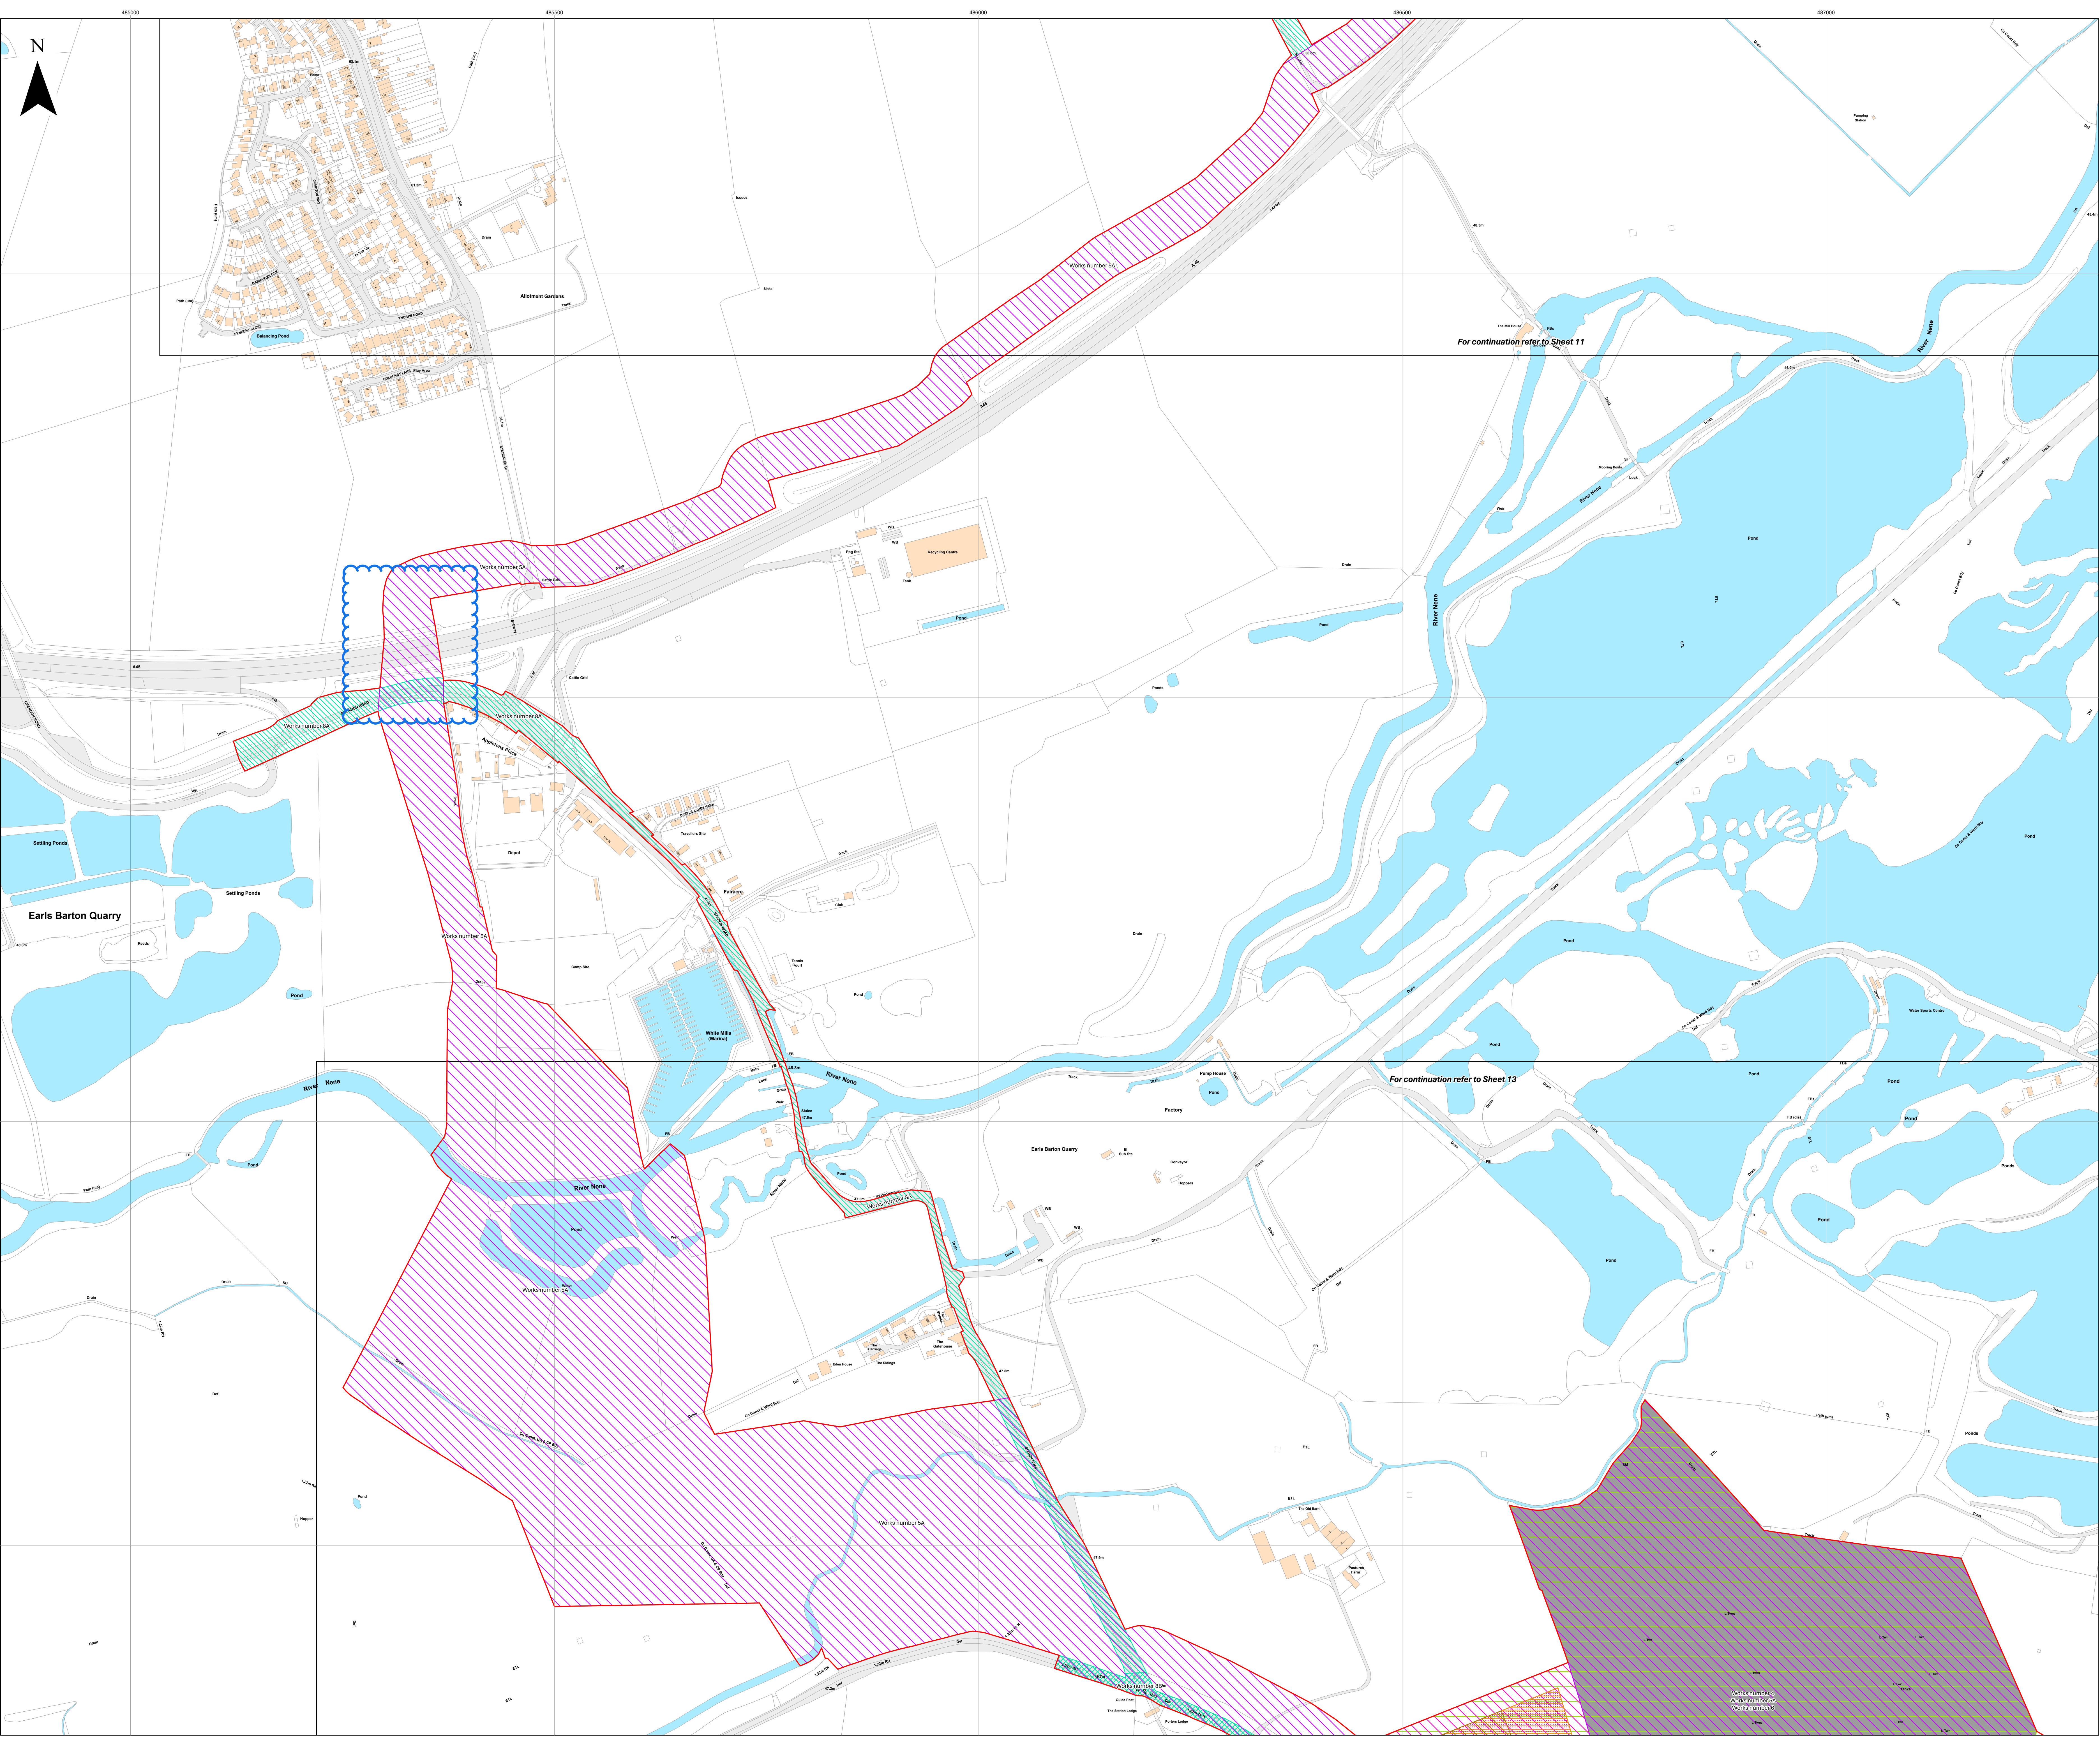

Key

- Order Limits
- Index Sheet
- Works Number**
- 2
- 3A
- 4
- 5
- 5A
- 6
- 7
- 8A
- 8B


Layers: Lanpro, 2025: KIP, 2025
 Base map: Reproduced from Ordnance Survey digital map data © Crown copyright 2025. All rights reserved. License number 0100031673

0 100 200 300 Meters

Scale: 1:2,500@ A0

APFP Regulation: 5(2)(j)	Application Doc No. EX3/GH2.4_D
Ref: P3535_LPR_ZZ_XX_DR_Z_0274	Date: 15/12/2025
Drawn by: AZ	Checked by: JC

Works Plan
 Sheet 12 of 18
 Revision D

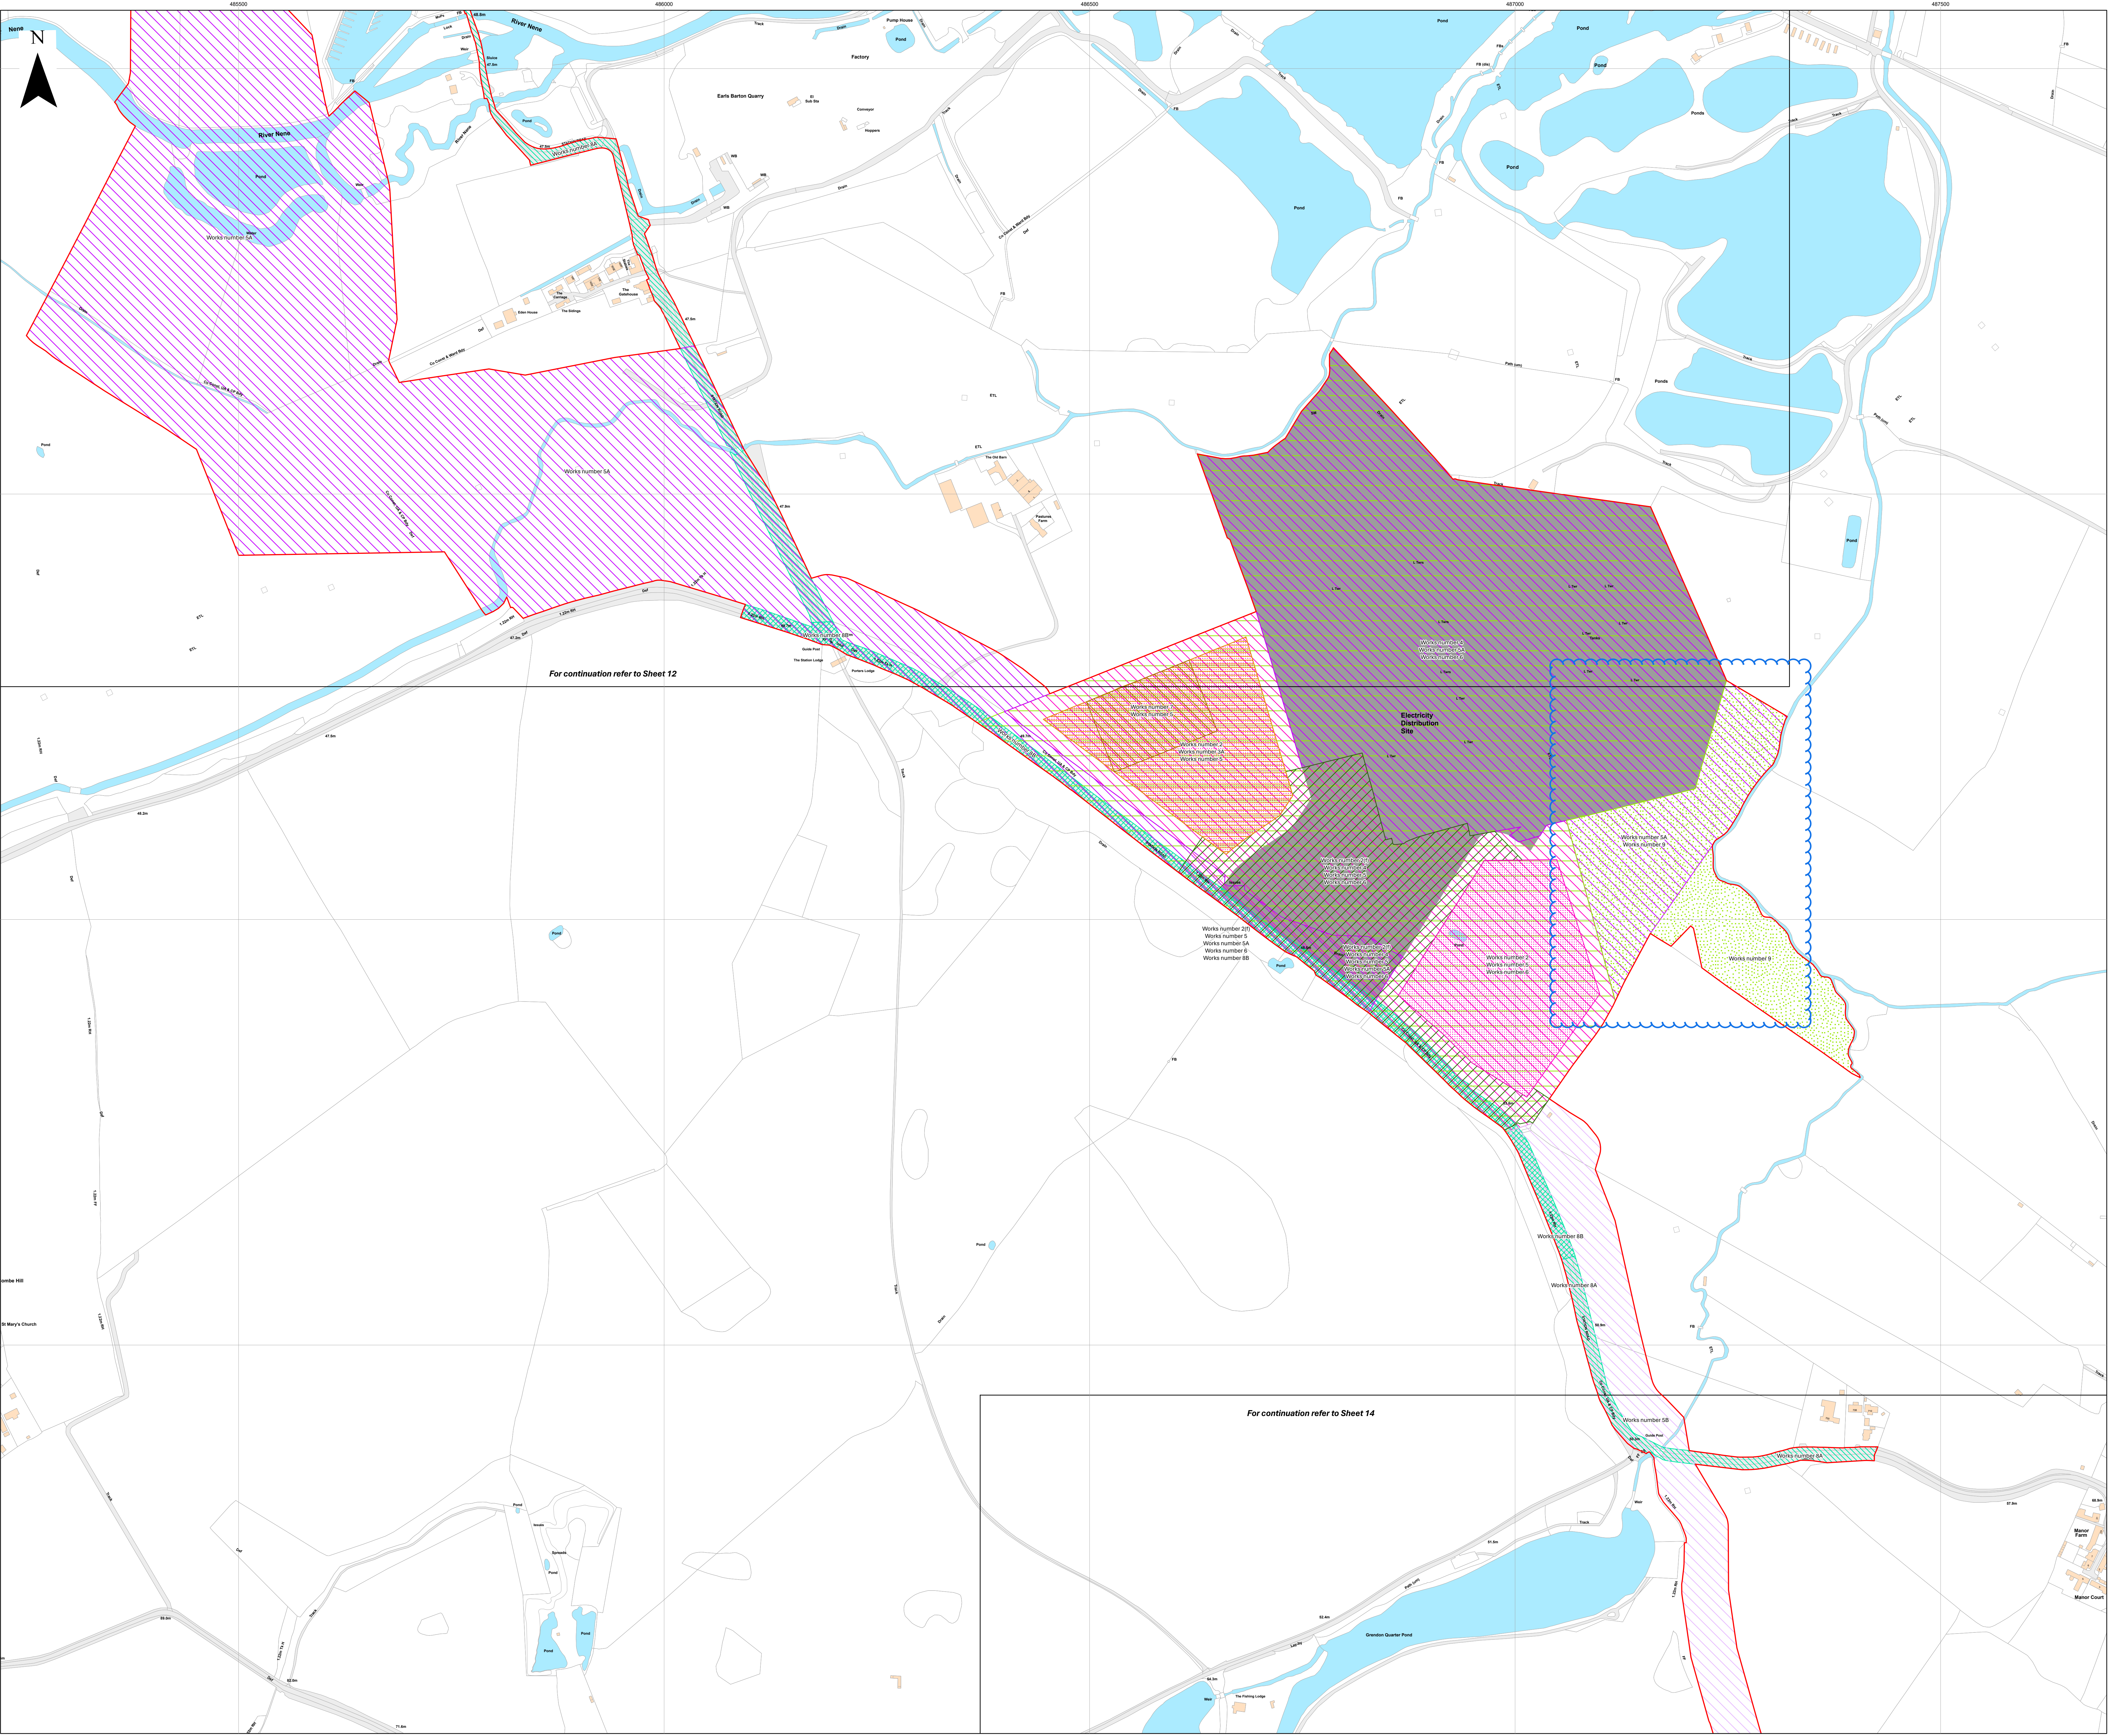



Key

- Order Limits
- Index Sheet
- Works Number**
- 2
- 2(f)
- 3A
- 4
- 5
- 5A
- 5B
- 6
- 7
- 8A
- 8B
- 9

Layers: Lanpro, 2025; KIP, 2025
Base map: Reproduced from Ordnance Survey digital map data © Crown copyright 2025. All rights reserved. License number 0100031673


0 100 200 300 Meters

Scale: 1:2,500@ A0

APFP Regulation: 5(2)(j)	Application Doc No. EX3/GH2.4_D
Ref: P3535_LPR_ZZ_XX_DR_Z_0274	Date: 15/12/2025
Drawn by: AZ	Checked by: JC


Works Plan
Sheet 13 of 18
Revision D



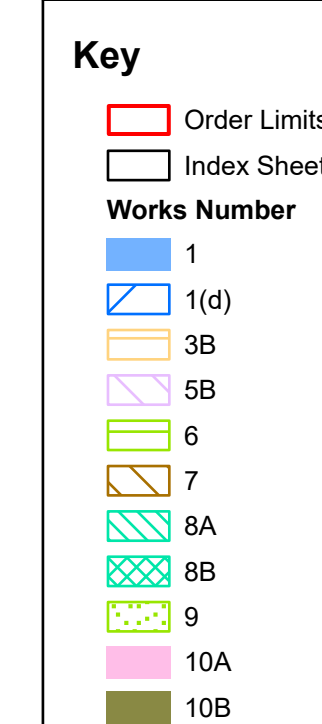

Works Plan
Sheet 15 of 18
Revision D



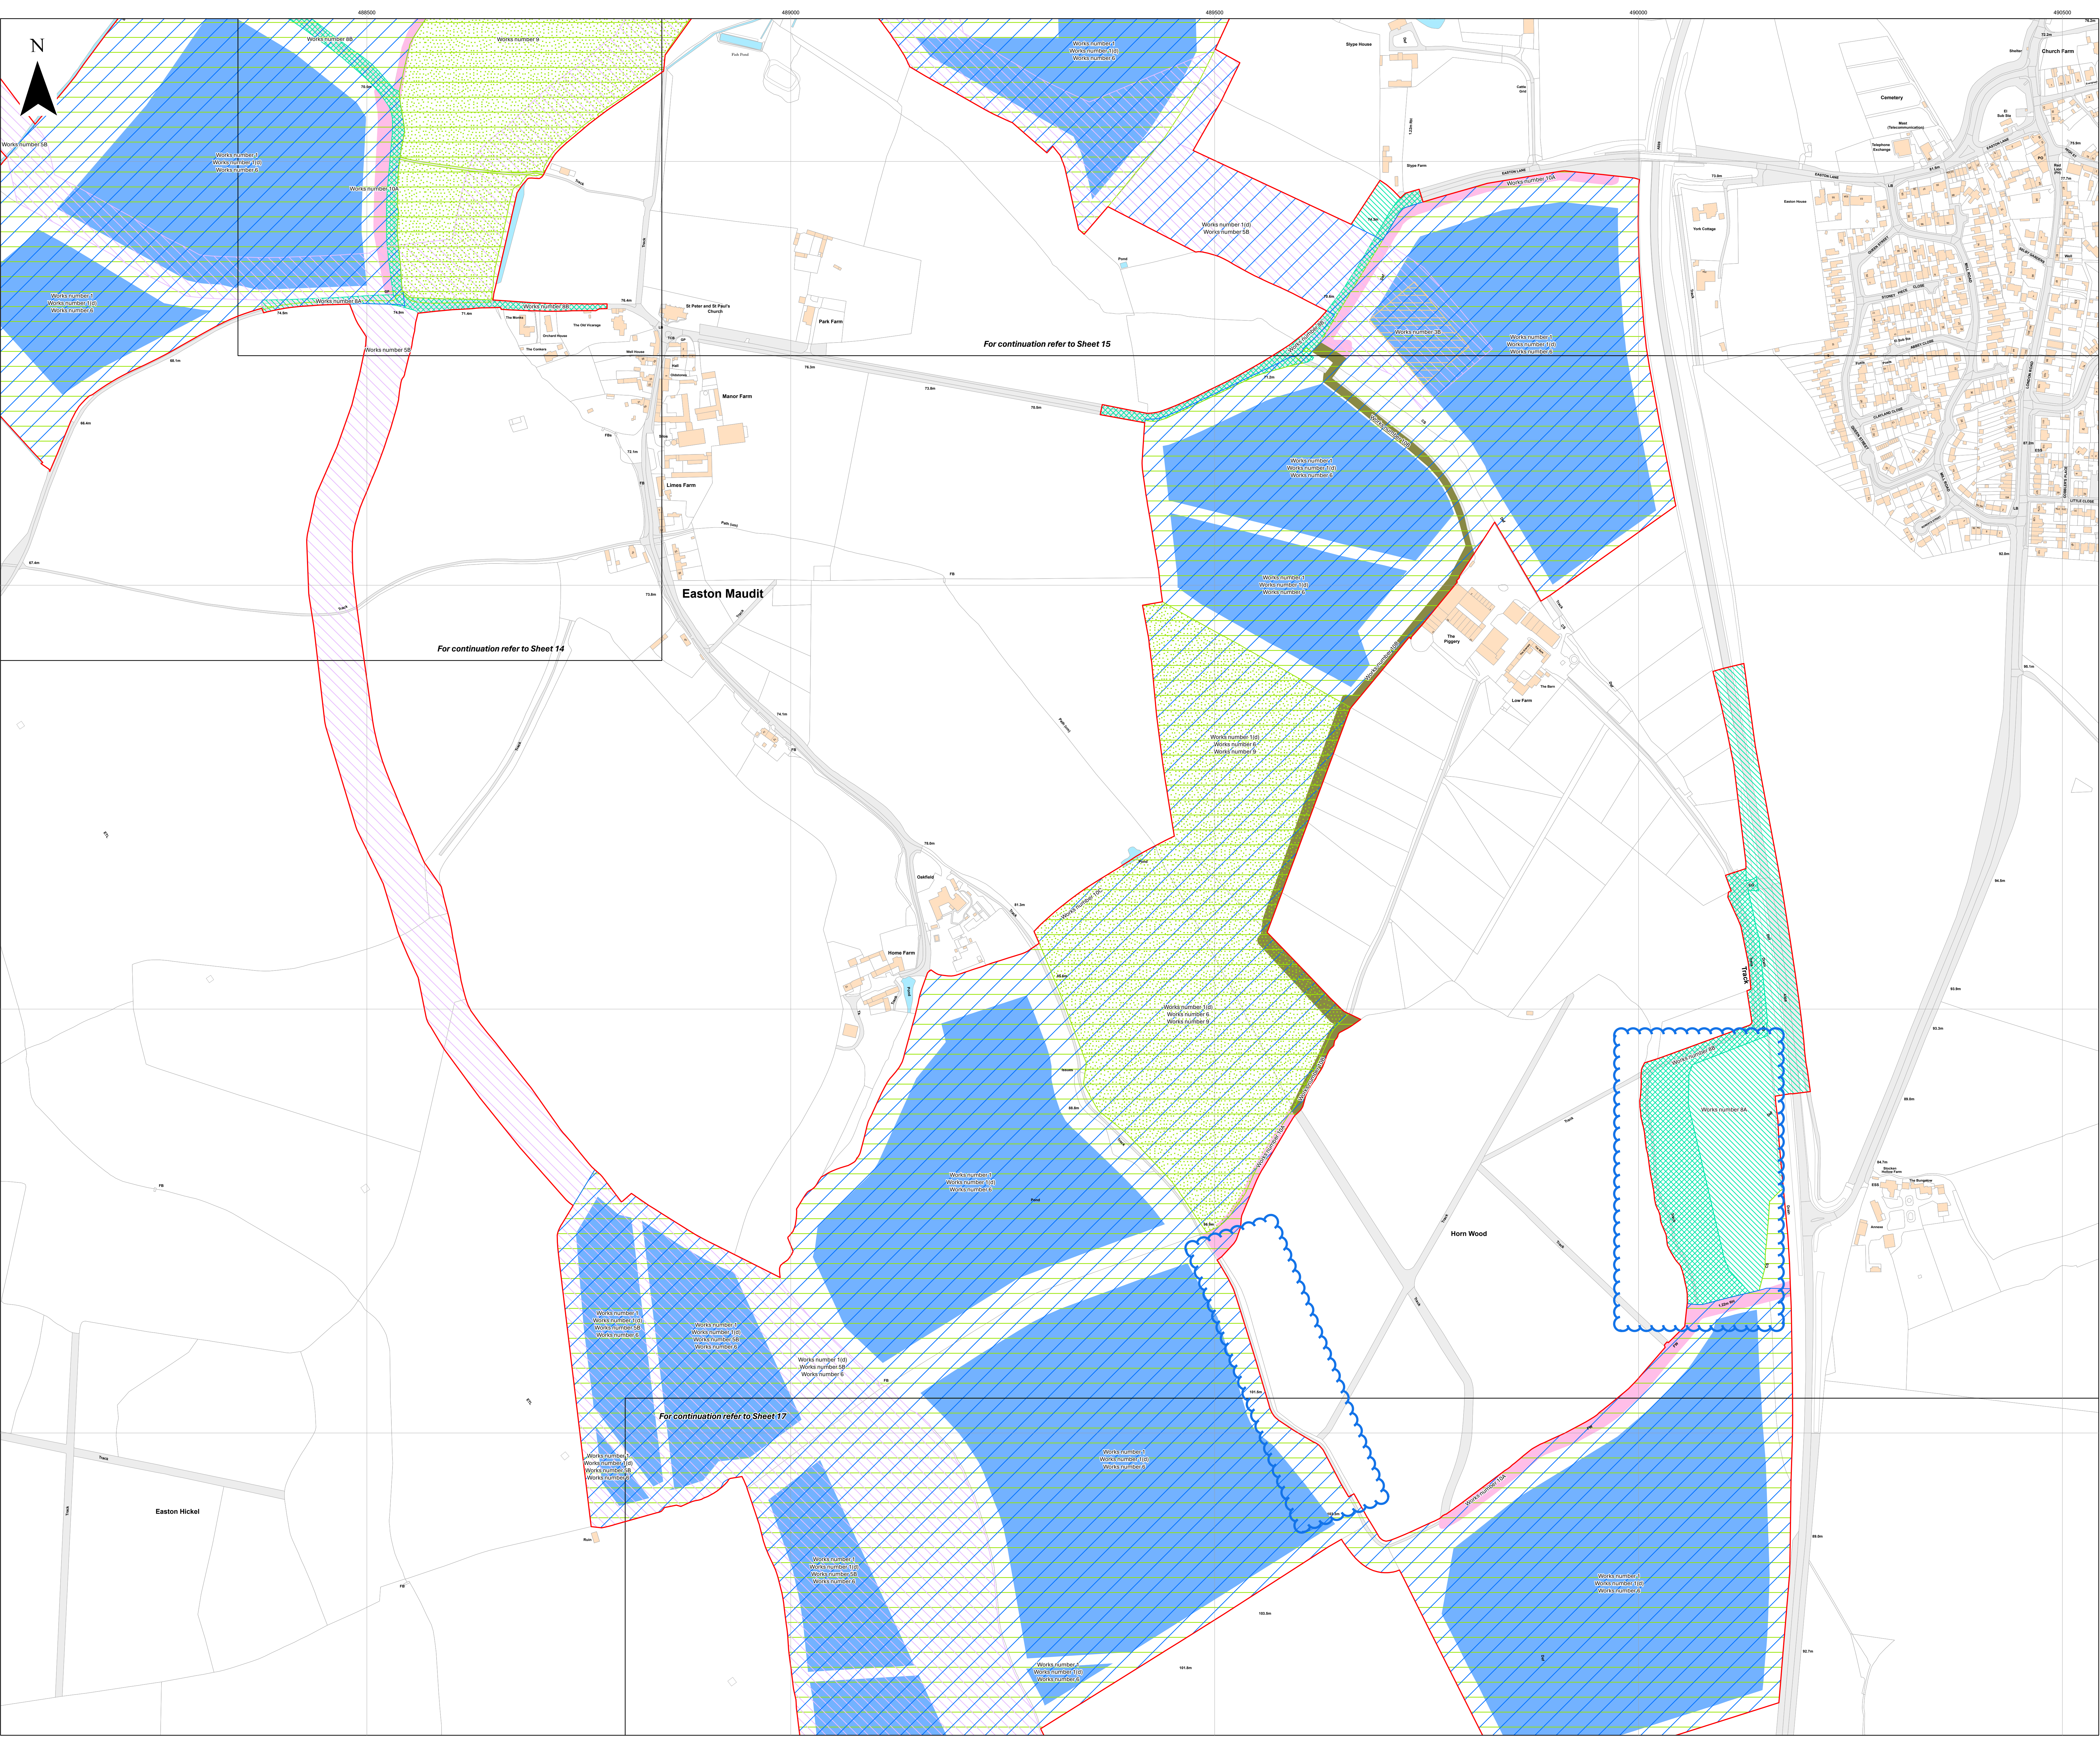



Key

- Order Limits
- Index Sheet
- Works Number**
- 1
- 1(d)
- 3B
- 5B
- 6
- 8A
- 8B
- 9
- 10A
- 10B

Layers: Lanpro, 2025: KIP, 2025
Base map: Reproduced from Ordnance Survey digital map data © Crown copyright 2025. All rights reserved. License number 0100031673

0100031673


0 100 200 300 Meters

Scale: 1:2,500@ A0

APFP Regulation: 5(2)(j)	Application Doc No. EX3/GH2.4_D
Ref: P3535_LPR_ZZ_XX_DR_Z_0274	Date: 15/12/2025
Drawn by: AZ	Checked by: JC

Works Plan
Sheet 16 of 18
Revision D



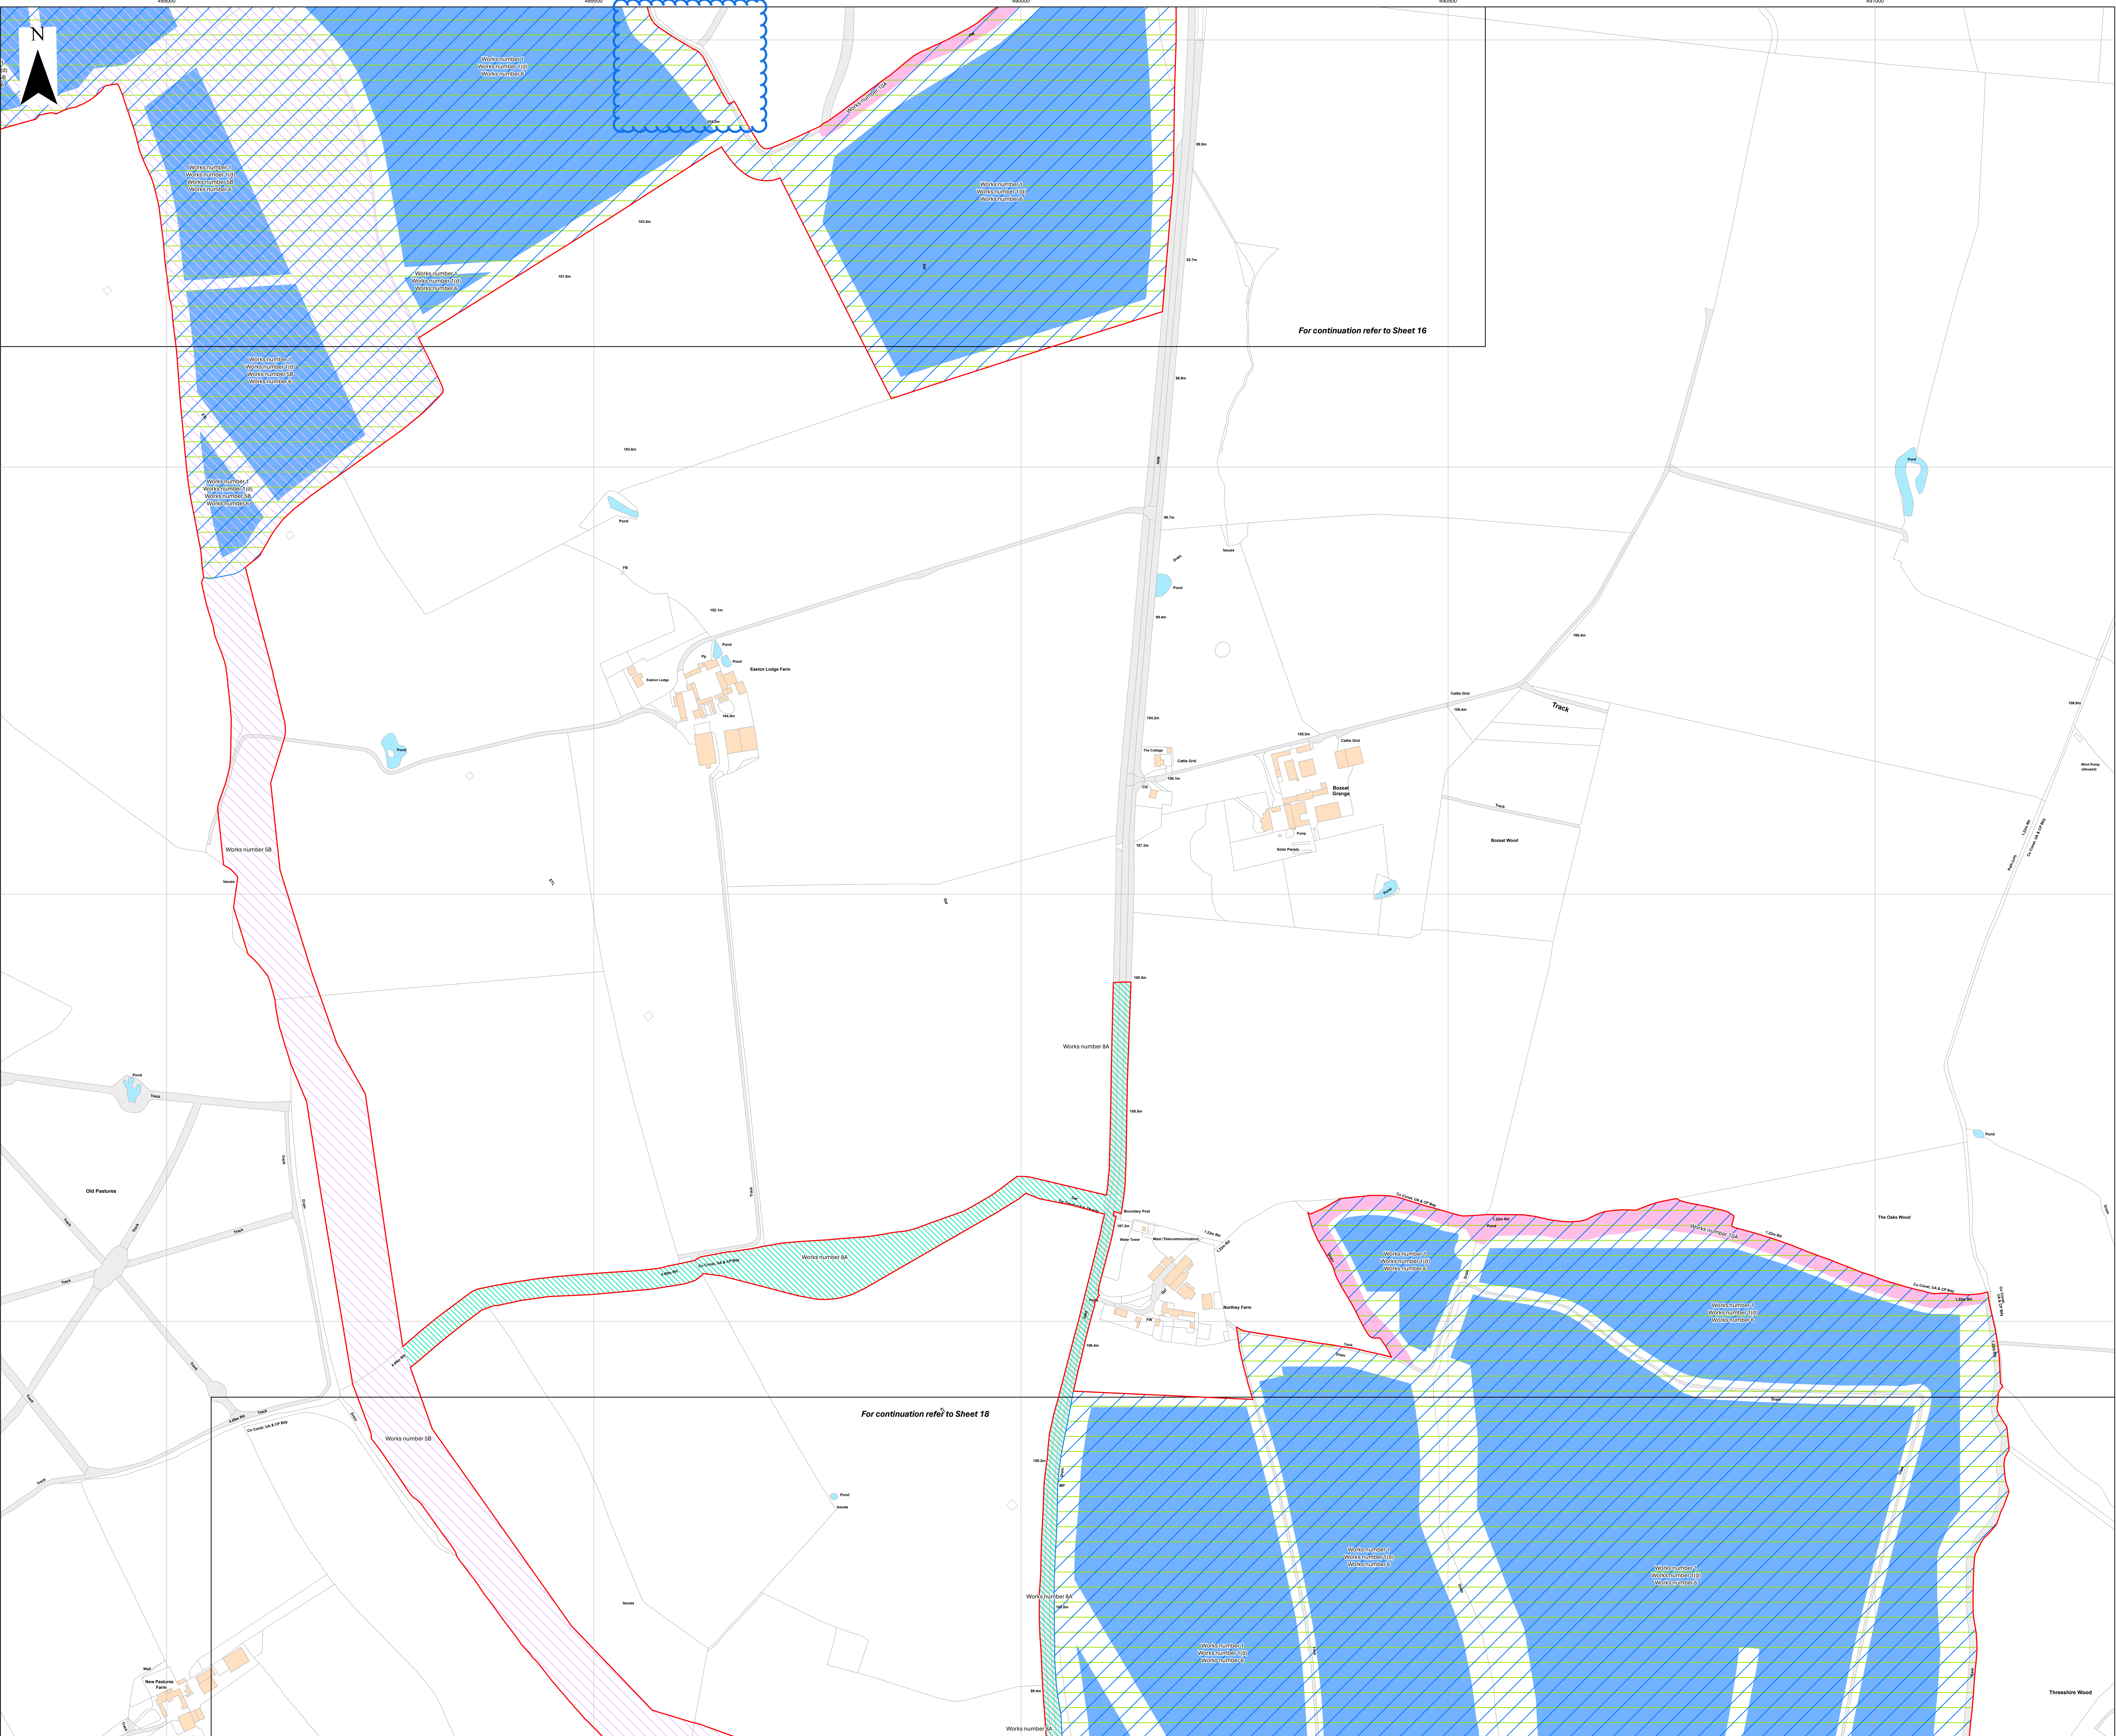



Key

- Order Limits
- Index Sheet
- Works Number**
- 1
- 1(d)
- 5B
- 6
- 8A
- 10A

Layers: Lanpro, 2025, KPR, 2025
Base map: Reproduced from Ordnance Survey digital map data © Crown copyright 2025. All rights reserved. License number 0100031673


0 100 200 300 Meters

Scale: 1:2,500@ A0

APFP Regulation: 5(2)(j)	Application Doc No. EX3/GH2.4_D
Ref: P3535_LPR_ZZ_XX_DR_Z_0274	Date: 15/12/2025
Drawn by: AZ	Checked by: JC

Works Plan
Sheet 17 of 18
Revision D



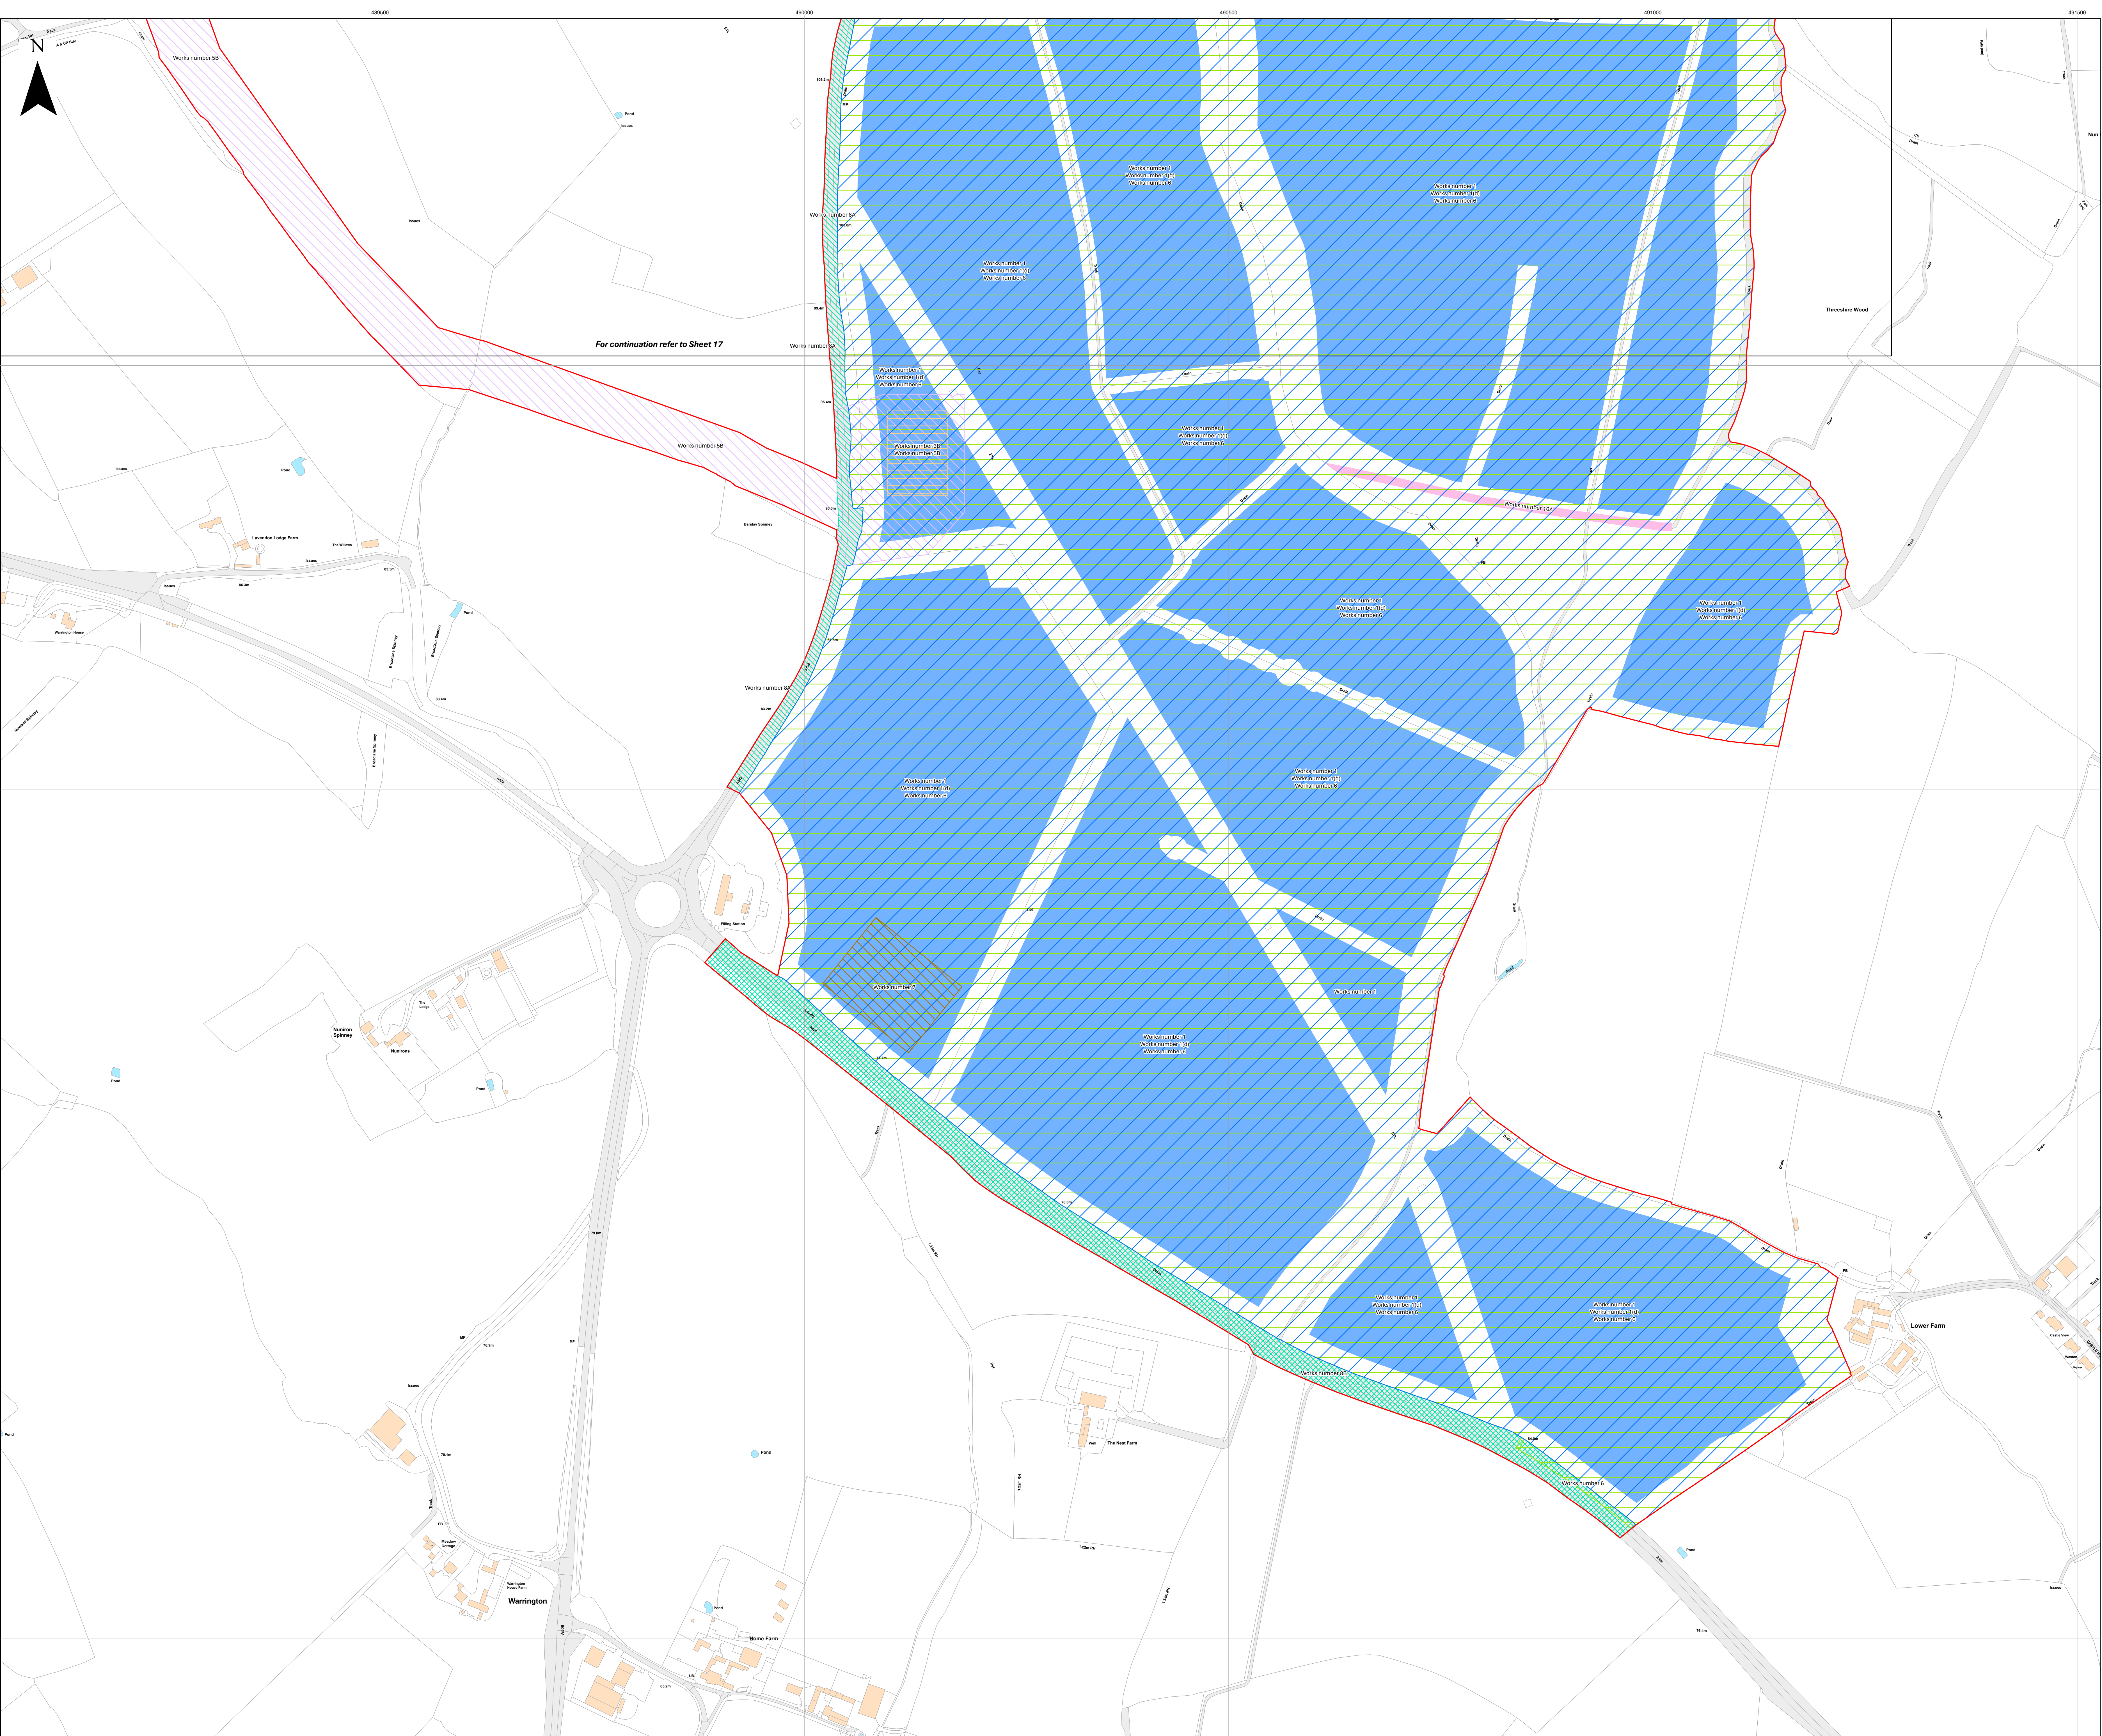



Key

- Order Limits
- Index Sheet
- Works Number**
- 1
- 1(d)
- 3B
- 5B
- 6
- 7
- 8A
- 8B
- 10A

Layers: Lanpro, 2025; KPR, 2025
Base map: Reproduced from Ordnance Survey digital map data © Crown copyright 2025. All rights reserved. License number 0100031673

0100031673

0 100 200 300 Meters

Scale: 1:2,500@ A0

APFP Regulation: 5(2)(j)	Application Doc No. EX3/GH2.4_D
Ref: P3535_LPR_ZZ_XX_DR_Z_0274	Date: 15/12/2025
Drawn by: AZ	Checked by: JC

Works Plan
Sheet 18 of 18
Revision D

