

Green Hill Solar Farm

EN010170

Works Plan

Revision ~~DE~~ (Tracked)

Prepared by: Lanpro

Date: ~~December 2025~~ February 2026


Document Reference: ~~EX3~~ CR2/GH2.4_ ~~DE~~

APFP Regulation 5(2)(i)




Schedule of Changes

Figure Reference	Page	Description of Changes	Reason for Revision
[cover]		Updated document reference to Revision E	As required for submission of Change Application.
All sheets	3-21	Updated document references and annotations	As required for submission of Change Application.
Sheet 1	4	Update to extents of Works Nos. 1, 1(d) and 9	Presentation of Change 4 requested in Change Application and Supporting Environmental Information Report [CR2/GH9.6].
Sheets 13 to 18	16-21	Works No. 5B redesignated to 5A	Presentation of Change 3 requested in Change Application and Supporting Environmental Information Report [CR2/GH9.6].
Sheet 14	17	Works No. 5B(vi) redesignated to 5A(vi)	Presentation of Change 3 requested in Change Application and Supporting Environmental Information Report [CR2/GH9.6].
Sheets 16 and 17	19-20	Update to extents of Works No. 5B	Presentation of Change 3 requested in Change Application and Supporting Environmental Information Report [CR2/GH9.6].
Sheets 17 and 18	20-21	Addition of area for Works No. 3A	Presentation of Change 1 requested in Change Application and Supporting Environmental Information Report [CR2/GH9.6].

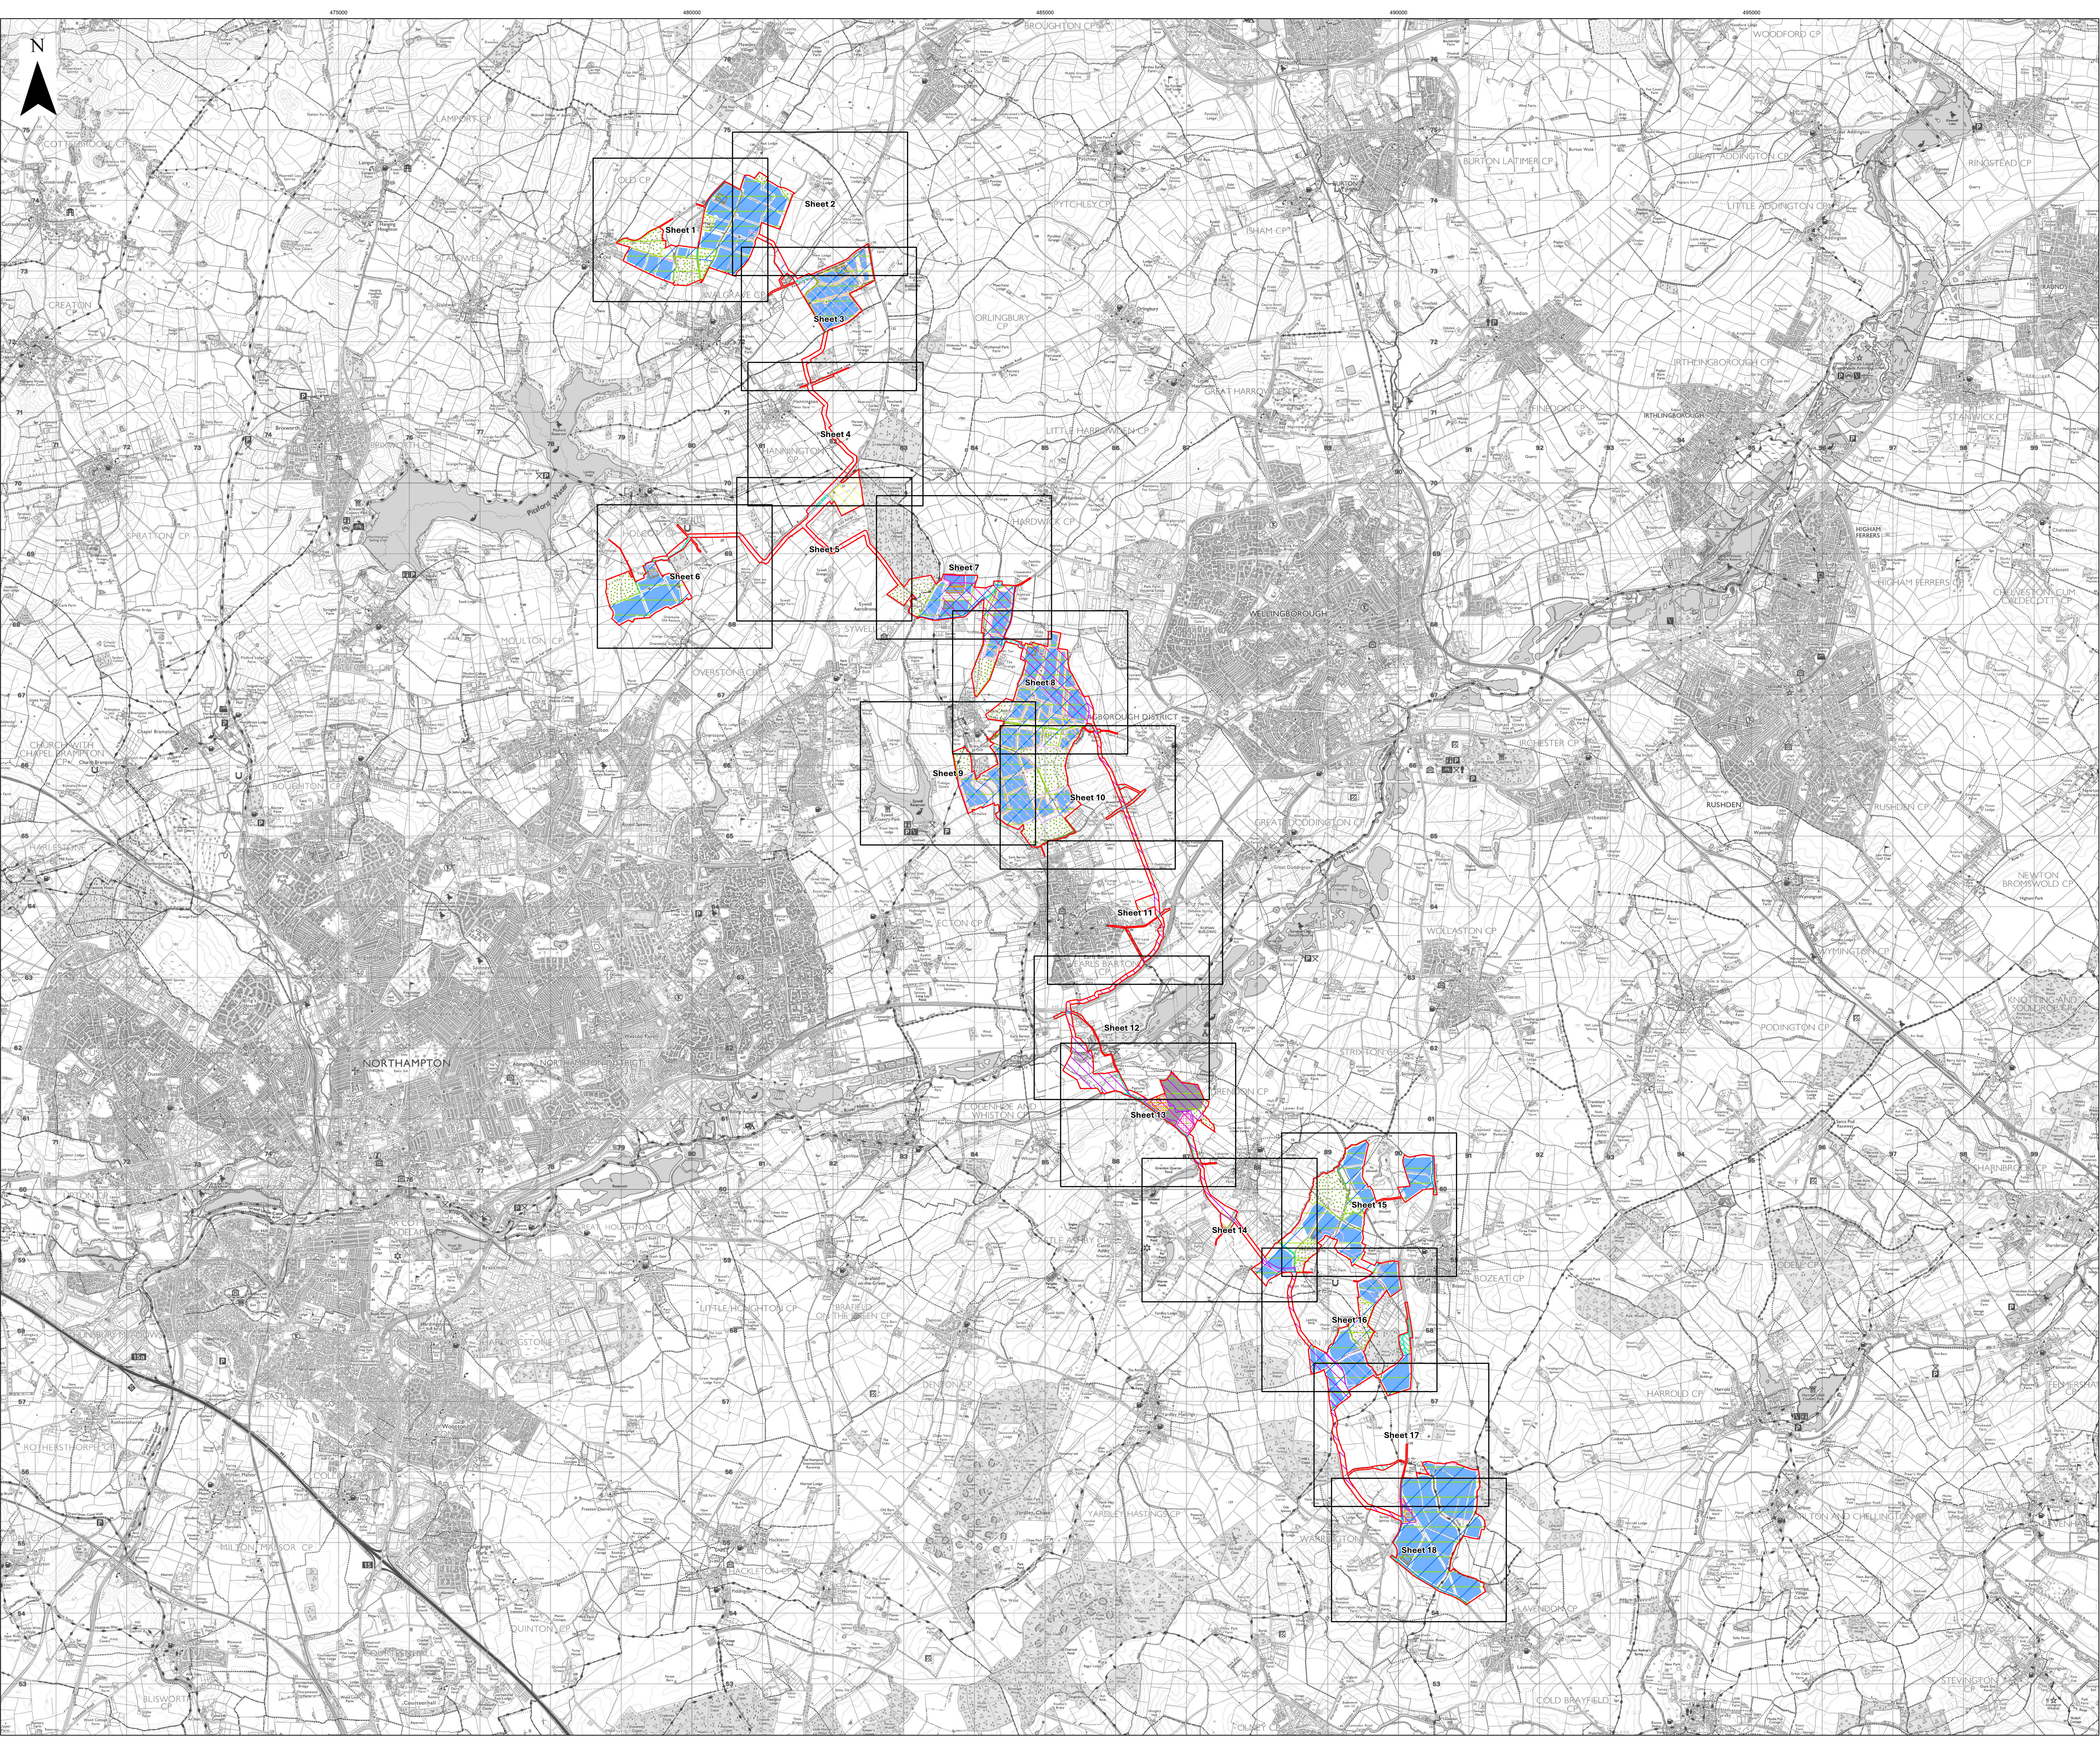

- Key**
- Order Limits
 - Index Sheet
 - Works Number
 - 1
 - 1(d)
 - 2
 - 3A
 - 3B
 - 3C
 - 4
 - 5
 - 5A
 - 5A(v)
 - 5B
 - 5B(v)
 - 6
 - 7
 - 8A
 - 8B
 - 9
 - 10A
 - 10B


Layers: Lanpro, 2025: GP, 2025
Base map: Reproduced from Ordnance Survey digital map data © Crown copyright 2025. All rights reserved. License number 0100031673

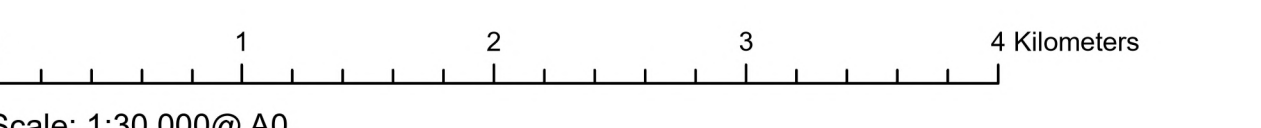

APFP Regulation: 5(2)(j)	Application Doc No. CR2/GH2.4_E
Ref: P3535_LPR_ZZ_XX_DR_Z_0274	Date: 16/02/2026
Drawn by: BH	Checked by: JC

Works Plan (Change Application Version)
Index Sheet
Revision E



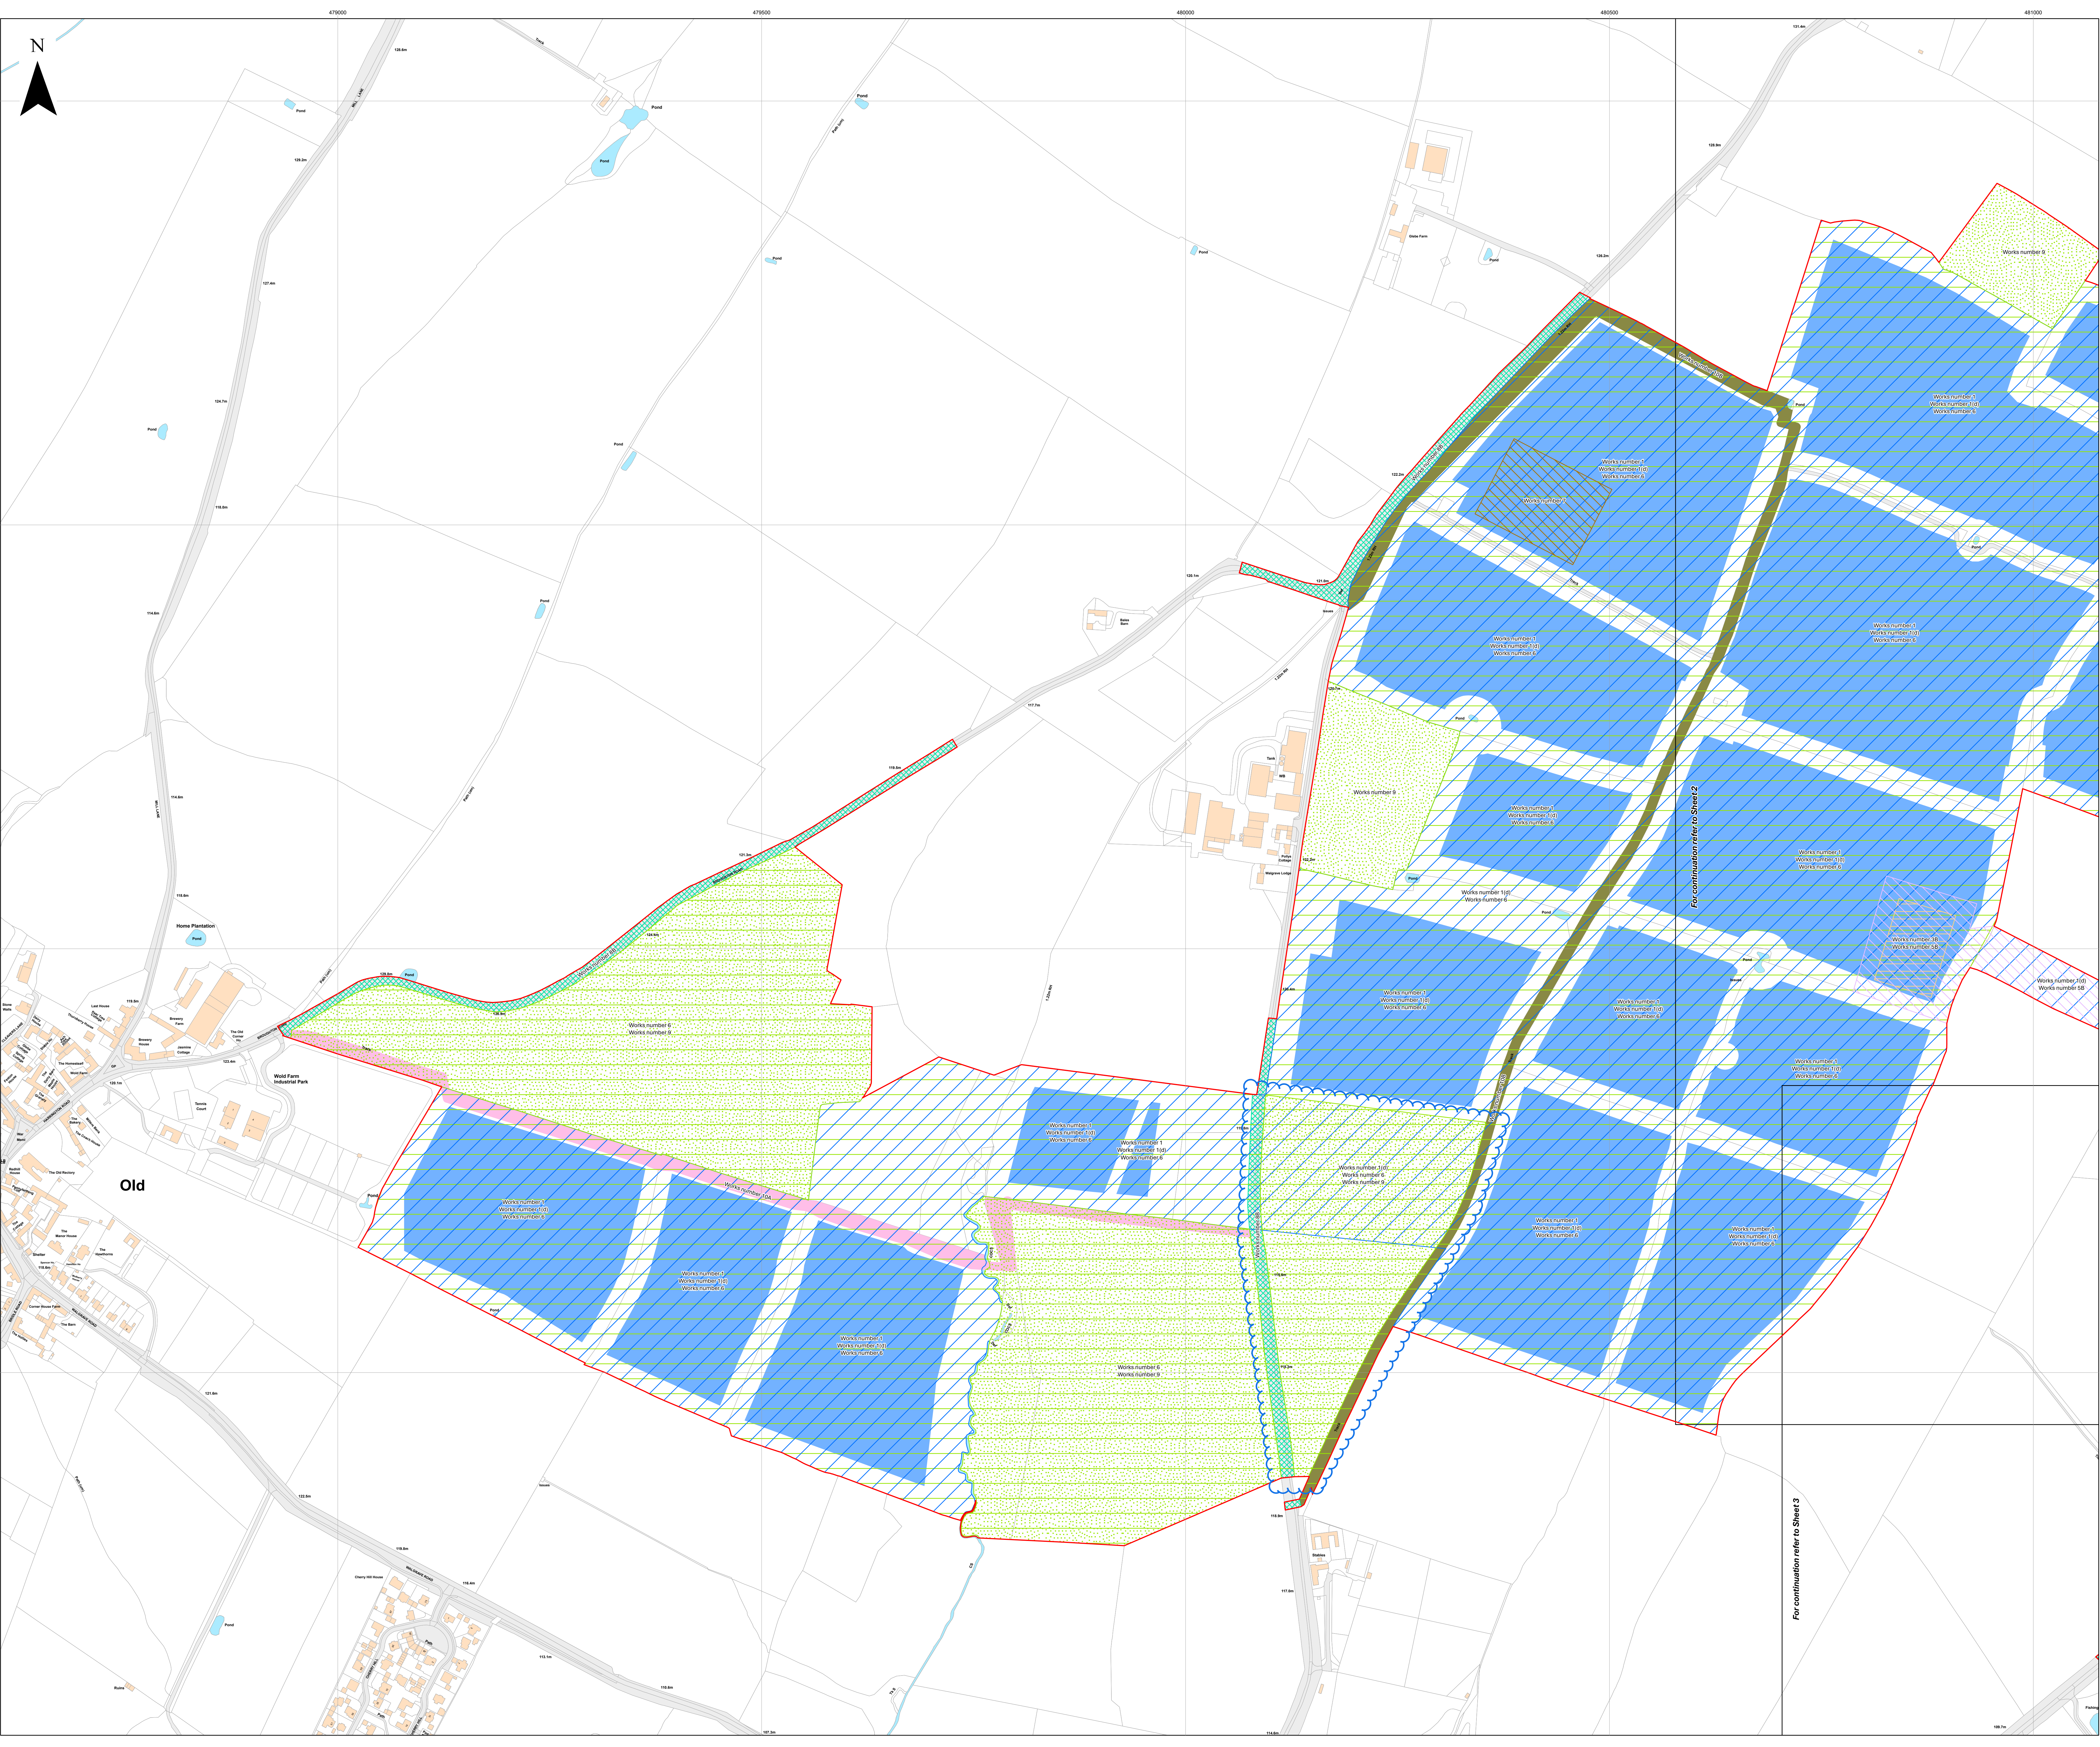



Key

- Order Limits
- Index Sheet
- Works Number**
- 1
- 1(d)
- 3B
- 5B
- 6
- 7
- 8A
- 8B
- 9
- 10A
- 10B

Layers: Lanpro, 2025; KIP, 2025
Base map: Reproduced from Ordnance Survey digital map data © Crown copyright 2025. All rights reserved. License number 0100031673

0100031673


0 100 200 300 Meters

Scale: 1:2,500@ A0

APFP Regulation: 5(2)(j)	Application Doc No. CR2/GH2.4_E
Ref: P3535_LPR_ZZ_XX_DR_Z_0274	Date: 16/02/2026
Drawn by: BH	Checked by: JC

Works Plan (Change Application Version)
Sheet 1 of 16
Revision E



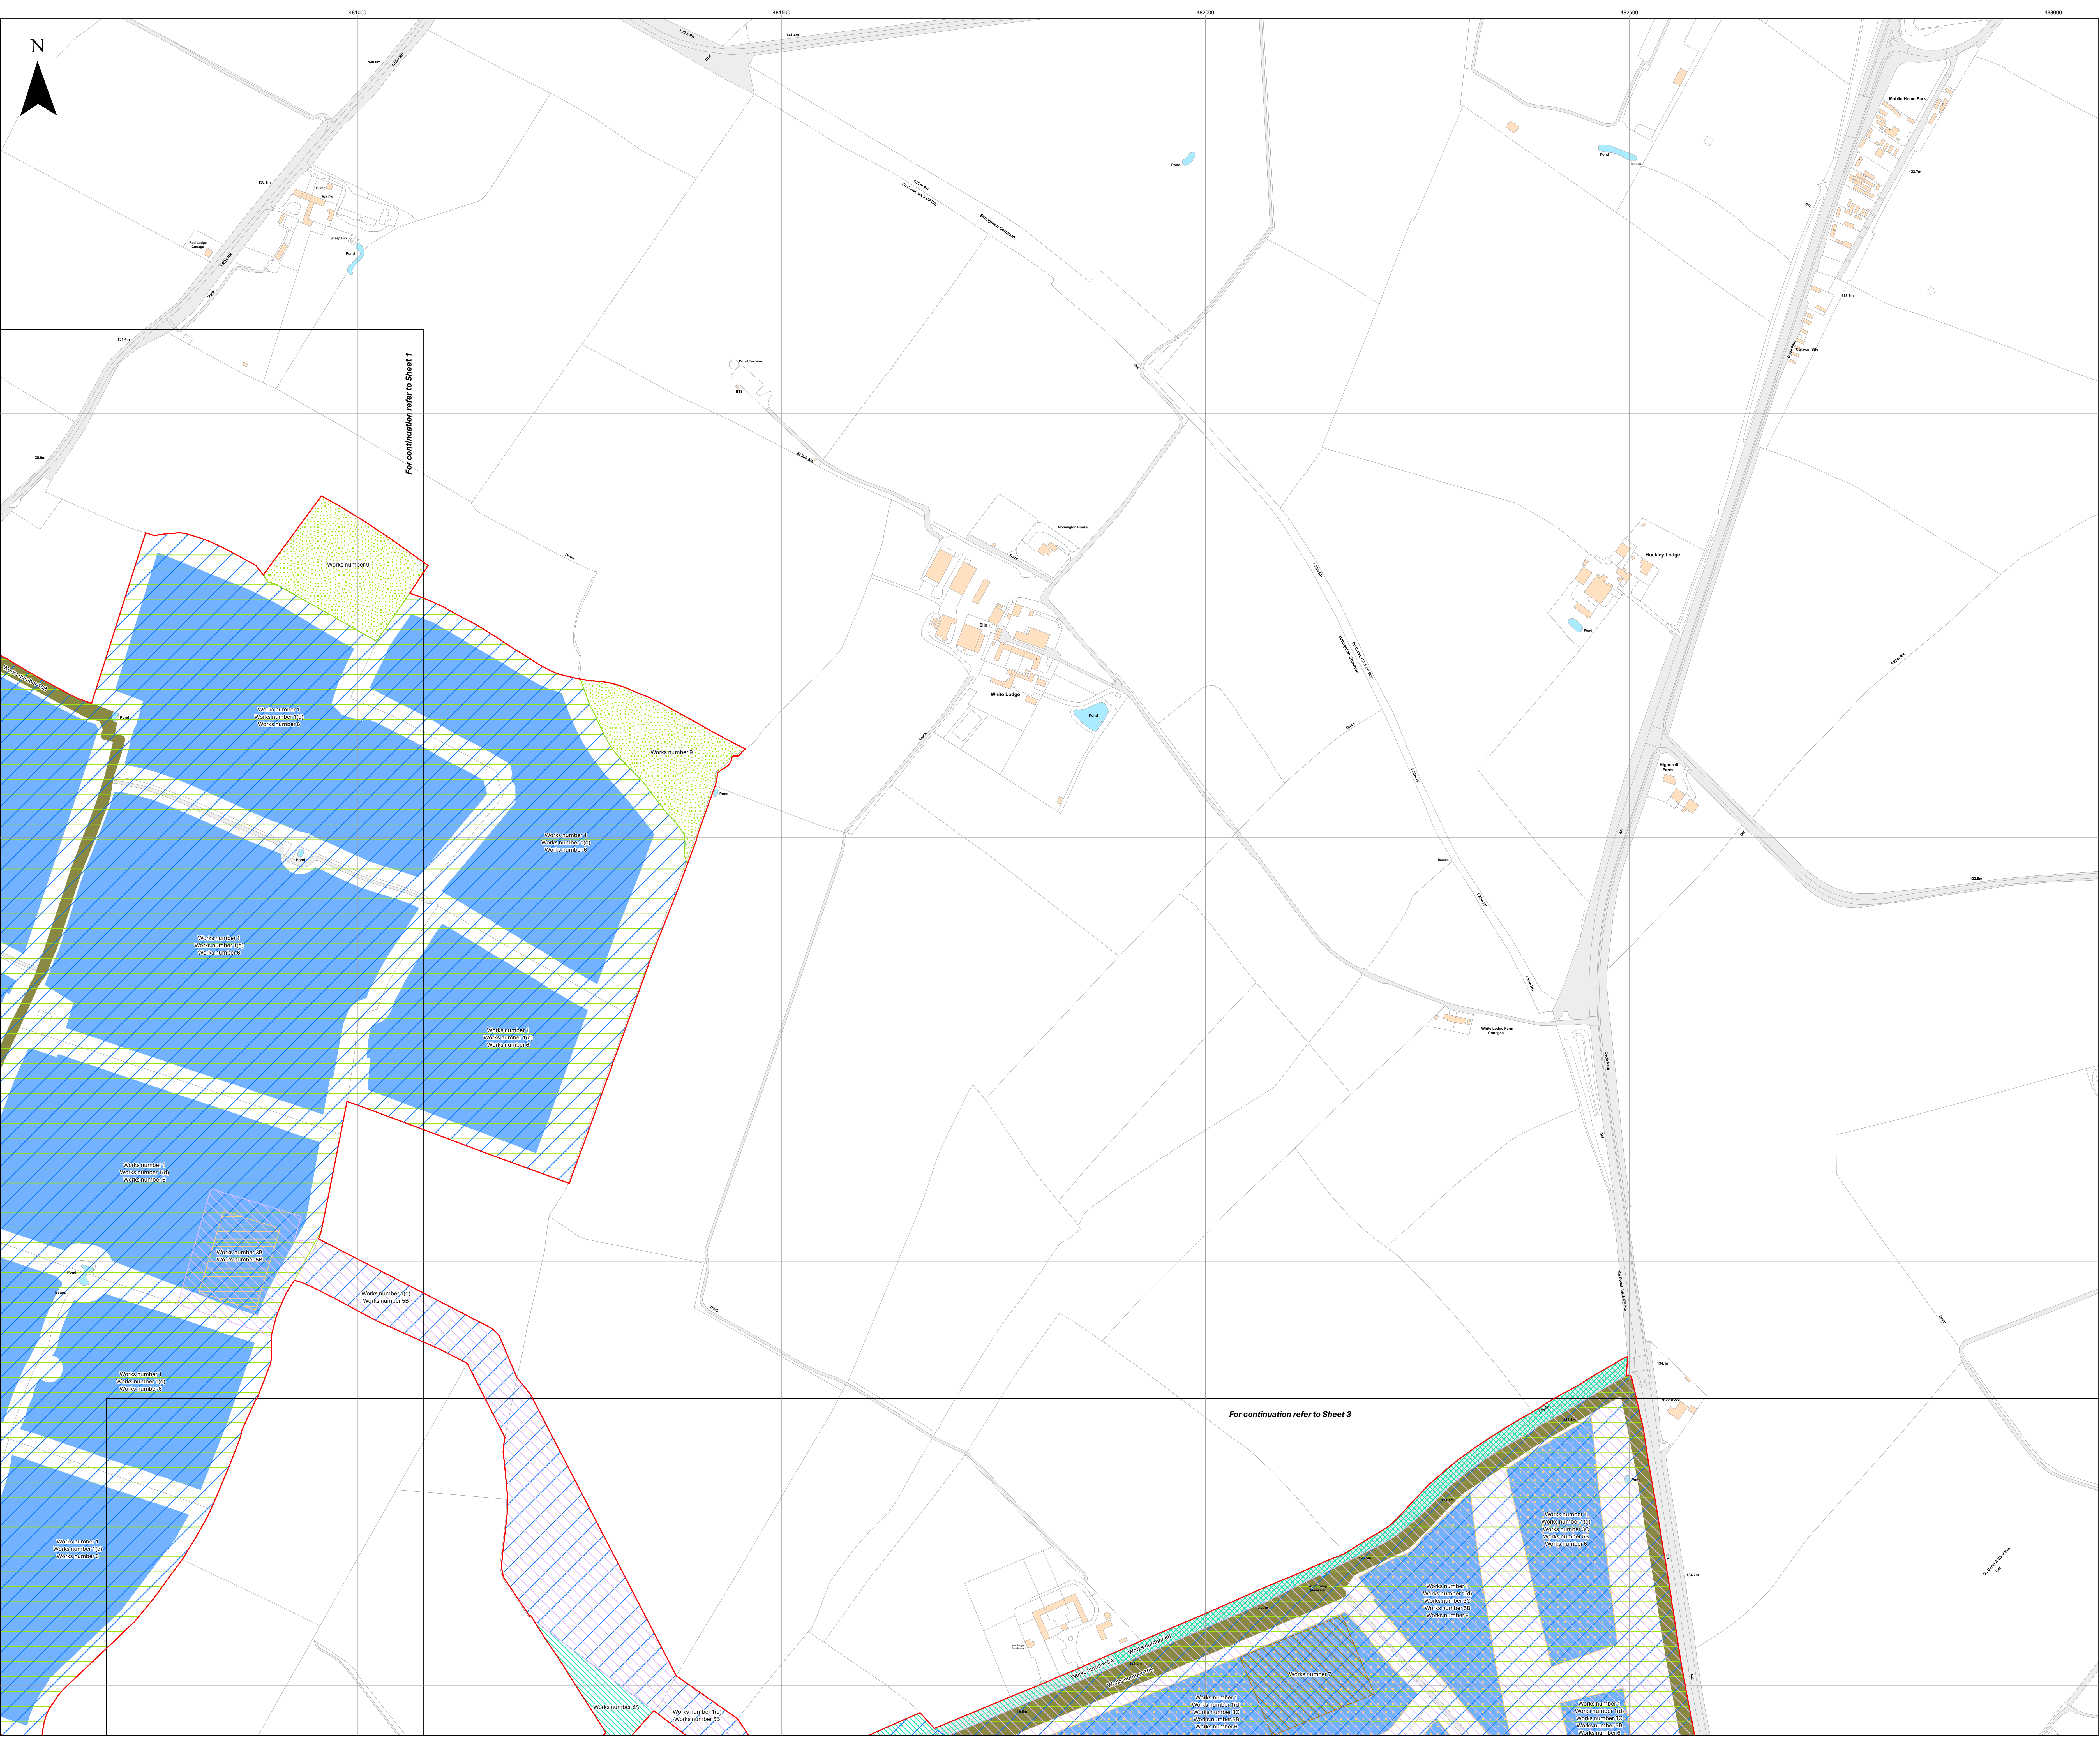



Key

- Order Limits
- Index Sheet
- Works Number**
- 1
- 1(d)
- 3B
- 3C
- 5B
- 6
- 7
- 8A
- 8B
- 9
- 10B

Layers: Lanpro, 2025; KIP, 2025
Base map: Reproduced from Ordnance Survey digital map data © Crown copyright 2025. All rights reserved. License number 0100031673


0 100 200 300 Meters

Scale: 1:2,500@ A0

APFP Regulation: 5(2)(j)	Application Doc No. CR2/GH2.4_E
Ref: P3535_LPR_ZZ_XX_DR_Z_0274	Date: 16/02/2026
Drawn by: BH	Checked by: JC

Works Plan (Change Application Version)
Sheet 2 of 16
Revision E



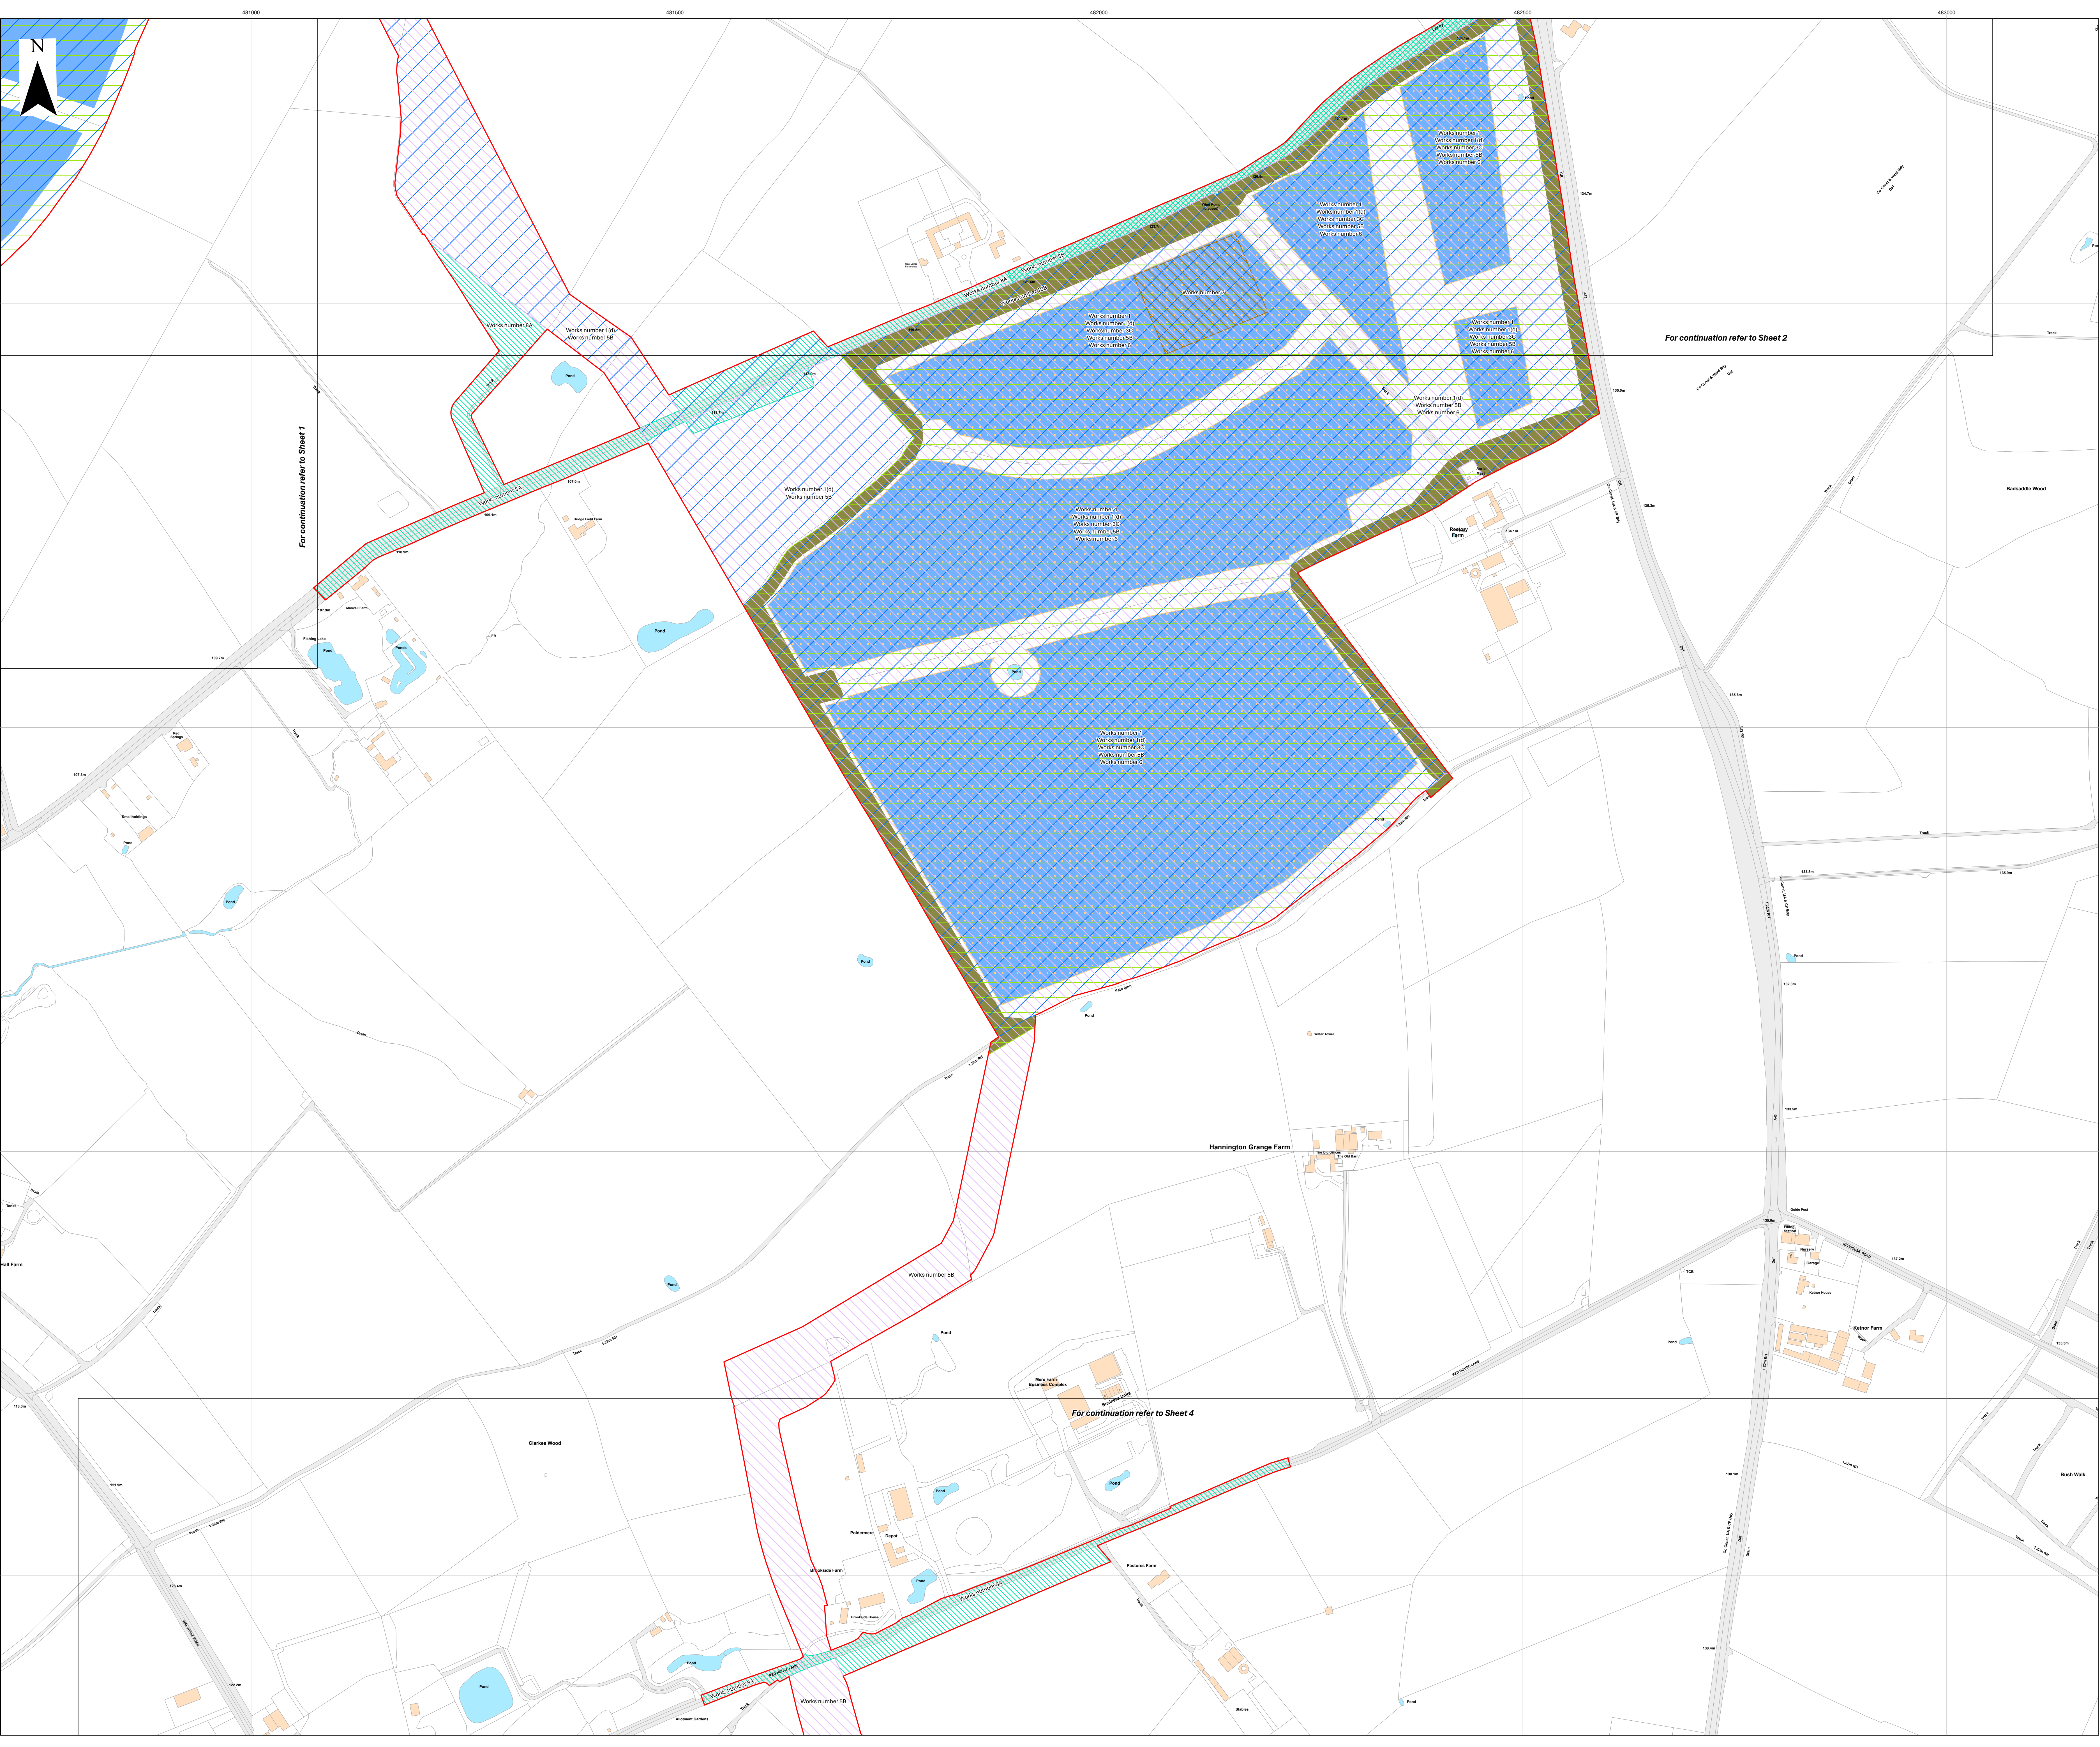



Key

- Order Limits
- Index Sheet
- Works Number**
- 1
- 1(d)
- 3C
- 5B
- 6
- 7
- 8A
- 8B
- 10B

Layers: Lanpro, 2025: KIP, 2025
Base map: Reproduced from Ordnance Survey digital map data © Crown copyright 2025. All rights reserved. License number 0100031673

0100031673

0 100 200 300 Meters

Scale: 1:2,500@ A0


APFP Regulation: 5(2)(j)	Application Doc No. CR2/GH2.4_E
Ref: P3535_LPR_ZZ_XX_DR_Z_0274	Date: 16/02/2026
Drawn by: BH	Checked by: JC

Works Plan (Change Application Version)

Sheet 3 of 16

Revision E



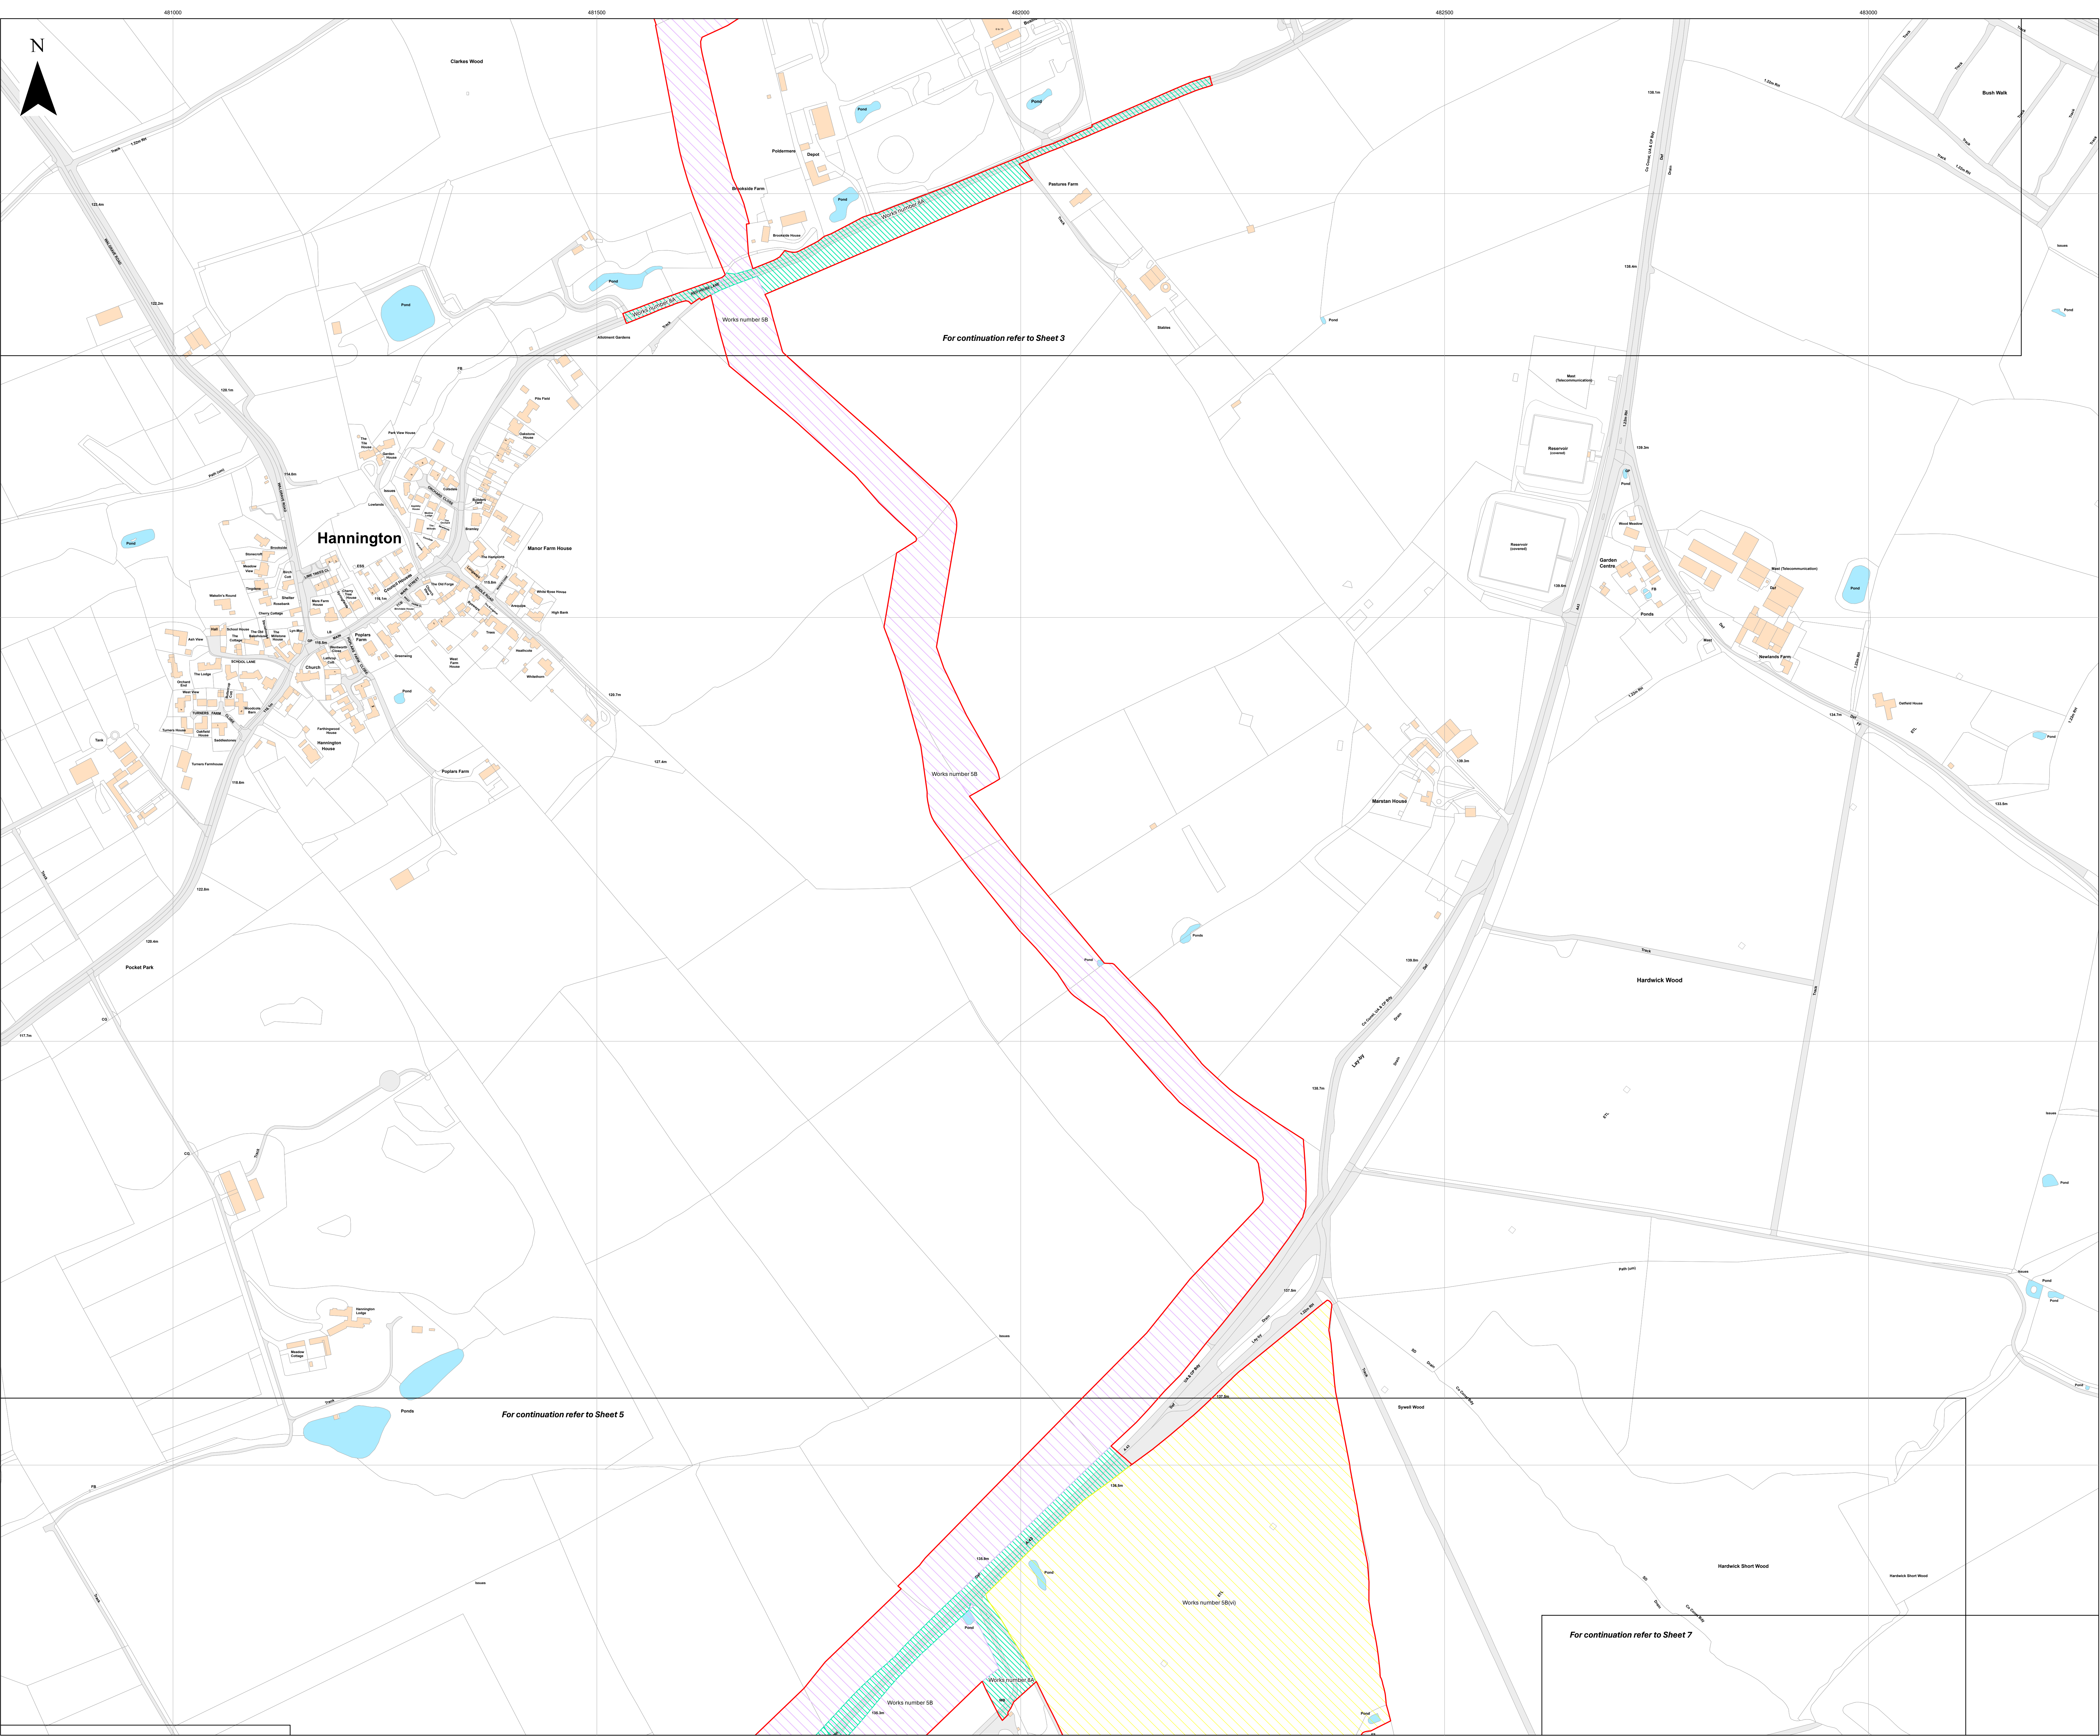



Key

- Order Limits
- Index Sheet
- Works Number
- 5B
- 5B(vi)
- 5A

Layers: Lanpro, 2025; KIP, 2025
Base map: Reproduced from Ordnance Survey digital map data © Crown copyright 2025. All rights reserved. License number 0100031673



0 100 200 300 Meters

Scale: 1:2,500@A0

APFP Regulation: 5(2)(j)	Application Doc No. CR2/GH2.4_E
Ref: P3535_LPR_ZZ_XX_DR_Z_0274	Date: 16/02/2026
Drawn by: BH	Checked by: JC

Works Plan (Change Application Version)
Sheet 4 of 16
Revision E



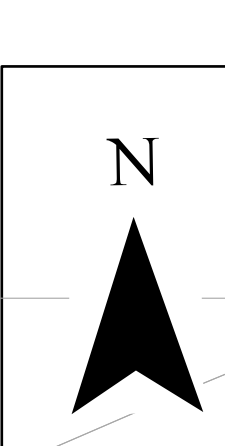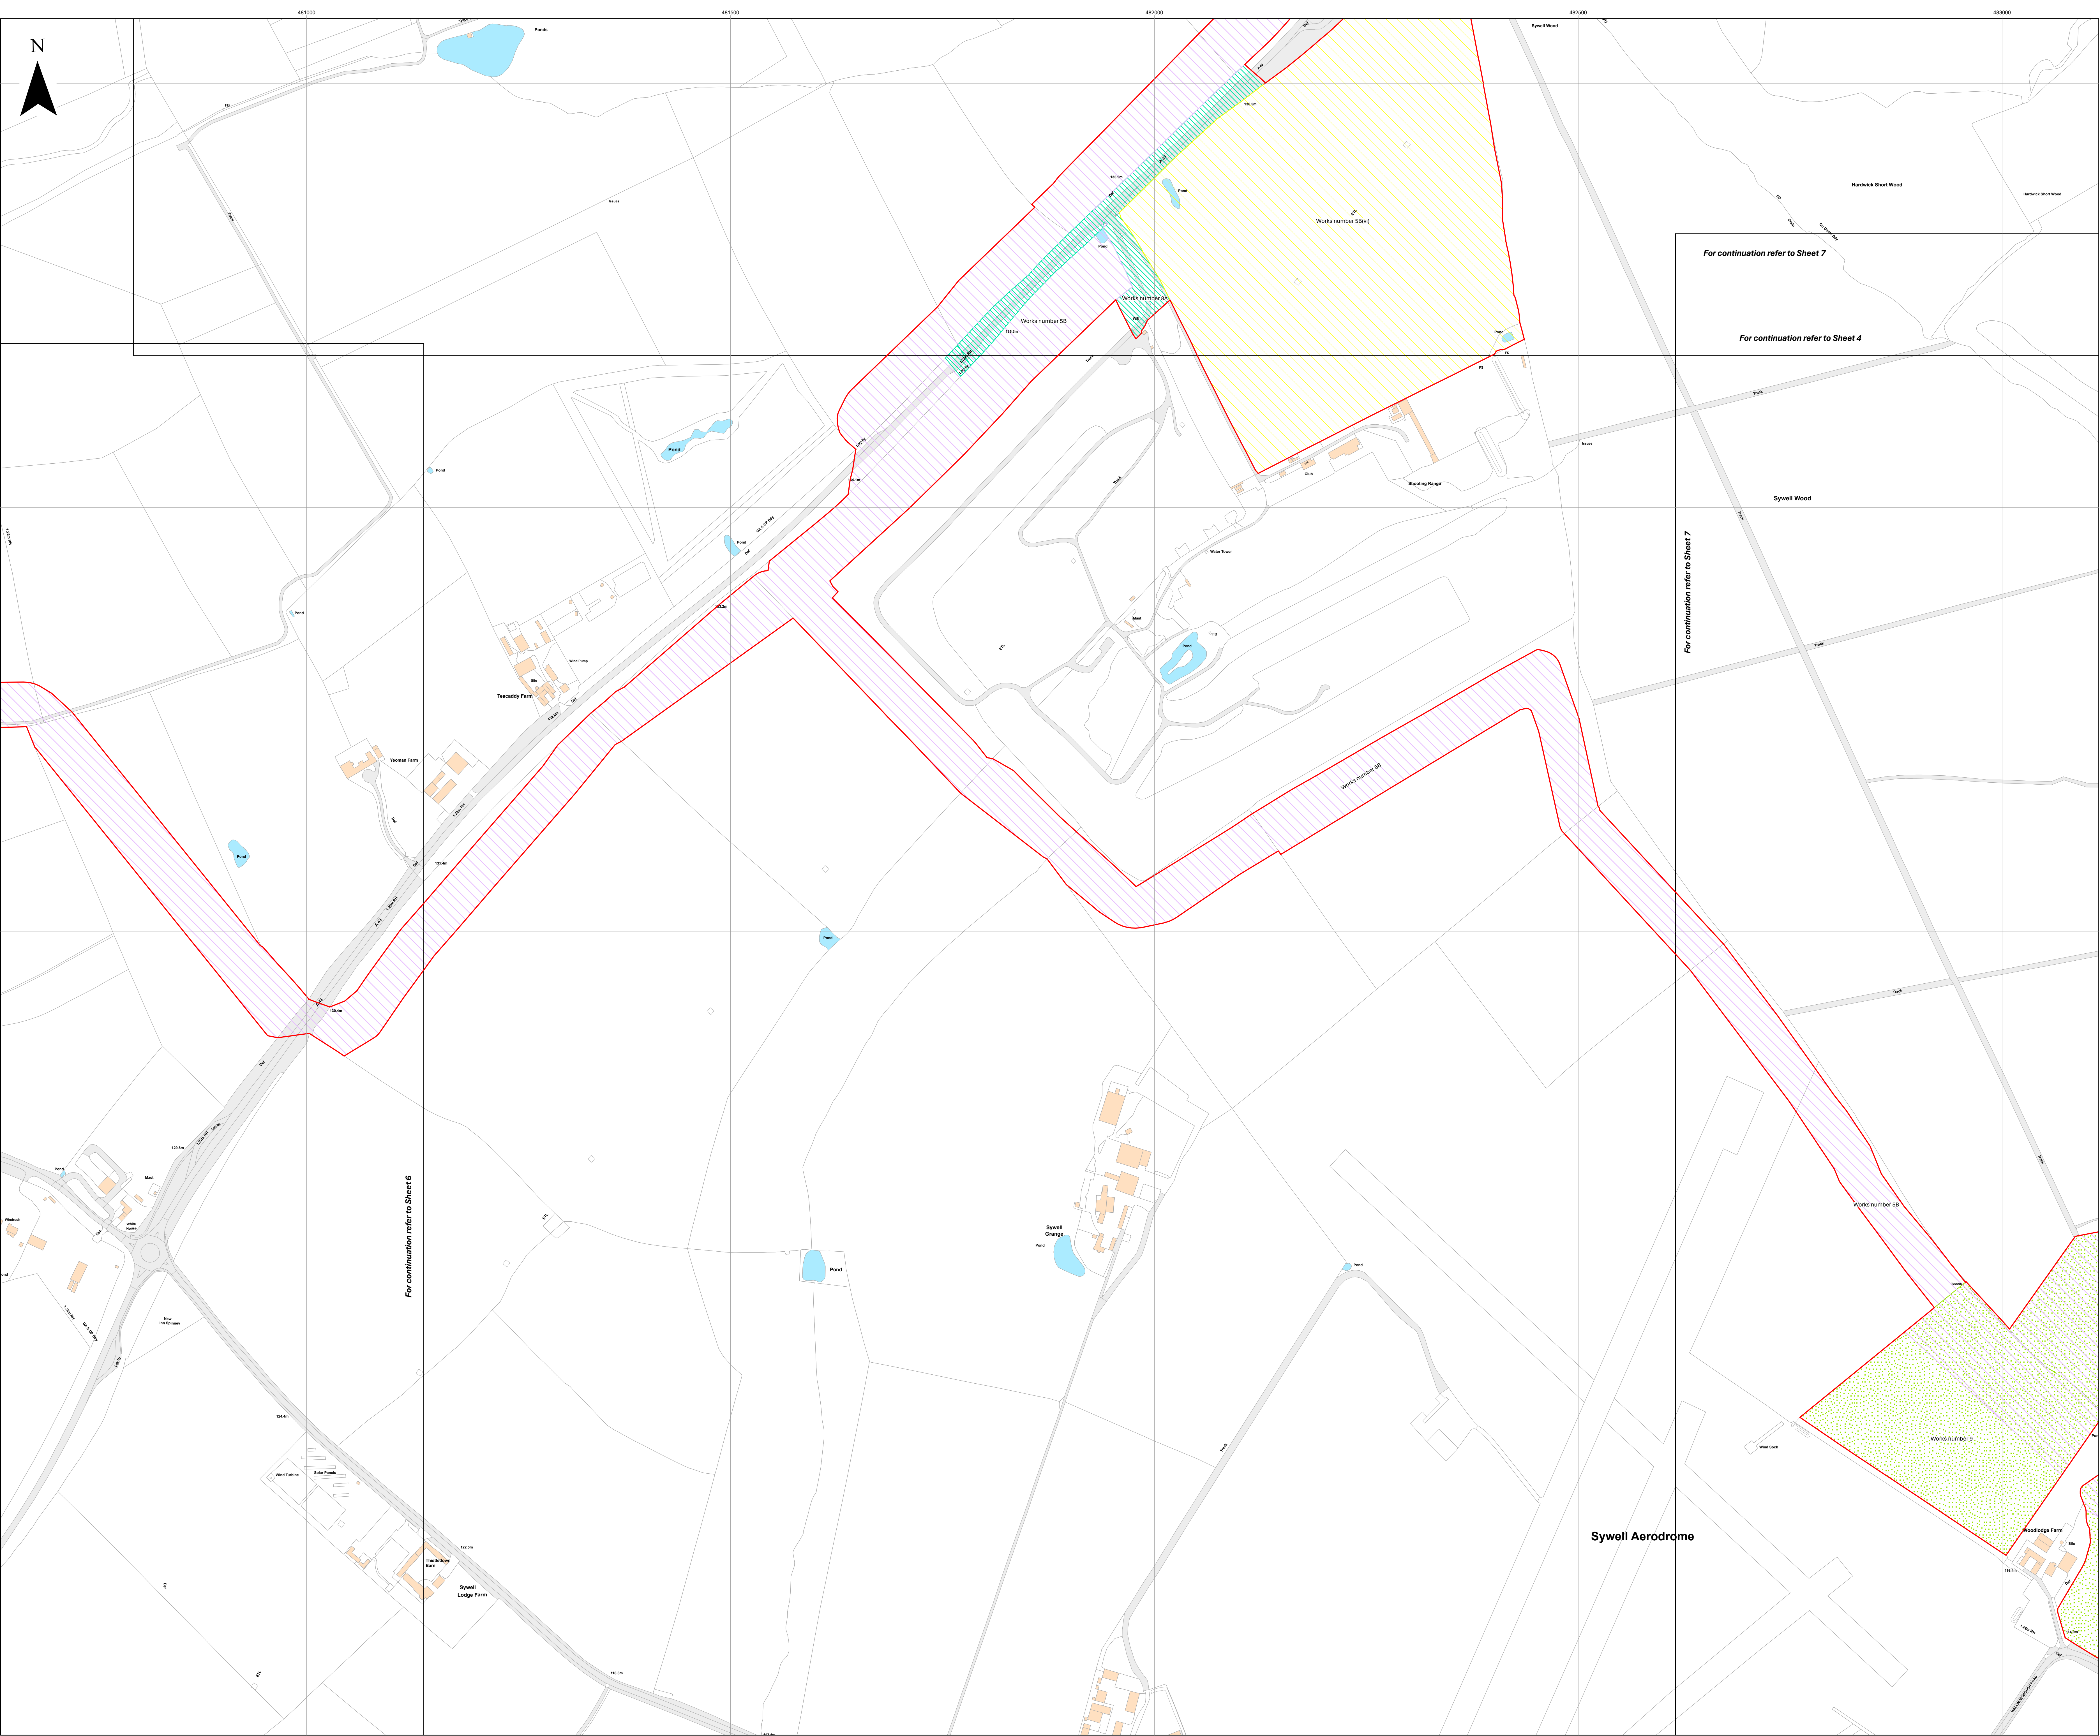



Key

- Order Limits
- Index Sheet
- Works Number
 - SB
 - SB(vi)
 - 8A
 - 9

Layers: Lanpro, 2025; KIP, 2025
Base map: Reproduced from Ordnance Survey digital map data © Crown copyright 2025. All rights reserved. License number 0100031673


0 100 200 300 Meters

Scale: 1:2,500@ A0

APFP Regulation: 5(2)(j)	Application Doc No. CR2/GH2.4_E
Ref: P3535_LPR_ZZ_XX_DR_Z_0274	Date: 16/02/2026
Drawn by: BH	Checked by: JC

Works Plan (Change Application Version)
Sheet 5 of 16
Revision E



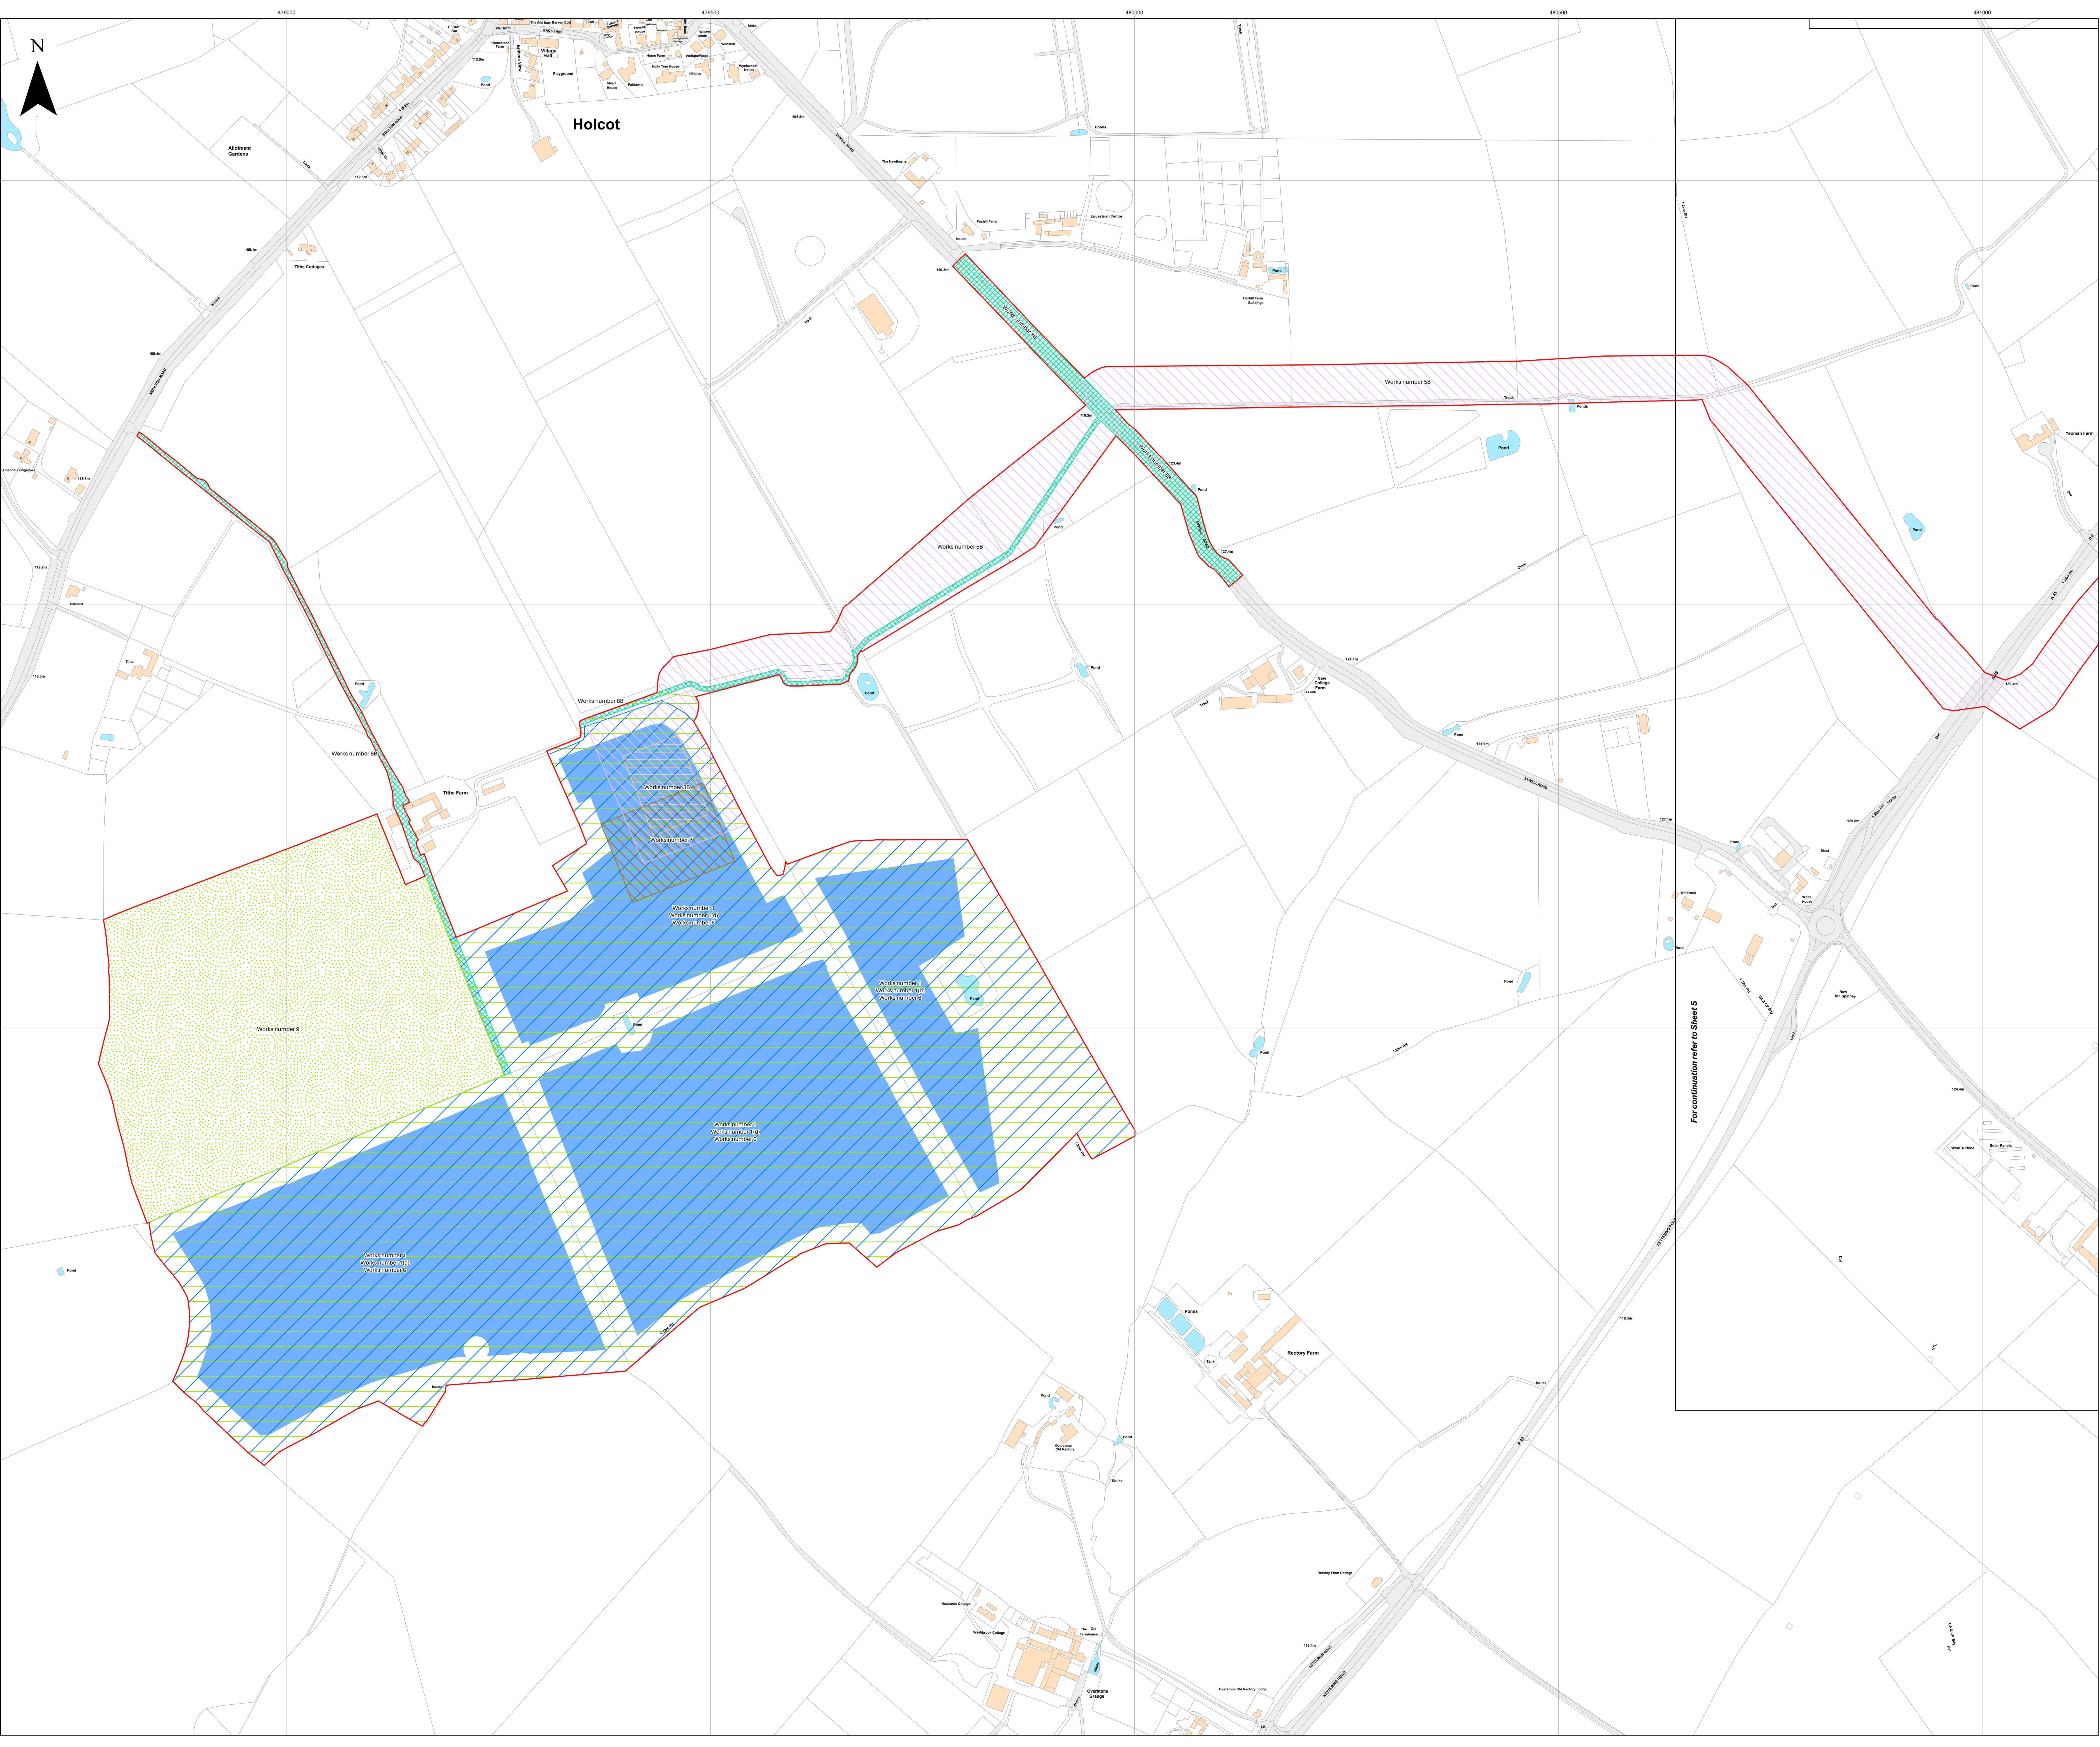



Key

- Order Limits
- Index Sheet
- Works Number**
- 1
- 1(d)
- 3B
- 5B
- 6
- 7
- 8B
- 9

Layers: Lanpro, 2025: KIP, 2025
Base map: Reproduced from Ordnance Survey digital map data © Crown copyright 2025. All rights reserved. License number 0100031673


0 100 200 300 Meters

Scale: 1:2,500@ A0

APFP Regulation: 5(2)(j)	Application Doc No. CR2/GH2.4_E
Ref: P3535_LPR_ZZ_XX_DR_Z_0274	Date: 16/02/2026
Drawn by: BH	Checked by: JC

Works Plan (Change Application Version)
Sheet 6 of 16
Revision E



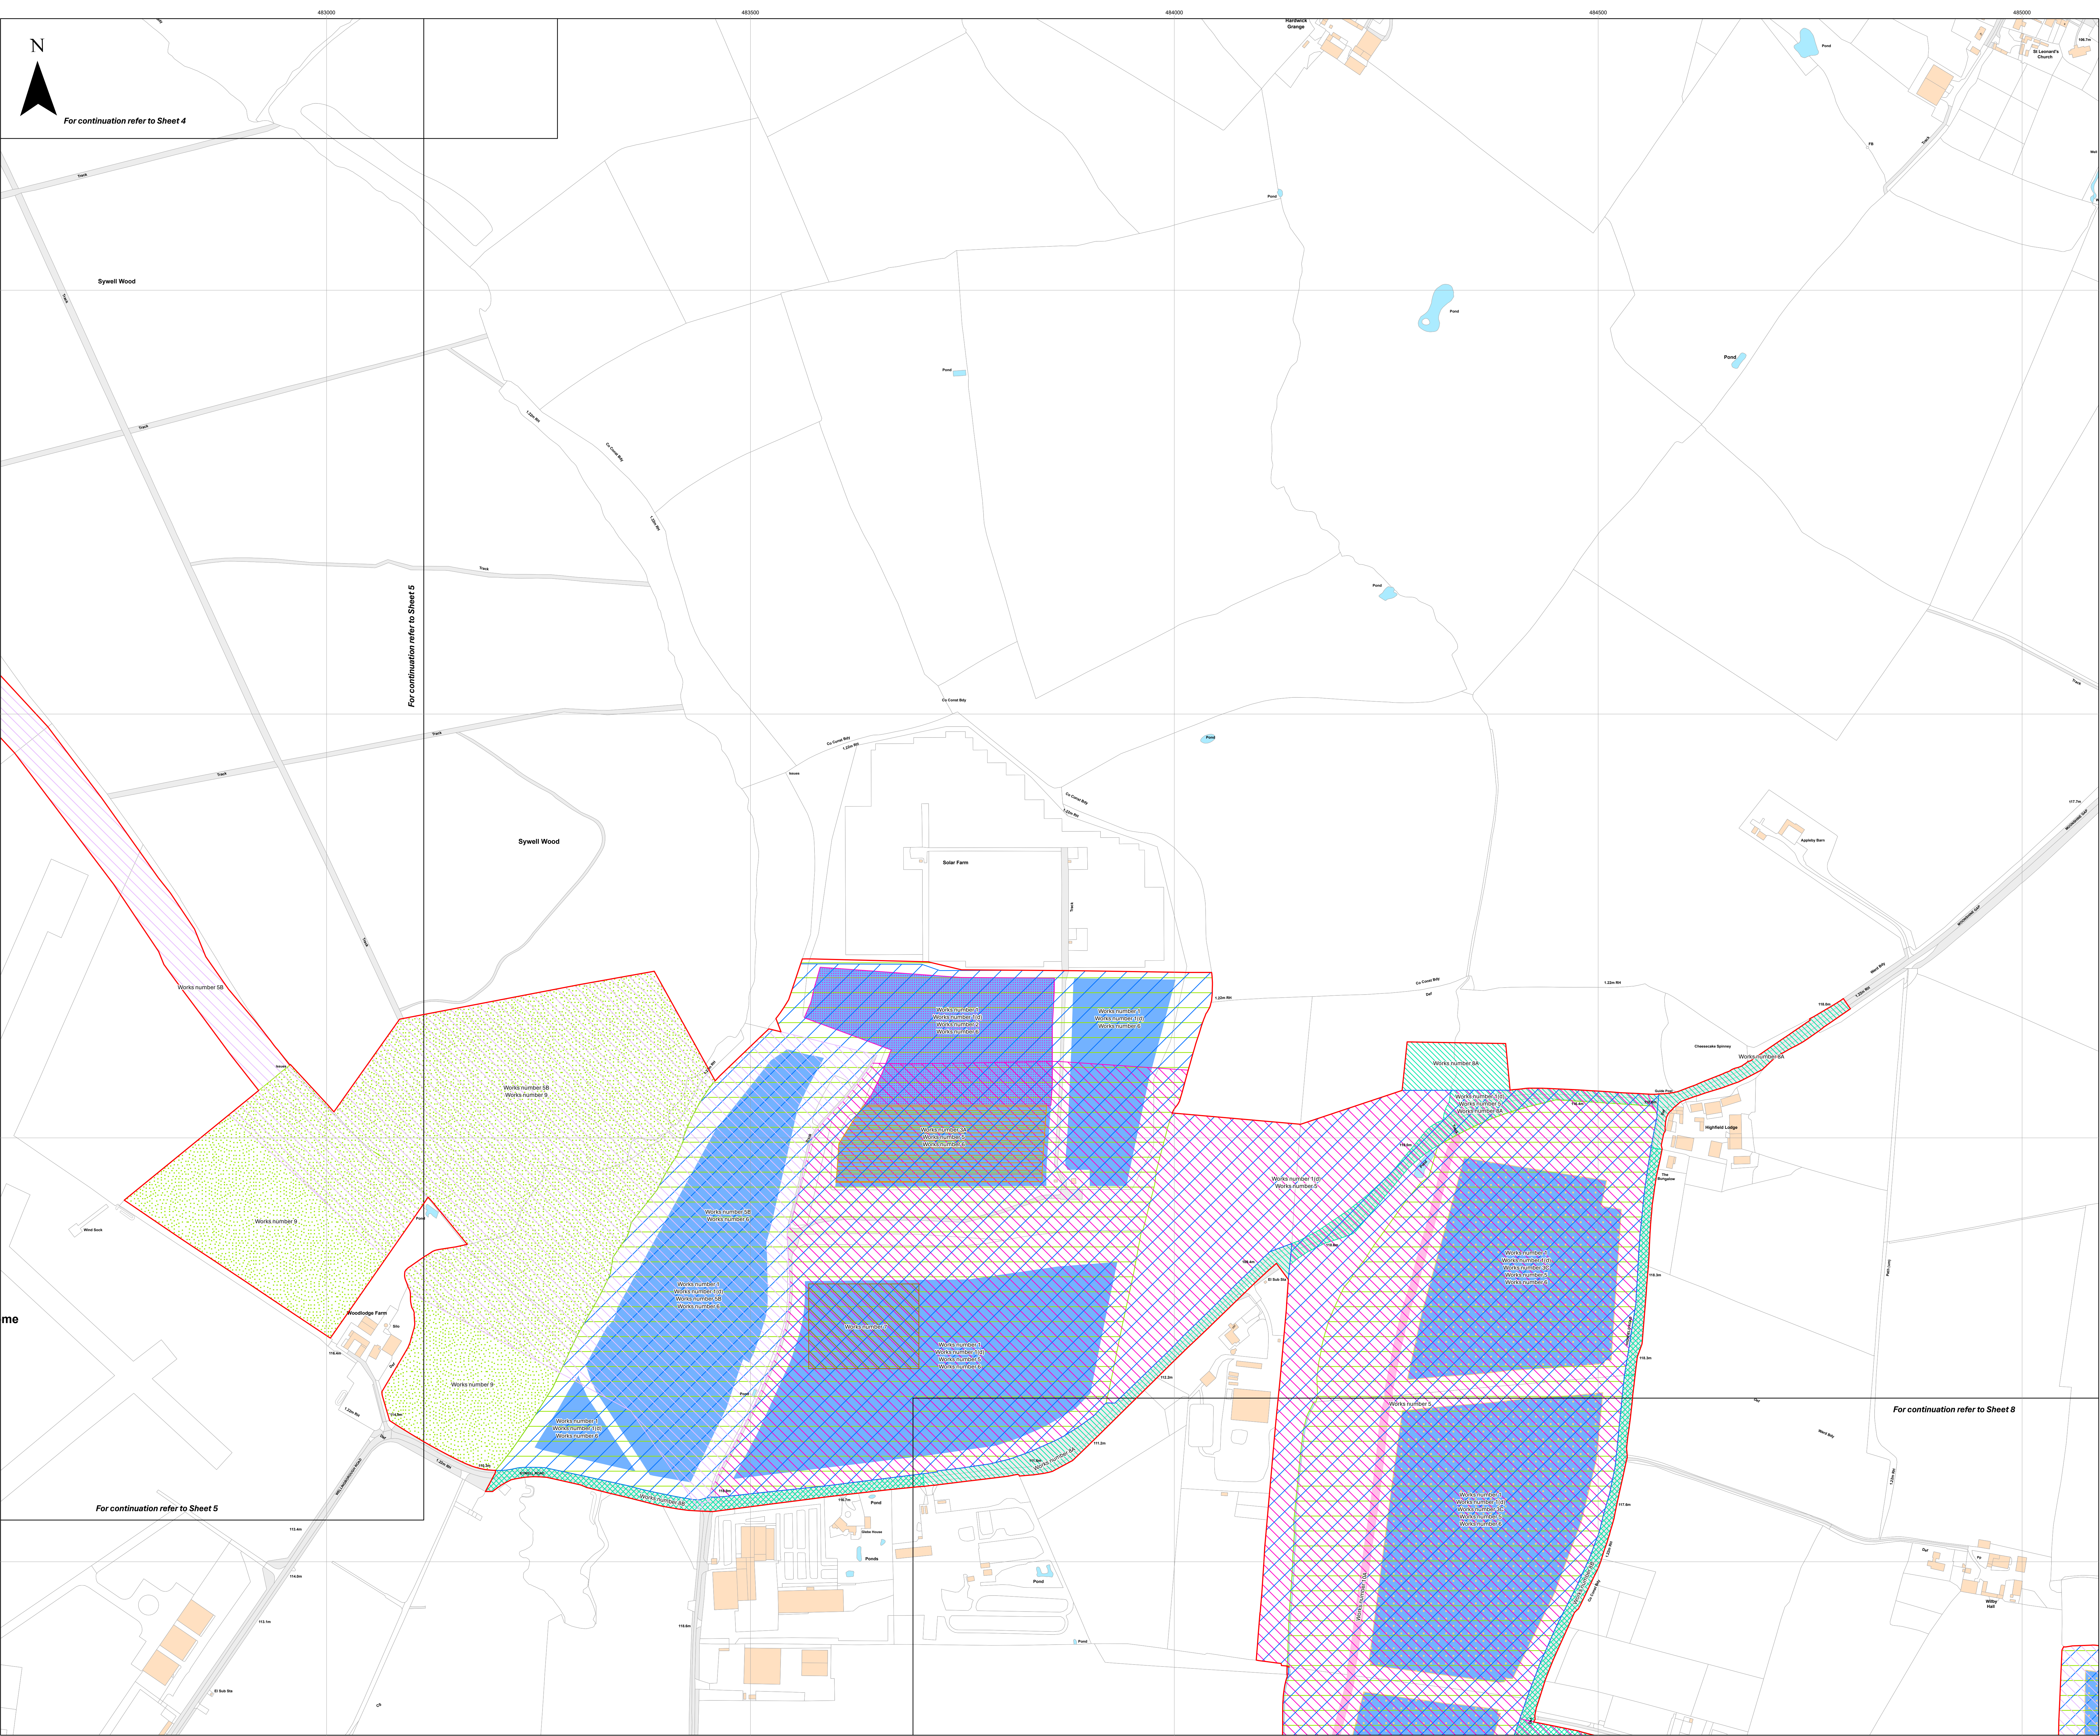



Key

Order Limits

Index Sheet

Works Number

- 1
- 1(d)
- 2
- 3A
- 3C
- 5
- 5B
- 6
- 7
- 8A
- 8B
- 9
- 10A

Layers: Lanpro, 2025; KPR, 2025

Base map: Reproduced from Ordnance Survey digital map data © Crown copyright 2025. All rights reserved. License number 0100031673

0 100 200 300 Meters

Scale: 1:2,500 @ A0


APFP Regulation: 5(2)(j)	Application Doc No. CR2/GH2.4_E
Ref: P3535_LPR_ZZ_XX_DR_Z_0274	Date: 16/02/2026
Drawn by: BH	Checked by: JC

Works Plan (Change Application Version)

Sheet 7 of 16

Revision E



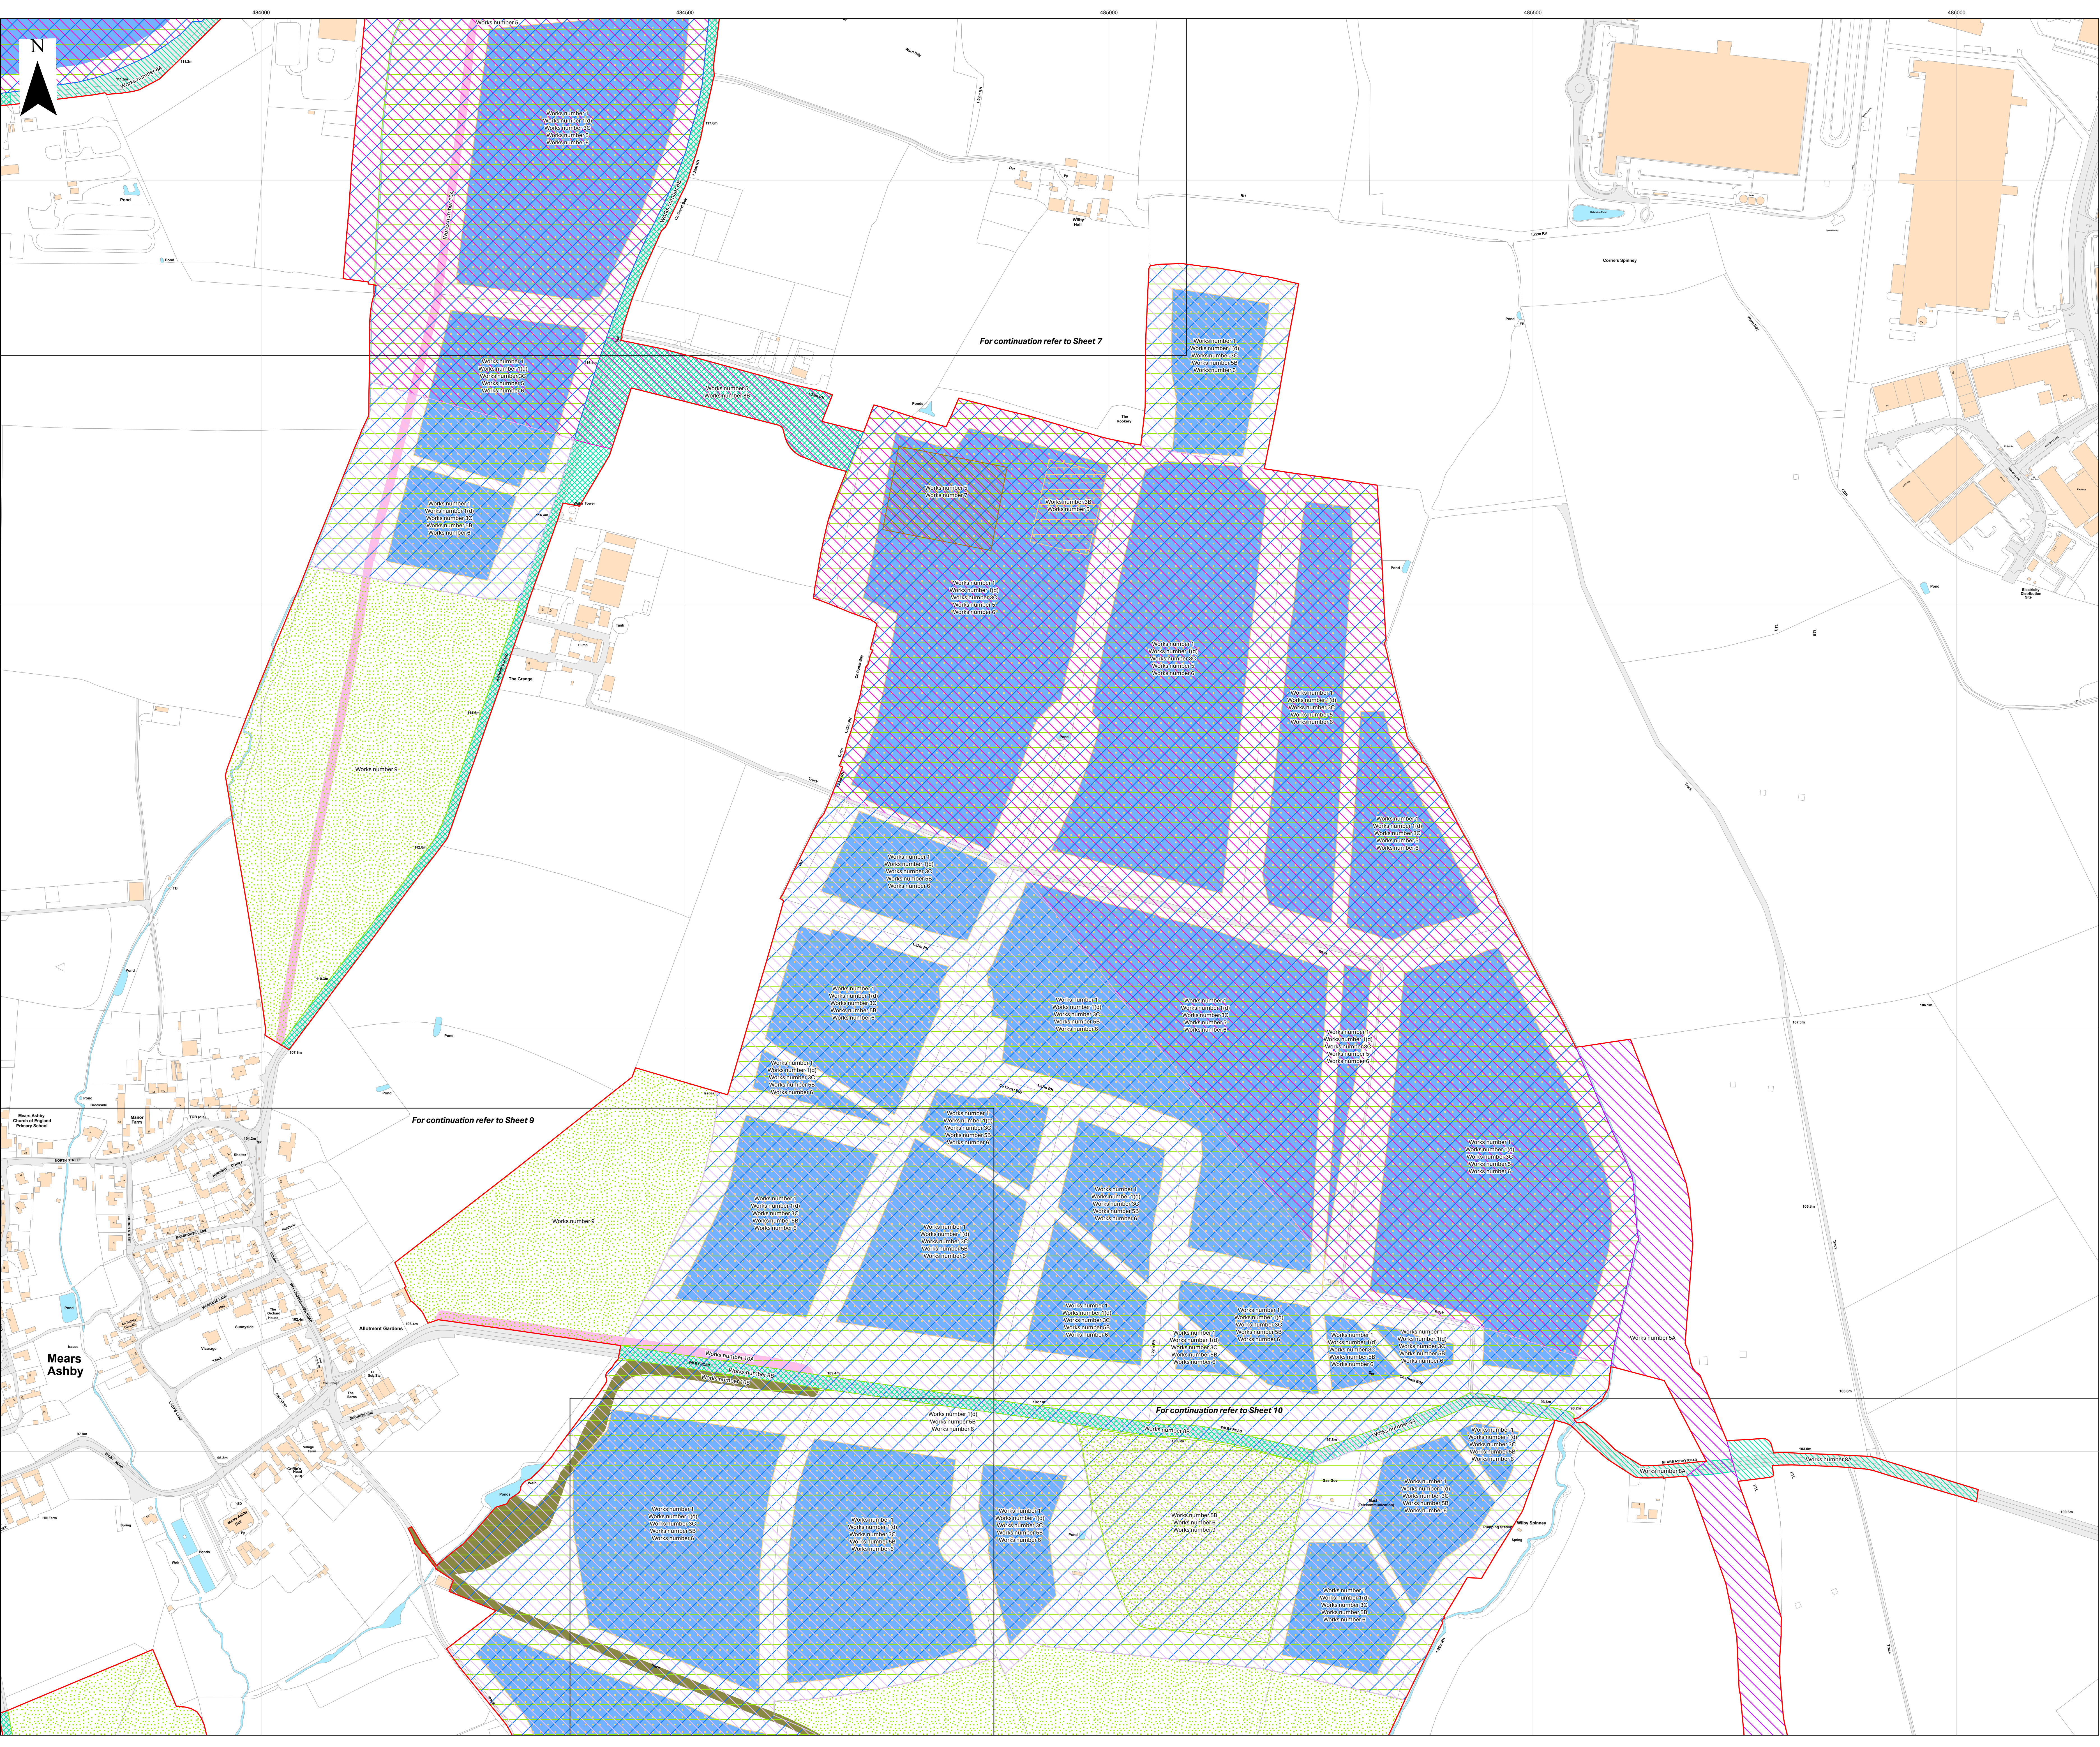



Key

Order Limits

Index Sheet

Works Number

1

1(d)

3B

3C

5

5A

5B

6

7

8A

8B

9

10A

10B

Layers: Lanpro, 2025; KPR, 2025

Base map: Reproduced from Ordnance Survey digital map data © Crown copyright 2025. All rights reserved. License number 0100031673

0 100 200 300 Meters

Scale: 1:2,500@ A0


APFP Regulation: 5(2)(j)	Application Doc No. CR2/GH2.4_E
Ref: P3535_LPR_ZZ_XX_DR_Z_0274	Date: 16/02/2026
Drawn by: BH	Checked by: JC

Works Plan (Change Application Version)

Sheet 8 of 16

Revision E



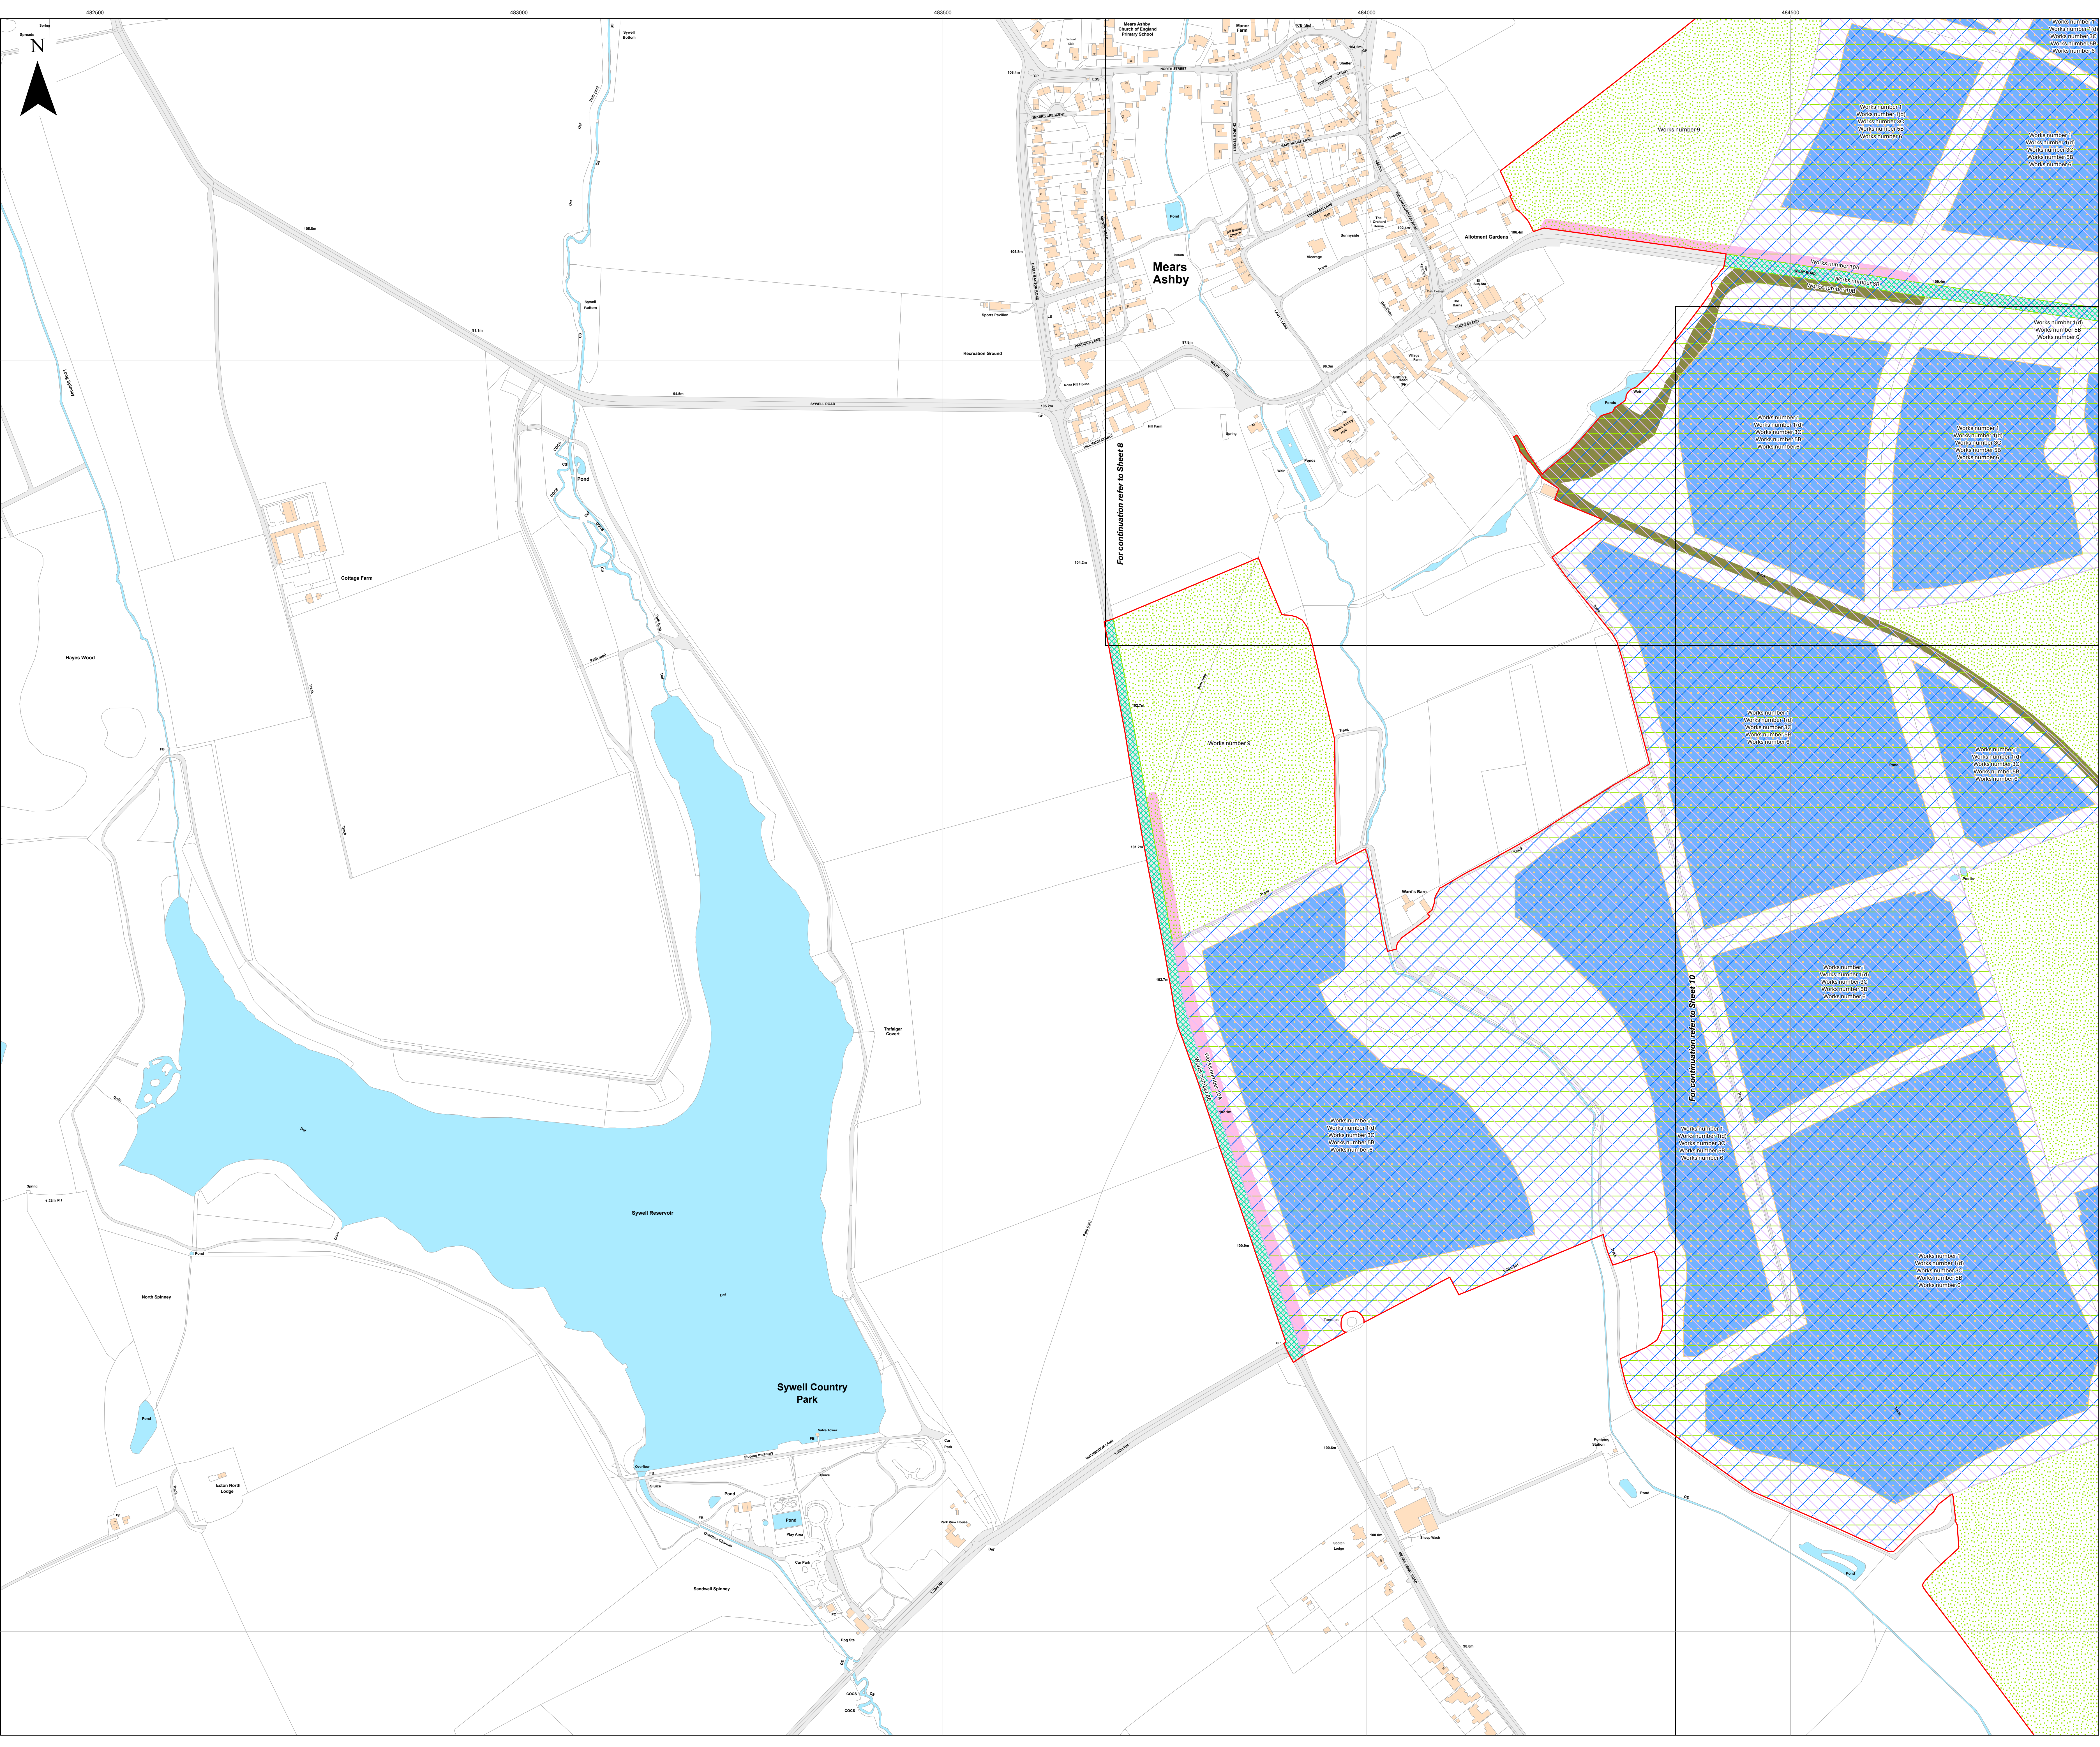



Key

Order Limits

Index Sheet

Works Number

- 1
- 1(d)
- 3C
- 5B
- 6
- 8B
- 9
- 10A
- 10B

Layers: Lanpro, 2025; KPR, 2025

Base map: Reproduced from Ordnance Survey digital map data © Crown copyright 2025. All rights reserved. License number 0100031673

0

100

200

300 Meters

Scale: 1:2,500@ A0


APFP Regulation: 5(2)(j)	Application Doc No. CR2/GH2.4_E
Ref: P3535_LPR_ZZ_XX_DR_Z_0274	Date: 16/02/2026
Drawn by: BH	Checked by: JC

Works Plan (Change Application Version)

Sheet 9 of 16

Revision E



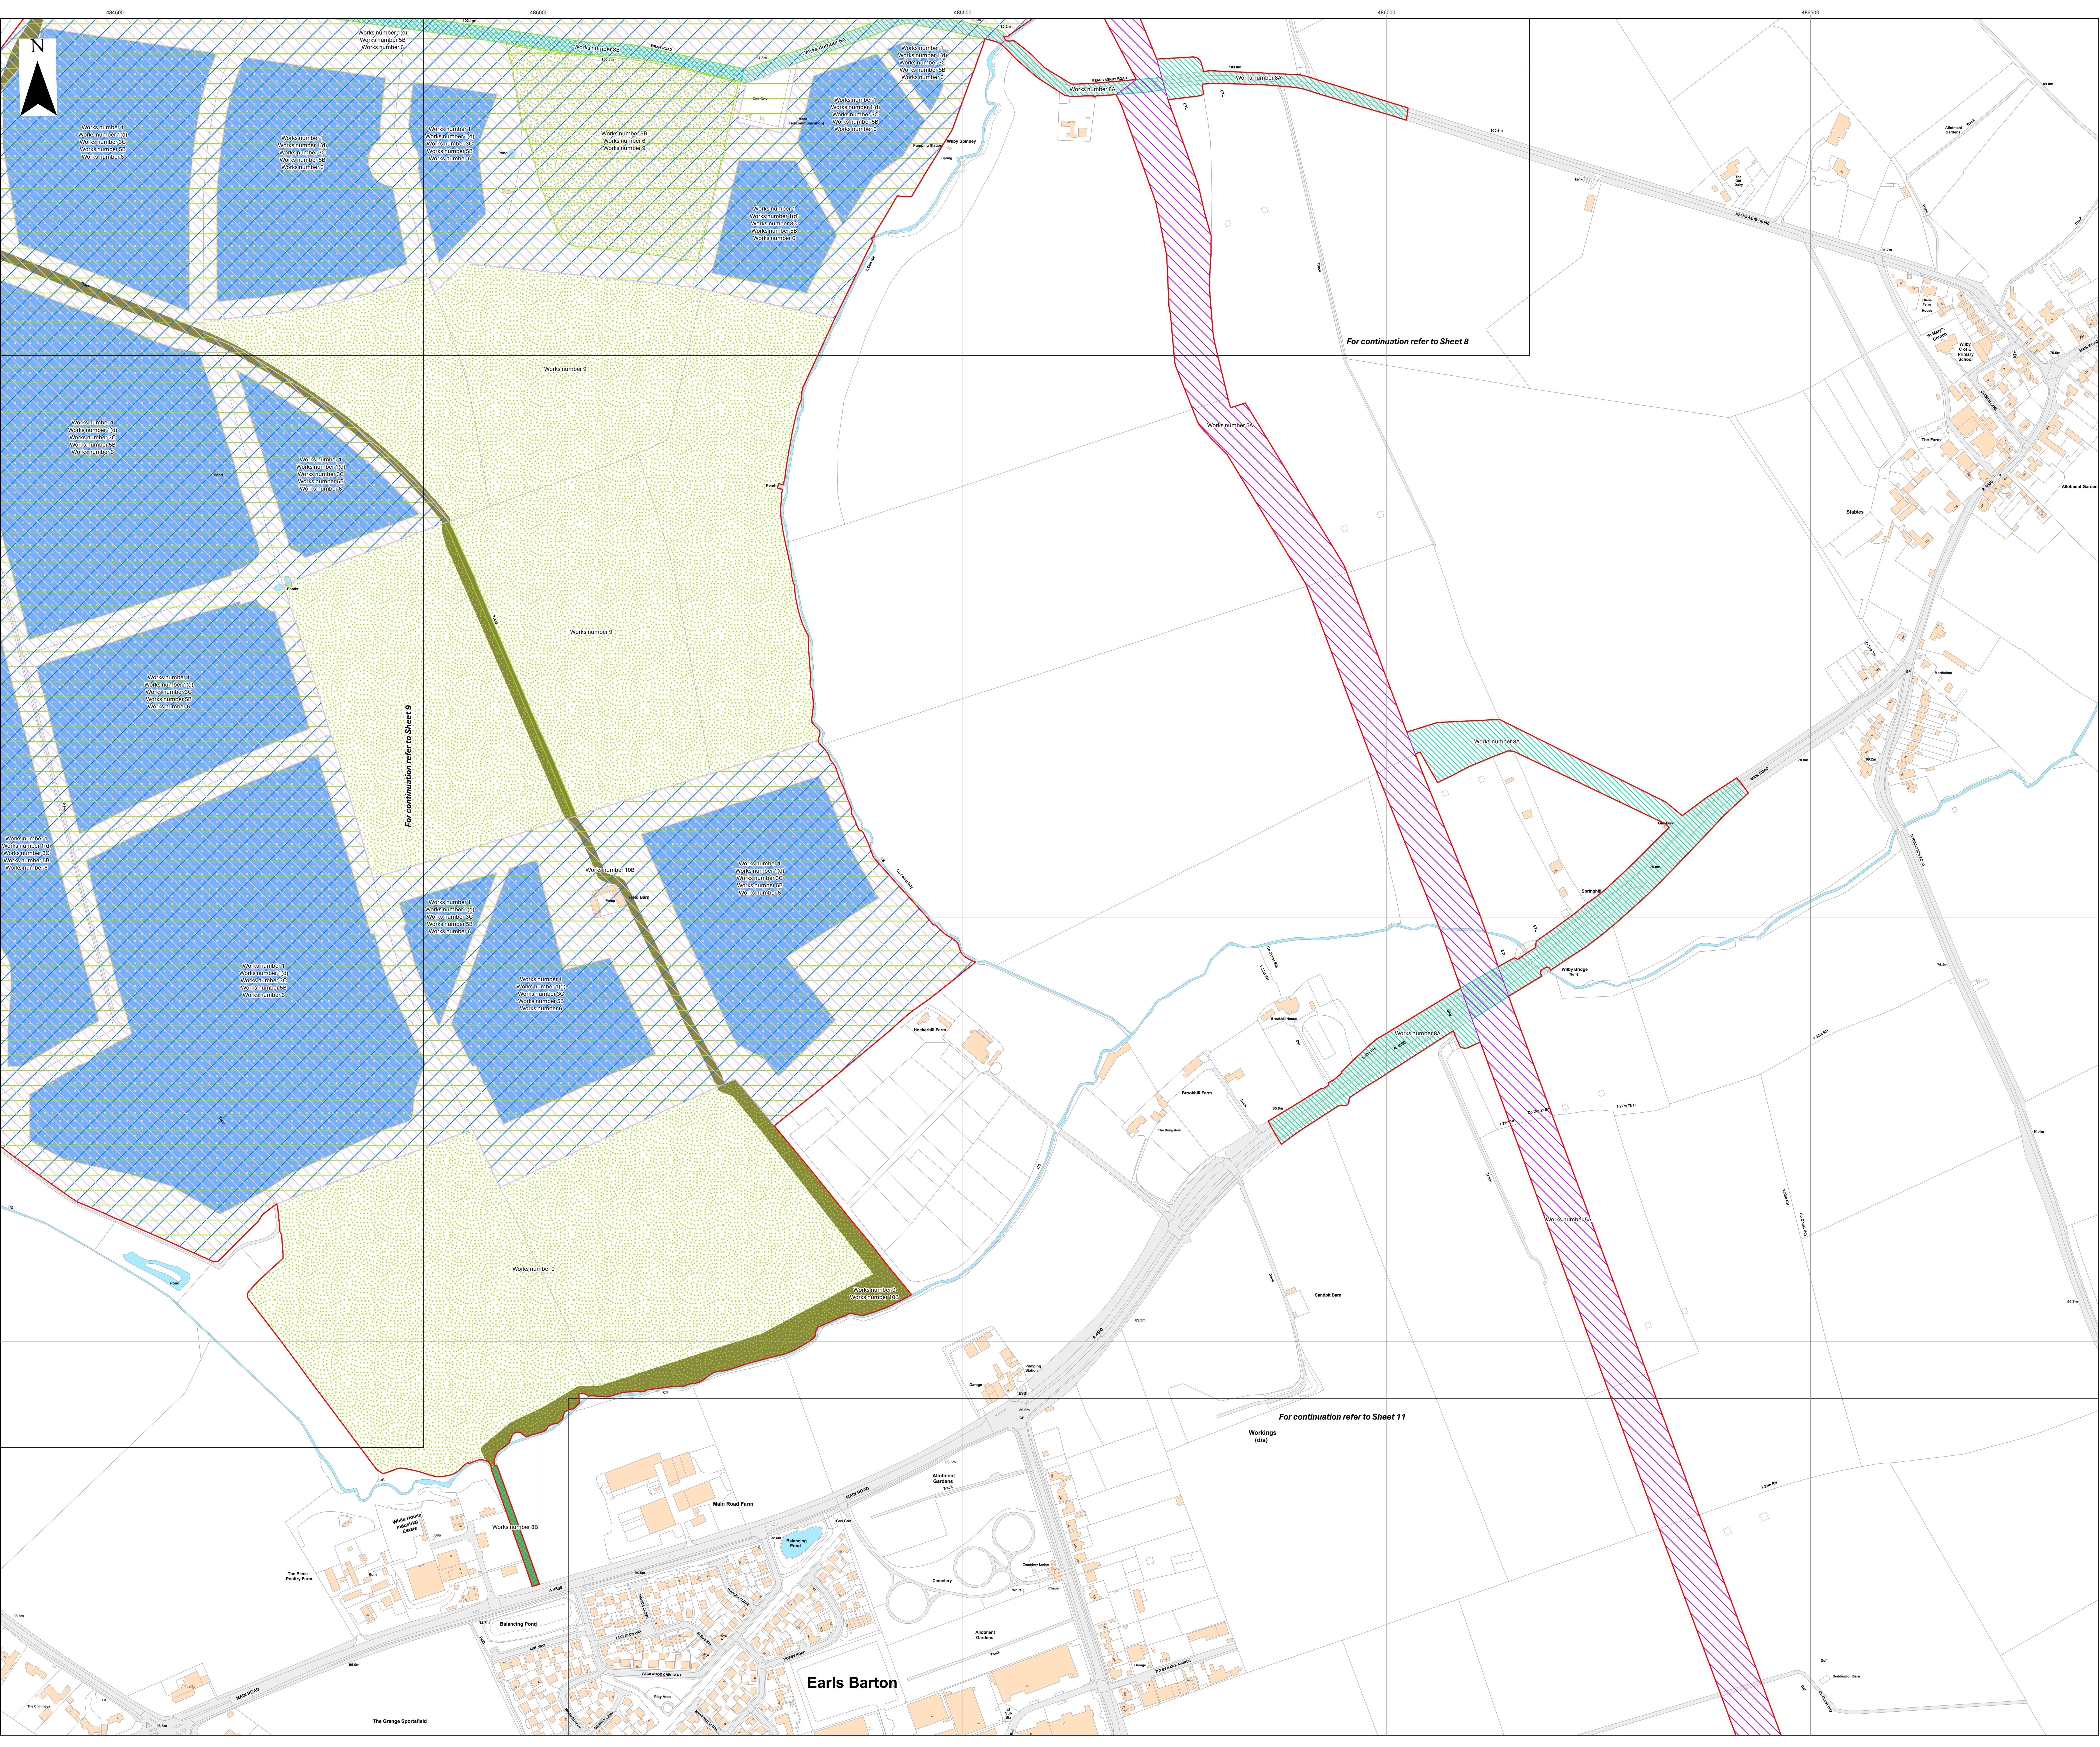



Key

- Order Limits
- Index Sheet
- Works Number**
- 1
- 1(d)
- 3C
- 5A
- 5B
- 6
- 8A
- 8B
- 9
- 10B

Layers: Lanpro, 2025; KIP, 2025
Base map: Reproduced from Ordnance Survey digital map data © Crown copyright 2025. All rights reserved. License number 0100031673

0100031673


0 100 200 300 Meters

Scale: 1:2,500@ A0


APFP Regulation: 5(2)(j)	Application Doc No. CR2/GH2.4_E
Ref: P3535_LPR_ZZ_XX_DR_Z_0274	Date: 16/02/2026
Drawn by: BH	Checked by: JC

Works Plan (Change Application Version)
Sheet 10 of 18
Revision E




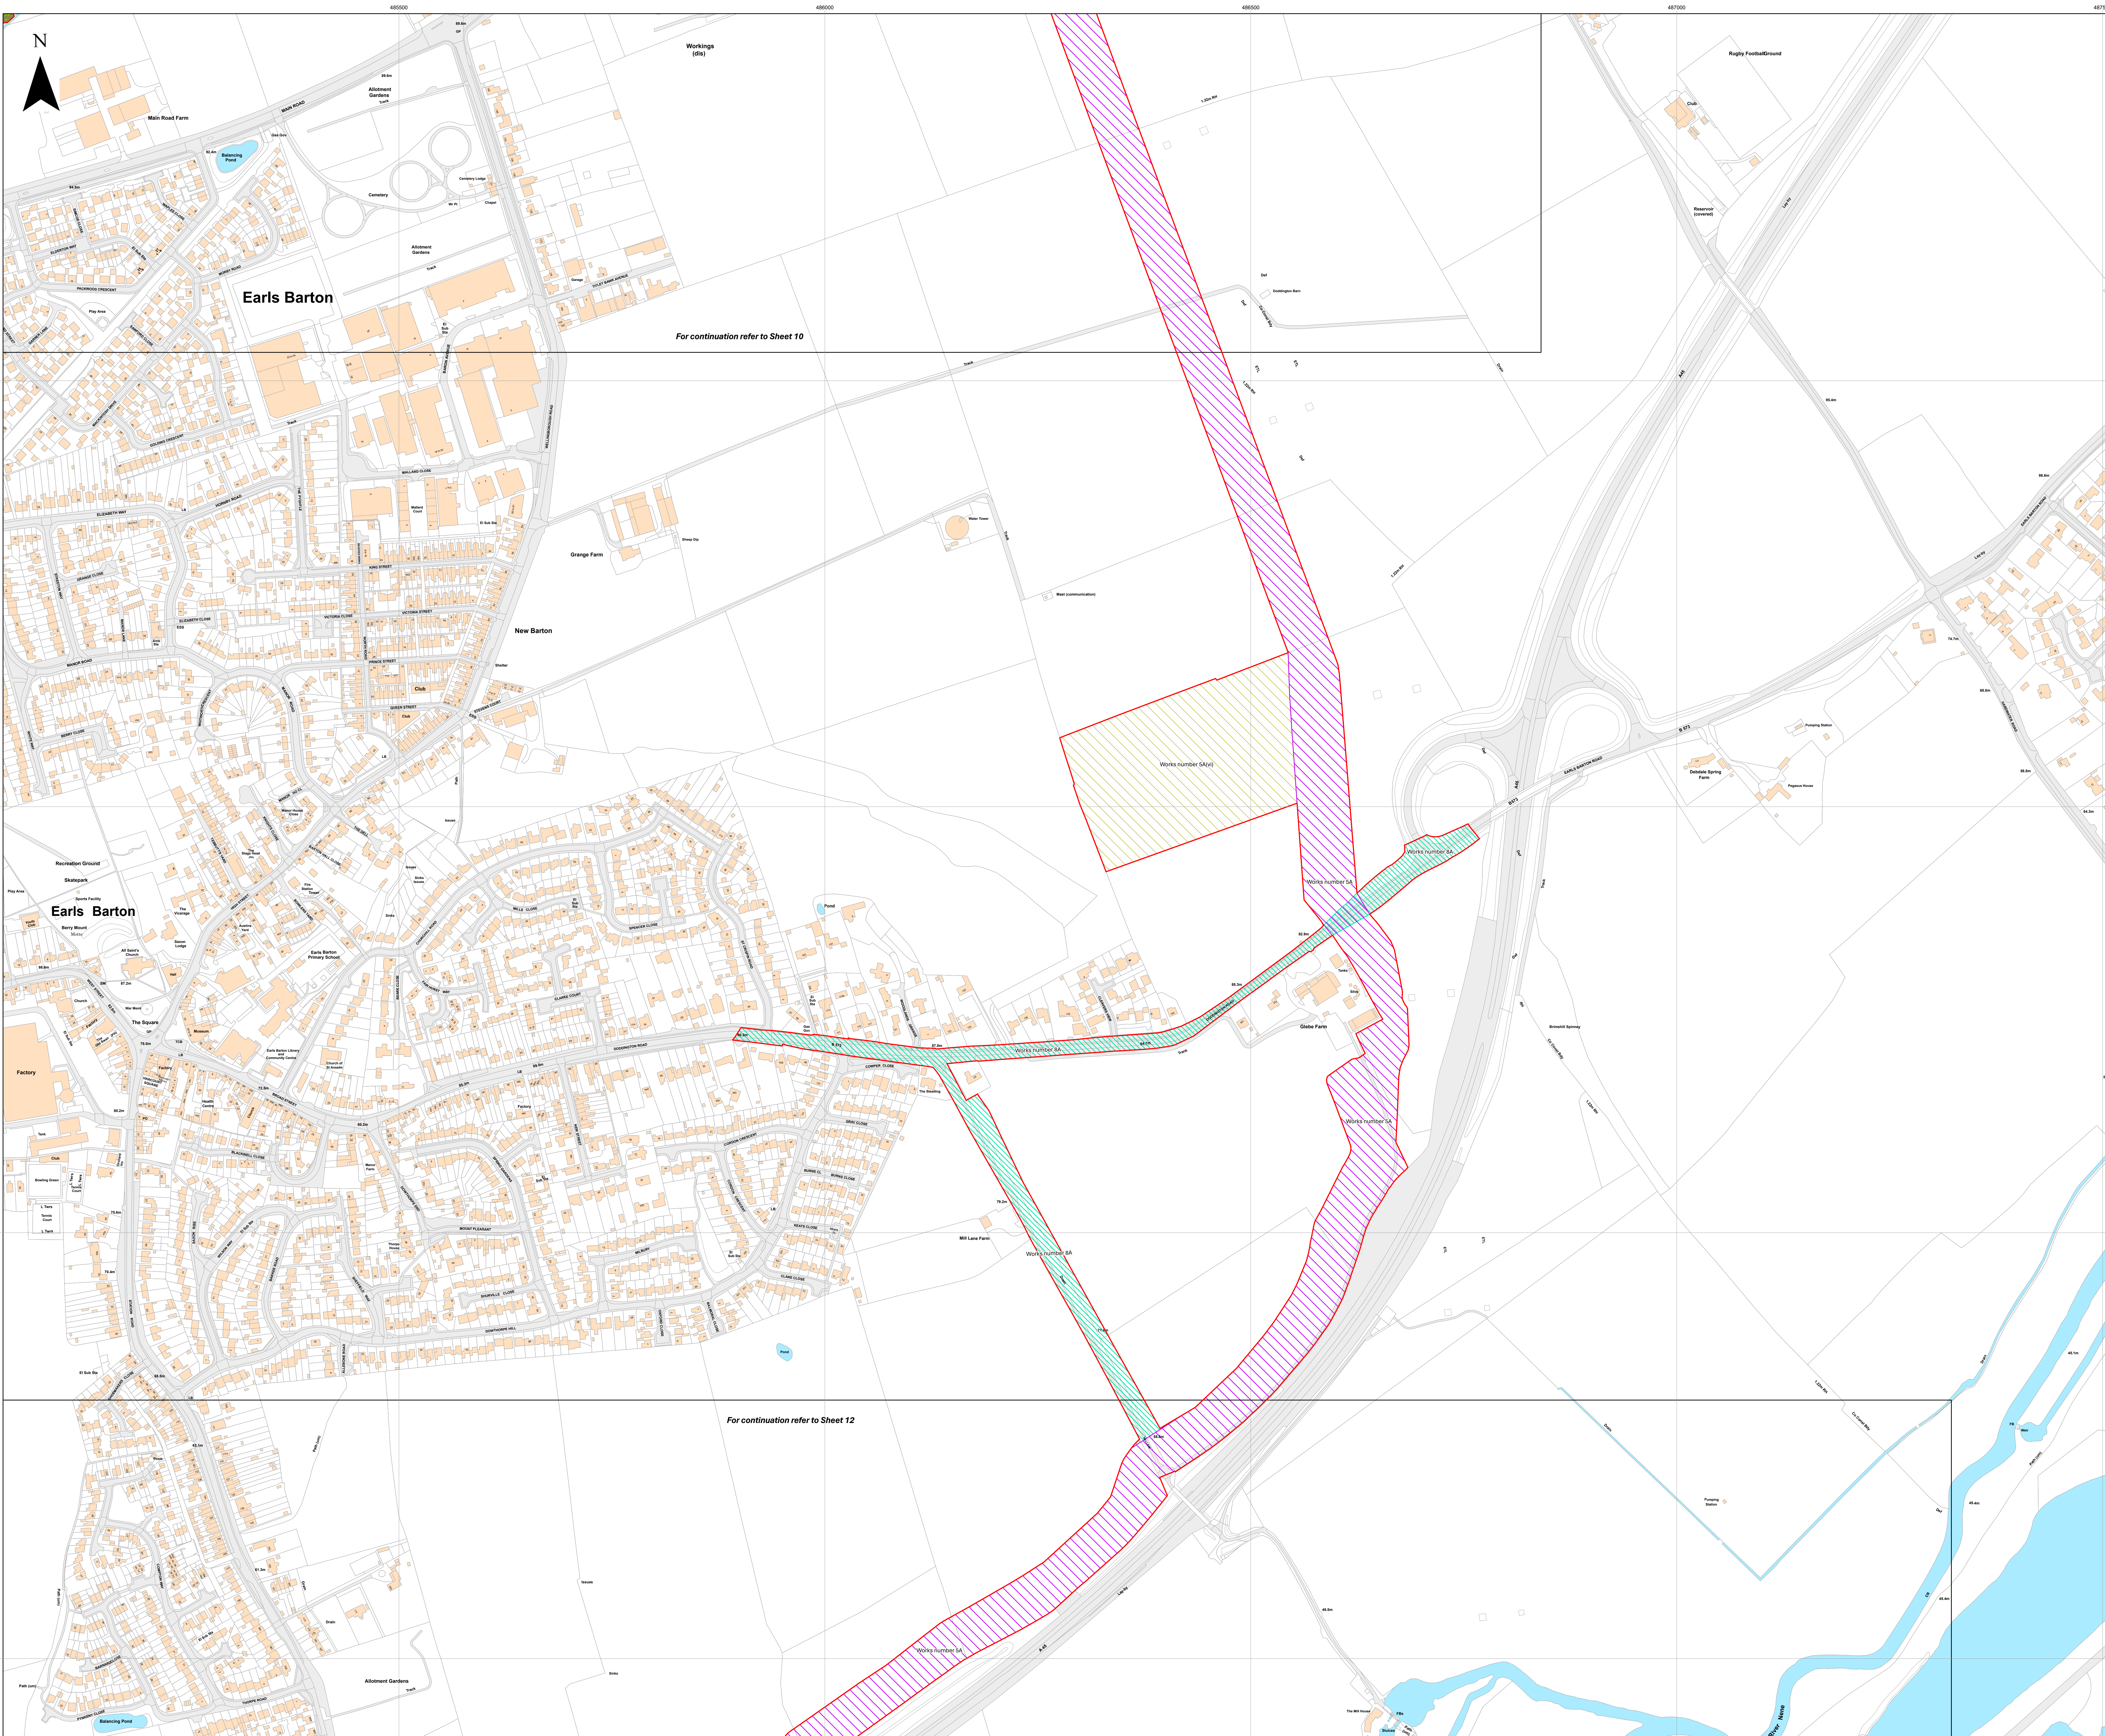

Key

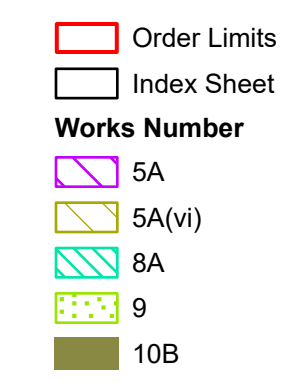

Base map: Reproduced from Ordnance Survey digital map data © Crown copyright 2025. All rights reserved. License number 0100031673

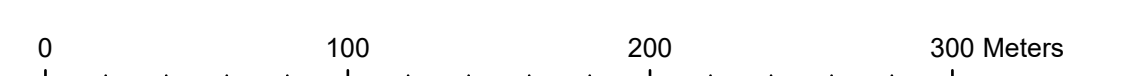


Scale: 1:2,500@ A0

APFP Regulation: 5(2)(j)	Application Doc No. CR2/GH2.4_E
Ref: P3535_LPR_ZZ_XX_DR_Z_0274	Date: 16/02/2026
Drawn by: BH	Checked by: JC

Works Plan (Change Application Version)
Sheet 11 of 18
Revision E



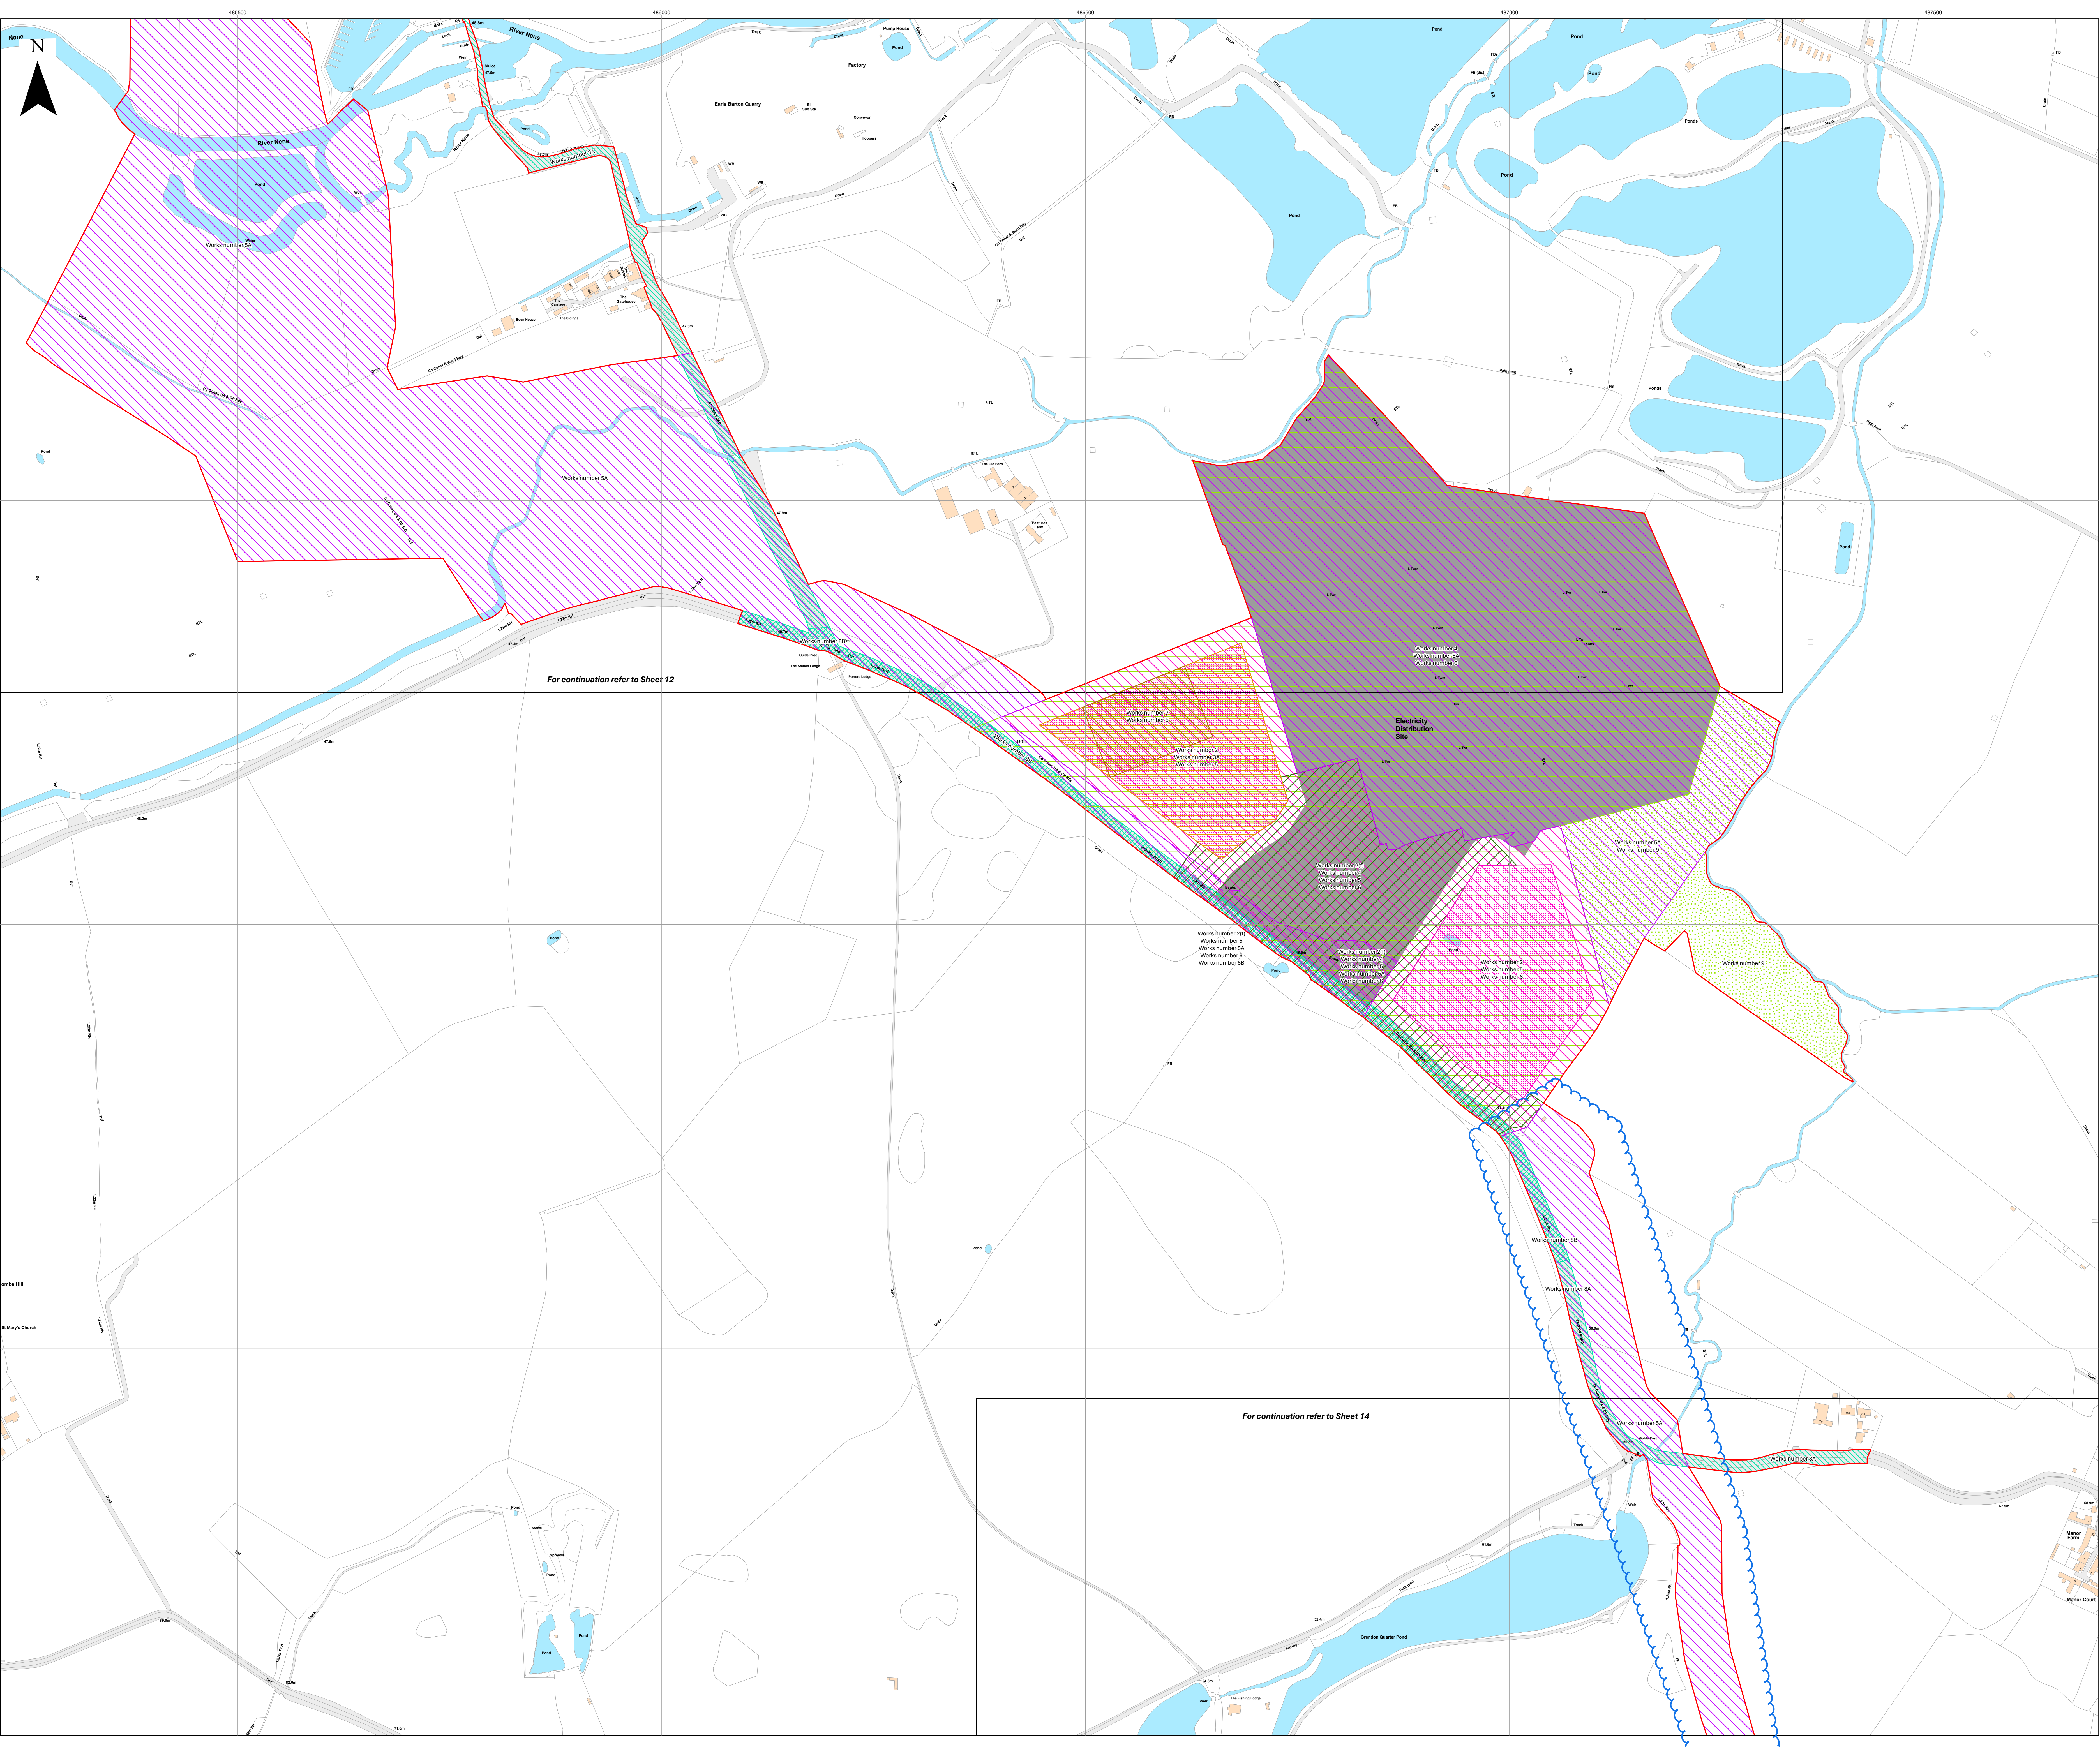



Key

- Order Limits
- Index Sheet
- Works Number**
- 2
- 2(f)
- 3A
- 4
- 5
- 5A
- 6
- 7
- 8A
- 8B
- 9

Layers: Lanpro, 2025: KIP, 2025
Base map: Reproduced from Ordnance Survey digital map data © Crown copyright 2025. All rights reserved. License number 0100031673


0 100 200 300 Meters

Scale: 1:2,500@ A0

APFP Regulation: 5(2)(j)	Application Doc No. CR2/GH2.4_E
Ref: P3535_LPR_ZZ_XX_DR_Z_0274	Date: 16/02/2026
Drawn by: BH	Checked by: JC

Works Plan (Change Application Version)
Sheet 13 of 18
Revision E



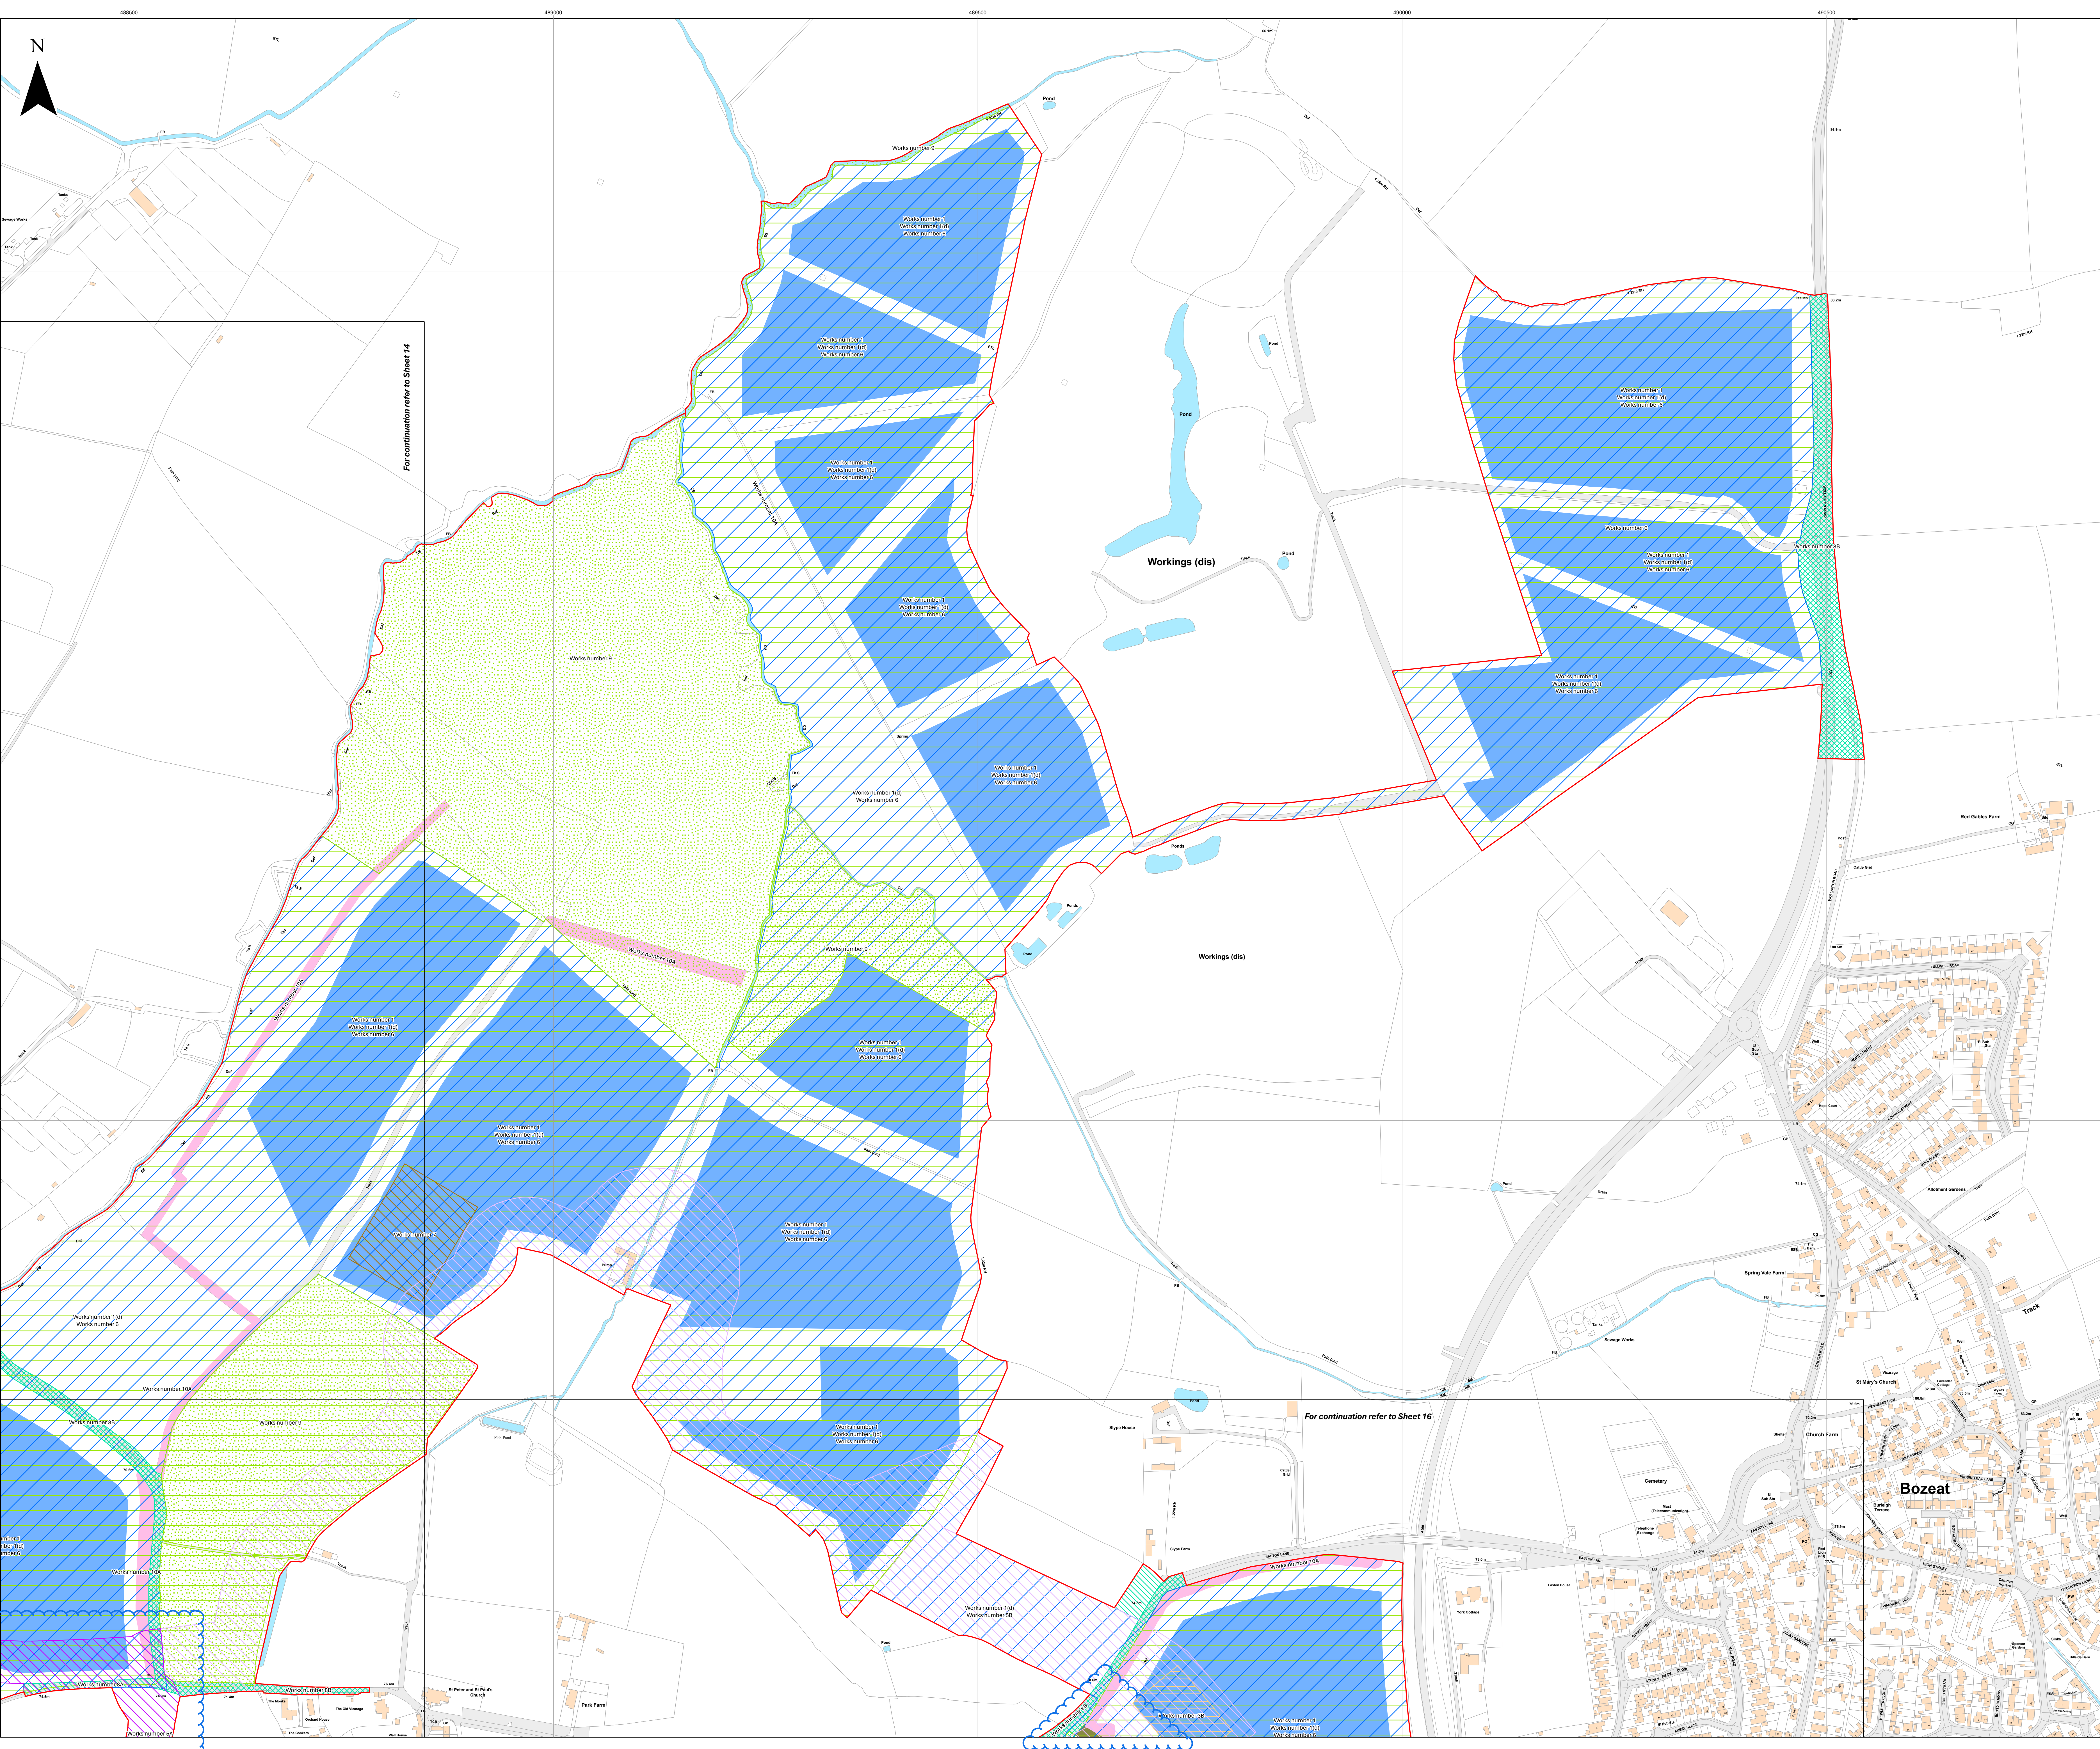



Key

- Order Limits
- Index Sheet
- Works Number**
- 1
- 1(d)
- 3B
- 5A
- 5B
- 6
- 7
- 8A
- 8B
- 9
- 10A
- 10B

Layers: Lanpro, 2025; KIP, 2025
Base map: Reproduced from Ordnance Survey digital map data © Crown copyright 2025. All rights reserved. License number 0100031673

0 100 200 300 Meters

Scale: 1:2,500@ A0


APPP Regulation: 5(2)(j)	Application Doc No. CR2/GH2.4_E
Ref: P3535_LPR_ZZ_XX_DR_Z_0274	Date: 16/02/2026
Drawn by: BH	Checked by: JC

Works Plan (Change Application Version)

Sheet 15 of 18


Revision E



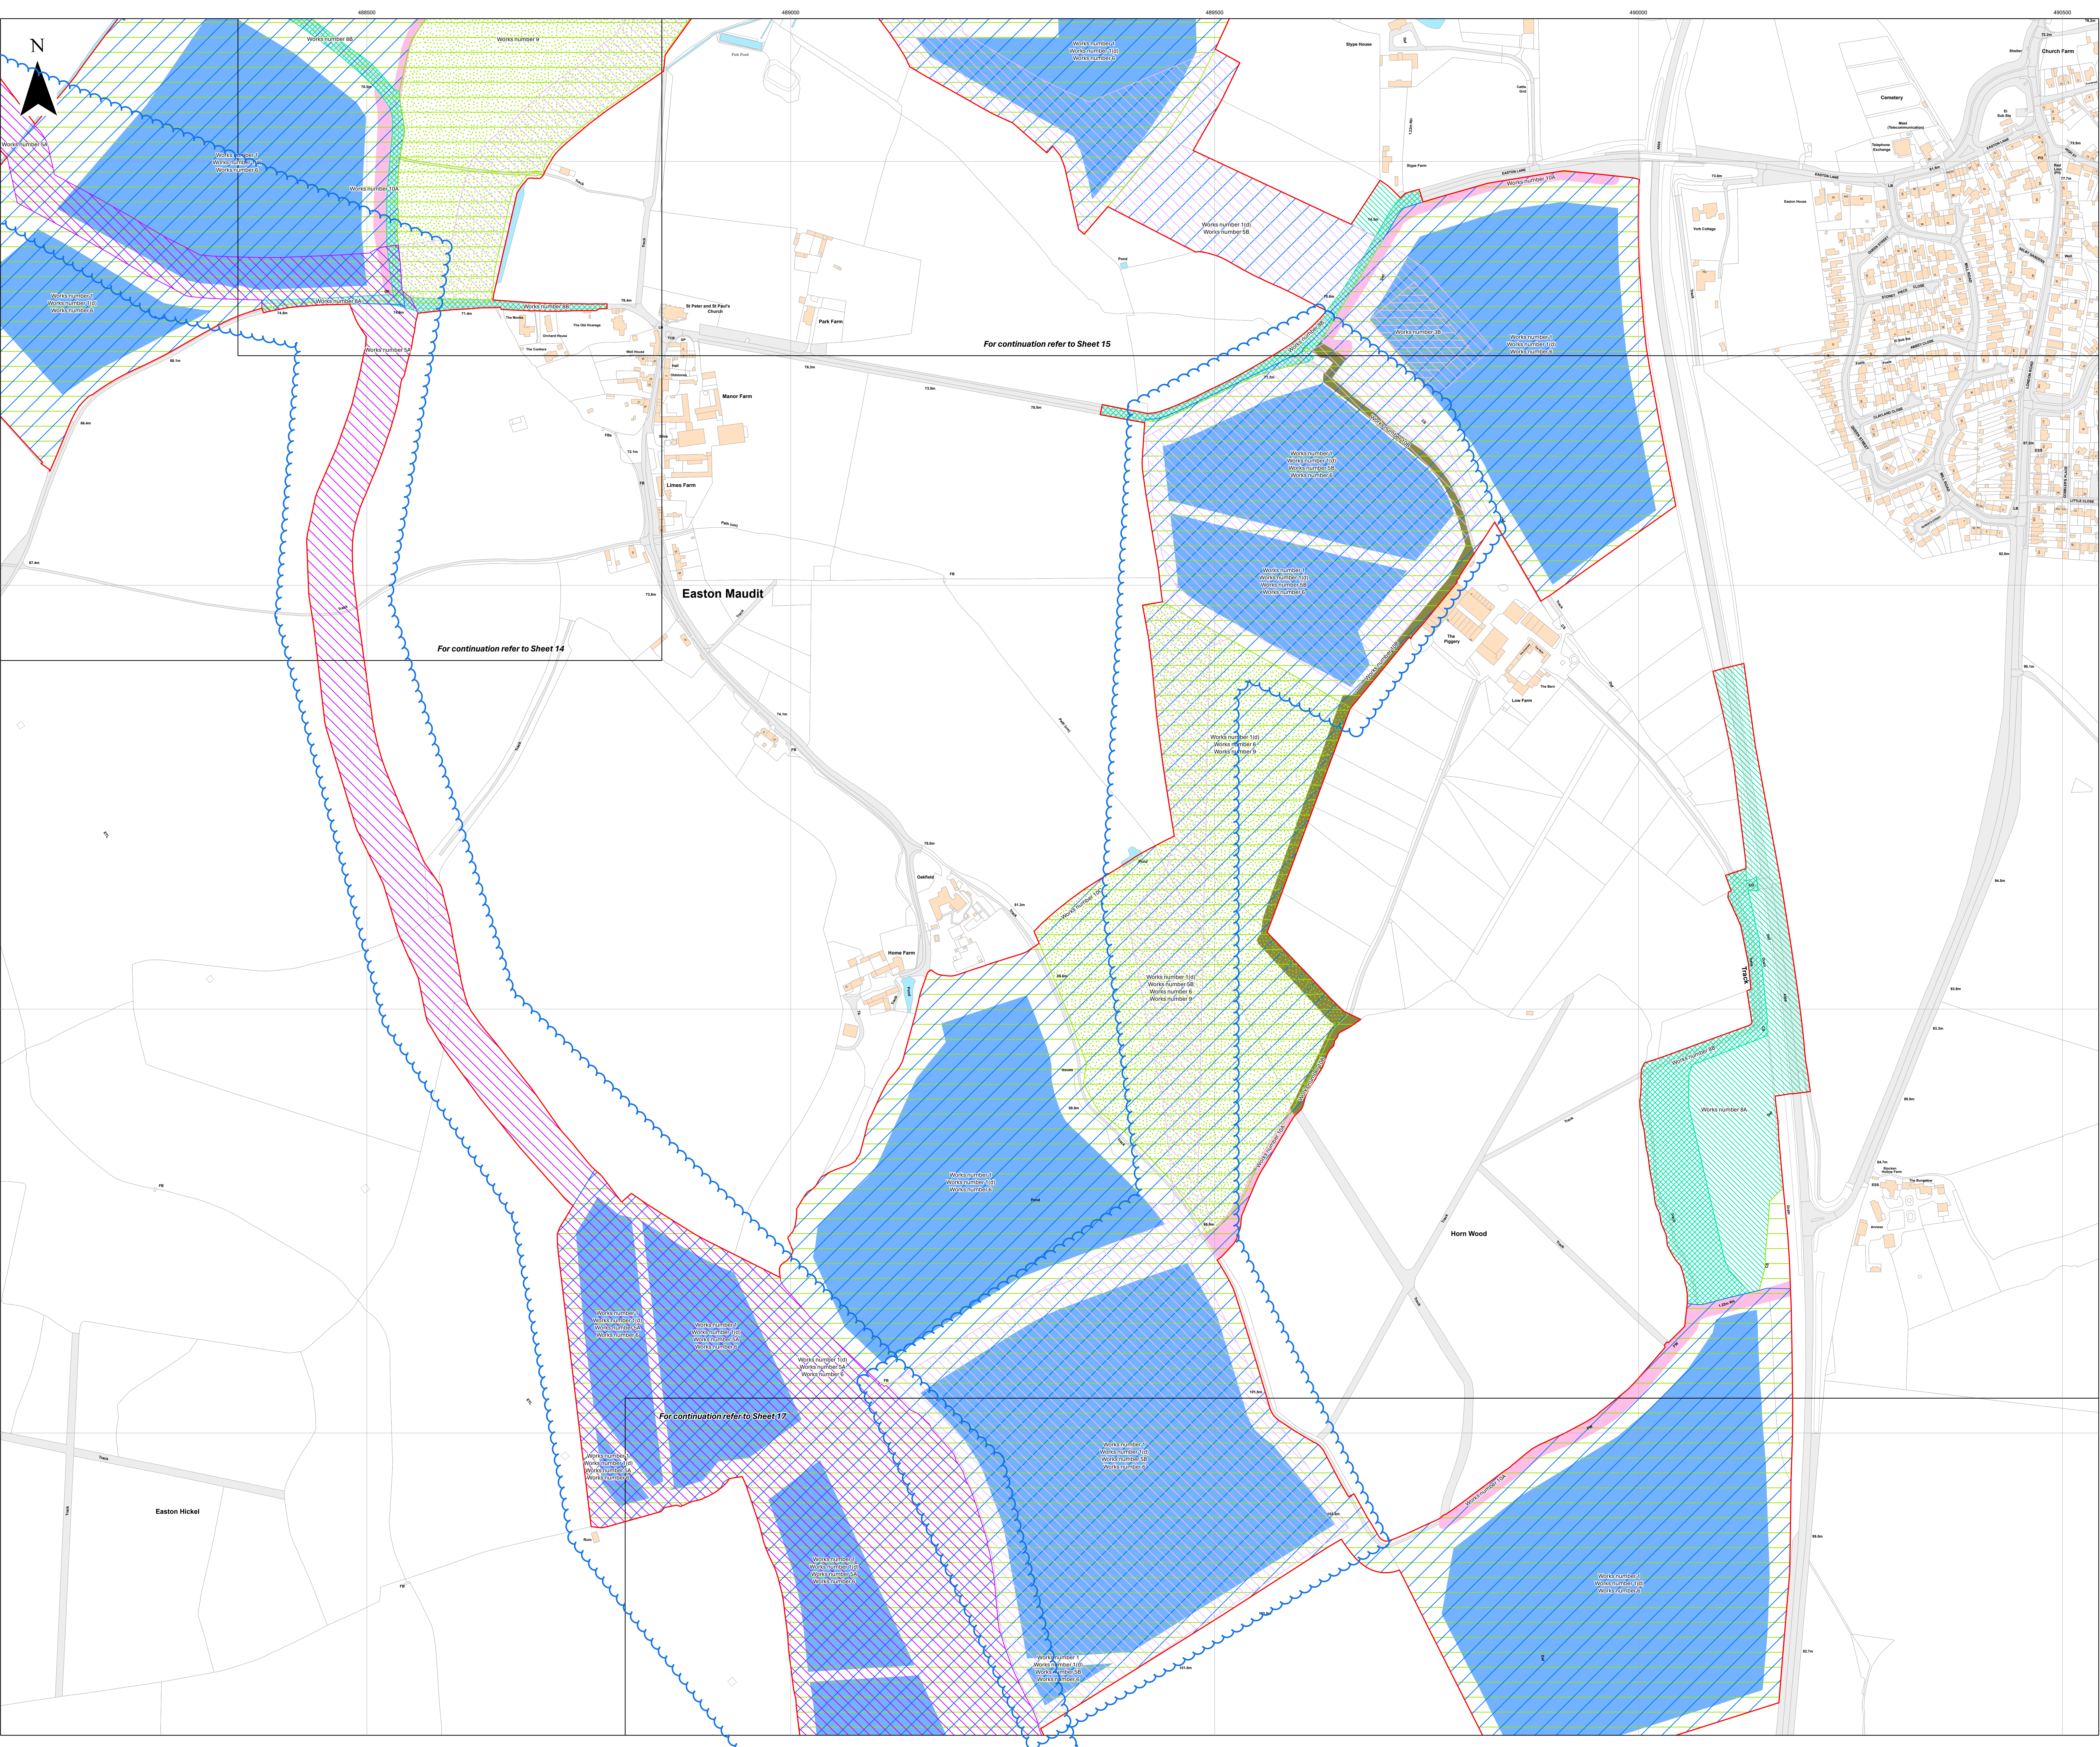

- Key**
- Order Limits
 - Index Sheet
 - Works Number**
 - 1
 - 1(d)
 - 3B
 - 5A
 - 5B
 - 6
 - 8A
 - 8B
 - 9
 - 10A
 - 10B


Layers: Lanpro, 2025: KIP, 2025
Base map: Reproduced from Ordnance Survey digital map data © Crown copyright 2025. All rights reserved. License number 0100031673

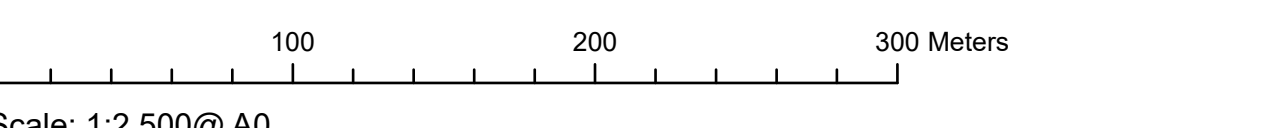

APFP Regulation: 5(2)(j)	Application Doc No. CR2/GH2.4_E
Ref: P3535_LPR_ZZ_XX_DR_Z_0274	Date: 16/02/2026
Drawn by: BH	Checked by: JC

Works Plan (Change Application Version)
Sheet 16 of 18
Revision E



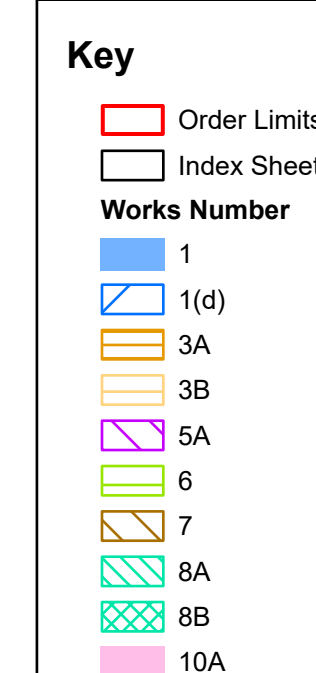

APFP Regulation: 5(2)(i)	Application Doc No. CR2/GH2.4 E
--------------------------	---------------------------------

Date: 16/02/2026

Checked by: JC

Sheet 18 of 18
Revision E

