



MORGAN AND MORECAMBE OFFSHORE WIND FARMS: TRANSMISSION ASSETS

Without Prejudice Removal of Lytham Moss - Onshore and Intertidal Order Limits Plan



Deadline: SoS Letter 3
PINS Reference: EN020028

Document Numbers:
MOR001-FLO-CON-CAG-PLN-0087
MRCNS-J3303-DMC-19097

APFP Regulations: 5(2)(k)

Document reference: S_SoSQ_38
Rev: F01

22 July 2026

Document status					
Version	Purpose of document	Approved by	Date	Approved by	Date
F01	SoS Letter 3	GL	July 2026	AB	July 2026

Prepared by:


**Morgan Offshore Wind Project Limited,
Morecambe Offshore Windfarm Ltd**

Prepared for:



**Morgan Offshore Wind Project Limited,
Morecambe Offshore Windfarm Ltd**

Schedule of Changes

Sheet Number	Change requested by	Change Made	Reason for Change	Revision	Submission deadline
All sheets	Secretary of State	Plans updated to show without prejudice removal of Lytham Moss ecological mitigation area from the DCO Order Limits	As instructed by the Secretary of State in letter (C3-001) dated 08 July 2026	F01	Secretary of State Consultation 3

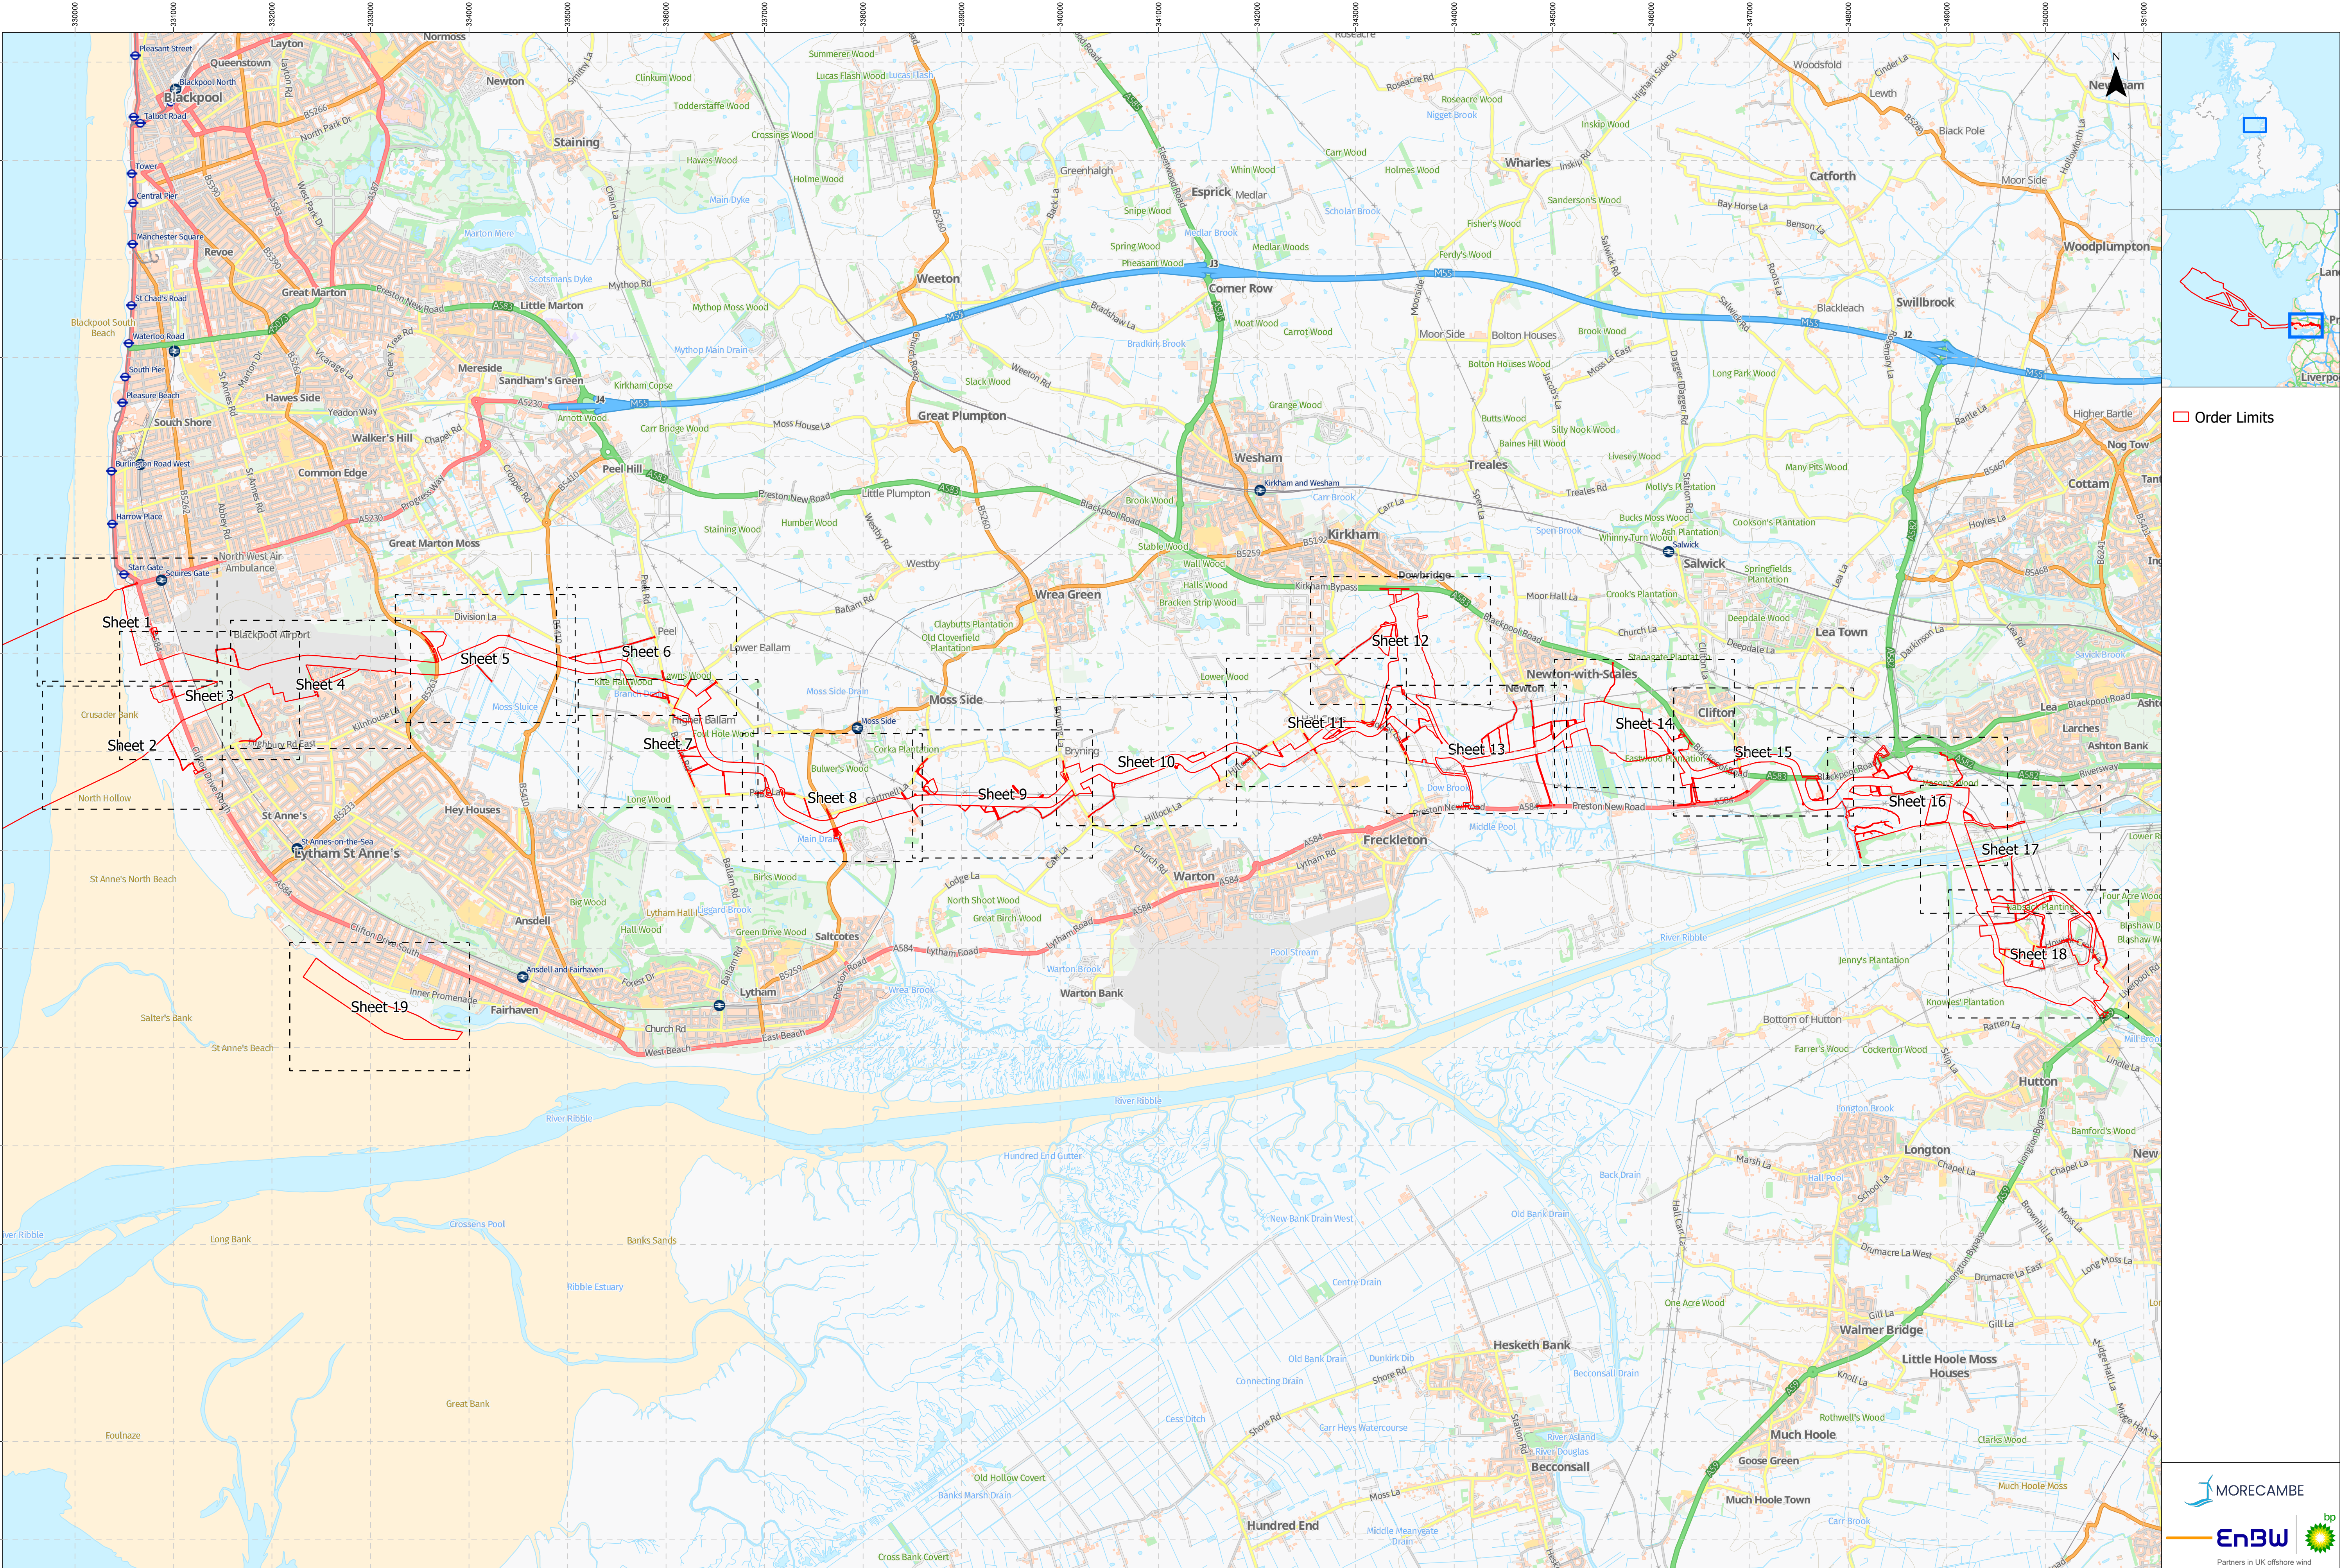

Project Name: MORGAN AND MORECAMBE OFFSHORE WIND FARMS: TRANSMISSION ASSETS	Drawing Title: Without Prejudice Removal of Lytham Moss - Onshore and Intertidal Order Limits Plan - Index AFPF Regulation: 5(2)(j)(ii) Document Reference: S_SoSQ_38	00.250.50.751 nm 00.51 Kilometers Scale@A1:1:30,000	Geodetic Information: Datum: OSGB 1936 Projection: British National Grid	Data Sources: BP, Ordnance Survey Based Upon The Ordnance Survey Map With The Sanction Of The Controller Of HM Stationery Office. Crown Copyright Reserved. © OS Licence No. 100042124	Services Layer Credits: GB Cartographic Local Names: Contains OS data © Crown Copyright and database right 2026. Contains data from OS Zoomstack	VER	DATE	DETAILS	AUTH	CHK	APPRV	Drawing Number: 22003214_PLN_DCO_13660.0
						01	17.07.2026	SoS Consultation 3 Submission	DM	CB	OG	

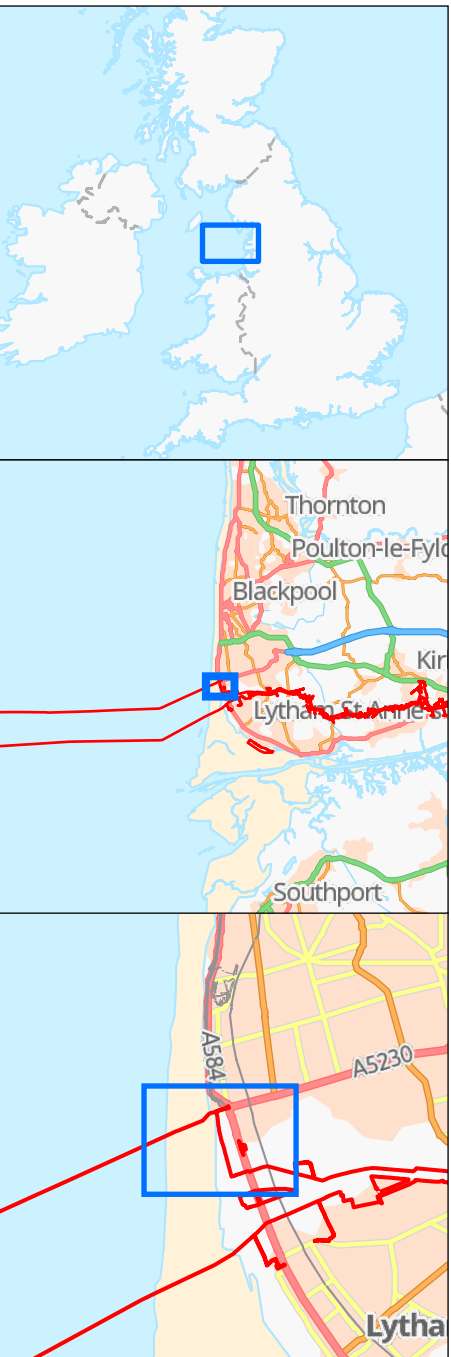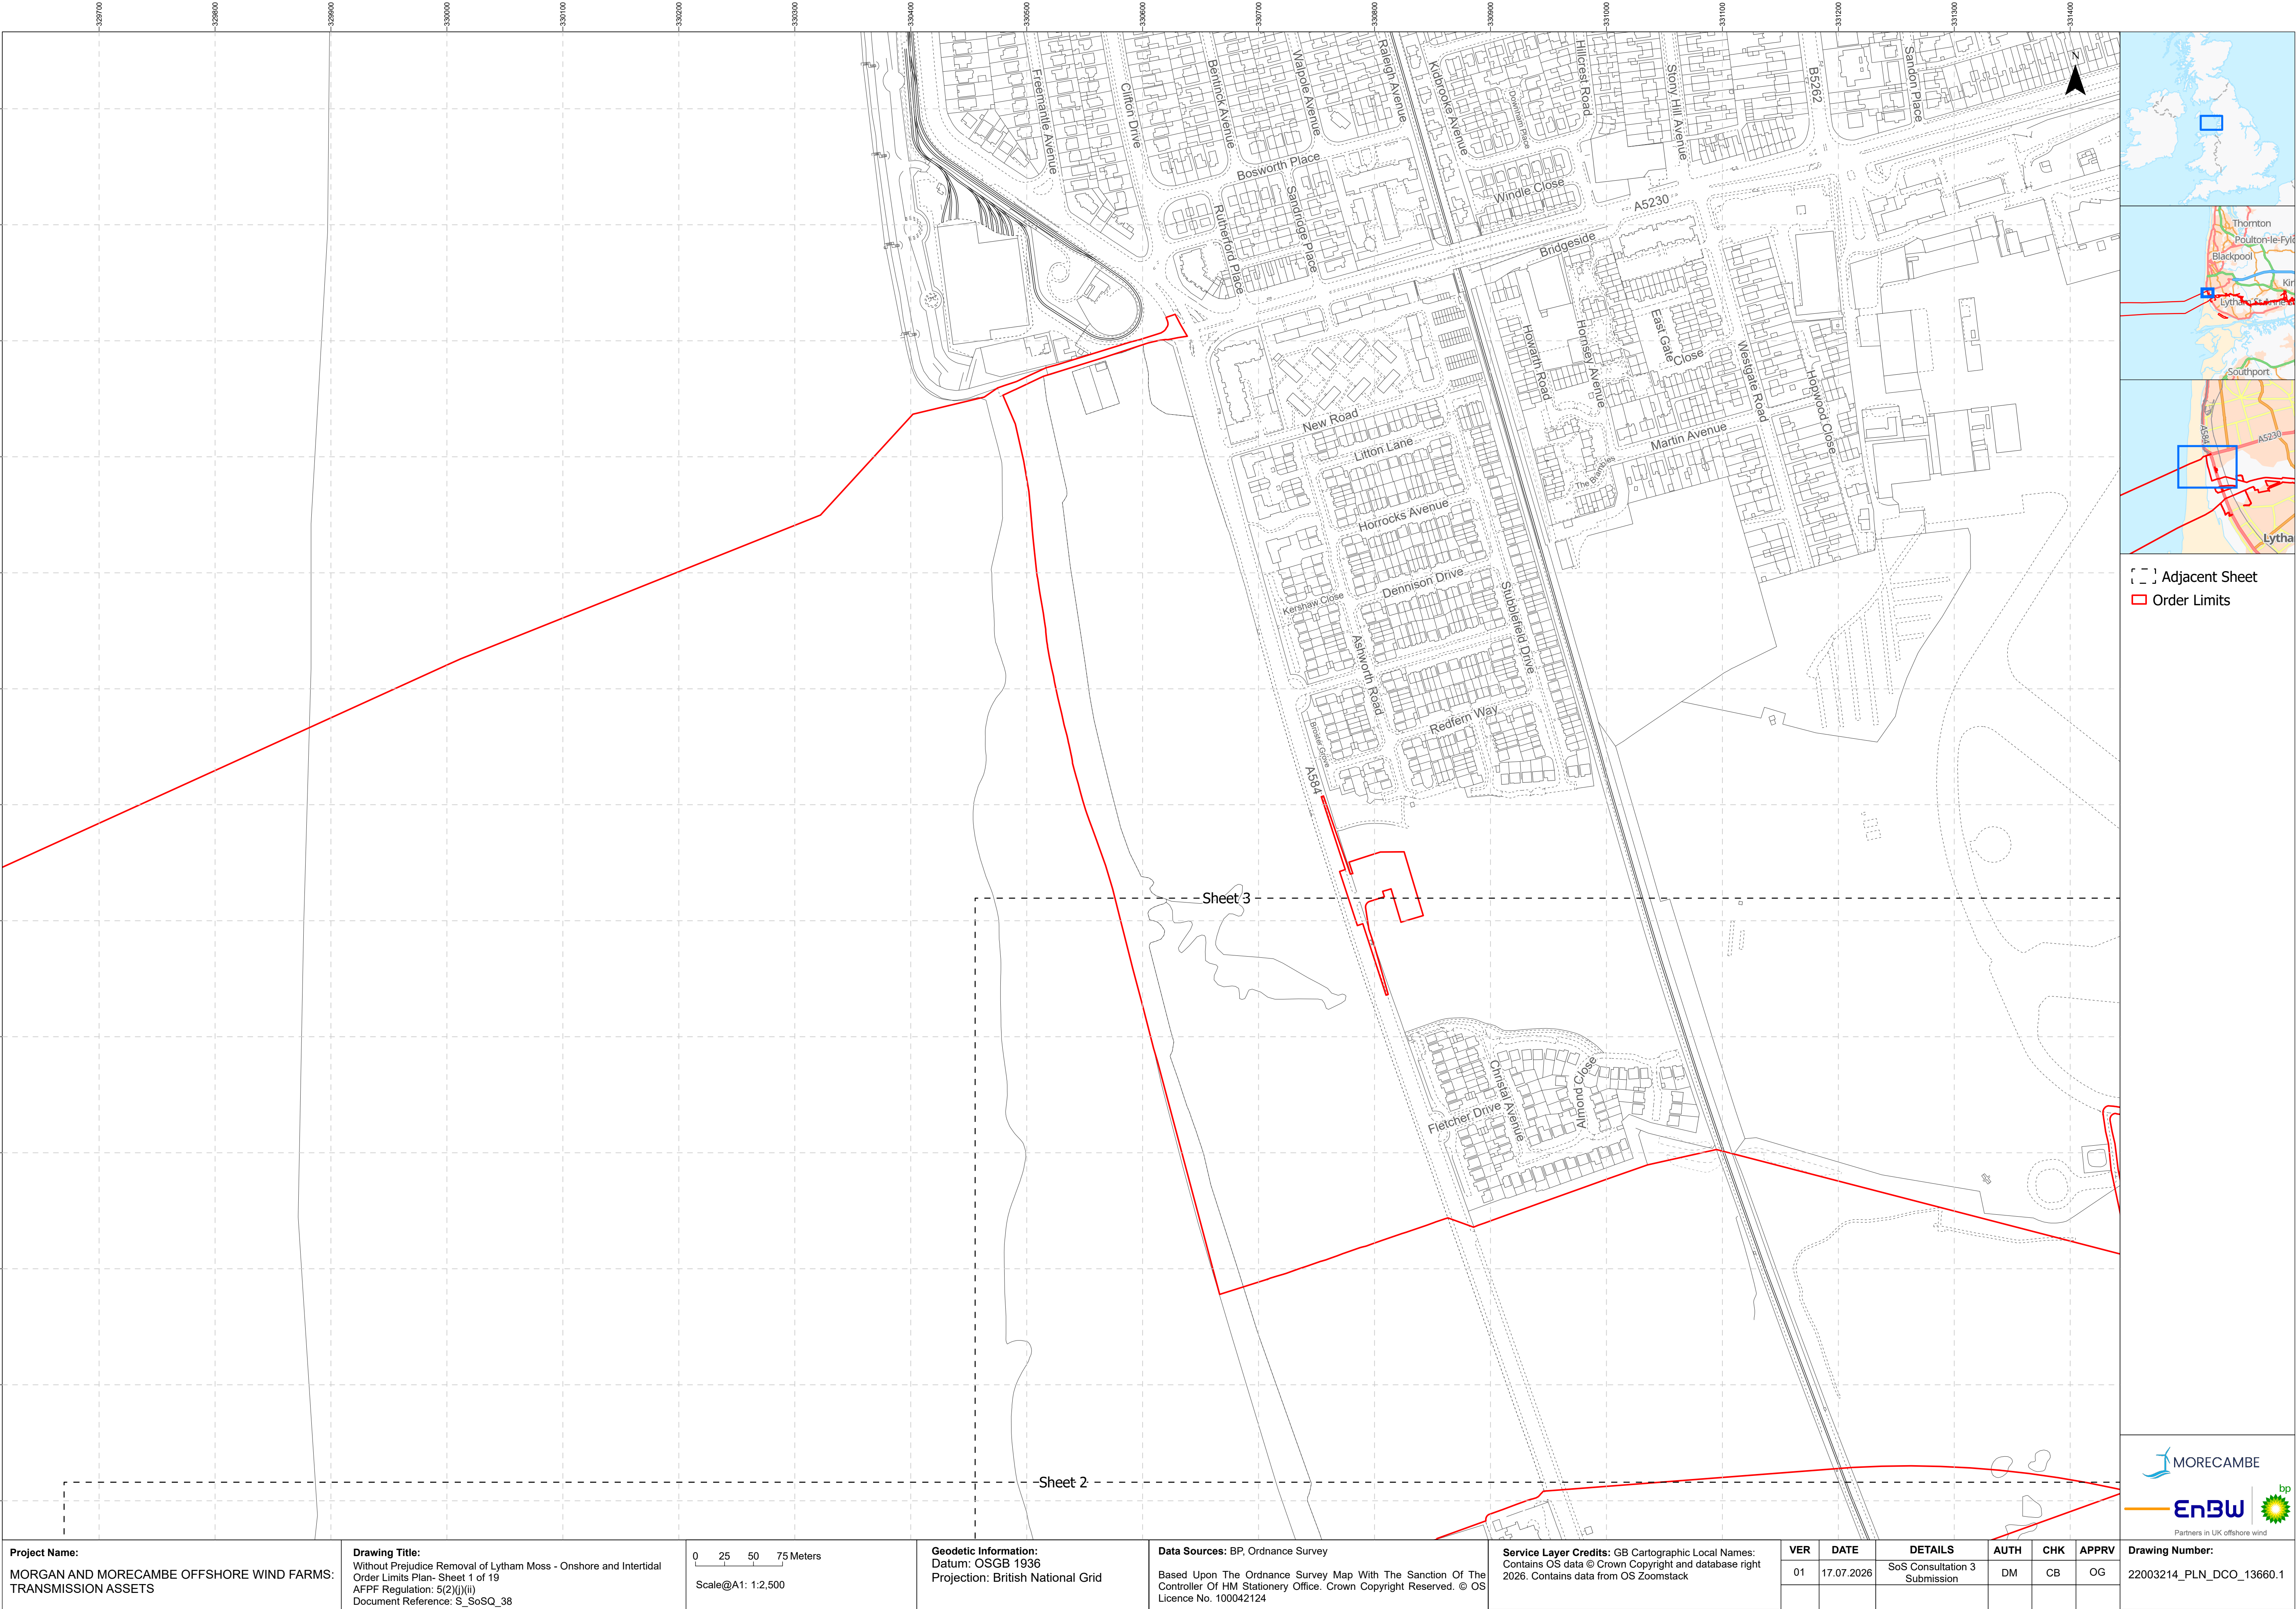

[] Adjacent Sheet
[] Order Limits

Project Name:
MORGAN AND MORECAMBE OFFSHORE WIND FARMS:
TRANSMISSION ASSETS

Drawing Title:
Without Prejudice Removal of Lytham Moss - Onshore and Intertidal
Order Limits Plan- Sheet 1 of 19
AFPF Regulation: 5(2)(j)(ii)
Document Reference: S_SoSQ_38

0 25 50 75 Meters
Scale@A1: 1:2,500

Geodetic Information:
Datum: OSGB 1936
Projection: British National Grid


Data Sources: BP, Ordnance Survey
Based Upon The Ordnance Survey Map With The Sanction Of The
Controller Of HM Stationery Office. Crown Copyright Reserved. © OS
Licence No. 100042124

Service Layer Credits: GB Cartographic Local Names:
Contains OS data © Crown Copyright and database right
2026. Contains data from OS Zoomstack

VER	DATE	DETAILS	AUTH	CHK	APPRV
01	17.07.2026	SoS Consultation 3 Submission	DM	CB	OG




Drawing Number:
22003214_PLN_DCO_13660.1

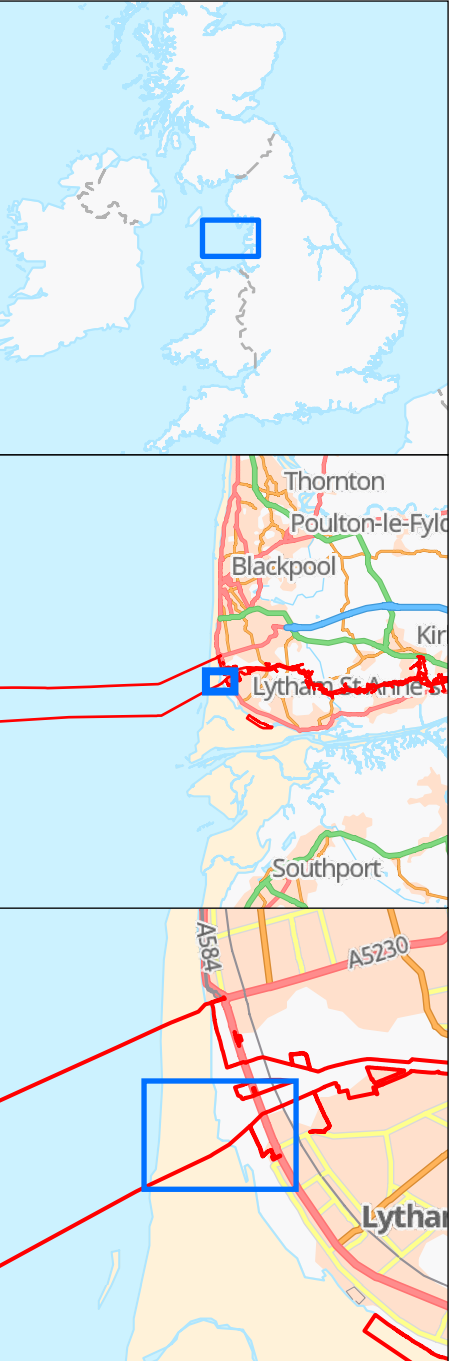

[] Adjacent Sheet
[] Order Limits

Project Name: MORGAN AND MORECAMBE OFFSHORE WIND FARMS: TRANSMISSION ASSETS	Drawing Title: Without Prejudice Removal of Lytham Moss - Onshore and Intertidal Order Limits Plan- Sheet 2 of 19 AFPF Regulation: 5(2)(j)(ii) Document Reference: S_SoSQ_38	0255075Meters Scale@A1: 1:2,500	Geodetic Information: Datum: OSGB 1936 Projection: British National Grid	Data Sources: BP, Ordnance Survey Based Upon The Ordnance Survey Map With The Sanction Of The Controller Of HM Stationery Office. Crown Copyright Reserved. © OS Licence No. 100042124	Service Layer Credits: GB Cartographic Local Names: Contains OS data © Crown Copyright and database right 2026. Contains data from OS Zoomstack	VER	DATE	DETAILS	AUTH	CHK	APPRV	Drawing Number: 22003214_PLN_DCO_13660.2
						01	17.07.2026	SoS Consultation 3 Submission	DM	CB	OG	



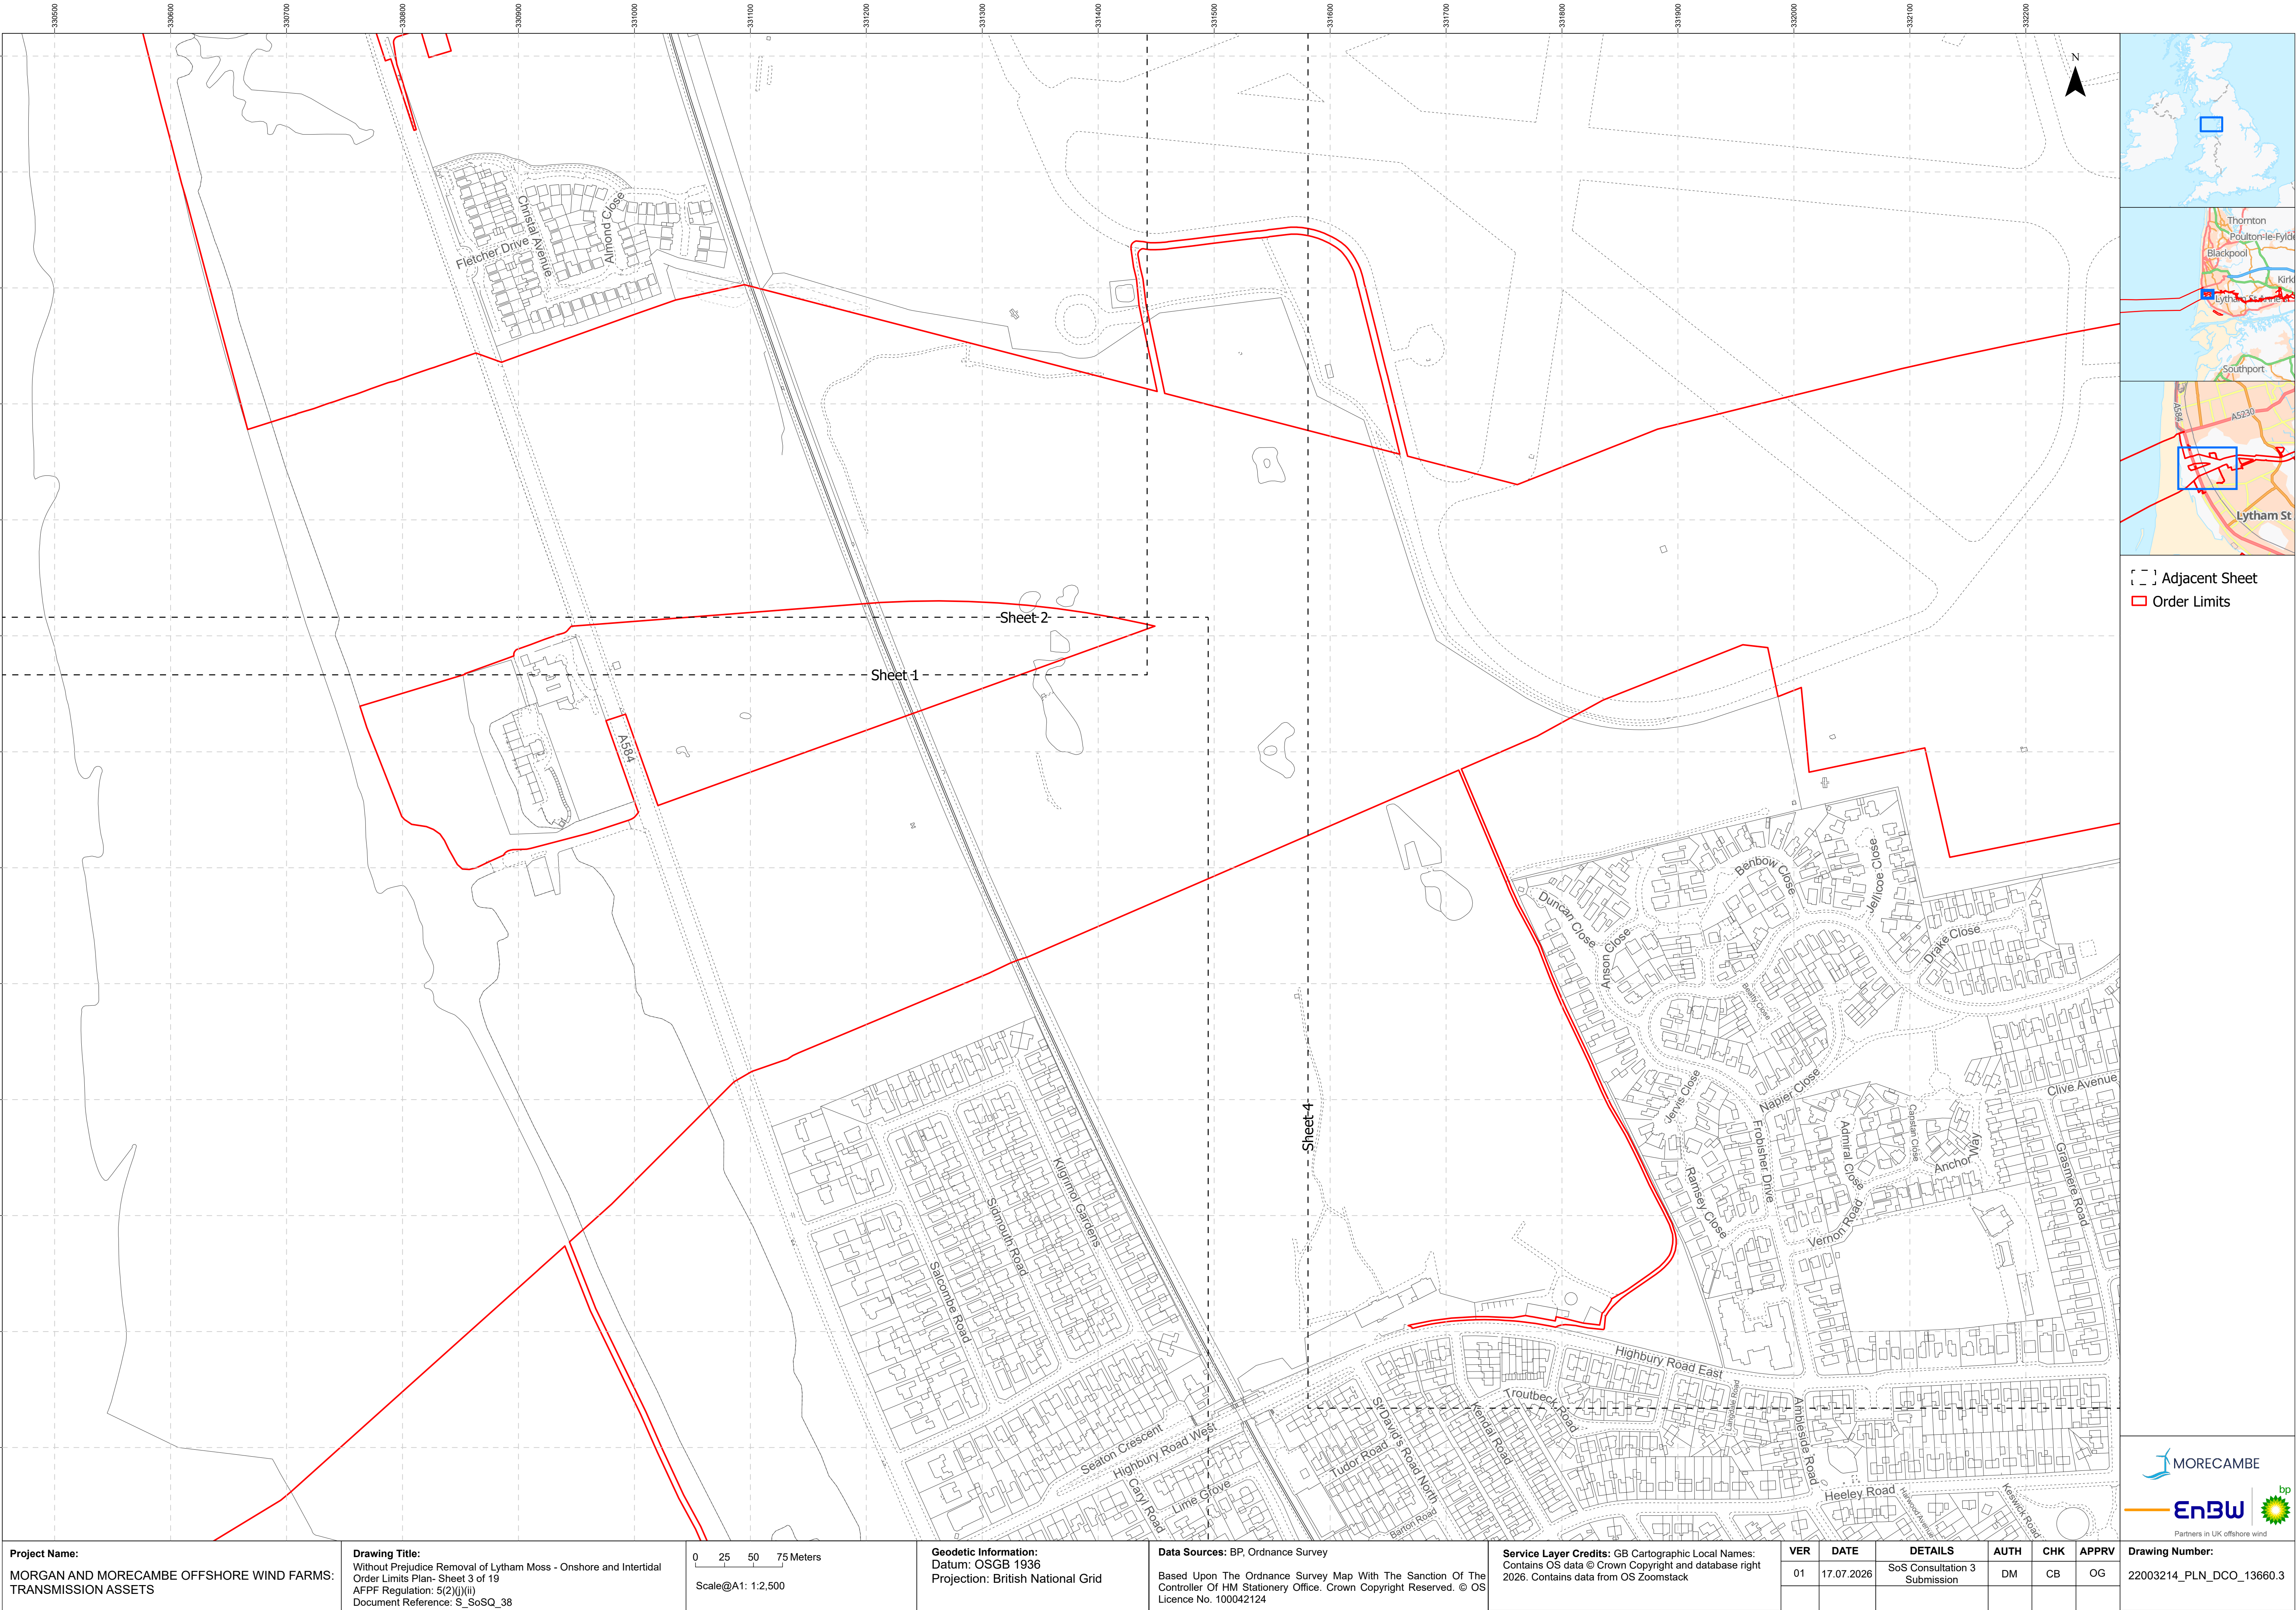

Project Name:
MORGAN AND MORECAMBE OFFSHORE WIND FARMS:
TRANSMISSION ASSETS

Drawing Title:
Without Prejudice Removal of Lytham Moss - Onshore and Intertidal
Order Limits Plan- Sheet 3 of 19
AFPF Regulation: 5(2)(j)(ii)
Document Reference: S_SoSQ_38

0 25 50 75 Meters
Scale@A1: 1:2,500

Geodetic Information:
Datum: OSGB 1936
Projection: British National Grid




Data Sources: BP, Ordnance Survey
Based Upon The Ordnance Survey Map With The Sanction Of The
Controller Of HM Stationery Office. Crown Copyright Reserved. © OS
Licence No. 100042124

Service Layer Credits: GB Cartographic Local Names:
Contains OS data © Crown Copyright and database right
2026. Contains data from OS Zoomstack

VER	DATE	DETAILS	AUTH	CHK	APPRV
01	17.07.2026	SoS Consultation 3 Submission	DM	CB	OG

Drawing Number:
22003214_PLN_DCO_13660.3



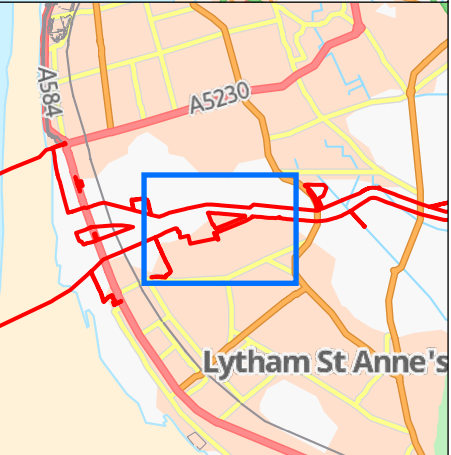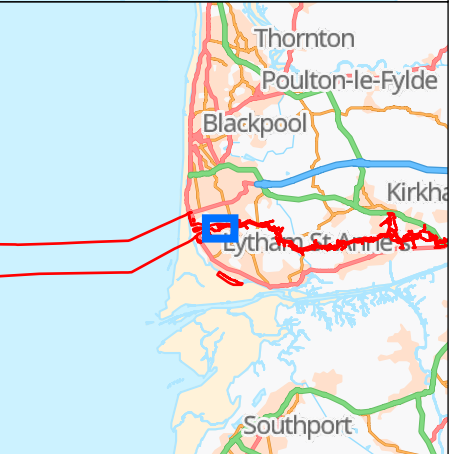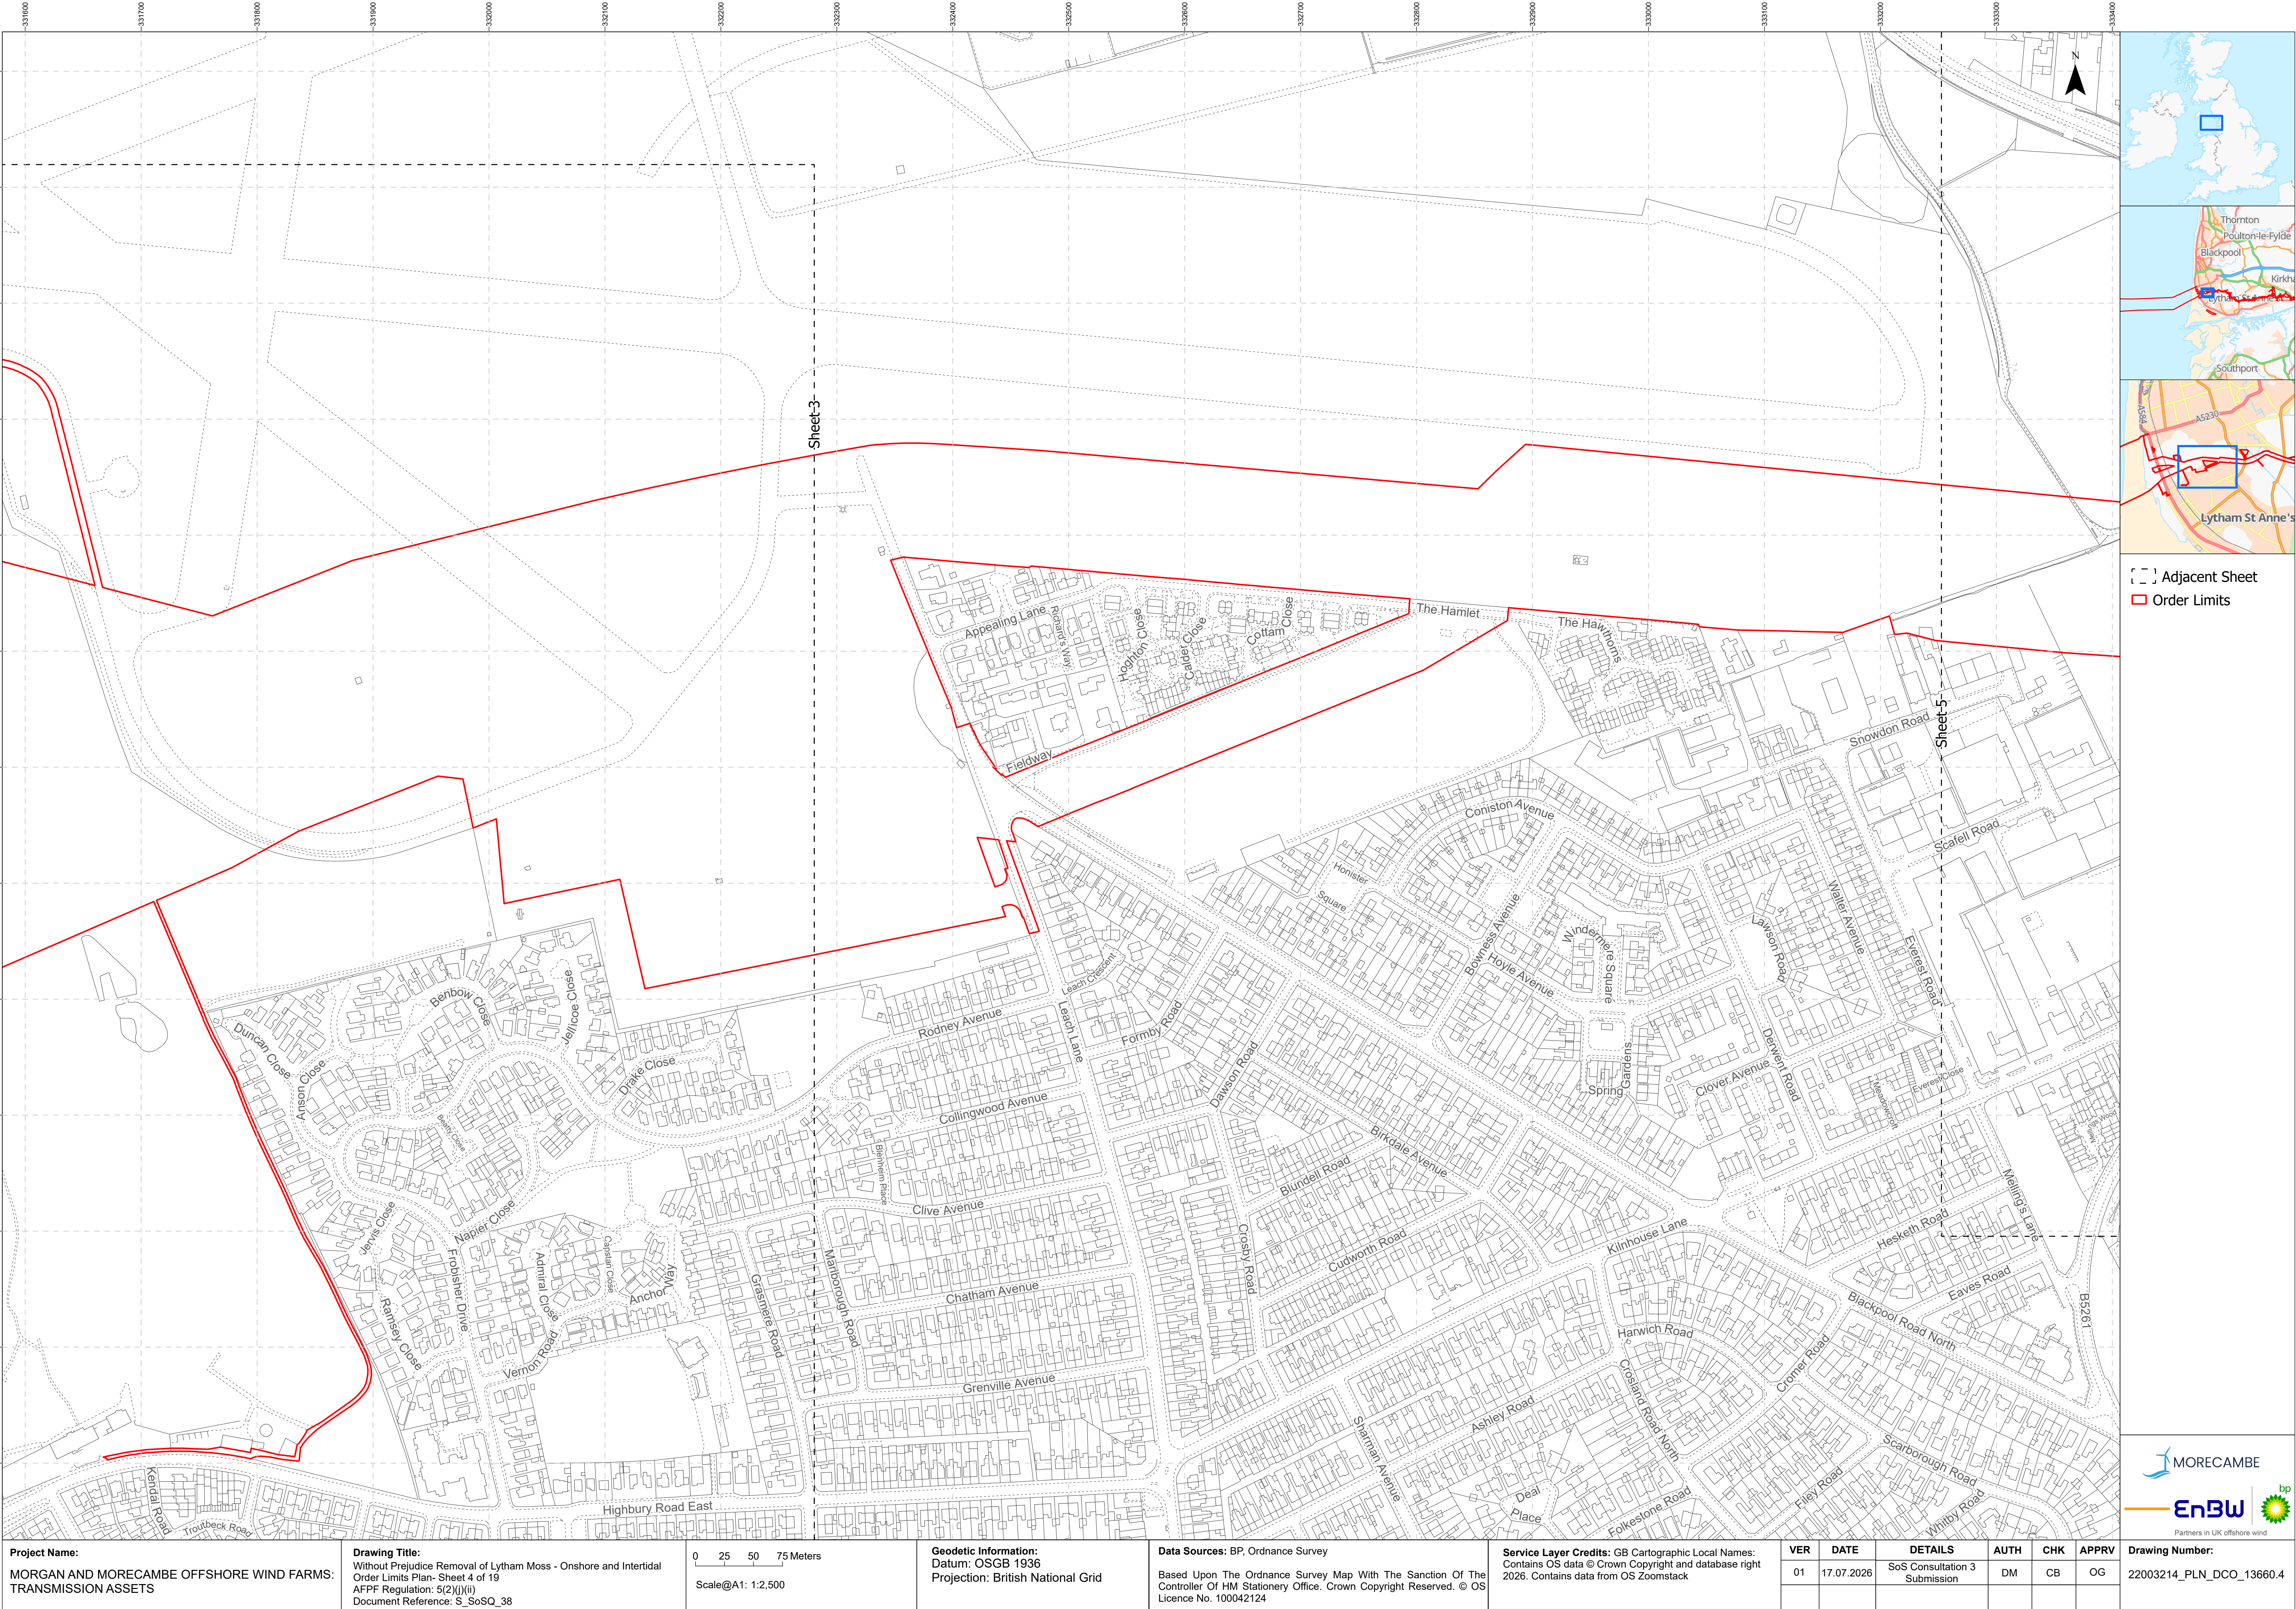

[] Adjacent Sheet
[] Order Limits

Project Name:
MORGAN AND MORECAMBE OFFSHORE WIND FARMS:
TRANSMISSION ASSETS

Drawing Title:
Without Prejudice Removal of Lytham Moss - Onshore and Intertidal
Order Limits Plan- Sheet 4 of 19
AFPF Regulation: 5(2)(ii)
Document Reference: S_SoSQ_38

0 25 50 75 Meters
Scale@A1: 1:2,500

Geodetic Information:
Datum: OSGB 1936
Projection: British National Grid



Data Sources: BP, Ordnance Survey
Based Upon The Ordnance Survey Map With The Sanction Of The
Controller Of HM Stationery Office. Crown Copyright Reserved. © OS
Licence No. 100042124

Service Layer Credits: GB Cartographic Local Names:
Contains OS data © Crown Copyright and database right
2026. Contains data from OS Zoomstack

VER	DATE	DETAILS	AUTH	CHK	APPRV
01	17.07.2026	SoS Consultation 3 Submission	DM	CB	OG



Drawing Number:
22003214_PLN_DCO_13660.4

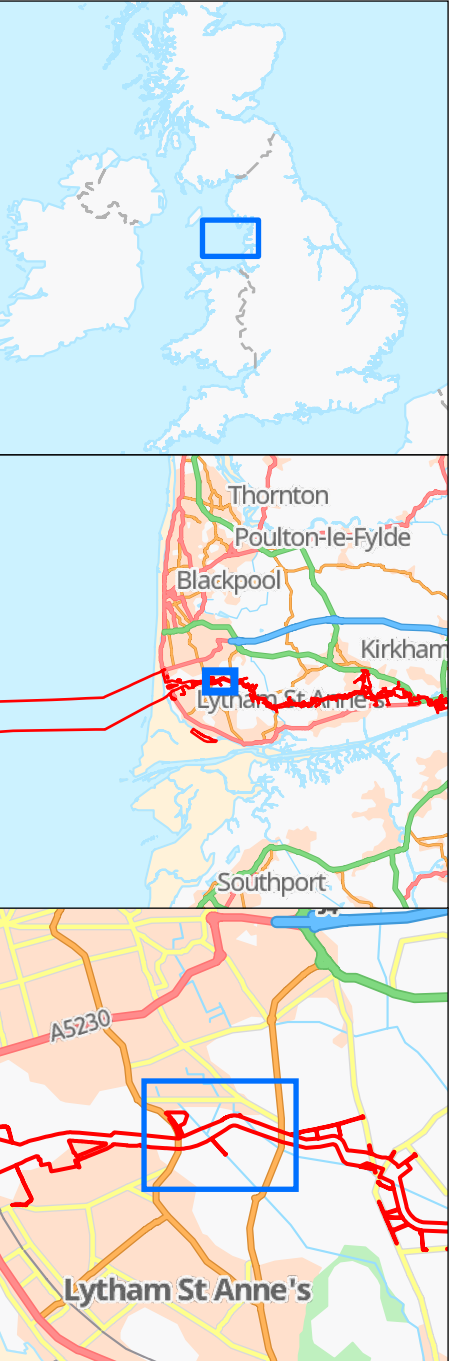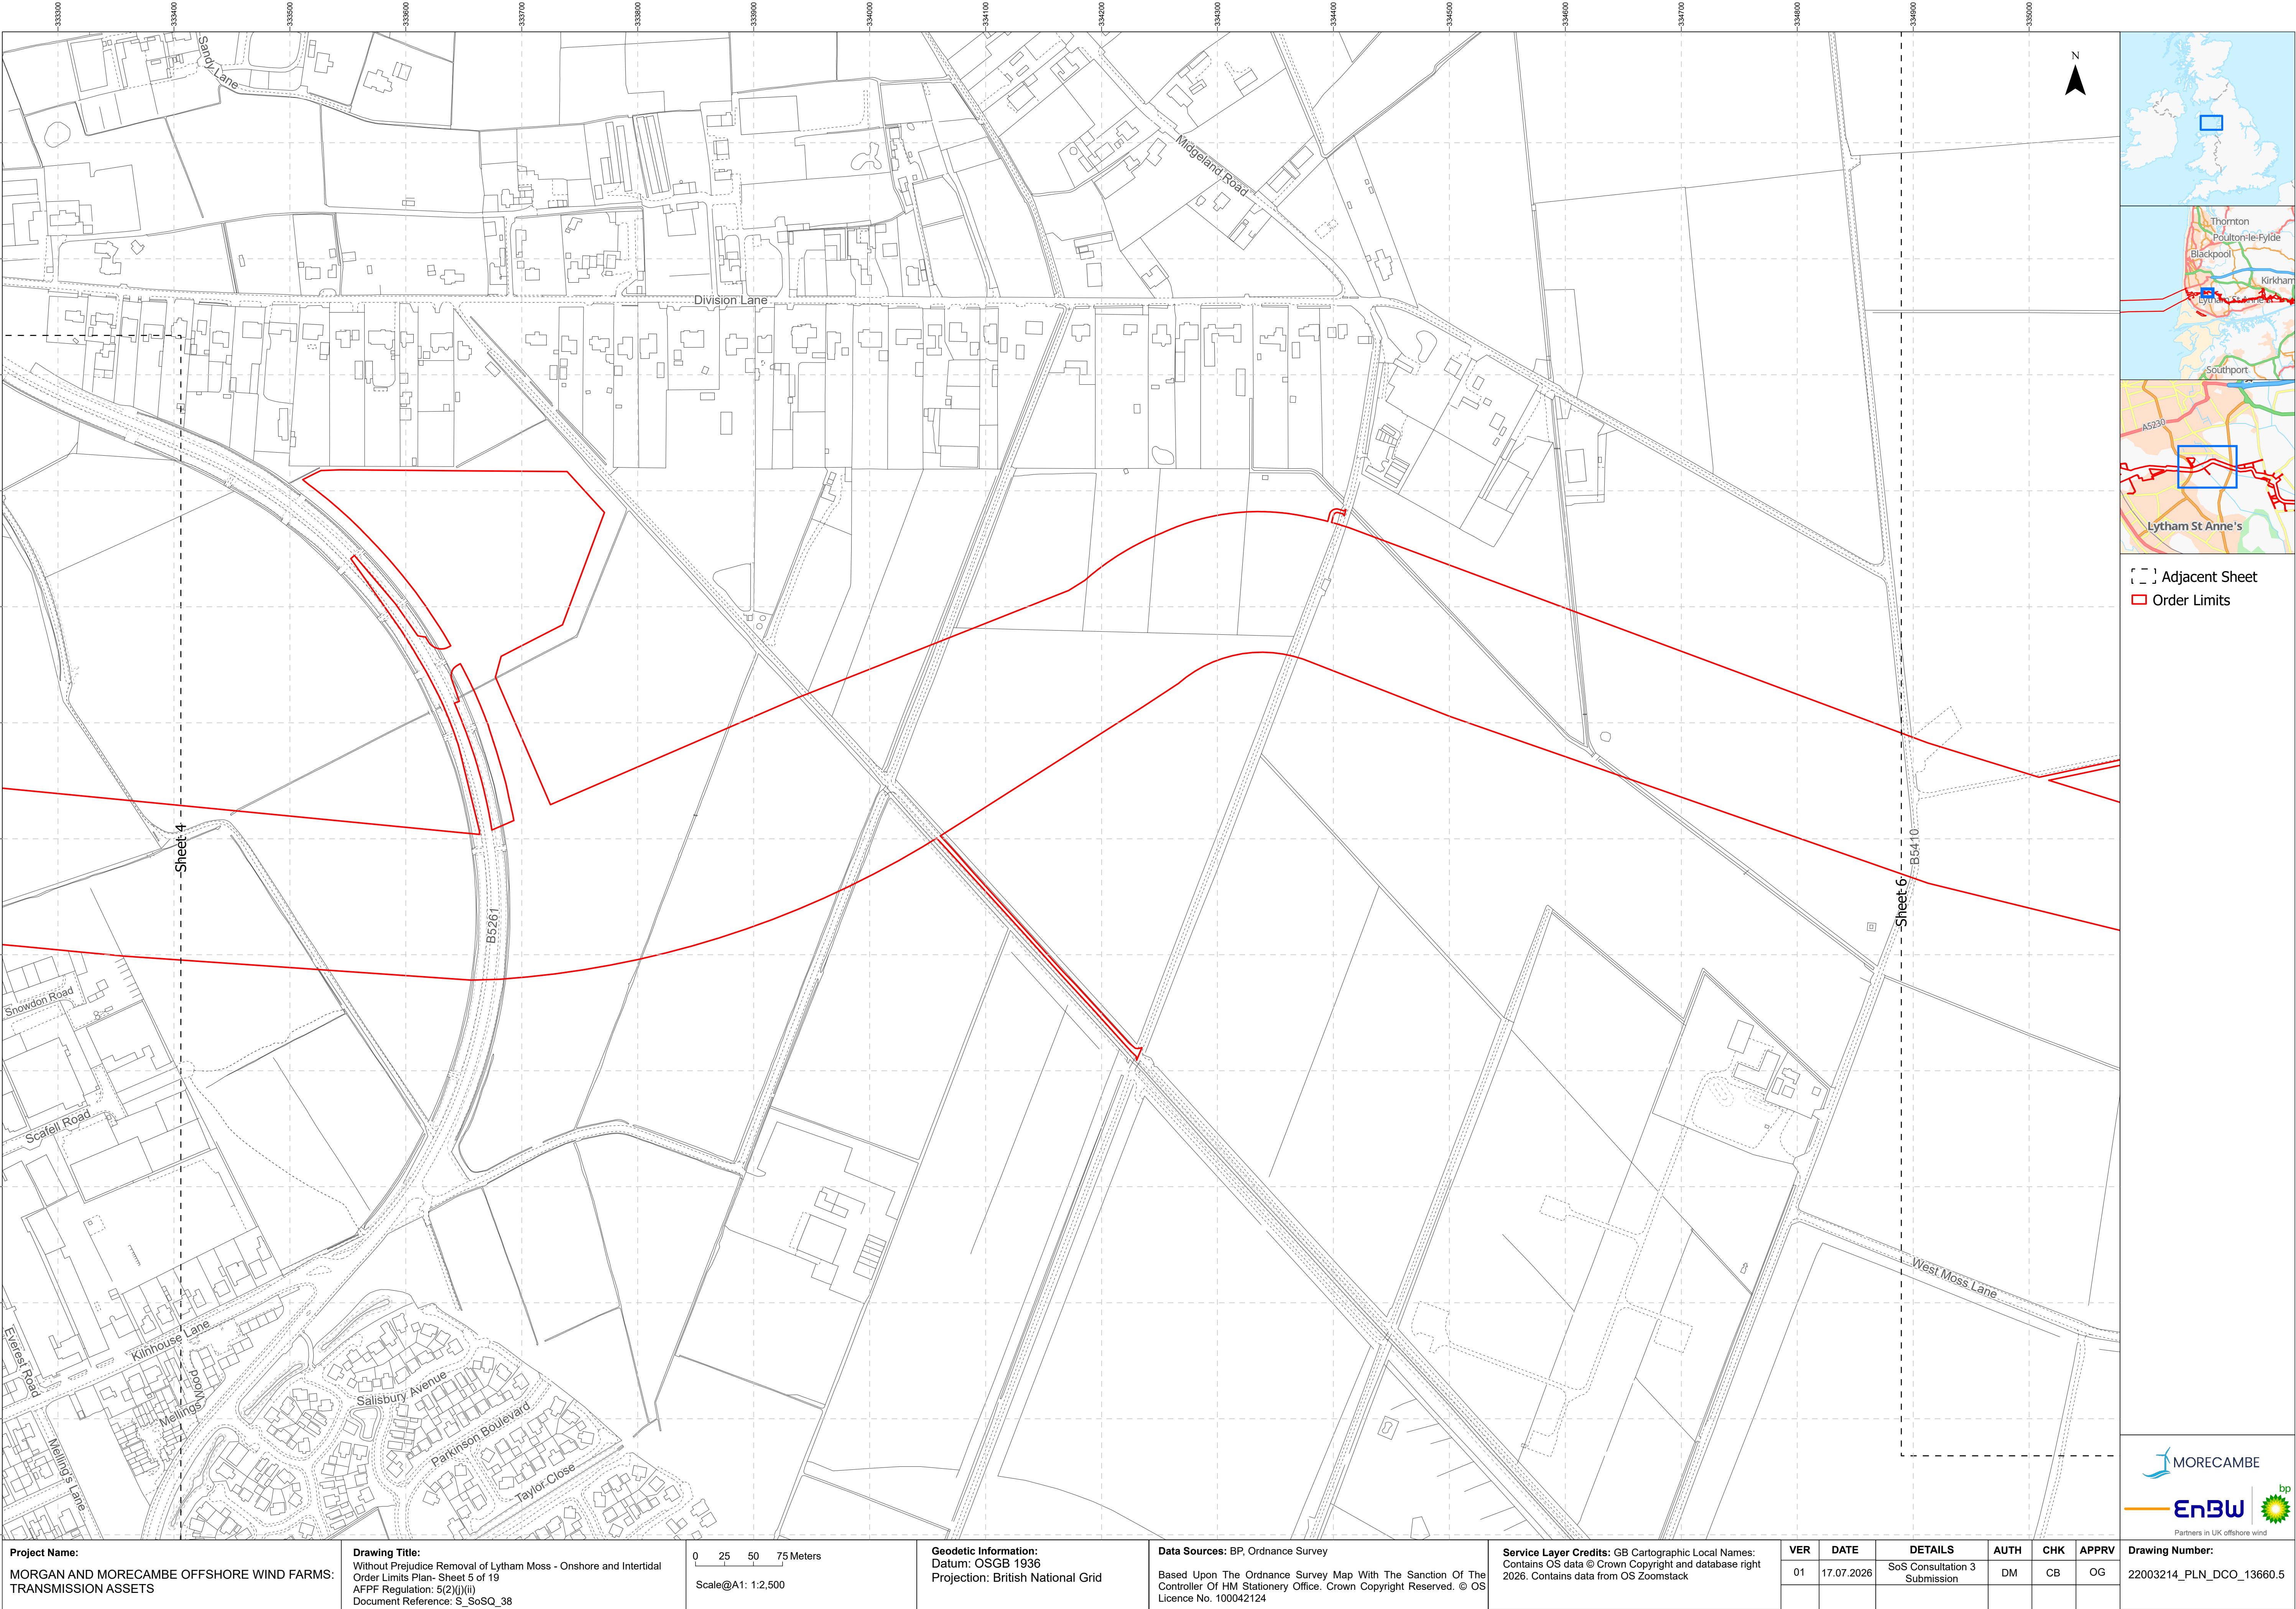

[] Adjacent Sheet
[] Order Limits



Project Name:
MORGAN AND MORECAMBE OFFSHORE WIND FARMS:
TRANSMISSION ASSETS

Drawing Title:
Without Prejudice Removal of Lytham Moss - Onshore and Intertidal
Order Limits Plan- Sheet 5 of 19
AFPF Regulation: 5(2)(j)(ii)
Document Reference: S_SoSQ_38

0 25 50 75 Meters
Scale@A1: 1:2,500



Geodetic Information:
Datum: OSGB 1936
Projection: British National Grid

Data Sources: BP, Ordnance Survey
Based Upon The Ordnance Survey Map With The Sanction Of The
Controller Of HM Stationery Office. Crown Copyright Reserved. © OS
Licence No. 100042124

Service Layer Credits: GB Cartographic Local Names:
Contains OS data © Crown Copyright and database right
2026. Contains data from OS Zoomstack

VER	DATE	DETAILS	AUTH	CHK	APPRV
01	17.07.2026	SoS Consultation 3 Submission	DM	CB	OG

Drawing Number:
22003214_PLN_DCO_13660.5

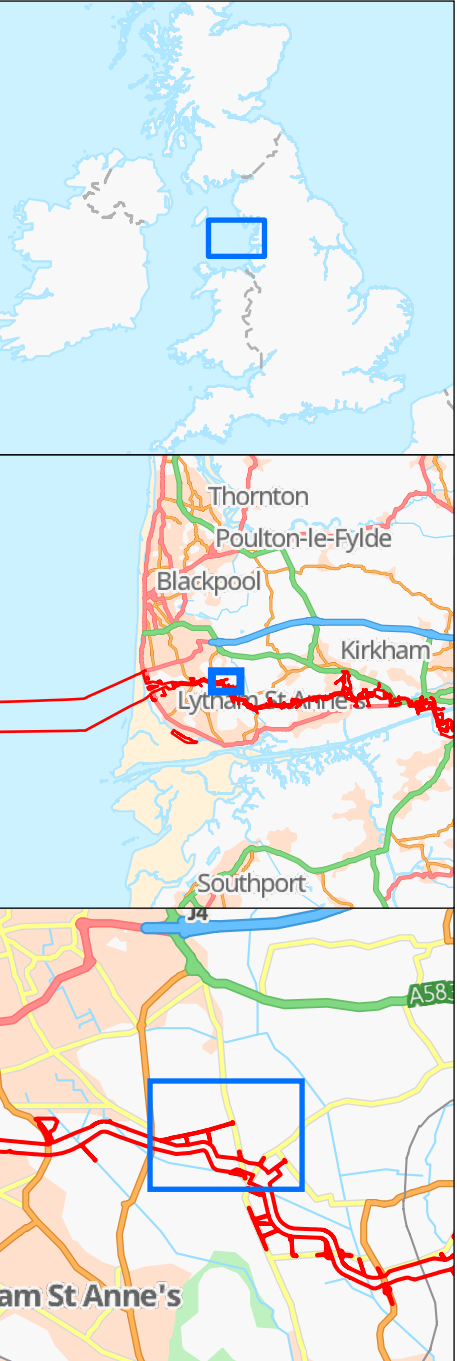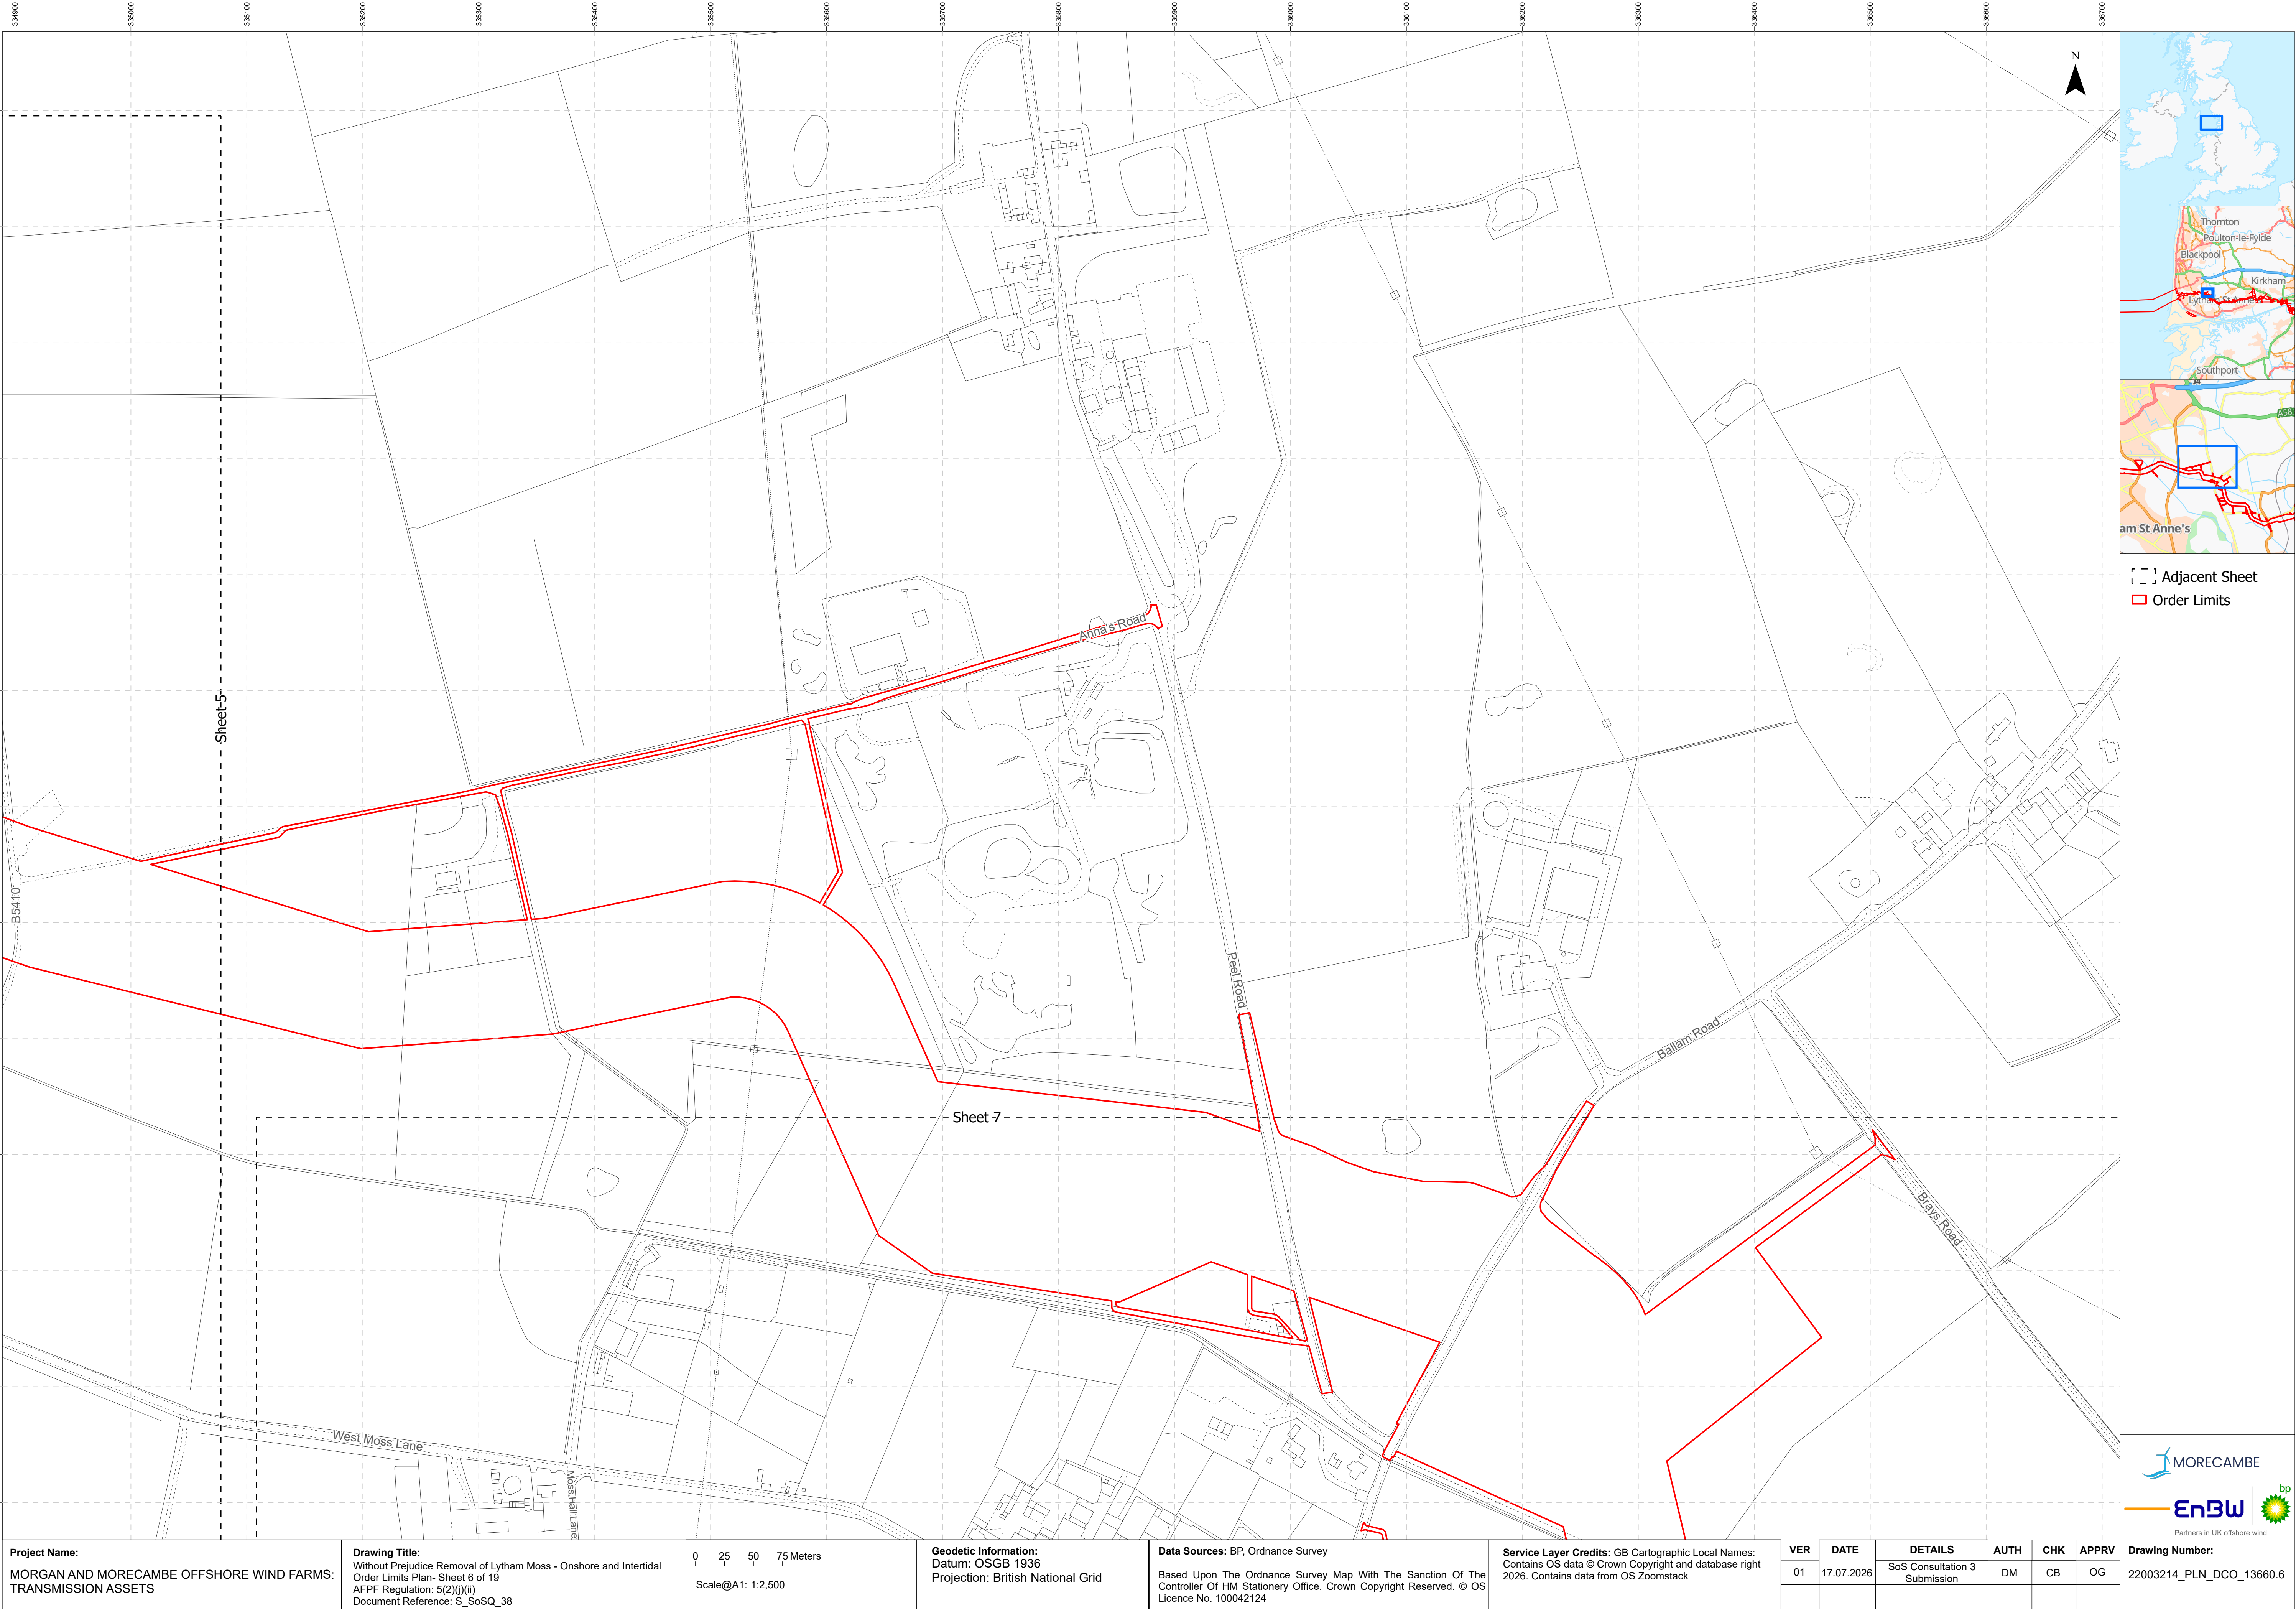

[] Adjacent Sheet
[red line] Order Limits

Project Name:
MORGAN AND MORECAMBE OFFSHORE WIND FARMS:
TRANSMISSION ASSETS

Drawing Title:
Without Prejudice Removal of Lytham Moss - Onshore and Intertidal
Order Limits Plan- Sheet 6 of 19
AFPF Regulation: S(2)(j)(ii)
Document Reference: S_SoSQ_38

0 25 50 75 Meters
Scale@A1: 1:2,500

Geodetic Information:
Datum: OSGB 1936
Projection: British National Grid



Data Sources: BP, Ordnance Survey
Based Upon The Ordnance Survey Map With The Sanction Of The
Controller Of HM Stationery Office. Crown Copyright Reserved. © OS
Licence No. 100042124

Service Layer Credits: GB Cartographic Local Names:
Contains OS data © Crown Copyright and database right
2026. Contains data from OS Zoomstack

VER	DATE	DETAILS	AUTH	CHK	APPRV
01	17.07.2026	SoS Consultation 3 Submission	DM	CB	OG



Drawing Number:
22003214_PLN_DCO_13660.6

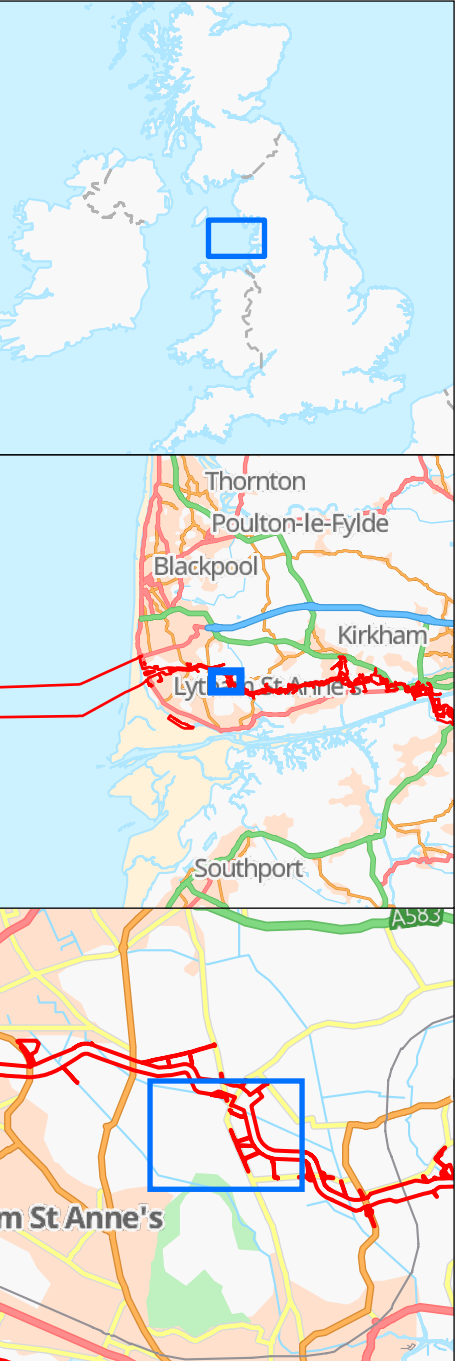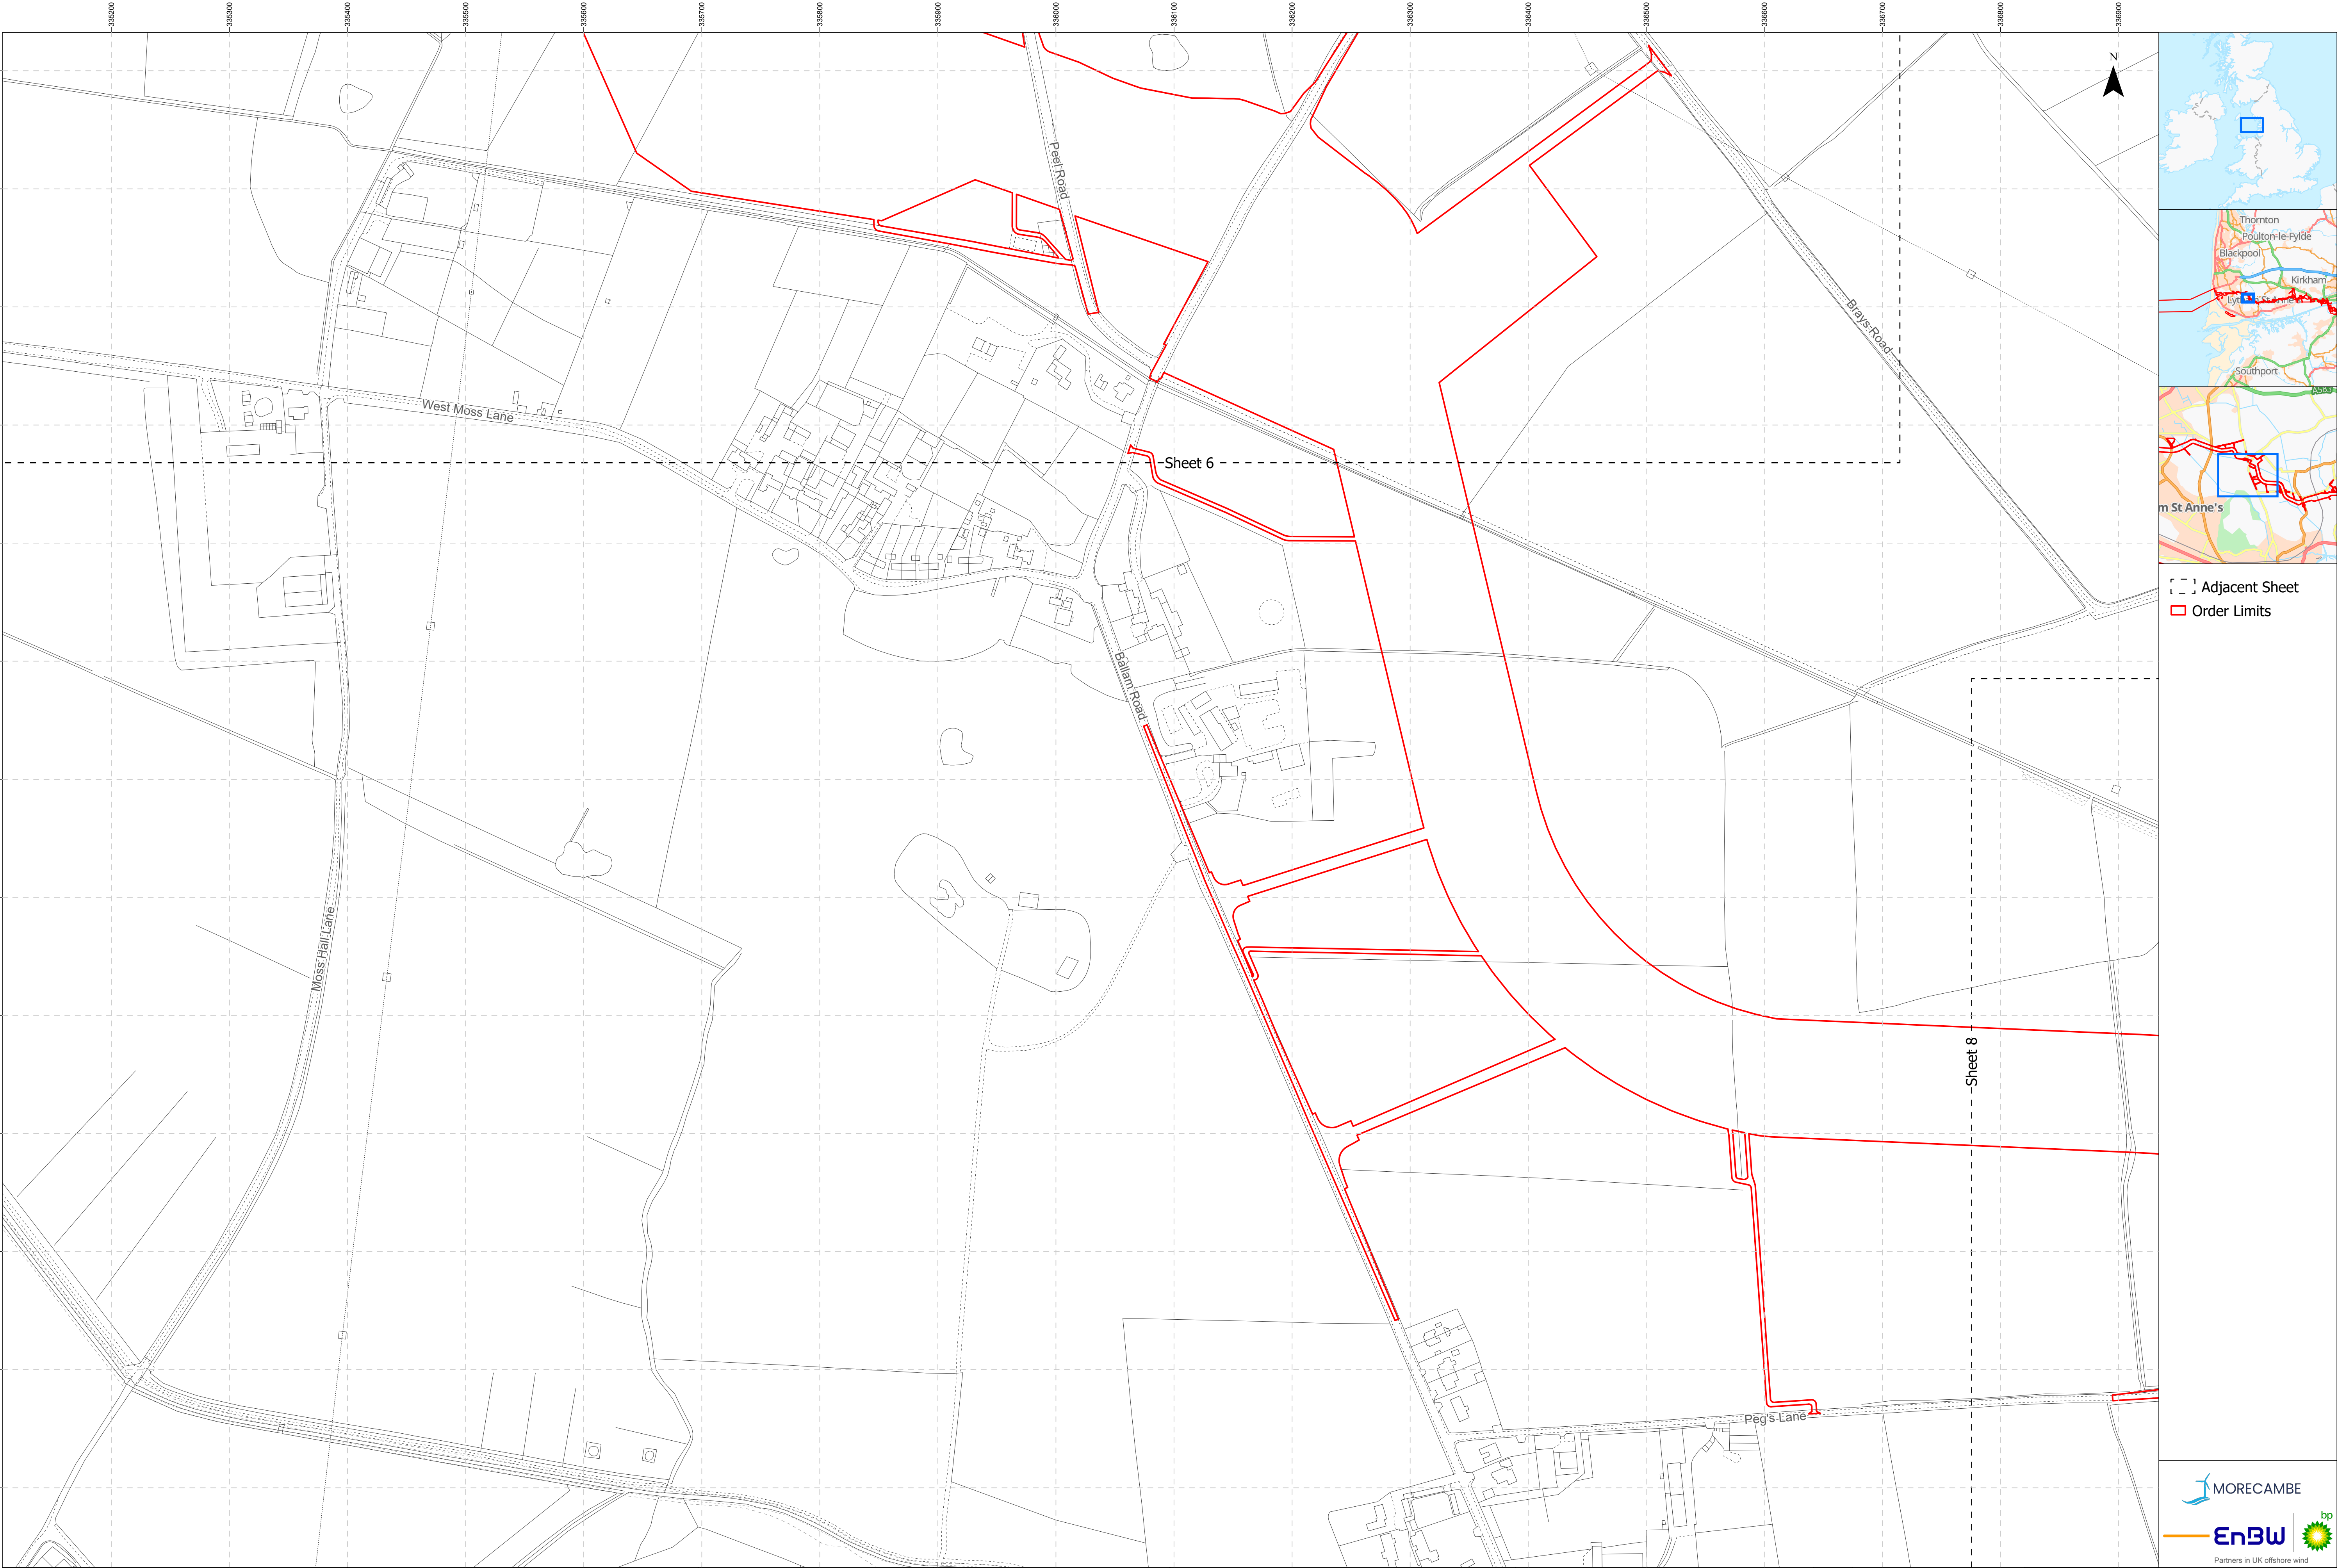

[- - -] Adjacent Sheet
[Red Line] Order Limits

Project Name:
MORGAN AND MORECAMBE OFFSHORE WIND FARMS:
TRANSMISSION ASSETS

Drawing Title:
Without Prejudice Removal of Lytham Moss - Onshore and Intertidal
Order Limits Plan- Sheet 7 of 19
AFPF Regulation: 5(2)(j)(ii)
Document Reference: S_SoSQ_38

0 25 50 75 Meters
Scale@A1: 1:2,500

Geodetic Information:
Datum: OSGB 1936
Projection: British National Grid



Data Sources: BP, Ordnance Survey
Based Upon The Ordnance Survey Map With The Sanction Of The
Controller Of HM Stationery Office. Crown Copyright Reserved. © OS
Licence No. 100042124

Service Layer Credits: GB Cartographic Local Names:
Contains OS data © Crown Copyright and database right
2026. Contains data from OS Zoomstack

VER	DATE	DETAILS	AUTH	CHK	APPRV
01	17.07.2026	SoS Consultation 3 Submission	DM	CB	OG



Drawing Number:
22003214_PLN_DCO_13660.7

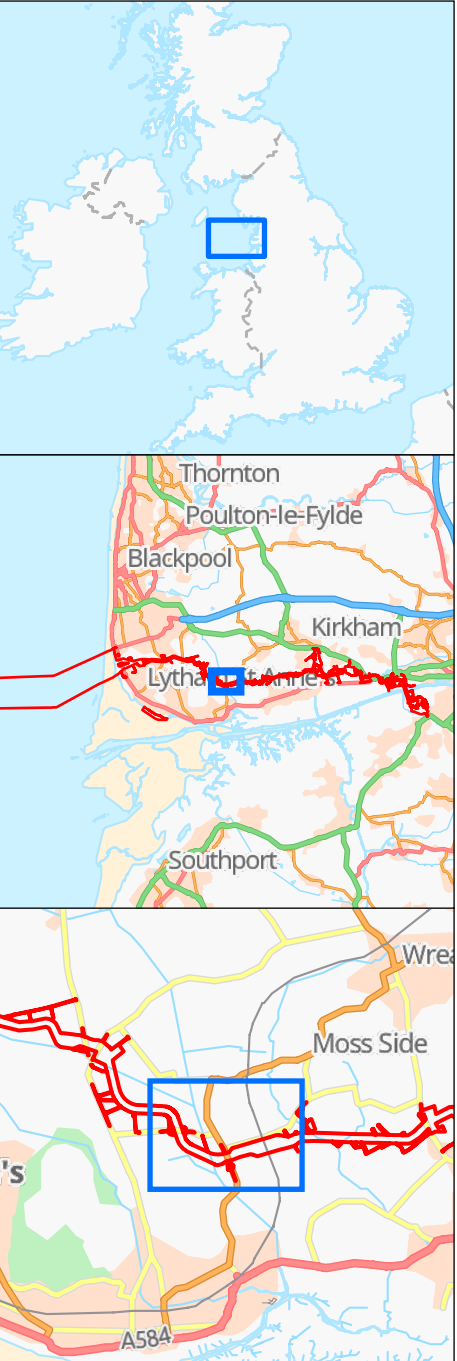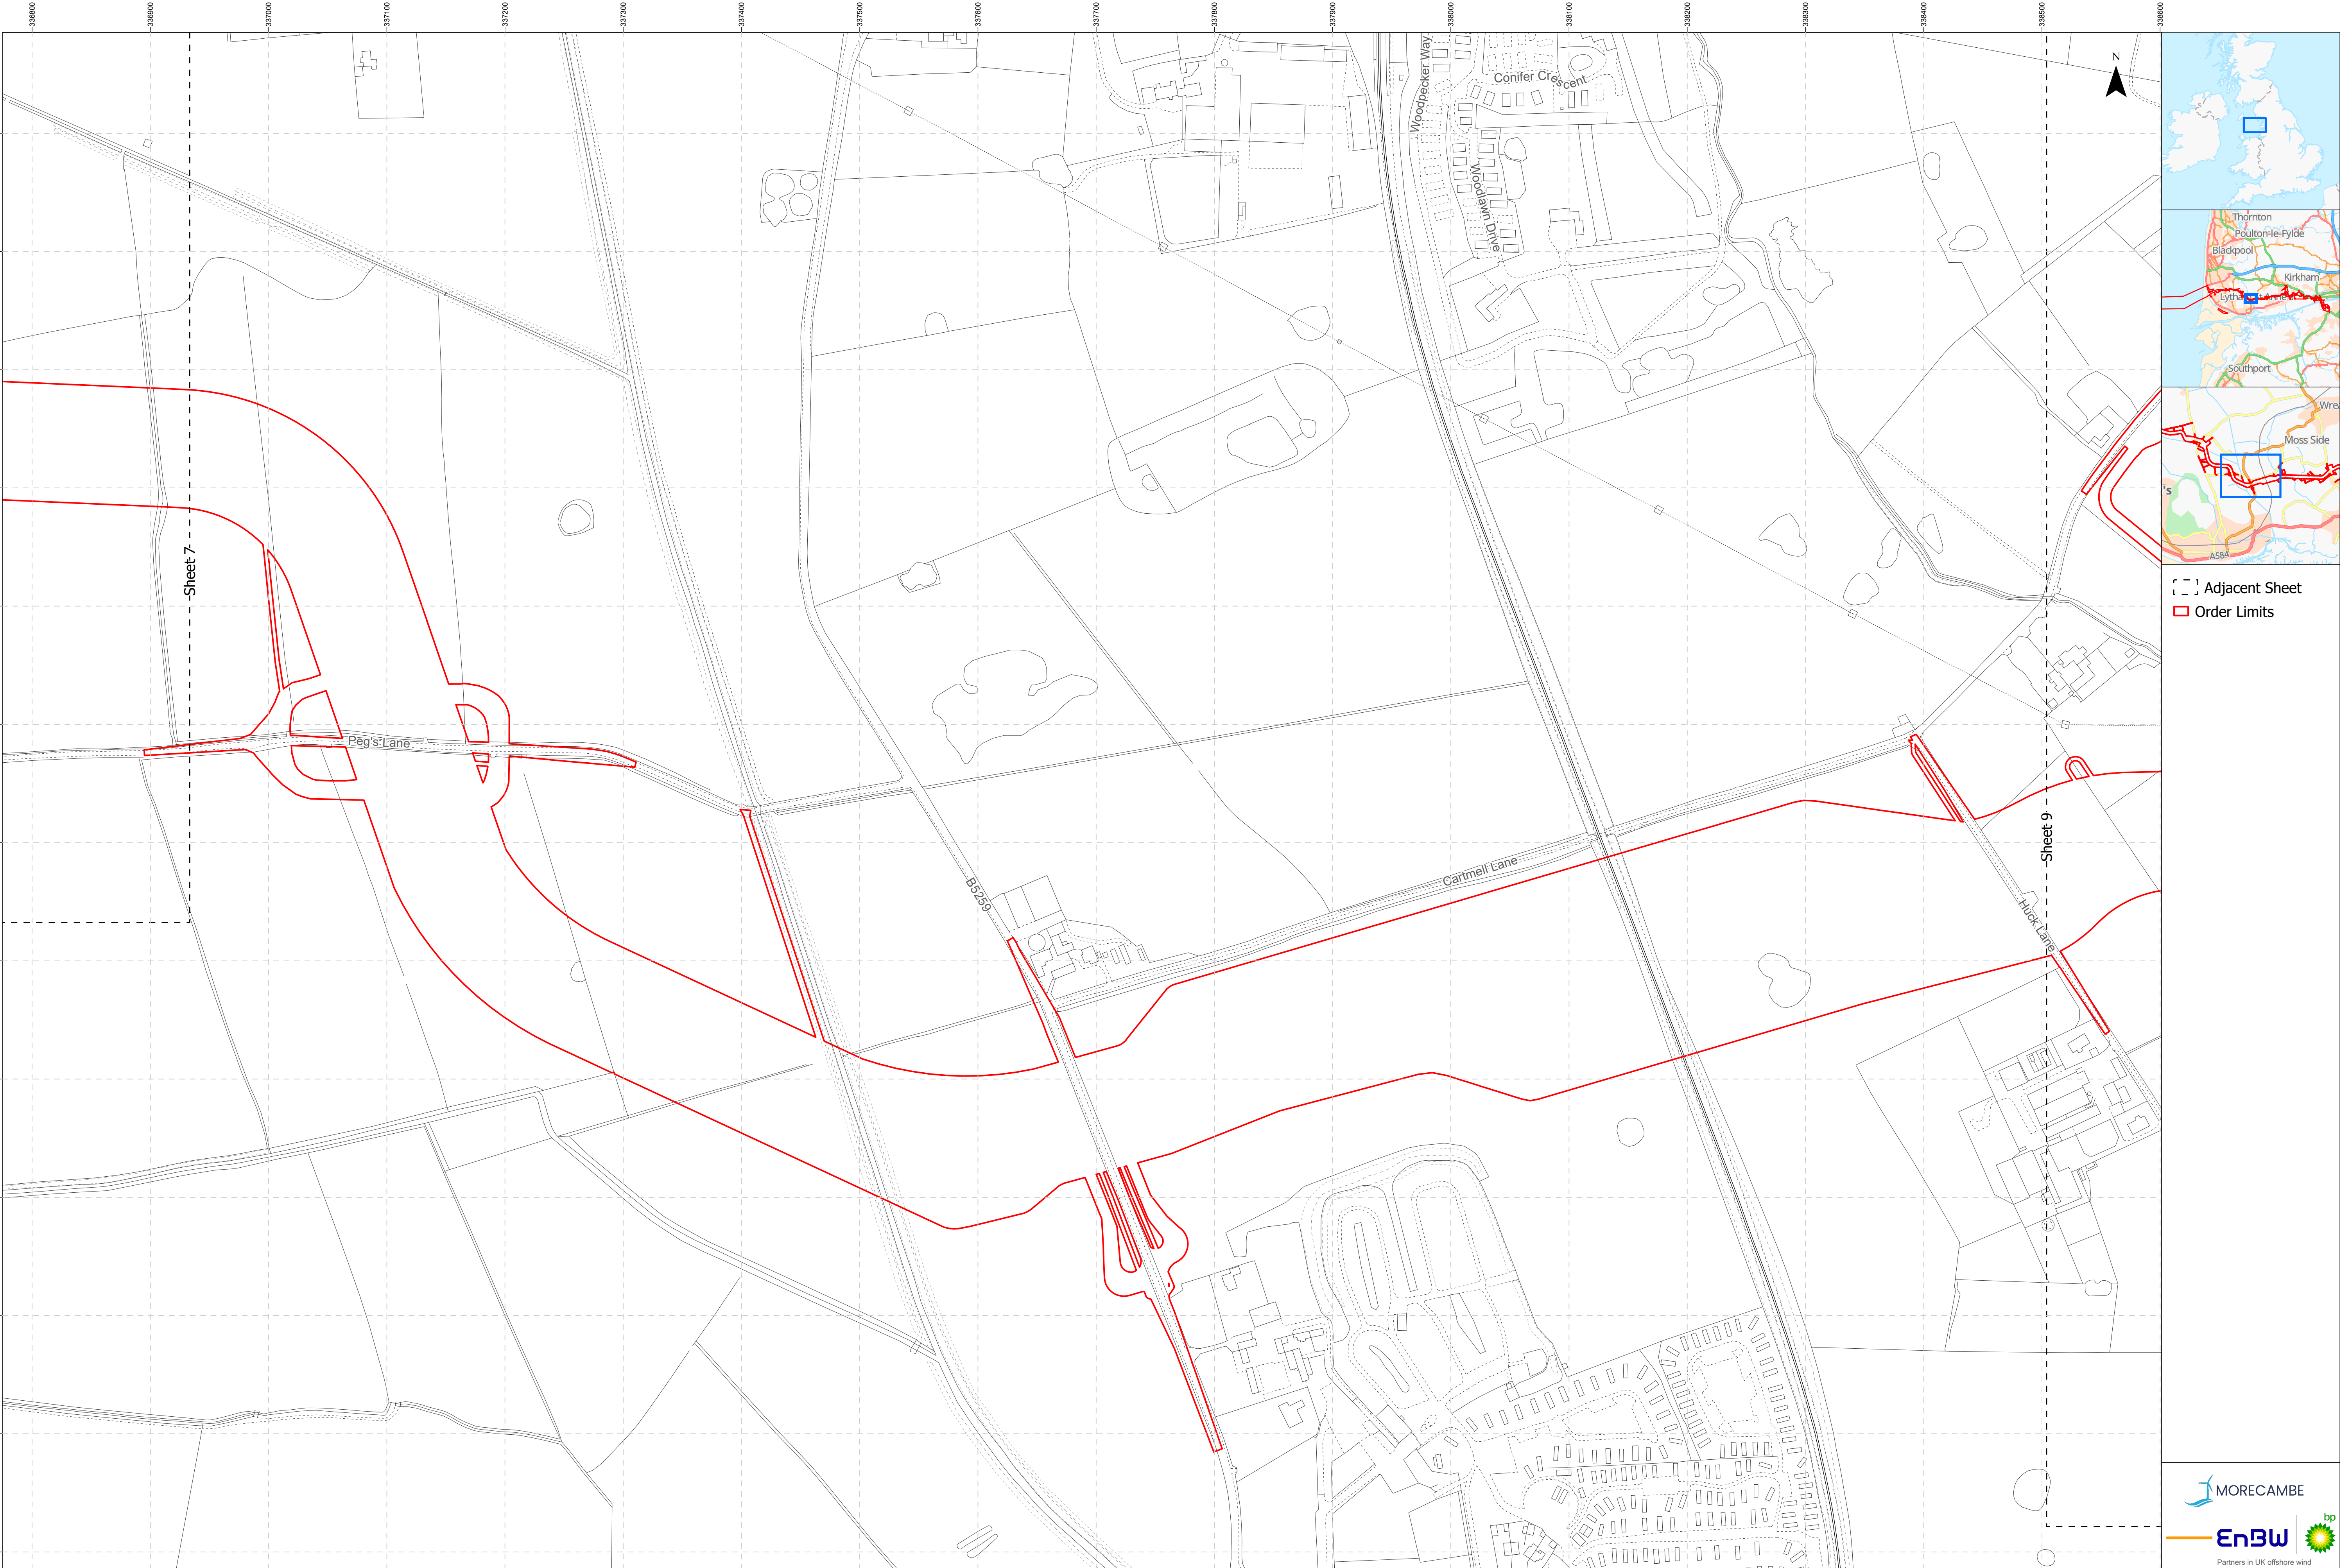

- [] Adjacent Sheet
- [] Order Limits



Project Name:
MORGAN AND MORECAMBE OFFSHORE WIND FARMS:
TRANSMISSION ASSETS

Drawing Title:
Without Prejudice Removal of Lytham Moss - Onshore and Intertidal
Order Limits Plan- Sheet 8 of 19
AFPF Regulation: 5(2)(j)(ii)
Document Reference: S_SoSQ_38

0 25 50 75 Meters
Scale@A1: 1:2,500



Geodetic Information:
Datum: OSGB 1936
Projection: British National Grid

Data Sources: BP, Ordnance Survey
Based Upon The Ordnance Survey Map With The Sanction Of The
Controller Of HM Stationery Office. Crown Copyright Reserved. © OS
Licence No. 100042124

Service Layer Credits: GB Cartographic Local Names:
Contains OS data © Crown Copyright and database right
2026. Contains data from OS Zoomstack

VER	DATE	DETAILS	AUTH	CHK	APPRV
01	17.07.2026	SoS Consultation 3 Submission	DM	CB	OG

Drawing Number:
22003214_PLN_DCO_13660.8

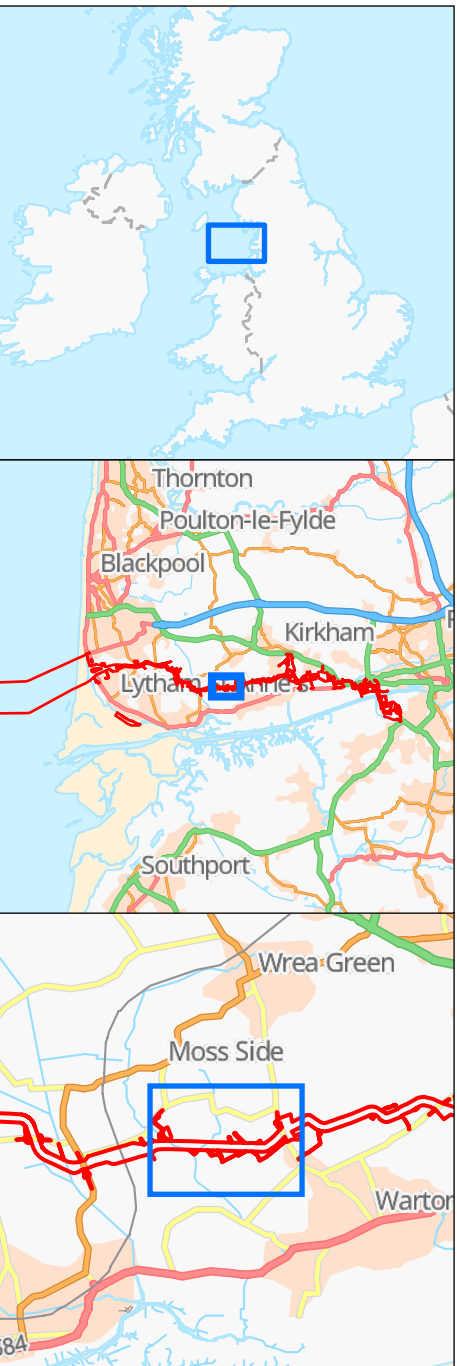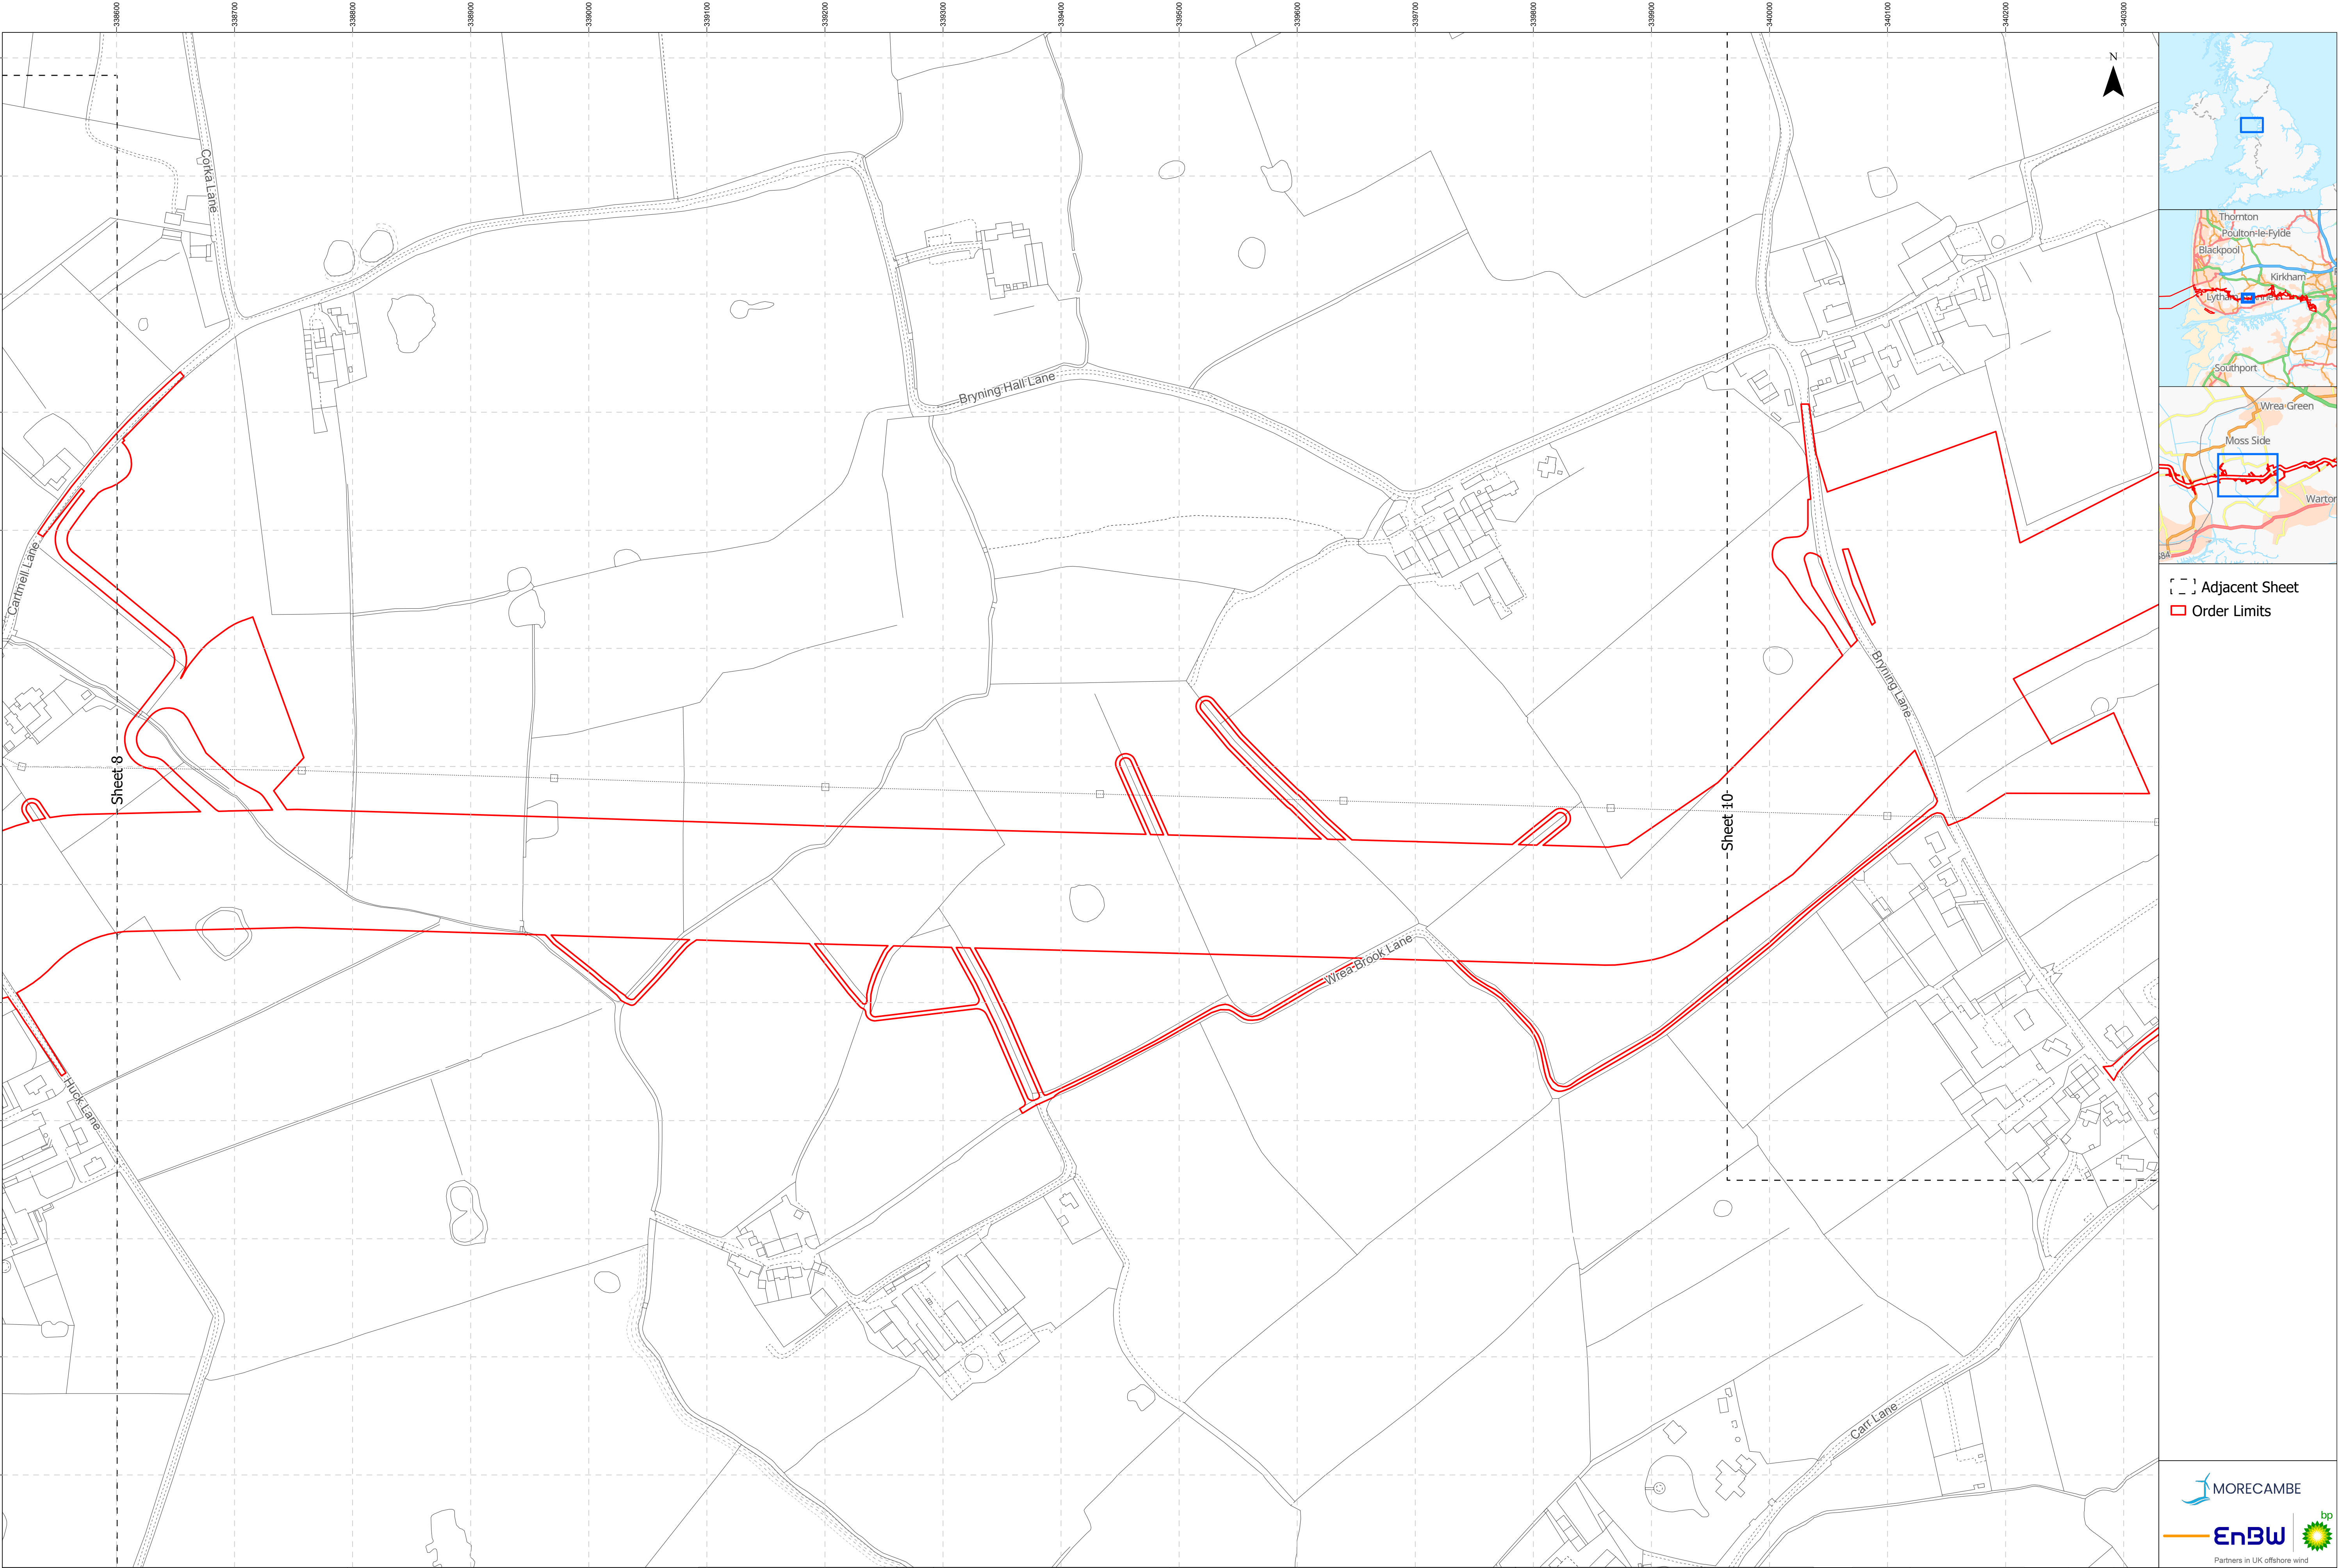

[---] Adjacent Sheet
[Red Outline] Order Limits

Project Name:
MORGAN AND MORECAMBE OFFSHORE WIND FARMS:
TRANSMISSION ASSETS

Drawing Title:
Without Prejudice Removal of Lytham Moss - Onshore and Intertidal
Order Limits Plan- Sheet 9 of 19
AFPF Regulation: 5(2)(j)(ii)
Document Reference: S_SoSQ_38

0 25 50 75 Meters
Scale@A1: 1:2,500

Geodetic Information:
Datum: OSGB 1936
Projection: British National Grid



Data Sources: BP, Ordnance Survey
Based Upon The Ordnance Survey Map With The Sanction Of The
Controller Of HM Stationery Office. Crown Copyright Reserved. © OS
Licence No. 100042124

Service Layer Credits: GB Cartographic Local Names:
Contains OS data © Crown Copyright and database right
2026. Contains data from OS Zoomstack

VER	DATE	DETAILS	AUTH	CHK	APPRV
01	17.07.2026	SoS Consultation 3 Submission	DM	CB	OG



Drawing Number:
22003214_PLN_DCO_13660.9

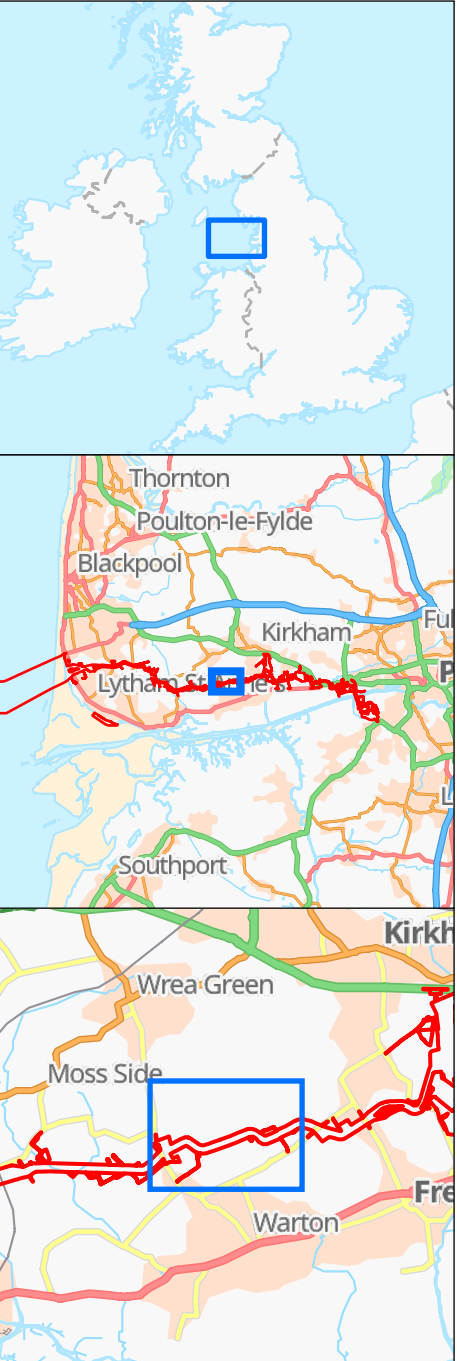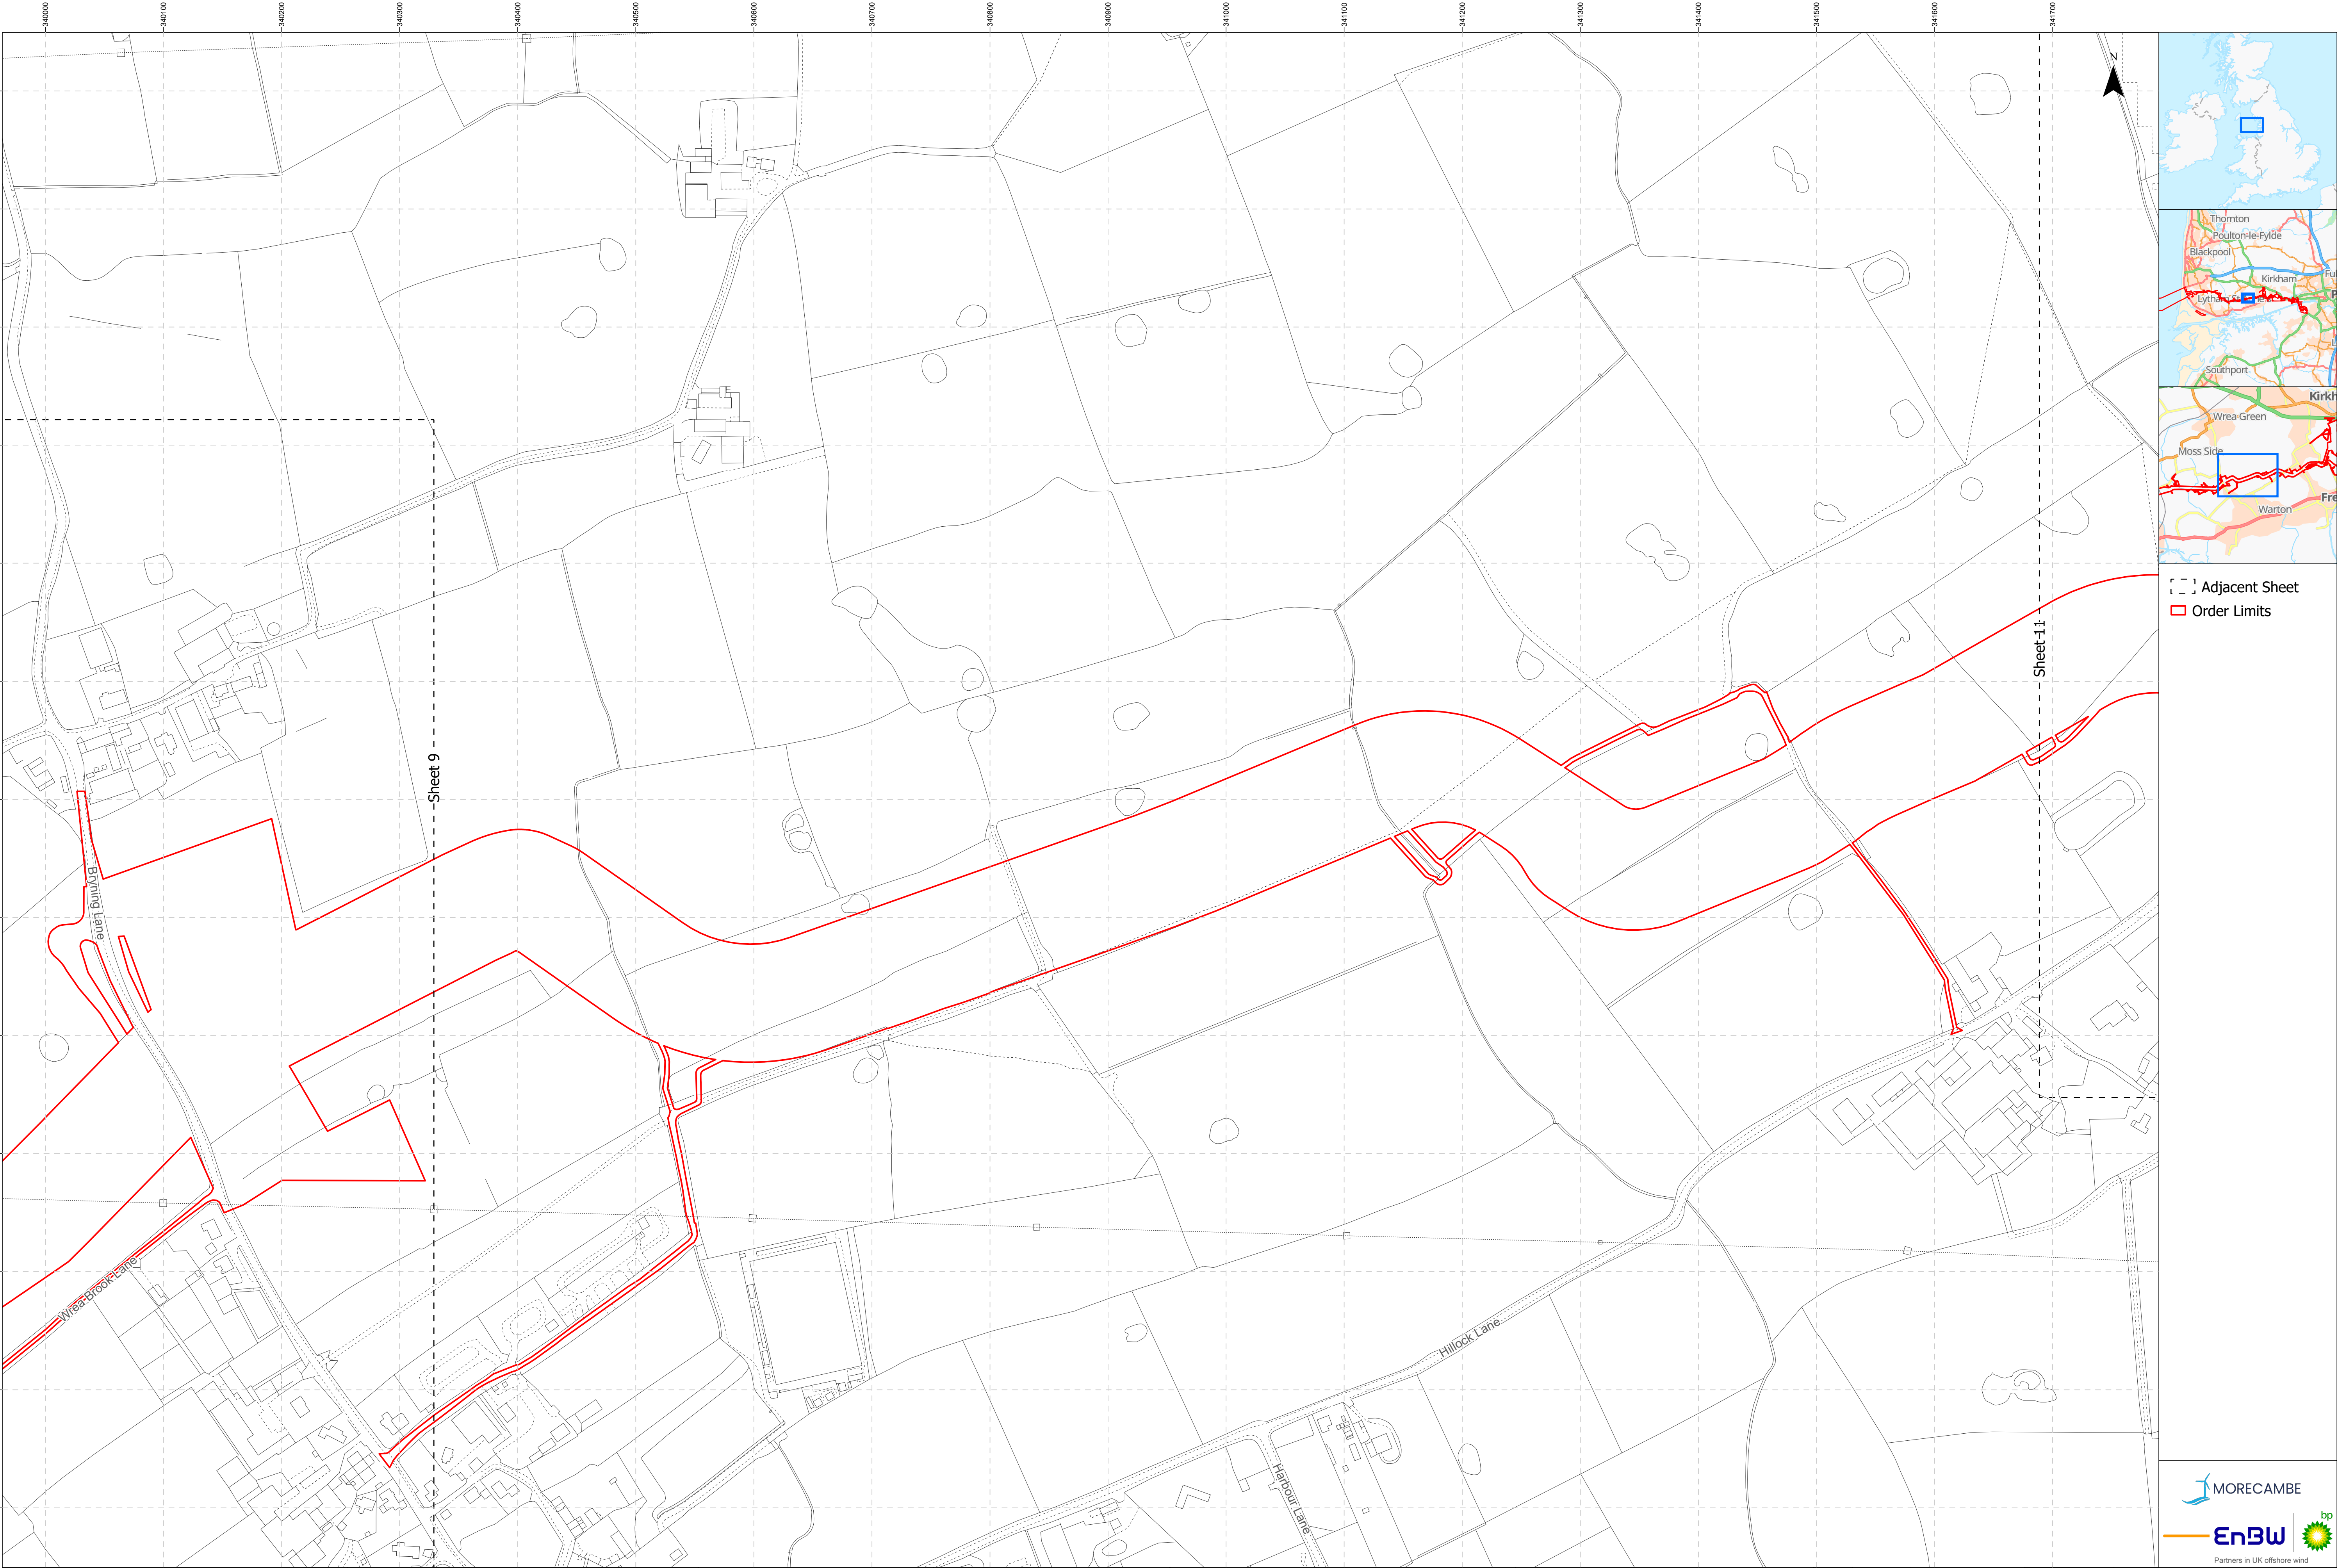

[] Adjacent Sheet
[] Order Limits

Project Name:
MORGAN AND MORECAMBE OFFSHORE WIND FARMS:
TRANSMISSION ASSETS

Drawing Title:
Without Prejudice Removal of Lytham Moss - Onshore and Intertidal
Order Limits Plan- Sheet 10 of 19
AFPF Regulation: 5(2)(j)(ii)
Document Reference: S_SoSQ_38

0 25 50 75 Meters
Scale@A1: 1:2,500

Geodetic Information:
Datum: OSGB 1936
Projection: British National Grid



Data Sources: BP, Ordnance Survey
Based Upon The Ordnance Survey Map With The Sanction Of The
Controller Of HM Stationery Office. Crown Copyright Reserved. © OS
Licence No. 100042124

Service Layer Credits: GB Cartographic Local Names:
Contains OS data © Crown Copyright and database right
2026. Contains data from OS Zoomstack

VER	DATE	DETAILS	AUTH	CHK	APPRV
01	17.07.2026	SoS Consultation 3 Submission	DM	CB	OG



Drawing Number:
22003214_PLN_DCO_13660.10

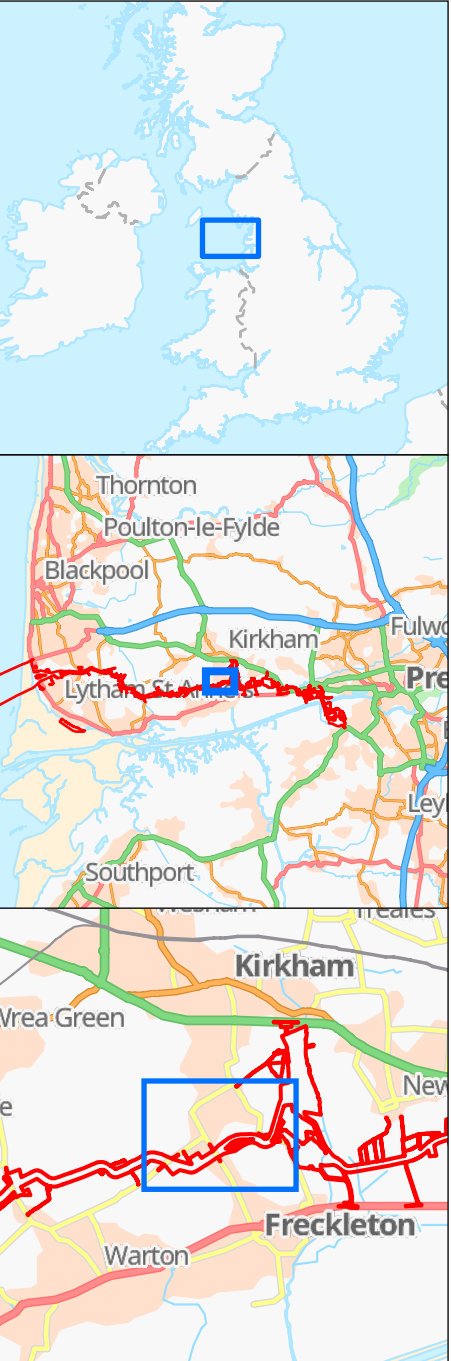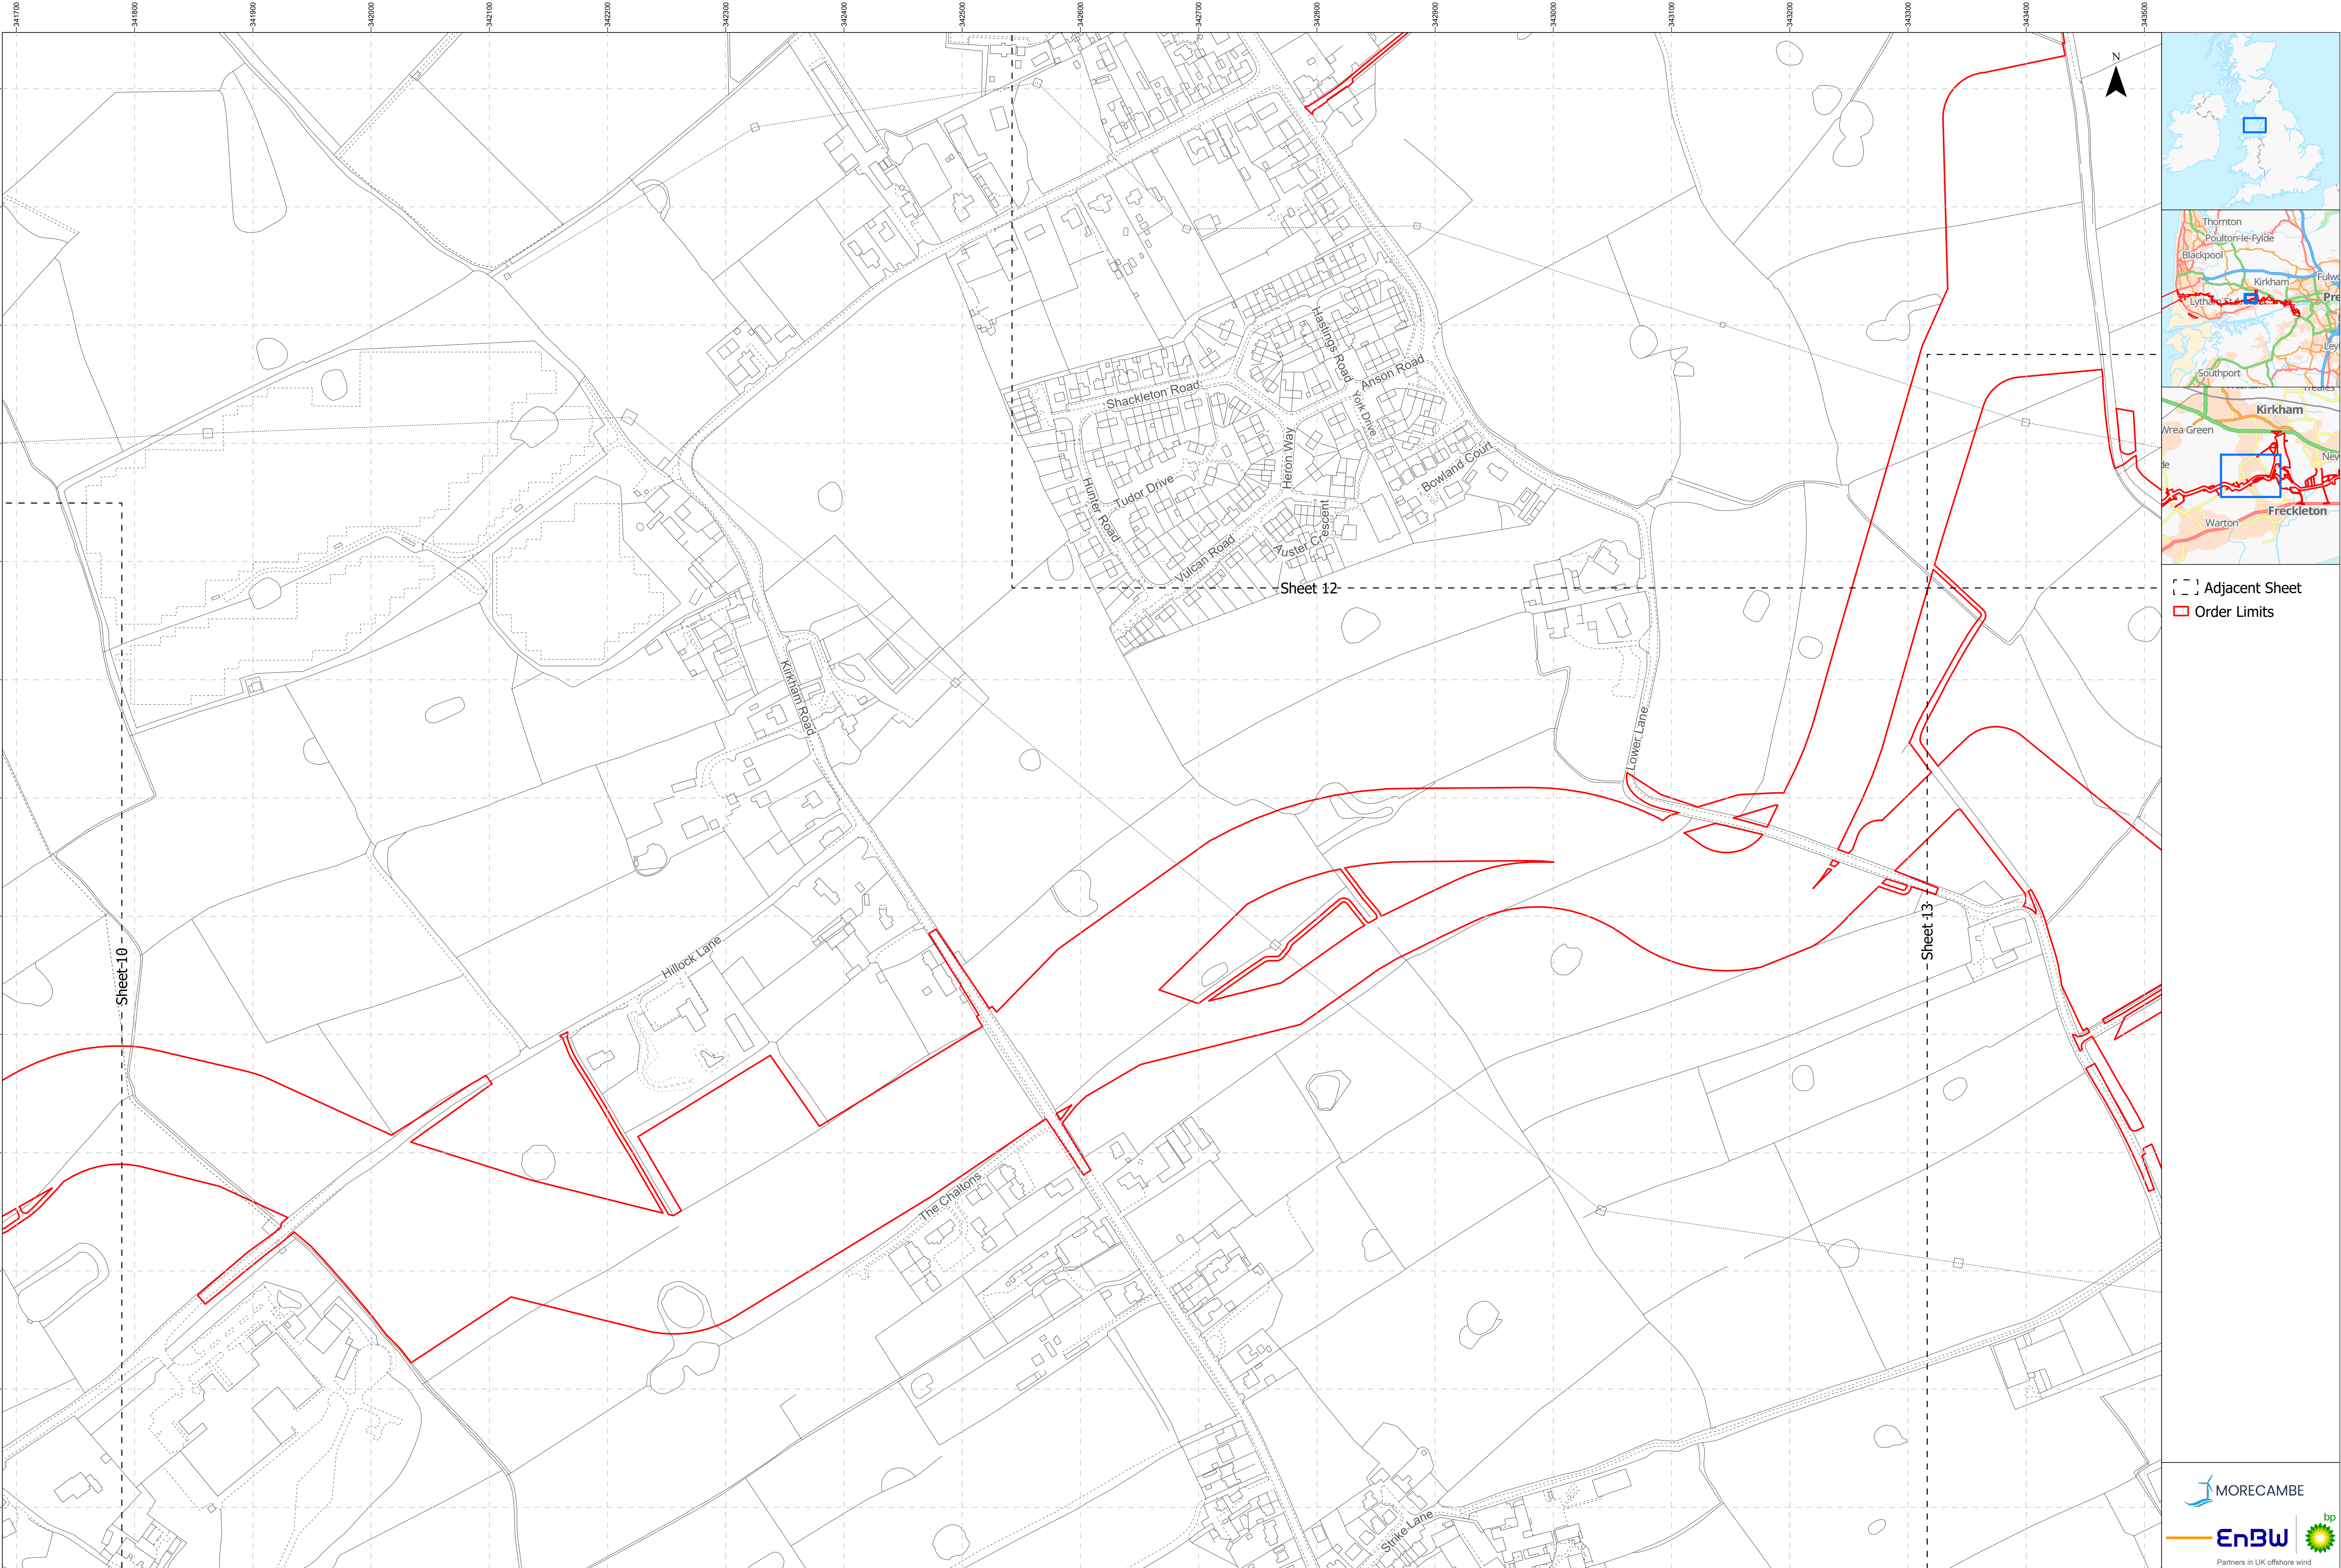

[] Adjacent Sheet
[] Order Limits

Project Name:
MORGAN AND MORECAMBE OFFSHORE WIND FARMS:
TRANSMISSION ASSETS

Drawing Title:
Without Prejudice Removal of Lytham Moss - Onshore and Intertidal
Order Limits Plan- Sheet 11 of 19
AFPF Regulation: 5(2)(j)(ii)
Document Reference: S_SoSQ_38

0 25 50 75 Meters
Scale@A1: 1:2,500

Geodetic Information:
Datum: OSGB 1936
Projection: British National Grid



Data Sources: BP, Ordnance Survey
Based Upon The Ordnance Survey Map With The Sanction Of The
Controller Of HM Stationery Office. Crown Copyright Reserved. © OS
Licence No. 100042124

Service Layer Credits: GB Cartographic Local Names:
Contains OS data © Crown Copyright and database right
2026. Contains data from OS Zoomstack

VER	DATE	DETAILS	AUTH	CHK	APPRV
01	17.07.2026	SoS Consultation 3 Submission	DM	CB	OG

Drawing Number:
22003214_PLN_DCO_13660.11



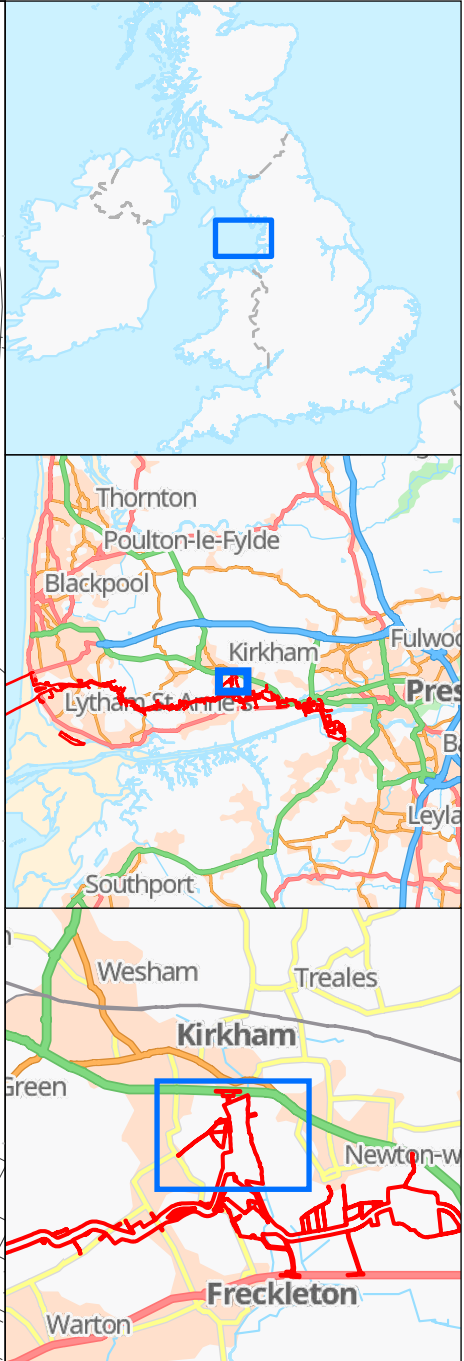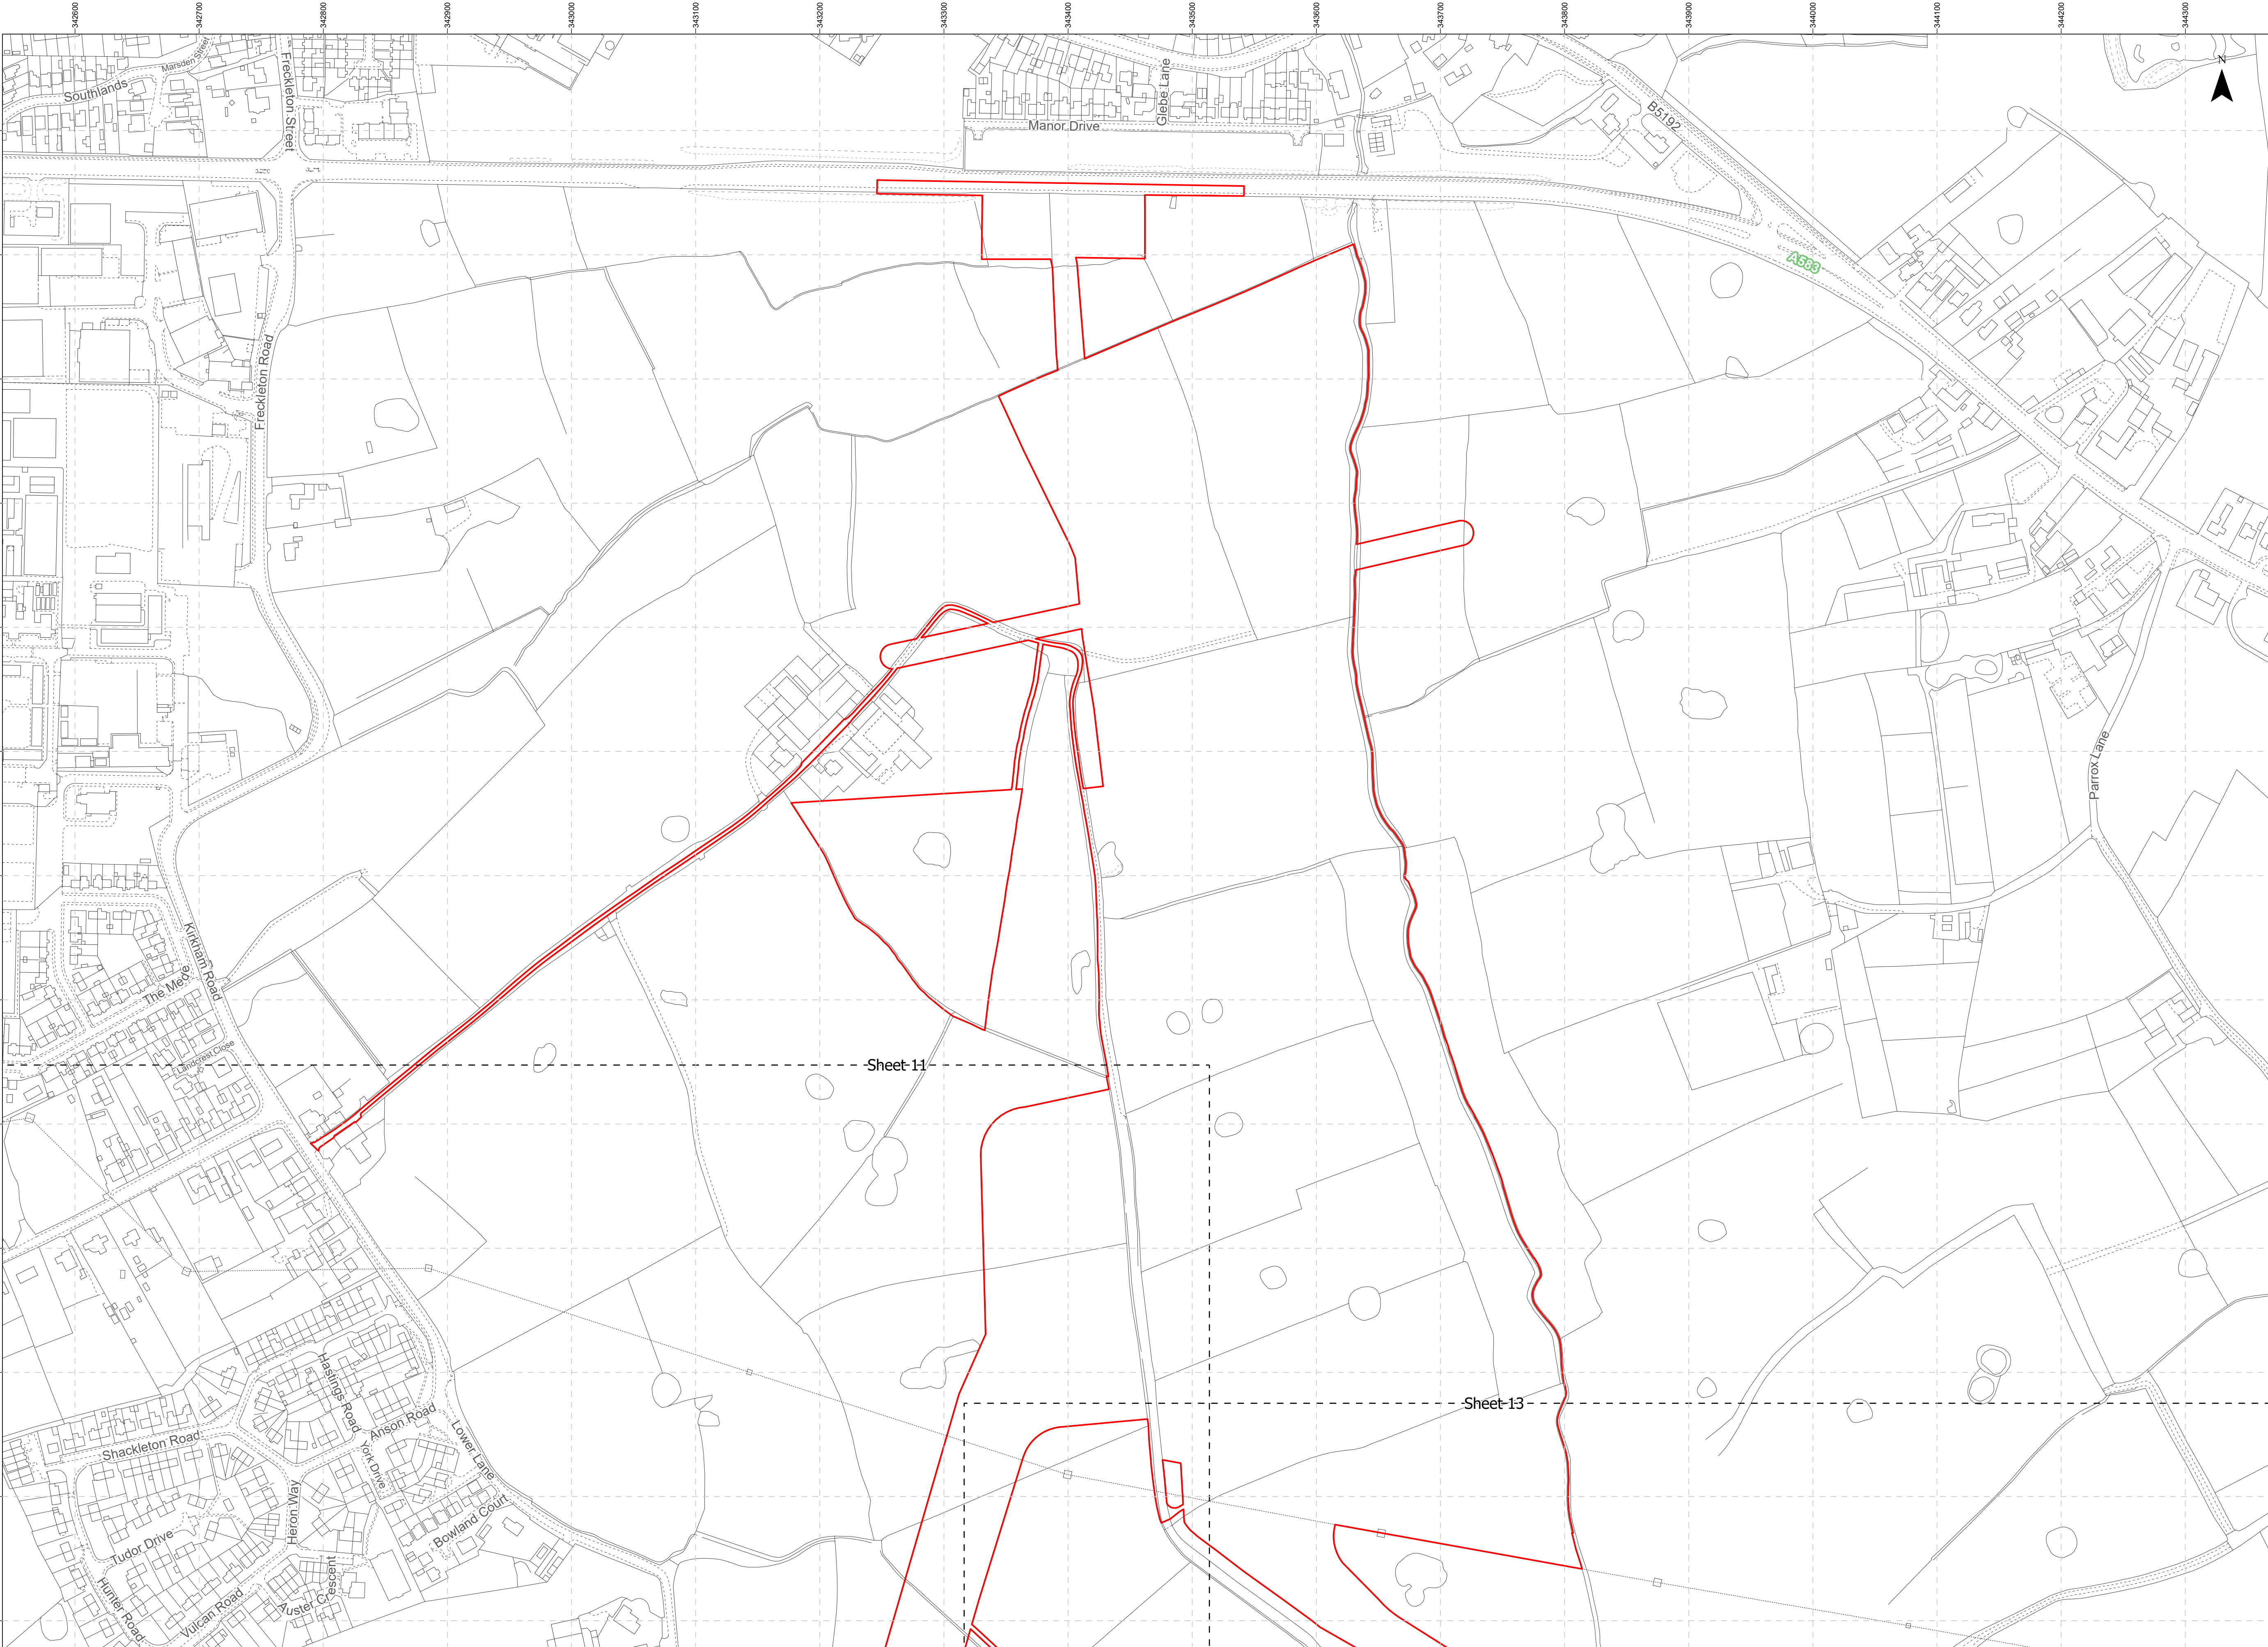

[] Adjacent Sheet
[] Order Limits

Project Name:
MORGAN AND MORECAMBE OFFSHORE WIND FARMS:
TRANSMISSION ASSETS

Drawing Title:
Without Prejudice Removal of Lytham Moss - Onshore and Intertidal
Order Limits Plan- Sheet 12 of 19
AFPF Regulation: 5(2)(j)(ii)
Document Reference: S_SoSQ_38

0 25 50 75 Meters
Scale@A1: 1:2,500

Geodetic Information:
Datum: OSGB 1936
Projection: British National Grid



Data Sources: BP, Ordnance Survey
Based Upon The Ordnance Survey Map With The Sanction Of The
Controller Of HM Stationery Office. Crown Copyright Reserved. © OS
Licence No. 100042124

Service Layer Credits: GB Cartographic Local Names:
Contains OS data © Crown Copyright and database right
2026. Contains data from OS Zoomstack

VER	DATE	DETAILS	AUTH	CHK	APPRV
01	17.07.2026	SoS Consultation 3 Submission	DM	CB	OG

Drawing Number:
22003214_PLN_DCO_13660.12



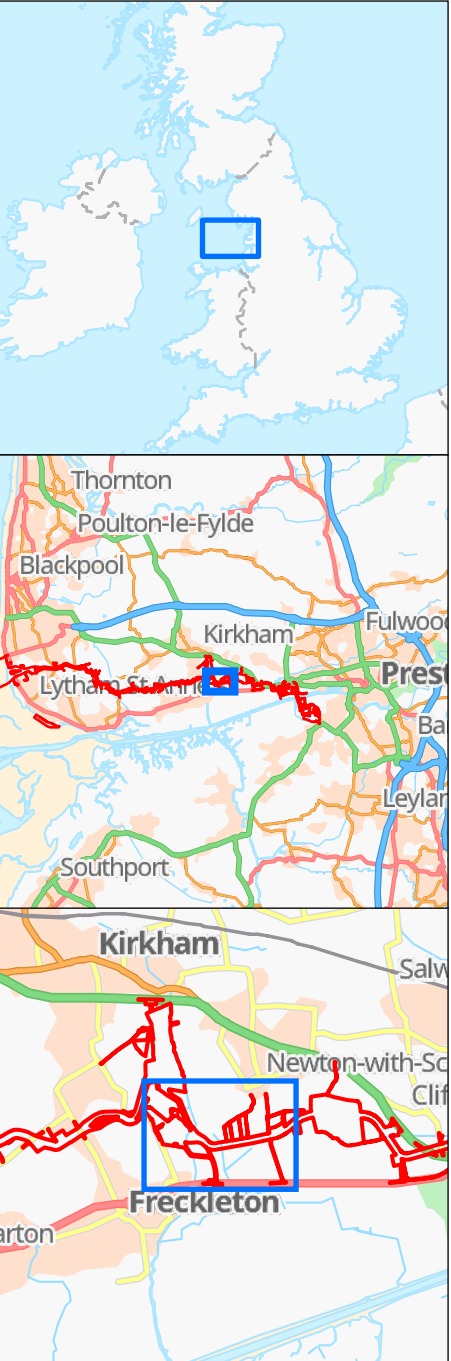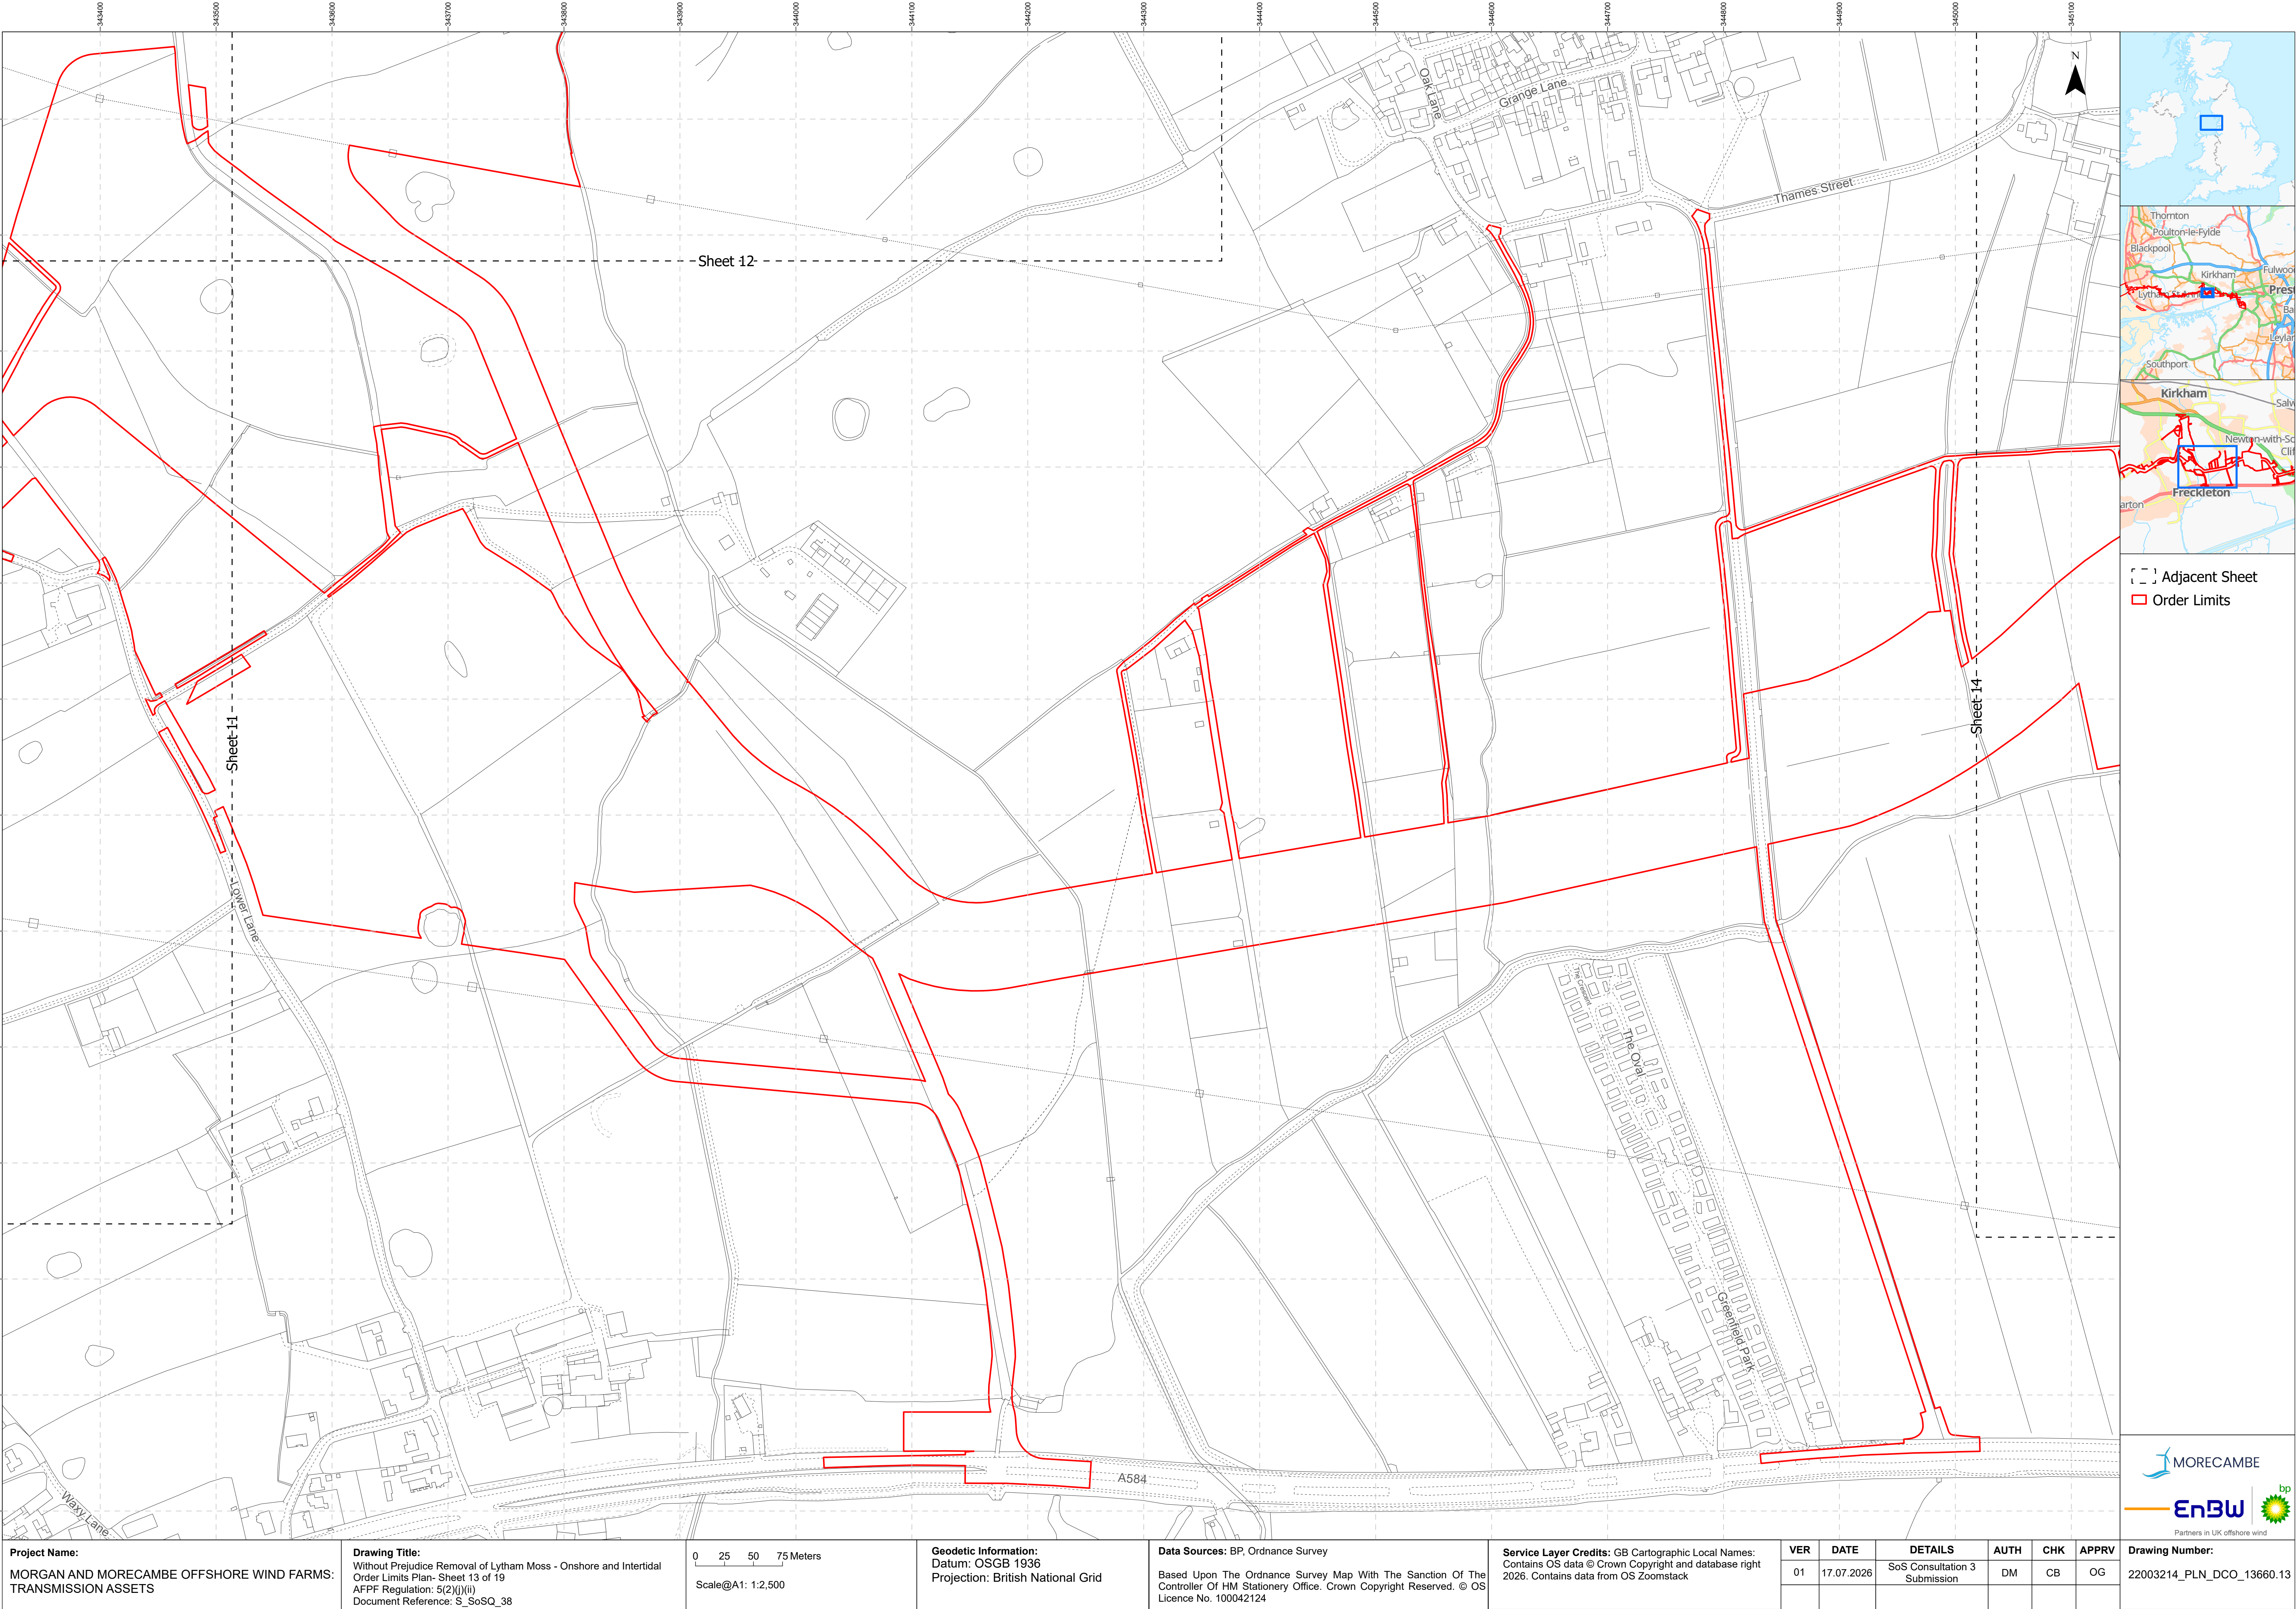

[---] Adjacent Sheet
[Red Outline] Order Limits

Project Name:
MORGAN AND MORECAMBE OFFSHORE WIND FARMS:
TRANSMISSION ASSETS

Drawing Title:
Without Prejudice Removal of Lytham Moss - Onshore and Intertidal
Order Limits Plan- Sheet 13 of 19
AFPF Regulation: 5(2)(j)(ii)
Document Reference: S_SoSQ_38

0 25 50 75 Meters
Scale@A1: 1:2,500

Geodetic Information:
Datum: OSGB 1936
Projection: British National Grid


Data Sources: BP, Ordnance Survey
Based Upon The Ordnance Survey Map With The Sanction Of The
Controller Of HM Stationery Office. Crown Copyright Reserved. © OS
Licence No. 100042124



Service Layer Credits: GB Cartographic Local Names:
Contains OS data © Crown Copyright and database right
2026. Contains data from OS Zoomstack

VER	DATE	DETAILS	AUTH	CHK	APPRV
01	17.07.2026	SoS Consultation 3 Submission	DM	CB	OG

Drawing Number:
22003214_PLN_DCO_13660.13



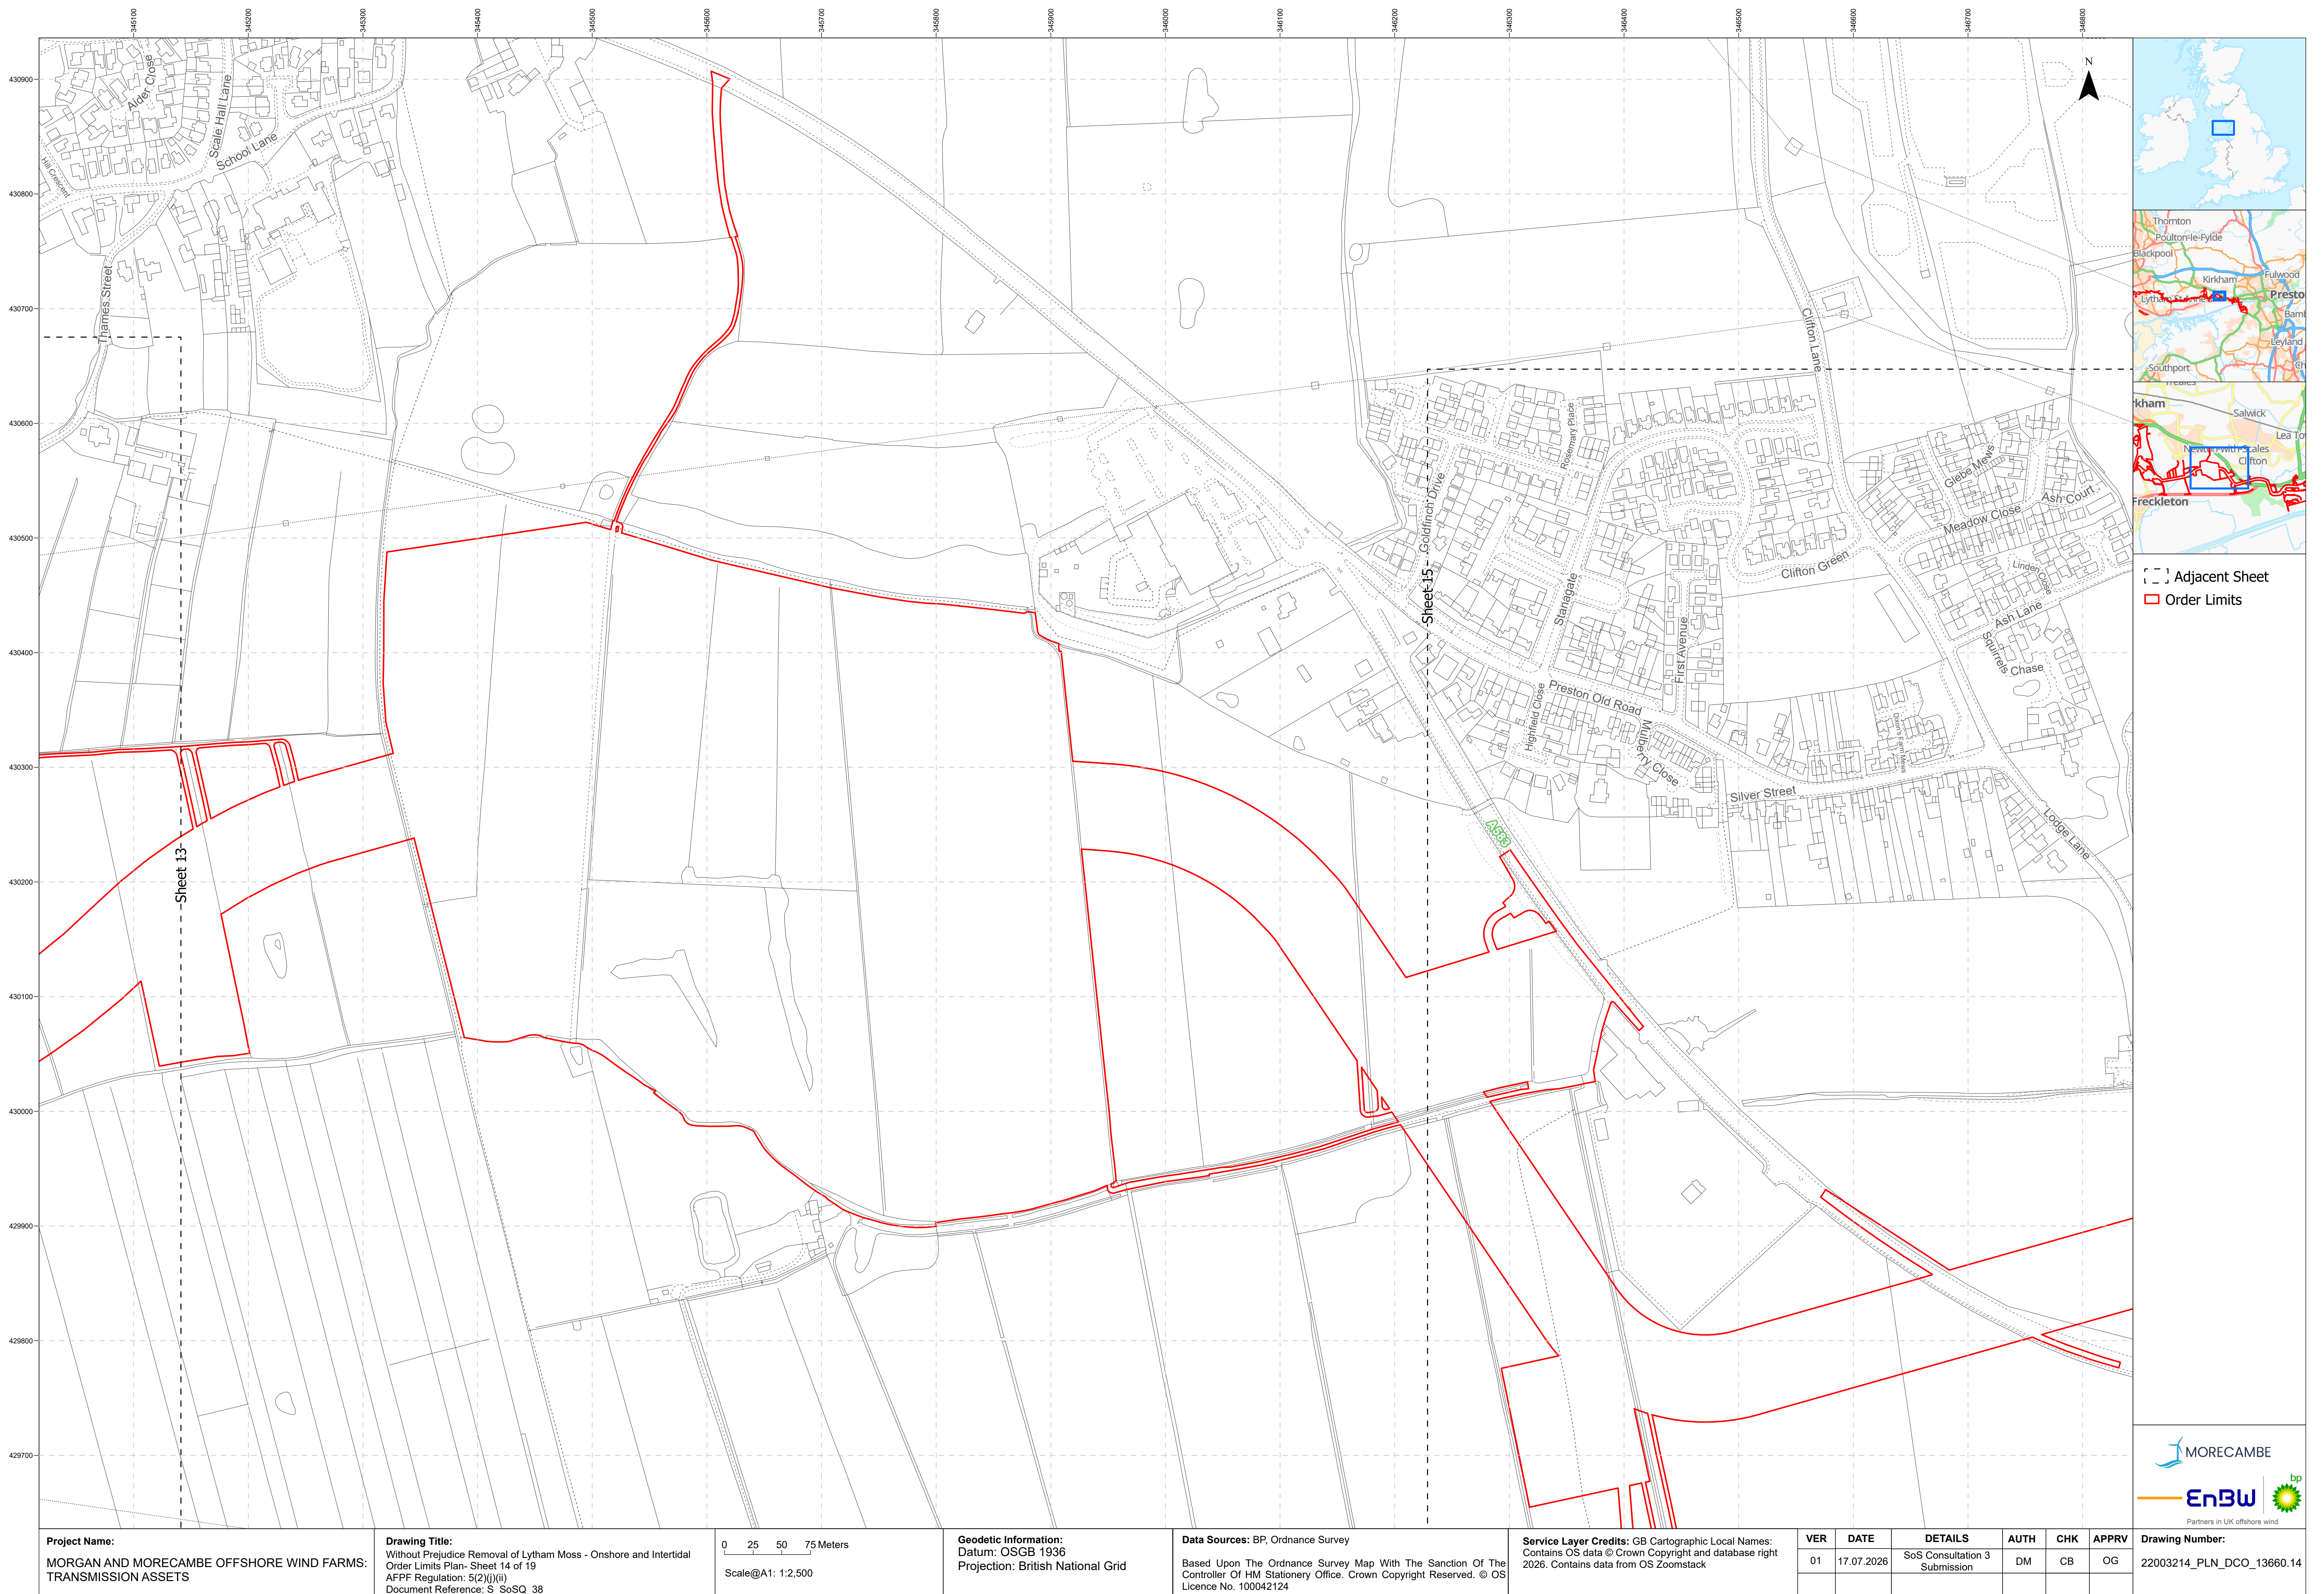

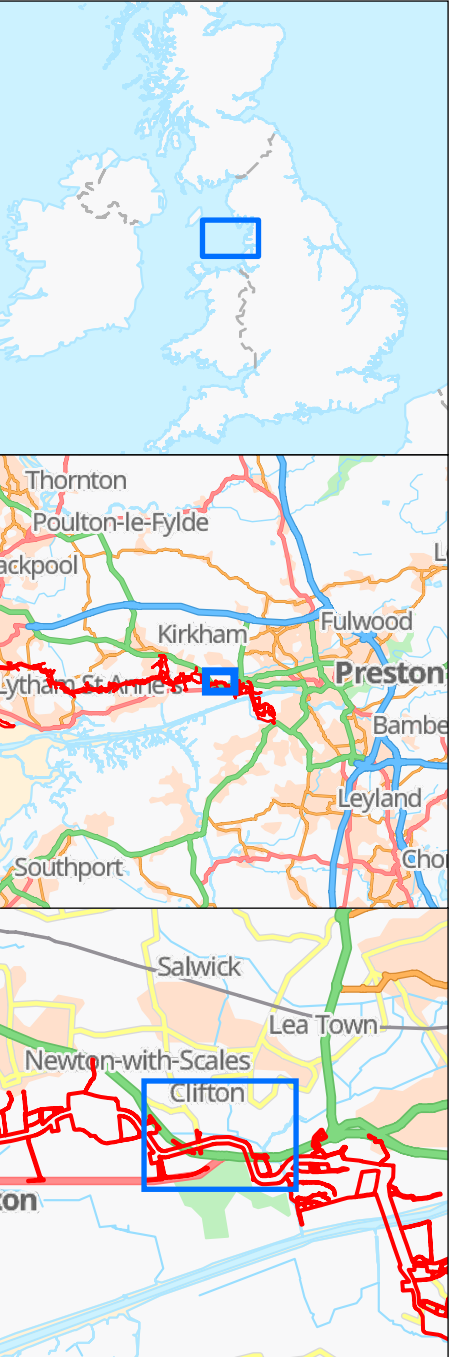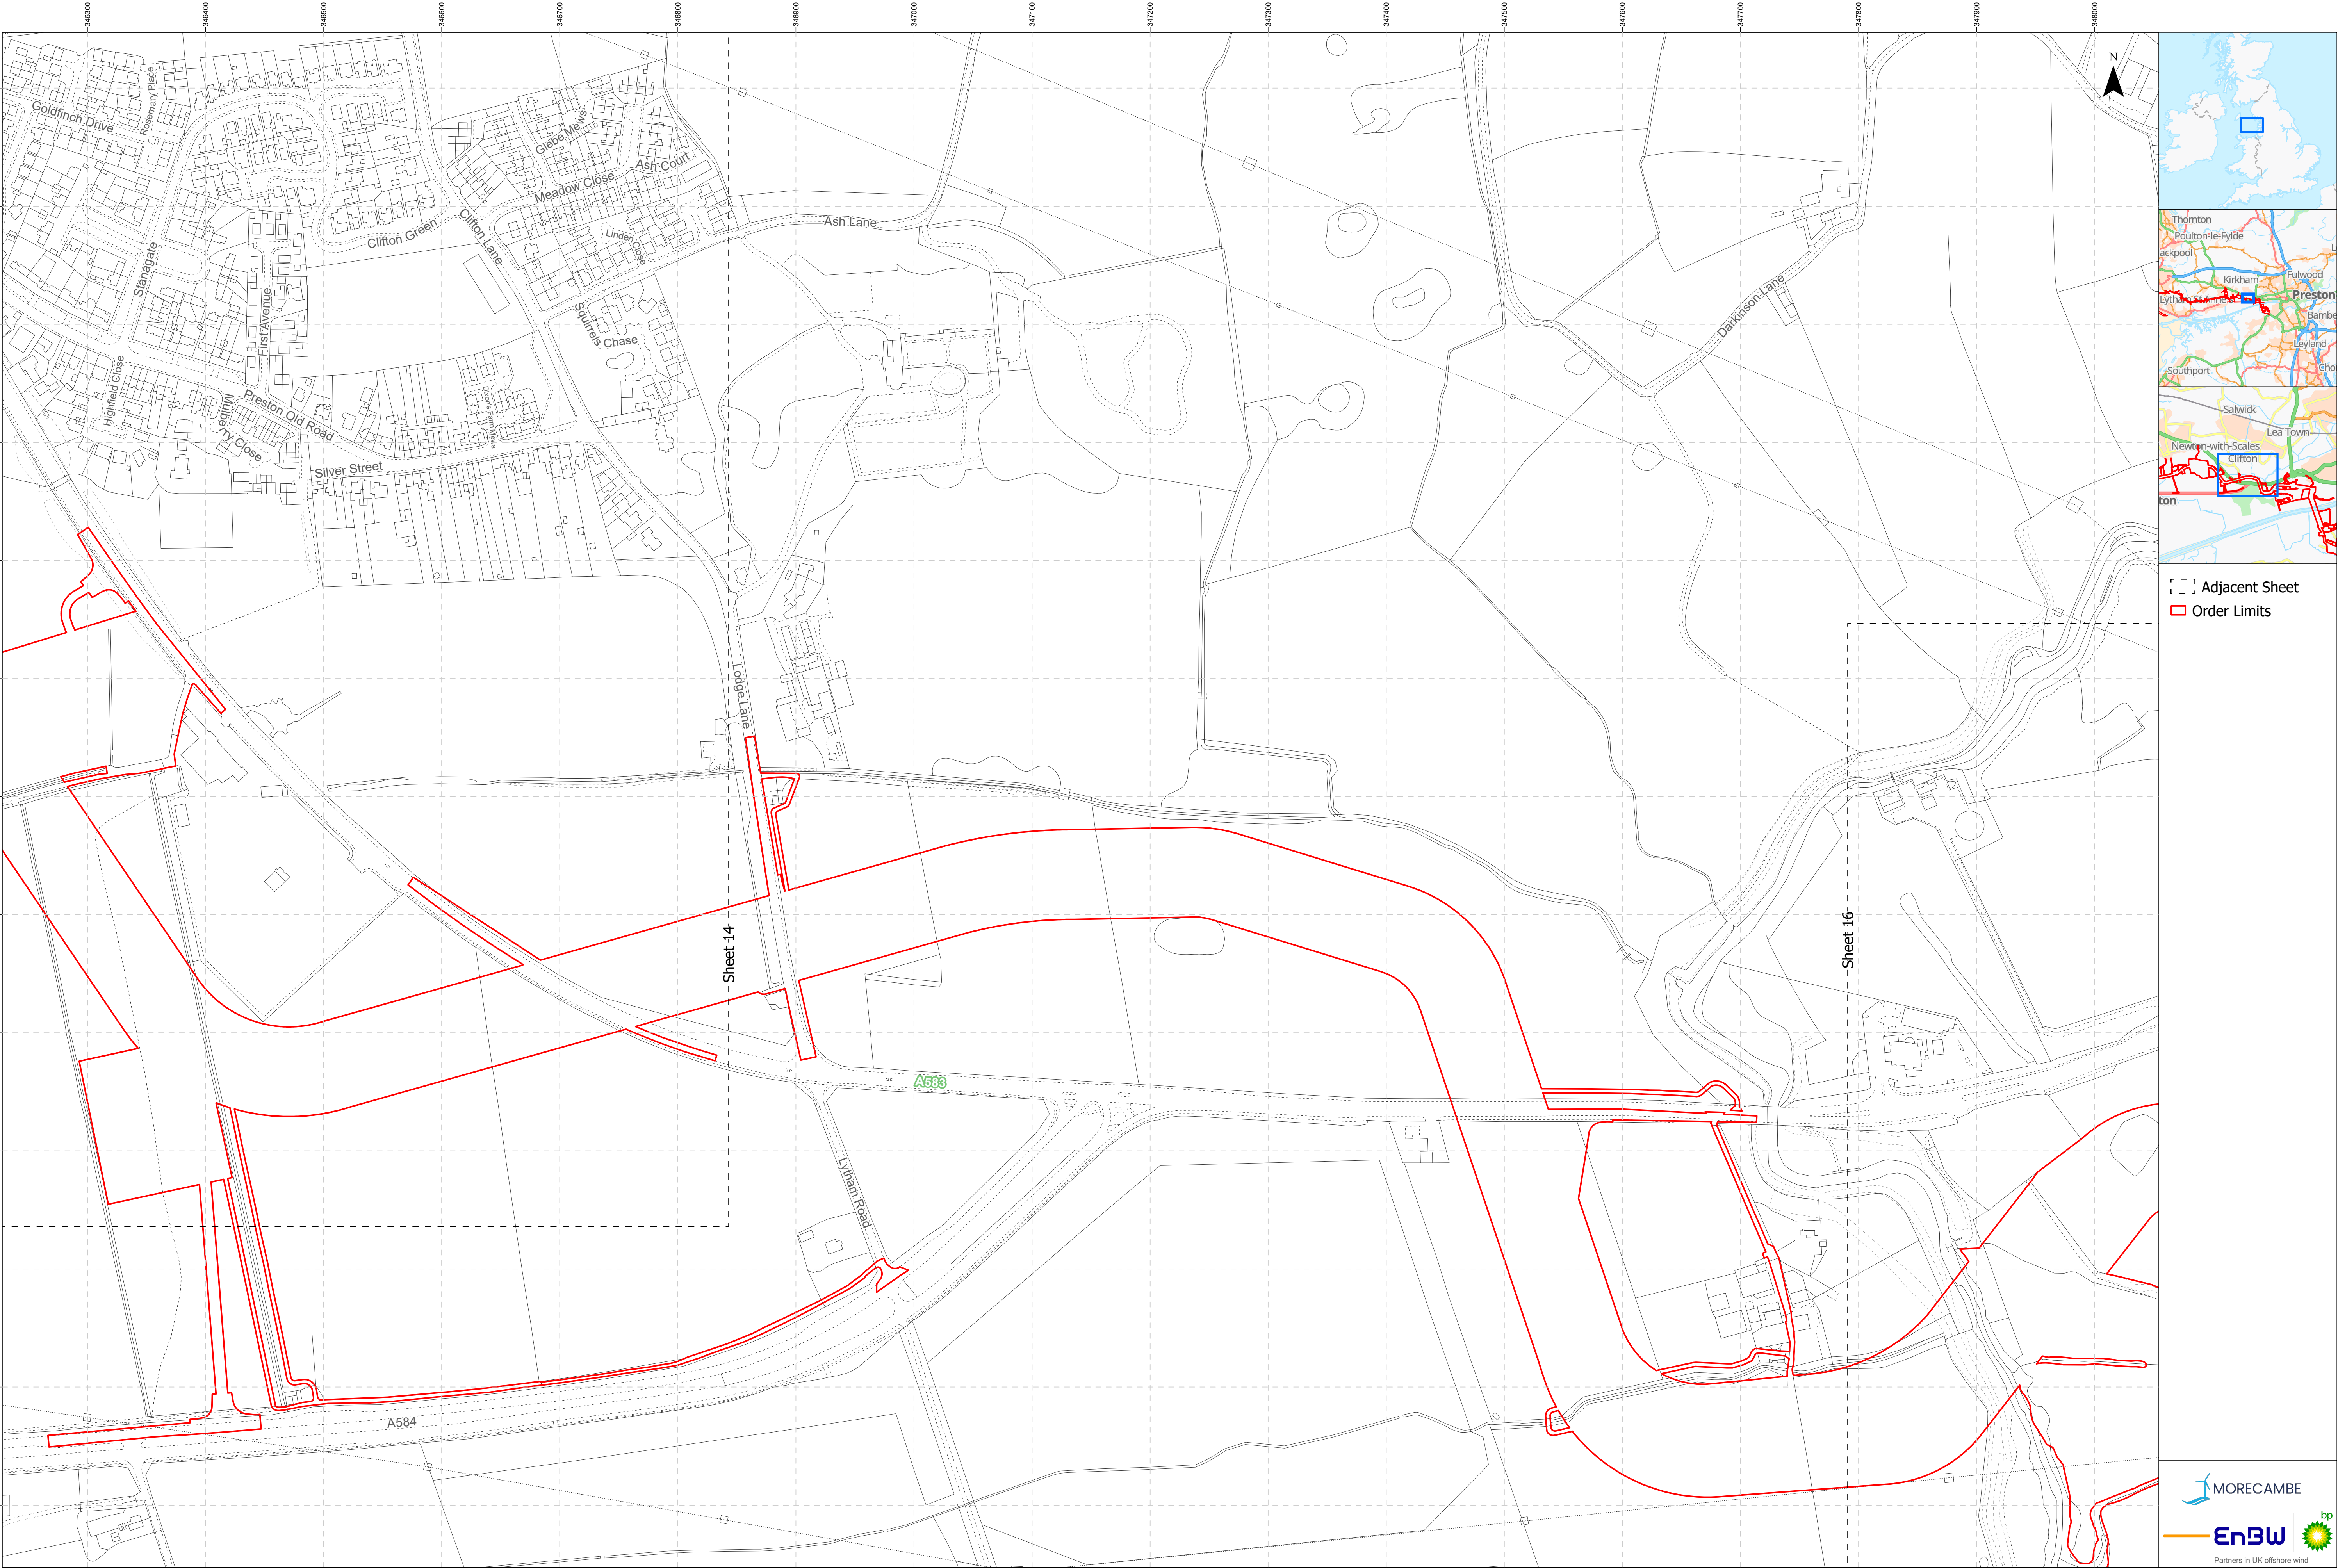

[] Adjacent Sheet
[] Order Limits

Project Name:
MORGAN AND MORECAMBE OFFSHORE WIND FARMS:
TRANSMISSION ASSETS

Drawing Title:
Without Prejudice Removal of Lytham Moss - Onshore and Intertidal
Order Limits Plan- Sheet 15 of 19
AFPF Regulation: 5(2)(j)(ii)
Document Reference: S_SoSQ_38

0 25 50 75 Meters
Scale@A1: 1:2,500

Geodetic Information:
Datum: OSGB 1936
Projection: British National Grid


Data Sources: BP, Ordnance Survey
Based Upon The Ordnance Survey Map With The Sanction Of The
Controller Of HM Stationery Office. Crown Copyright Reserved. © OS
Licence No. 100042124

Service Layer Credits: GB Cartographic Local Names:
Contains OS data © Crown Copyright and database right
2026. Contains data from OS Zoomstack

VER	DATE	DETAILS	AUTH	CHK	APPRV
01	17.07.2026	SoS Consultation 3 Submission	DM	CB	OG



Drawing Number:
22003214_PLN_DCO_13660.15

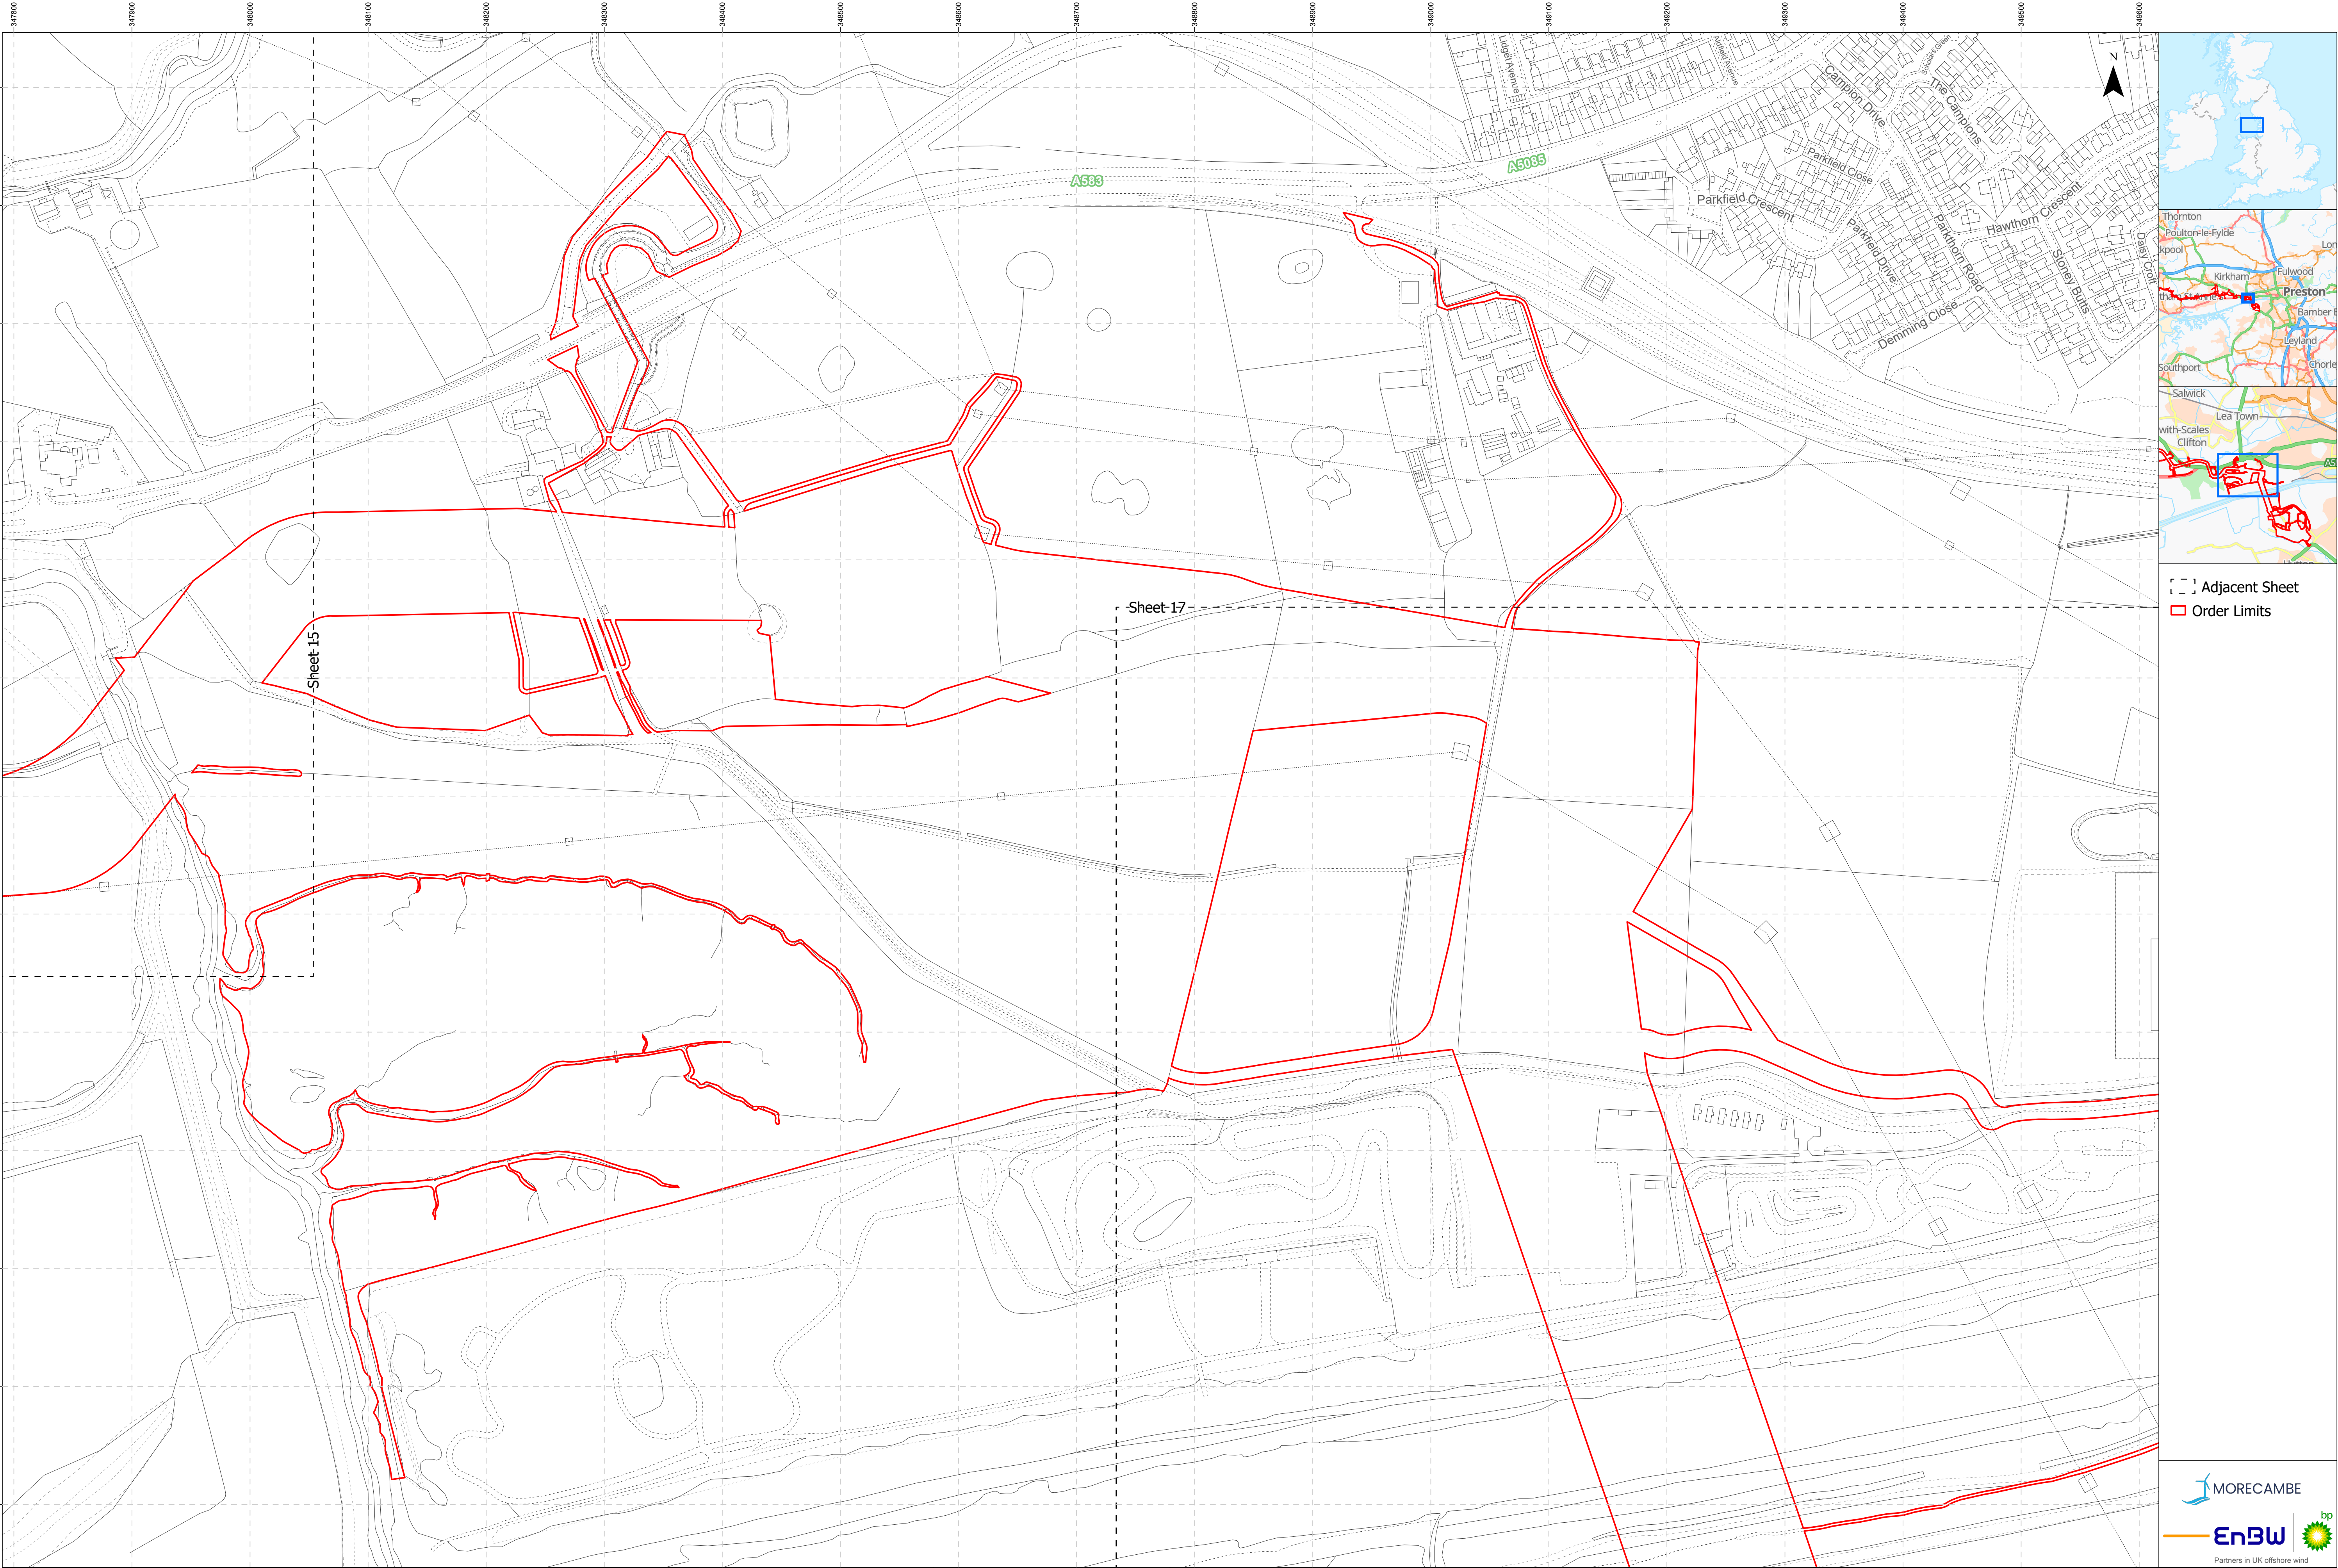

[] Adjacent Sheet
[] Order Limits

Project Name:
MORGAN AND MORECAMBE OFFSHORE WIND FARMS:
TRANSMISSION ASSETS

Drawing Title:
Without Prejudice Removal of Lytham Moss - Onshore and Intertidal
Order Limits Plan- Sheet 16 of 19
AFPF Regulation: 5(2)(j)(ii)
Document Reference: S_SoSQ_38

0 25 50 75 Meters
Scale@A1: 1:2,500

Geodetic Information:
Datum: OSGB 1936
Projection: British National Grid


Data Sources: BP, Ordnance Survey
Based Upon The Ordnance Survey Map With The Sanction Of The
Controller Of HM Stationery Office. Crown Copyright Reserved. © OS
Licence No. 100042124


Service Layer Credits: GB Cartographic Local Names:
Contains OS data © Crown Copyright and database right
2026. Contains data from OS Zoomstack

VER	DATE	DETAILS	AUTH	CHK	APPRV
01	17.07.2026	SoS Consultation 3 Submission	DM	CB	OG



Drawing Number:
22003214_PLN_DCO_13660.16

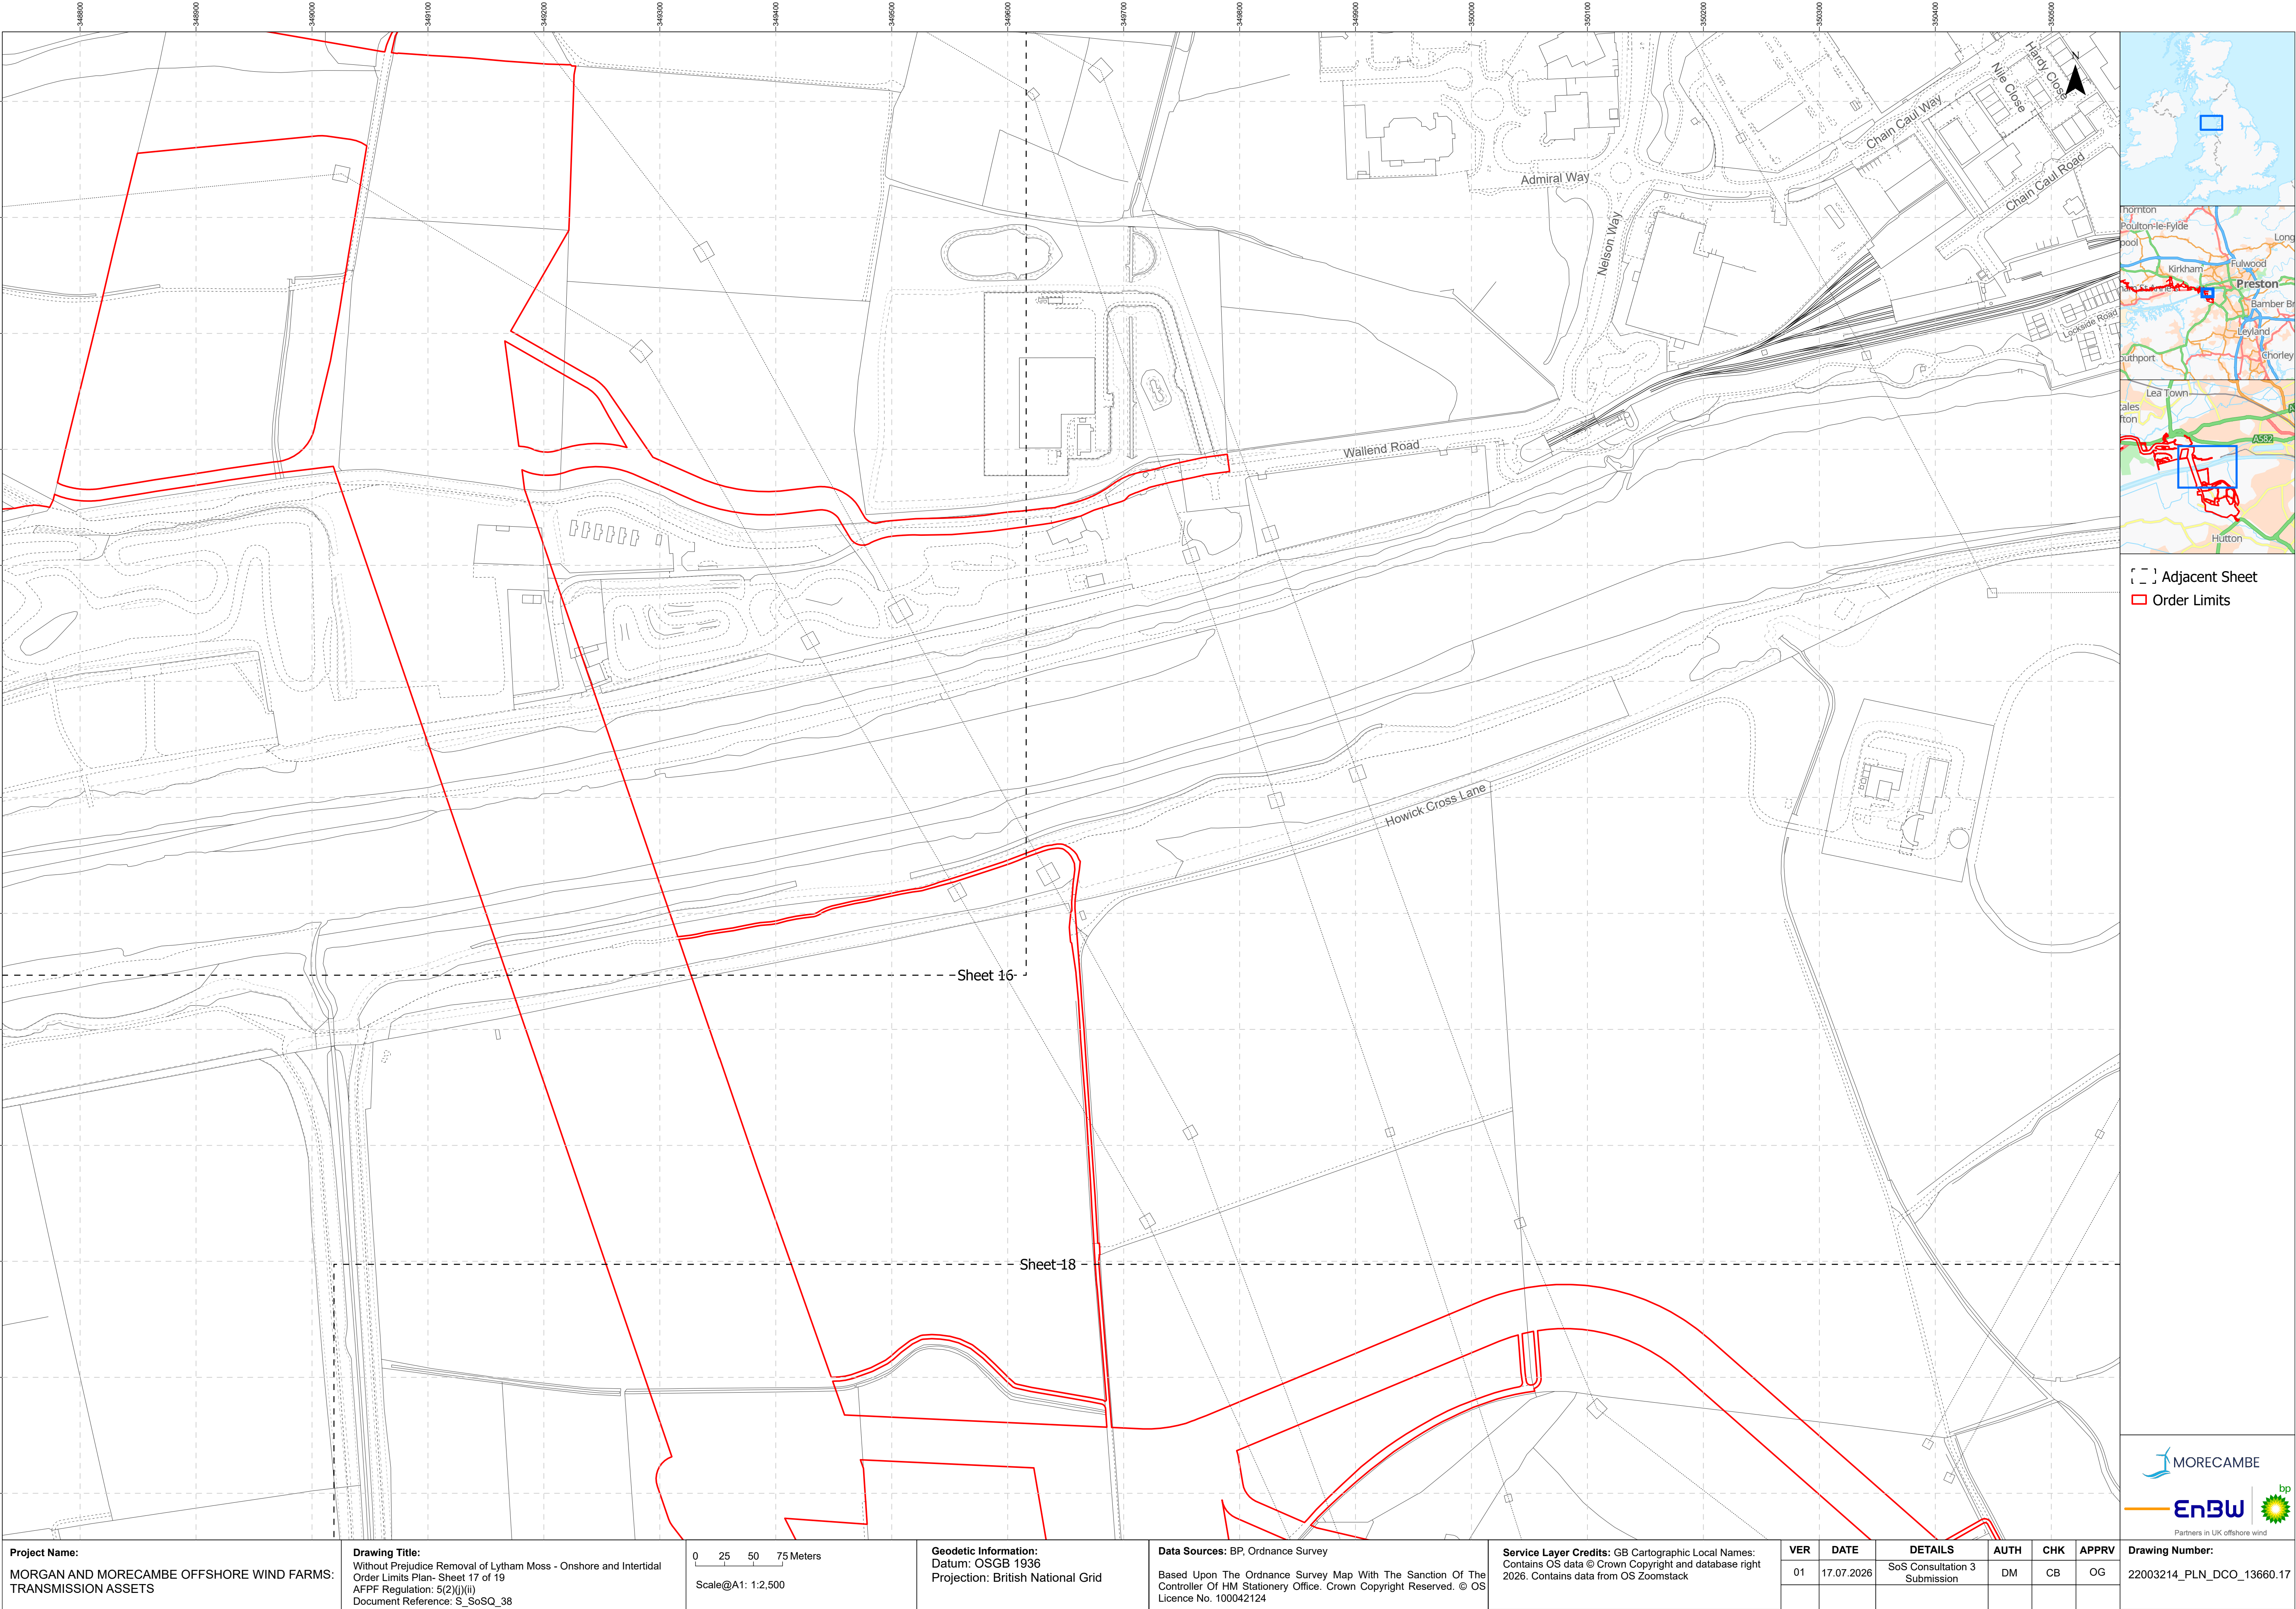

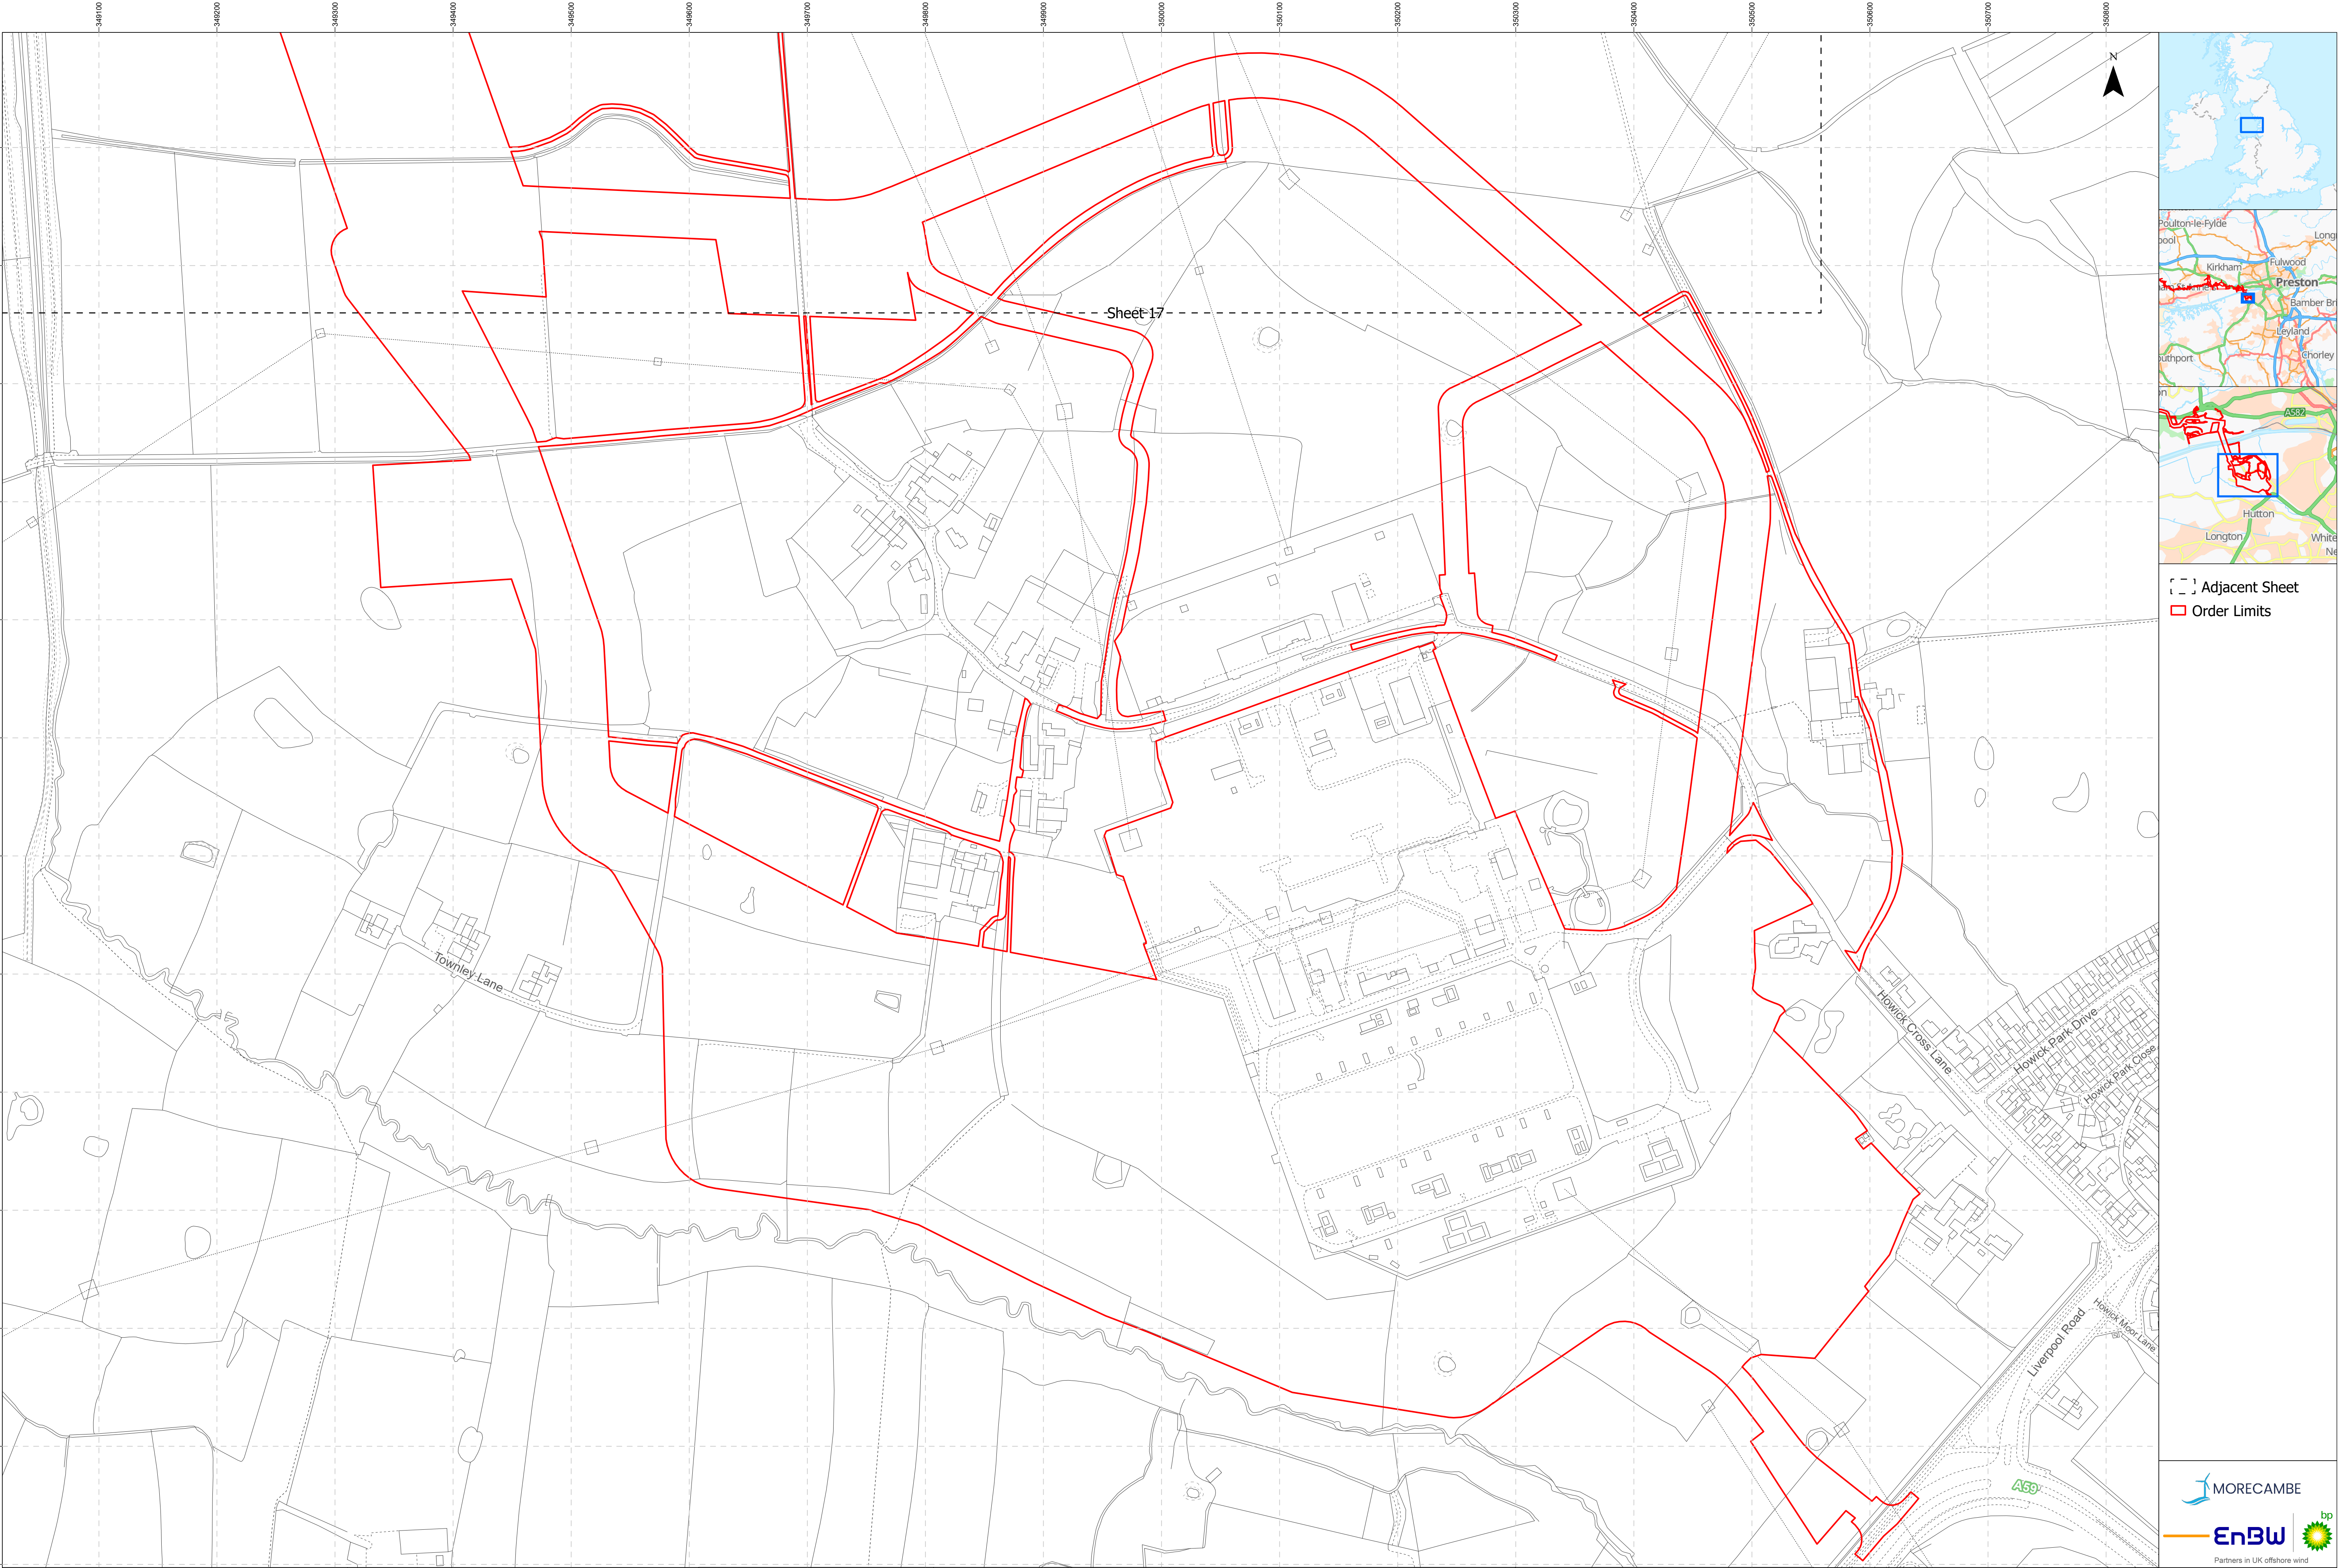

[- -] Adjacent Sheet
[Red Outline] Order Limits

Project Name:
MORGAN AND MORECAMBE OFFSHORE WIND FARMS:
TRANSMISSION ASSETS

Drawing Title:
Without Prejudice Removal of Lytham Moss - Onshore and Intertidal
Order Limits Plan- Sheet 18 of 19
AFPF Regulation: 5(2)(j)(ii)
Document Reference: S_SoSQ_38

0 25 50 75 Meters
Scale@A1: 1:2,500

Geodetic Information:
Datum: OSGB 1936
Projection: British National Grid



Data Sources: BP, Ordnance Survey
Based Upon The Ordnance Survey Map With The Sanction Of The
Controller Of HM Stationery Office. Crown Copyright Reserved. © OS
Licence No. 100042124

Service Layer Credits: GB Cartographic Local Names:
Contains OS data © Crown Copyright and database right
2026. Contains data from OS Zoomstack

VER	DATE	DETAILS	AUTH	CHK	APPRV
01	17.07.2026	SoS Consultation 3 Submission	DM	CB	OG

Drawing Number:
22003214_PLN_DCO_13660.18



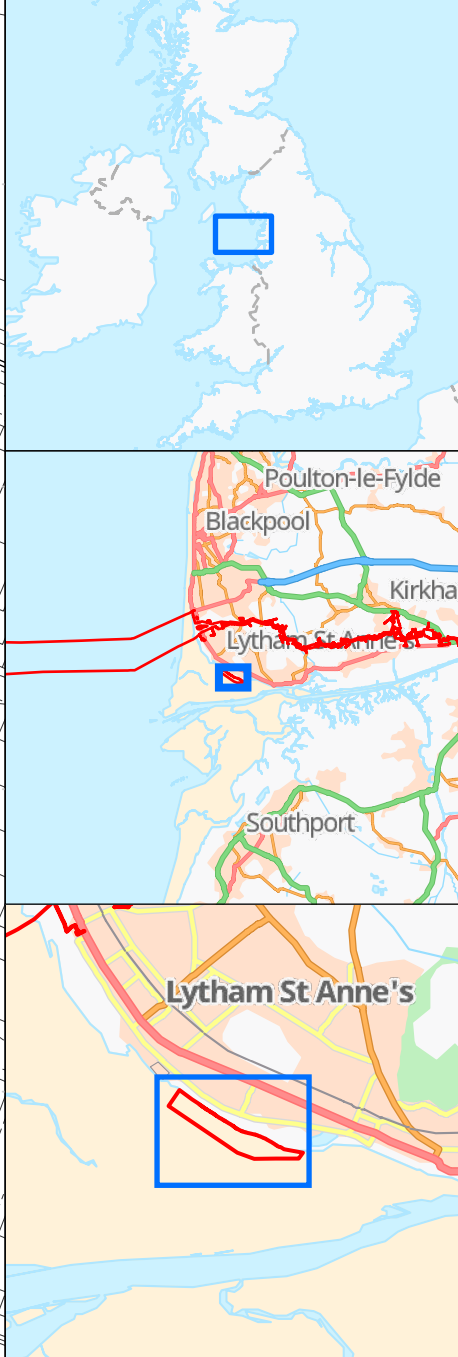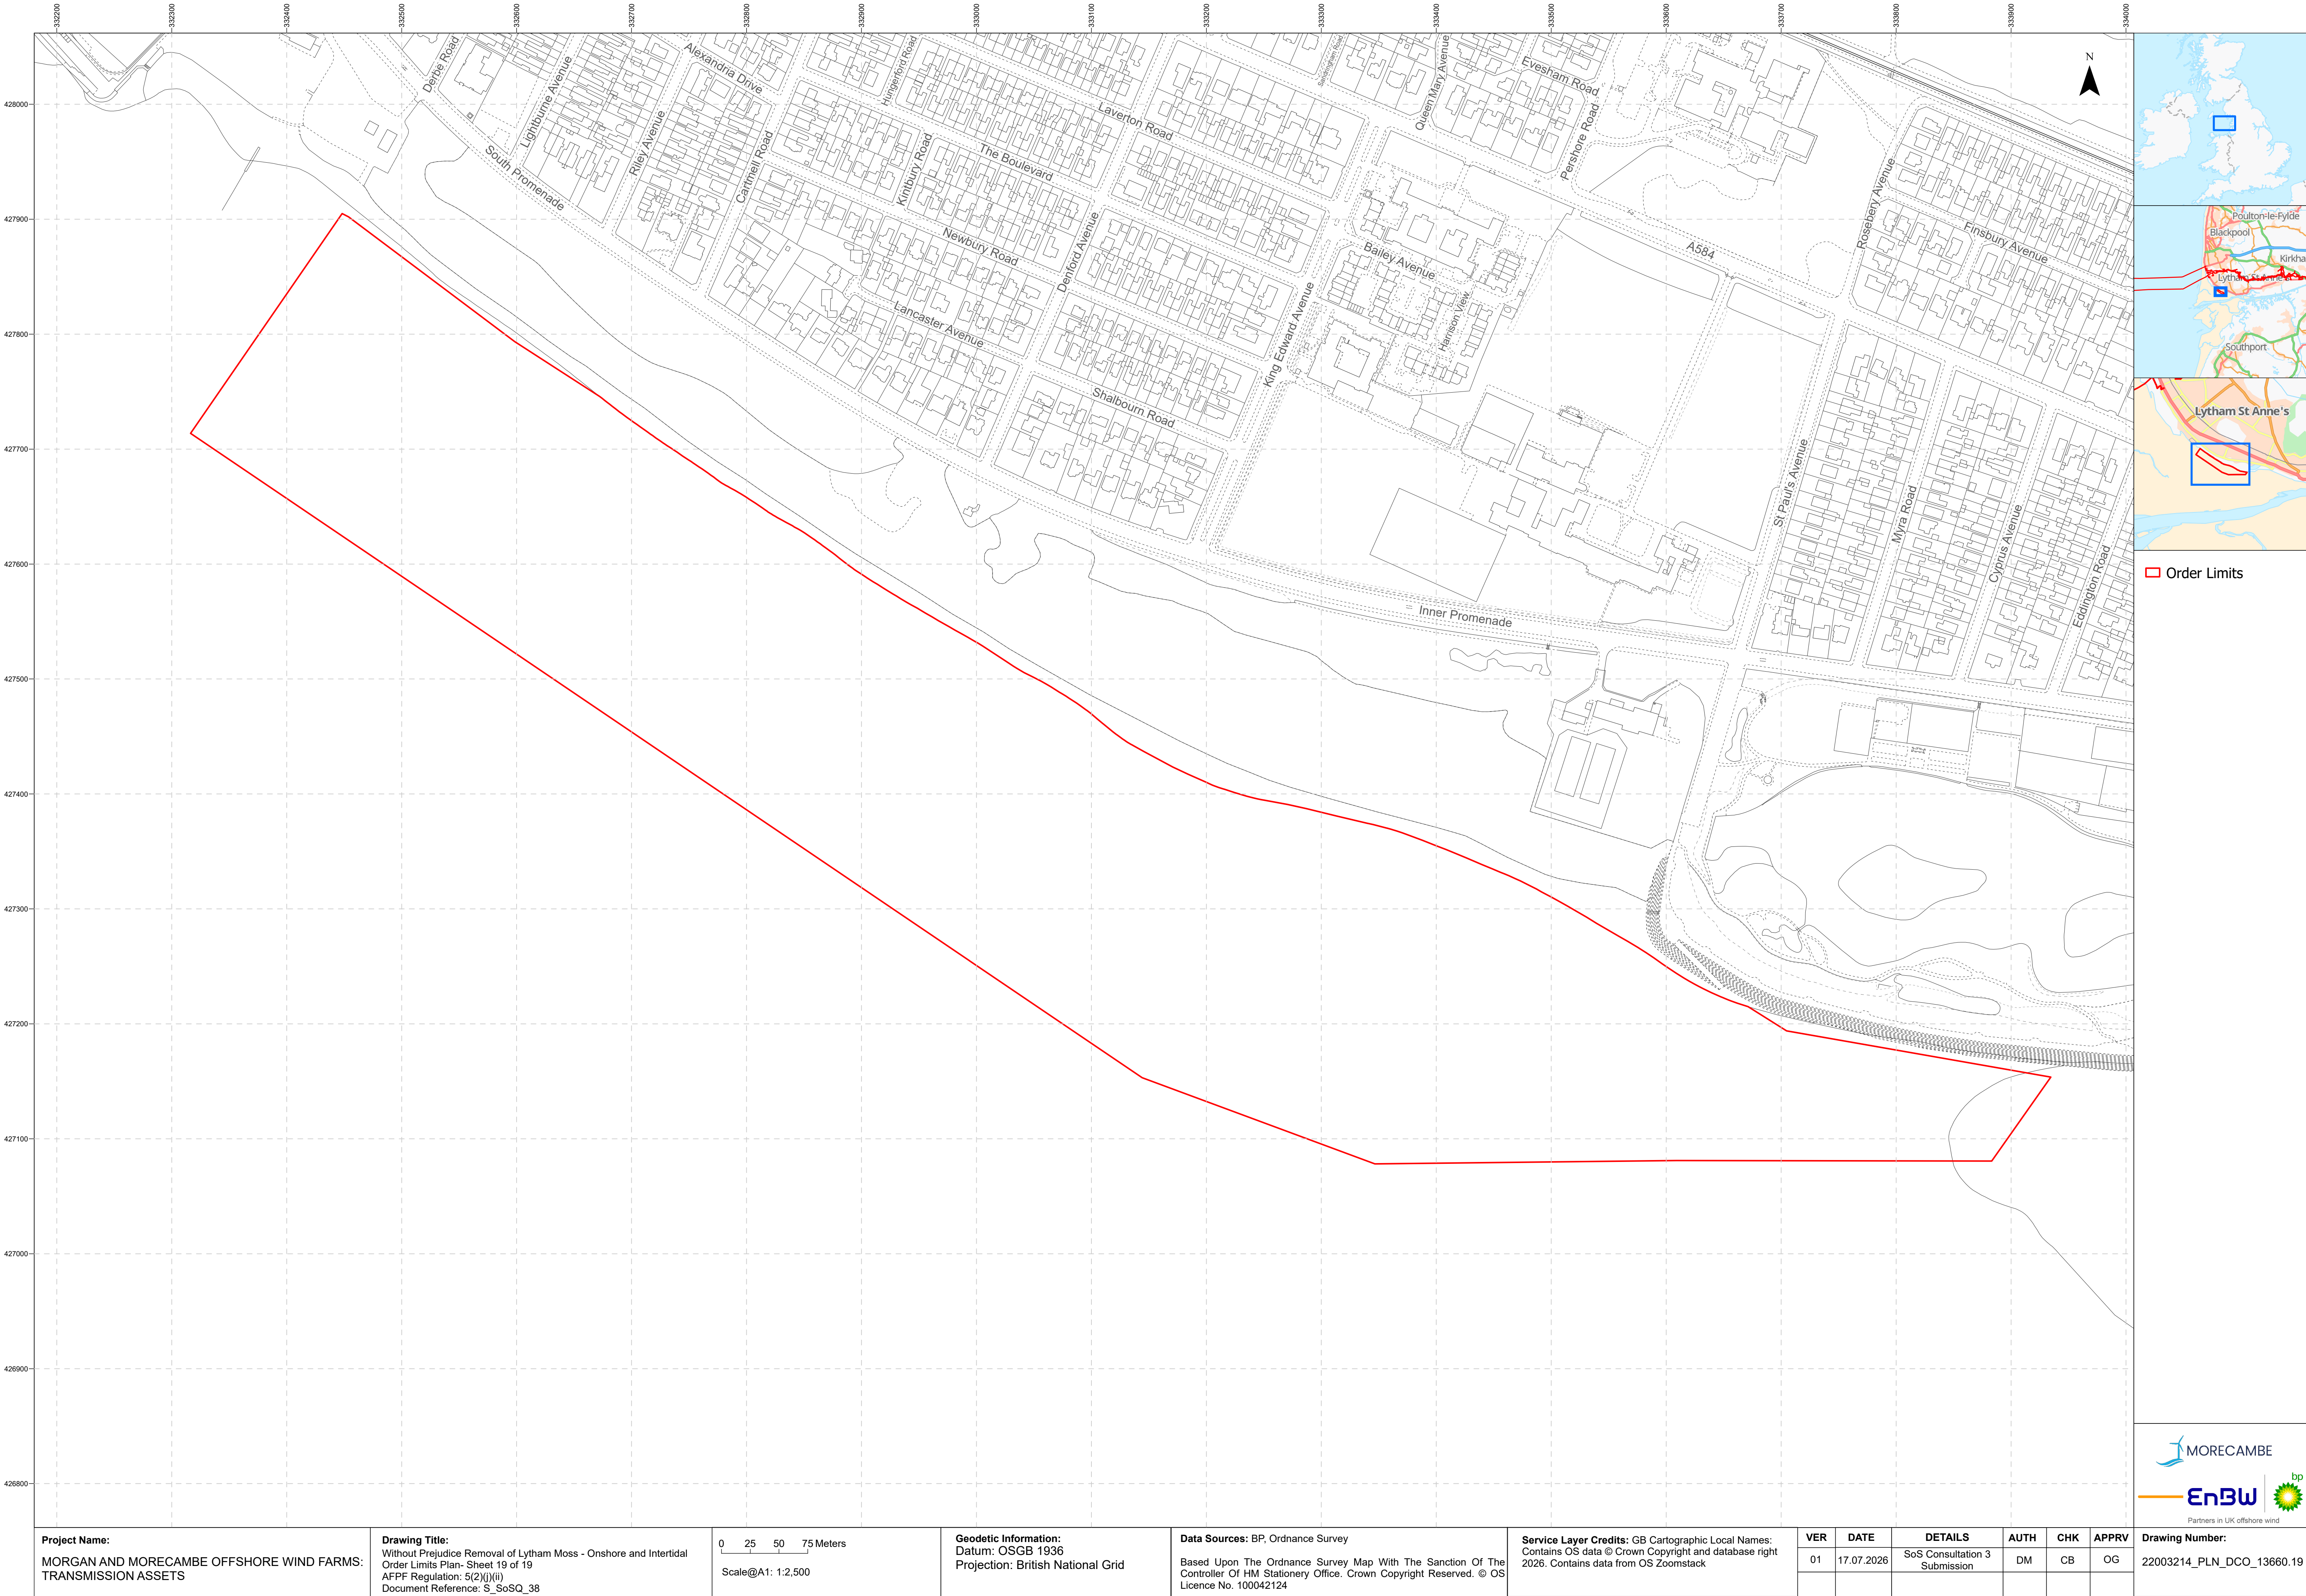

Order Limits

Project Name:
MORGAN AND MORECAMBE OFFSHORE WIND FARMS:
TRANSMISSION ASSETS

Drawing Title:
Without Prejudice Removal of Lytham Moss - Onshore and Intertidal
Order Limits Plan- Sheet 19 of 19
AFPF Regulation: 5(2)(j)(ii)
Document Reference: S_SoSQ_38

0 25 50 75 Meters
Scale@A1: 1:2,500

Geodetic Information:
Datum: OSGB 1936
Projection: British National Grid

Data Sources: BP, Ordnance Survey
Based Upon The Ordnance Survey Map With The Sanction Of The
Controller Of HM Stationery Office. Crown Copyright Reserved. © OS
Licence No. 100042124

Service Layer Credits: GB Cartographic Local Names:
Contains OS data © Crown Copyright and database right
2026. Contains data from OS Zoomstack

VER	DATE	DETAILS	AUTH	CHK	APPRV
01	17.07.2026	SoS Consultation 3 Submission	DM	CB	OG



Drawing Number:
22003214_PLN_DCO_13660.19