SUNNICA ENERGY FARM

EN010106

8.46 Arboricultural Impact Assessment Report

Planning Act 2008

Infrastructure Planning (Examination Procedure) Rules 2010

13 ~~November~~ January 2023~~2~~

Version number: 0~~1~~0

Planning Act 2008

Infrastructure Planning
(Examination Procedure) Rules 2010

Sunnica Energy Farm

Arboricultural Impact Assessment Report

Planning Inspectorate Scheme Reference	EN010106
Application Document Reference	EN010106/APP/8.46
Author	Sunnica Energy Farm Project Team

Version	Date	Status of Version
Rev 00	22 November 2022	Submitted at Deadline 3
Rev 01	13 January 2023	Submitted at Deadline 5

Table of contents

Chapter **Pages**

Table of contents **1**
1 Introduction **3**
1.1 Purpose of this assessment 3
2 Methodology **3**
2.1 The Scheme Survey 3
2.2 Detailed Tree Surveys 5
3 National Legislation, Policy and Guidance **5**
3.1 Trees and the Planning Process 5
3.2 Trees and Risk in the Context of Development 6
3.3 National Policy for Energy 7
3.4 Local Policy Context 7
3.5 East Cambridgeshire District Council Local Plan (2015) 7
3.6 East Cambridgeshire District Council Natural Environment – Supplementary Planning Document (SPD, Adopted 24 September 2020) 8
3.7 Forest heath and St Edmundsbury Local Plan Joint Development Management Policies document (2015) 10
4 General Arboricultural Principles **11**
4.1 General Principles 11
4.2 Below ground constraints 11
4.3 Soils 12
4.4 Above ground constraints 12
5 Statutory and Non-Statutory Designations **13**
6 Detailed Tree Survey Findings: **14**
7 Arboricultural Impact Assessment: **15**
7.1 The Scheme 15
7.2 Purpose 15
7.3 Summary of Arboricultural Impacts 16
7.4 Tree Works to Facilitate the Scheme 17
7.5 Incursions within the RPA or Canopy Spread 18
7.6 The Future Impact of Retained Trees 19
7.7 Tree Protection 20
7.8 Tree Planting 21
8 Summary and Conclusion **21**

References 24

Appendix A Tree Constraints Plans 25

Appendix B Detailed Tree Survey Schedule 26

Key to Abbreviations Used in the Detailed Survey Schedule 105

Appendix C Precautionary Arboricultural Method Statement 106

1 Precautionary Arboricultural Method Statement (PAMS) 106

1.2 Order of operations 106

1.3 Preliminary tree works and tree related impacts 106

1.4 Scheme briefing for site personnel 107

1.5 Site monitoring 108

1.6 Installation of tree protection fencing 108

1.7 Ground Protection 109

1.8 Movement of Vehicles and People and the Movement and Operation of Machinery 109

1.9 Site organisation, storage and mixing of materials 110

1.10 General principles for the management of tree roots 110

1.11 Installation of New Access Trackways within RPAs 110

1.12 Earthworks 111

1.13 Installation of tree protection fencing, security fencing and CCTV footings in proximity to retained trees 111

1.14 Removal of existing services 112

1.15 Diversion and installation of services (including cables) within RPAs 112

1.16 Use of trenchless techniques 112

1.17 Trenching techniques 112

1.18 Soft landscaping works 113

1.19 Dismantling of tree protection measures 114

1.20 Contact details in relation to arboricultural works 114

Appendix D Tree Protection and Removal Plans 115

Table of Tables

Table 1: Buffer Zones Determined Via Tree Height 4
Table 2: BS5837:2012 Tree Categorisation process 5
Table 3: Tree Replacement Table extracted from East Cambridgeshire District Council Natural Environment – Supplementary Planning Document (SPD, Adopted 24 September 2020).....9
Table 4: Number of Trees of Each Quality Category 14
Table 5: Summary of Removals, Incursions and Pruning (Detailed Tree Survey) 15

Table 6: Summary of Removals, Incursions and Pruning (High Level Tree Assessment) 16

1 Introduction

1.1 Purpose of this assessment

1.1.1 This Arboricultural Impact Assessment report (AIA) considers the likely direct and indirect arboricultural impacts required to facilitate the Scheme. A reasonable worst case has been assumed for the purposes of this assessment and it is likely that in practice tree loss and impacts could be significantly reduced.

1.1.2 This report includes tree constraints information in relation to the nature and potential level of constraint posed by existing trees within the assessment area (hereafter referred to as the Scheme). This has been determined via desk study information supplemented by site walkovers where feasible and a detailed tree survey of key areas where arboricultural impacts are considered most likely.

1.1.3 A site wide consideration of arboricultural impacts including the likely extent of tree loss is included along with a Precautionary Arboricultural Method Statement (PAMS) report addressing generic tree protection measures for works carried out in relation to the Scheme which will be developed into a detailed Arboricultural Method Statement post consent (pursuant to the CEMP).

1.1.4 This builds on the preliminary information provided in the Tree Constraints Report **[APP-101]**.

2 Methodology

2.1 The Scheme Survey

2.1.1 The tree constraints assessment of the Scheme has been based on Ordnance Survey base mapping, the National Tree Map (NTM) data set and walk-over review assessment for accessible areas. The extent of the Scheme is identified as the Order limits found within Appendix A of this report.

2.1.2 The walk-over tree constraints assessment of the Scheme was undertaken over intermittent dates including 10th to 12th December 2018, 7th to 9th January, 28th to 29th May, 3rd to 4th July, 6th September 2019, ~~and~~ 14th June 2021 and December 2022.

2.1.3 A walk-over review of ~~publicly~~ accessible areas was carried out to verify the general results of the desk top study, to map areas of trees of likely higher value and to identify those trees of low stature and large stem diameters which would not be afforded a suitable buffer zone using the assessment methodology based on tree height (which could apply to veteran trees afforded a high priority in the planning process). Full access was available to the main sites and cable routes were generally considered from publicly accessible land.

2.1.4 Approximate tree height and canopy spread information taken from the NTM data set was used in conjunction with walk-over assessments to identify trees likely to be of higher value and to allow an assessment of the typical approximate nature and spatial constraints associated with trees. A notional buffer zone has been added around each tree to illustrate the maximum likely area of significant constraint associated with above ground (tree canopies) and below ground (tree roots) parts of trees.

~~2.1.5~~ The buffer is based on a large data set of trees surveyed in detail by AECOM which cross references recorded tree heights against stem diameter ranges, as discussed below. Stem diameter is the key metric used to determine the Root Protection Area (RPA - the notional key area of tree root development important for tree health and stability) and this approach allows for the calculation of an estimated stem diameter for each tree or group derived from tree height information recorded in the NTM data set. This buffer zone is intended as high-level guidance only, based on our experience surveying trees and attempts to illustrate and account for the potential approximate area of constraint around each tree (which may be greater than the canopy spread shown in the NTM data). ~~.~~Table 1 ~~Table 1~~ illustrates the buffer zone applied to tree features of different height ranges.

2.1.5

Table 1: Buffer Zones Determined Via Tree Height

Tree Height Range	Buffer Zone (Radius)
0 – 5m	3.6m
5 – 10m	6.0m
10 – 15m	9.6m
15 – 20m	12.6m
20 – 25m	14.4m
25 – 30m	15.0m
>30m	15.0m

~~2.1.7~~2.1.6 In addition to the above process, an assessment of aerial photography using Google Earth was carried out to identify those trees and tree groups likely to be of the greatest significance where walk-over survey access was not possible and to fill any anomalies in the NTM data set. This assessment incorporated an assessment of tree height, canopy width, shadow and location and the relative importance of trees is based upon the discretion of the surveyor (experienced in undertaking tree surveys to BS 5837). Google Street View was also utilised on an ad hoc basis where feasible to provide additional verification of the assessment process.

~~2.1.8~~2.1.7 Section 4.6.1 of BS5837 recommends that RPAs are capped at 707m^2 and this is equivalent to a circle with a radius capped at 15m for each individual tree and therefore the buffer zone is capped at this radius around the largest trees within the study area.

2.1.8 The assessment results and information in relation to statutory and non-statutory designations such as Conservation Areas, Tree Preservation Orders and designated Ancient Semi Natural Woodland have been incorporated into the Tree Constraint Assessment Plans, included as Appendix A.

2.1.9 The assessment excludes lower hedgerow features (such as formally maintained or low stature hedgerows below circa 5m in height), and these are considered as part of **Chapter 8:** Ecology and Nature Conservation Assessment **[APP-040].**

2.2 Detailed Tree Surveys

2.2.1 The tree survey of those areas of the Scheme where the potential for significant arboricultural impacts is greatest has been based on a combination of Ordnance Survey Base Mapping, aerial imagery and the NTM dataset. Trees have been plotted indicatively with reference to GPS positions, Site features and publicly available aerial photography. As such all positions must be considered to be indicative only and the relative distances of features must be measured out on the Site. A Tree Constraints Plan of the Site is contained within Appendix A of this report.

2.2.2 The survey was otherwise conducted in accordance with the general principles of BS5837:2012 Trees in relation to design, demolition and construction – Recommendations (BS5837).

2.2.3 The initial fieldwork was undertaken between August 2021 and July 2022, during which time dimensional data and observational information were collected. A diameter tape measure was used to measure stem diameters where feasible. The fieldwork informing this report has comprised a preliminary, non-intrusive, visual survey undertaken from ground level with the specific intention of evaluating the quality and benefits of trees on the Site.

2.2.4 Where further inspection is deemed appropriate to ascertain the condition of the tree or other arboreal features, this has been identified within the preliminary management recommendations. Average dimensions or dimensional ranges have occasionally been used, where appropriate, to best describe features.

2.2.5 The tree categorisation process recommended by BS5837:2012 is summarised in the Tree Survey Schedule of the Site included as Appendix B.

Table 2: BS5837:2012 Tree Categorisation process

Category	Definition
A	High quality, minimum of 40+ years remaining contribution
B	Moderate quality, minimum of 20+ years remaining contribution
C	Low quality, minimum of 10+ years remaining contribution
U	Unsuitable for retention, <10 years remaining contribution
1	Arboricultural value
2	Landscape value
3	Conservation or cultural value

3 National Legislation, Policy and Guidance

3.1 Trees and the Planning Process

3.1.1 The National Planning Policy Framework (NPPF) seeks to ensure that new development is sustainable and underlines the importance of Green Infrastructure, of which trees form an integral part. This encompasses a recognition of the importance of trees in relation to the management of air, soil and water quality along with other associated ecosystem services and climate

change adaption. The NPPF also seeks to achieve the protection and enhancement of landscapes and a net gain in biodiversity. Finally, it specifically identifies veteran and ancient trees and woodland as a highly valuable and irreplaceable habitat.

3.1.2 'BS5837:2012 Trees in relation to design demolition and construction – Recommendations (BS5837)' provides a framework which sets out how trees should be considered in this context and also explicitly applies to development where planning consent is not required.

3.1.3 BS5837 recommends that a tree survey is undertaken to identify the quality and benefits of trees and the spatial constraints associated with them. This is then used to produce a Tree Constraints Plan showing the above and below ground constraints associated with trees. This drawing is used to inform the design process and to allow the retention of good quality trees where appropriate.

3.1.4 An AIA is then developed to identify the likely direct and indirect impacts of a proposed development, and plans are prepared to identify trees to be removed or retained and to illustrate how retained trees are to be protected.

3.2 Trees and Risk in the Context of Development

3.2.1 Tree owners/managers have a legal duty to prevent foreseeable harm. It is generally accepted that this duty can be fulfilled by undertaking proactive inspections of significant trees to identify obvious defects and by taking appropriate remedial action or gaining further advice as appropriate.

3.2.2 The tree surveys carried out as the basis of this report has been primarily for planning purposes, focusing on the quality and benefits of the trees and is not specifically designed to assess the safety of trees within the Scheme.

3.2.3 The Construction (Design and Management) Regulations (2015) states that developers and contractors have responsibilities for health and safety as a result of their actions. Should trees be left in an unstable or hazardous condition the Health and Safety Executive (HSE) could seek to prosecute those responsible along with the potential for further Civil claims for damages.

3.2.4 Full consideration must be given to the presence of species protected under the Wildlife and Countryside Act (1981 - as amended), the Countryside Rights of Way Act (2000) and the Conservation of Habitats and Species Regulations (2017). In particular, the presence of bats and nesting birds. It is recommended that wherever possible, significant tree/hedge works take place outside of the typical bird nesting season of March to September.

3.2.5 Any tree surgery recommendations contained within this report are to be undertaken in accordance with BS3998: 2010 Tree work – Recommendations (BS3998) by suitably qualified and insured contractors. Significant pruning works are best undertaken when trees are dormant or outside periods of high functional activity to reduce the overall impact on energy available to the tree for growth and processes. In general, the optimum period for works is between November to February and July to August (subject to the presence of protected species) when the tree is less active and better placed to respond to wounding and a reduction in leaf area.

3.2.6 The Hedgerows Regulations (1997) protect agricultural or countryside hedgerows which meet the requirements of an 'important hedgerow'. These include a minimum length of 20m (or meets another hedge at each end) and a minimum age of at least 30 years. A wide range of other ecological and archaeological/heritage features can constitute an important hedgerow. Powers in relation to hedgerows are contained within the DCO.

3.2.7 The DCO disapplies the need for a felling licence as may otherwise be required by the Forestry Commission, in light of the proposals in the Framework CEMP and OLEMP.

3.3 National Policy for Energy

3.3.1 The National Policy Statement for Energy Infrastructure documents EN-1, EN-3 and EN-5 (2011) set out the national policy for energy infrastructure in relation to planning and design.

3.3.2 In terms of trees, document EN-1 draws reference to Ancient Woodland and Veteran Trees. Section 5.3.14 details that: 'Ancient woodland is a valuable biodiversity resource both for its diversity of species and for its longevity as woodland. Once lost it cannot be recreated. Planning Inspectorate should not grant development consent for any development that would result in its loss or deterioration unless the benefits (including need) of the development, in that location outweigh the loss of the woodland habitat. Aged or 'veteran' trees found outside ancient woodland are also particularly valuable for biodiversity and their loss should be avoided. This does not prevent the loss of such trees where the Planning Inspectorate is satisfied that their loss is unavoidable. Where such trees would be affected by development proposals the applicant should set out proposals for their conservation or, where their loss is unavoidable, the reasons why.'

3.3.3 The Department of Business, Energy and Industrial Strategy (BEIS) consulted upon a review of energy National Policy Statements (NPS) with consultation closing in November 2021. The draft NPS have been reviewed and there are no substantive changes in relation to arboriculture.

3.4 Local Policy Context

3.4.1 The Scheme is located within two local authority districts. These are West Suffolk Council and East Cambridgeshire District Council.

3.4.2 The relevant council websites each contain guidance on how the authority expects to see trees considered in relation to development and design. The relevant policies referring to trees are outlined in separate headings within this section according to the local authority district.

3.5 East Cambridgeshire District Council Local Plan (2015)

3.5.1 Policy ENV 7: Biodiversity and geology

'Development proposals where the main aim is to conserve biodiversity will be permitted; and opportunities to incorporate biodiversity into new development will be supported.

All development proposals will be required to:

Article I. Protect the biodiversity and geological value of land and buildings and minimise harm to or loss

of environmental features, such as trees, hedgerows, woodland, wetland and ponds.

Article II. Provide appropriate mitigation measures, reinstatement or replacement of features and/or

compensatory work that will enhance or recreate habitats on or off site where harm to

environmental features and habitat is unavoidable; and

Article III. Maximise opportunities for creation, restoration, enhancement and connection of natural habitats as an integral part of development proposals.'

3.6 East Cambridgeshire District Council Natural Environment – Supplementary Planning Document (SPD, Adopted 24 September 2020)

3.6.1 Policy SPD.NE8: Trees and Woodland

'Development proposals should be prepared based on the overriding principle that:

(a) the existing tree and woodland cover is maintained, improved and expanded; and

opportunities for expanding woodland are actively considered and implemented where practical and appropriate to do so.

Existing Trees and Woodland

Planning permission will only be granted if the proposal provides evidence that it has been subject to adequate consideration of the impact of the development on any existing trees and woodland found on-site (and off-site, if there are any trees near the site, with 'near' defined as the distance comprising 12 times the stem diameter of the off-site tree). If any trees exists on or near the development site, 'adequate consideration' is likely to mean:

(a) the completion of a British Standard 5837 Tree Survey and, if applicable,

(b) an Arboricultural Method Statement, Impact Assessment and Tree Protection Plan.

Where the proposal will result in the loss or deterioration of these irreplaceable assets (as defined by the NPPF):

(c) ancient woodland; and/or

(d) the loss of aged or veteran trees found outside ancient woodland

permission will be refused, unless, and on an wholly exceptional basis, the need for and benefits of the development in that location clearly outweigh the loss and a suitable compensation strategy exists.

Where the proposal will result in the loss or deterioration of a tree protected by a Tree Preservation Order or a tree within a Conservation Area, then permission will be refused unless:

(e) there is no net loss of amenity value which arises as a result of the development; or

(f) the need for, and benefits of, the development in that location clearly outweigh the loss.

Where the proposal will result in the loss of any other tree or woodland not covered by above, then the council will expect the proposal to retain those trees that make a significant contribution to the landscape or biodiversity value of the area, provided this can be done without compromising the achievement of good design for the site.

Mitigating for loss of Trees and Woodland

Where it is appropriate for higher value tree(s) (category A or B trees (BS5837)) and/or woodland to be lost as part of a development proposal, then appropriate mitigation, via compensatory tree planting, will be required. Such tree planting should:

*(g) take all opportunities to meet the six Tree Planting Principles (*refer to Section 7.6 of this report*); and*

(h) unless demonstrably impractical or inappropriate, provide the following specific quantity of compensatory trees:

Table 3: Tree Replacement Table extracted from East Cambridgeshire District Council Natural Environment – Supplementary Planning Document (SPD, Adopted 24 September 2020)

Trunk diameter (mm) at 1.5m above ground of tree lost to development	Number of replacement trees required, per tree lost*
75-200	1
210-400	4
410-600	6
610-800	9
810-1000	10
1000+	11

* replacement based on selected standards 10/12 cm girth at 1m

New Trees and Woodland

Where appropriate and practical, opportunities for new tree planting should be explored as part of all development proposals (in addition to, if applicable, any necessary compensatory tree provision).

Where new trees are proposed, they should be done so on the basis of the six Tree Planting Principles. Proposals which fail to provide practical opportunities for new tree planting will be refused.

Planting schemes should include provision to replace any plant failures within five years after the date of planting. Planting of trees must be considered in the context of wider plans for nature recovery which seeks to increase biodiversity and green infrastructure generally, not simply planting of trees, and protecting / enhancing soils, particularly peat soils.

Tree planting should only be carried out in appropriate locations that will not impact on existing ecology or opportunities to create alternative habitats that could deliver better enhancements for people and wildlife, including carbon storage.

Where woodland habitat creation is appropriate, consideration should be given to the economic and ecological benefits that can be achieved through natural regeneration. Any tree planting should use native and local provenance tree species suitable for the location.

Management and Maintenance

In instances where new trees and/or woodlands are proposed, it may be necessary for the Council to require a tree/woodland management plan and/or appropriate developer contributions to be provided, to ensure provision is made for appropriate management and maintenance of the new trees and/or woodland.

Carbon Sequestration Implications of Proposals

The net increase or decrease in tree cover as a consequence of a development will be a material consideration in the decision-making process in terms of the carbon sequestration consequences of the proposal. Considerable weight in favour of a proposal will be given where the net situation is a considerable increase in tree cover (and hence the positive and significant contribution to carbon sequestration). Where the net situation is a loss of trees, weight against a proposal will be given as a consequence of the loss of carbon sequestration, with the degree of weight dependent on the scale of net loss.

3.7 Forest heath and St Edmundsbury Local Plan Joint Development Management Policies document (2015)

3.7.1 Policy DM13: Landscape Features

'Development will be permitted where it will not have an unacceptable adverse impact on the character of the landscape, landscape features, wildlife, or amenity value.

All proposals for development should be informed by, and be sympathetic to, the character of the landscape.

All development proposals should demonstrate that their location, scale, design and materials will protect, and where possible enhance the character of the landscape, including the setting of settlements, the significance of gaps between them and the nocturnal character of the landscape.

Developers/applicants will be required to submit, where appropriate, landscaping schemes with applications for planning permission and for the approval of reserved matters.

Where any harm will not significantly and demonstrably outweigh the benefit of the proposal, development will be permitted subject to other planning considerations.

However, it is essential that commensurate provision must be made for landscape mitigation and compensation measures, so that harm to the locally distinctive character is minimised and there is no net loss of characteristic features.

Where this is not possible development will not be permitted.'

The policies provide an insight into the value afforded to trees and woodland in the planning process and how the local authorities expect impacts on trees and proposed new planting to be managed.

4 General Arboricultural Principles

4.1 General Principles

4.1.1 Trees are dynamic living organisms which provide essential benefits to society and the wider environment. Any proposed development with the potential to impact on trees must take into consideration the value of trees on site, the impact of any proposed activity along with any potential future conflicts on a site. Suitable measures to safeguard retained trees or mitigate the loss of trees (to be removed) will need to be fully considered.

4.1.2 Tree branches and roots frequently grow across site boundaries and off-site trees can pose a significant constraint and should be carefully considered when assessing the developable space within a site.

4.2 Below ground constraints

4.2.1 Below ground tree roots and the soil environment in which they grow need to be protected if the tree is to be retained. Trees grow in association with fungi and other soil organisms which are of key importance to tree health. Roots are essential for anchorage, the uptake of water and nutrients, and the storage of energy (carbohydrates) for the future growth and function of the tree.

4.2.2 Roots can be damaged by physical severance or wounding (e.g. following excavation of the soil) which can lead to the development of decay and a decline in vitality and/or instability.

4.2.3 Raising the soil level can bury tree roots at a depth where suitable conditions for growth are less available. Toxic materials discharged into the soil (such as cement-based aggregates, fuel and chemicals) can lead to root death and dysfunction. Soils can be compacted to levels inhospitable to tree growth with even a single pass of machinery, regular pedestrian traffic or the storage of plant and materials. Relieving compaction can be problematic and may require costly remedial works. Changes in drainage/water levels can also have significant long-term impacts for tree health.

4.2.4 The effects of these incursions may take many years to manifest, with a resulting decline in amenity value and potentially the death or failure of the tree. It should

be noted that older trees are particularly sensitive to damage and changes in conditions.

4.2.5 The RPA is a notional area considered to be the minimum zone that must be protected to avoid any adverse impacts on retained trees. This area is deemed to be particularly important for tree stability, growth, function and health. However, roots may extend far greater distances, with the distribution of the root system relating directly to the availability of suitable conditions for growth (namely oxygen, water and nutrients). It is generally accepted that tree roots are predominantly located in the upper 1000mm of soil; however, roots may develop at deeper levels where conditions allow.

4.2.6 The default position must be that all development, including any associated services will occur outside the RPAs of retained trees. Where this is unavoidable, it may be appropriate to use special measures to install structures, services or surfacing within RPAs which allow the protection of roots and soil structure which are essential for tree growth and keep any incursion to a minimum.

4.2.7 Further steps to improve or increase the useable rooting area available to the tree may also be required.

4.2.8 Further guidance on tree protection measures in relation to the Scheme are identified in the PAMS report contained within Appendix C.

4.3 Soils

4.3.1 On shrinkable clay soil, tree growth can lead to the differential movement of structures as moisture is removed from the soil during the growing season. Soils must be carefully assessed, and any foundations must be installed following the recommendations of National House Building Council (NHBC) Standards Chapter 4.2: *Building Near Trees* (2021) to avoid potential future damage. Where trees which predate existing structures are to be removed, this can result in heave as the soils are re-wet.

4.3.2 The advice of a suitably qualified engineer must be obtained to inform any potential issue of heave. Specific advice in relation to this issue is beyond the scope of this report.

4.4 Above ground constraints

4.4.1 Tree stems and branches can restrict available space on a site. Damage or wounding (including excessive pruning) can significantly reduce the amenity contribution of the tree and may lead to the development of dysfunction and decay, with significant long-term implications for tree health. The future impact of existing trees should be carefully considered, including individual species characteristics (such as potential future size, fruit fall, shade etc.) and how the tree will interact with any proposed development and future land use. Annual tree growth can lead to direct damage if stems/branches (or roots) come into physical contact with structures and this must also be taken into consideration.

5 Statutory and Non-Statutory Designations

5.1.1 Following searches of the Scheme area performed in 2019 and updated in 2022, statutory designations including Conservation Areas and Tree Preservation Orders (TPOs) affecting trees within or immediately adjacent to the Scheme are highlighted in the Tree Constraints Plans in Appendix A.

5.1.2 Conservation Areas are present within the Scheme at Freckenham (Freckenham Conservation Area) and at Exning (Exning Conservation Area) as shown on sheet 18 of the Tree Constraints Plan. The Conservation Areas are limited to highway sections of the Order limits only and are not present within the main solar sites or the proposed cable routes.

5.1.3 Two TPOs are located within the Scheme at land south of Worlington (West Suffolk Council) and the beech avenue at Chippenham Road, east of Snailwell (East Cambridgeshire District Council) as shown on sheet 6 and sheet 14 of the Tree Constraints Plan.

5.1.4 A small number of trees subject to TPO are located just outside the Scheme boundary at land at Freckenham (West Suffolk Council) as shown on sheet 18 of the Tree Constraints Plan.

5.1.5 The Woodland Trust Ancient Tree Inventory contains a database of recorded ancient or veteran trees. The findings from the interactive mapping tool indicate the presence of a veteran sycamore (*Acer pseudoplatanus*) in land to the northwest of Burwell. This tree was not found during the walkover assessment of the area identified in the Woodland Trust inventory however any proposed works in this area should be subject to a more detailed assessment to identify the precise location of this tree and to confirm its veteran status. However, several trees with veteran characteristics were identified during the walkover and detailed tree survey which are identified in the accompanying Tree Constraints Plans contained in Appendix A of this report. These include trees: T130, T133, T134, T136, T137, T138, T139, T141, T143, T144, T147, T164, T216, T218, T223 and T225. Trees have been classified as ancient or veteran based on their size (at least mature for the species) and the presence and extent of significant habitat features associated with veteran or ancient trees such as extensive decay, dead wood habitat and crown retrenchment.

5.1.6 Veteran trees are considered to be an irreplaceable resource and should be retained and protected. The NPPF and current standing advice from Natural England and the Forestry Commission states that development affecting veteran trees should be refused unless justification is wholly exceptional. Veteran trees require a buffer equivalent to 15 x stem diameter (at 1.5m) or the canopy spread +5m (whichever is greatest) and this has been applied to all veteran tree features identified via the detailed tree surveys.

5.1.7 Following an assessment of the Magic Map resource, no Sites of Special Scientific Interest (SSSIs) or designated Ancient Woodland areas are located directly within the Scheme. Non-statutory designation search results on Magic Map identified designated ‘deciduous woodland’, ‘traditional orchard’ and ‘wood pasture and parkland’. These non-statutory designations do not require specific

consent prior to tree works but are likely to be taken into consideration by the LPA when reviewing the DCO Application.

6 Detailed Tree Survey Findings:

6.1.1 The detailed tree survey included 3~~2~~525~~5~~ tree features on land at Burwell, north of Snailwell, south and east of Chippenham and south and west of Worlington. Surveyed trees comprised a wide range of species including: hybrid black poplar (*Populus × canadensis*), white poplar (*Populus alba*), oak (*Quercus sp.),* Scots pine (*Pinus sylvestris*), common beech (*Fagus sylvatica*), Corsican pine (*Pinus nigra*), common ash (*Fraxinus excelsior),* crack willow (*Salix fragilis*), apple (*Malus domestica*), field maple (*Acer campestre*), hawthorn (*Crataegus monogyna*), blackthorn (*Prunus spinosa*), sycamore (*Acer pseudoplatanus*), elm (*Ulmus* sp), elder (*Sambucus nigra*) and aspen (*Populus tremula*).

6.1.2 Surveyed trees ranged from poor to good in condition and from young to mature in life stage. ~~-~~As summarised by Table 4~~table 3~~ the majority of surveyed trees were considered to be of moderate or low quality although a substantial number of high and very low quality trees were also identified.

6.1.3 Sixteen likely veteran or ancient trees were identified at land north of Snailwell and south of Worlington and these features represent the greatest arboricultural constraints within the survey area.

~~6.1.3~~6.1.4 The tree avenue to the south of Chippenham Hall is part of the Registered Park and Garden and is understood to have been formed of a double line of beech trees. The majority of beech trees in this area are no longer present and the linear tree group that remains is largely informal and formed of pine, ash, thorn and other mixed broadleaved species including some semi-mature and early mature beech. A small number of mature beech are still present which may have formed part of the original avenue feature.

Table 4: Number of Trees of Each Quality Category[1]

Category	Number of tree features
A	5~~3~~7
B	162~~07~~
C	107~~90~~
U	2~~6~~1
Total	**352~~255~~**

~~6.1.4~~6.1.5 Further summary information on wider tree cover as identified via site walkover and desk study assessment is identified in the Tree Constraints Report **[APP-101].**

[1] See Table 2~~table 1~~ for definitions of each quality category.

7 Arboricultural Impact Assessment:

7.1 The Scheme

7.1.1 A comprehensive description of the Scheme is provided in **Chapter 3** of the ES **[REP2-023].**

7.2 Purpose

7.2.1 This impact assessment sets out the reasonable worst-case scenario of likely arboricultural impacts associated with the Scheme.

7.2.2 A brief summary of trees to be removed, tree works, and incursions for tree features subject to detailed tree survey are detailed within Table 5 ~~table 4~~ below. Canopy areas to be removed have also been recorded (rounded up to the nearest 50m^2).

~~7.2.2~~

Table 5: ~~-~~Summary of Removals, Incursions and Pruning (Detailed Tree Survey)

Impact	Category A	Category B	Category C	Category U
Tree features to be removed to facilitate the Scheme	W94 (part), W112 (part), W255 (part), W256 (part)	G10 (part), G21 (part), G81 (part), G111 (part), G118, G206 (part), G243 (part), G247 (part), H249 (part), H251 (part), T335, T337,	G9 (part), T44, G82 (part), G119 (part), ~~H194 (part),~~ G196 (part), H197 (part), ~~G203 (part),~~ T219, G248 (part), T336,	G102, T228,
Total canopy area removed m^2	244~~2~~50m^2	3300~~2950~~m^2	135~~175~~0m^2	3~~0~~0m^2
Total	**4 part woodland groups**	**2 individual trees, 1 tree group, part of 7 tree groups, part of 2 hedgerows**	**3~~2~~ individual trees, part of 5~~6~~ tree groups, part of 1~~2~~ hedgerows.**	**1~~1~~ individual tree, 1 tree group**
Total canopy area		**740~~925~~0m^2**		
Trees/groups which may require some incursion into their construction exclusion zone	~~T141, T143, T144, T147~~0	T60, T131, T132	~~T145, G181~~0	~~T142~~0
Total	**~~4 individual trees~~0**	**3 individual trees**	**~~1 individual tree, 1 tree group~~0**	**~~1 individual tree~~0**
Trees/groups to be pruned under arboricultural supervision	~~T143~~0	T332~~-~~	~~T40, G181, T222~~	0~~T142~~
Total	**~~1 individual tree~~0**	**1 individual tree~~-~~**	**0~~2 individual trees, 1 hedge~~**	**~~1 individual tree~~0**

7.2.3 A brief summary of trees to be removed, tree works, and incursions related to trees assessed via high level desk study/walkover are detailed within Table 6~~table 5~~ below. Canopy areas have been rounded up to the nearest 50m^2.

Table 6: Summary of Removals, Incursions and Pruning (High Level Tree Assessment)

Impact	Likely Category A	Likely Category B	Likely Category C	Likely Category U
Tree features at risk of removal to facilitate the Scheme (canopy area in m^2)	150m^2	52~~3~~00m^2	290~~85~~0m^2	-
Total canopy area to be removed		**825~~30~~0**		
Tree features at risk of pruning to facilitate the Scheme	-	1 tree (Freckenham)	-	-
Total		**1 tree**		

7.3 Summary of Arboricultural Impacts

7.3.1 Tree removals are illustrated on the Tree Protection and Removal Plans (TPRP) included as Appendix D. These are presented as a reasonable worst case and will be further reviewed and reduced where feasible as part of the detailed design process and this is secured as a commitment in the FCEMP **[EN010106/APP/6.2].**

7.3.2 Six~~Two~~ individual trees, two~~wo~~ tree groups, part of four~~four~~ woodland groups, part of 12~~3~~ tree groups and part of three ~~four~~ hedgerow features are to be removed to facilitate the Scheme.~~-~~ This includes four part woodland groups of high quality (Category A), two individual trees, one tree group, part of seven tree groups and part of two~~two~~ hedgerows of moderate quality (Category B), three ~~two~~ individual trees, part of five~~six~~ tree groups ~~-~~and part of one~~two~~ hedgerow~~s~~ of low quality (Category C) and ~~-one~~one ~~-~~individual tree and one tree group which are unsuitable for retention for more than 10 years (Category U).

7.3.3 These Category U trees are not suitable for long-term retention and their removal is justified regardless due to pre-existing condition and proximal land use.

~~7.3.3~~

7.3.4 In addition as a reasonable worst case the Scheme would require the removal of up to 150m^2 of likely high quality tree cover, 52~~3~~00m^2 of likely moderate quality tree cover and 290~~85~~0m^2 of likely low quality tree cover. In practice this extent of loss is likely to be reduced with the application of design refinements and careful working methodologies such as those set out in the PAMS included as Appendix C.

7.3.5 In total 740~~905~~0m^2 of trees subject to detailed survey would be removed and 825~~30~~0m^2 of trees assessed via walkover and desk study would be removed and

this gives a combined total canopy cover which would be removed to facilitate the Scheme of 1565~~7055~~m^2 (1.5~~7~~65ha).~~.~~

~~7.3.5~~7.3.6 Circa 47% of all tree canopy cover to be removed has been subject to detailed survey with 53% assessed via desk study and walkover review (where feasible). The relative percentage of surveyed trees to be removed has been substantially reduced due to design changes and commitments secured via the FCEMP **[EN010106/APP/6.2]**.

~~7.3.6~~7.3.7 The loss of lower growing and managed hedgerows is considered via **Chapter 8:** Ecology and Nature Conservation Assessment **[APP-040]** and is excluded from this Impact Assessment. No important hedgerows are to be removed.

~~7.3.7~~7.3.8 In practice it is likely that tree loss and impacts could be significantly reduced. A detailed tree survey for all areas of the Scheme where trees are at risk of impact will be undertaken in advance of commencement. An updated assessment of arboricultural impacts and mitigation along with a detailed Arboricultural Method Statement will then be submitted to the Local Planning Authorities for agreement in advance and this is a commitment in the FCEMP **[EN010106/APP/6.2]** ~~(latest version submitted to the Examination at Deadline 3)~~ secured as part of the draft DCO **[REP2-012]**.

~~7.3.8~~7.3.9 All of the trees to be removed are on or within the Order limits boundary.

7.3.10 Of the trees to be removed one individual tree and part of two tree groups which have been subject to a detailed tree survey are protected by a TPO to the south of Worlington. An additional two trees protected by TPO at Chippenham Road and a third tree not subject to a TPO ~~which have not been subject to detailed tree survey~~ are also to be removed to facilitate the proposed cable route and associated access (which utilises an existing farm access to minimise tree removals). The design has been developed to minimise the loss of trees however the loss of these trees cannot be avoided if the current Scheme design is to be achieved. In relation to trees south of Worlington, t~~T~~hese trees are located adjacent to a public right of way and tree loss will impact on the amenity of users of the route, however more broadly the tree line is set well back from other well used areas and is largely screened from the nearest roads via roadside hedgerows and field boundary trees. The potential for these trees to be retained will be reviewed as part of the detailed design process and this is secured as a commitment in the FCEMP **[EN010106/APP/6.2]** ~~Project Team is further considering how impacts to trees subject to TPO can be reduced or avoided and will provide an update by Deadline 04~~.

~~7.3.9~~7.3.11 Impacts to trees which form part of the tree avenue within the Registered Park and Garden of Chippenham Hall will be avoided, either by micrositing the Scheme works around them, or through implementing HDD.

~~7.3.10~~

7.3.12 No trees within County Wildlife Sites (CWS) are to be removed to facilitate the Scheme.

~~7.3.11~~7.3.13 No veteran or ancient trees are to be removed and the retention and protection of any unidentified veteran trees is a commitment in the FCEMP **[EN010106/APP/6.2]** ~~(latest version submitted at Deadline 3)~~ secured via the draft DCO **[REP2-012]**.

7.4 Tree Works to Facilitate the Scheme

7.4.1 Tree removals and tree pruning works to facilitate the Scheme are detailed in the Tree Survey Schedule included as Appendix B. Tree works should be completed before any other work begins on the Site.

~~7.4.2 One veteran tree (T143) is to be crown lifted to clear an existing field access route to provide a 5.2m clearance and to manage the risk of damage from construction traffic. This pruning will be limited to low diameter branches and epicormic growth only and will not have a negative impact on the amenity or health of the tree. Regardless of any proposed development this tree is recommended to be pollarded (as a preliminary management recommendation in the Tree Survey Schedule in Appendix B) to prevent its collapse adjacent to the existing highway.~~

7.4.2 One individual moderate quality tree (subject to TPO at Chippenham Road) is~~Two individual low quality tree~~ to be pruned to facilitate the Scheme.

7.4.3 T332 (moderate quality) at Chippenham Road would be crown lifted to 4m to the north and east to provide a clearance of vehicle oversail for the use of the existing access point for construction access.

~~7.4.3~~7.4.4 ~~s and one group are to be pruned to facilitate the Scheme. T40 is to be crown lifted to 5.2m over the area of grass verge where large construction vehicles will oversail. This will prevent any risk of direct damage to the tree.~~ T227 (low quality) could ~~is to~~ be pollarded to 10-12m to address structural defects which would represent an unacceptable risk following the change in use of adjacent land. These works are justified to promote the long term survival of the tree but will be avoided and the area within falling distance of the tree will be protected as a fenced exclusion zone. ~~G181 (category C) is to be cut back to facilitate construction access in to Sunnica West Site B and this pruning will not detract from its value as a hedgerow feature. T142 (Category U) is also to be pruned to clear the proposed access route.~~

~~7.4.4~~7.4.5 Two trees (T219 – Category C, and T228 Category U) are to be felled due to their condition in proximity to the development. However, these trees could also be retained as standing deadwood monoliths where feasible to provide habitat features.

~~7.4.5~~7.4.6 One semi mature chestnut (*Aesculus* species) which has not been subject to a detailed tree survey may require pruning following a review of available desktop information. This is considered likely to be a moderate quality feature and is located in a central traffic island at Freckenham within the Freckenham Conservation Area. The tree is to be cut back by approximately 1m to the west to allow an oversail of construction traffic. This extent of pruning will not have a significant negative impact on the long-term health or amenity value of the tree and lower canopy will likely regenerate following pruning. Pruning of the lower crown of the tree is also likely to be required to maintain a reasonable clearance of the highway into the future, regardless of the Scheme.

~~7.4.6~~7.4.7 Tree removals within groups proposed for part-removal should be carried out under arboricultural supervision, ensuring the trees to be removed are uniquely identified and agreed prior to felling operations. The remaining trees shall then be re-inspected by an appointed site arboriculturist to determine their suitability for retention and any additional pruning or management requirements and/or the removal of deadwood as necessary.

~~7.4.7~~7.4.8 All tree pruning works are to follow the principles of BS3998: 2010 Treework – Recommendations. These works must be carried out by suitably qualified and insured contractors, the Arboricultural Association provides a list of contractors who meet these requirements.

~~7.4.8~~7.4.9 Should the requirement for additional tree works be identified, this will be discussed with an appointed arboriculturist and no works will be undertaken without the consent of the relevant LPA.

7.5 Incursions within the RPA or Canopy Spread

~~7.5.1 An RPA incursion within the RPA of four likely veteran trees classified as high quality, two trees classified as moderate quality and one tree and one tree group of low quality is required to achieve access into Sunnica West Site B. Furthermore an incursion into the RPA of one Category U tree is also required to facilitate this access route.~~

~~7.5.2 This incursion will be sited on an existing farm access route which is formed of compacted material. Utilising an existing access at this location removes the requirement for extensive tree loss to provide the required visibility splays during the operational phase. The access route will be protected using a three dimensional proprietary raft or tile system installed without excavation ('no dig') and will be designed to avoid any additional compaction of the underlying soil. Any widening (if required) will be to the east furthest from the tree stem positions.~~

~~7.5.3 The existing canopy clearance of the track is predominantly likely to be sufficient for construction access use due to its existing use by high sided farm machinery. One category A veteran tree to the west (T143) and one category U tree T142) and one category C hedgerow (H194) to the east may require pruning to achieve a reasonable clearance of 5.2m as considered in section 8.4. .~~

7.5.1 A very small area of the RPA of T60 (moderate quality) is ~~also~~ subject to an incursion for a proposed access route. Where the access route cannot be re-routed to avoid the RPA it will be achieved using a three dimensional raft or tile system installed without excavation. T60 (pine) has a high canopy on its northern side which provides ample crown clearance for access with no requirement for pruning.

~~7.5.4~~7.5.2 The proposed access route and cable route which is positioned to the north of the Chippenham Park avenue will be achieved without tree loss. There is an existing hard standing access route which will be utilised for access where feasible, should any widening be required within an RPA it will be achieved without excavation using a three dimensional raft or tile system installed without excavation and will maintain a minimum 1m from any tree stem position. The cable will be routed to avoid RPAs and where this is not possible (to be determined via detailed design) it will be installed via Horizontal Directional

Drilling (HDD) or equivalent at a minimum depth of 1.5m (final depth to be confirmed at detailed design taking into account soil type and tree species), with insertion and retrieval pits located outside of RPAs.

~~7.5.5~~7.5.3 All proposed drainage is shown indicatively on the Tree Protection and Removal Plan and will be positioned to avoid the area of constraint associated with retained trees. This will be secured as a commitment in the Framework CEMP **[EN010106/APP/6.2]** ~~(latest version was submitted to the Examination at Deadline 3)~~.

~~7.5.6~~7.5.4 No other incursions have been identified at this stage however in practice some tree features identified for removal may be retained with an acceptable impact and be subject to an RPA incursion managed by tree protection measures and a careful working methodology. This will be reviewed following additional detailed tree surveys and confirmation of the final design and in advance of the commencement of works on site.

~~7.5.7~~7.5.5 Unavoidable temporary access within RPAs for construction will be achieved using ground protection to protect soil structure and avoid any requirement for excavation.

7.6 The Future Impact of Retained Trees

7.6.1 The future impact of retained trees in conjunction with the Scheme and future use of the Site has been considered.

7.6.2 Retained trees will require periodic inspection to assess their structural condition and safety. Occasional removal of dead wood or other remedial works to address significant defects may be required in areas of frequent access. This is unlikely to be overly onerous and will be the responsibility of the tree owner.

7.6.3 All tree works recommended as a result of the preliminary tree surveys, considered trees in the context of the present use of the Site (i.e. prior to development proposals) in the Detailed Tree Survey Schedule (Appendix B). Where these works are not superseded by proposed tree removal, they should be actioned.

7.6.4 Tree clearance to facilitate access for the Scheme will provide a reasonable clearance for construction and this will form the framework for a clearance during operation which can be maintained on an ad hoc basis. This will not be overly onerous and will not result in future pressure to remove retained trees.

7.6.5 Retained trees have the potential to cast shade on solar panels and may impair their function and output. The design has been developed so that trees are generally set well back from the position of solar arrays to reduce or avoid this issue.

7.6.6 Shading arcs equivalent to tree height and formed of a radius from northwest to due east have been plotted on the Tree Constraints Plan (Appendix A) and the Tree Protection and Removal Plan (Appendix D). Shading arcs show the typical extent of likely shading from trees throughout the day (as the sun moves from east to west in a southerly orientation) but do not illustrate areas subject to

constant shade. Shading from deciduous trees will be reduced in winter (when the sun is lowest in the sky and the extent of shade is greatest) following leaf fall.

7.6.7 Shading arc radii are based on detailed tree survey height estimates, NTM LiDAR heights and estimated heights determined via desk study and this is included on the Tree Constraints Plan and Tree Protection and Removal Plan. This illustrates that no solar arrays will be subject to significant shading at the time of construction.

7.6.8 Trees will increase in height over time as they mature, however the heights of those trees which are already mature are less likely to be subject to substantial increases. ~~Due to the extent of the offset between solar arrays and retained trees, and the general maturity of retained tree groups bordering solar array areas, this is not considered to be likely to result in future pressure to fell or remove trees to address shading impacts.~~

7.6.9 To address future shading potential as trees mature, a 30m shading arc has been applied to all tree features to identify areas for more detailed assessment, the mature shading arc has then been adjusted in those areas with potential to impact on solar array positions to reflect the assumed mature height of the given species of tree. Mature heights are determined using data provided in Table 3 of NHBC Chapter 4.2 (2022) (Ref 14).

7.6.10 Solar arrays potentially affected by the maximum anticipated mature height of trees (based on the tallest growing species identified) include blocks: W08, W15, E12, E13, E14, E15, E19, E20, E21, E24, E26, E27, E29, E30 and E31. It is recognised that most groups of trees are formed of mixed species and will not uniformly achieve the maximum heights proposed which are based on an assumed worst case, tree growth will also be influenced by growing conditions including climate, soil and exposure.

7.6.11 Due to the extent of the offset between solar arrays and retained trees, and the general maturity of retained tree groups bordering solar array areas, this is not considered to be likely to result in future pressure to fell or remove trees to address shading impacts. The panels require at least three hours of unshaded daylight to function at required levels and due to the partial nature of shading in all cases (limited to specific times of day as the sun moves across the sky and generally reduced in winter due to leaf fall for deciduous tree species) shading over time is not anticipated to be a significant issue.

~~7.7.0~~

~~7.8~~7.7 Tree Protection

~~7.8.1~~7.7.1 Retained trees are vulnerable to damage from construction activities which can include physical damage to stems and branches following impacts with plant. Root severance following trenching, root death or dysfunction following damage to soil structure (caused by the movement of people or machinery on unsurfaced ground) or via the spillage of materials toxic to tree health.

~~7.8.2~~7.7.2 The default position is that the RPA and Canopy spread of trees to be retained will form an effective Construction Exclusion Zone (CEZ), secured

with robust fencing where no access will be permitted. Where access is necessary within RPAs/canopy spreads, these areas are referred to as CWZs and require measures such as the use of ground protection and arboricultural supervision.

~~7.8.3~~7.7.3 Tree protection measures are considered in the PAMS contained within Appendix C of this report. This includes proposed measures for other tree related impacts such as for protected species (e.g. birds, bats and badger). A detailed Arboricultural Method Statement will be required which will set out the phasing of site operations, the finalised tree protection measures for a proposed development (including exclusion zones) and to provide detail on how sensitive elements of work are to be achieved in proximity to retained trees. This will be secured through the Framework Construction Environmental Management Plan (FCEMP) in **Appendix 16C** of this Environmental Statement **[EN010106/APP/6.2]** ~~(latest version was submitted to the Examination at Deadline 3)~~.

~~7.9~~7.8 Tree Planting

~~7.9.1~~7.8.1 Where trees are to be removed due to a conflict with proposals in relation to the Scheme, mitigation planting is likely to be required to ensure a continuity of tree cover for the Scheme and to address any negative impact on local amenity and landscape character. Consideration should be given to the reasonable provision of space for new tree planting to off-set any necessary tree loss.

~~7.9.2~~7.8.2 Soil structure in areas for new planting will need to be maintained and may require protection during operation of the proposed development to ensure reasonable conditions for future tree growth are available.

~~7.9.3~~7.8.3 New planting should consider the existing species mix present on site in relation to both arboricultural and ecological considerations. New planting also offers an opportunity to increase the species and age class diversity for a given area which can boost the resilience of the local tree stock in relation to pests, disease and climate change as well as providing a greater range of amenity and other benefits. New planting will be secured through the Outline Landscape and Ecological Management Plan (OLEMP)~~, the latest version of which was submitted to the Examination at Deadline 3~~.

~~7.9.4~~7.8.4 New trees should be planted in accordance with the guidance set out in BS8545:2014 Trees: from nursery to independence in the landscape – Recommendations (BS8545) and with the minimum distances from new structures, services and surfacing set out in Table A.1 of BS5837.

8 Summary and Conclusion

8.1.1 This AIA report identifies the likely arboricultural impacts of the Scheme and a reasonable worst case has been assumed.

8.1.2 Six individual trees, two tree groups, part of four woodland groups, part of 12 tree groups and part of three hedgerow features are to be removed to facilitate the Scheme. This includes four part woodland groups of high quality (Category A), two individual trees, one tree group, part of seven tree groups and part of two

hedgerows of moderate quality (Category B), three individual trees, part of five tree groups and part of one hedgerow of low quality (Category C) and one individual tree and one tree group which are unsuitable for retention for more than 10 years (Category U).

8.1.3 These Category U trees are not suitable for long-term retention and their removal is justified regardless due to pre-existing condition and proximal land use.

8.1.4 In total 7400m^2 of tree canopy cover subject to detailed survey is to be removed as a reasonable worst case.

~~8.1.2 Two individual trees, two tree groups, part of four woodland groups, part of 13 tree groups and part of four hedgerow features are to be removed to facilitate the Scheme. This would include four part woodland groups of high quality (Category A), one tree group, part of seven tree groups and part of two hedgerows of moderate quality (Category B), two individual trees, part of six tree groups and part of two hedgerows of low quality (Category C) and one individual tree and one tree group which are unsuitable for retention for more than 10 years (Category U).~~

~~8.1.3 These Category U trees are not suitable for long-term retention and their removal is justified regardless due to pre-existing condition and proximal land use.~~

~~8.1.4~~8.1.5 In addition as a reasonable worst case the Scheme would require the removal of up to 150m^2 of likely high quality tree cover, 52~~3~~00m^2 of likely moderate quality tree cover and 290~~85~~0m^2 of likely low quality tree cover (825~~30~~0m^2 in total). In practice this extent of loss is likely to be reduced with the application of design refinements and careful working methodologies such as those set out in the PAMS included as Appendix C.

~~8.1.5~~8.1.6 In practice it is likely that tree loss and impacts would be significantly reduced and detailed tree surveys for all areas of the Scheme where unsurveyed trees are at risk of impact would be undertaken in advance of detailed design and construction and the results, including an updated assessment of arboricultural impacts and mitigation along with a detailed Arboricultural Method Statement, will be submitted to the Local Planning Authorities for agreement in advance and this is a commitment in the Framework CEMP **[EN010106/APP/6.2]** ~~(the latest version was submitted to the Examination at Deadline 3)~~ secured as part of the draft DCO **[REP2-012]**.

8.1.7 Of the trees to be removed one individual tree and part of two tree groups are subject to a TPO at land south of Worlington and two ~~. In addition two~~ trees ~~not~~ subject to a ~~detailed tree survey are protected~~ by a recently served TPO are located at Chippenham Road (east of Snailwell). The design has been developed to minimise tree loss where possible however the loss of these trees cannot be avoided if the current Scheme design is to be achieved. The ~~The Project Team will further consider how impacts might be reduced or avoided and will provide an update at Deadline 04.~~ potential for these trees to be retained will be reviewed as part of the detailed design process and this is secured as a commitment in the FCEMP **[EN010106/APP/6.2]**.

8.1.8 No trees are to be removed from the tree avenue which forms part of the Registered Park and Garden at Chippenham Hall.

8.1.9 No trees within County Wildlife Sites are to be removed to facilitate the Scheme.

~~8.1.6~~

~~8.1.7~~8.1.10 No veteran or ancient trees are to be removed and the retention and protection of any unidentified veteran trees is a commitment in the Framework CEMP **[EN010106/APP/6.2]** ~~(the latest version was submitted to the Examination at Deadline 3)~~ secured via the draft DCO **[REP2-012]**.

8.1.11 One ~~surveyed veteran tree, one~~ unsurveyed tree likely to be of moderate quality (located within the Freckenham Conservation Area) and~~,~~ one moderate quality surveyed tree subject to TPO (at Chippenham Road) ~~one surveyed tree and one group of low quality~~ are to be pruned to facilitate construction access. This level of pruning will not have a significant negative impact on the health or amenity value of these trees. ~~T~~

~~8.1.8~~8.1.12 ~~he veteran tree is in poor structural condition and has been identified for pollard management which is recommended to prevent its structural failure regardless of the Scheme to manage the risk of collapse in proximity to the exiting highway.~~ One surveyed low quality tree could~~is also to~~ be pollarded to address structural defects to manage its condition in association with the proposed change in land use however the pruning (which would otherwise help to prevent the collapse and of the tree and would promote its long term survival) will be avoided and a fenced exclusion zone with no access or development activity is to be established around the tree (within falling distance).~~.~~

~~8.1.9~~8.1.13 ~~An RPA incursion within the RPA of four likely veteran trees classified as high quality, two trees classified as moderate quality and one tree and one tree group of low quality is required to achieve access into Sunnica West Site B. This will be achieved along the alignment of an existing farm access route without excavation or compaction~~. ~~A further~~ proposed access route will incur within the outer RPA of a moderate quality tree to the south of Worlington and where it cannot be adjusted to avoid the RPA of this tree it will be installed without excavation or compaction.

~~8.1.10~~8.1.14 In advance of construction a detailed tree survey of all areas of potential tree impacts will be carried out and this is a commitment in the Framework CEMP **[EN010106/APP/6.2]** ~~(the latest version was submitted to the Examination at Deadline 3)~~.

~~8.1.11~~8.1.15 Tree protection measures are considered in the PAMS contained within Appendix C of this report. A detailed Arboricultural Method Statement will be prepared to set out the phasing of site operations, the finalised tree protection measures for a proposed development, and to provide detail on how sensitive elements of work are to be achieved in proximity to retained trees. This will be secured through the CEMP in **Appendix 16C** of this Environmental Statement **[EN010106/APP/6.2]**~~, the latest version of the Framework CEMP was submitted to the Examination at Deadline 3~~.

~~8.1.12~~8.1.16 Where trees are to be removed due to a conflict with proposals in relation to the Scheme, mitigation planting will be delivered to ensure a continuity of tree cover for the Scheme and to address any negative impact on

local amenity and landscape character, this will be secured through the OLEMP ~~(the latest version was submitted to the Examination at Deadline 3)~~.

References

Ref. 1 HMSO (2018). Conservation of Habitats and Species Regulations 2017 (as amended). HMSO, London.

Ref. 2 HMSO (2019) The Conservation of Habitats and Species (Amendment) (EU Exit) Regulations 2019. HMSO, London

Ref. 3 HMSO (1981). The Wildlife & Countryside Act 1981. HMSO, London.

Ref. 4 HMSO (2000). Countryside and Rights of Way Act 2000. HMSO, London.

Ref. 5 HMSO (1997). Hedgerows Regulations 1997. HMSO, London.

Ref. 6 DECC (2011) National Policy Statement for Electricity Networks Infrastructure (EN-5), Available at: https://www.gov.uk/government/publications/national-policy-statements-for-energy-infrastructure [Date Accessed: March 2021].

Ref. 7 National Planning Policy Framework. Ministry of Housing, Communities and Local Government. Available at: https://www.gov.uk/guidance/national-planning-policy-framework

Ref. 8 East Cambridgeshire District Council (2015). East Cambridgeshire Local Plan Adopted April 2015. Section 6.8.

Ref. 9 East Cambridgeshire District Council (2020). Natural Environment – Supplementary Planning Document (SPD). Adopted September 2020

Ref. 10 Forest Heath and St Edmundsbury Local Plan; Joint Development Management Policies Document. February 2015. Section 4.

Ref. 11 British Standards Institution (BSI), BS5837:2012. Trees in relation to design, demolition and construction – Recommendations. BSI

Ref. 12 British Standards Institution (BSI), BS3998:2010. Tree work – Recommendations. BSI

Ref. 13 British Standards Institution (BSI), BS8545:2014. Trees: from nursery to independence in the landscape – Recommendations. BSI

Ref. 14 National House Building Council (NHBC) Standards, (2021). Chapter 4.2: Building Near Trees

Ref. 15 National Joint Utilities Group (NJUG) Volume 4, Issue 2, (2007). NJUG Guidelines for the Planning, Installation and Maintenance of Utility Apparatus in Proximity to Trees.

Ref. 16 National Tree Safety Group (NTSG), 2011. Common sense risk management of trees. Forestry Commission.

Ref. 17 Natural England and The Forestry Commission (2022) Ancient woodland, ancient trees and veteran trees: protecting them from development https://www.gov.uk/guidance/ancient-woodland-and-veteran-trees-protection-surveys-licences

Appendix A Tree Constraints Plans

Author: GR Designer: JB Checked: TF Approved: AW

Last saved by: BREWERJ (2023-01-13) Last Plotted: 2023-01-13
Filename: C:\USERS\BREWERJ\ONEDRIVE - AECOM\DESKTOP\SUNNICA FARM\SS\SUNNICA ENERGY FARN - TPP_001 - OFFLINE COPY\SUNNICA ENERGY FARN - TCP_004.DWG

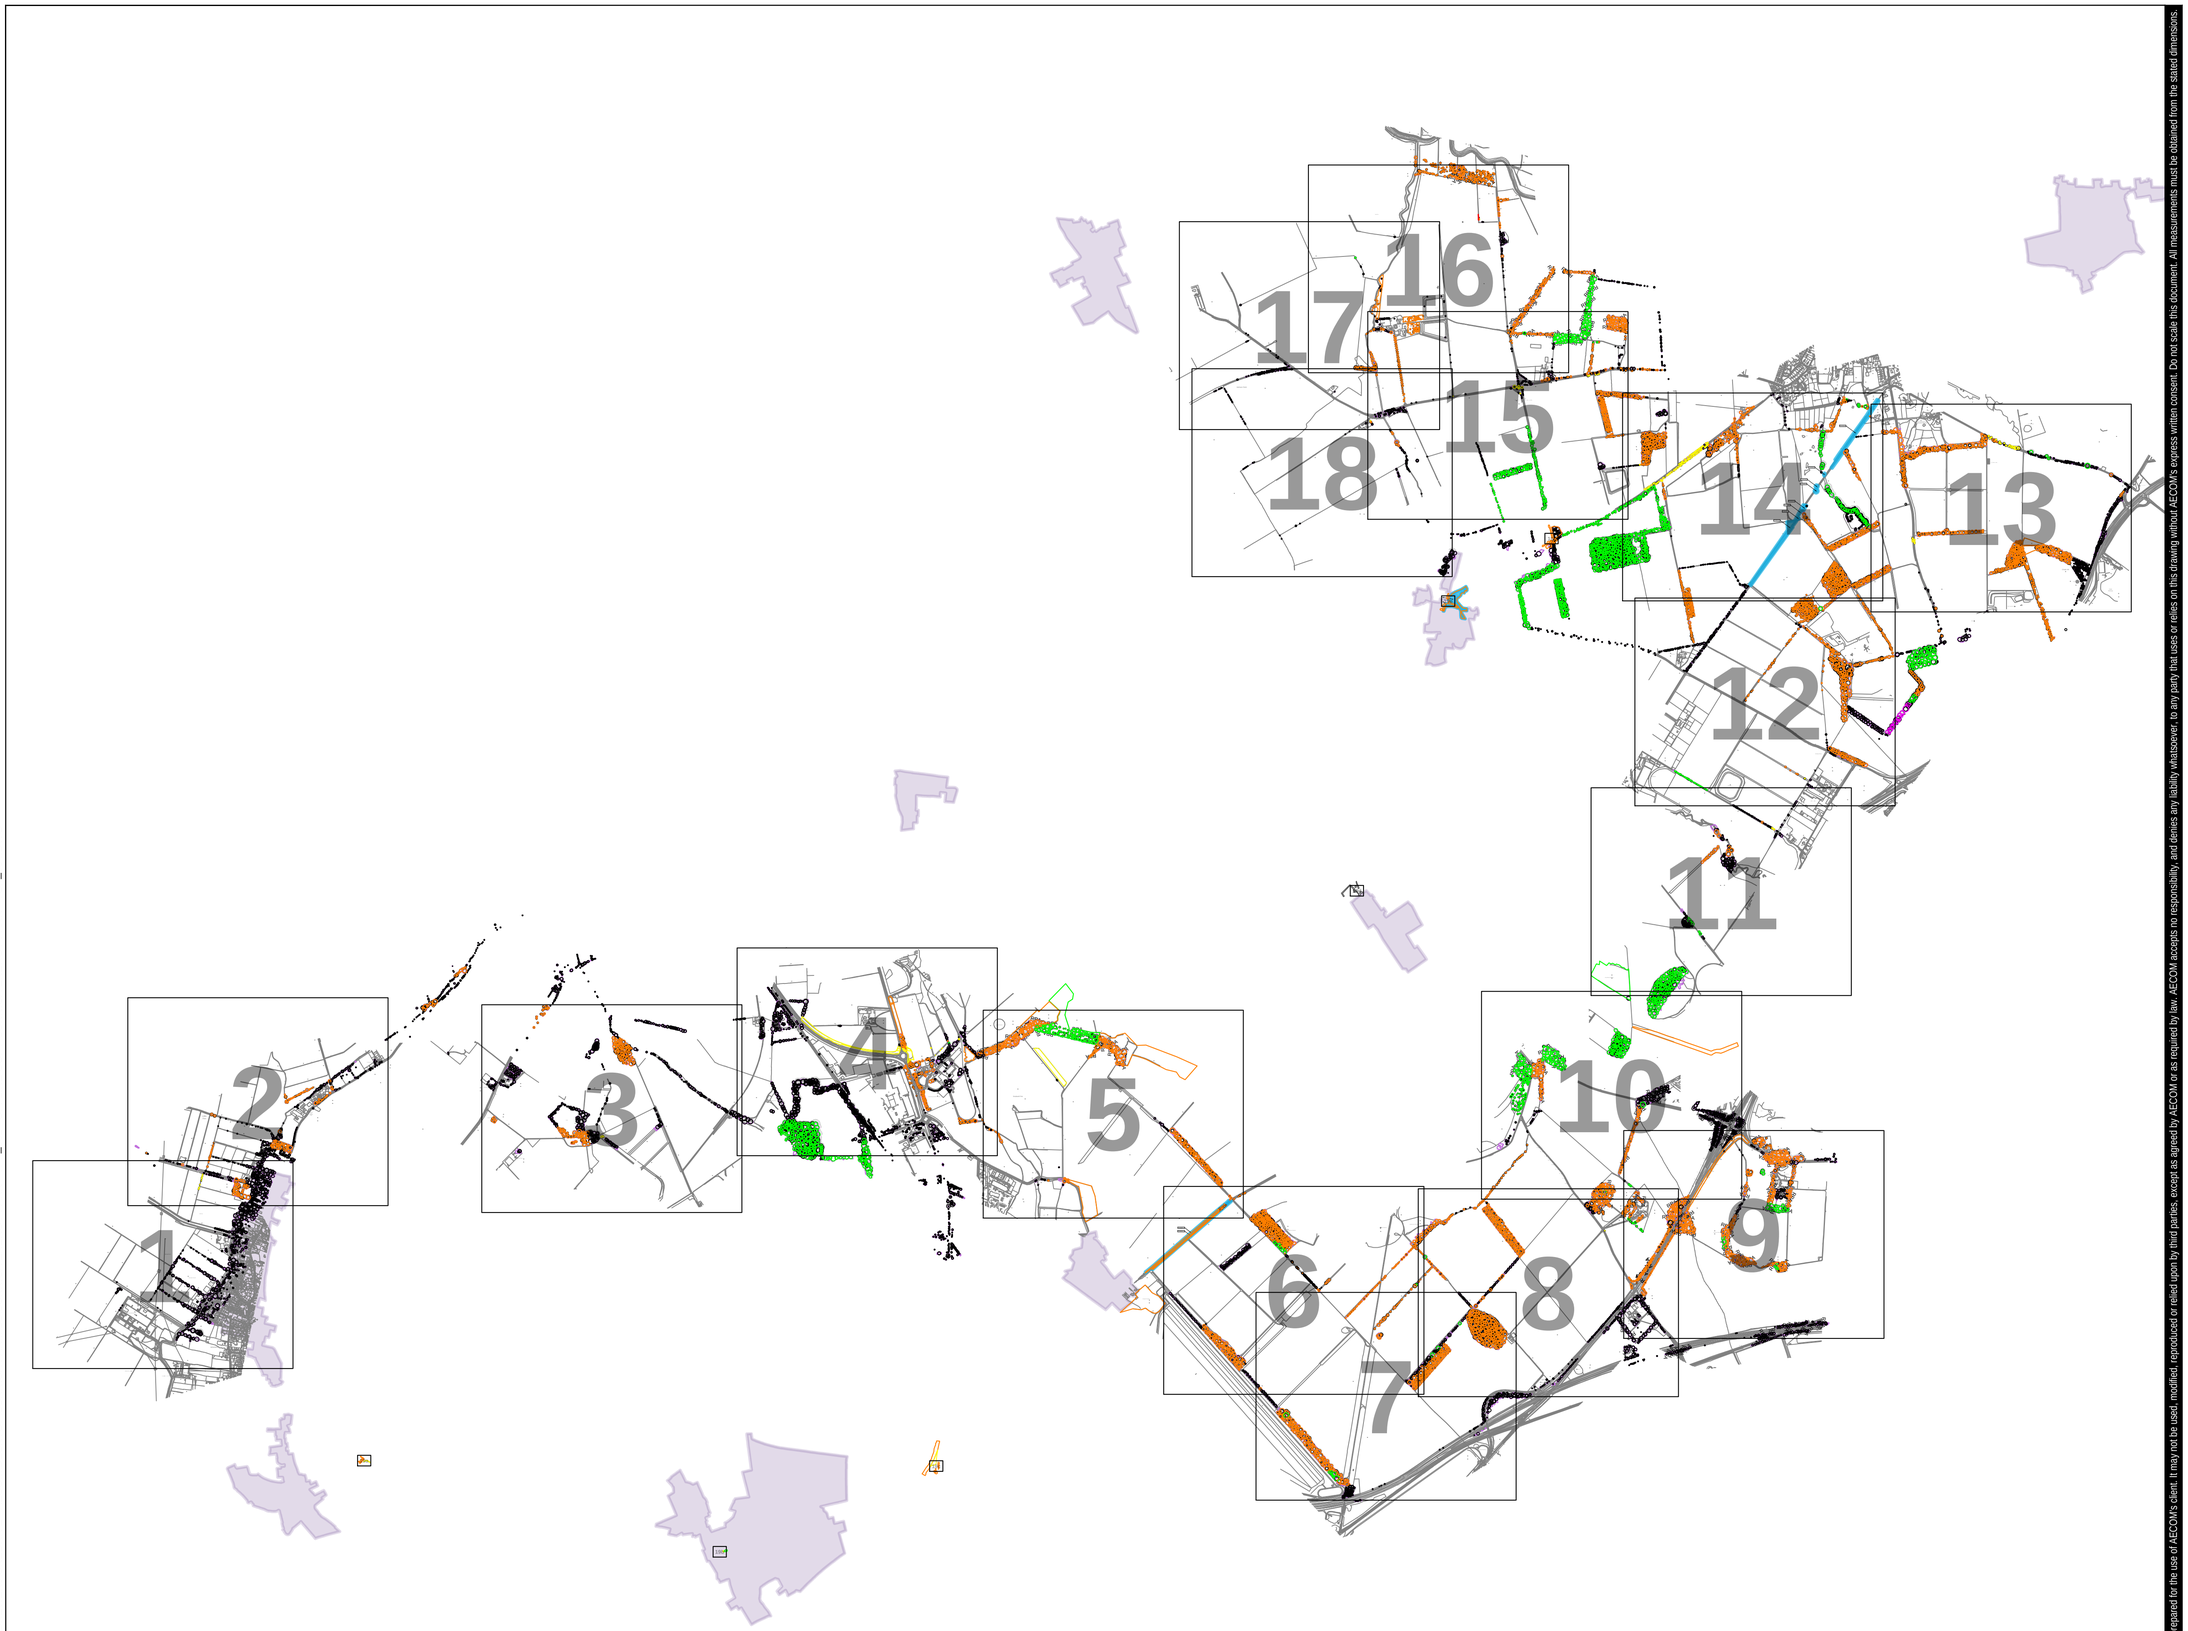

This drawing has been prepared for the use of AECOM's client. It may not be used, modified, reproduced or relied upon by third parties, except as agreed by AECOM or as required by law. AECOM accepts no responsibility, and denies any liability whatsoever, to any party that uses or relies on this drawing without AECOM's express written consent. Do not scale this document. All measurements must be obtained from the stated dimensions.

AECOM

PROJECT

SUNNICA ENERGY FARM

CLIENT

SUNNICA ENERGY FARM

CONSULTANT

AECOM
Plumer House, Third Floor,
East Wing, Tailyour Road
Plymouth, PL6 5DH
Tel +44(0)1752 676700
Fax +44(0)870 238 6023
www.aecom.com

GENERAL NOTES

1. TREE CATEGORIES AS DEFINED BY BS 5837:2012
2. TREE LOCATIONS ARE BASED ON THE TOPOGRAPHICAL SURVEY, AERIAL IMAGERY, AND GPS CO-ORDINATES FROM ON SITE WALKOVER.
3. * INDICATES A TREE / GROUP WHOSE POSITION IS APPROXIMATE AS BASED UPON AERIAL PHOTOGRAPHY AND ON SITE OBSERVATIONS.
4. PLANS SHOULD BE READ IN CONJUNCTION WITH THE AECOM ARBORICULTURAL REPORT.
5. THE ORIGINAL OF THIS DRAWING WAS PRODUCED IN COLOUR - A MONOCHROME COPY SHOULD NOT BE RELIED UPON.
6. DRAWING REFERNCES:
   TPO.dwg
   MERGED NTM DATA RevA Modified.dwg
   xref_OSMap.dwg
   20230105_Sunnica_WSP_RLB.dwg

KEY PLAN

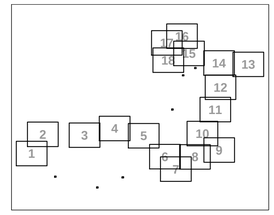

KEY

- **ORDER LIMITS BOUNDARY**
- **LOCAL AUTHORITY BOUNDARY**
- **A CATEGORY TREE, GROUP, HEDGE, OR WOODLAND** *(AS FOUND DURING DETAILED SURVEY, INDICATES HIGH QUALITY & VALUE)*
- **B CATEGORY TREE, GROUP, HEDGE, OR WOODLAND** *(AS FOUND DURING DETAILED SURVEY, INDICATES MODERATE QUALITY & VALUE)*
- **C CATEGORY TREE, GROUP, HEDGE, OR WOODLAND** *(AS FOUND DURING DETAILED SURVEY, INDICATES LOW QUALITY & VALUE)*
- **U CATEGORY TREE, GROUP, HEDGE, OR WOODLAND** *(AS FOUND DURING DETAILED SURVEY, UNSUITABLE FOR RETENTION)*
- **ROOT PROTECTION AREAS (RPA)** *(AS DEFINED BY BS 5837:2012 FOR TREES SUBJECT TO DETAILED SURVEY. ESTIMATED BUFFER ZONE SHOWN INDICATIVELY FOR OTHER TREES)*
- **APPROXIMATE SHADING ARC** *(AS DEFINED BY BS 5837:2012)*
- **NTM CATEGORY TREE, GROUP, HEDGE, OR WOODLAND** *(QUALITY CATEGORY ESTIMATED VIA WALKOVER AND/OR DESK STUDY: A, B, C, U, OR UNCATEGORIZED*
- **VETERAN/ANCIENT TREE** *(IDENTIFIED BY SURVEY)*
- **VETERAN/ANCIENT TREE** *(IDENTIFIED BY WALKOVER/DESK STUDY)*
- **TREE PRESERVATION ORDER** *(AREA COVERED BY A TREE PRESERVATION ORDER (TPO))*
- **CONSERVATION AREA** *(AREA COVERED BY A TREE PRESERVATION ORDER (TPO))*

ISSUE/REVISION

I/R	DATE	DESCRIPTION
P01	13/01/22	SECOND ISSUE
00	22/11/22	FIRST ISSUE

DRAWING STATUS

SUBMITTED AT DEADLINE 5

PROJECT NUMBER

60589004

SHEET TITLE

TREE CONSTRAINTS PLAN
(SHEET 0)

SHEET NUMBER **REV.**

60589004-ACM-XX-XX-AB-TCP-00 P01

Author: GR Designer: JB Checked: TF Approved: AW

Last saved by: BREWERJ(2023-01-13) Last Plotted: 2023-01-13
Filename: C:\USERS\BREWERJ\ONEDRIVE - AECOM\DESKTOP\SUNNICA FARM\SS\SUNNICA ENERGY FARN - TPP_001 - OFFLINE COPY\SUNNICA ENERGY FARN - TCP_004.DWG

This drawing has been prepared for the use of AECOM's client. It may not be used, modified, reproduced or relied upon by third parties, except as agreed by AECOM or as required by law. AECOM accepts no responsibility and denies any liability whatsoever, to any party that uses or relies on this drawing without AECOM's express written consent. Do not scale this document. All measurements must be obtained from the stated dimensions.

AECOM

PROJECT

SUNNICA ENERGY FARM

CLIENT

SUNNICA ENERGY FARM

CONSULTANT

AECOM
Plumer House, Third Floor,
East Wing, Tailyour Road
Plymouth, PL6 5DH
Tel +44(0)1752 676700
Fax +44(0)870 238 6023
www.aecom.com

GENERAL NOTES

1. TREE CATEGORIES AS DEFINED BY BS 5837:2012
2. TREE LOCATIONS ARE BASED ON THE TOPOGRAPHICAL SURVEY, AERIAL IMAGERY, AND GPS CO-ORDINATES FROM ON SITE WALKOVER.
3. * INDICATES A TREE / GROUP WHOSE POSITION IS APPROXIMATE AS BASED UPON AERIAL PHOTOGRAPHY AND ON SITE OBSERVATIONS.
4. PLANS SHOULD BE READ IN CONJUNCTION WITH THE AECOM ARBORICULTURAL REPORT.
5. THE ORIGINAL OF THIS DRAWING WAS PRODUCED IN COLOUR - A MONOCHROME COPY SHOULD NOT BE RELIED UPON.
6. DRAWING REFERNCES:
   TPO.dwg
   MERGED NTM DATA RevA Modified.dwg
   xref_OSMap.dwg
   20230105_Sunnica_WSP_RLB.dwg

KEY PLAN

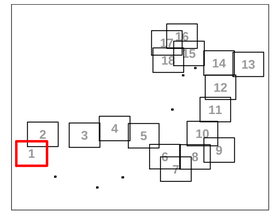

KEY

- **ORDER LIMITS BOUNDARY**
- **LOCAL AUTHORITY BOUNDARY**
- **A CATEGORY TREE, GROUP, HEDGE, OR WOODLAND** *(AS FOUND DURING DETAILED SURVEY, INDICATES HIGH QUALITY & VALUE)*
- **B CATEGORY TREE, GROUP, HEDGE, OR WOODLAND** *(AS FOUND DURING DETAILED SURVEY, INDICATES MODERATE QUALITY & VALUE)*
- **C CATEGORY TREE, GROUP, HEDGE, OR WOODLAND** *(AS FOUND DURING DETAILED SURVEY, INDICATES LOW QUALITY & VALUE)*
- **U CATEGORY TREE, GROUP, HEDGE, OR WOODLAND** *(AS FOUND DURING DETAILED SURVEY, UNSUITABLE FOR RETENTION)*
- **ROOT PROTECTION AREAS (RPA)** *(AS DEFINED BY BS 5837:2012 FOR TREES SUBJECT TO DETAILED SURVEY, ESTIMATED BUFFER ZONE SHOWN INDICATIVELY FOR OTHER TREES)*
- **APPROXIMATE SHADING ARC** *(AS DEFINED BY BS 5837:2012)*
- **NTM CATEGORY TREE, GROUP, HEDGE, OR WOODLAND** *(QUALITY CATEGORY ESTIMATED VIA WALKOVER AND/OR DESK STUDY: A, B, C, U, OR UNCATEGORIZED*
- **VETERAN/ANCIENT TREE** *(IDENTIFIED BY SURVEY)*
- **VETERAN/ANCIENT TREE** *(IDENTIFIED BY WALKOVER/DESK STUDY)*
- **TREE PRESERVATION ORDER** *(AREA COVERED BY A TREE PRESERVATION ORDER [TPO])*
- **CONSERVATION AREA** *(AREA COVERED BY A TREE PRESERVATION ORDER [TPO])*

ISSUE/REVISION

P01	13/01/22	SECOND ISSUE
00	22/11/22	FIRST ISSUE
I/R	DATE	DESCRIPTION

DRAWING STATUS

SUBMITTED AT DEADLINE 5

PROJECT NUMBER

60589004

SHEET TITLE

TREE CONSTRAINTS PLAN (SHEET 1)

SHEET NUMBER

60589004-ACM-XX-XX-AB-TCP-01

REV.

P01

Author: GR Designer: JB Checked: TF Approved: AW

Last saved by: BREWERJ(2023-01-13) Last Plotted: 2023-01-13
Filename: C:\USERS\BREWERJ\ONEDRIVE - AECOM\DESKTOP\SUNNICA FARM\SS\SUNNICA ENERGY FARN - TPP_001 - OFFLINE COPY\SUNNICA ENERGY FARN - TCP_004.DWG

This drawing has been prepared for the use of AECOM's client. It may not be used, modified, reproduced or relied upon by third parties, except as agreed by AECOM or as required by law. AECOM accepts no responsibility, and denies any liability whatsoever, to any party that uses or relies on this drawing without AECOM's express written consent. Do not scale this document. All measurements must be obtained from the stated dimensions.

AECOM

PROJECT

SUNNICA ENERGY FARM

CLIENT

SUNNICA ENERGY FARM

CONSULTANT

AECOM
Plumer House, Third Floor,
East Wing, Tailyour Road
Plymouth, PL6 5DH
Tel +44(0)1752 676700
Fax +44(0)870 238 6023
www.aecom.com

GENERAL NOTES

1. TREE CATEGORIES AS DEFINED BY BS 5837:2012
2. TREE LOCATIONS ARE BASED ON THE TOPOGRAPHICAL SURVEY, AERIAL IMAGERY, AND GPS CO-ORDINATES FROM ON SITE WALKOVER.
3. * INDICATES A TREE / GROUP WHOSE POSITION IS APPROXIMATE AS BASED UPON AERIAL PHOTOGRAPHY AND ON SITE OBSERVATIONS.
4. PLANS SHOULD BE READ IN CONJUNCTION WITH THE AECOM ARBORICULTURAL REPORT.
5. THE ORIGINAL OF THIS DRAWING WAS PRODUCED IN COLOUR - A MONOCHROME COPY SHOULD NOT BE RELIED UPON.
6. DRAWING REFERNCES:
   TPO.dwg
   MERGED NTM DATA RevA Modified.dwg
   xref_OSMap.dwg
   20230105_Sunnica_WSP_RLB.dwg

KEY PLAN

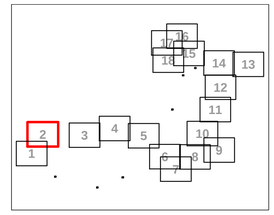

KEY

- **ORDER LIMITS BOUNDARY**
- **LOCAL AUTHORITY BOUNDARY**
- **A CATEGORY TREE, GROUP, HEDGE, OR WOODLAND** *(AS FOUND DURING DETAILED SURVEY, INDICATES HIGH QUALITY & VALUE)*
- **B CATEGORY TREE, GROUP, HEDGE, OR WOODLAND** *(AS FOUND DURING DETAILED SURVEY, INDICATES MODERATE QUALITY & VALUE)*
- **C CATEGORY TREE, GROUP, HEDGE, OR WOODLAND** *(AS FOUND DURING DETAILED SURVEY, INDICATES LOW QUALITY & VALUE)*
- **U CATEGORY TREE, GROUP, HEDGE, OR WOODLAND** *(AS FOUND DURING DETAILED SURVEY, UNSUITABLE FOR RETENTION)*
- **ROOT PROTECTION AREAS (RPA)** *(AS DEFINED BY BS 5837:2012 FOR TREES SUBJECT TO DETAILED SURVEY. ESTIMATED BUFFER ZONE SHOWN INDICATIVELY FOR OTHER TREES)*
- **APPROXIMATE SHADING ARC** *(AS DEFINED BY BS 5837:2012)*
- **NTM CATEGORY TREE, GROUP, HEDGE, OR WOODLAND** *(QUALITY CATEGORY ESTIMATED VIA WALKOVER AND/OR DESK STUDY: A, B, C, U, OR UNCATEGORIZED*
- **VETERAN/ANCIENT TREE** *(IDENTIFIED BY SURVEY)*
- **VETERAN/ANCIENT TREE** *(IDENTIFIED BY WALKOVER/DESK STUDY)*
- **TREE PRESERVATION ORDER** *(AREA COVERED BY A TREE PRESERVATION ORDER (TPO))*
- **CONSERVATION AREA** *(AREA COVERED BY A TREE PRESERVATION ORDER (TPO))*

ISSUE/REVISION

P01	13/01/22	SECOND ISSUE
00	22/11/22	FIRST ISSUE
I/R	DATE	DESCRIPTION

DRAWING STATUS

SUBMITTED AT DEADLINE 5

PROJECT NUMBER

60589004

SHEET TITLE

TREE CONSTRAINTS PLAN (SHEET 2)

SHEET NUMBER **REV.**

60589004-ACM-XX-XX-AB-TCP-02 P01

Author: GR Designer: JB Checked: TF Approved: AW

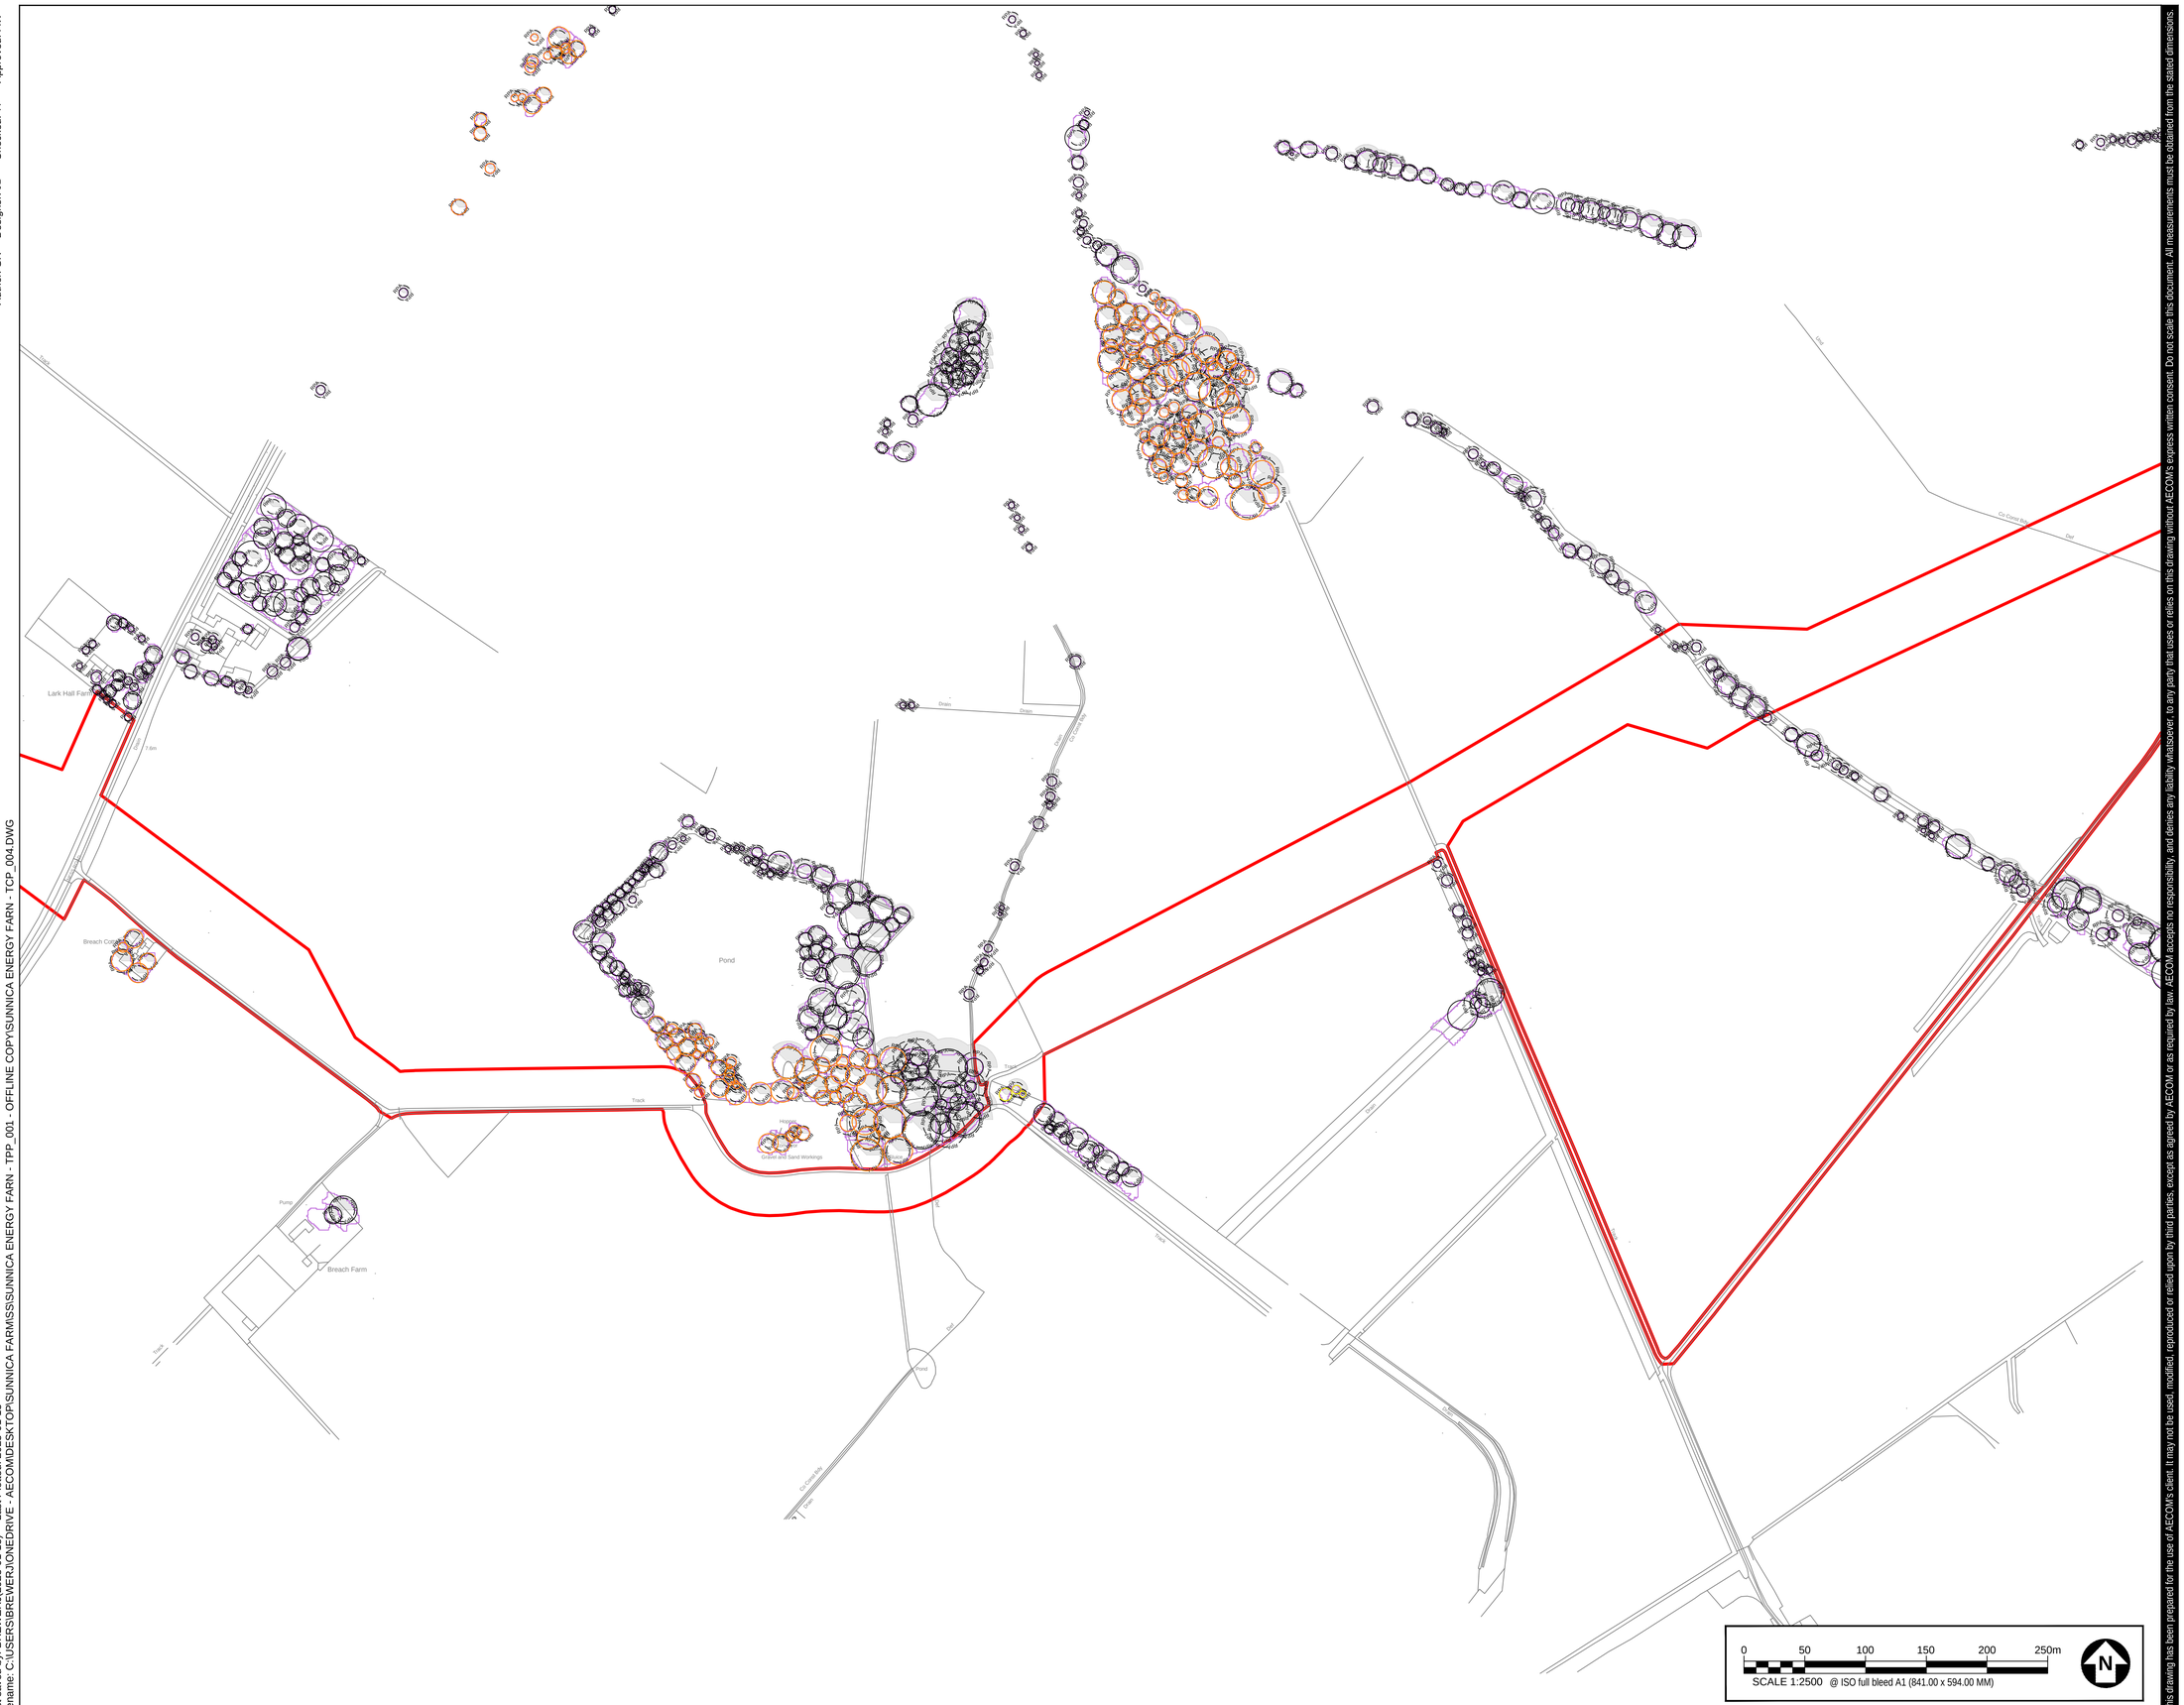

Last saved by: BREWERJ (2023-01-13) Last Plotted: 2023-01-13
Filename: C:\USERS\BREWERJ\ONEDRIVE - AECOM\DESKTOP\SUNNICA FARM\SS\SUNNICA ENERGY FARM - TPP_001 - OFFLINE COPY\SUNNICA ENERGY FARM - TCP_004.DWG

This drawing has been prepared for the use of AECOM's client. It may not be used, modified, reproduced or relied upon by third parties, except as agreed by AECOM or as required by law. AECOM accepts no responsibility, and denies any liability whatsoever, to any party that uses or relies on this drawing without AECOM's express written consent. Do not scale this document. All measurements must be obtained from the stated dimensions.

AECOM

PROJECT

SUNNICA ENERGY FARM

CLIENT

SUNNICA ENERGY FARM

CONSULTANT

AECOM
Plumer House, Third Floor,
East Wing, Tailyour Road
Plymouth, PL6 5DH
Tel +44(0)1752 676700
Fax +44(0)870 238 6023
www.aecom.com

GENERAL NOTES

1. TREE CATEGORIES AS DEFINED BY BS 5837:2012
2. TREE LOCATIONS ARE BASED ON THE TOPOGRAPHICAL SURVEY, AERIAL IMAGERY, AND GPS CO-ORDINATES FROM ON SITE WALKOVER.
3. * INDICATES A TREE / GROUP WHOSE POSITION IS APPROXIMATE AS BASED UPON AERIAL PHOTOGRAPHY AND ON SITE OBSERVATIONS.
4. PLANS SHOULD BE READ IN CONJUNCTION WITH THE AECOM ARBORICULTURAL REPORT.
5. THE ORIGINAL OF THIS DRAWING WAS PRODUCED IN COLOUR - A MONOCHROME COPY SHOULD NOT BE RELIED UPON.
6. DRAWING REFERNCES:
   TPO.dwg
   MERGED NTM DATA RevA Modified.dwg
   xref_OSMap.dwg
   20230105_Sunnica_WSP_RLB.dwg

KEY PLAN

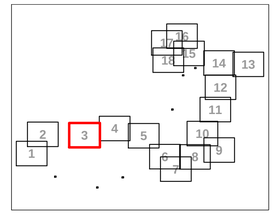

KEY

- **ORDER LIMITS BOUNDARY**
- **LOCAL AUTHORITY BOUNDARY**
- **A CATEGORY TREE, GROUP, HEDGE, OR WOODLAND** *(AS FOUND DURING DETAILED SURVEY, INDICATES HIGH QUALITY & VALUE)*
- **B CATEGORY TREE, GROUP, HEDGE, OR WOODLAND** *(AS FOUND DURING DETAILED SURVEY, INDICATES MODERATE QUALITY & VALUE)*
- **C CATEGORY TREE, GROUP, HEDGE, OR WOODLAND** *(AS FOUND DURING DETAILED SURVEY, INDICATES LOW QUALITY & VALUE)*
- **U CATEGORY TREE, GROUP, HEDGE, OR WOODLAND** *(AS FOUND DURING DETAILED SURVEY, UNSUITABLE FOR RETENTION)*
- **ROOT PROTECTION AREAS (RPA)** *(AS DEFINED BY BS 5837:2012 FOR TREES SUBJECT TO DETAILED SURVEY. ESTIMATED BUFFER ZONE SHOWN INDICATIVELY FOR OTHER TREES)*
- **APPROXIMATE SHADING ARC** *(AS DEFINED BY BS 5837:2012)*
- **NTM CATEGORY TREE, GROUP, HEDGE, OR WOODLAND** *(QUALITY CATEGORY ESTIMATED VIA WALKOVER AND/OR DESK STUDY: A, B, C, U, OR UNCATEGORIZED*
- **VETERAN/ANCIENT TREE** *(IDENTIFIED BY SURVEY)*
- **VETERAN/ANCIENT TREE** *(IDENTIFIED BY WALKOVER/DESK STUDY)*
- **TREE PRESERVATION ORDER** *(AREA COVERED BY A TREE PRESERVATION ORDER [TPO])*
- **CONSERVATION AREA** *(AREA COVERED BY A TREE PRESERVATION ORDER [TPO])*

ISSUE/REVISION

P01	13/01/22	SECOND ISSUE
00	22/11/22	FIRST ISSUE
I/R	DATE	DESCRIPTION

DRAWING STATUS

SUBMITTED AT DEADLINE 5

PROJECT NUMBER

60589004

SHEET TITLE

TREE CONSTRAINTS PLAN (SHEET 3)

SHEET NUMBER **REV.**

60589004-ACM-XX-XX-AB-TCP-03 P01

Author: GR Designer: JB Checked: TF Approved: AW

Trees not included in the NTM dataset, identified via review of aerial imagery

Trees not included in the NTM dataset, identified via review of aerial imagery

Trees not included in the NTM dataset, identified via review of aerial imagery

Fordham House Court
The Studio
The Barn
Fordham House
Willow Farm
Chalk Farm
Horseracing Forensic Laboratory
Limekiln Farm
Depot
Track
Drain
Ditch
Culvert
Public Right of Way
Overhead Line
Tank

0 50 100 150 200 250m

SCALE 1:2500 @ ISO full bleed A1 (841.00 x 594.00 MM)

This drawing has been prepared for the use of AECOM's client. It may not be used, modified, reproduced or relied upon by third parties, except as agreed by AECOM or as required by law. AECOM accepts no responsibility and denies any liability whatsoever, to any party that uses or relies on this drawing without AECOM's express written consent. Do not scale this document. All measurements must be obtained from the stated dimensions.

AECOM

PROJECT

SUNNICA ENERGY FARM

CLIENT

SUNNICA ENERGY FARM

CONSULTANT

AECOM
Plumer House, Third Floor,
East Wing, Tailyour Road
Plymouth, PL6 5DH
Tel +44(0)1752 676700
Fax +44(0)870 238 6023
www.aecom.com

GENERAL NOTES

1. TREE CATEGORIES AS DEFINED BY BS 5837:2012
2. TREE LOCATIONS ARE BASED ON THE TOPOGRAPHICAL SURVEY, AERIAL IMAGERY, AND GPS CO-ORDINATES FROM ON SITE WALKOVER.
3. * INDICATES A TREE / GROUP WHOSE POSITION IS APPROXIMATE AS BASED UPON AERIAL PHOTOGRAPHY AND ON SITE OBSERVATIONS.
4. PLANS SHOULD BE READ IN CONJUNCTION WITH THE AECOM ARBORICULTURAL REPORT.
5. THE ORIGINAL OF THIS DRAWING WAS PRODUCED IN COLOUR - A MONOCHROME COPY SHOULD NOT BE RELIED UPON.
6. DRAWING REFERNCES:
   TPO.dwg
   MERGED NTM DATA RevA Modified.dwg
   xref_OSMap.dwg
   20230105_Sunnica_WSP_RLB.dwg

KEY PLAN

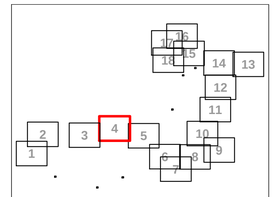

KEY

- ORDER LIMITS BOUNDARY
- LOCAL AUTHORITY BOUNDARY
- A CATEGORY TREE, GROUP, HEDGE, OR WOODLAND *(AS FOUND DURING DETAILED SURVEY, INDICATES HIGH QUALITY & VALUE)*
- B CATEGORY TREE, GROUP, HEDGE, OR WOODLAND *(AS FOUND DURING DETAILED SURVEY, INDICATES MODERATE QUALITY & VALUE)*
- C CATEGORY TREE, GROUP, HEDGE, OR WOODLAND *(AS FOUND DURING DETAILED SURVEY, INDICATES LOW QUALITY & VALUE)*
- U CATEGORY TREE, GROUP, HEDGE, OR WOODLAND *(AS FOUND DURING DETAILED SURVEY, UNSUITABLE FOR RETENTION)*
- ROOT PROTECTION AREAS (RPA) *(AS DEFINED BY BS 5837:2012 FOR TREES SUBJECT TO DETAILED SURVEY, ESTIMATED BUFFER ZONE SHOWN INDICATIVELY FOR OTHER TREES)*
- APPROXIMATE SHADING ARC *(AS DEFINED BY BS 5837:2012)*
- NTM CATEGORY TREE, GROUP, HEDGE, OR WOODLAND *(QUALITY CATEGORY ESTIMATED VIA WALKOVER AND/OR DESK STUDY: A, B, C, U, OR UNCATEGORIZED*
- VETERAN/ANCIENT TREE *(IDENTIFIED BY SURVEY)*
- VETERAN/ANCIENT TREE *(IDENTIFIED BY WALKOVER/DESK STUDY)*
- TREE PRESERVATION ORDER *(AREA COVERED BY A TREE PRESERVATION ORDER [TPO])*
- CONSERVATION AREA *(AREA COVERED BY A TREE PRESERVATION ORDER [TPO])*

ISSUE/REVISION

P01	13/01/22	SECOND ISSUE
00	22/11/22	FIRST ISSUE
I/R	DATE	DESCRIPTION

DRAWING STATUS

SUBMITTED AT DEADLINE 5

PROJECT NUMBER

60589004

SHEET TITLE

TREE CONSTRAINTS PLAN (SHEET 4)

SHEET NUMBER 60589004-ACM-XX-XX-AB-TCP-04

REV. P01

Last saved by: BREWERJ(2023-01-13) Last Plotted: 2023-01-13
Filename: C:\USERS\BREWERJ\ONEDRIVE - AECOM\DESKTOP\SUNNICA FARM\SS\SUNNICA ENERGY FARN - TPP_001 - OFFLINE COPY\SUNNICA ENERGY FARN - TCP_004.DWG

Author: GR Designer: JB Checked: TF Approved: AW

Last saved by: BREWERJ (2023-01-13) Last Plotted: 2023-01-13
Filename: C:\USERS\BREWER.ION\ONEDRIVE - AECOM\DESKTOP\SUNNICA FARM\SSSUNNICA ENERGY FARM - TPP_001 - OFFLINE COPY\SUNNICA ENERGY FARM - TCP_004.DWG

Limekiln Plantation
Snailwell Fen
Trees not included in the NTM dataset, identified via review of aerial imagery
Track
Ditch
River Snail
Nursery
Depot
Tanks
Cemetery
Newmarket House
Lodge House
A14 Trunk Road
A142
B1085
15.5m
24.8m
Trees not included in the NTM dataset, identified via review of aerial imagery

G195* G196* H197* G206* T177* G201* T176 G200* G199* G192* G203* G193* G191* H194* W204* T164* T169* T168* T170* G190* T167* T171* T165* G189* G202* G198* G188* G181* T131* T132* T166 T172* T173* T174* T175* G205* T163* T162 G187* G186* T180 G185* T156* T152* T153* T160 T157* T159 T158* G184* T161* G183* T155 T154 T178 T179 T130 T133 T134* T135* T136* T137* T138* T139* T140* T141* T142* T145 T143* T144* T146 T147* T149* T148* T150* G182* T151* T335 T336 T337 T334 T338 T339

0 50 100 150 200 250m
SCALE 1:2500 @ ISO full bleed A1 (841.00 x 594.00 MM)

This drawing has been prepared for the use of AECOM's client. It may not be used, modified, reproduced or relied upon by third parties, except as agreed by AECOM or as required by law. AECOM accepts no responsibility, and denies any liability whatsoever, to any party that uses or relies on this drawing without AECOM's express written consent. Do not scale this document. All measurements must be obtained from the stated dimensions.

AECOM

PROJECT
SUNNICA ENERGY FARM

CLIENT
SUNNICA ENERGY FARM

CONSULTANT
AECOM
Plumer House, Third Floor,
East Wing, Tailyour Road
Plymouth, PL6 5DH
Tel +44(0)1752 676700
Fax +44(0)870 238 6023
www.aecom.com

GENERAL NOTES

1. TREE CATEGORIES AS DEFINED BY BS 5837:2012
2. TREE LOCATIONS ARE BASED ON THE TOPOGRAPHICAL SURVEY, AERIAL IMAGERY, AND GPS CO-ORDINATES FROM ON SITE WALKOVER.
3. * INDICATES A TREE / GROUP WHOSE POSITION IS APPROXIMATE AS BASED UPON AERIAL PHOTOGRAPHY AND ON SITE OBSERVATIONS.
4. PLANS SHOULD BE READ IN CONJUNCTION WITH THE AECOM ARBORICULTURAL REPORT.
5. THE ORIGINAL OF THIS DRAWING WAS PRODUCED IN COLOUR - A MONOCHROME COPY SHOULD NOT BE RELIED UPON.
6. DRAWING REFERNCES:
   TPO.dwg
   MERGED NTM DATA RevA Modified.dwg
   xref_OSMap.dwg
   20230105_Sunnica_WSP_RLB.dwg

KEY PLAN

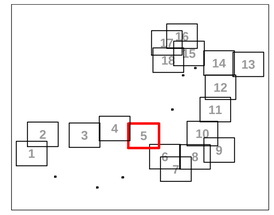

KEY

- ORDER LIMITS BOUNDARY
- LOCAL AUTHORITY BOUNDARY
- A CATEGORY TREE, GROUP, HEDGE, OR WOODLAND *(AS FOUND DURING DETAILED SURVEY, INDICATES HIGH QUALITY & VALUE)*
- B CATEGORY TREE, GROUP, HEDGE, OR WOODLAND *(AS FOUND DURING DETAILED SURVEY, INDICATES MODERATE QUALITY & VALUE)*
- C CATEGORY TREE, GROUP, HEDGE, OR WOODLAND *(AS FOUND DURING DETAILED SURVEY, INDICATES LOW QUALITY & VALUE)*
- U CATEGORY TREE, GROUP, HEDGE, OR WOODLAND *(AS FOUND DURING DETAILED SURVEY, UNSUITABLE FOR RETENTION)*
- ROOT PROTECTION AREAS (RPA) *(AS DEFINED BY BS 5837:2012 FOR TREES SUBJECT TO DETAILED SURVEY, ESTIMATED BUFFER ZONE SHOWN INDICATIVELY FOR OTHER TREES)*
- APPROXIMATE SHADING ARC *(AS DEFINED BY BS 5837:2012)*
- NTM CATEGORY TREE, GROUP, HEDGE, OR WOODLAND *(QUALITY CATEGORY ESTIMATED VIA WALKOVER AND/OR DESK STUDY: A, B, C, U, OR UNCATEGORIZED*
- VETERAN/ANCIENT TREE *(IDENTIFIED BY SURVEY)*
- VETERAN/ANCIENT TREE *(IDENTIFIED BY WALKOVER/DESK STUDY)*
- TREE PRESERVATION ORDER *(AREA COVERED BY A TREE PRESERVATION ORDER [TPO])*
- CONSERVATION AREA *(AREA COVERED BY A TREE PRESERVATION ORDER [TPO])*

ISSUE/REVISION

P01	13/01/22	SECOND ISSUE
00	22/11/22	FIRST ISSUE
I/R	DATE	DESCRIPTION

DRAWING STATUS
SUBMITTED AT DEADLINE 5

PROJECT NUMBER
60589004

SHEET TITLE
TREE CONSTRAINTS PLAN (SHEET 5)

SHEET NUMBER 60589004-ACM-XX-XX-AB-TCP-05

REV. P01

Author: GR Designer: JB Checked: TF Approved: AW

Last saved by: BREWER.I (2023-01-13) Last Plotted: 2023-01-13
Filename: C:\USERS\BREWER.I\ONEDRIVE - AECOM\DESKTOP\SUNNICA FARM\SS\SUNNICA ENERGY FARN - TPP_001 - OFFLINE COPY\SUNNICA ENERGY FARN - TCP_004.DWG

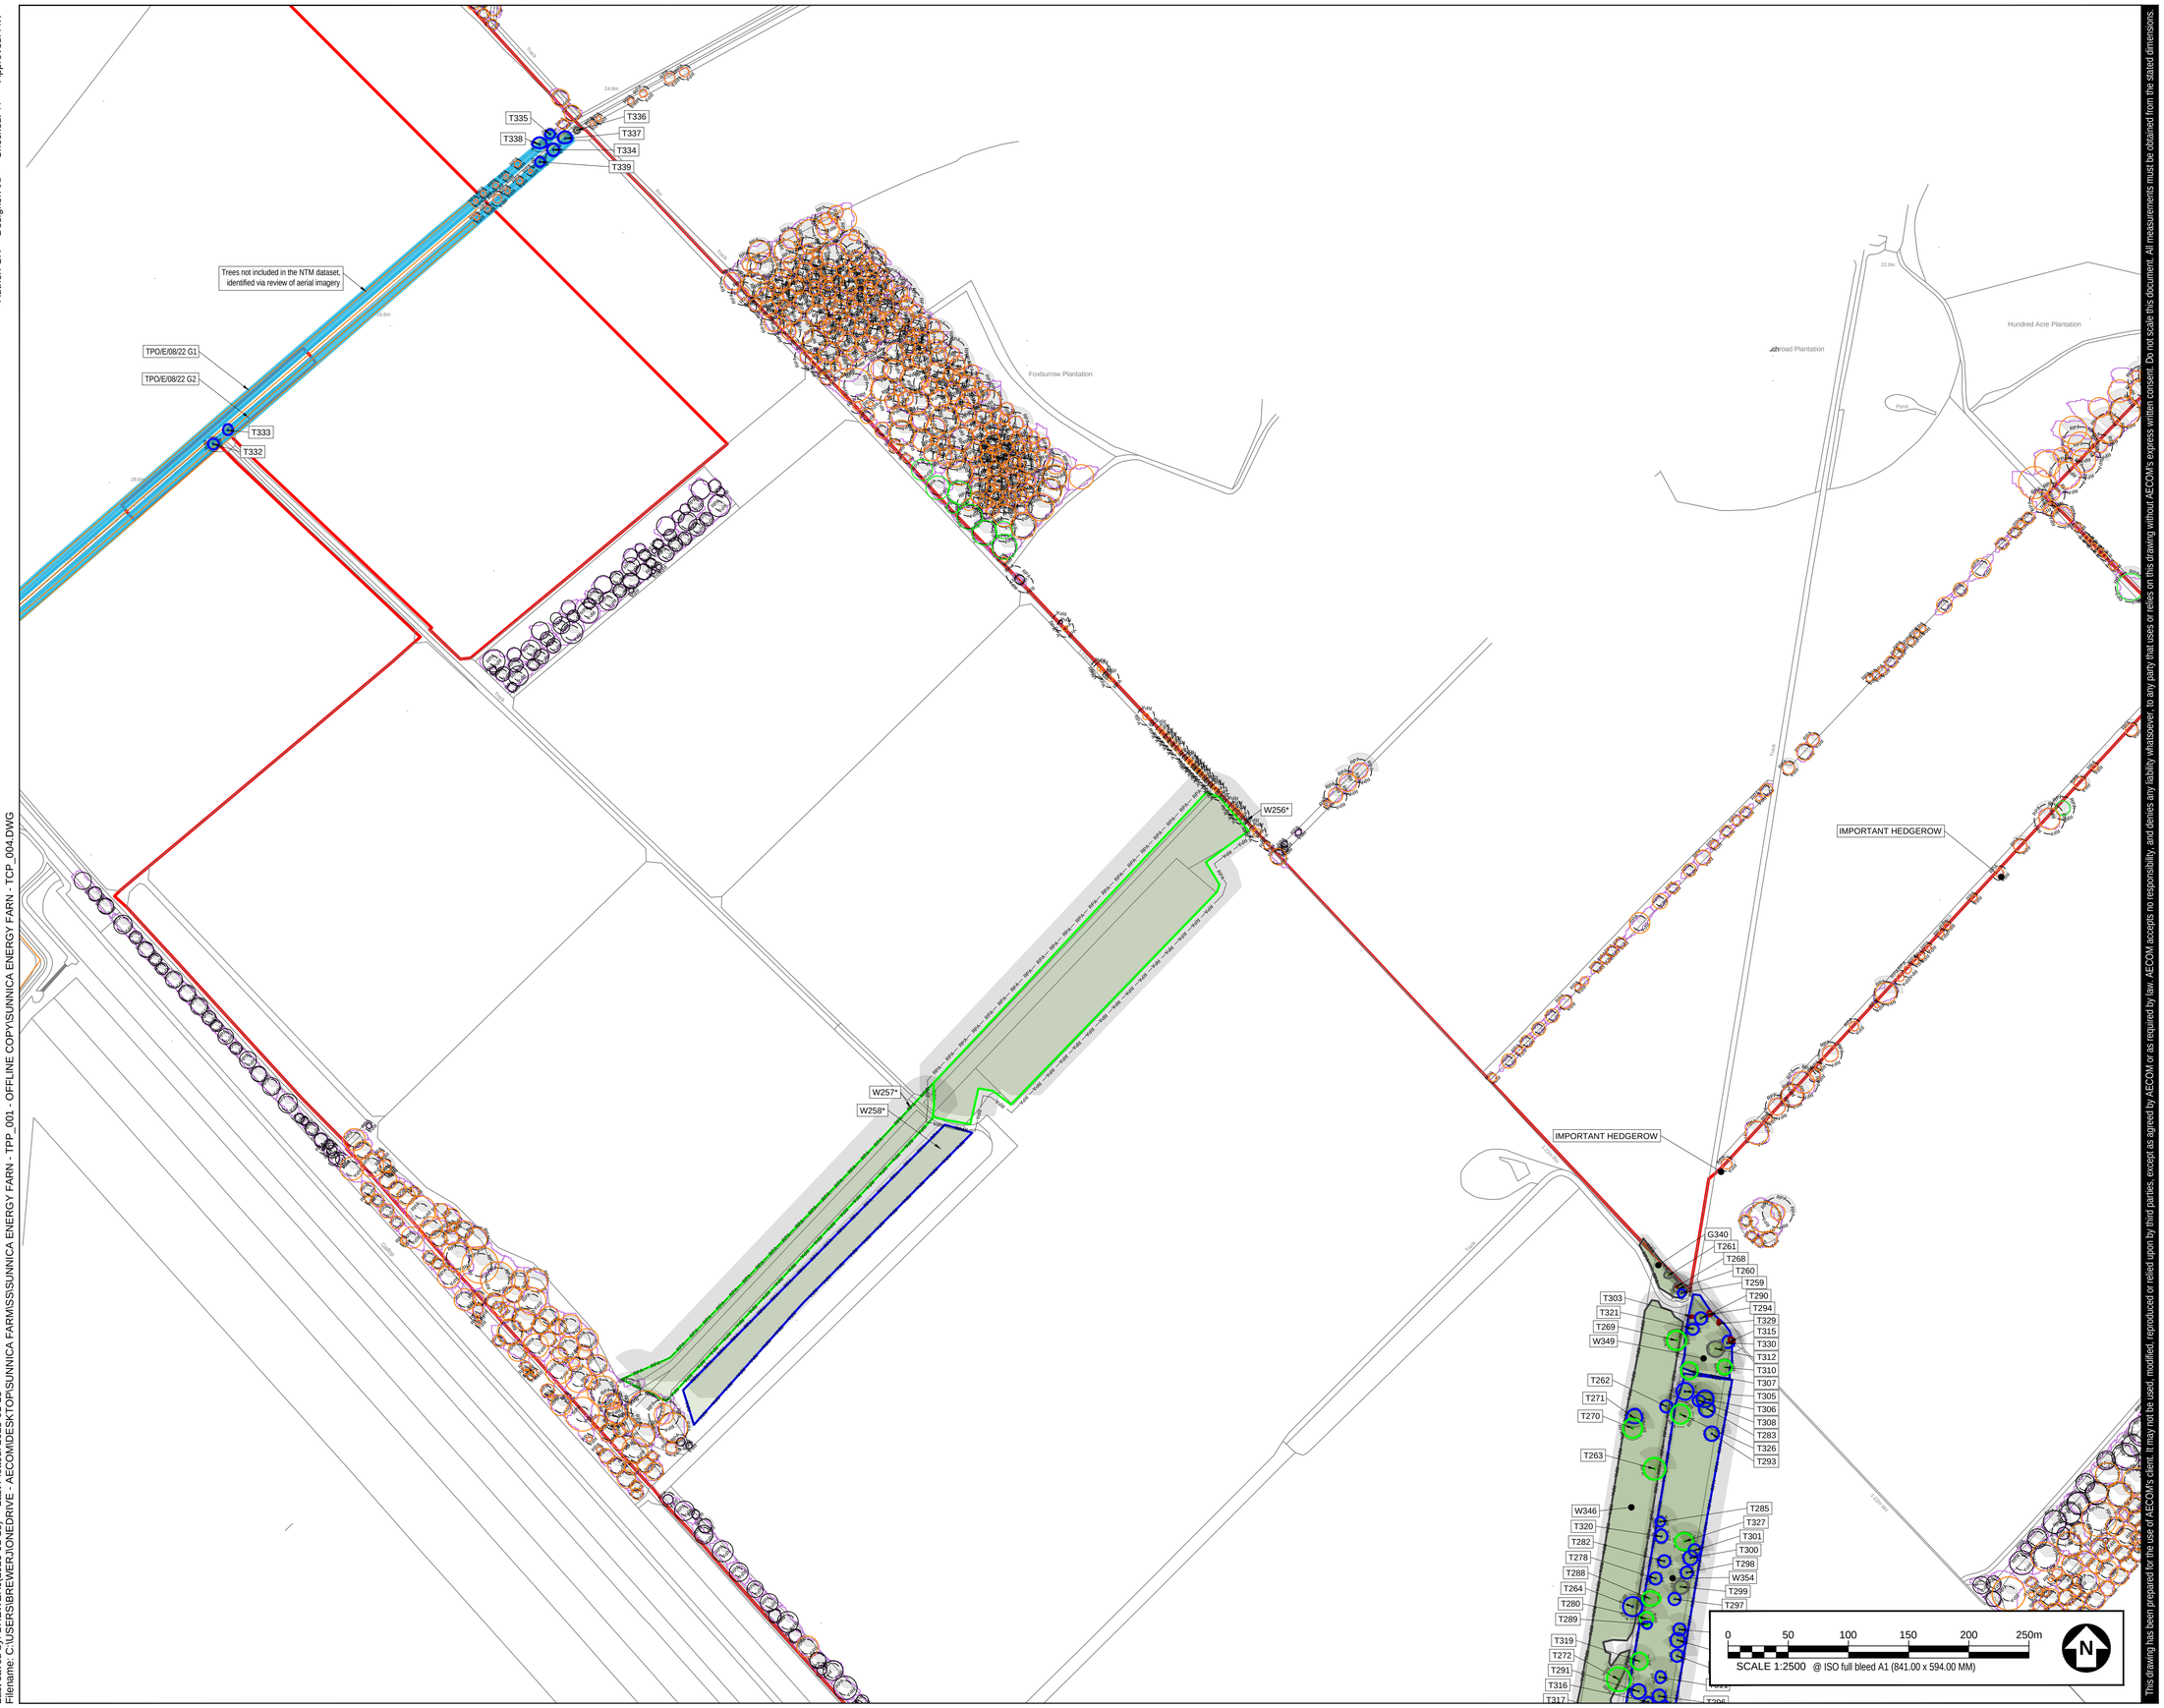

This drawing has been prepared for the use of AECOM's client. It may not be used, modified, reproduced or relied upon by third parties, except as agreed by AECOM or as required by law. AECOM accepts no responsibility, and denies any liability whatsoever, to any party that uses or relies on this drawing without AECOM's express written consent. Do not scale this document. All measurements must be obtained from the stated dimensions.

AECOM

PROJECT

SUNNICA ENERGY FARM

CLIENT

SUNNICA ENERGY FARM

CONSULTANT

AECOM
Plumer House, Third Floor,
East Wing, Tailyour Road
Plymouth, PL6 5DH
Tel +44(0)1752 676700
Fax +44(0)870 238 6023
www.aecom.com

GENERAL NOTES

1. TREE CATEGORIES AS DEFINED BY BS 5837:2012
2. TREE LOCATIONS ARE BASED ON THE TOPOGRAPHICAL SURVEY, AERIAL IMAGERY, AND GPS CO-ORDINATES FROM ON SITE WALKOVER.
3. * INDICATES A TREE / GROUP WHOSE POSITION IS APPROXIMATE AS BASED UPON AERIAL PHOTOGRAPHY AND ON SITE OBSERVATIONS.
4. PLANS SHOULD BE READ IN CONJUNCTION WITH THE AECOM ARBORICULTURAL REPORT.
5. THE ORIGINAL OF THIS DRAWING WAS PRODUCED IN COLOUR - A MONOCHROME COPY SHOULD NOT BE RELIED UPON.
6. DRAWING REFERNCES:
   TPO.dwg
   MERGED NTM DATA RevA Modified.dwg
   xref_OSMap.dwg
   20230105_Sunnica_WSP_RLB.dwg

KEY PLAN

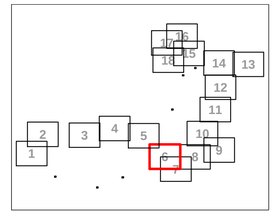

KEY

- **ORDER LIMITS BOUNDARY**
- **LOCAL AUTHORITY BOUNDARY**
- **A CATEGORY TREE, GROUP, HEDGE, OR WOODLAND** *(AS FOUND DURING DETAILED SURVEY, INDICATES HIGH QUALITY & VALUE)*
- **B CATEGORY TREE, GROUP, HEDGE, OR WOODLAND** *(AS FOUND DURING DETAILED SURVEY, INDICATES MODERATE QUALITY & VALUE)*
- **C CATEGORY TREE, GROUP, HEDGE, OR WOODLAND** *(AS FOUND DURING DETAILED SURVEY, INDICATES LOW QUALITY & VALUE)*
- **U CATEGORY TREE, GROUP, HEDGE, OR WOODLAND** *(AS FOUND DURING DETAILED SURVEY, UNSUITABLE FOR RETENTION)*
- **ROOT PROTECTION AREAS (RPA)** *(AS DEFINED BY BS 5837:2012 FOR TREES SUBJECT TO DETAILED SURVEY; ESTIMATED BUFFER ZONE SHOWN INDICATIVELY FOR OTHER TREES)*
- **APPROXIMATE SHADING ARC** *(AS DEFINED BY BS 5837:2012)*
- **NTM CATEGORY TREE, GROUP, HEDGE, OR WOODLAND** *(QUALITY CATEGORY ESTIMATED VIA WALKOVER AND/OR DESK STUDY: A, B, C, U, OR UNCATEGORIZED*
- **VETERAN/ANCIENT TREE** *(IDENTIFIED BY SURVEY)*
- **VETERAN/ANCIENT TREE** *(IDENTIFIED BY WALKOVER/DESK STUDY)*
- **TREE PRESERVATION ORDER** *(AREA COVERED BY A TREE PRESERVATION ORDER [TPO])*
- **CONSERVATION AREA** *(AREA COVERED BY A TREE PRESERVATION ORDER [TPO])*

ISSUE/REVISION

I/R	DATE	DESCRIPTION
P01	13/01/22	SECOND ISSUE
00	22/11/22	FIRST ISSUE

DRAWING STATUS

SUBMITTED AT DEADLINE 5

PROJECT NUMBER

60589004

SHEET TITLE

TREE CONSTRAINTS PLAN (SHEET 6)

SHEET NUMBER **REV.**

60589004-ACM-XX-XX-AB-TCP-06 P01

Author: GR Designer: JB Checked: TF Approved: AW

AECOM

PROJECT

SUNNICA ENERGY FARM

CLIENT

SUNNICA ENERGY FARM

CONSULTANT

AECOM
Plumer House, Third Floor,
East Wing, Tailyour Road
Plymouth, PL6 5DH
Tel +44(0)1752 676700
Fax +44(0)870 238 6023
www.aecom.com

GENERAL NOTES

1. TREE CATEGORIES AS DEFINED BY BS 5837:2012
2. TREE LOCATIONS ARE BASED ON THE TOPOGRAPHICAL SURVEY, AERIAL IMAGERY, AND GPS CO-ORDINATES FROM ON SITE WALKOVER.
3. * INDICATES A TREE / GROUP WHOSE POSITION IS APPROXIMATE AS BASED UPON AERIAL PHOTOGRAPHY AND ON SITE OBSERVATIONS.
4. PLANS SHOULD BE READ IN CONJUNCTION WITH THE AECOM ARBORICULTURAL REPORT.
5. THE ORIGINAL OF THIS DRAWING WAS PRODUCED IN COLOUR - A MONOCHROME COPY SHOULD NOT BE RELIED UPON.
6. DRAWING REFERNCES:
   TPO.dwg
   MERGED NTM DATA RevA Modified.dwg
   xref_OSMap.dwg
   20230105_Sunnica_WSP_RLB.dwg

KEY PLAN

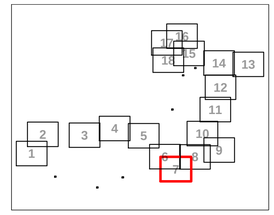

KEY

- **ORDER LIMITS BOUNDARY**
- **LOCAL AUTHORITY BOUNDARY**
- **A CATEGORY TREE, GROUP, HEDGE, OR WOODLAND** *(AS FOUND DURING DETAILED SURVEY, INDICATES HIGH QUALITY & VALUE)*
- **B CATEGORY TREE, GROUP, HEDGE, OR WOODLAND** *(AS FOUND DURING DETAILED SURVEY, INDICATES MODERATE QUALITY & VALUE)*
- **C CATEGORY TREE, GROUP, HEDGE, OR WOODLAND** *(AS FOUND DURING DETAILED SURVEY, INDICATES LOW QUALITY & VALUE)*
- **U CATEGORY TREE, GROUP, HEDGE, OR WOODLAND** *(AS FOUND DURING DETAILED SURVEY, UNSUITABLE FOR RETENTION)*
- **ROOT PROTECTION AREAS (RPA)** *(AS DEFINED BY BS 5837:2012 FOR TREES SUBJECT TO DETAILED SURVEY, ESTIMATED BUFFER ZONE SHOWN INDICATIVELY FOR OTHER TREES)*
- **APPROXIMATE SHADING ARC** *(AS DEFINED BY BS 5837:2012)*
- **NTM CATEGORY TREE, GROUP, HEDGE, OR WOODLAND** *(QUALITY CATEGORY ESTIMATED VIA WALKOVER AND/OR DESK STUDY: A, B, C, U, OR UNCATEGORIZED*
- **VETERAN/ANCIENT TREE** *(IDENTIFIED BY SURVEY)*
- **VETERAN/ANCIENT TREE** *(IDENTIFIED BY WALKOVER/DESK STUDY)*
- **TREE PRESERVATION ORDER** *(AREA COVERED BY A TREE PRESERVATION ORDER [TPO])*
- **CONSERVATION AREA** *(AREA COVERED BY A TREE PRESERVATION ORDER [TPO])*

ISSUE/REVISION

I/R	DATE	DESCRIPTION
P01	13/01/22	SECOND ISSUE
00	22/11/22	FIRST ISSUE

DRAWING STATUS

SUBMITTED AT DEADLINE 5

PROJECT NUMBER

60589004

SHEET TITLE

TREE CONSTRAINTS PLAN (SHEET 7)

SHEET NUMBER 60589004-ACM-XX-XX-AB-TCP-07

REV. P01

This drawing has been prepared for the use of AECOM's client. It may not be used, modified, reproduced or relied upon by third parties, except as agreed by AECOM or as required by law. AECOM accepts no responsibility, and denies any liability whatsoever, to any party that uses or relies on this drawing without AECOM's express written consent. Do not scale this document. All measurements must be obtained from the stated dimensions.

Last saved by: BREWERJ (2023-01-13) Last Plotted: 2023-01-13
Filename: C:\USERS\BREWERJ\ONEDRIVE - AECOM\DESKTOP\SUNNICA FARM\SS\SUNNICA ENERGY FARN - TPP_001 - OFFLINE COPY\SUNNICA ENERGY FARN - TCP_004.DWG

Author: GR Designer: JB Checked: TF Approved: AW

Last saved by: BREWERJ (2023-01-13) Last Plotted: 2023-01-13
Filename: C:\USERS\BREWERJ\ONEDRIVE - AECOM\DESKTOP\SUNNICA FARM\SSI\SUNNICA ENERGY FARN - TPP_001 - OFFLINE COPY\SUNNICA ENERGY FARN - TCP_004.DWG

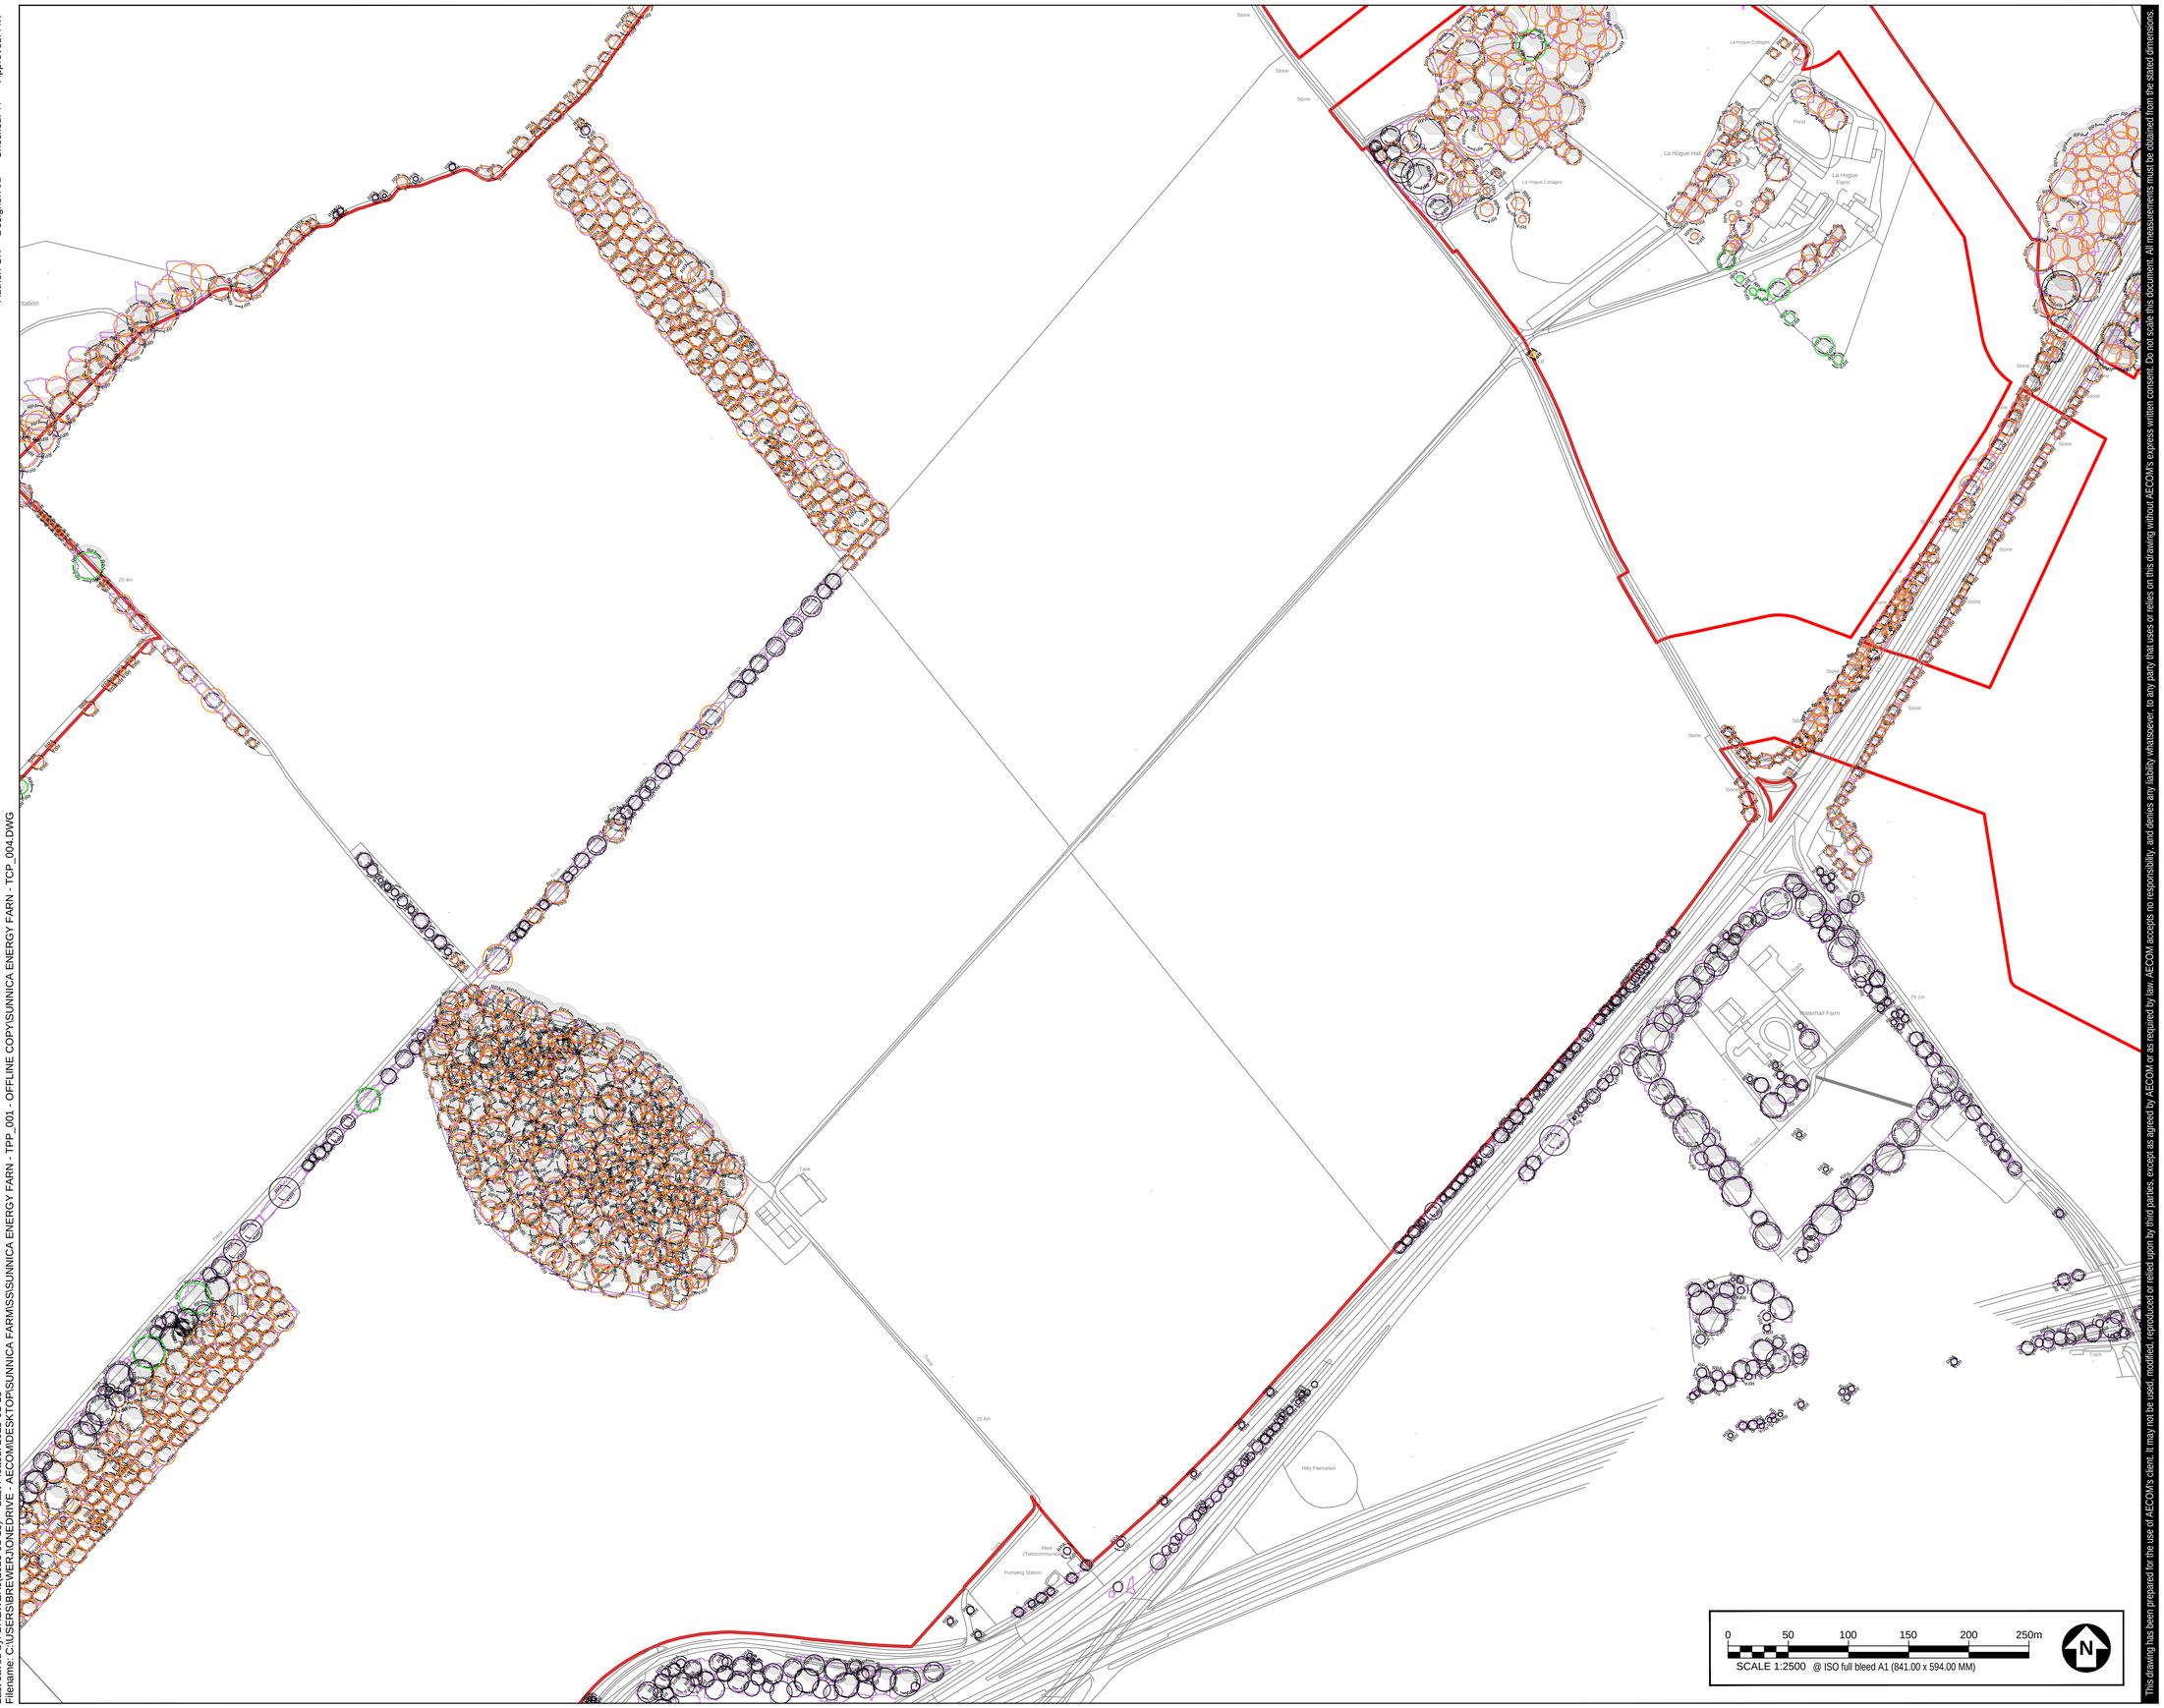
La Hogue Cottages
Pond
La Hogue Hall
La Hogue Farm
La Hogue Cottages
Stone
Stone
Stone

Potential Veteran tree's identified by site walkover [2019]

Author: GR Designer: JB Checked: TF Approved: AW

Last saved by: BREWERJ(2023-01-13) Last Plotted: 2023-01-13
Filename: C:\USERS\BREWERJ\ONEDRIVE - AECOM\DESKTOP\SUNNICA FARM\SS\SUNNICA ENERGY FARN - TPP_001 - OFFLINE COPY\SUNNICA ENERGY FARN - TCP_004.DWG

This drawing has been prepared for the use of AECOM's client. It may not be used, modified, reproduced or relied upon by third parties, except as agreed by AECOM or as required by law. AECOM accepts no responsibility, and denies any liability whatsoever, to any party that uses or relies on this drawing without AECOM's express written consent. Do not scale this document. All measurements must be obtained from the stated dimensions.

0 50 100 150 200 250m

SCALE 1:2500 @ ISO full bleed A1 (841.00 x 594.00 MM)

AECOM

PROJECT

SUNNICA ENERGY FARM

CLIENT

SUNNICA ENERGY FARM

CONSULTANT

AECOM
Plumer House, Third Floor,
East Wing, Tailyour Road
Plymouth, PL6 5DH
Tel +44(0)1752 676700
Fax +44(0)870 238 6023
www.aecom.com

GENERAL NOTES

1. TREE CATEGORIES AS DEFINED BY BS 5837:2012
2. TREE LOCATIONS ARE BASED ON THE TOPOGRAPHICAL SURVEY, AERIAL IMAGERY, AND GPS CO-ORDINATES FROM ON SITE WALKOVER.
3. * INDICATES A TREE / GROUP WHOSE POSITION IS APPROXIMATE AS BASED UPON AERIAL PHOTOGRAPHY AND ON SITE OBSERVATIONS.
4. PLANS SHOULD BE READ IN CONJUNCTION WITH THE AECOM ARBORICULTURAL REPORT.
5. THE ORIGINAL OF THIS DRAWING WAS PRODUCED IN COLOUR - A MONOCHROME COPY SHOULD NOT BE RELIED UPON.
6. DRAWING REFERNCES:
   TPO.dwg
   MERGED NTM DATA RevA Modified.dwg
   xref_OSMap.dwg
   20230105_Sunnica_WSP_RLB.dwg

KEY PLAN

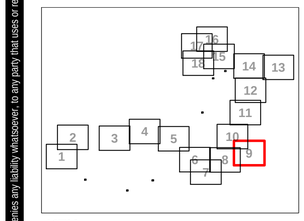

KEY

- **ORDER LIMITS BOUNDARY**
- **LOCAL AUTHORITY BOUNDARY**
- **A CATEGORY TREE, GROUP, HEDGE, OR WOODLAND** *(AS FOUND DURING DETAILED SURVEY, INDICATES HIGH QUALITY & VALUE)*
- **B CATEGORY TREE, GROUP, HEDGE, OR WOODLAND** *(AS FOUND DURING DETAILED SURVEY, INDICATES MODERATE QUALITY & VALUE)*
- **C CATEGORY TREE, GROUP, HEDGE, OR WOODLAND** *(AS FOUND DURING DETAILED SURVEY, INDICATES LOW QUALITY & VALUE)*
- **U CATEGORY TREE, GROUP, HEDGE, OR WOODLAND** *(AS FOUND DURING DETAILED SURVEY, UNSUITABLE FOR RETENTION)*
- **ROOT PROTECTION AREAS (RPA)** *(AS DEFINED BY BS 5837:2012 FOR TREES SUBJECT TO DETAILED SURVEY. ESTIMATED BUFFER ZONE SHOWN INDICATIVELY FOR OTHER TREES)*
- **APPROXIMATE SHADING ARC** *(AS DEFINED BY BS 5837:2012)*
- **NTM CATEGORY TREE, GROUP, HEDGE, OR WOODLAND** *(QUALITY CATEGORY ESTIMATED VIA WALKOVER AND/OR DESK STUDY: A, B, C, U, OR UNCATEGORIZED*
- **VETERAN/ANCIENT TREE** *(IDENTIFIED BY SURVEY)*
- **VETERAN/ANCIENT TREE** *(IDENTIFIED BY WALKOVER/DESK STUDY)*
- **TREE PRESERVATION ORDER** *(AREA COVERED BY A TREE PRESERVATION ORDER [TPO])*
- **CONSERVATION AREA** *(AREA COVERED BY A TREE PRESERVATION ORDER [TPO])*

ISSUE/REVISION

P01	13/01/22	SECOND ISSUE
00	22/11/22	FIRST ISSUE
I/R	DATE	DESCRIPTION

DRAWING STATUS

SUBMITTED AT DEADLINE 5

PROJECT NUMBER

60589004

SHEET TITLE

TREE CONSTRAINTS PLAN (SHEET 9)

SHEET NUMBER / REV.

60589004-ACM-XX-XX-AB-TCP-09 P01

Author: GR Designer: JB Checked: TF Approved: AW

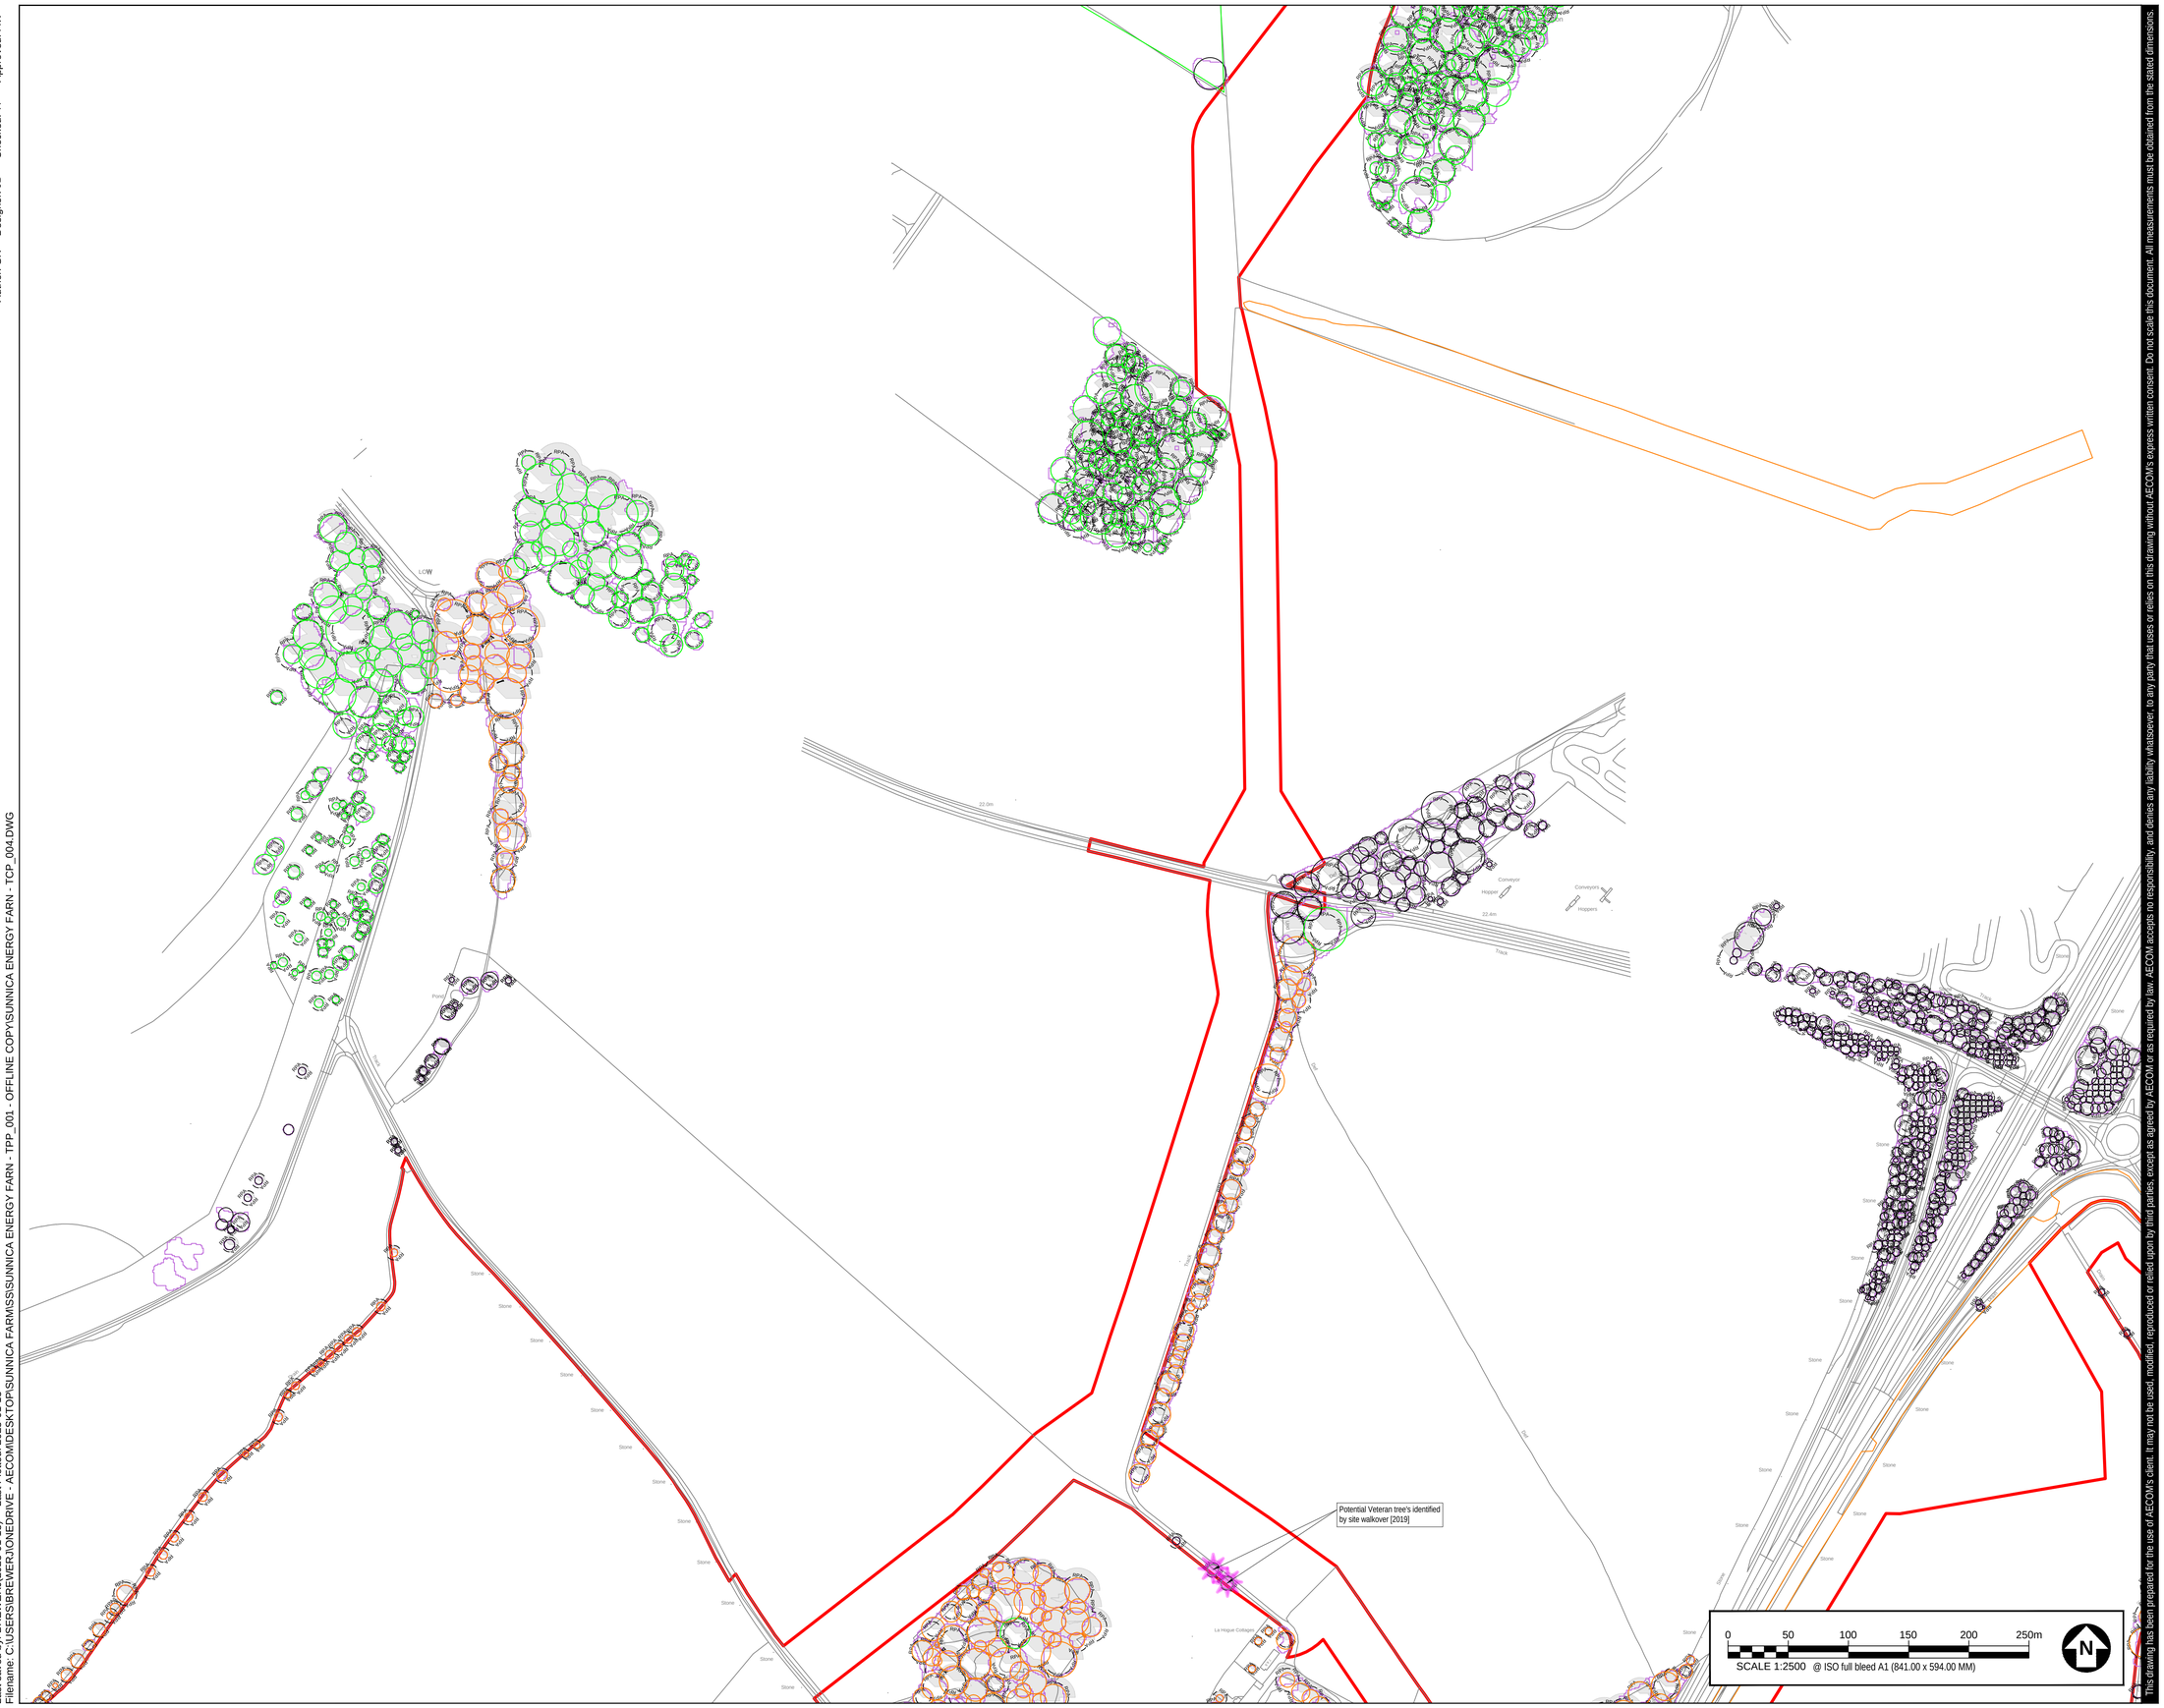

Last saved by: BREWER.J (2023-01-13) , Last Plotted: 2023-01-13
Filename: C:\USERS\BREWER.J\ONEDRIVE - AECOM\DESKTOP\SUNNICA FARM\SS\SUNNICA ENERGY FARN - TPP_001 - OFFLINE COPY\SUNNICA ENERGY FARN - TCP_004.DWG

This drawing has been prepared for the use of AECOM's client. It may not be used, modified, reproduced or relied upon by third parties, except as agreed by AECOM or as required by law. AECOM accepts no responsibility, and denies any liability whatsoever, to any party that uses or relies on this drawing without AECOM's express written consent. Do not scale this document. All measurements must be obtained from the stated dimensions.

AECOM

PROJECT

SUNNICA ENERGY FARM

CLIENT

SUNNICA ENERGY FARM

CONSULTANT

AECOM
Plumer House, Third Floor,
East Wing, Tailyour Road
Plymouth, PL6 5DH
Tel +44(0)1752 676700
Fax +44(0)870 238 6023
www.aecom.com

GENERAL NOTES

1. TREE CATEGORIES AS DEFINED BY BS 5837:2012
2. TREE LOCATIONS ARE BASED ON THE TOPOGRAPHICAL SURVEY, AERIAL IMAGERY, AND GPS CO-ORDINATES FROM ON SITE WALKOVER.
3. * INDICATES A TREE / GROUP WHOSE POSITION IS APPROXIMATE AS BASED UPON AERIAL PHOTOGRAPHY AND ON SITE OBSERVATIONS.
4. PLANS SHOULD BE READ IN CONJUNCTION WITH THE AECOM ARBORICULTURAL REPORT.
5. THE ORIGINAL OF THIS DRAWING WAS PRODUCED IN COLOUR - A MONOCHROME COPY SHOULD NOT BE RELIED UPON.
6. DRAWING REFERNCES:
   TPO.dwg
   MERGED NTM DATA RevA Modified.dwg
   xref_OSMap.dwg
   20230105_Sunnica_WSP_RLB.dwg

KEY PLAN

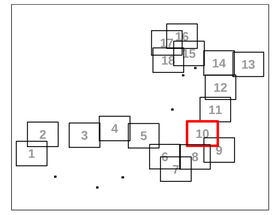

KEY

- **ORDER LIMITS BOUNDARY**
- **LOCAL AUTHORITY BOUNDARY**
- **A CATEGORY TREE, GROUP, HEDGE, OR WOODLAND** *(AS FOUND DURING DETAILED SURVEY, INDICATES HIGH QUALITY & VALUE)*
- **B CATEGORY TREE, GROUP, HEDGE, OR WOODLAND** *(AS FOUND DURING DETAILED SURVEY, INDICATES MODERATE QUALITY & VALUE)*
- **C CATEGORY TREE, GROUP, HEDGE, OR WOODLAND** *(AS FOUND DURING DETAILED SURVEY, INDICATES LOW QUALITY & VALUE)*
- **U CATEGORY TREE, GROUP, HEDGE, OR WOODLAND** *(AS FOUND DURING DETAILED SURVEY, UNSUITABLE FOR RETENTION)*
- **ROOT PROTECTION AREAS (RPA)** *(AS DEFINED BY BS 5837:2012 FOR TREES SUBJECT TO DETAILED SURVEY, ESTIMATED BUFFER ZONE SHOWN INDICATIVELY FOR OTHER TREES)*
- **APPROXIMATE SHADING ARC** *(AS DEFINED BY BS 5837:2012)*
- **NTM CATEGORY TREE, GROUP, HEDGE, OR WOODLAND** *(QUALITY CATEGORY ESTIMATED VIA WALKOVER AND/OR DESK STUDY: A, B, C, U, OR UNCATEGORIZED*
- **VETERAN/ANCIENT TREE** *(IDENTIFIED BY SURVEY)*
- **VETERAN/ANCIENT TREE** *(IDENTIFIED BY WALKOVERDESK STUDY)*
- **TREE PRESERVATION ORDER** *(AREA COVERED BY A TREE PRESERVATION ORDER [TPO])*
- **CONSERVATION AREA** *(AREA COVERED BY A TREE PRESERVATION ORDER [TPO])*

ISSUE/REVISION

P01	13/01/22	SECOND ISSUE
00	22/11/22	FIRST ISSUE
I/R	DATE	DESCRIPTION

DRAWING STATUS

SUBMITTED AT DEADLINE 5

PROJECT NUMBER

60589004

SHEET TITLE

TREE CONSTRAINTS PLAN (SHEET 10)

SHEET NUMBER **REV.**

60589004-ACM-XX-XX-AB-TCP-010 P01

Author: GR Designer: JB Checked: TF Approved: AW

Last saved by: BREWER.I (2023-01-13) Last Plotted: 2023-01-13
Filename: C:\USERS\BREWER.I\ONEDRIVE - AECOM\DESKTOP\SUNNICA FARM\SS\SUNNICA ENERGY FARN - TPP_001 - OFFLINE COPY\SUNNICA ENERGY FARN - TCP_004.DWG

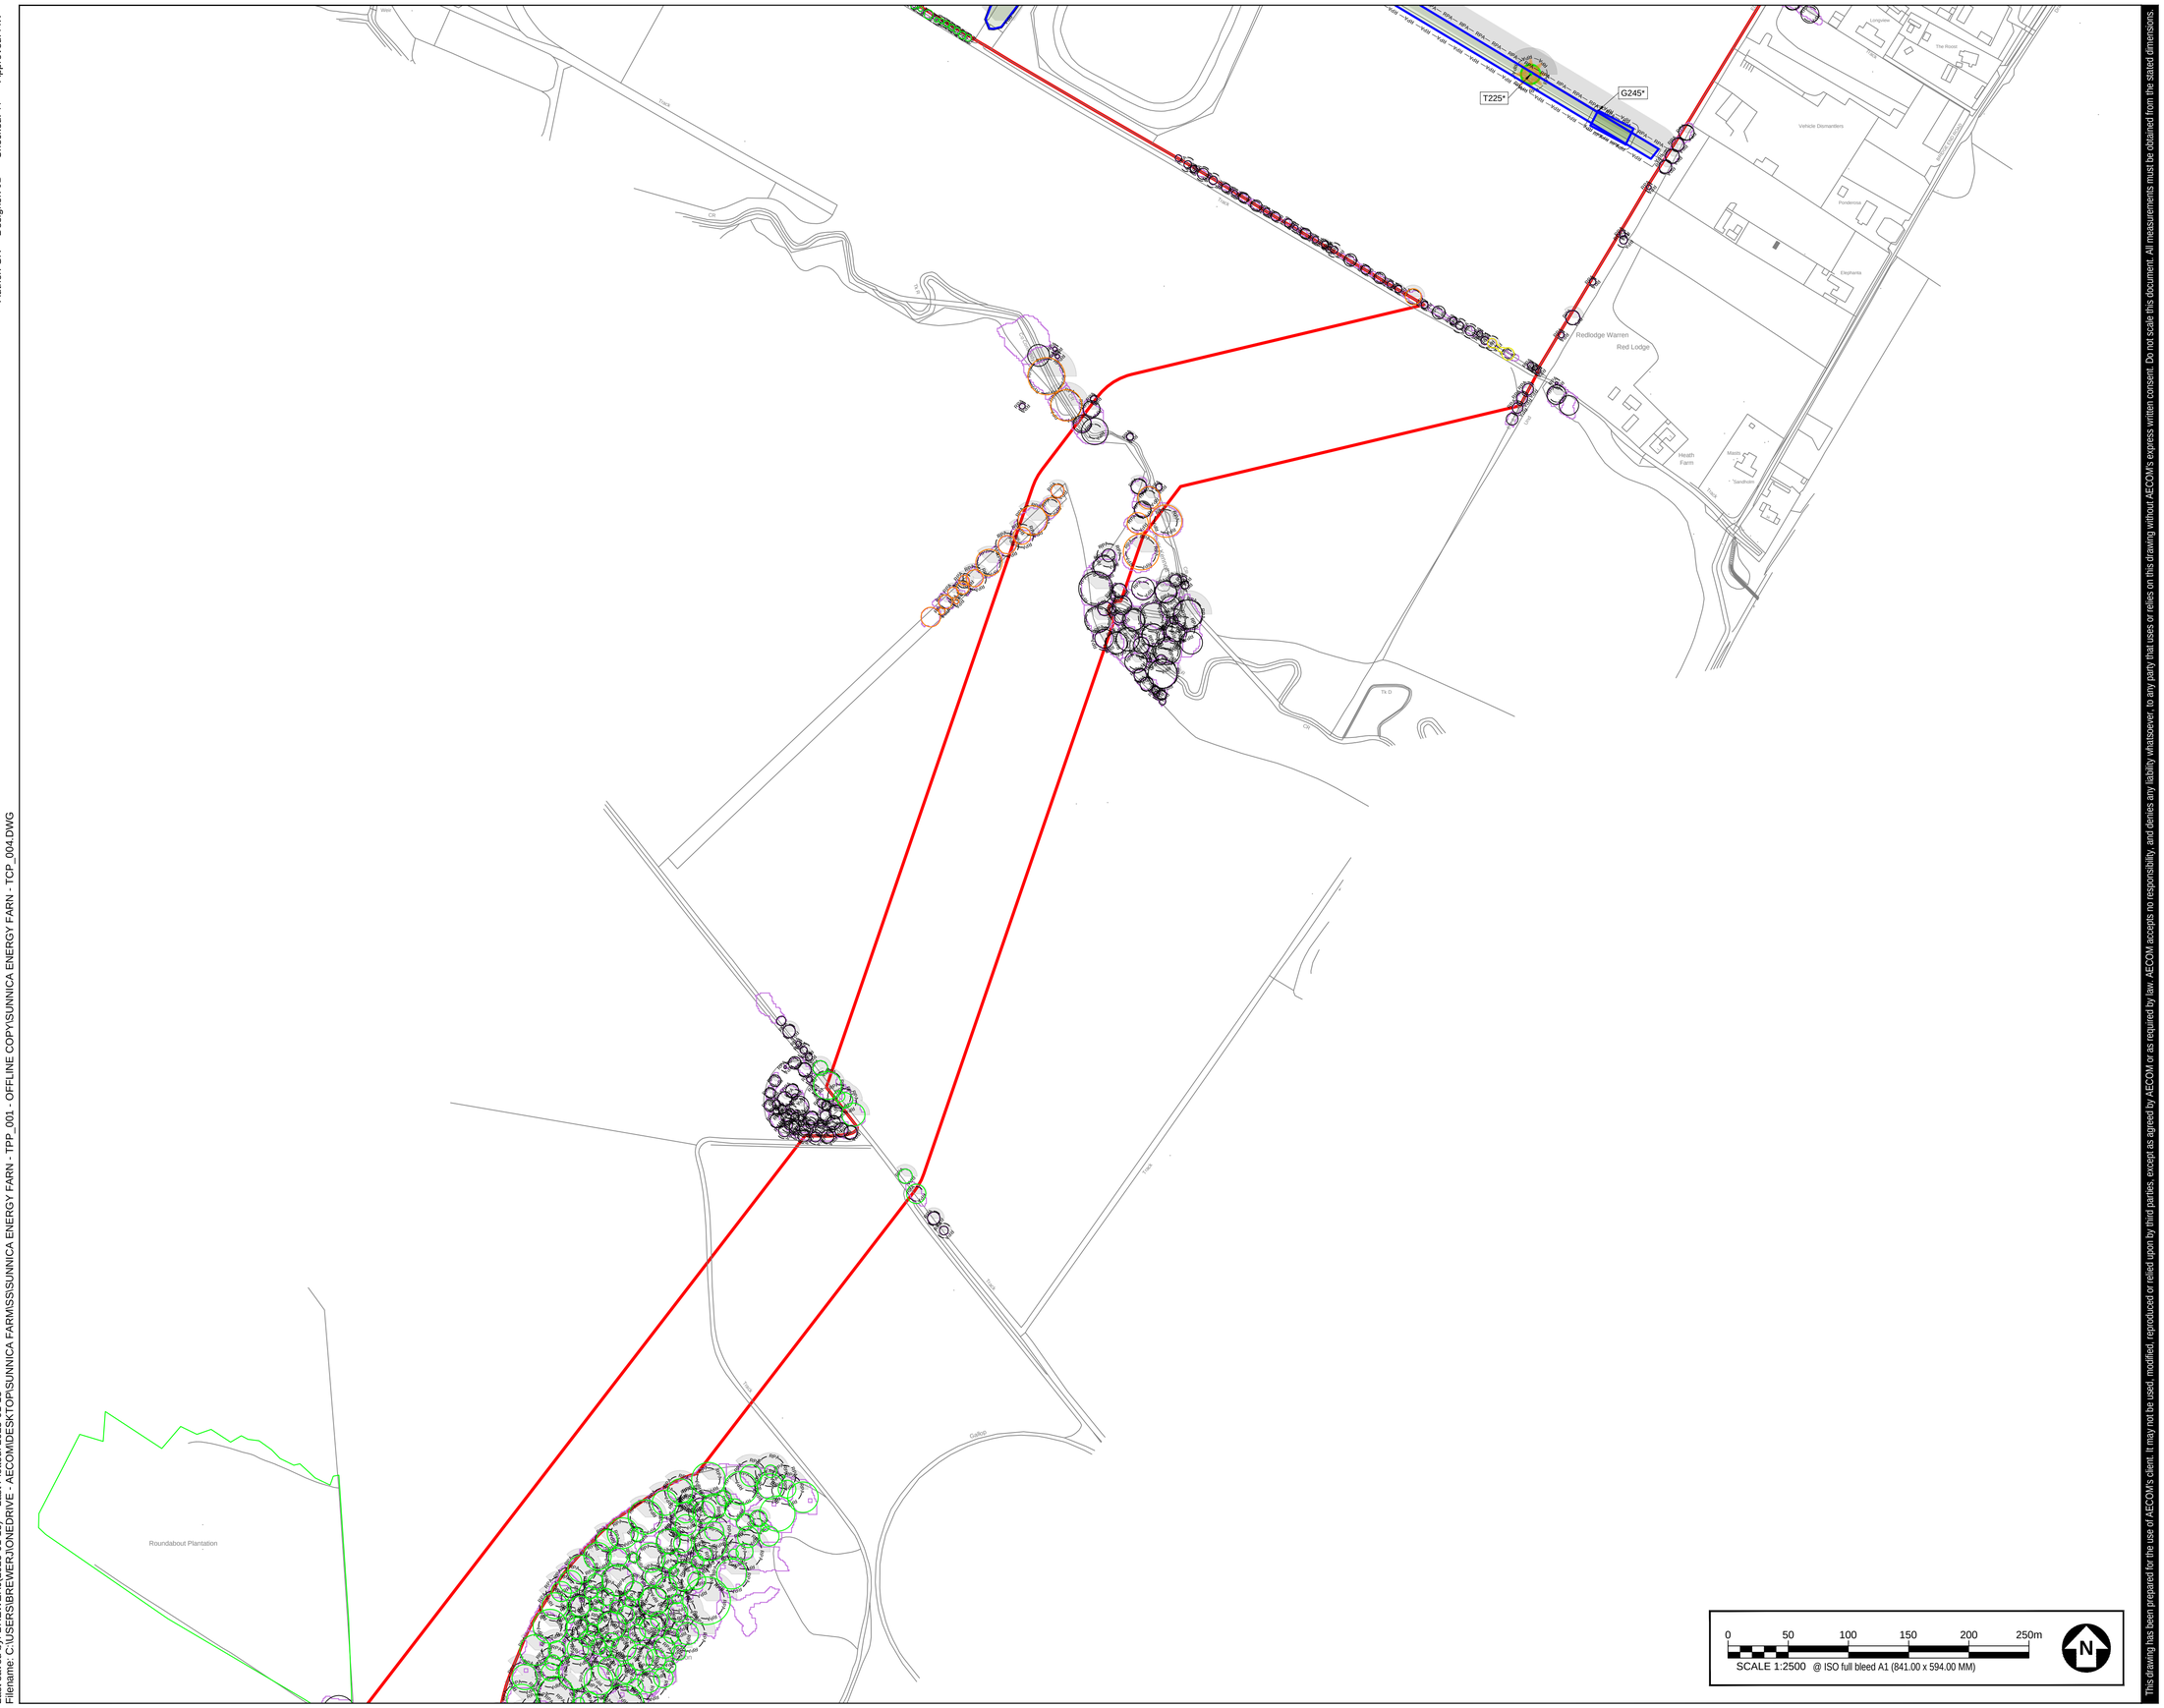

0 50 100 150 200 250m

SCALE 1:2500 @ ISO full bleed A1 (841.00 x 594.00 MM)

This drawing has been prepared for the use of AECOM's client. It may not be used, modified, reproduced or relied upon by third parties, except as agreed by AECOM or as required by law. AECOM accepts no responsibility, and denies any liability whatsoever, to any party that uses or relies on this drawing without AECOM's express written consent. Do not scale this document. All measurements must be obtained from the stated dimensions.

AECOM

PROJECT

SUNNICA ENERGY FARM

CLIENT

SUNNICA ENERGY FARM

CONSULTANT

AECOM
Plumer House, Third Floor,
East Wing, Tailyour Road
Plymouth, PL6 5DH
Tel +44(0)1752 676700
Fax +44(0)870 238 6023
www.aecom.com

GENERAL NOTES

1. TREE CATEGORIES AS DEFINED BY BS 5837:2012
2. TREE LOCATIONS ARE BASED ON THE TOPOGRAPHICAL SURVEY, AERIAL IMAGERY, AND GPS CO-ORDINATES FROM ON SITE WALKOVER.
3. * INDICATES A TREE / GROUP WHOSE POSITION IS APPROXIMATE AS BASED UPON AERIAL PHOTOGRAPHY AND ON SITE OBSERVATIONS.
4. PLANS SHOULD BE READ IN CONJUNCTION WITH THE AECOM ARBORICULTURAL REPORT.
5. THE ORIGINAL OF THIS DRAWING WAS PRODUCED IN COLOUR - A MONOCHROME COPY SHOULD NOT BE RELIED UPON.
6. DRAWING REFERNCES:
   TPO.dwg
   MERGED NTM DATA RevA Modified.dwg
   xref_OSMap.dwg
   20230105_Sunnica_WSP_RLB.dwg

KEY PLAN

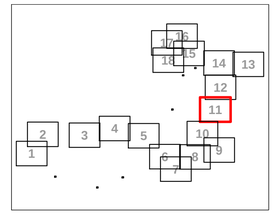

KEY

- **ORDER LIMITS BOUNDARY**
- **LOCAL AUTHORITY BOUNDARY**
- **A CATEGORY TREE, GROUP, HEDGE, OR WOODLAND** *(AS FOUND DURING DETAILED SURVEY, INDICATES HIGH QUALITY & VALUE)*
- **B CATEGORY TREE, GROUP, HEDGE, OR WOODLAND** *(AS FOUND DURING DETAILED SURVEY, INDICATES MODERATE QUALITY & VALUE)*
- **C CATEGORY TREE, GROUP, HEDGE, OR WOODLAND** *(AS FOUND DURING DETAILED SURVEY, INDICATES LOW QUALITY & VALUE)*
- **U CATEGORY TREE, GROUP, HEDGE, OR WOODLAND** *(AS FOUND DURING DETAILED SURVEY, UNSUITABLE FOR RETENTION)*
- **ROOT PROTECTION AREAS (RPA)** *(AS DEFINED BY BS 5837:2012 FOR TREES SUBJECT TO DETAILED SURVEY, ESTIMATED BUFFER ZONE SHOWN INDICATIVELY FOR OTHER TREES)*
- **APPROXIMATE SHADING ARC** *(AS DEFINED BY BS 5837:2012)*
- **NTM CATEGORY TREE, GROUP, HEDGE, OR WOODLAND** *(QUALITY CATEGORY ESTIMATED VIA WALKOVER AND/OR DESK STUDY: A, B, C, U, OR UNCATEGORIZED*
- **VETERAN/ANCIENT TREE** *(IDENTIFIED BY SURVEY)*
- **VETERAN/ANCIENT TREE** *(IDENTIFIED BY WALKOVER/DESK STUDY)*
- **TREE PRESERVATION ORDER** *(AREA COVERED BY A TREE PRESERVATION ORDER [TPO])*
- **CONSERVATION AREA** *(AREA COVERED BY A TREE PRESERVATION ORDER [TPO])*

ISSUE/REVISION

I/R	DATE	DESCRIPTION
P01	13/01/22	SECOND ISSUE
00	22/11/22	FIRST ISSUE

DRAWING STATUS

SUBMITTED AT DEADLINE 5

PROJECT NUMBER

60589004

SHEET TITLE

TREE CONSTRAINTS PLAN (SHEET 11)

SHEET NUMBER **REV.**

60589004-ACM-XX-XX-AB-TCP-011 P01

Author: GR Designer: JB Checked: TF Approved: AW

Last saved by: BREWERJ (2023-01-13) Last Plotted: 2023-01-13
Filename: C:\USERS\BREWERJ\ONEDRIVE - AECOM\DESKTOP\SUNNICA FARM\SS\SUNNICA ENERGY FARN - TPP_001 - OFFLINE COPY\SUNNICA ENERGY FARN - TCP_004.DWG

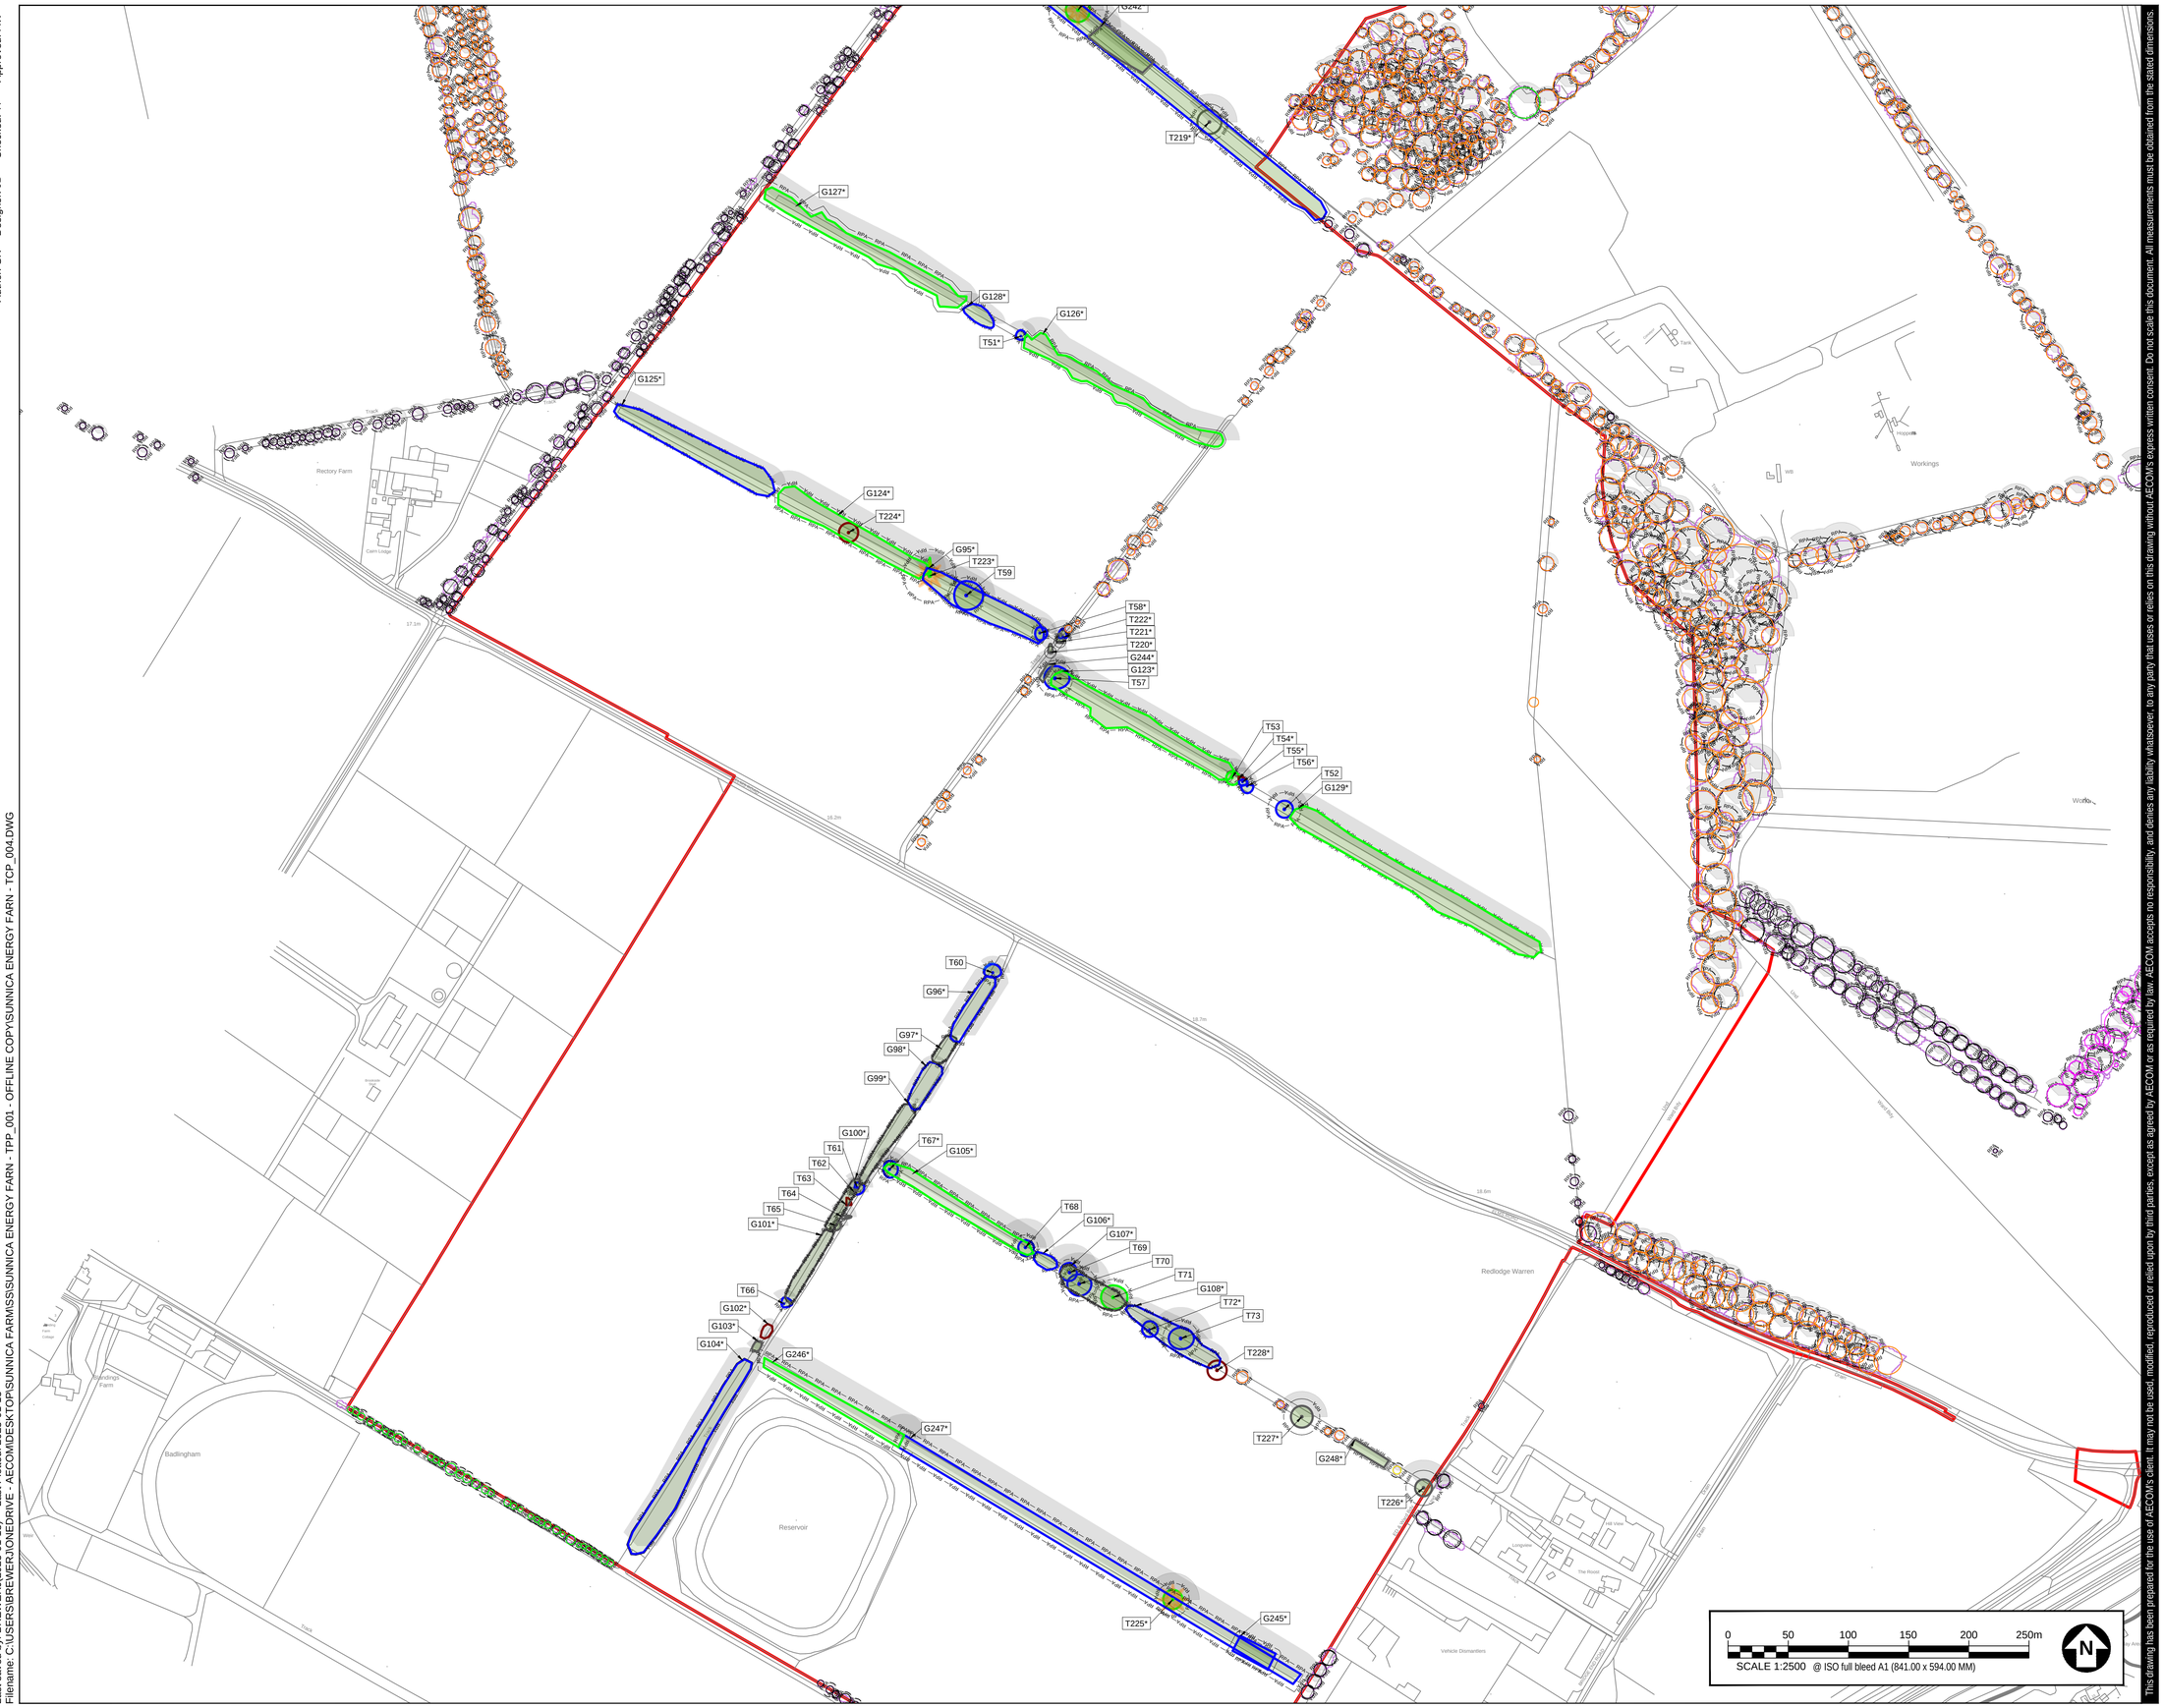

AECOM

PROJECT

SUNNICA ENERGY FARM

CLIENT

SUNNICA ENERGY FARM

CONSULTANT

AECOM
Plumer House, Third Floor,
East Wing, Tailyour Road
Plymouth, PL6 5DH
Tel +44(0)1752 676700
Fax +44(0)870 238 6023
www.aecom.com

GENERAL NOTES

1. TREE CATEGORIES AS DEFINED BY BS 5837:2012
2. TREE LOCATIONS ARE BASED ON THE TOPOGRAPHICAL SURVEY, AERIAL IMAGERY, AND GPS CO-ORDINATES FROM ON SITE WALKOVER.
3. * INDICATES A TREE / GROUP WHOSE POSITION IS APPROXIMATE AS BASED UPON AERIAL PHOTOGRAPHY AND ON SITE OBSERVATIONS.
4. PLANS SHOULD BE READ IN CONJUNCTION WITH THE AECOM ARBORICULTURAL REPORT.
5. THE ORIGINAL OF THIS DRAWING WAS PRODUCED IN COLOUR - A MONOCHROME COPY SHOULD NOT BE RELIED UPON.
6. DRAWING REFERNCES:
   TPO.dwg
   MERGED NTM DATA RevA Modified.dwg
   xref_OSMap.dwg
   20230105_Sunnica_WSP_RLB.dwg

KEY PLAN

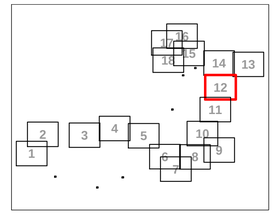

KEY

- **ORDER LIMITS BOUNDARY**
- **LOCAL AUTHORITY BOUNDARY**
- **A CATEGORY TREE, GROUP, HEDGE, OR WOODLAND** *(AS FOUND DURING DETAILED SURVEY, INDICATES HIGH QUALITY & VALUE)*
- **B CATEGORY TREE, GROUP, HEDGE, OR WOODLAND** *(AS FOUND DURING DETAILED SURVEY, INDICATES MODERATE QUALITY & VALUE)*
- **C CATEGORY TREE, GROUP, HEDGE, OR WOODLAND** *(AS FOUND DURING DETAILED SURVEY, INDICATES LOW QUALITY & VALUE)*
- **U CATEGORY TREE, GROUP, HEDGE, OR WOODLAND** *(AS FOUND DURING DETAILED SURVEY, UNSUITABLE FOR RETENTION)*
- **ROOT PROTECTION AREAS (RPA)** *(AS DEFINED BY BS 5837:2012 FOR TREES SUBJECT TO DETAILED SURVEY, ESTIMATED BUFFER ZONE SHOWN INDICATIVELY FOR OTHER TREES)*
- **APPROXIMATE SHADING ARC** *(AS DEFINED BY BS 5837:2012)*
- **NTM CATEGORY TREE, GROUP, HEDGE, OR WOODLAND** *(QUALITY CATEGORY ESTIMATED VIA WALKOVER AND/OR DESK STUDY: A, B, C, U, OR UNCATEGORIZED*
- **VETERAN/ANCIENT TREE** *(IDENTIFIED BY SURVEY)*
- **VETERAN/ANCIENT TREE** *(IDENTIFIED BY WALKOVER/DESK STUDY)*
- **TREE PRESERVATION ORDER** *(AREA COVERED BY A TREE PRESERVATION ORDER [TPO])*
- **CONSERVATION AREA** *(AREA COVERED BY A TREE PRESERVATION ORDER [TPO])*

ISSUE/REVISION

P01	13/01/22	SECOND ISSUE
00	22/11/22	FIRST ISSUE
I/R	DATE	DESCRIPTION

DRAWING STATUS

SUBMITTED AT DEADLINE 5

PROJECT NUMBER

60589004

SHEET TITLE

TREE CONSTRAINTS PLAN (SHEET 12)

SHEET NUMBER **REV.**

60589004-ACM-XX-XX-AB-TCP-012 P01

This drawing has been prepared for the use of AECOM's client. It may not be used, modified, reproduced or relied upon by third parties, except as agreed by AECOM or as required by law. AECOM accepts no responsibility, and denies any liability whatsoever, to any party that uses or relies on this drawing without AECOM's express written consent. Do not scale this document. All measurements must be obtained from the stated dimensions.

Author: GR Designer: JB Checked: TF Approved: AW

Last saved by: BREWERJ(2023-01-13) Last Plotted: 2023-01-13
Filename: C:\USERS\BREWERJ\ONEDRIVE - AECOM\DESKTOP\SUNNICA FARM\SS\SUNNICA ENERGY FARM - TPP_001 - OFFLINE COPY\SUNNICA ENERGY FARM - TCP_004.DWG

This drawing has been prepared for the use of AECOM's client. It may not be used, modified, reproduced or relied upon by third parties, except as agreed by AECOM or as required by law. AECOM accepts no responsibility, and denies any liability whatsoever, to any party that uses or relies on this drawing without AECOM's express written consent. Do not scale this document. All measurements must be obtained from the stated dimensions.

AECOM

PROJECT

SUNNICA ENERGY FARM

CLIENT

SUNNICA ENERGY FARM

CONSULTANT

AECOM
Plumer House, Third Floor,
East Wing, Tailyour Road
Plymouth, PL6 5DH
Tel +44(0)1752 676700
Fax +44(0)870 238 6023
www.aecom.com

GENERAL NOTES

1. TREE CATEGORIES AS DEFINED BY BS 5837:2012
2. TREE LOCATIONS ARE BASED ON THE TOPOGRAPHICAL SURVEY, AERIAL IMAGERY, AND GPS CO-ORDINATES FROM ON SITE WALKOVER.
3. * INDICATES A TREE / GROUP WHOSE POSITION IS APPROXIMATE AS BASED UPON AERIAL PHOTOGRAPHY AND ON SITE OBSERVATIONS.
4. PLANS SHOULD BE READ IN CONJUNCTION WITH THE AECOM ARBORICULTURAL REPORT.
5. THE ORIGINAL OF THIS DRAWING WAS PRODUCED IN COLOUR - A MONOCHROME COPY SHOULD NOT BE RELIED UPON.
6. DRAWING REFERNCES:
   TPO.dwg
   MERGED NTM DATA RevA Modified.dwg
   xref_OSMap.dwg
   20230105_Sunnica_WSP_RLB.dwg

KEY PLAN

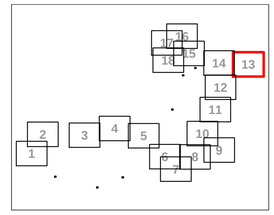

KEY

- ORDER LIMITS BOUNDARY
- LOCAL AUTHORITY BOUNDARY
- A CATEGORY TREE, GROUP, HEDGE, OR WOODLAND *(AS FOUND DURING DETAILED SURVEY, INDICATES HIGH QUALITY & VALUE)*
- B CATEGORY TREE, GROUP, HEDGE, OR WOODLAND *(AS FOUND DURING DETAILED SURVEY, INDICATES MODERATE QUALITY & VALUE)*
- C CATEGORY TREE, GROUP, HEDGE, OR WOODLAND *(AS FOUND DURING DETAILED SURVEY, INDICATES LOW QUALITY & VALUE)*
- U CATEGORY TREE, GROUP, HEDGE, OR WOODLAND *(AS FOUND DURING DETAILED SURVEY, UNSUITABLE FOR RETENTION)*
- ROOT PROTECTION AREAS (RPA) *(AS DEFINED BY BS 5837:2012 FOR TREES SUBJECT TO DETAILED SURVEY, ESTIMATED BUFFER ZONE SHOWN INDICATIVELY FOR OTHER TREES)*
- APPROXIMATE SHADING ARC *(AS DEFINED BY BS 5837:2012)*
- NTM CATEGORY TREE, GROUP, HEDGE, OR WOODLAND *(QUALITY CATEGORY ESTIMATED VIA WALKOVER AND/OR DESK STUDY: A, B, C, U, OR UNCATEGORIZED*
- VETERAN/ANCIENT TREE *(IDENTIFIED BY SURVEY)*
- VETERAN/ANCIENT TREE *(IDENTIFIED BY WALKOVER/DESK STUDY)*
- TREE PRESERVATION ORDER *(AREA COVERED BY A TREE PRESERVATION ORDER [TPO])*
- CONSERVATION AREA *(AREA COVERED BY A TREE PRESERVATION ORDER [TPO])*

ISSUE/REVISION

I/R	DATE	DESCRIPTION
P01	13/01/22	SECOND ISSUE
00	22/11/22	FIRST ISSUE

DRAWING STATUS

SUBMITTED AT DEADLINE 5

PROJECT NUMBER

60589004

SHEET TITLE

TREE CONSTRAINTS PLAN (SHEET 13)

SHEET NUMBER **REV.**

60589004-ACM-XX-XX-AB-TCP-013 P01

Author: GR Designer: JB Checked: TF Approved: AW

Last saved by: BREWERJ (2023-01-13) Last Plotted: 2023-01-13
Filename: C:\USERS\BREWERJ\ONEDRIVE - AECOM\DESKTOP\SUNNICA FARM\SS\SUNNICA ENERGY FARN - TPP_001 - OFFLINE COPY\SUNNICA ENERGY FARN - TCP_004.DWG

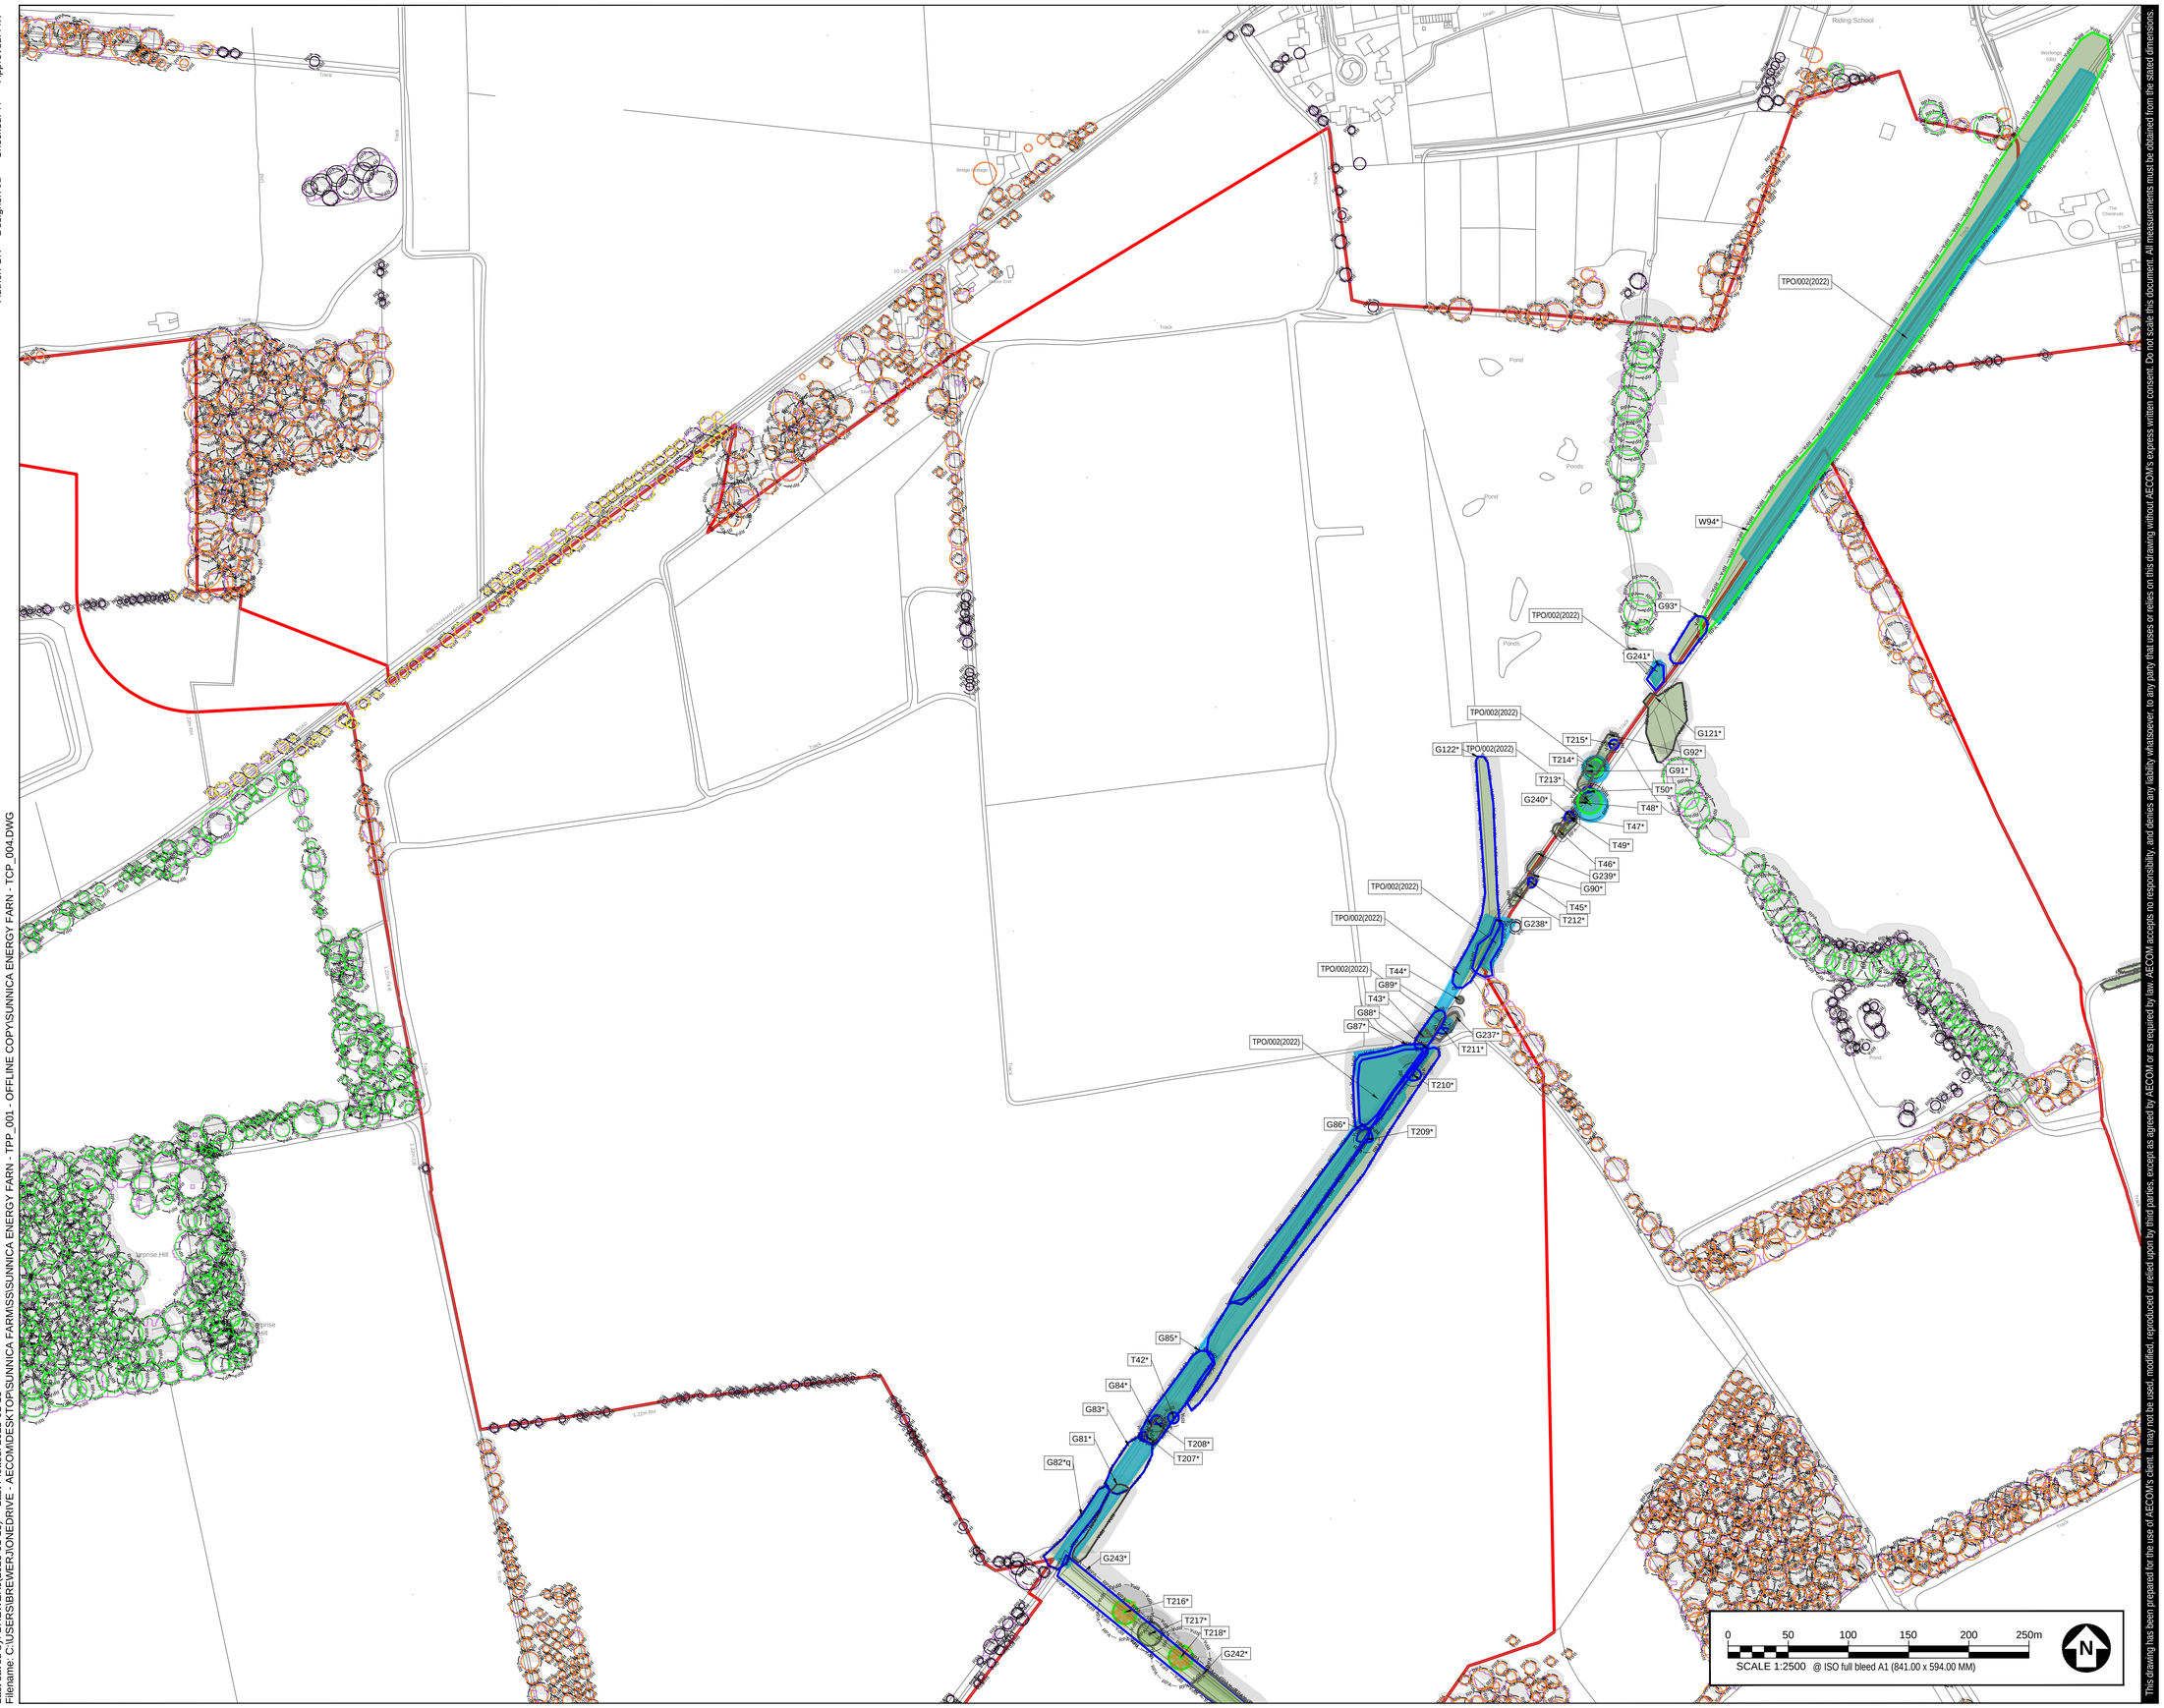

This drawing has been prepared for the use of AECOM's client. It may not be used, modified, reproduced or relied upon by third parties, except as agreed by AECOM or as required by law. AECOM accepts no responsibility, and denies any liability whatsoever, to any party that uses or relies on this drawing without AECOM's express written consent. Do not scale this document. All measurements must be obtained from the stated dimensions.

AECOM

PROJECT
SUNNICA ENERGY FARM

CLIENT
SUNNICA ENERGY FARM

CONSULTANT
AECOM
Plumer House, Third Floor,
East Wing, Tailyour Road
Plymouth, PL6 5DH
Tel +44(0)1752 676700
Fax +44(0)870 238 6023
www.aecom.com

GENERAL NOTES
1. TREE CATEGORIES AS DEFINED BY BS 5837:2012
2. TREE LOCATIONS ARE BASED ON THE TOPOGRAPHICAL SURVEY, AERIAL IMAGERY, AND GPS CO-ORDINATES FROM ON SITE WALKOVER.
3. * INDICATES A TREE / GROUP WHOSE POSITION IS APPROXIMATE AS BASED UPON AERIAL PHOTOGRAPHY AND ON SITE OBSERVATIONS.
4. PLANS SHOULD BE READ IN CONJUNCTION WITH THE AECOM ARBORICULTURAL REPORT.
5. THE ORIGINAL OF THIS DRAWING WAS PRODUCED IN COLOUR - A MONOCHROME COPY SHOULD NOT BE RELIED UPON.
6. DRAWING REFERNCES:
   TPO.dwg
   MERGED NTM DATA RevA Modified.dwg
   xref_OSMap.dwg
   20230105_Sunnica_WSP_RLB.dwg

KEY PLAN
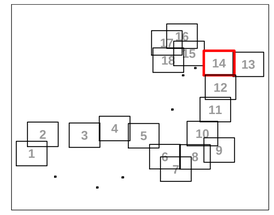

KEY
- **ORDER LIMITS BOUNDARY**
- **LOCAL AUTHORITY BOUNDARY**
- **A CATEGORY TREE, GROUP, HEDGE, OR WOODLAND** *(AS FOUND DURING DETAILED SURVEY, INDICATES HIGH QUALITY & VALUE)*
- **B CATEGORY TREE, GROUP, HEDGE, OR WOODLAND** *(AS FOUND DURING DETAILED SURVEY, INDICATES MODERATE QUALITY & VALUE)*
- **C CATEGORY TREE, GROUP, HEDGE, OR WOODLAND** *(AS FOUND DURING DETAILED SURVEY, INDICATES LOW QUALITY & VALUE)*
- **U CATEGORY TREE, GROUP, HEDGE, OR WOODLAND** *(AS FOUND DURING DETAILED SURVEY, UNSUITABLE FOR RETENTION)*
- **ROOT PROTECTION AREAS (RPA)** *(AS DEFINED BY BS 5837:2012 FOR TREES SUBJECT TO DETAILED SURVEY, ESTIMATED BUFFER ZONE SHOWN INDICATIVELY FOR OTHER TREES)*
- **APPROXIMATE SHADING ARC** *(AS DEFINED BY BS 5837:2012)*
- **NTM CATEGORY TREE, GROUP, HEDGE, OR WOODLAND** *(QUALITY CATEGORY ESTIMATED VIA WALKOVER AND/OR DESK STUDY: A, B, C, U, OR UNCATEGORIZED*
- **VETERAN/ANCIENT TREE** *(IDENTIFIED BY SURVEY)*
- **VETERAN/ANCIENT TREE** *(IDENTIFIED BY WALKOVER/DESK STUDY)*
- **TREE PRESERVATION ORDER** *(AREA COVERED BY A TREE PRESERVATION ORDER [TPO])*
- **CONSERVATION AREA** *(AREA COVERED BY A TREE PRESERVATION ORDER [TPO])*

ISSUE/REVISION

I/R	DATE	DESCRIPTION
P01	13/01/22	SECOND ISSUE
00	22/11/22	FIRST ISSUE

DRAWING STATUS
SUBMITTED AT DEADLINE 5

PROJECT NUMBER
60589004

SHEET TITLE
TREE CONSTRAINTS PLAN (SHEET 14)

SHEET NUMBER / REV.
60589004-ACM-XX-XX-AB-TCP-014 P01

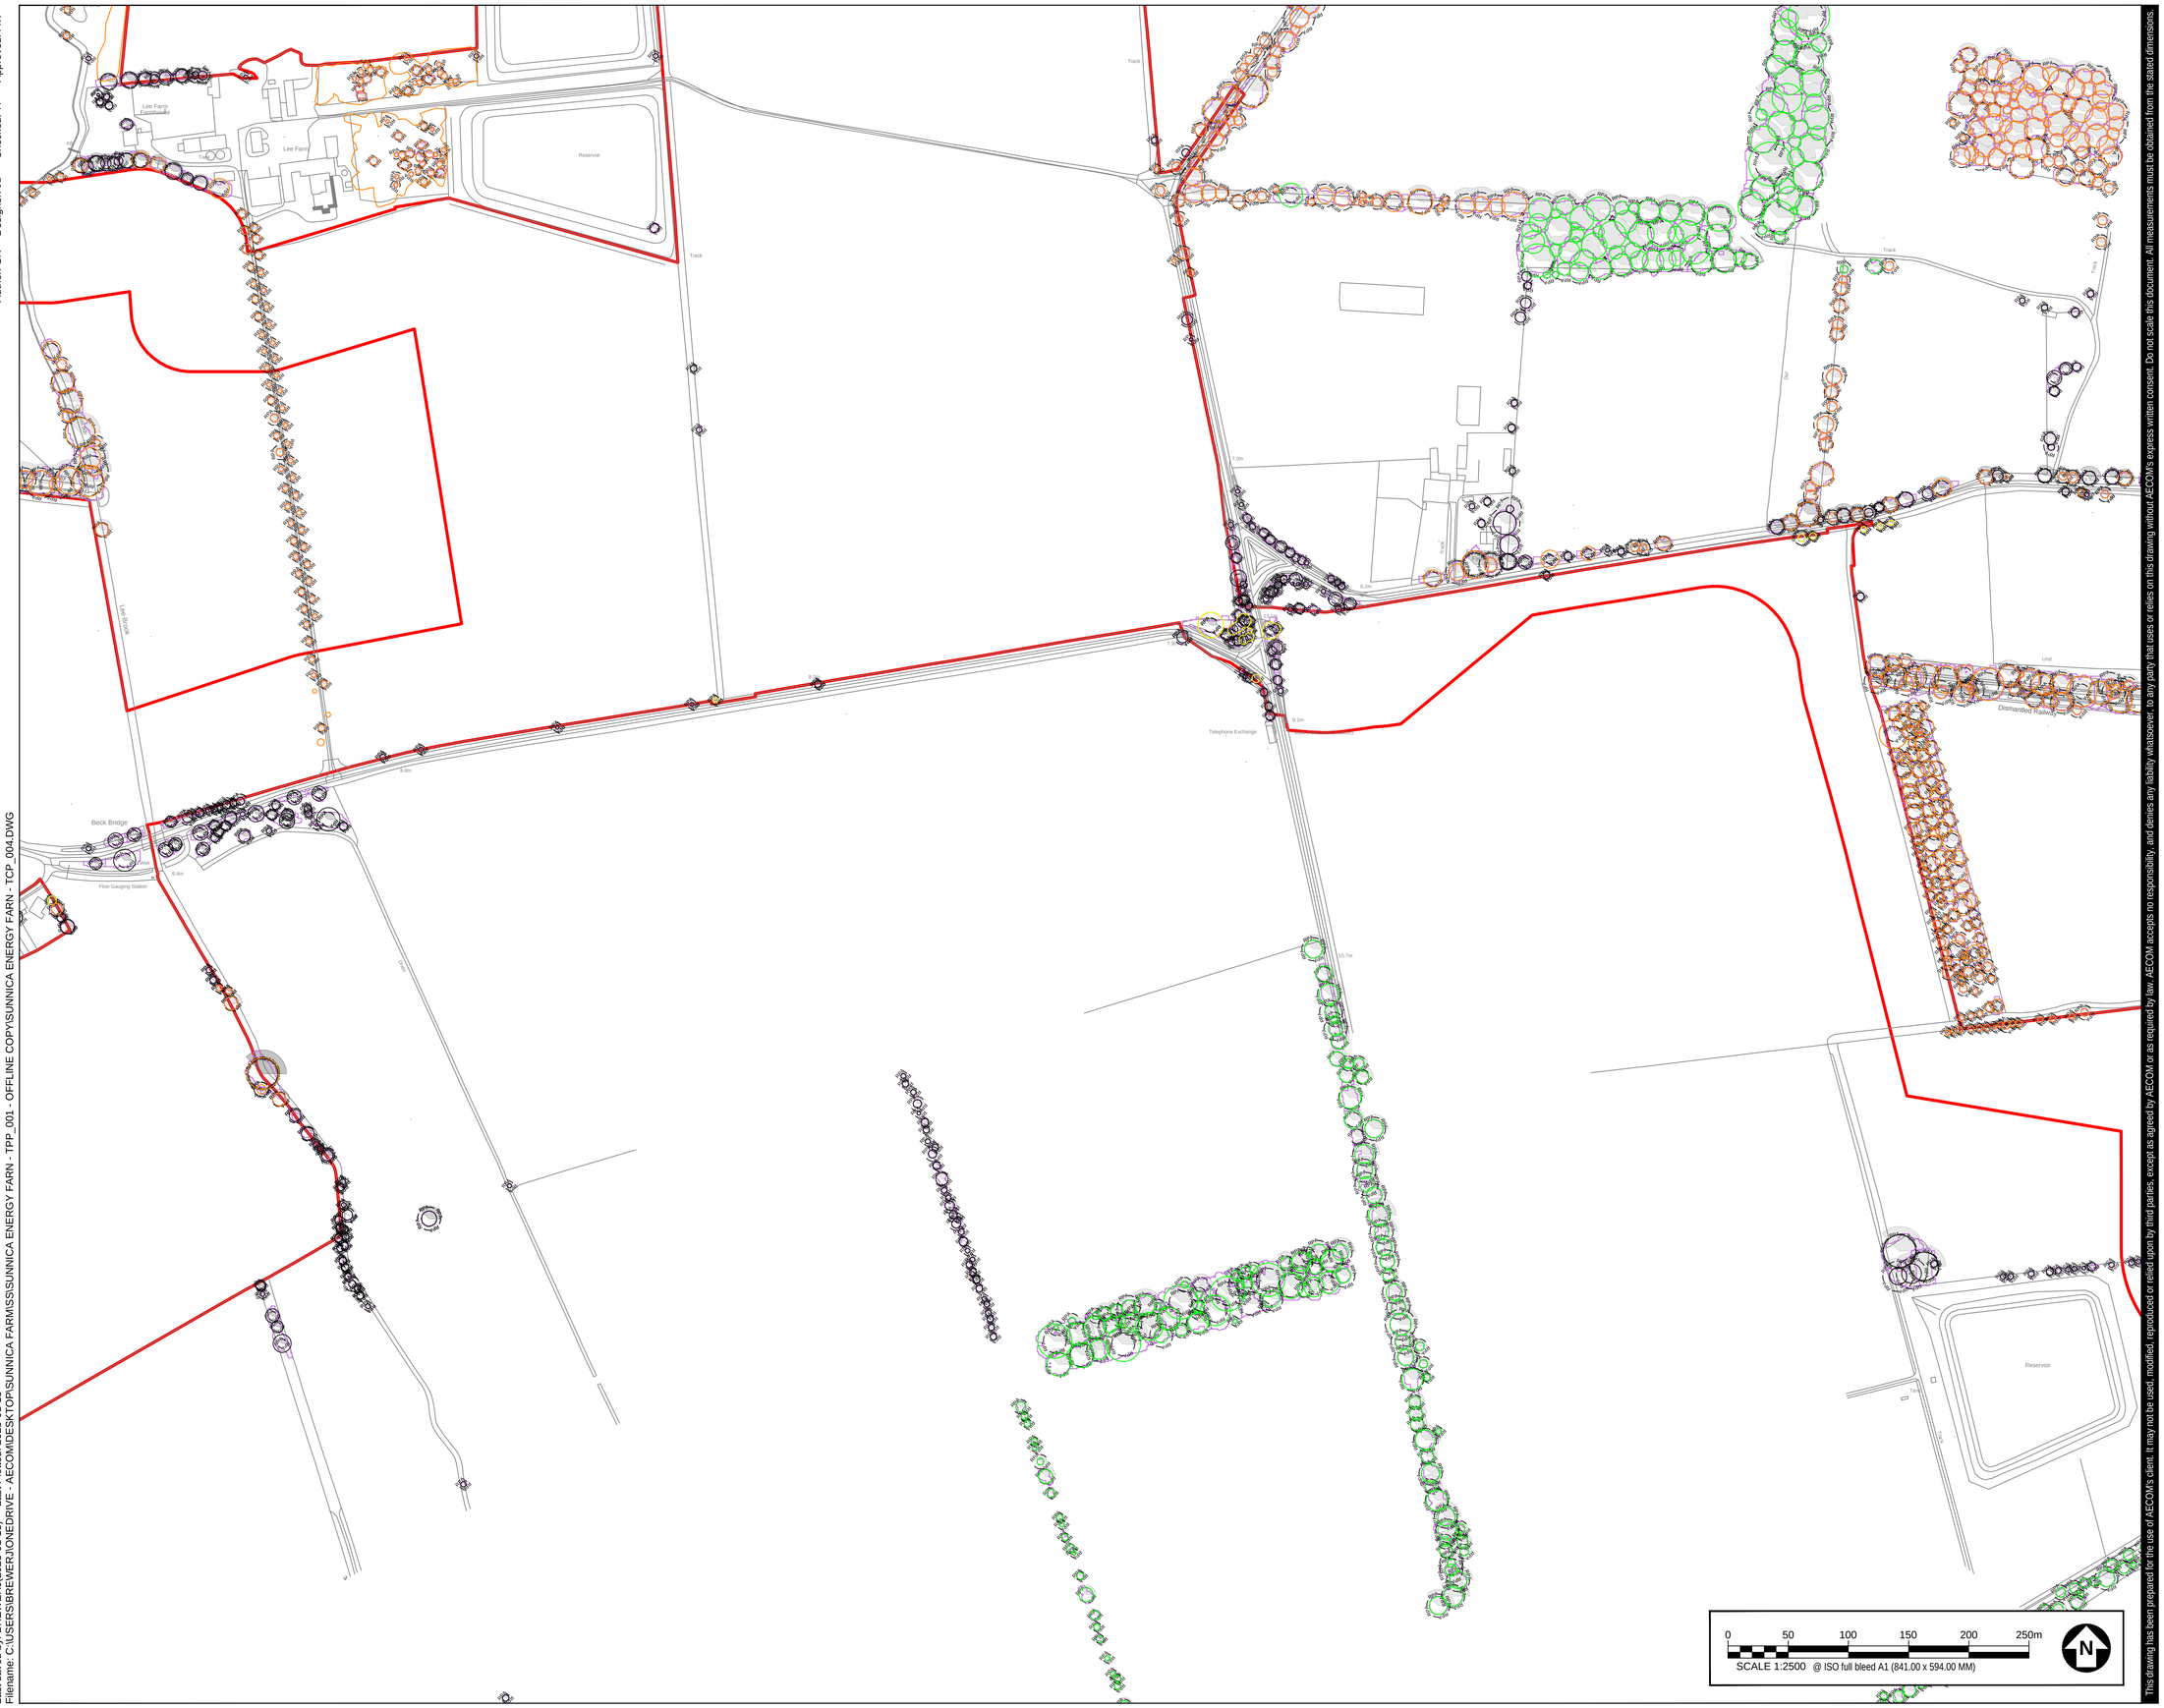

Author: GR Designer: JB Checked: TF Approved: AW

Last saved by: BREWERJ(2023-01-13) Last Plotted: 2023-01-13
Filename: C:\USERS\BREWERJ\ONEDRIVE - AECOM\DESKTOP\SUNNICA FARM\SS\SUNNICA ENERGY FARN - TPP_001 - OFFLINE COPY\SUNNICA ENERGY FARN - TCP_004.DWG

This drawing has been prepared for the use of AECOM's client. It may not be used, modified, reproduced or relied upon by third parties, except as agreed by AECOM or as required by law. AECOM accepts no responsibility, and denies any liability whatsoever, to any party that uses or relies on this drawing without AECOM's express written consent. Do not scale this document. All measurements must be obtained from the stated dimensions.

AECOM

PROJECT

SUNNICA ENERGY FARM

CLIENT

SUNNICA ENERGY FARM

CONSULTANT

AECOM
Plumer House, Third Floor,
East Wing, Tailyour Road
Plymouth, PL6 5DH
Tel +44(0)1752 676700
Fax +44(0)870 238 6023
www.aecom.com

GENERAL NOTES

1. TREE CATEGORIES AS DEFINED BY BS 5837:2012
2. TREE LOCATIONS ARE BASED ON THE TOPOGRAPHICAL SURVEY, AERIAL IMAGERY, AND GPS CO-ORDINATES FROM ON SITE WALKOVER.
3. * INDICATES A TREE / GROUP WHOSE POSITION IS APPROXIMATE AS BASED UPON AERIAL PHOTOGRAPHY AND ON SITE OBSERVATIONS.
4. PLANS SHOULD BE READ IN CONJUNCTION WITH THE AECOM ARBORICULTURAL REPORT.
5. THE ORIGINAL OF THIS DRAWING WAS PRODUCED IN COLOUR - A MONOCHROME COPY SHOULD NOT BE RELIED UPON.
6. DRAWING REFERNCES:
   TPO.dwg
   MERGED NTM DATA RevA Modified.dwg
   xref_OSMap.dwg
   20230105_Sunnica_WSP_RLB.dwg

KEY PLAN

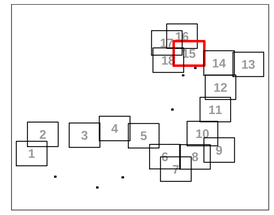

KEY

- **ORDER LIMITS BOUNDARY**
- **LOCAL AUTHORITY BOUNDARY**
- **A CATEGORY TREE, GROUP, HEDGE, OR WOODLAND** *(AS FOUND DURING DETAILED SURVEY, INDICATES HIGH QUALITY & VALUE)*
- **B CATEGORY TREE, GROUP, HEDGE, OR WOODLAND** *(AS FOUND DURING DETAILED SURVEY, INDICATES MODERATE QUALITY & VALUE)*
- **C CATEGORY TREE, GROUP, HEDGE, OR WOODLAND** *(AS FOUND DURING DETAILED SURVEY, INDICATES LOW QUALITY & VALUE)*
- **U CATEGORY TREE, GROUP, HEDGE, OR WOODLAND** *(AS FOUND DURING DETAILED SURVEY, UNSUITABLE FOR RETENTION)*
- **ROOT PROTECTION AREAS (RPA)** *(AS DEFINED BY BS 5837:2012 FOR TREES SUBJECT TO DETAILED SURVEY. ESTIMATED BUFFER ZONE SHOWN INDICATIVELY FOR OTHER TREES)*
- **APPROXIMATE SHADING ARC** *(AS DEFINED BY BS 5837:2012)*
- **NTM CATEGORY TREE, GROUP, HEDGE, OR WOODLAND** *(QUALITY CATEGORY ESTIMATED VIA WALKOVER AND/OR DESK STUDY: A, B, C, U, OR UNCATEGORIZED*
- **VETERAN/ANCIENT TREE** *(IDENTIFIED BY SURVEY)*
- **VETERAN/ANCIENT TREE** *(IDENTIFIED BY WALKOVER/DESK STUDY)*
- **TREE PRESERVATION ORDER** *(AREA COVERED BY A TREE PRESERVATION ORDER [TPO])*
- **CONSERVATION AREA** *(AREA COVERED BY A TREE PRESERVATION ORDER [TPO])*

ISSUE/REVISION

I/R	DATE	DESCRIPTION
P01	13/01/22	SECOND ISSUE
00	22/11/22	FIRST ISSUE

DRAWING STATUS

SUBMITTED AT DEADLINE 5

PROJECT NUMBER

60589004

SHEET TITLE

TREE CONSTRAINTS PLAN (SHEET 15)

SHEET NUMBER / REV.

60589004-ACM-XX-XX-AB-TCP-015 P01

Author: GR Designer: JB Checked: TF Approved: AW

Last saved by: BREWERJ(2023-01-13) Last Plotted: 2023-01-13
Filename: C:\USERS\BREWERJ\ONEDRIVE - AECOM\DESKTOP\SUNNICA FARMS\SUNNICA ENERGY FARN - TPP_001 - OFFLINE COPY\SUNNICA ENERGY FARN - TCP_004.DWG

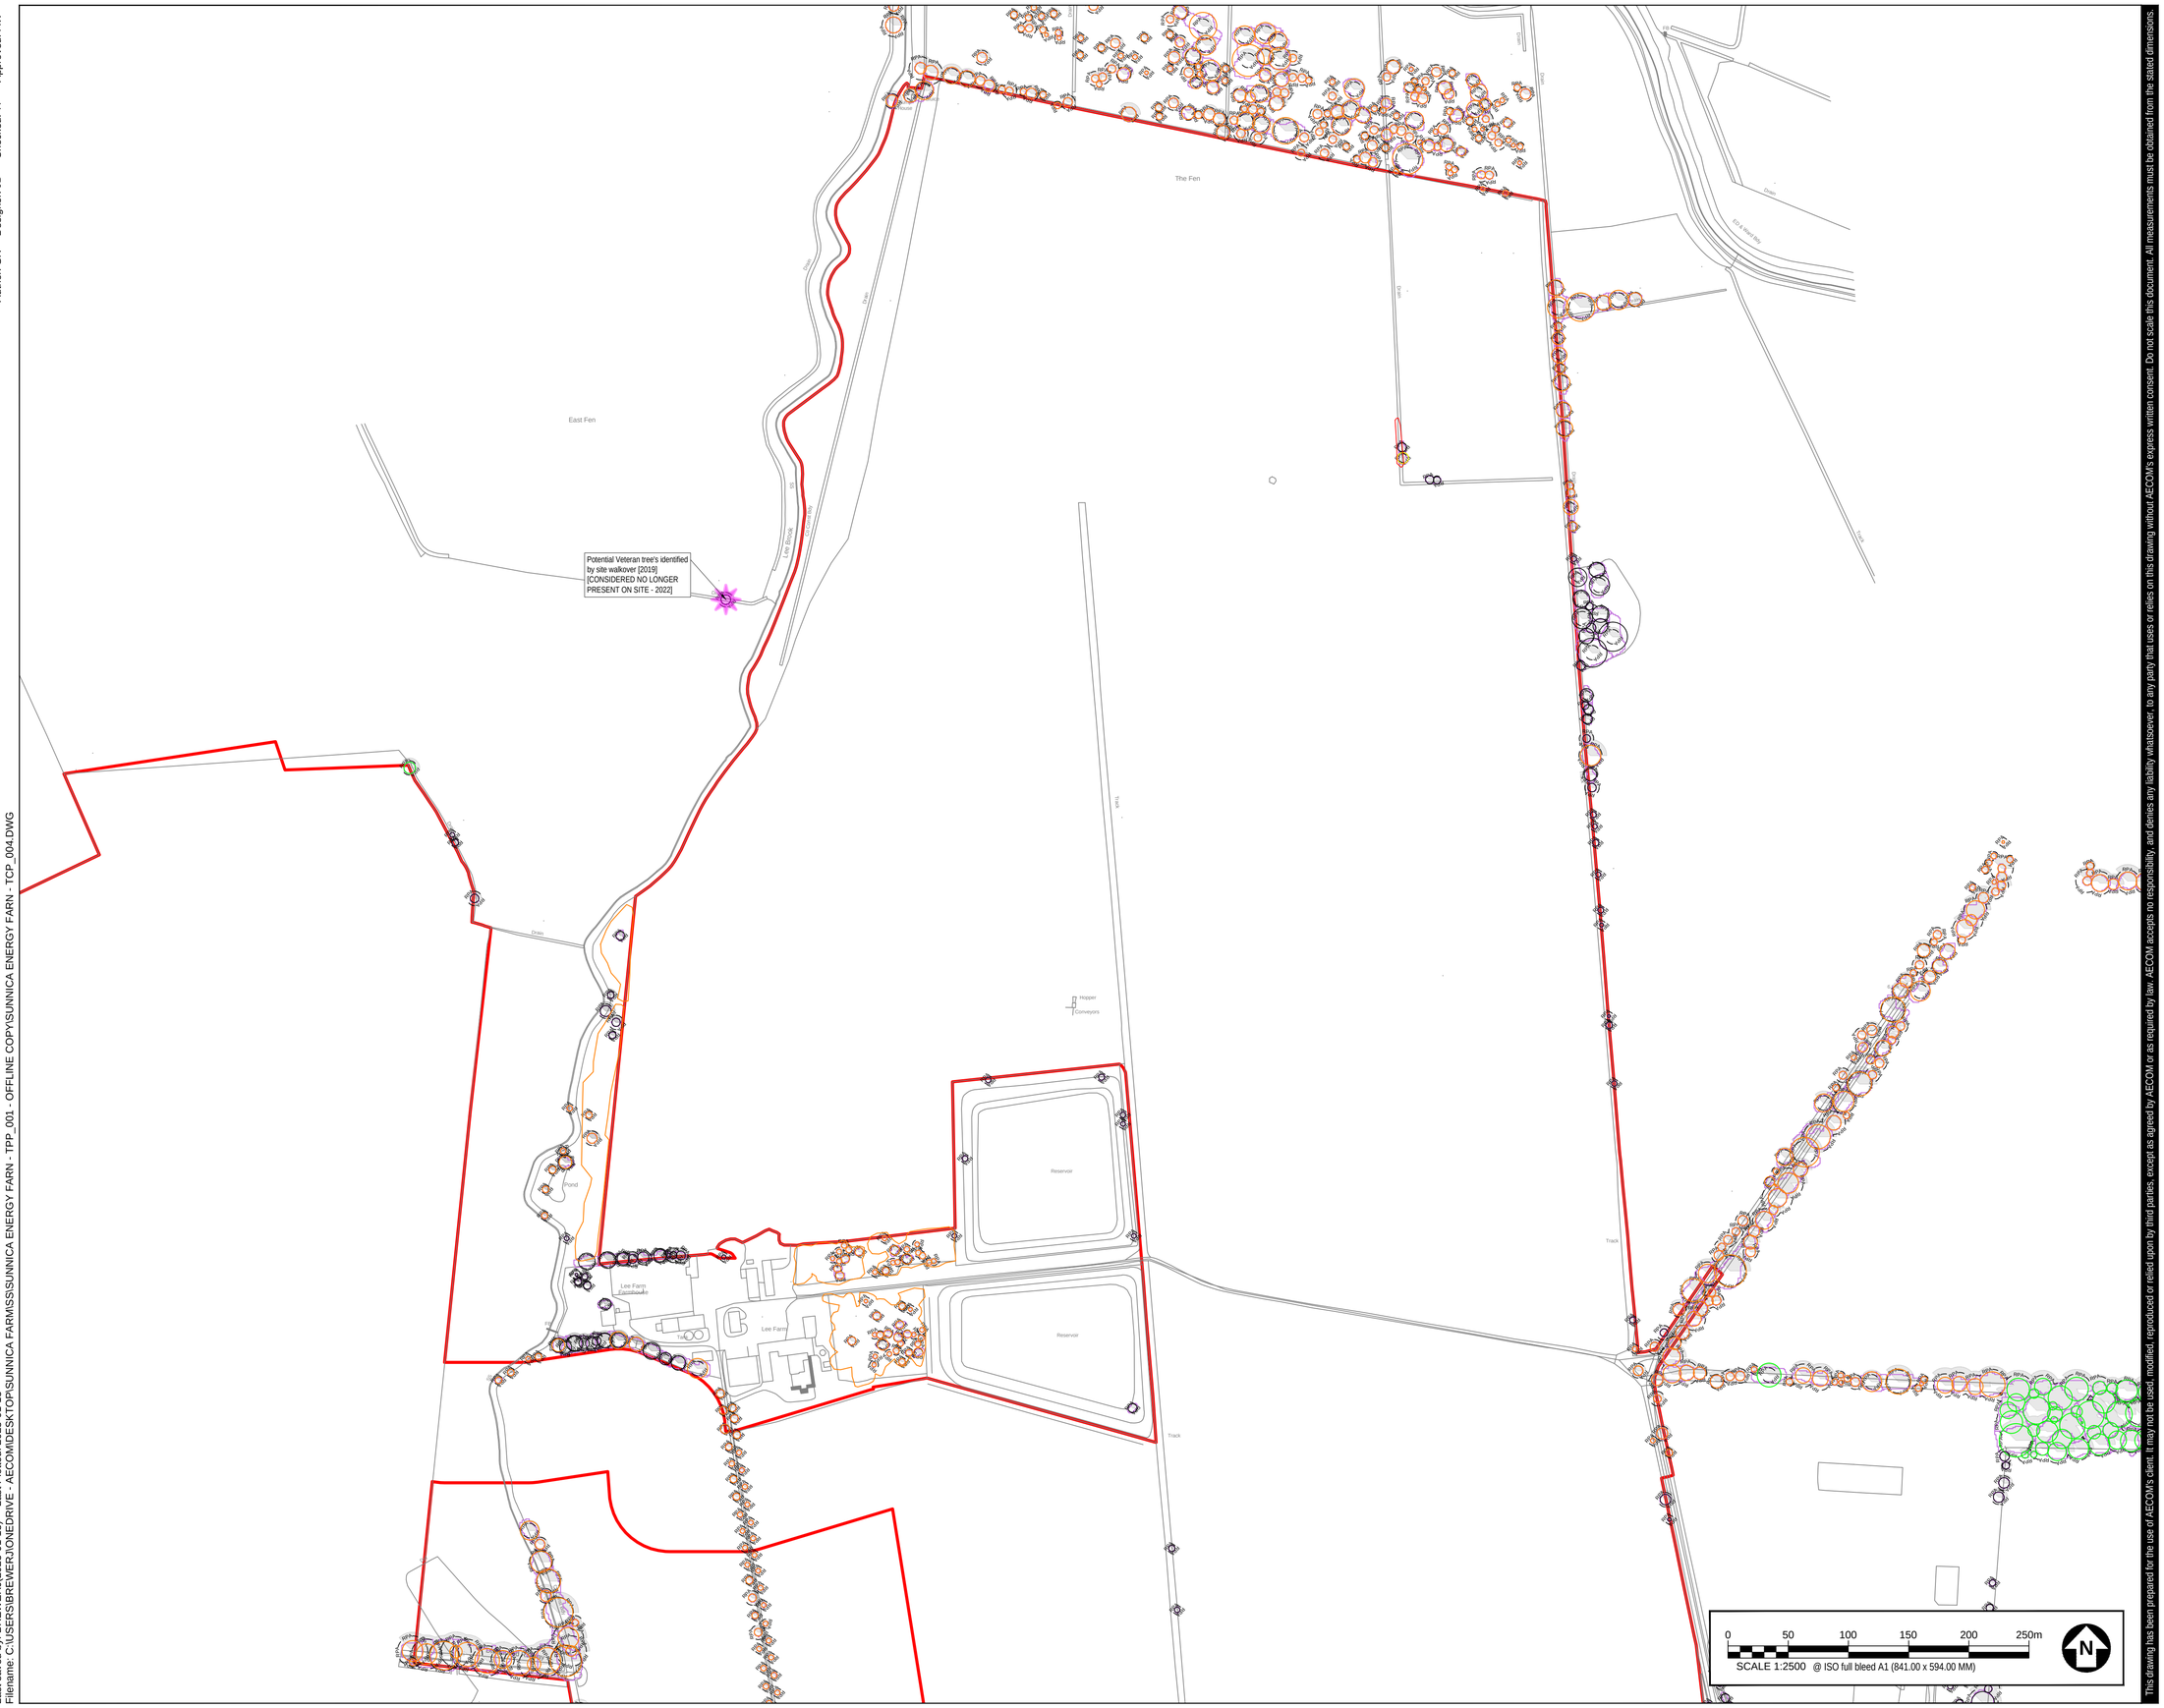
Potential Veteran tree's identified by site walkover [2019] [CONSIDERED NO LONGER PRESENT ON SITE - 2022]
The Fen
East Fen
Lee Brook
Lee Farm
Lee Farm Farmhouse
Reservoir
Reservoir
Track
Track
Track
Track
Pond
Hopper
Conveyors
Drain
Drain
Drain

Author: GR Designer: JB Checked: TF Approved: AW

Last saved by: BREWERJ(2023-01-13) Last Plotted: 2023-01-13
Filename: C:\USERS\BREWERJ\ONEDRIVE - AECOM\DESKTOP\SUNNICA FARM\SS\SUNNICA ENERGY FARN - TPP_001 - OFFLINE COPY\SUNNICA ENERGY FARN - TCP_004.DWG

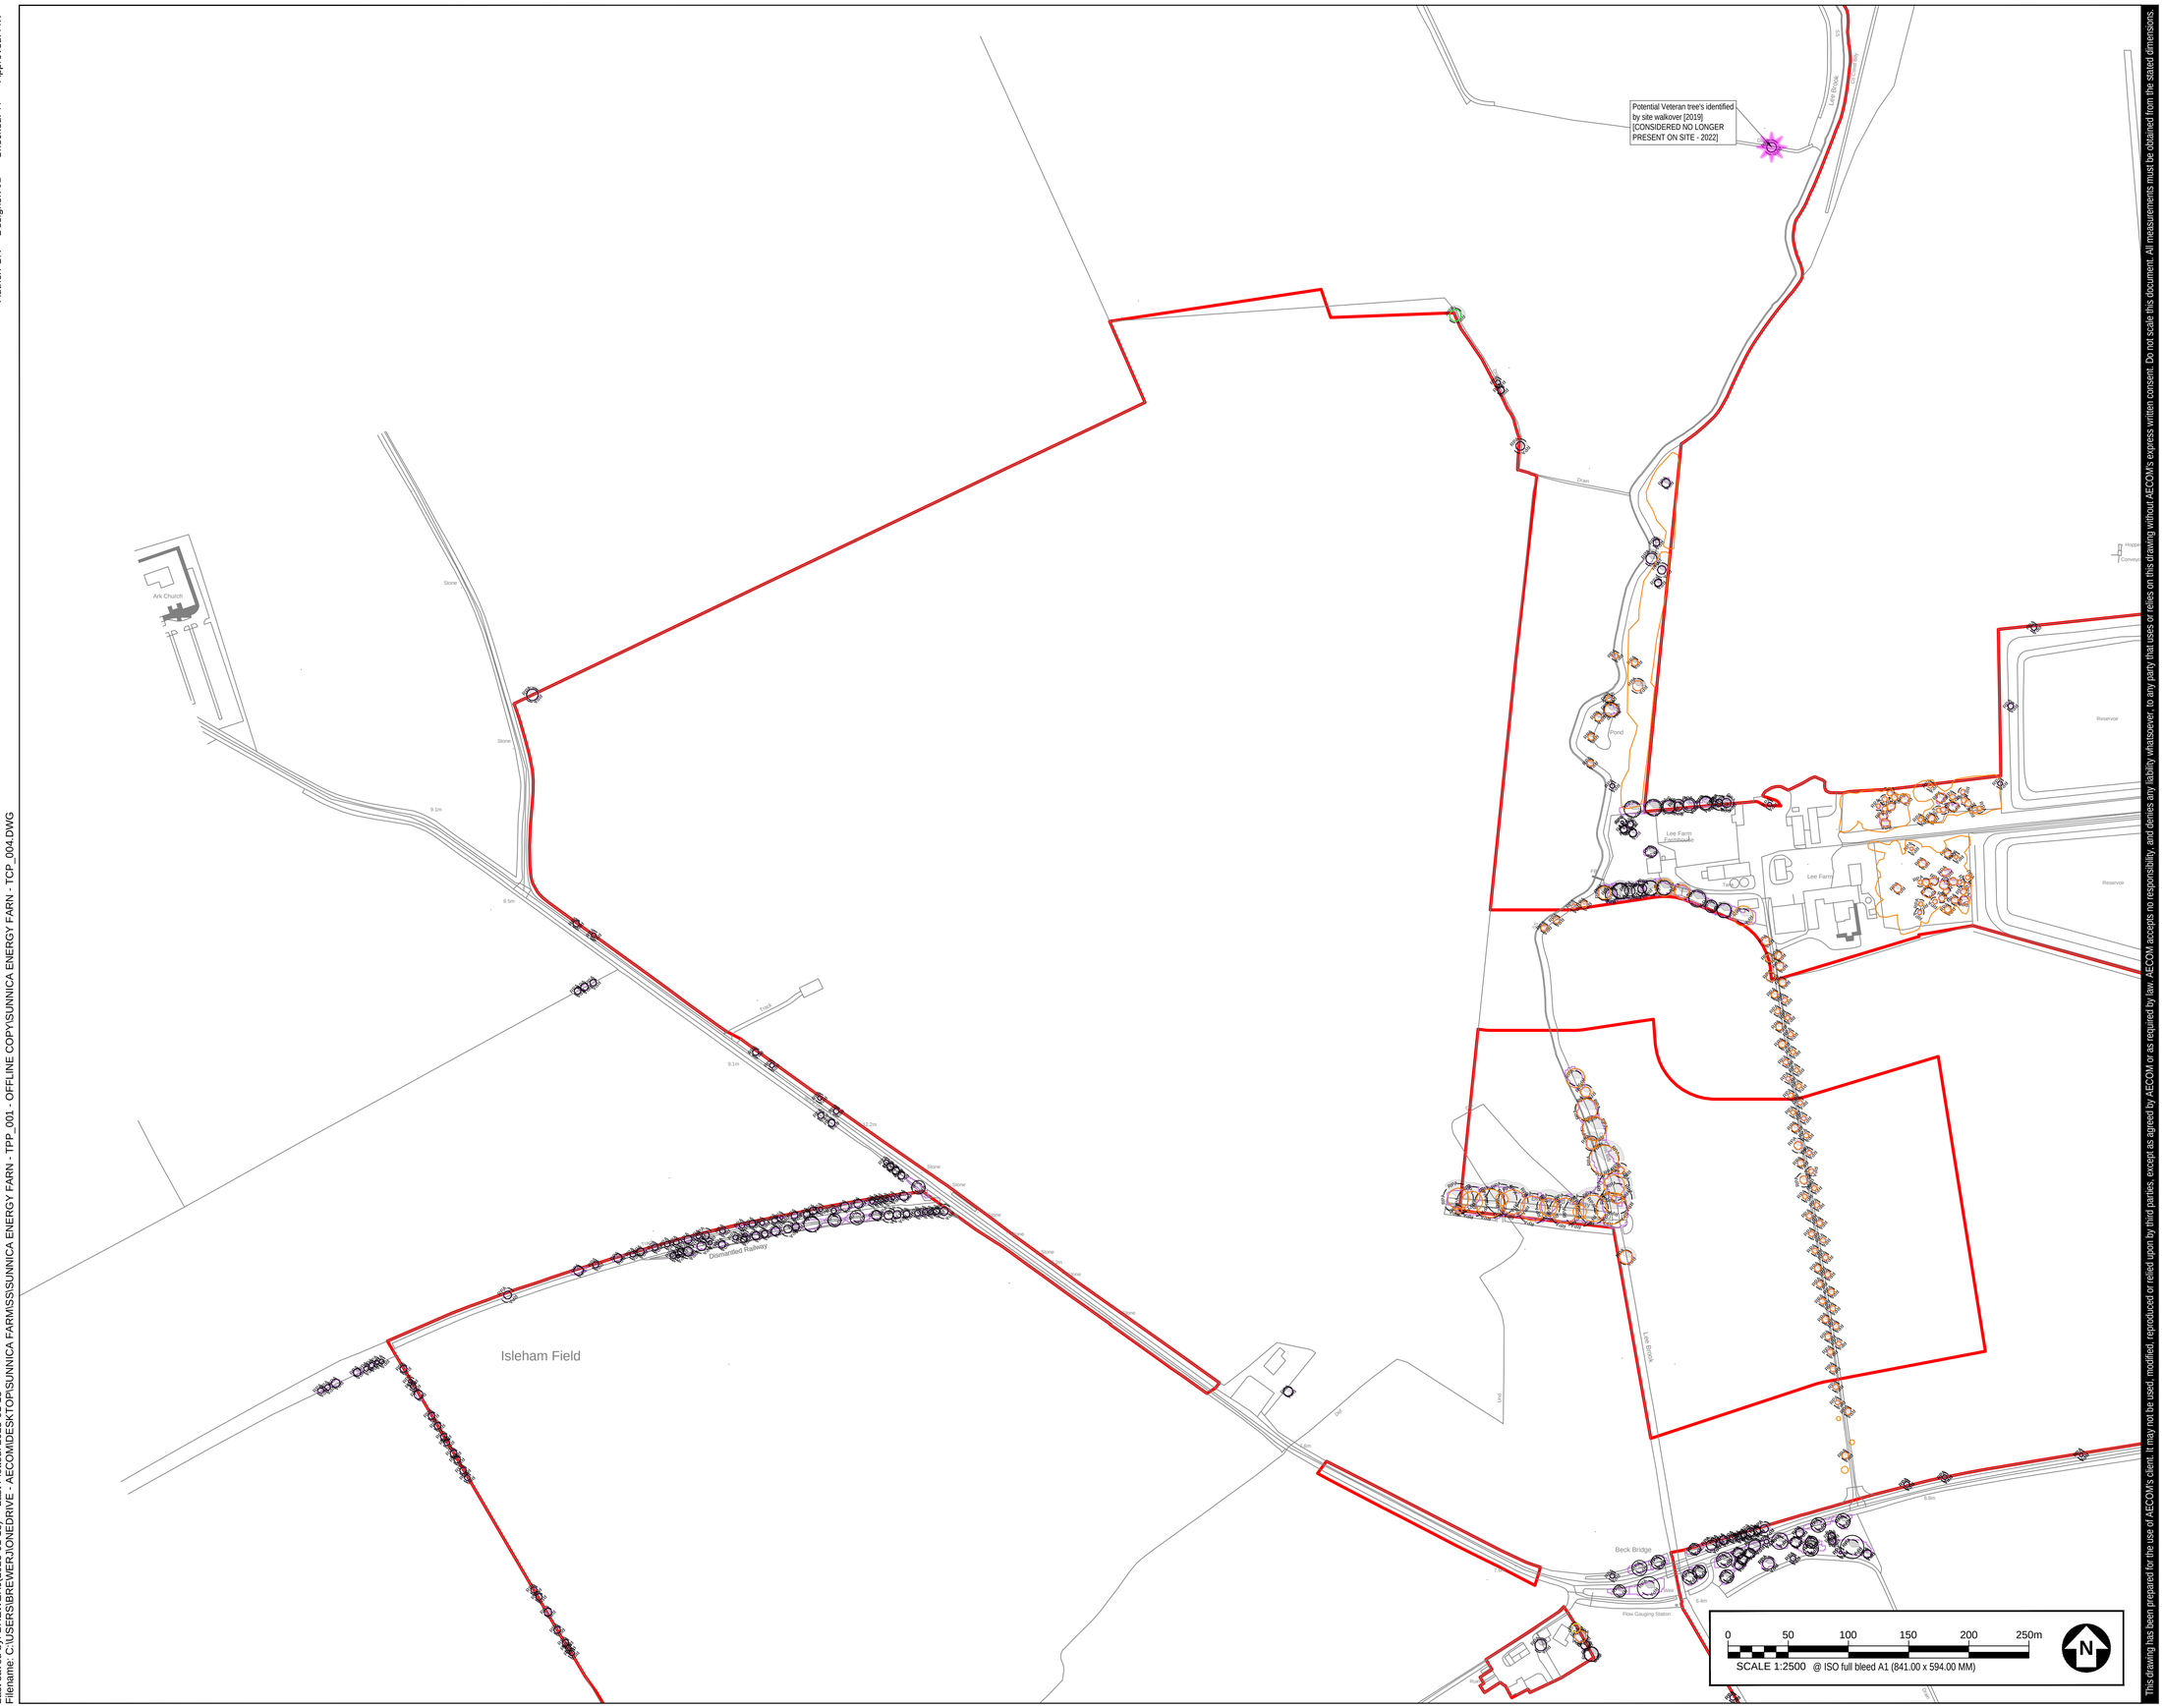
Potential Veteran tree's identified by site walkover [2019] [CONSIDERED NO LONGER PRESENT ON SITE - 2022]
Ark Ditch
Ark Ditch
Ark Church
Store
Store
9.1m
8.9m
T105
9.1m
2.2m
Store
Store
Store

Author: GR Designer: JB Checked: TF Approved: AW

Last saved by: BREWERJ (2023-01-13) Last Plotted: 2023-01-13
Filename: C:\USERS\BREWERJ\ONEDRIVE - AECOM\DESKTOP\SUNNICA FARM\SS\SUNNICA ENERGY FARN - TPP_001 - OFFLINE COPY\SUNNICA ENERGY FARN - TCP_004.DWG

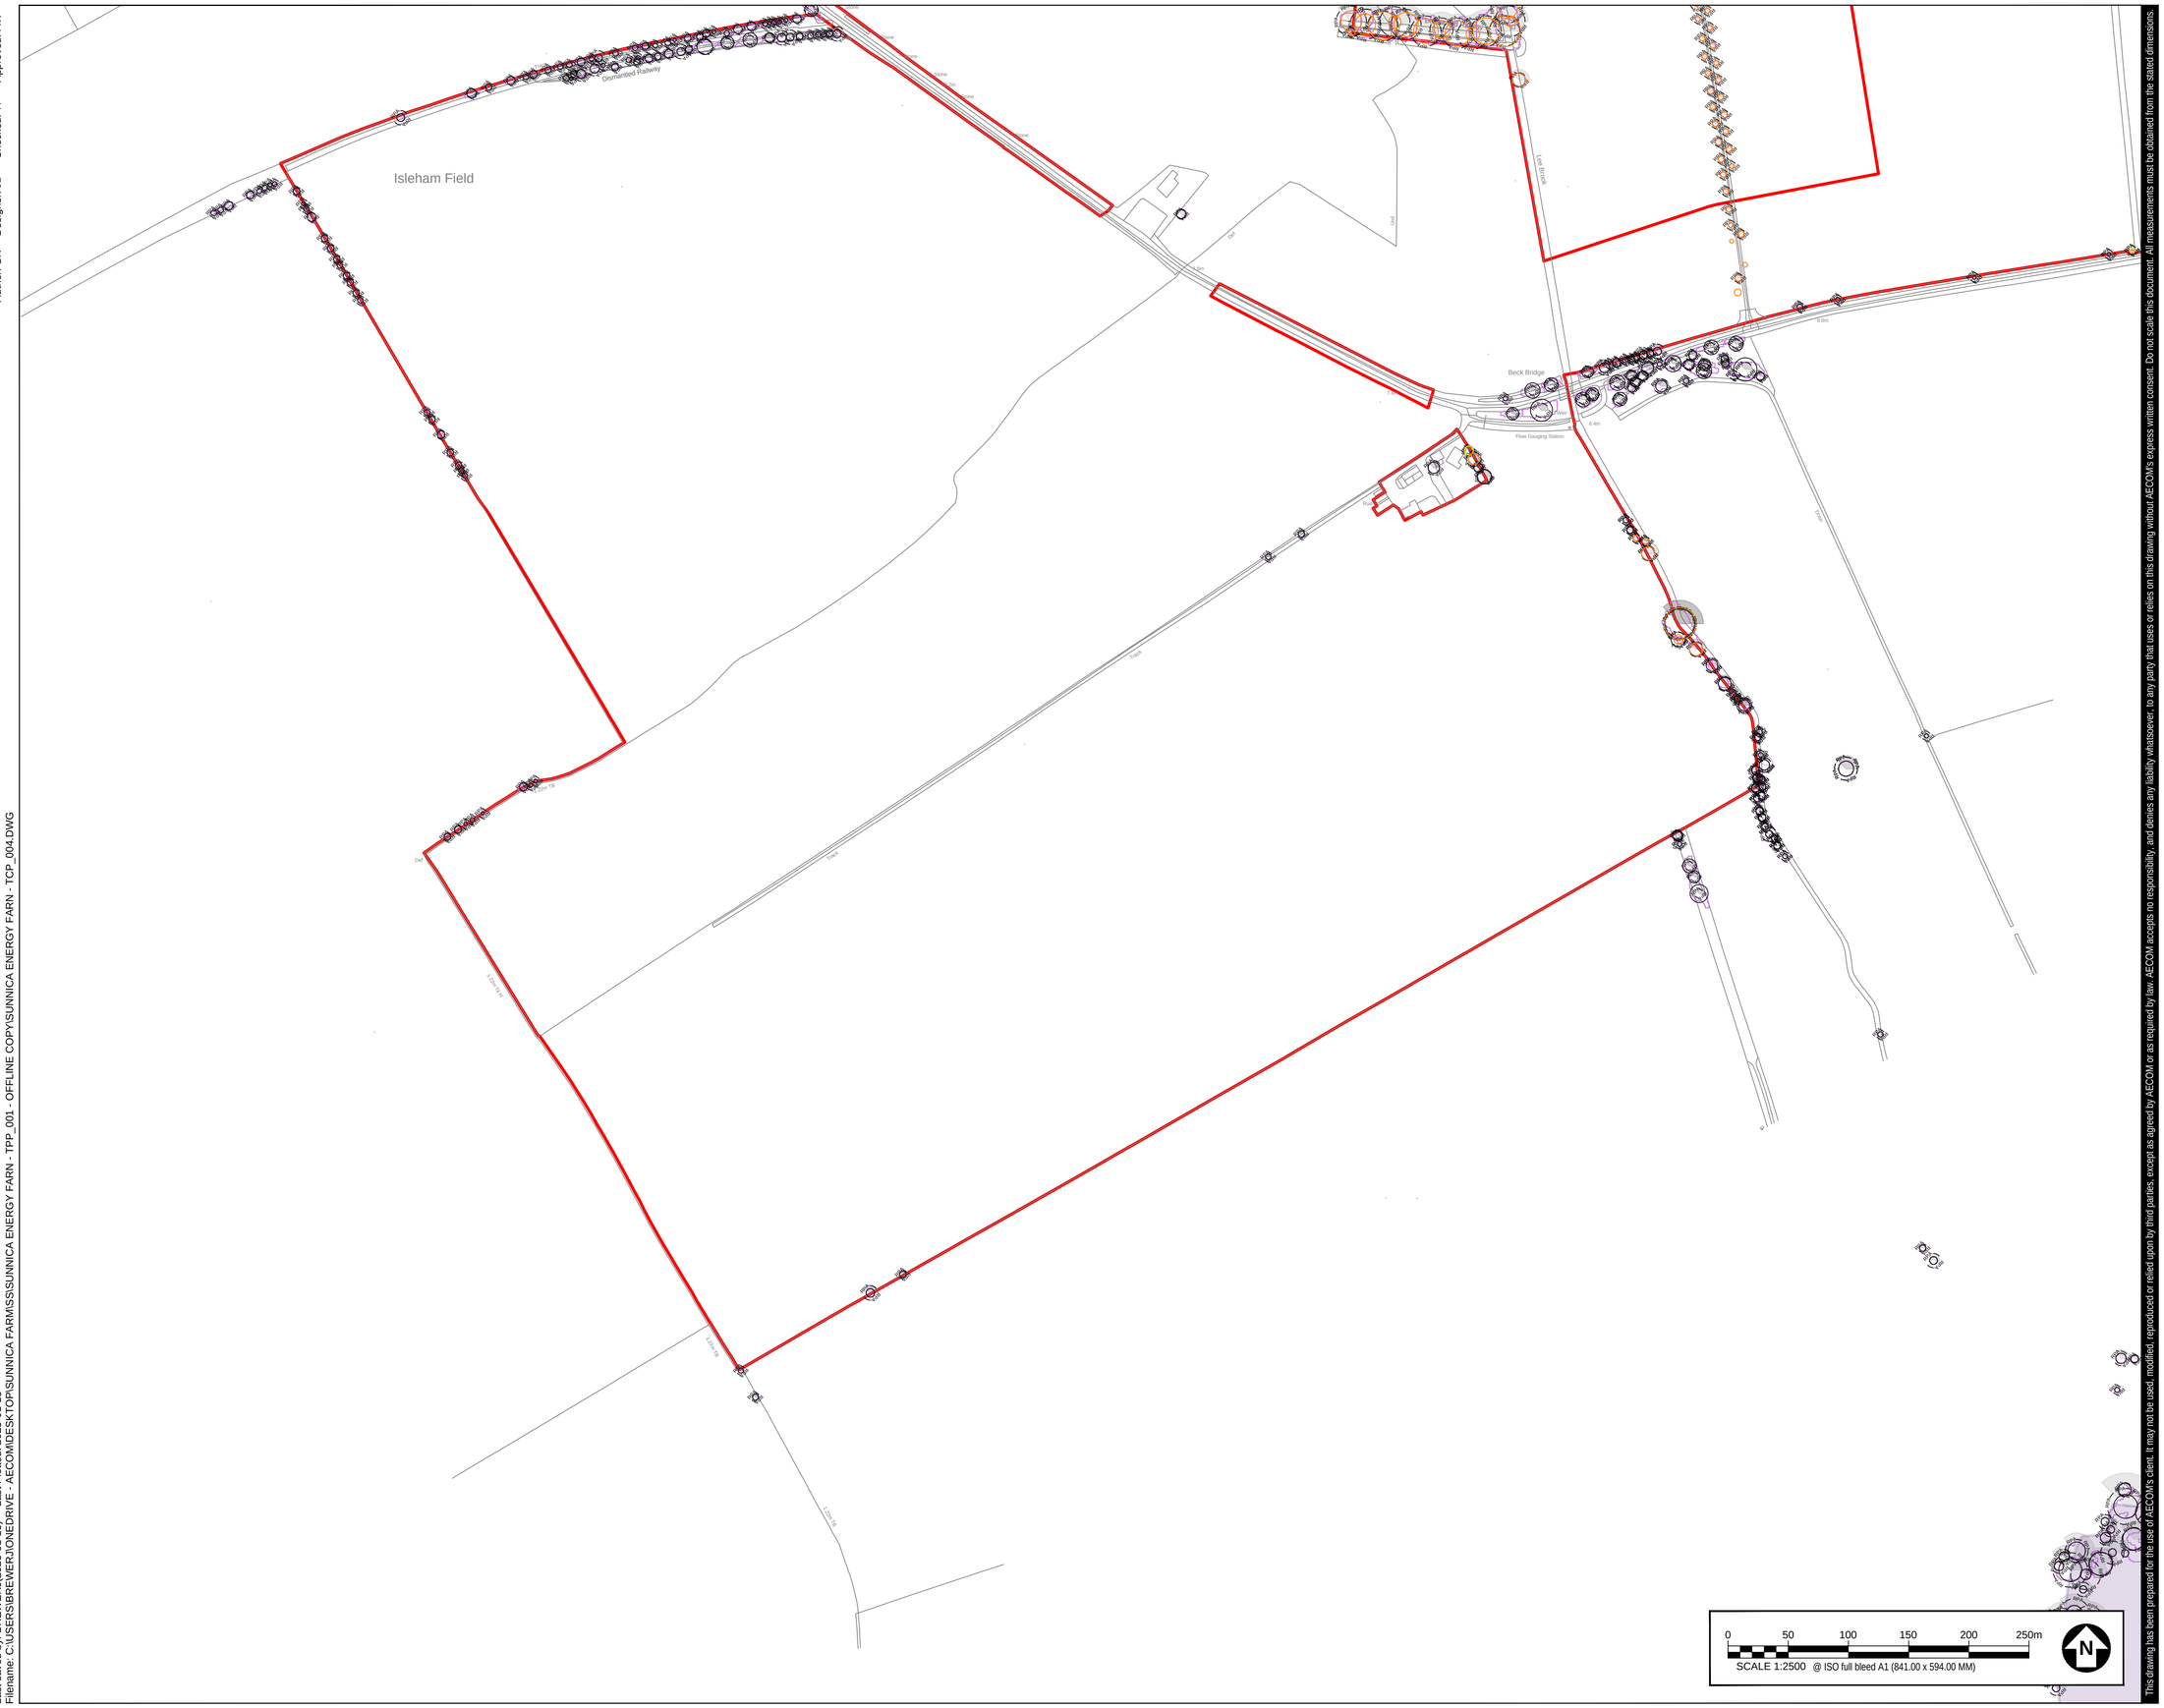

0 50 100 150 200 250m

SCALE 1:2500 @ ISO full bleed A1 (841.00 x 594.00 MM)

N

This drawing has been prepared for the use of AECOM's client. It may not be used, modified, reproduced or relied upon by third parties, except as agreed by AECOM or as required by law. AECOM accepts no responsibility, and denies any liability whatsoever, to any party that uses or relies on this drawing without AECOM's express written consent. Do not scale this document. All measurements must be obtained from the stated dimensions.

AECOM

PROJECT

SUNNICA ENERGY FARM

CLIENT

SUNNICA ENERGY FARM

CONSULTANT

AECOM
Plumer House, Third Floor,
East Wing, Tailyour Road
Plymouth, PL6 5DH
Tel +44(0)1752 676700
Fax +44(0)870 238 6023
www.aecom.com

GENERAL NOTES

1. TREE CATEGORIES AS DEFINED BY BS 5837:2012
2. TREE LOCATIONS ARE BASED ON THE TOPOGRAPHICAL SURVEY, AERIAL IMAGERY, AND GPS CO-ORDINATES FROM ON SITE WALKOVER.
3. * INDICATES A TREE / GROUP WHOSE POSITION IS APPROXIMATE AS BASED UPON AERIAL PHOTOGRAPHY AND ON SITE OBSERVATIONS.
4. PLANS SHOULD BE READ IN CONJUNCTION WITH THE AECOM ARBORICULTURAL REPORT.
5. THE ORIGINAL OF THIS DRAWING WAS PRODUCED IN COLOUR - A MONOCHROME COPY SHOULD NOT BE RELIED UPON.
6. DRAWING REFERNCES:
   TPO.dwg
   MERGED NTM DATA RevA Modified.dwg
   xref_OSMap.dwg
   20230105_Sunnica_WSP_RLB.dwg

KEY PLAN

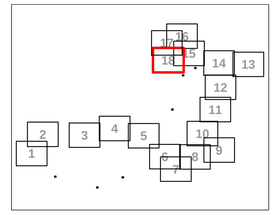

KEY

- **ORDER LIMITS BOUNDARY**
- **LOCAL AUTHORITY BOUNDARY**
- **A CATEGORY TREE, GROUP, HEDGE, OR WOODLAND** *(AS FOUND DURING DETAILED SURVEY, INDICATES HIGH QUALITY & VALUE)*
- **B CATEGORY TREE, GROUP, HEDGE, OR WOODLAND** *(AS FOUND DURING DETAILED SURVEY, INDICATES MODERATE QUALITY & VALUE)*
- **C CATEGORY TREE, GROUP, HEDGE, OR WOODLAND** *(AS FOUND DURING DETAILED SURVEY, INDICATES LOW QUALITY & VALUE)*
- **U CATEGORY TREE, GROUP, HEDGE, OR WOODLAND** *(AS FOUND DURING DETAILED SURVEY, UNSUITABLE FOR RETENTION)*
- **ROOT PROTECTION AREAS (RPA)** *(AS DEFINED BY BS 5837:2012 FOR TREES SUBJECT TO DETAILED SURVEY. ESTIMATED BUFFER ZONE SHOWN INDICATIVELY FOR OTHER TREES)*
- **APPROXIMATE SHADING ARC** *(AS DEFINED BY BS 5837:2012)*
- **NTM CATEGORY TREE, GROUP, HEDGE, OR WOODLAND** *(QUALITY CATEGORY ESTIMATED VIA WALKOVER AND/OR DESK STUDY: A, B, C, U, OR UNCATEGORIZED*
- **VETERAN/ANCIENT TREE** *(IDENTIFIED BY SURVEY)*
- **VETERAN/ANCIENT TREE** *(IDENTIFIED BY WALKOVER/DESK STUDY)*
- **TREE PRESERVATION ORDER** *(AREA COVERED BY A TREE PRESERVATION ORDER [TPO])*
- **CONSERVATION AREA** *(AREA COVERED BY A TREE PRESERVATION ORDER [TPO])*

ISSUE/REVISION

P01	13/01/22	SECOND ISSUE
00	22/11/22	FIRST ISSUE
I/R	DATE	DESCRIPTION

DRAWING STATUS

SUBMITTED AT DEADLINE 5

PROJECT NUMBER

60589004

SHEET TITLE

TREE CONSTRAINTS PLAN (SHEET 18)

SHEET NUMBER REV.

60589004-ACM-XX-XX-AB-TCP-018 P01

Author: GR Designer: JB Checked: TF Approved: AW

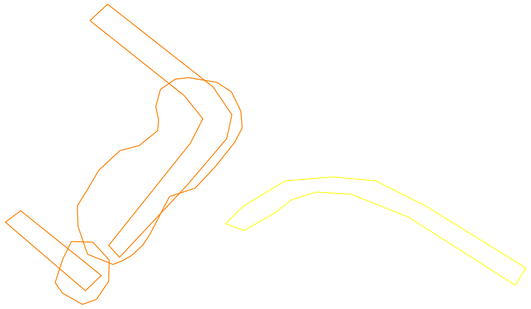

B1103 Newmarket Road / B1102 Isaacson Road Junction (Scale 1:500)

B1103 Swan Lane / Oxford Street Junction (Scale 1:500)

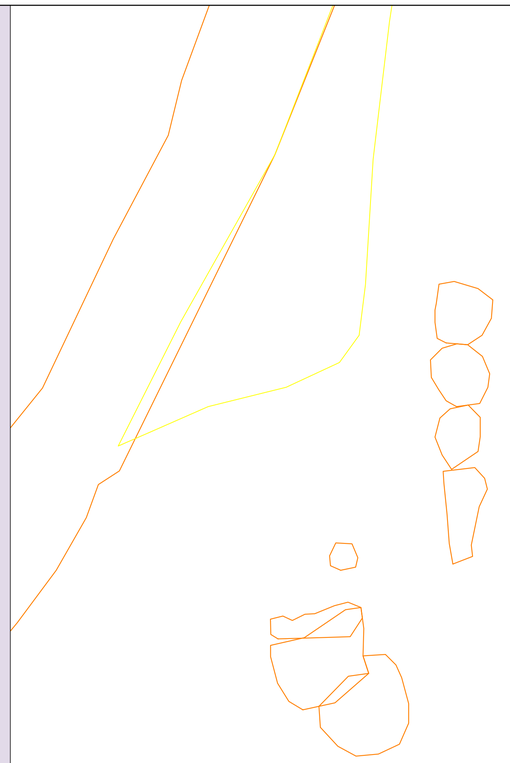

A142 Fordham Road / Windmill Road Junction (Scale 1:500)

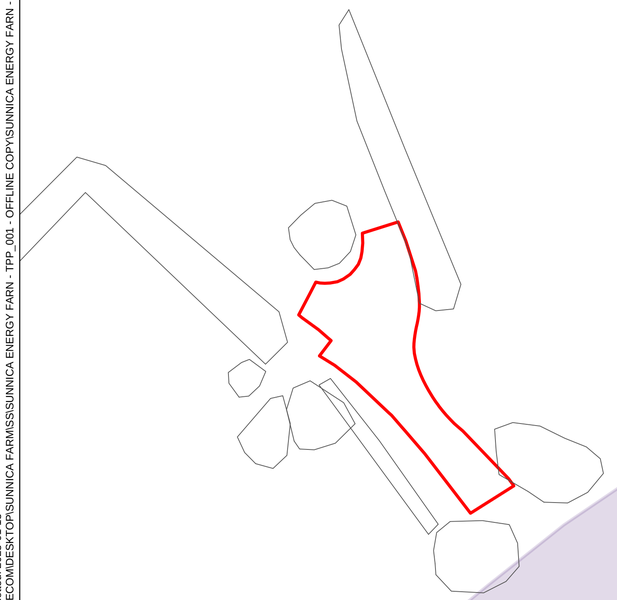

B1104 / Chippenham road junction (Scale 1:500)

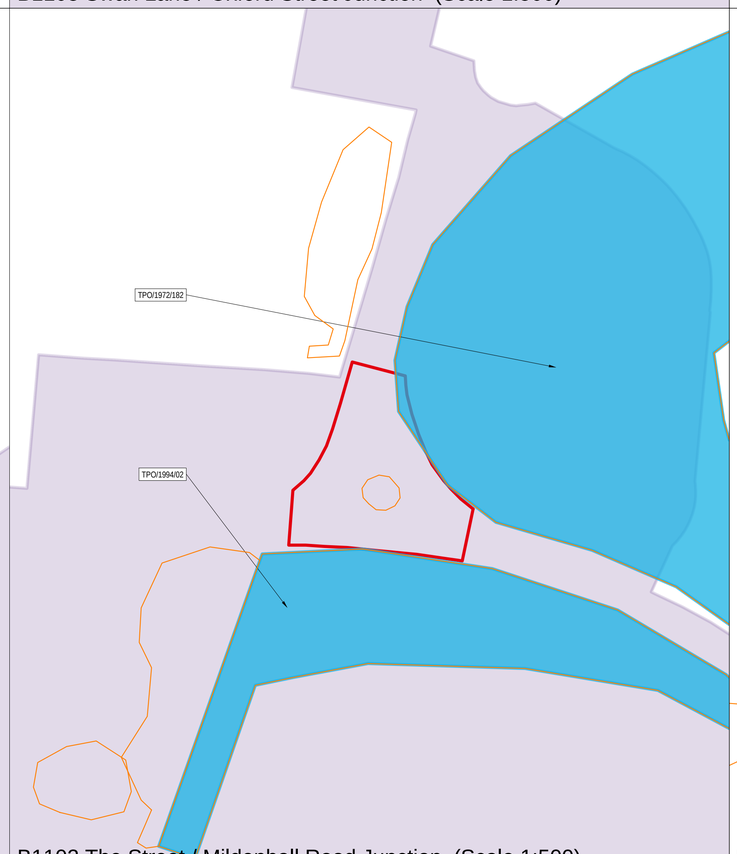

B1102 The Street / Mildenhall Road Junction (Scale 1:500)

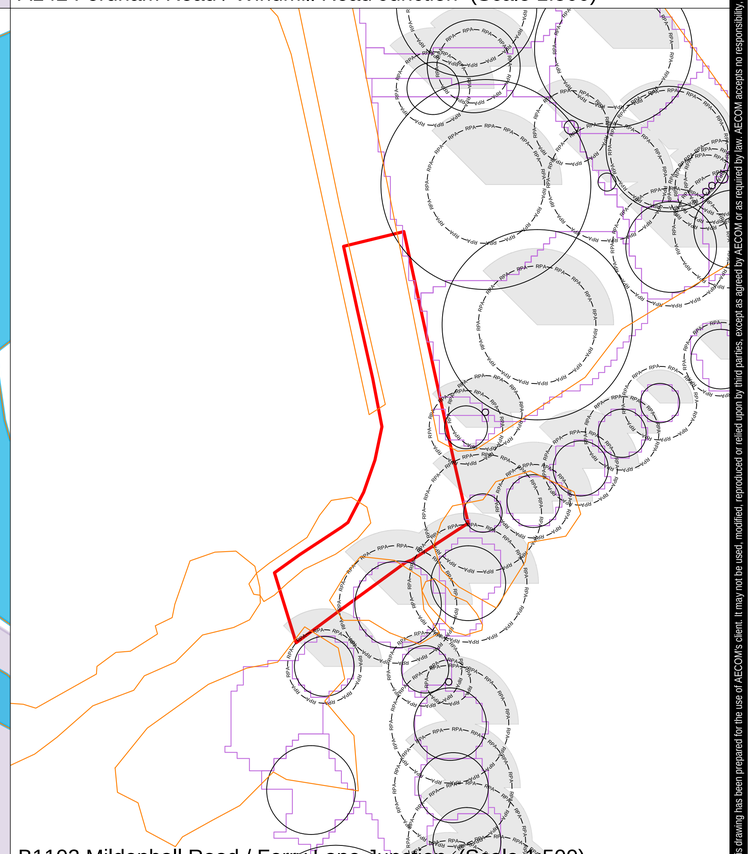

B1102 Mildenhall Road / Ferry Lane Junction (Scale 1:500)

This drawing has been prepared for the use of AECOM's client. It may not be used, modified, reproduced or relied upon by third parties, except as agreed by AECOM or as required by law. AECOM accepts no responsibility, and denies any liability whatsoever, to any party that uses or relies on this drawing without AECOM's express written consent. Do not scale this document. All measurements must be obtained from the stated dimensions.

AECOM

PROJECT

SUNNICA ENERGY FARM

CLIENT

SUNNICA ENERGY FARM

CONSULTANT

AECOM
Plumer House, Third Floor,
East Wing, Tailyour Road
Plymouth, PL6 5DH
Tel +44(0)1752 676700
Fax +44(0)870 238 6023
www.aecom.com

GENERAL NOTES

1. TREE CATEGORIES AS DEFINED BY BS 5837:2012
2. TREE LOCATIONS ARE BASED ON THE TOPOGRAPHICAL SURVEY, AERIAL IMAGERY, AND GPS CO-ORDINATES FROM ON SITE WALKOVER.
3. * INDICATES A TREE / GROUP WHOSE POSITION IS APPROXIMATE AS BASED UPON AERIAL PHOTOGRAPHY AND ON SITE OBSERVATIONS.
4. PLANS SHOULD BE READ IN CONJUNCTION WITH THE AECOM ARBORICULTURAL REPORT.
5. THE ORIGINAL OF THIS DRAWING WAS PRODUCED IN COLOUR - A MONOCHROME COPY SHOULD NOT BE RELIED UPON.
6. DRAWING REFERNCES:
   TPO.dwg
   MERGED NTM DATA RevA Modified.dwg
   xref_OSMap.dwg
   20230105_Sunnica_WSP_RLB.dwg

KEY PLAN

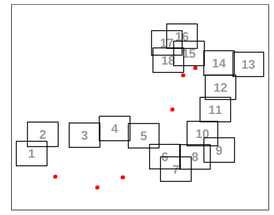

KEY

- ORDER LIMITS BOUNDARY
- LOCAL AUTHORITY BOUNDARY
- A CATEGORY TREE, GROUP, HEDGE, OR WOODLAND *(AS FOUND DURING DETAILED SURVEY, INDICATES HIGH QUALITY & VALUE)*
- B CATEGORY TREE, GROUP, HEDGE, OR WOODLAND *(AS FOUND DURING DETAILED SURVEY, INDICATES MODERATE QUALITY & VALUE)*
- C CATEGORY TREE, GROUP, HEDGE, OR WOODLAND *(AS FOUND DURING DETAILED SURVEY, INDICATES LOW QUALITY & VALUE)*
- U CATEGORY TREE, GROUP, HEDGE, OR WOODLAND *(AS FOUND DURING DETAILED SURVEY, UNSUITABLE FOR RETENTION)*
- ROOT PROTECTION AREAS (RPA) *(AS DEFINED BY BS 5837:2012 FOR TREES SUBJECT TO DETAILED SURVEY. ESTIMATED BUFFER ZONE SHOWN INDICATIVELY FOR OTHER TREES)*
- APPROXIMATE SHADING ARC *(AS DEFINED BY BS 5837:2012)*
- NTM CATEGORY TREE, GROUP, HEDGE, OR WOODLAND *(QUALITY CATEGORY ESTIMATED VIA WALKOVER AND/OR DESK STUDY: A, B, C, U, OR UNCATEGORIZED*
- VETERAN/ANCIENT TREE *(IDENTIFIED BY SURVEY)*
- VETERAN/ANCIENT TREE *(IDENTIFIED BY WALKOVER/DESK STUDY)*
- TREE PRESERVATION ORDER *(AREA COVERED BY A TREE PRESERVATION ORDER [TPO])*
- CONSERVATION AREA *(AREA COVERED BY A TREE PRESERVATION ORDER [TPO])*

ISSUE/REVISION

I/R	DATE	DESCRIPTION
P01	13/01/22	SECOND ISSUE
00	22/11/22	FIRST ISSUE

DRAWING STATUS

SUBMITTED AT DEADLINE 5

PROJECT NUMBER

60589004

SHEET TITLE

TREE CONSTRAINTS PLAN (SHEET 19)

SHEET NUMBER 60589004-ACM-XX-XX-AB-TCP-019

REV. P01

Last saved by: BREWERJ (2023-01-13) Last Plotted: 2023-01-13
Filename: C:\USERS\BREWERJ\ONEDRIVE - AECOM\DESKTOP\SUNNICA FARM\SSSUNNICA ENERGY FARN - TPP_001 - OFFLINE COPY\SUNNICA ENERGY FARN - TCP_004.DWG

Appendix B Detailed Tree Survey Schedule

Tree ID	Species	Estimated Height (m)	Stem Diameter (mm)	Canopy Spread (N)	Canopy Spread (S)	Canopy Spread (E)	Canopy Spread (W)	First Significant Branch (m)	Canopy Clearance (m)	Physiological Condition	Life Stage	Structural Condition	Condition Comments	Preliminary Management Comments	Works to Facilitate Proposed Development	Estimated Remaining Contribution	Category
G1*	Crack Willow (*Salix fragilis*), ~~Unknown~~	15	500	4.5	4.5	4.5	4.5	n/a	n/a	Good	EM-M	Good - Fair	Unable to fully access, main stems at approx.4.5m distance from road.			20+	B2
G2*	Aspen (*Populus tremula*), Crack Willow (*Salix fragilis*)	11	250	2.5	2.5	2.5	2.5	n/a	n/a	Good	SM	Good - Fair	Planted row at arable field boundary, established north of boundary drainage ditch. Planted row of aspen dominated single row at field boundary, some suppression of growth from crack willow groups at south where proximal.			20+	B2
G3*	Crack Willow (*Salix fragilis*), ~~Unknown~~	13	400	4	4	4	4	n/a	n/a	Good	EM-M	Good - Fair	Unable to fully access, main stems positioned at 4m distance from road edge.			20+	B2
G4*	Crack Willow (*Salix fragilis*)	12	400	4.5	4.5	4.5	4.5	n/a	n/a	Good	M	Fair	Unable to fully access. Co-dominant forms, ivy clad with mutual development suppression.			10+	C2

Tree ID	Species	Estimated Height (m)	Stem Diameter (mm)	Canopy Spread (N)	Canopy Spread (S)	Canopy Spread (E)	Canopy Spread (W)	First Significant Branch (m)	Canopy Clearance (m)	Physiological Condition	Life Stage	Structural Condition	Condition Comments	Preliminary Management Comments	Works to Facilitate Proposed Development	Estimated Remaining Contribution	Category
G5*	Hawthorn (*Crataegus monogyna*), Crack Willow (*Salix fragilis*), Aspen (*Populus tremula*)	11	150	2.5	2.5	2.5	2.5	n/a	n/a	Good	SM	Good - Fair	Unable to fully access. Co-dominant forms, ivy clad with mutual development suppression.			10+	C2
G6*	Sycamore (*Acer pseudoplatanus*), Crab Apple (*Malus sylvestris*), Damson (*Prunus domestica*)	10	150	2.5	2.5	2.5	2.5	n/a	n/a	Good	SM	Good - Fair	Co-dominant sycamore with fruit tree understorey.			10+	C2
G7*	Sycamore (*Acer pseudoplatanus*)	11	150	3.5	3.5	3.5	3.5	n/a	n/a	Good	SM	Fair	Mutually suppressed forms.			10+	C2
G8*	Sycamore (*Acer pseudoplatanus*)	9	150	2	2	2	2	n/a	n/a	Poor	SM	Fair - Poor	In decline from proximal no current target value			<10	U2
G9*	Sycamore (*Acer pseudoplatanus*)	12	150	3	3	3	3	n/a	n/a	Good	SM	Fair	Co-dominant forms, mutually suppressed.		Fell in part as per TPRP.	10+	C2

Tree ID	Species	Estimated Height (m)	Stem Diameter (mm)	Canopy Spread (N)	Canopy Spread (S)	Canopy Spread (E)	Canopy Spread (W)	First Significant Branch (m)	Canopy Clearance (m)	Physiological Condition	Life Stage	Structural Condition	Condition Comments	Preliminary Management Comments	Works to Facilitate Proposed Development	Estimated Remaining Contribution	Category
G10*	Sycamore (*Acer pseudoplatanus*)	15	500	7	7	7	7	n/a	n/a	Good	EM-M	Good - Fair	Unable to fully access, bordering both sides of field boundary ditch, co-dominant mutually suppressed forms throughout.		Fell in part as per TPRP.	20+	B2
T11*	Aspen (*Populus tremula*)	14	600,500	1	1	1	1		3.5	Good	M	Poor	Unable to access. Strongly weighted towards (low occupancy) road, ivy clad and potentially propped by neighbouring trees.	Consider f~~F~~ell Subject to tree ownership ~~(When funds allow)~~		<10	U1
T12*	Norway Maple (*Acer platanoides*)	10	310	2.5	2.5	2.5	2.5		2.5	Fair - Poor	EM	Fair	In decline, leaf chlorosis and minor deadwood throughout.			<10	U1
G13*	Sycamore (*Acer pseudoplatanus*)	14	500	5	5	5	5	n/a	n/a	Good	EM-M	Good	Unable to access. Co-dominant forms outside substation compound boundary.			20+	B2
G14*	Weeping Willow (*Salix X chrysocoma*), Crack Willow (*Salix fragilis*), Sycamore (*Acer pseudoplat*	16	750	8	8	8	8	n/a	n/a	Good	M	Good - Fair	Unable to access. Main stems set back from road edge at approx. 12m.			20+	B2

Tree ID	Species	Estimated Height (m)	Stem Diameter (mm)	Canopy Spread (N)	Canopy Spread (S)	Canopy Spread (E)	Canopy Spread (W)	First Significant Branch (m)	Canopy Clearance (m)	Physiological Condition	Life Stage	Structural Condition	Condition Comments	Preliminary Management Comments	Works to Facilitate Proposed Development	Estimated Remaining Contribution	Category
	anus), Alder (*Alnus sp*)																
G15*	Sycamore (*Acer pseudoplatanus*), Elder (*Sambucus nigra*)	13	300	3	3	3	3	n/a	n/a	Good	EM	Fair	At roadside with multiple bark wounds.			10+	C2
H16*	Damson (*Prunus domestica*)	3	75	1	1	1	1	n/a	n/a							10+	C2,3
G17*	Field Maple (*Acer campestre*)	14	500	3	3	3	3	n/a	n/a	Good	EM-M	Good - Fair	Unable to fully access, co-dominant forms.			20+	B2
G18*	Crack Willow (*Salix fragilis*)	8	300	3	3	3	3	n/a	n/a	Good	EM	Fair	Below powerline.			10+	C2

Tree ID	Species	Estimated Height (m)	Stem Diameter (mm)	Canopy Spread (N)	Canopy Spread (S)	Canopy Spread (E)	Canopy Spread (W)	First Significant Branch (m)	Canopy Clearance (m)	Physiological Condition	Life Stage	Structural Condition	Condition Comments	Preliminary Management Comments	Works to Facilitate Proposed Development	Estimated Remaining Contribution	Category
G19*	Crack Willow (*Salix fragilis*)	22	900	9	4	6	6	n/a	n/a	Good	M	Good - Fair	Large prominent trees with mutual development suppression. Unable to fully access, ivy clad multi stem unions at base, minor deadwood throughout.			20+	B2,3
G20*	Sycamore (*Acer pseudoplatanus*)	13	500	4	4	4	4	n/a	n/a	Good	M	Good - Fair	Unable to fully access, ivy clad forms.			20+	B2,3
G21*	Crack Willow (*Salix fragilis*), Weeping Willow (*Salix X chrysocoma*), Sycamore (*Acer pseudoplatanus*)	18	800	7	7	7	7	n/a	n/a	Good	M	Good - Fair	At adjacent side of ditch from road, dominated by large crack willow with minor deadwood throughout, remainder of group mutually suppressed.		Fell in part as per TPRP.	20+	B2
T22*	English Elm (*Ulmus procera*)	6	100	1.5	1.5	1.5	1.5			Dead	Y	Dead	Dead tree.			<10	U1

Tree ID	Species	Estimated Height (m)	Stem Diameter (mm)	Canopy Spread (N)	Canopy Spread (S)	Canopy Spread (E)	Canopy Spread (W)	First Significant Branch (m)	Canopy Clearance (m)	Physiological Condition	Life Stage	Structural Condition	Condition Comments	Preliminary Management Comments	Works to Facilitate Proposed Development	Estimated Remaining Contribution	Category
T23*	Elm (*Ulmus sp*)	14	700	7	7	7	7	3.0/E	1	Good	M	Good - Fair	At adjacent side of ditch, unable to fully access.			20+	B1,3
T24*	Sycamore (*Acer pseudoplatanus*)	9	200	2	2	2	2			Good	SM	Good - Fair	Unable to access.			10+	C1
G25*	Goat Willow (*Salix caprea*), Hawthorn (*Crataegus monogyna*), Elder (*Sambucus nigra*), Elm (*Ulmus sp*)	6	150	2	2	2	2	n/a	n/a	Good	EM	Fair	Denotes field boundary, unable to access.			10+	C2
G26*	Crack Willow (*Salix fragilis*), Hawthorn (*Crataegus monogyna*)	6	150	2	2	2	2	n/a	n/a	Good	EM	Good - Fair	Unable to fully access, denotes boundary.			10+	C2,3
T27*	Hawthorn (*Crataegus monogyna*)	7	250	2.5	2.5	2.5	2.5	1.0/S	1	Good	EM	Good	Unable to fully access.			10+	C1

Tree ID	Species	Estimated Height (m)	Stem Diameter (mm)	Canopy Spread (N)	Canopy Spread (S)	Canopy Spread (E)	Canopy Spread (W)	First Significant Branch (m)	Canopy Clearance (m)	Physiological Condition	Life Stage	Structural Condition	Condition Comments	Preliminary Management Comments	Works to Facilitate Proposed Development	Estimated Remaining Contribution	Category
G28*	Goat Willow (*Salix caprea*)	6	150	2.5	2.5	2.5	2.5	n/a	n/a	Good	EM	Fair	Denotes field boundary, unable to access.			10+	C2
T29*	Lawson Cypress (*Chamaecyparis lawsoniana*)	13	450	3	3	3	3			Good	M	Good - Fair	Unable to fully access, at adjacent side of ditch, ivy clad main stem.			10+	C1,2
G30*	Elder (*Sambucus nigra*), Lawson Cypress (*Chamaecyparis lawsoniana*)	8	150	1.5	1.5	1.5	1.5	n/a	n/a	Fair - Poor	EM	Fair - Poor	Both in decline, cypress with larger stem at adjacent side of ditch, no target value.			<10	U2
T31*	Unknown	6	800	2	2	2	2			Dead	M	Dead	Ivy clad monolith, no target value.			<10	U1,3
G32*	Ash (*Fraxinus excelsior*)	1	900	7	7	7	7	n/a	n/a	Good - Fair	M	Fair	Main stems at approx.6m distance roadside of ditch Unable to fully inspect. Ivy clad main stems and inner crowns, minor deadwood throughout. Weighted from mutual suppression.	Sever ivy (< 12 months)		20+	B2,3

Tree ID	Species	Estimated Height (m)	Stem Diameter (mm)	Canopy Spread (N)	Canopy Spread (S)	Canopy Spread (E)	Canopy Spread (W)	First Significant Branch (m)	Canopy Clearance (m)	Physiological Condition	Life Stage	Structural Condition	Condition Comments	Preliminary Management Comments	Works to Facilitate Proposed Development	Estimated Remaining Contribution	Category
G33*	Ash (*Fraxinus excelsior*)	13	450	5	5	5	5	n/a	n/a	Good	M	Good - Fair	Unable to fully access, at adjacent side of ditch.			20+	B2
G34*	Goat Willow (*Salix caprea*), Hawthorn (*Crataegus monogyna*), Elder (*Sambucus nigra*), Elm (*Ulmus sp*)	6	150	2	2	2	2	n/a	n/a	Good	EM	Fair	Denotes field boundary, unable to access.			10+	C2
G35*	Ash (*Fraxinus excelsior*)	17	500	6	6	6	6	n/a	n/a	Good	M	Good - Fair	Co-dominant forms with collective landscape value.			20+	B2
G36*	Field Maple (*Acer campestre*)	10	500	3	3	3	3	n/a	n/a	Good	M	Good - Fair	Unable to fully access, majority of group below overhead powerline.			10+	C1,2
T37*	Ash (*Fraxinus excelsior*)	13	800	7	7	7	7	3.0/S	2.5	Good	M	Good - Fair	Ivy clad main stem and inner crown, multi stem from 1.5m height.			20+	B1,3

Tree ID	Species	Estimated Height (m)	Stem Diameter (mm)	Canopy Spread (N)	Canopy Spread (S)	Canopy Spread (E)	Canopy Spread (W)	First Significant Branch (m)	Canopy Clearance (m)	Physiological Condition	Life Stage	Structural Condition	Condition Comments	Preliminary Management Comments	Works to Facilitate Proposed Development	Estimated Remaining Contribution	Category
G38*	Ash (*Fraxinus excelsior*), Crack Willow (*Salix fragilis*), Aspen (*Populus tremula*), Sycamore (*Acer pseudoplatanus*)	6	600	5	5	5	5	n/a	n/a	Good - Fair	EM	Fair	Unable to access, comprising of suppressed or structurally weighted forms.			10+	C2
T39*	Crack Willow (*Salix fragilis*)	22	900	7	7	7	7		5	Good	M	Fair	Dominant tree within group, some failed branches throughout, lapsed pollard.	Consider r~~R~~e pollard above previous points ~~(When funds allow)~~		20+	B1,2
T40*	White Poplar (*Populus alba*)	16	500,400,350	6	6	6	6		4	Good - Fair	M	Fair	Unable to fully inspect, dense ivy at base . Multi stem from base. Multiple branch failures throughout, slightly sparse canopy.	Remove hanging branch over road (Asap)	~~Crown lift to 5.2m over verge to south for vehicle movement.~~	10+	C1,2,3
T41*	Crack Willow (*Salix fragilis*)	16	600,600,500,450	5	5	1	4		1	Good	M	Fair	Multi stem union at 1m, cyclically cleared from proximal power line at east side, remaining form west weighted.			10+	C1,2

Tree ID	Species	Estimated Height (m)	Stem Diameter (mm)	Canopy Spread (N)	Canopy Spread (S)	Canopy Spread (E)	Canopy Spread (W)	First Significant Branch (m)	Canopy Clearance (m)	Physiological Condition	Life Stage	Structural Condition	Condition Comments	Preliminary Management Comments	Works to Facilitate Proposed Development	Estimated Remaining Contribution	Category
T42*	Scots Pine (*Pinus sylvestris*)	13	640	4	5	4	5	5.0/S	5	Good	M	Good	Dense ivy cover 0-5m. Several yellow patches on lower stem with black staining. Minor crown sparsity. Previous crown lifting over arable field to south east.			20+	B1
T43*	Scots Pine (*Pinus sylvestris*)	12	440	7	0.5	5	3		5	Poor	EM	Poor	Ivy cover 0-3m. Significant dieback of eastern crown with large deadwood. Western crown in good condition. Low traffic area on boundary of arable field.	Undertake safety survey if land frequency increases.		10+	C1
T44*	Hawthorn (*Crataegus monogyna*)	4	130	3	3	3	3		0	Good	EM	Good	No access to base. Unlikely to be sSubject to TPO		Fell	10+	C1
T45*	Common Oak (*Quercus robur*)	7	300	3	5	5	2	1.5/N	0	Good	SM	Good	Previous heavy clearance pruning from footway to north west.			20+	B2
T46*	Common Oak (*Quercus robur*)	10	210,200,200,180	6	4	4	5	1.0/N	2	Good	SM	Fair	Multiple stems from ground level. A number of large longitudinal stem wounds to north west. Minor to moderate wound wood development. Previous crown lifting to south east over footway.			10+	C1

Tree ID	Species	Estimated Height (m)	Stem Diameter (mm)	Canopy Spread (N)	Canopy Spread (S)	Canopy Spread (E)	Canopy Spread (W)	First Significant Branch (m)	Canopy Clearance (m)	Physiological Condition	Life Stage	Structural Condition	Condition Comments	Preliminary Management Comments	Works to Facilitate Proposed Development	Estimated Remaining Contribution	Category
T47*	Common Oak (*Quercus robur*)	10	310,250	5	3	4	4	2.5/NW	2.5	Good	SM	Good	Previous crown lifting over footway and livestock field.			20+	B1
T48*	Common Oak (*Quercus robur*)	8	200,220	5	0.5	2	5	1.7/N	2.5	Good	SM	Fair	Two stems from ground level. A number of large longitudinal stem wounds to north west. Minor to moderate wound wood development.			10+	C2
T49*	Common Oak (*Quercus robur*)	10	230,170	1	3	2	5	6.0/W	2.5	Good	SM	Fair	Two stems from ground level. A number of large longitudinal stem wounds to north west. Good wound wood development. Previous crown lifting to south east over footway.			10+	C1,2
T50*	Common Oak (*Quercus robur*)	10	230,270	4	1	3	5	5.0/SE	2	Good	SM	Good	Ivy covered 0-9m. Previous crown lifting over footway and livestock field.			20+	B2
T51*	Scots Pine (*Pinus sylvestris*)	13	350	5	3	4	4	1.3/SE	2.5	Good	SM	Good	Good landscape value. Individually of moderate value.			20+	B1,2

Tree ID	Species	Estimated Height (m)	Stem Diameter (mm)	Canopy Spread (N)	Canopy Spread (S)	Canopy Spread (E)	Canopy Spread (W)	First Significant Branch (m)	Canopy Clearance (m)	Physiological Condition	Life Stage	Structural Condition	Condition Comments	Preliminary Management Comments	Works to Facilitate Proposed Development	Estimated Remaining Contribution	Category
T52*	Austrian Pine (*Pinus nigra*)	20	1160	7	7	7	7	1.6/S	0	Good	M	Fair	Prominent tree. Hazard beam limb to north west with the tip of the branch resting on the ground. Two stems from 2m with tight included union and minimal adaptive growth. But with upright form and natural bracing. Low traffic area in arable field. Good landscape value.			20+	B1,2
T53*	Austrian Pine (*Pinus nigra*)	16	520	5	6	6	5	8.0/SW	2	Good	EM	Good	Good landscape value. Collectively of high value as part of row of black pine.			40+	A2
T54*	Scots Pine (*Pinus sylvestris*)	8	210	2	1	5	0.1		6	Dead	SM	Dead	Recently dead tree. Low traffic area.	Consider fFell if land frequency increases.		<10	U
T55*	Scots Pine (*Pinus sylvestris*)	12	310	2	3	4	3	7.0/E	1	Good	SM	Good	Minor form suppression from adjacent trees.			20+	B2

Tree ID	Species	Estimated Height (m)	Stem Diameter (mm)	Canopy Spread (N)	Canopy Spread (S)	Canopy Spread (E)	Canopy Spread (W)	First Significant Branch (m)	Canopy Clearance (m)	Physiological Condition	Life Stage	Structural Condition	Condition Comments	Preliminary Management Comments	Works to Facilitate Proposed Development	Estimated Remaining Contribution	Category
T56*	Scots Pine (*Pinus sylvestris*)	8	410,310	1	6	5	5	7.0/E	0	Good	EM	Fair	Minor form suppression from adjacent trees. Second smaller stem has previously failed at 4m with large stub remaining. Several other smaller tear out wounds in crown. Main stem in good physiological condition.			20+	B2
T57*	Hybrid black poplar (*Populus x canadensis*)	20	1220	10	9	12	9	1.4/NE	0	Good	M	Good	Prominent tree. DBH measured a 1.2m. A number of large over extended limbs but in low traffic area.			20+	B1,2
T58*	Field Maple (*Acer campestre*)	13	550	5	6	6	4	0.3/S	1	Good	M	Good	DBH measured at 0.2m. Multiple stems/limbs from 0.4m. Previous crown lifting over field to north east.			20+	B1,2
T59*	Hybrid black poplar (*Populus x canadensis*)	24	1060,540, 850,770	12	12	14	10	4.0/SE	4	Good	M	Fair	Prominent in group. Four stems from 1-1.6m. Numerous large tear out wounds in crown including a large cavity on the main (largest) stem at 6m to the north east. Several animal holes visible. Low traffic area in arable field.	Undertake safety survey if land frequency increases.		20+	B1,2

Tree ID	Species	Estimated Height (m)	Stem Diameter (mm)	Canopy Spread (N)	Canopy Spread (S)	Canopy Spread (E)	Canopy Spread (W)	First Significant Branch (m)	Canopy Clearance (m)	Physiological Condition	Life Stage	Structural Condition	Condition Comments	Preliminary Management Comments	Works to Facilitate Proposed Development	Estimated Remaining Contribution	Category
T60*	Scots Pine (*Pinus sylvestris*)	14	690	7	4	7	7	10.0/SE	4	Good	M	Good	Good landscape value. Previous major crown lifting. Several tear out wounds in crown.			20+	B1,2
T61*	Scots Pine (*Pinus sylvestris*)	13	500	4	6	6	2	5.0/S	5	Good	EM	Good	No access to base. Good landscape value. Previous crown lifting over access road.			20+	B1,2
T62*	Scots Pine (*Pinus sylvestris*)	12	330	2	2	2	3	5.0/NW	5	Fair	SM	Good	No access to base. Previous crown lifting over access road. Moderate form suppression. Minor crown dieback.			10+	C1,2
T63*	Scots Pine (*Pinus sylvestris*)	6	270	6	0.1	4	0.1		3	Good	SM	Poor	No access to base. Partially failed main stem at 5m with hazard beam fracture. Stem is hung up in understory but still alive. Low traffic area in arable field.	Consider fFell if land frequency increases.		<10	U1
T64*	Scots Pine (*Pinus sylvestris*)	12	320	1	2	8	-4		5	Good	SM	Poor	No access to base. Significant lean to east over access road. Previous heavy crown lifting. Low traffic area in arable field.	Undertake safety survey if land frequency increases.		10+	C1

Tree ID	Species	Estimated Height (m)	Stem Diameter (mm)	Canopy Spread (N)	Canopy Spread (S)	Canopy Spread (E)	Canopy Spread (W)	First Significant Branch (m)	Canopy Clearance (m)	Physiological Condition	Life Stage	Structural Condition	Condition Comments	Preliminary Management Comments	Works to Facilitate Proposed Development	Estimated Remaining Contribution	Category
T65*	Scots Pine (*Pinus sylvestris*)	10	320	4	4	4	2	7.0/N	6	Good	SM	Fair	No access to base. Previous failure of main leader at 9m. Cavity present with birds nesting however extent of cavity not clear. Low traffic area in arable field.	Undertake safety survey if land frequency increases.		10+	C1
T66*	Scots Pine (*Pinus sylvestris*)	12	400	5	3	7	2	6.0/E	5	Good	SM	Good	No access to base. Previous crown lifting over access road.			20+	B1
T67*	Hybrid black poplar (*Populus x canadensis*)	15	390,420,530	7	7	7	5	3.0/NW	4	Good	EM	Fair	Three stems from 0-1m with tight included unions but with upright form and in a low traffic area in an arable field.	Undertake safety survey if land frequency increases.		20+	B2
T68*	Austrian Pine (*Pinus nigra*)	24	870	6	7	7	6	4.0/NE	0	Good	M	Fair	Provides significant landscape value. Two stems from 3m with tight included union but with some adaptive growth and upright form. Low traffic area in arable field.			20+	B1,2
T69*	Austrian Pine (*Pinus nigra*)	24	930	8	7	6	8	6.0/W	0	Good	M	Fair				20+	B1,2

Tree ID	Species	Estimated Height (m)	Stem Diameter (mm)	Canopy Spread (N)	Canopy Spread (S)	Canopy Spread (E)	Canopy Spread (W)	First Significant Branch (m)	Canopy Clearance (m)	Physiological Condition	Life Stage	Structural Condition	Condition Comments	Preliminary Management Comments	Works to Facilitate Proposed Development	Estimated Remaining Contribution	Category
T70*	Hybrid black poplar (*Populus x canadensis*)	26	1100,430	8	10	10	10	4.0/N	1	Good	M	Good	Significant landscape feature. Two stems from base with tight included union. However smaller stem has previously failed at 5m. Several large tearout wounds in crown and a number of animal holes visible.			20+	B1,2
T71*	Common Oak (*Quercus robur*)	8	1290	10	10	12	10	1.7/S	0	Good	M	Good	Significant landscape value. Multiple stems/limbs from 1.7m. Moderate deadwood but in low traffic arable field.			40+	A1,2
T72*	Common Oak (*Quercus robur*)	10	410,310	7	6	7	6	2.0/E	0	Good	SM	Good	Good landscape value.			20+	B1,3
T73*	Hybrid black poplar (*Populus x canadensis*)	26	710,970,540,850	9	9	11	10	1.6/SW	4	Good	M	Good	Multiple stems from 0-2m with good to fair unions. A number of overextended limbs but in low traffic arable field. Significant landscape value.			20+	B1,2
T74*	White Poplar (*Populus alba*)	12	500	0.5	0.5	0.5	0.5			Fair	EM	Fair	Monolithed at 12m.			10+	C1

Tree ID	Species	Estimated Height (m)	Stem Diameter (mm)	Canopy Spread (N)	Canopy Spread (S)	Canopy Spread (E)	Canopy Spread (W)	First Significant Branch (m)	Canopy Clearance (m)	Physiological Condition	Life Stage	Structural Condition	Condition Comments	Preliminary Management Comments	Works to Facilitate Proposed Development	Estimated Remaining Contribution	Category
T75*	Sycamore (*Acer pseudoplatanus*)	14	500	7	5	7	6	2.5/NW	1.5	Good	M	Good	No access to base. Two stems from 1.7m but with limited visibility of union. Individually of moderate value.			20+	B1,2
T76*	Beech (*Fagus sylvatica*)	11	250	3	3	4	3		2	Fair	SM	Good	No access to base. Minor upper crown dieback with moderate form suppression. Individually of low quality.			10+	C2
T77*	Common Oak (*Quercus robur*)	12	450	6	6	5	6	4.0/NW	2	Good	SM	Good	No access to base. Dense ivy cover 0-6m. Individually of moderate quality.			20+	B1,2
T78*	Sycamore (*Acer pseudoplatanus*)	12	230,300,180	5	5	5	3	2.0/S	0	Good	EM	Good	Limited access to base.			20+	B1
T79*	Sycamore (*Acer pseudoplatanus*)	12	320	4	4	4	4	1.0/S	0	Good	SM	Good	No access to base.			20+	B1

Tree ID	Species	Estimated Height (m)	Stem Diameter (mm)	Canopy Spread (N)	Canopy Spread (S)	Canopy Spread (E)	Canopy Spread (W)	First Significant Branch (m)	Canopy Clearance (m)	Physiological Condition	Life Stage	Structural Condition	Condition Comments	Preliminary Management Comments	Works to Facilitate Proposed Development	Estimated Remaining Contribution	Category
T80*	Common Oak (*Quercus robur*)	15	750	10	8	10	6	5.0/NW	4	Fair	M	Good	Limited access to base. Moderate inner crown sparsity. Good landscape value.			20+	B1,2
G81*	Scots Pine (*Pinus sylvestris*)	15	450	5	5	5	5	n/a	n/a	Good - Dead	EM	Good - Dead	Limited access to bases. Avenue of Scots pine. Varying condition with a number of dying or dead trees within. Low traffic area on boundary of arable field. Subject to TPO.	Consider f~~F~~ell dead/dying trees if land frequency increases.	Fell in part as per TPRP.	20+	B2
G82* ~~q~~	Common Oak (*Quercus robur*), Hawthorn (*Crataegus monogyna*), Blackthorn (*Prunus spinosa*), Elm (*Ulmus sp*)	10	300	4	4	4	4	n/a	n/a	Good	Y-SM	Good	Limited access to bases. Dense group on boundary of arable field. Subject to TPO.		Fell in part as per TPRP.	10+	C1,2
G83*	Elm (*Ulmus sp*), Hawthorn (*Crataegus monogyna*), Elder (*Sambucus nigra*), Scots Pine (*Pinus sylvestris*)	12	400	5	5	5	5	n/a	n/a	Good - Dead	Y-EM	Good - Dead	Limited access to bases. Several dead/dying trees within group. Low traffic area on boundary of arable field.	Consider f~~F~~ell dead/dying trees if land frequency increases.		20+	B2

Tree ID	Species	Estimated Height (m)	Stem Diameter (mm)	Canopy Spread (N)	Canopy Spread (S)	Canopy Spread (E)	Canopy Spread (W)	First Significant Branch (m)	Canopy Clearance (m)	Physiological Condition	Life Stage	Structural Condition	Condition Comments	Preliminary Management Comments	Works to Facilitate Proposed Development	Estimated Remaining Contribution	Category
G84*	Blackthorn (*Prunus spinosa*), Elm (*Ulmus sp*), Hawthorn (*Crataegus monogyna*), Elder (*Sambucus nigra*)	5	130	2	2	2	2	n/a	n/a	Good	Y-SM	Good	Understory group.			10+	C2
G85*	Scots Pine (*Pinus sylvestris*)	15	500	5	5	5	5	n/a	n/a	Good	EM	Good	Limited access to bases. Avenue of pine trees. Several dead/dying trees within group. Low traffic area on boundary of arable field.	Consider fFell dead/dying trees if land frequency increases.		20+	B2
G86*	Scots Pine (*Pinus sylvestris*)	16	500	5	5	5	5	n/a	n/a	Good	EM	Good	Limited access to bases. Avenue of pine. Varying condition with a number of dying or dead trees within. Low traffic area on boundary of arable field.	Consider fFell dead/dying trees if land frequency increases.		20+	B1,2
G87*	Scots Pine (*Pinus sylvestris*), Common Oak (*Quercus robur*), Elder (*Sambucus nigra*)	16	500	5	5	5	5	n/a	n/a	Good - Dead	SM-EM	Good - Dead	Mixed group. Limited access to bases. Varying condition with a number of dying or dead trees present. Low traffic area on boundary of arable field.	Consider fFell dead/dying trees if land frequency increases.		20+	B1,2
G88*	Common Oak (*Quercus robur*), Hawthorn (*Crataegus monogyna*), Elm (*Ulmus sp*), Elder (*Sambucus nigra*)	16	500	6	6	6	6	n/a	n/a	Good - Dead	Y-EM	Good - Dead	Pine, limited access to bases. Mixed group in varying condition with a number of dying or dead trees present. Low traffic area on boundary of arable field. Good landscape value.	Consider fFell dead/dying trees if land frequency increases.		20+	B1,2

Tree ID	Species	Estimated Height (m)	Stem Diameter (mm)	Canopy Spread (N)	Canopy Spread (S)	Canopy Spread (E)	Canopy Spread (W)	First Significant Branch (m)	Canopy Clearance (m)	Physiological Condition	Life Stage	Structural Condition	Condition Comments	Preliminary Management Comments	Works to Facilitate Proposed Development	Estimated Remaining Contribution	Category
G89*	Common Oak (*Quercus robur*), Scots Pine (*Pinus sylvestris*)	15	440	5	5	5	5	n/a	n/a	Good	SM-EM	Good	Avenue of 5 scots pine. Good landscape value. Adjacent to access tracks.			20+	B1,2
G90*	Common Oak (*Quercus robur*), Hawthorn (*Crataegus monogyna*)	6	130	2	2	2	2	n/a	n/a	Good	Y-SM	Good	Limited access to bases. Previous heavy clearance pruning from footway to north west. Circa 5 trees <200mm dbh.			10+	C2
G91*	Common Oak (*Quercus robur*)	10	200	4	4	4	4	n/a	n/a	Good	SM	Fair	Multiple stems from ground level. A number of large longitudinal stem wounds to north west. Minor to moderate wound wood development. Previous crown lifting to south east over footway.			10+	C2
G92*	Common Oak (*Quercus robur*)	10	230	4	4	4	4	n/a	n/a	Good	SM	Fair	A number of large longitudinal stem wounds to north west. Minor to moderate wound wood development. Previous crown lifting to south east over footway. Three trees at 210-400mm dbh.			10+	C2
G93*	Common Oak (*Quercus robur*), Scots Pine (*Pinus sylvestris*), Hawthorn (*Crataegus monogyna*)	8	450	5	5	5	5	n/a	n/a	Good	SM-EM	Good	Mix of oak and pine with squat form. Good landscape value. Five trees @0-210mm dbh. Four trees @410-600mm dbh.			20+	B1,2

Tree ID	Species	Estimated Height (m)	Stem Diameter (mm)	Canopy Spread (N)	Canopy Spread (S)	Canopy Spread (E)	Canopy Spread (W)	First Significant Branch (m)	Canopy Clearance (m)	Physiological Condition	Life Stage	Structural Condition	Condition Comments	Preliminary Management Comments	Works to Facilitate Proposed Development	Estimated Remaining Contribution	Category
W94 *	Common Oak (*Quercus robur*), Sycamore (*Acer pseudoplatanus*), Elder (*Sambucus nigra*), Hawthorn (*Crataegus monogyna*)	18	900	8	8	8	8	n/a	n/a	Good - Dead	Y-M	Good - Dead	Ash, norway maple, blackthorn. Limited access to bases. Significant woodland group with numerous mature oak trees present. Subject to TPO.		Fell in part as per TPRP.	40+	A1,2
G95*	Austrian Pine (*Pinus nigra*), Field Maple (*Acer campestre*), Hawthorn (*Crataegus monogyna*), White Poplar (*Populus alba*)	20	700	7	7	7	7	n/a	n/a	Good	SM-M	Good	Overstory of pine and white poplar with understory of hawthorn and field maple. Good landscape value.			20+	B1,2
G96*	Scots Pine (*Pinus sylvestris*), Hawthorn (*Crataegus monogyna*), Elder (*Sambucus nigra*)	16	600	6	6	6	6	n/a	n/a	Good - Dead	EM-M	Good - Dead	Limited access to bases. Row of Scots pine with hawthorn and elder understory. Several dead trees within group. Previous crown lifting over arable field and access road.			20+	B1,2
G97*	Blackthorn (*Prunus spinosa*), Elder (*Sambucus nigra*)	6	100	3	3	3	3	n/a	n/a	Good	SM	Good	No access to bases. Dense group.			10+	C2

Tree ID	Species	Estimated Height (m)	Stem Diameter (mm)	Canopy Spread (N)	Canopy Spread (S)	Canopy Spread (E)	Canopy Spread (W)	First Significant Branch (m)	Canopy Clearance (m)	Physiological Condition	Life Stage	Structural Condition	Condition Comments	Preliminary Management Comments	Works to Facilitate Proposed Development	Estimated Remaining Contribution	Category
G98*	Blackthorn (*Prunus spinosa*), Scots Pine (*Pinus sylvestris*)	13	430	5	5	5	5	n/a	n/a	Good	SM-EM	Good	No access to bases. Dense understory of blackthorn with pine overstory.			20+	B1,2
G99*	Blackthorn (*Prunus spinosa*), Elder (*Sambucus nigra*), Hawthorn (*Crataegus monogyna*)	7	150	3	3	3	3	n/a	n/a	Good	SM-EM	Good	No access to bases. Dense group. One dead stem within group circa 5m tall with 300mm stem diameter. - 40 trees 75-200mm dbh.			10+	C2
G100*	Blackthorn (*Prunus spinosa*), Hawthorn (*Crataegus monogyna*), Elder (*Sambucus nigra*)	6	100	3	3	3	3	n/a	n/a	Good	SM-EM	Good	No access to bases. Dense group.			10+	C2
G101*	Blackthorn (*Prunus spinosa*), Hawthorn (*Crataegus monogyna*), Elder (*Sambucus nigra*)	7	150	3	3	3	3	n/a	n/a	Good - Dead	Y-M	Good - Dead	No access to bases. Dense group. One dead stem within group circa 7m tall with 350mm stem diameter. - 20 trees 75-200mm dbh.			10+	C2
G102*	Pine (*Pinus sp*)	7	450	1	1	1	1	n/a	n/a	Dead	EM	Dead	Two dead stems one previously failed at 4m and the other at 8m. Low traffic area.		Fell	<10	U

Tree ID	Species	Estimated Height (m)	Stem Diameter (mm)	Canopy Spread (N)	Canopy Spread (S)	Canopy Spread (E)	Canopy Spread (W)	First Significant Branch (m)	Canopy Clearance (m)	Physiological Condition	Life Stage	Structural Condition	Condition Comments	Preliminary Management Comments	Works to Facilitate Proposed Development	Estimated Remaining Contribution	Category
G103*	Blackthorn (*Prunus spinosa*)	3	100	1	1	1	1	n/a	n/a	Good	SM	Good	No access to bases. Dense group.			10+	C2
G104*	Scots Pine (*Pinus sylvestris*), Blackthorn (*Prunus spinosa*), Hawthorn (*Crataegus monogyna*), Elder (*Sambucus nigra*)	16	500	5	5	5	5	n/a	n/a	Good - Fair	SM-EM	Good	Row of Scots pine overstory with hawthorn, elder and blackthorn understory. Good landscape value.			20+	B1,2
G105*	Scots Pine (*Pinus sylvestris*), Austrian Pine (*Pinus nigra*), Hawthorn (*Crataegus monogyna*), Blackthorn (*Prunus spinosa*)	18	700	6	6	6	6	n/a	n/a	Good	SM-M	Good	A row of predominantly Scots pine and black pine providing significant landscape value.			40+	A1,2
G106*	Hawthorn (*Crataegus monogyna*)	6	200	4	4	4	4	n/a	n/a	Good	EM	Good	Limited access to bases. Collectively of moderate value.			20+	B2

Tree ID	Species	Estimated Height (m)	Stem Diameter (mm)	Canopy Spread (N)	Canopy Spread (S)	Canopy Spread (E)	Canopy Spread (W)	First Significant Branch (m)	Canopy Clearance (m)	Physiological Condition	Life Stage	Structural Condition	Condition Comments	Preliminary Management Comments	Works to Facilitate Proposed Development	Estimated Remaining Contribution	Category
G107*	Hawthorn (*Crataegus monogyna*)	6	100	3	3	3	3	n/a	n/a	Good	SM	Good	Understory group.			10+	C2
G108*	Scots Pine (*Pinus sylvestris*), Hawthorn (*Crataegus monogyna*)	9	250	3	3	3	3	n/a	n/a	Good	Y-EM	Good	Understory group. Collectively of moderate quality.			20+	B2
G109*	White Poplar (*Populus alba*)	14	900	6	6	6	6	n/a	n/a	Good	EM-M	Good	Row of recently topped white poplar.			20+	B2
G110*	White Poplar (*Populus alba*), Hawthorn (*Crataegus monogyna*)	15	420	5	5	5	5	n/a	n/a	Good	SM	Good	Limited access to bases. Predominantly semi mature white poplar.			20+	B2
G111*~~q~~	Scots Pine (*Pinus sylvestris*), Maritime Pine (*Pinus pinaster*), Hawthorn (*Crataegus monogyna*)	12	400	4	4	4	4	n/a	n/a	Good	SM	Good	Plantation group of pine with scattered understory of hawthorn. Provides good landscape value. Average spacing of 1.5m. - 30 trees 75-200mm dbh and 40 trees 210-400mm dbh in a 30m strip.		Fell in part as per TPRP.	20+	B2

Tree ID	Species	Estimated Height (m)	Stem Diameter (mm)	Canopy Spread (N)	Canopy Spread (S)	Canopy Spread (E)	Canopy Spread (W)	First Significant Branch (m)	Canopy Clearance (m)	Physiological Condition	Life Stage	Structural Condition	Condition Comments	Preliminary Management Comments	Works to Facilitate Proposed Development	Estimated Remaining Contribution	Category
W112*	Beech (*Fagus sylvatica*), Wild Cherry (*Prunus avium*), Sycamore (*Acer pseudoplatanus*), Hawthorn (*Crataegus monogyna*)	22	800	7	7	7	7	n/a	n/a	Good - Dead	Y-M	Good - Dead	Norway maple, black pine, lime, elder, ash, Elm. Mixed woodland group providing significant landscape value. Trees in varying condition including a number of dead/dying trees adjacent to road.	Undertake detailed tree safety survey adjacent to road. (< 3 months)	Fell in part as per TPRP.	40+	A1,2
G113*	Hawthorn (*Crataegus monogyna*), Sycamore (*Acer pseudoplatanus*)	6	100	3	3	3	3	n/a	n/a	Good - Dead	Y-SM	Good - Dead	No access to bases. Dense understory group. One dead tree within group circa 7m tall and 300mm dbh. 30 trees @75-200mm dbh.			10+	C2
G114*	Sycamore (*Acer pseudoplatanus*)	14	450	6	6	6	6	n/a	n/a	Good - Dead	SM-EM	Good - Dead	No access to bases. Several dead/dying trees within group. Adjacent to road.	Undertake detailed tree safety survey of trees adjacent to road. (< 3 months)		20+	B2
H115*	Hawthorn (*Crataegus monogyna*)	4	70	2	2	2	2	n/a	n/a	Good	Y	Good	Recently planted hawthorn hedge.			10+	C2

Tree ID	Species	Estimated Height (m)	Stem Diameter (mm)	Canopy Spread (N)	Canopy Spread (S)	Canopy Spread (E)	Canopy Spread (W)	First Significant Branch (m)	Canopy Clearance (m)	Physiological Condition	Life Stage	Structural Condition	Condition Comments	Preliminary Management Comments	Works to Facilitate Proposed Development	Estimated Remaining Contribution	Category
G116*	Sycamore (*Acer pseudoplatanus*), Hawthorn (*Crataegus monogyna*)	12	200	4	4	4	4	n/a	n/a	Fair - Dead	Y-SM	Good - Dead	No access to bases. Sycamore showing minor to moderate crown sparsity and dieback with one dead tree in group.	Consider fFell dead tree (< 3 months)		10+	C2
H117*	Hawthorn (*Crataegus monogyna*), Blackthorn (*Prunus spinosa*), Sycamore (*Acer pseudoplatanus*), Other	2	100	1	1	1	1	n/a	n/a	Good	SM	Good	Privet. Mixed hedge. - 30 trees 75-200mm dbh.			10+	C2
G118*	Sycamore (*Acer pseudoplatanus*)	14	450	6	6	6	6	n/a	n/a	Good	SM-EM	Good	Ivy covered. Limited access to bases.		Fell	20+	B1,2
G119*	Scots Pine (*Pinus sylvestris*), Sycamore (*Acer pseudoplatanus*)	6	130	2	2	2	2	n/a	n/a	Good - Dead	Y	Good - Dead	Predominantly planted Scots pine. A number of dead/dying trees within group. Low traffic area adjacent to arable fields. - 40 trees 75-200mm dbh per 30m.		Fell in part as per TPRP.	10+	C2
G120*	Common Oak (*Quercus robur*), Hawthorn (*Crataegus monogyna*), Field Maple (*Acer campestre*)	7	200	3	3	3	3	n/a	n/a	Good	Y	Good	Mixed planted row. - 15 trees 75-200mm per 30m.			10+	C1,2

Tree ID	Species	Estimated Height (m)	Stem Diameter (mm)	Canopy Spread (N)	Canopy Spread (S)	Canopy Spread (E)	Canopy Spread (W)	First Significant Branch (m)	Canopy Clearance (m)	Physiological Condition	Life Stage	Structural Condition	Condition Comments	Preliminary Management Comments	Works to Facilitate Proposed Development	Estimated Remaining Contribution	Category
G121*	Hawthorn (*Crataegus monogyna*), Common Oak (*Quercus robur*), Apple (*Malus sp*), Hybrid black poplar (*Populus x canadensis*)	11	210	4	4	4	4	n/a	n/a	Good	Y-SM	Good	Limited access to bases. Circa 25 trees <210mm dbh.			10+	C2
G122*	Scots Pine (*Pinus sylvestris*)	15	450	5	5	5	5	n/a	n/a	Good	EM	Good	Avenue of Scots pine. Good landscape value. Several dead/dying trees within group. Low traffic area on boundary of arable field.	If land frequency increases consider fell dead/dying trees.		20+	B1,2
G123*	Austrian Pine (*Pinus nigra*), Scots Pine (*Pinus sylvestris*), Hybrid black poplar (*Populus x canadensis*)	20	740	7	7	7	7	n/a	n/a	Good - Dead	SM-M	Good - Dead	Row of predominantly black pine providing significant landscape value. A number of dead/dying trees within group. Low traffic area.	Consider fFell dead/dying trees if land frequency increases.		40+	A1,2
G124*	Austrian Pine (*Pinus nigra*), White Poplar (*Populus alba*), Field Maple (*Acer campestre*), Hawthorn (*Crataegus monogyna*)	22	800	7	7	7	7	n/a	n/a	Good	EM-M	Good - Fair	A row of predominantly black pine providing significant landscape value.			40+	A1,2

Tree ID	Species	Estimated Height (m)	Stem Diameter (mm)	Canopy Spread (N)	Canopy Spread (S)	Canopy Spread (E)	Canopy Spread (W)	First Significant Branch (m)	Canopy Clearance (m)	Physiological Condition	Life Stage	Structural Condition	Condition Comments	Preliminary Management Comments	Works to Facilitate Proposed Development	Estimated Remaining Contribution	Category
G125*	Field Maple (*Acer campestre*), Hawthorn (*Crataegus monogyna*), White Poplar (*Populus alba*), Austrian Pine (*Pinus nigra*)	18	450	6	6	6	6	n/a	n/a	Good	SM-EM	Good	Scots pine. Mixed group providing good landscape value.			20+	B1,2
G126*	Austrian Pine (*Pinus nigra*), Hawthorn (*Crataegus monogyna*), Hybrid black poplar (*Populus x canadensis*), Elder (*Sambucus nigra*)	20	750	7	7	7	7	n/a	n/a	Good	EM-M	Good	Scots pine. Predominantly a row of early mature to mature black pine providing significant landscape value. Scattered understory of hawthorn and elder.			40+	A1,2
G127*	Austrian Pine (*Pinus nigra*), Hawthorn (*Crataegus monogyna*), Hybrid black poplar (*Populus x canadensis*)	20	840	6	6	6	6	n/a	n/a	Good	EM-M	Good	Predominantly a row of early mature to mature black pine providing significant landscape value. Scattered understory of hawthorn.			40+	A1,2
G128*	Scots Pine (*Pinus sylvestris*), Hawthorn (*Crataegus monogyna*), Fir (*Abies sp*), European Larch (*Larix decidua*)	13	440	5	5	5	5	n/a	n/a	Good	SM	Good	Mixed species group. Good landscape value. Best location for 30m buffer. 25 trees <200mm dbh. 5 trees 210-400mm dbh. 1 tree >410-600mm dbh.			20+	B2

Tree ID	Species	Estimated Height (m)	Stem Diameter (mm)	Canopy Spread (N)	Canopy Spread (S)	Canopy Spread (E)	Canopy Spread (W)	First Significant Branch (m)	Canopy Clearance (m)	Physiological Condition	Life Stage	Structural Condition	Condition Comments	Preliminary Management Comments	Works to Facilitate Proposed Development	Estimated Remaining Contribution	Category
G129*	Scots Pine (*Pinus sylvestris*), Austrian Pine (*Pinus nigra*), Hybrid black poplar (*Populus x canadensis*)	20	640	7	7	7	7	n/a	n/a	Good - Dead	SM-M	Good - Dead	Several dead/dying trees within group. Low traffic area in arable field. A row of predominantly black pine providing significant landscape value.	Consider fFell dead/dying trees if land frequency increases.		40+	A2
T130*	White Willow (*Salix alba*)	18	1890	5	6	13	3	2.0/E	0	Good	A	Poor	Ancient based on 1432mm stem girth parameters for crack willow. Apical dieback with good lower crown formation (retrenchment). Significant adaptive growth of stem base. Contact wounding to buttressing with peripheral woundwood formation. Major deadwood in significant volumes. Significant split to second order limb east. Major exposure of inner wood, circa 4mx500mm. Limb partially failed with apices in contact with ground- Several cracks visible in main stem. Likely mix of rot types to exposed inner wood substrate. Tree showing high vitality.			40+	A3
T131*	Ash (*Fraxinus excelsior*)	12	640,320	6	5	5	5	2.5/SW	2	Good	EM	Fair	Limited access to base due to barbed wire. viewed from west only. Two likely ash coppice in proximity. Significant stool development. Decay of eastern base visible, adaptive growth. Dense ivy preventing view of mid to upper stems. Leaf density and branching pattern normal.			20+	B1,2,3

Tree ID	Species	Estimated Height (m)	Stem Diameter (mm)	Canopy Spread (N)	Canopy Spread (S)	Canopy Spread (E)	Canopy Spread (W)	First Significant Branch (m)	Canopy Clearance (m)	Physiological Condition	Life Stage	Structural Condition	Condition Comments	Preliminary Management Comments	Works to Facilitate Proposed Development	Estimated Remaining Contribution	Category
T132 *	Ash (*Fraxinus excelsior*)	14	600	6	8	6	8	3.0/W	2.5	Fair	EM	Poor	No access to base due to barbed wire. Moderate crown sparsity of upper northern crown. Minor crown sparsity surrounding. Dessicated fungal fruiting bodies on second order limb south at circa 3.5m at third to fourth order limb union. High likelihood of failure for circa 50% of crown.	Consider e~~E~~xtensive crown reduction/ pollard if land use changes.		20+	B3
T133 *	Ash (*Fraxinus excelsior*)	28	1500	11	9	10	11	7.0/N	2	Good	A	Good	Potentially ancient due to girth. No access to base due to barbed wire. Dense ivy from circa 2m obstructing view. Significant volumes of major deadwood in crown, likely previous significant limb shedding. Leaf density and branching pattern normal. Small cavities visible with good woundwood. Hung up deadwood visible. Significant tree, dominant landscape feature.			40+	A1,2,3
T134 *	Ash (*Fraxinus excelsior*)	16	1100	2	9	6	9	0.5/N	2	Good	V	Fair	No access to base due to barbed wire. Co to sub-dominant with neighbouring ash north. Significant buttress development, circa 2.6m in diameter. Cavity at base north, decay of inner wood, significant adaptive growth of stem. Leaf density and branching pattern normal. Previous second order stem failure east at circa 4m, significant deadwood. Veteran tree on this basis. Retained, stub circa 2mx350mm.			40+	A3

Tree ID	Species	Estimated Height (m)	Stem Diameter (mm)	Canopy Spread (N)	Canopy Spread (S)	Canopy Spread (E)	Canopy Spread (W)	First Significant Branch (m)	Canopy Clearance (m)	Physiological Condition	Life Stage	Structural Condition	Condition Comments	Preliminary Management Comments	Works to Facilitate Proposed Development	Estimated Remaining Contribution	Category
T135 *	Ash (*Fraxinus excelsior*)	12	620	6	8	6	7	3.5/W	1.5	Fair	M	Good	No access to base due to barbed wire. Significant ivy establishment sprouting photosynthetic material.	Consider ~~S~~sever ivy (< 1 month)		20+	B1,2
T136 *	Ash (*Fraxinus excelsior*)	15	1200	4	5	6	4	4.0/NW	2	Fair	V	Good	No access due to barbed wire. Significant buttressing development, 4.2m in diameter. Stags head development, good crown retrenchment/lower crown formation despite significant ivy establishment on stem. Veteran tree.	~~S~~Consider sever ivy (< 1 month)		40+	A3
T137 *	Ash (*Fraxinus excelsior*)	11	900	1	6	2	12	4.5/S	2	Good	V	Fair	No access due to barbed wire. Dense ivy establishment on main stem. - Previous stem failure at circa 5m. No visibility of wound due to ivy. Second order limb now apical leader. Cavity formation of buttress south with good adaptive growth. Stem failure considered likely significant veteran feature.	Consider ~~S~~sever ivy (< 1 month)		40+	A3
T138 *	Ash (*Fraxinus excelsior*)	14	1100	7	5	7	9	0.5/N	3	Good	V	Fair	No access due to barbed wire. Dense ivy across main stem and branch scaffold limiting visibility. - Significant buttress development, circa 3m in diameter. Likely previous stem failure at circa 6m. Ivy entirely obstructing view. Likely veteran tree due to stool and suspected significant exposure of inner wood substrate.	Consider ~~S~~sever ivy (< 1 month)		40+	A3

Tree ID	Species	Estimated Height (m)	Stem Diameter (mm)	Canopy Spread (N)	Canopy Spread (S)	Canopy Spread (E)	Canopy Spread (W)	First Significant Branch (m)	Canopy Clearance (m)	Physiological Condition	Life Stage	Structural Condition	Condition Comments	Preliminary Management Comments	Works to Facilitate Proposed Development	Estimated Remaining Contribution	Category
T139 *	Ash (*Fraxinus excelsior*)	23	1000	8	6	7	7	4.0/SW	2	Fair	V	Fair	No access due to barbed wire. Dense ivy across main stem and branch scaffold severely limiting visibility. - Apical eastern crown with significant gap, likely previous limb failure. - Minor crown sparsity. Dessicated, likely Inonotus hispidus, at base. Unknown point of attachment. Part failure of crown likely. Previous failure of main stem at circa 8m, wound circa 700mm in diameter, significant decay visible.	Consider ~~S~~sever ivy (< 1 month)		40+	A3
T140 *	Ash (*Fraxinus excelsior*)	14	850	1	5	5	5	1.0/S	2	Good	M	Fair	No access due to barbed wire. Dense ivy across main stem and branch scaffold limiting visibility. - Crown apices with dieback, showing significant stags head, leaf density and branching pattern immediately below normal. Assessment of nonfiscal quality requires removal of ivy. Veteran tree on the basis of significant deadwood from stags head, with good future longevity likely by crown vitality.	Consider ~~S~~sever ivy (< 1 month)		40+	A3
T141 *	Ash (*Fraxinus excelsior*)	8	1000	6	6	7	1	5.0/SW	3	Fair	V	Fair	No access to base due to barbed wire. Significant ivy establishment obstructing visibility of stem and branch scaffold. - Previous stem failure at circa 7m. Ivy entirely shrouding main stem. Second order limb at circa 4m supporting entire live crown. Likely functional unit. Veteran tree on this basis. Stump at base to immediate south.	Consider ~~S~~sever ivy (< 1 month)		40+	A3

Tree ID	Species	Estimated Height (m)	Stem Diameter (mm)	Canopy Spread (N)	Canopy Spread (S)	Canopy Spread (E)	Canopy Spread (W)	First Significant Branch (m)	Canopy Clearance (m)	Physiological Condition	Life Stage	Structural Condition	Condition Comments	Preliminary Management Comments	Works to Facilitate Proposed Development	Estimated Remaining Contribution	Category
T142 *	Ash (*Fraxinus excelsior*)	12	1000	4	4	4	4	4.0/W	2	Dead	M	Poor	No access to base due to barbed wire. Dense ivy across stem and branch scaffold limiting visibility. Circa 95% crown dieback.	Consider c~~C~~reate monolith at 5m. (When funds allow)	~~Cut back to clear proposed access route to the west.~~	<10	U1
T143 *	White Willow (*Salix alba*)	18	1600	4	4	12	1	5.0/SE	4	Fair	A	Poor	Ancient based on 1432mm stem girth parameters for crack willow. Limited access due to barbed wire and fencing. Significant cavity at base north, approx. 1m deep, 500mm wide, circa 3m in length. Significant decay\dysfunction of exposed wood. No woundwood formation visible. Limited adaptive swelling visible. Minor apical crown dieback. Dense ivy across main stem limiting visibility. Lean east, no corrective growth. canopy gap west visible. Potentially creeping failure. - Sounding mallet test where possible north, wood density sounds poor. Severing ivy and topping tree likely to preserve habitat and longevity whilst preventing catastrophic failure. Target of highway. Not considered veteran due to poor longevity of inner wood substrate. Requires remedial works to prevent catastrophic failure.	~~C~~Create pollard/ monolith to approx 8m and sever ivy. (< 1 month)	~~Cut back to clear proposed access gateway to east (small diameter branches only)~~	40+	A3

Tree ID	Species	Estimated Height (m)	Stem Diameter (mm)	Canopy Spread (N)	Canopy Spread (S)	Canopy Spread (E)	Canopy Spread (W)	First Significant Branch (m)	Canopy Clearance (m)	Physiological Condition	Life Stage	Structural Condition	Condition Comments	Preliminary Management Comments	Works to Facilitate Proposed Development	Estimated Remaining Contribution	Category
T144 *	White Willow (*Salix alba*)	28	1480	7	7	7	7	7.0/W	6	Good	A	Good	Limited access to base due to barbed wire. Stem measured above significant swelling at 1.5m north. Significant ivy establishment across main stem and second order limbs. Deadwood throughout crown, normal for species and age. Good crown form and leaf density. Ancient based on 1432mm stem girth parameters for crack willow.	Consider ~~S~~sever ivy (< 12 months)		40+	A3
T145 *	Hawthorn (*Crataegus monogyna*)	5	300	2	2	1	2		1	Poor	M	Fair	No access to base due to barbed wire. Dense ivy almost entirely shrouding live crown. Removal of ivy likely to facilitate recovery.	Consider ~~S~~sever ivy (< 1 month)		10+	C1
T146 *	Hawthorn (*Crataegus monogyna*)	3	250	3	1	1	1	1.5/N	1.5	Dead	EM	Poor	One live epicormic limb to base. Likely dead due to ivy dominance.			<10	U
T147 *	Ash (*Fraxinus excelsior*)	23	850,1000, 450	12	6	6	6	6.0/N	7	Fair	A	Fair	Potentially ancient due to girth. No access to base due to barbed wire and vegetation. Apical crown dieback of northern crown, surrounding crown vitality normal. Major deadwood in crown, atypical for species and age. Sever ivy to enable epicormic development of lower crown. Three stems arising from stool. Minor bark inclusion. Apical crown with	Consider ~~S~~sever ivy to enable epicormic development of lower crown (< 12 months)		20+	B3

Tree ID	Species	Estimated Height (m)	Stem Diameter (mm)	Canopy Spread (N)	Canopy Spread (S)	Canopy Spread (E)	Canopy Spread (W)	First Significant Branch (m)	Canopy Clearance (m)	Physiological Condition	Life Stage	Structural Condition	Condition Comments	Preliminary Management Comments	Works to Facilitate Proposed Development	Estimated Remaining Contribution	Category
													deviation of branching pattern and high leaf sparsity. Mid to lower crown with normal density. With the exception of second-order limb north at circa 6m with dieback. Lack of vitality to preserve life expectancy cause for downgrade.				
T148 *	Ash (*Fraxinus excelsior*)	23	800,850,150,250	8	7	5	7	2.0/N	2	Fair	M	Fair	No access to base due to barbed wire and vegetation. Multi stemmed from significant stool. Minor bark inclusions. Crown with moderate sparsity. Dense ivy significantly limiting visibility. Downgraded due to physiological condition.	Consider s~~S~~ever ivy (< 12 months)		20+	B1,2
T149 *	White Willow (*Salix alba*)	11	300	1	5	3	3	1.0/E	2	Good	SM	Fair	No access to base due to barbed wire and vegetation. Ivy establishment across stem significantly limiting visibility. Lean south, likely light foraging due to suppression by dominant ash north.			20+	B2
T150 *	White Willow (*Salix alba*)	13	400	4	4	2	4	1.0/N	2	Good	SM	Fair	No access to base due to barbed wire and vegetation. Ivy establishment across stem significantly limiting visibility. Minor lean south, becoming codominant with ash east.			20+	B2

Tree ID	Species	Estimated Height (m)	Stem Diameter (mm)	Canopy Spread (N)	Canopy Spread (S)	Canopy Spread (E)	Canopy Spread (W)	First Significant Branch (m)	Canopy Clearance (m)	Physiological Condition	Life Stage	Structural Condition	Condition Comments	Preliminary Management Comments	Works to Facilitate Proposed Development	Estimated Remaining Contribution	Category
T151 *	Ash (*Fraxinus excelsior*)	19	1000	6	6	6	6	0.1/W	1.5	Fair	OM	Fair	No access to base due to barbed wire and vegetation. Ivy establishment across stem limiting visibility. Significant deviation in branching pattern, apical crown dieback, moderate crown sparsity. Epicormic lower crown formation, unlikely sufficient considering size of total crown volume. Downgraded due to physiological condition.			20+	B1,2
T152 *	Ash (*Fraxinus excelsior*)	18	800	5	5	5	5	7.0/NE	4	Dead	M	Poor	Significant dead tree.	Consider create monolith at approx 6m. (< 1 month)		<10	U1
T153 *	Ash (*Fraxinus excelsior*)	8	200	1	1	1	1	0.5/E	0.5	Poor	SM	Poor	No access to base due to barbed wire and vegetation. Dead crown, epicormic flushing at base. Likely cause of ash dieback.	Consider fFell and remove arisings. (< 3 months)		<10	U
T154 *	Ash (*Fraxinus excelsior*)	8	190	3	3	3	3	2.0/N	1.5	Dead	SM	Poor	No access to base due to barbed wire and vegetation. Ivy establishment across stem significantly limiting visibility. Over 95% crown dieback, minor stem epicormic development.	Consider fFell and remove arisings. (< 3 months)		<10	U

Tree ID	Species	Estimated Height (m)	Stem Diameter (mm)	Canopy Spread (N)	Canopy Spread (S)	Canopy Spread (E)	Canopy Spread (W)	First Significant Branch (m)	Canopy Clearance (m)	Physiological Condition	Life Stage	Structural Condition	Condition Comments	Preliminary Management Comments	Works to Facilitate Proposed Development	Estimated Remaining Contribution	Category
T155 *	White Willow (*Salix alba*)	12	600	3	4	5	6	1.0/E	3	Poor	M	Poor	No access to base due to barbed wire and vegetation. Approx 80% crown dieback, significant deviation in branching pattern.	Consider create monolith at approx. 5m. (< 3 months)		<10	U
T156 *	White Willow (*Salix alba*)	10	250,200	4	4	4	4	1.0/N	3	Fair	SM	Good	No access to base due to barbed wire and vegetation.			10+	C1,2
T157 *	White Willow (*Salix alba*)	21	1200	12	8	3	3	5.0/N	5	Fair	M	Fair	No access to base due to barbed wire and vegetation. Ivy establishment across stem significantly limiting visibility. Apical crown dieback. Base submerged. Alder established at base. Volume of deadwood atypical for age, likely caused by decline in vitality. Species with poor durability of inner wood substrate.	Consider sSever ivy (< 12 months)		10+	C1,2
T158 *	White Willow (*Salix alba*)	22	1000	7	8	3	10	2.0/N	3	Fair	M	Fair	No access to base due to barbed wire and vegetation. Minor apical crown dieback visible. Major deadwood present in crown considered of normal volume for species and age. Wasps nest or similar activity in small cavity at 1m north on main stem. Adaptive growth at cavity visible.			20+	B1,2

Tree ID	Species	Estimated Height (m)	Stem Diameter (mm)	Canopy Spread (N)	Canopy Spread (S)	Canopy Spread (E)	Canopy Spread (W)	First Significant Branch (m)	Canopy Clearance (m)	Physiological Condition	Life Stage	Structural Condition	Condition Comments	Preliminary Management Comments	Works to Facilitate Proposed Development	Estimated Remaining Contribution	Category
T159 *	Ash (*Fraxinus excelsior*)	6	150	0.5	0.5	0.5	0.5			Poor	SM	Dead	No access to base due to barbed wire and vegetation. Ivy establishment across stem significantly limiting visibility. Significant crown dieback. Likely cause of ash dieback.	Consider fFell and remove arisings. (< 3 months)		<10	U
T160 *	Hawthorn (*Crataegus monogyna*)	4	100	2	1	1	1		0	Good	SM	Good	No access to base due to barbed wire and vegetation. Establishing in understory at boundary.			10+	C1
T161 *	Ash (*Fraxinus excelsior*)	12	350	5	5	5	5	2.0/S	2	Good	SM	Good	No access to base due to barbed wire and vegetation. Ivy establishment across stem significantly limiting visibility. Leaf density and branching pattern normal.	Consider sSever ivy (< 3 months)		20+	B1,2
T162 *	Hawthorn (*Crataegus monogyna*)	5	75	3	3	3	3		0	Fair	SM	Good	No access to base due to dense brambles, forming shroud over crown.	Consider Cut back brambles. (< 12 months)		10+	C1,2
T163 *	Hawthorn (*Crataegus monogyna*)	5	90,140,120	3	2	2	2	0.5/N	0.5	Fair	SM	Good	Multistemmed from ground level. Contact wounding partially and fully occluded. Dead young hawthorn to immediate south.			10+	C1,2

Tree ID	Species	Estimated Height (m)	Stem Diameter (mm)	Canopy Spread (N)	Canopy Spread (S)	Canopy Spread (E)	Canopy Spread (W)	First Significant Branch (m)	Canopy Clearance (m)	Physiological Condition	Life Stage	Structural Condition	Condition Comments	Preliminary Management Comments	Works to Facilitate Proposed Development	Estimated Remaining Contribution	Category
T164 *	Ash (*Fraxinus excelsior*)	15	840	6	9	5	6	3.0/S	1	Good	V	Fair	Veteran tree. Open cavity at base west, significant adaptive swelling with minor peripheral woundwood. Cavity 900mmx900mm. Second order limb east with significant hollowing visible with multiple cavity openings. Good peripheral woundwood. Good crown vitality, branching pattern and leaf density normal. Hung up deadwood.			40+	A3
T165 *	Ash (*Fraxinus excelsior*)	19	760	9	8	9	5	5.0/S	4	Good	M	Good	Minor twig dieback in crown. Major dead limb west at circa 8m. Shedding collars with varying levels of occlusion.			40+	A2
T166 *	Ash (*Fraxinus excelsior*)	17	590	8	8	8	8	3.5/E	2	Fair	M	Good	Minor leaf sparsity, branching pattern normal. No obvious signs or symptoms of ash dieback. Dense brambles at base limiting inspection.			20+	B1,2
T167 *	Ash (*Fraxinus excelsior*)	22	890	10	10	10	4	4.0/N	2	Good	M	Good	Locally dominant, significant leaf density for species. Normal volume of deadwood within crown.			40+	A1,2

Tree ID	Species	Estimated Height (m)	Stem Diameter (mm)	Canopy Spread (N)	Canopy Spread (S)	Canopy Spread (E)	Canopy Spread (W)	First Significant Branch (m)	Canopy Clearance (m)	Physiological Condition	Life Stage	Structural Condition	Condition Comments	Preliminary Management Comments	Works to Facilitate Proposed Development	Estimated Remaining Contribution	Category
T168 *	Ash (*Fraxinus excelsior*)	20	530	8	8	3	7	4.0/N	2	Good	M	Good	Dominant to neighbouring ash west. Good leaf density for species. Major deadwood, normal for species and age.			40+	A2
T169 *	Ash (*Fraxinus excelsior*)	17	360,280,430	7	7	0.5	10	1.0/E	2	Good	EM	Fair	Structurally suppressed by ash east. Multistemmed from stool, minor bark inclusion. Cavity north at circa 3m, likely woodpecker hole. Fruiting bodies on limb central to crown, likely Daldinia concentrica.			20+	B1,2
T170 *	Ash (*Fraxinus excelsior*)	17	330,110,130,110	0.5	4	1	5	4.0/W	3	Good	SM	Fair	No access to base due to field layer. Multistemmed from ground level. Structurally suppressed. Good leaf density. Major deadwood in crown, likely due to suppression.			20+	B1,2
T171 *	Ash (*Fraxinus excelsior*)	11	180,180,110	2	1	4	6	3.0/N	2	Good	SM	Poor	Significant stem failure from tree south has removed northern crown to approx 4m. Stem hung up, circa 10mx500mm.			10+	C1,2
T172 *	Ash (*Fraxinus excelsior*)	19	300,430,600	1	8	7	5	1.0/N	2	Poor	M	Poor	Primary stem failure north at circa 1.5m, barber-chair type failure. Stem east dead. Surrounding stems with moderate sparsity, no deviation in branching pattern. Dense ivy across now dominant stem. Deadwood in crown.	Consider s~~S~~ever ivy (< 12 months)		20+	B2,3

Tree ID	Species	Estimated Height (m)	Stem Diameter (mm)	Canopy Spread (N)	Canopy Spread (S)	Canopy Spread (E)	Canopy Spread (W)	First Significant Branch (m)	Canopy Clearance (m)	Physiological Condition	Life Stage	Structural Condition	Condition Comments	Preliminary Management Comments	Works to Facilitate Proposed Development	Estimated Remaining Contribution	Category
T173 *	Ash (*Fraxinus excelsior*)	18	500	2	5	10	9	3.0/E	3	Good	M	Good	Codominant in canopy. Minor deadwood throughout crown, normal for species. Dense ivy across mid stem limiting visibility.			20+	B1,2
T174 *	Ash (*Fraxinus excelsior*)	15	310,350,300,280,300,290	8	7	8	8	0.1/SW	2	Good	EM	Fair	Two trees in proximity. Dense brambles preventing access. No obvious stool formation. Minor bark inclusions. Minor deadwood in crown, typical of species. Collars with likely previous limb failures showing dysfunction of exposed wood, no woundwood formation.			20+	B2
T175 *	Ash (*Fraxinus excelsior*)	12	230,250	1	6	6	6	3.0/E	2	Good	SM	Fair	No access due to dense brambles. Two trees in immediate proximity. Tree southeast subdominant.			10+	C1,2
T176 *	White Willow (*Salix alba*)	15	400,400	4	10	8	8	1.0/S	1	Good	EM	Poor	No access. Codominant from circa 1m, significant bark inclusion. Locally dominant.			10+	C1,2

Tree ID	Species	Estimated Height (m)	Stem Diameter (mm)	Canopy Spread (N)	Canopy Spread (S)	Canopy Spread (E)	Canopy Spread (W)	First Significant Branch (m)	Canopy Clearance (m)	Physiological Condition	Life Stage	Structural Condition	Condition Comments	Preliminary Management Comments	Works to Facilitate Proposed Development	Estimated Remaining Contribution	Category
T177 *	Apple (*Malus sp*)	12	350	4	4	4	4	2.0/N	0.5	Good	EM	Good	No access, within dense bramble/boundary scrub. Good leaf density and branching pattern.			20+	B1,2
T178 *	White Willow (*Salix alba*)	10	250	1	2	1	2	5.0/W	5	Fair	SM	Fair	No access to base due to barbed wire and vegetation. Ivy establishment across stem significantly limiting visibility. Dead ivy covered stem to immediate south of base, circa 6mx100m.			10+	C1,2
T179 *	White Willow (*Salix alba*)	20	900	2	8	10	5	2.0/E	4	Good	M	Fair	No access to base due to barbed wire and vegetation. Ivy establishment across stem significantly limiting visibility. Minor tip dieback in crown. Majority of crown with normal branching pattern and leaf density. Significant landscape feature.			40+	A2
T180 *	Hawthorn (*Crataegus monogyna*)	5	200,200,220	4	4	2	1	0.1/S	1	Fair	EM	Fair	Dense ivy concealing crown. Three stems arising from ground level, no obvious stool, minor bark inclusions. Contact wounding to stems, cavity with decay, little to no peripheral woundwood formation.	Consider sSever ivy (< 3 months)		10+	C1,2

Tree ID	Species	Estimated Height (m)	Stem Diameter (mm)	Canopy Spread (N)	Canopy Spread (S)	Canopy Spread (E)	Canopy Spread (W)	First Significant Branch (m)	Canopy Clearance (m)	Physiological Condition	Life Stage	Structural Condition	Condition Comments	Preliminary Management Comments	Works to Facilitate Proposed Development	Estimated Remaining Contribution	Category
G181*	Hawthorn (*Crataegus monogyna*), Blackthorn (*Prunus spinosa*), Elder (*Sambucus nigra*),	4	150	3	3	3	3	n/a	n/a	Good	Y-SM	Good	Boundary group, dense ivy throughput. Rose species present. - privet. - Density higher north. Likely average of one tree a metre approx @75-200 range.		~~Cut back to west to clear site access/ gateway.~~	10+	C2
G182*	Elder (*Sambucus nigra*)	6	100	2	2	2	2	n/a	n/a	Good - Fair	Y-SM	Good - Fair	Intermittent sparse group in understory. Circa five trees @75-200 range.			10+	C1,2
G183*	Hawthorn (*Crataegus monogyna*)	6	150	3	3	3	3	n/a	n/a	Good - Fair	Y-SM	Good - Fair	No access to base due to barbed wire and vegetation. Ivy establishment across stem significantly limiting visibility. Dense brambles throughout. Circa three trees @ 75-200 range.	Consider s~~S~~ever ivy (~~When funds allow~~)		10+	C1,2
G184*	Hawthorn (*Crataegus monogyna*)	6	150	3	3	3	3	n/a	n/a	Good - Fair	Y-SM	Good - Fair	No access to base due to barbed wire and vegetation. Ivy establishment across stem significantly limiting visibility. Dense bramble throughout.	Consider s~~S~~ever ivy ~~(When funds allow)~~		10+	C1,2
G185*	White Willow (*Salix alba*), Common Alder (*Alnus glutinosa*)	30	400	6	6	6	6	n/a	n/a	Good - Fair	SM-EM	Good - Fair	No access to base due to watercourse. Viewed from east only. One tree every circa 4m. Stand density likely to have caused high top height to diameter ratios. Significant landscape feature. Considered high future potential.			40+	A2

Tree ID	Species	Estimated Height (m)	Stem Diameter (mm)	Canopy Spread (N)	Canopy Spread (S)	Canopy Spread (E)	Canopy Spread (W)	First Significant Branch (m)	Canopy Clearance (m)	Physiological Condition	Life Stage	Structural Condition	Condition Comments	Preliminary Management Comments	Works to Facilitate Proposed Development	Estimated Remaining Contribution	Category
G186*	Hawthorn (*Crataegus monogyna*), Other	5	150	2	2	2	2	n/a	n/a	Fair - Poor	Y-SM	Fair - Poor	Group of ten hawthorn, well spaced. Majority with moderate crown sparsity. Vigorous growth of field layer at bases.			10+	C2
G187*	Hawthorn (*Crataegus monogyna*), Elder (*Sambucus nigra*)	5	150	3	3	3	3	n/a	n/a	Good - Fair	Y-SM	Good - Fair	Established west of water course. Dense bramble.	Consider c~~C~~ut back brambles. (< 12 months)		10+	C2
G188*	Hawthorn (*Crataegus monogyna*), Other	5	150	3	3	3	3	n/a	n/a	Good - Fair	Y-SM	Good - Fair	Established to the east and west of water course.			10+	C2
G189*	Hawthorn (*Crataegus monogyna*), Elder (*Sambucus nigra*)	6	150	3	3	3	3	n/a	n/a	Good - Poor	Y-SM	Good - Poor	Likely remnant of field margin hedgerow. Elder declining, typical of species. Estimated 27 trees.			10+	C1,2
G190*	Hawthorn (*Crataegus monogyna*),	6	150	3	3	3	3	n/a	n/a	Good	Y-SM	Good	Sparse understory to ash. Estimated 16 features.			10+	C2

Tree ID	Species	Estimated Height (m)	Stem Diameter (mm)	Canopy Spread (N)	Canopy Spread (S)	Canopy Spread (E)	Canopy Spread (W)	First Significant Branch (m)	Canopy Clearance (m)	Physiological Condition	Life Stage	Structural Condition	Condition Comments	Preliminary Management Comments	Works to Facilitate Proposed Development	Estimated Remaining Contribution	Category
G191*	Hawthorn (*Crataegus monogyna*), Field Maple (*Acer campestre*), Hazel (*Corylus avellana*), Ash (*Fraxinus excelsior*)	11	300	4	4	4	4	n/a	n/a	Good	Y-SM	Good	Beech, wayfaring tree, buckthorn, elder. - Dense boundary scrub with overstory of ash, hazel and field maple. X6 overstory trees.			20+	B2
G192*	Hawthorn (*Crataegus monogyna*), Field Maple (*Acer campestre*), Hazel (*Corylus avellana*), Ash (*Fraxinus excelsior*)	11	300	3	3	3	3	n/a	n/a	Good	Y-SM	Good	Beech, wayfaring tree, dogwood, elder, privet. Dense boundary scrub with overstory of ash, hazel and field maple.			20+	B2
G193*	Elder (*Sambucus nigra*), Hawthorn (*Crataegus monogyna*),	4	150	1	1	1	1	n/a	n/a	Poor - Dead	EM	Fair - Poor	Sparse severely declining group of three elder and one hawthorn.			<10	U2
H194*	Other, Blackthorn (*Prunus spinosa*), Elder (*Sambucus nigra*), Hawthorn (*Crataegus monogyna*)	3	150	1	1	1	1	n/a	n/a	Good	Y-SM	Good	Estimated one tree every 500mm. Dense managed hedgerow. Privet and midland hawthorn present.		~~Fell in part as per TPRP.~~	10+	C1,2

Tree ID	Species	Estimated Height (m)	Stem Diameter (mm)	Canopy Spread (N)	Canopy Spread (S)	Canopy Spread (E)	Canopy Spread (W)	First Significant Branch (m)	Canopy Clearance (m)	Physiological Condition	Life Stage	Structural Condition	Condition Comments	Preliminary Management Comments	Works to Facilitate Proposed Development	Estimated Remaining Contribution	Category
G195*	Apple (*Malus sp*), Common Oak (*Quercus robur*), Elder (*Sambucus nigra*), Hawthorn (*Crataegus monogyna*)	4	150	3	3	3	3	n/a	n/a	Good	Y-SM	Good	Field margin scrub. Estimated one tree every 3m.			10+	C1,2
G196*	Silver Birch (*Betula pendula*), Common Oak (*Quercus robur*), Elder (*Sambucus nigra*), Hawthorn (*Crataegus monogyna*)	6	150	3	3	3	3	n/a	n/a	Good	Y-SM	Good	Field margin tree belt at canopy closure. Estimated one tree every 1m. Plum and wild cherry present.		Fell in part as per TPRP.	10+	C1,2
H197*	Damson (*Prunus domestica*), Wild Cherry (*Prunus avium*), Elder (*Sambucus nigra*), Hawthorn (*Crataegus monogyna*)	3	150	1	1	1	1	n/a	n/a	Good	Y-SM	Good	Managed hedgerow, western boundary to tree belt. Privet present.		Fell in part as per TPRP.	10+	C2
G198*	Elder (*Sambucus nigra*), Hawthorn (*Crataegus monogyna*)	6	150	3	3	3	3	n/a	n/a	Good	SM	Good	No access to barbed wire. Scrub group, inherent value of forage and habitat.			10+	C2

Tree ID	Species	Estimated Height (m)	Stem Diameter (mm)	Canopy Spread (N)	Canopy Spread (S)	Canopy Spread (E)	Canopy Spread (W)	First Significant Branch (m)	Canopy Clearance (m)	Physiological Condition	Life Stage	Structural Condition	Condition Comments	Preliminary Management Comments	Works to Facilitate Proposed Development	Estimated Remaining Contribution	Category
G199*	Ash (*Fraxinus excelsior*), Field Maple (*Acer campestre*), Elder (*Sambucus nigra*), Hawthorn (*Crataegus monogyna*)	8	300	4	4	4	4	n/a	n/a	Good	Y-SM	Good	No access due to cattle. Viewed at distance south. Three overstory trees. Remaining scrub boundary 75-200 range with approx. one tree per metre.			20+	B2
G200*	Elder (*Sambucus nigra*), Crack Willow (*Salix fragilis*),	6	100	3	3	3	3	n/a	n/a	Good	Y	Good	Wayfaring tree, dogwood, Dense thicket, canopy closure stage, no access. Dogwood and elder dominant. Very high density. Estimated to be one tree every 500mm.			10+	C2
G201*	Elder (*Sambucus nigra*), White Willow (*Salix alba*), Willow (*Salix sp*), Hawthorn (*Crataegus monogyna*)	12	200	5	5	5	5	n/a	n/a	Good	Y-SM	Good	Dense field margin scrub, no access. Buckthorn present. Inherent value as habitat and forage. Likely one tree every 1.5m.			10+	C1,2
G202*	Ash (*Fraxinus excelsior*), Other, Elder (*Sambucus nigra*), Hawthorn (*Crataegus monogyna*)	16	450	8	8	8	8	n/a	n/a	Good	Y-EM	Good	No access due to cattle and dense field layer. Viewed at distance. Five ash trees. Approx x 20 hawthorn and elder 75-200 range. Crown spread and branching pattern normal.			20+	B1,2

Tree ID	Species	Estimated Height (m)	Stem Diameter (mm)	Canopy Spread (N)	Canopy Spread (S)	Canopy Spread (E)	Canopy Spread (W)	First Significant Branch (m)	Canopy Clearance (m)	Physiological Condition	Life Stage	Structural Condition	Condition Comments	Preliminary Management Comments	Works to Facilitate Proposed Development	Estimated Remaining Contribution	Category
G203*	Hawthorn (*Crataegus monogyna*)	8	200	4	4	4	4	n/a	n/a	Good	Y-SM	Good	Intermittent field margin group, likely remnant hedgerow. 25 trees @ 75-200 range.		~~Fell in part as per TPRP.~~	10+	C1,2
W204*	Hawthorn (*Crataegus monogyna*), Wild Cherry (*Prunus avium*), Beech (*Fagus sylvatica*), Ash (*Fraxinus excelsior*)	18	400	3	3	3	3	n/a	n/a	Good - Dead	Y-SM	Good - Dead	No access, mixed conifer and broadleaved woodland. Sycamore and Pinus spp. Present. Symptoms of ash dieback visible.			20+	B1,2,3
G205*	Hawthorn (*Crataegus monogyna*),	5	200	3	3	3	3	n/a	n/a	Good - Fair	Y-SM	Good - Fair	Established as wood pasture. Few individuals with minor crown dieback.			10+	C1,2
G206*	Black Walnut (*Juglans nigra*), Wild Cherry (*Prunus avium*), Common Oak (*Quercus robur*), Ash (*Fraxinus excelsior*)	10	400	2	2	2	2	n/a	n/a	Good - Dead	Y-SM	Good - Dead	Beech, hornbeam, hawthorn, hazel, elder, plum. field maple, blackthorn. cherry laurel in tree guard. 2.1m gap in row, 3m between rows. 6 rows. Ash with significant symptoms of ash dieback. Sample plots: Row - 190, 160, 190, 200, 130, 120. Row - 220, 230, 180, 130, 130, 60. Very north of group with trees missing from first 5 rows. Row 1 two trees, row 2-5 four trees.		Fell in part as per TPRP.	20+	B2

Tree ID	Species	Estimated Height (m)	Stem Diameter (mm)	Canopy Spread (N)	Canopy Spread (S)	Canopy Spread (E)	Canopy Spread (W)	First Significant Branch (m)	Canopy Clearance (m)	Physiological Condition	Life Stage	Structural Condition	Condition Comments	Preliminary Management Comments	Works to Facilitate Proposed Development	Estimated Remaining Contribution	Category
T207 *	Common Oak (*Quercus robur*)	14	430	3	5	1	6	3.5/SW	3.5	Good	EM	Good	Single stemmed tree, ivy covers entirety of trunk. Minor deadwood. Previous pruning wounds on South at 0.5m. Situated along footpath, bordering arable fields			20+	B1,2
T208 *	Common Oak (*Quercus robur*)	14	390,470	6	1	5	5	3.5/N	3.5	Good	EM	Good	Single stemmed with ivy covering entirety of main stems. Minor deadwood. Situated along footpath, bordering arable fields			20+	B1,2
T209 *	Common Oak (*Quercus robur*)	17	880	9	2	5	8	1.0/NE	3.5	Good	M	Good	Ivy cover to 0-13m. Minor crown suppression from adjacent trees. Prominent in group			20+	B1,2
T210 *	Common Oak (*Quercus robur*)	17	810	5	5	7	5	4.0/SW	5	Good	M	Good	Ivy from 0-15m. Minor crown suppression from tree adjacent to the north.			20+	B1,2
T211 *	Scots Pine (*Pinus sylvestris*)	18	500	1	4	4	6	3.0/W	0.5	Good	M	Good	Slight easterly lean bias. Previous pruning. Minor deadwood			20+	B1,2

Tree ID	Species	Estimated Height (m)	Stem Diameter (mm)	Canopy Spread (N)	Canopy Spread (S)	Canopy Spread (E)	Canopy Spread (W)	First Significant Branch (m)	Canopy Clearance (m)	Physiological Condition	Life Stage	Structural Condition	Condition Comments	Preliminary Management Comments	Works to Facilitate Proposed Development	Estimated Remaining Contribution	Category
T212 *	Common Oak (*Quercus robur*)	7	270,240,180,200	2	2	2	2	2.0/N	2.5	Good	SM	Fair	Previous pruning. Wound bleeding, black exudate. Previous lateral wounds located on western aspects of Codominant stems. Substantial occlusion on wounds. Sound tested with sounding mallet = normal density			10+	C2
T213 *	Common Oak (*Quercus robur*)	17	1350	10	10	10	10	3.0/SW	1.5	Good	M	Good	Minor deadwood. Previous pruning. Ivy from 0-14m. Prominent tree, significant landscape and good example for species			40+	A1,2,3
T214 *	Common Oak (*Quercus robur*)	14	750	7	7	7	7	3.0/SW	2.5	Good	M	Good	Previous pruning on Eastern aspect. Good example of species. Significant landscape value			40+	A1,2
T215 *	Common Oak (*Quercus robur*)	8	420,370	4	4	4	4	1.0/S	3.5	Good	EM	Good	Co dominant stem. 200mm diameter wound on northern aspect. Substantial occlusion.			20+	B1,2
T216 *	Hybrid black poplar (*Populus x canadensis*)	22	1520	10	10	10	10	1.0/SW	0.5	Good	V	Good	Veteran tree. Minor deadwood. Woodpecker holes with possible bat roost potential.			40+	A1,2,3

Tree ID	Species	Estimated Height (m)	Stem Diameter (mm)	Canopy Spread (N)	Canopy Spread (S)	Canopy Spread (E)	Canopy Spread (W)	First Significant Branch (m)	Canopy Clearance (m)	Physiological Condition	Life Stage	Structural Condition	Condition Comments	Preliminary Management Comments	Works to Facilitate Proposed Development	Estimated Remaining Contribution	Category
T217 *	Hybrid black poplar (*Populus x canadensis*)	21	800,730,690	10	10	10	10	0.5/NW	3	Fair	OM	Fair	Moderate abundance of minor deadwood. Mainly at stem tips. Moderate foliage density. Multi stemmed.			10+	C2
T218 *	Hybrid black poplar (*Populus x canadensis*)	21	830,600, 610,790,750	10	10	10	10	0.5/SW	3	Poor	V	Poor	Veteran tree. Bracket fungi, presumed Polyporus squamosus. Large cavities and previous limb failure. Multi stemmed, possible bat roost potential. Bird nest present. Moderate abundance of minor deadwood at tips of branches.			40+	A1,2,3
T219 *	Hybrid black poplar (*Populus x canadensis*)	23	1600#	10	10	10	10	0.5/SE	0.5	Fair	OM	Poor	Multi stemmed, tightly formed compression forks. Crown dieback. Inaccessible at base.		Fell, consider creating monolith at 5-6m	10+	C2
T220 *	Scots Pine (*Pinus sylvestris*)	14	410	7	1	2	2	7.0/N	4	Good	SM	Fair	Wound with in grown barbed wire at 0.5 west on stem. Low to moderate occlusion. Previous pruning. Northern lean bias. Piling works 1m East of trunk.			10+	C2

Tree ID	Species	Estimated Height (m)	Stem Diameter (mm)	Canopy Spread (N)	Canopy Spread (S)	Canopy Spread (E)	Canopy Spread (W)	First Significant Branch (m)	Canopy Clearance (m)	Physiological Condition	Life Stage	Structural Condition	Condition Comments	Preliminary Management Comments	Works to Facilitate Proposed Development	Estimated Remaining Contribution	Category
T221 *	Scots Pine (*Pinus sylvestris*)	10	410	7	1	3	3	9.0/N	6	Good	SM	Fair	Wound at base 0.5m south. Northern lean bias.			10+	C2
T222 *	Scots Pine (*Pinus sylvestris*)	14	450	7	1	3	4	5.0/NW	4	Good	SM	Fair	Northern lean bias. Unable to access base. Full, balanced and healthy crown				B2
T223 *	Hybrid black poplar (*Populus x canadensis*)	20	800,700,700,700	15	1	1	1	0.5/NW	0.5	Poor	V	Poor	Veteran tree. Major stem failure on 3 of 4 codominant stems.			40+	A1,2,3
T224 *	Hybrid black poplar (*Populus x canadensis*)	20	310,200,470,540,540,460	8	8	8	8	0.5/E	5	Poor	OM	Poor	Low foliage density and significant dieback. Multi stemmed, compression fork unions.	Consider fFell If land use changes		<10	U2
T225 *	Hybrid black poplar (*Populus x canadensis*)	22	650,650	8	8	8	8	5.0/SW	6	Poor	V	Fair	Veteran tree. Major stem failure forming Imbalanced crown. Dieback. Low levels of foliage in crown. Epicormic growth on stem.			40+	A1,2,3

Tree ID	Species	Estimated Height (m)	Stem Diameter (mm)	Canopy Spread (N)	Canopy Spread (S)	Canopy Spread (E)	Canopy Spread (W)	First Significant Branch (m)	Canopy Clearance (m)	Physiological Condition	Life Stage	Structural Condition	Condition Comments	Preliminary Management Comments	Works to Facilitate Proposed Development	Estimated Remaining Contribution	Category
T226 *	Hybrid black poplar (*Populus x canadensis*)	23	380,650,650,650,400,250	7	7	7	7	4.0/NW	5	Good	OM	Fair	Potentially reaching its life expectancy. Multi stemmed with close unions. Minor deadwood in crown.			10+	C1,2
T227 *	Hybrid black poplar (*Populus x canadensis*)	21	850,750,650	9	9	9	9	0.5/N	5	Good	OM	Fair	Potentially reaching its life expectancy - Longitudinal crack along x1 Co dominant stem. Bat and bird roost potential.	Consider create pollard at 10-12m to reduce the risk of collapse or fence off the tree within falling distance as an exclusion zone	~~Create pollard at 10-12m to address structural condition due to change in land use~~Fence off the tree (area within falling distance) as an exclusion zone on safety grounds.	10+	C1,2,3
T228 *	Hybrid black poplar (*Populus x canadensis*)	21	1170	8	8	8	8	0.5/N	7	Poor	OM	Poor	Potentially reaching end of its safe life expectancy. Previous failure on south-eastern aspect. Wound 0-6m on stem. Woundwood occluding leaving substantial posts. Dieback in crown.	Consider f~~F~~ell If land use changes	Fell~~-~~, consider creating monolith at 7m	<10	U2,3
T229 *	Holly (*Ilex aquifolium*)	8	450	3	3	3	1	1.0/S	4	Fair	M	Fair	Unbalanced crown, likely pruned on western aspect. Pruning/flailing wounds on western aspect. Small leaves and stunted growth. Tree within hedgerow, unable to fully access base.			10+	C2,3

Tree ID	Species	Estimated Height (m)	Stem Diameter (mm)	Canopy Spread (N)	Canopy Spread (S)	Canopy Spread (E)	Canopy Spread (W)	First Significant Branch (m)	Canopy Clearance (m)	Physiological Condition	Life Stage	Structural Condition	Condition Comments	Preliminary Management Comments	Works to Facilitate Proposed Development	Estimated Remaining Contribution	Category
T230 *	Sycamore (*Acer pseudoplatanus*)	10	400	3.5	3.5	3.5	3.5	3.5/SE	4	Good	SM	Good	Ivy 0-8m on stem. Tree within hedgerow. Unable to fully access base.			20+	B1,2
T231 *	Elm (*Ulmus sp*)	18	600	5	6	8	8	3.5/NE	5	Good	M	Good	Ivy 0-12m. Low level dieback in crown. Unable to fully access base.			20+	B2
T232 *	Elm (*Ulmus sp*)	12	500	5	3	8	2	3.0/N	4	Dead		Dead	Unable to access base. High density ivy 0-10m. Eastern lean bias.	Consider fFell If land use changes		<10	U3
T233 *	Elm (*Ulmus sp*)	14	600	6	4	6	4	3.0/W	3	Good	M	Good	Ivy 0-6m. Minor dieback in crown. Unable to fully access base.			20+	B1,2
T234 *	Sycamore (*Acer pseudoplatanus*)	13	400	4	4	4	4	4.0/SW	5	Good	EM	Good	High density ivy, 0-12m. Unable to access base and visibility poor.			20+	B1,2,3

Tree ID	Species	Estimated Height (m)	Stem Diameter (mm)	Canopy Spread (N)	Canopy Spread (S)	Canopy Spread (E)	Canopy Spread (W)	First Significant Branch (m)	Canopy Clearance (m)	Physiological Condition	Life Stage	Structural Condition	Condition Comments	Preliminary Management Comments	Works to Facilitate Proposed Development	Estimated Remaining Contribution	Category
T235 *	Sycamore (*Acer pseudoplatanus*)	15	350,350	6	6	6	6	3.0/W	5	Good	M	Good	Unable to fully access base, visibility poor. High density ivy, 0.5-13m on main stems. Co dominant stems.			20+	B1,2,3
T236 *	Beech (*Fagus sylvatica*)	13	450	5	5	5	5	3.5/N	4	Poor	M	Good	Low density of foliage. High volume of dieback. High density ivy, 0-10m. Unable to access base, poor visibility.	Consider f~~F~~ell If land use changes		<10	U3
G237*	Hawthorn (*Crataegus monogyna*), Common Oak (*Quercus robur*)	8	200	1	1	1	1	n/a	n/a	Good	Y	Good				10+	C1,2
G238*	Common Oak (*Quercus robur*), Hawthorn (*Crataegus monogyna*)	14	400	3	3	3	3	n/a	n/a	Good	SM	Good	Previous pruning causing minor crown suppression on western aspects.			20+	B1,2
G239*	Common Oak (*Quercus robur*)	8	400	3	3	3	3	n/a	n/a	Good	SM	Good	Previous pruning on eastern aspect causing crown suppression. Lateral wounds on western aspect with substantial occlusion. Three trees all between 210-400mm range.			10+	C2

Tree ID	Species	Estimated Height (m)	Stem Diameter (mm)	Canopy Spread (N)	Canopy Spread (S)	Canopy Spread (E)	Canopy Spread (W)	First Significant Branch (m)	Canopy Clearance (m)	Physiological Condition	Life Stage	Structural Condition	Condition Comments	Preliminary Management Comments	Works to Facilitate Proposed Development	Estimated Remaining Contribution	Category
G240*	Common Oak (*Quercus robur*)	6	500	3	3	3	3	n/a	n/a	Good	Y-EM	Good - Fair	Deadwood in crown. Western crown suppression, likely cause - flailing and pruning. X1 @ 200-400 range, x2 410-600 range. Multi stemmed.			10+	C2
G241*	Scots Pine (*Pinus sylvestris*)	17	600	5	5	5	5	n/a	n/a	Good	SM-M	Good - Fair	Strongly ivy clad. Unable to access base. Nesting birds present.			10+	B3
G242*	Scots Pine (*Pinus sylvestris*)	20	550	5	5	5	5	n/a	n/a	Good - Dead	SM-M	Good - Dead	Majority semi-mature pine.			10+	C2
G243*	Stone Pine (*Pinus pinea*), Cedar of Lebanon (*Cedrus libani*), Hawthorn (*Crataegus monogyna*)	25	800	7	7	7	7	n/a	n/a	Good - Dead	Y-M	Good - Dead	Majority of trees in good condition. Landscape and agricultural value.		Fell in part as per TPRP.	20+	B1,2
G244*	Common Oak (*Quercus robur*), Scots Pine (*Pinus sylvestris*)	14	400	6	6	6	6	n/a	n/a	Good-Fair	SM	Good - Fair	Pines heavily leaning. Cavity in main stem of one pine. Previous pruning and probable mechanical damage to stem.			10+	C2

Tree ID	Species	Estimated Height (m)	Stem Diameter (mm)	Canopy Spread (N)	Canopy Spread (S)	Canopy Spread (E)	Canopy Spread (W)	First Significant Branch (m)	Canopy Clearance (m)	Physiological Condition	Life Stage	Structural Condition	Condition Comments	Preliminary Management Comments	Works to Facilitate Proposed Development	Estimated Remaining Contribution	Category
G245*	Hawthorn (*Crataegus monogyna*)	5	500	2	2	2	2	n/a	n/a	Good - Fair	Y-M	Good - Fair	Least valued area, however still of moderate importance.			20+	B1,2
G246*	Elm (*Ulmus sp*), Scots Pine (*Pinus sylvestris*), Poplar (*Populus sp*)	24	800	5	5	5	5	n/a	n/a	Good - Dead	SM-OM	Good - Dead	Sporadically spaced and mixed sp. Band of trees offering valuable screening for reservoir. High density of understorey species.			40+	A1,2,3
G247*	Scots Pine (*Pinus sylvestris*), Poplar (*Populus sp*)	24	800	5	5	5	5	n/a	n/a	Good - Dead		Good - Dead	Majority pine with occasional poplar.		Fell in part as per TPRP.	20+	B1,2
G248*	Hawthorn (*Crataegus monogyna*)	4	300	2	2	2	2	n/a	n/a	Good	SM-M	Good	Scrub with 8 trees.		Fell in part as per TPRP.	10+	C2,3
H249*	Norway Maple (*Acer platanoides*), Sycamore (*Acer pseudoplatanus*), Elm (*Ulmus sp*), Hawthorn	3	110	1	1	1	1	n/a	n/a	Good	M	Good	X2 hedgerows either side of farm track. Dense, mainly gap less hedge. Likely flailed/pruned frequently. High density ivy throughout. Visibility to stem bases poor.		Fell in part as per TPRP.	20+	B1,2,3

Tree ID	Species	Estimated Height (m)	Stem Diameter (mm)	Canopy Spread (N)	Canopy Spread (S)	Canopy Spread (E)	Canopy Spread (W)	First Significant Branch (m)	Canopy Clearance (m)	Physiological Condition	Life Stage	Structural Condition	Condition Comments	Preliminary Management Comments	Works to Facilitate Proposed Development	Estimated Remaining Contribution	Category
	(*Crataegus monogyna*)																
G250*	Elm (*Ulmus sp*)	12	600	6	6	6	6	n/a	n/a	Good	M	Good	High density of ivy @ 80% of tree. Unable to fully access base.			20+	B1,2
H251*	Sycamore (*Acer pseudoplatanus*), Hawthorn (*Crataegus monogyna*), Elm (*Ulmus sp*)	3.5	110	1	1	1	1	n/a	n/a	Good	Y-M	Good	Dense hedgerow, mainly gapless. Likely pruned/flailed frequently. Two hedgerows either side of a farm track. High density ivy throughout. Visibility to stem bases poor.		Fell in part as per TPRP.	20+	B2,3
~~W255*~~	~~Scots Pine (*Pinus sylvestris*), Beech (*Fagus sylvatica*), Blackthorn (*Prunus spinosa*), Hawthorn (*Crataegus monogyna*)~~	~~25~~	~~850~~	~~5~~	~~5~~	~~5~~	~~5~~	~~n/a~~	~~n/a~~	~~Good – Dead~~	~~Y-M~~	~~Good – Dead~~	~~Self set, mixed woodland. Dense tree understorey, with mature climax tree species. Farm track runs through woodland north to south, 4m wide. Number of Scots pine in poor/dead condition.~~		~~Fell in part as per TPRP.~~	~~40+~~	~~A1,2,3~~

Tree ID	Species	Estimated Height (m)	Stem Diameter (mm)	Canopy Spread (N)	Canopy Spread (S)	Canopy Spread (E)	Canopy Spread (W)	First Significant Branch (m)	Canopy Clearance (m)	Physiological Condition	Life Stage	Structural Condition	Condition Comments	Preliminary Management Comments	Works to Facilitate Proposed Development	Estimated Remaining Contribution	Category
W256*	Maple (*Acer sp*), Dogwood (*Cornus sanguinea Dogwood*), Beech (*Fagus sylvatica*), Ash (*Fraxinus sp*)	25	650	5	5	5	5	n/a	n/a	Good - Dead	Y-M	Good - Dead	Mixed plantation with two distinct ages between semi mature and mature. Self set younger trees. Evenly spaced, dense understorey and ground flora. Tree guards present. Unable to gain full access due to dense vegetation.		Fell in part as per TPRP.	40+	A1,2,3
W257*	Maple (*Acer sp*), Hawthorn (*Crataegus monogyna*), Ash (*Fraxinus sp*), Common Oak (*Quercus robur*)	25	800	10	10	10	10	n/a	n/a	Good - Dead	Y-M	Good - Dead	Mainly mature, mixed woodland. Separated from young plantation woodland to the east by a 5m ride. Dense understorey, unable to fully access.			40+	A1,2,3
W258*	Maple (*Acer sp*), Birch (*Betula sp*), Dogwood (*Cornus sanguinea Dogwood*), Common Oak (*Quercus robur*)	15	350	5	5	5	5	n/a	n/a	Good - Dead	Y	Good - Dead	Young plantation woodland with low density spacing in the eastern half. High density spacing on the western half. Unable to fully access, dense scrub.			20+	B1,2,3
T259*	Lombardy Poplar (Populus nigra `Italica´)	18	650	3	4	3	3	1.0/W	5	Good	EM	Good	Tight unions			20+	B1,2

Tree ID	Species	Estimated Height (m)	Stem Diameter (mm)	Canopy Spread (N)	Canopy Spread (S)	Canopy Spread (E)	Canopy Spread (W)	First Significant Branch (m)	Canopy Clearance (m)	Physiological Condition	Life Stage	Structural Condition	Condition Comments	Preliminary Management Comments	Works to Facilitate Proposed Development	Estimated Remaining Contribution	Category
T260 *	Grey Poplar (Populus canescens)	12	400	5	3	5	4	1.0/S	0	Good	SM	Fair	North lean bias. Unbalanced crown			10+	C2
T261 *	Grey Poplar (Populus canescens)	8	200	4	2	4	3	3.0/W	4	Good	SM	Fair	North lean bias			10+	C2
T262 *	Crab Apple (Malus sylvestris)	10	360	5	5	5	5	1.0/S	3	Fair	EM	Good	Epicormic growth on main stem			20+	B2
T263 *	Beech (Fagus sylvatica)	18	810	9	9	9	9	1.0/N	5	Good	M	Fair	Tight and congested unions between 1-5m. Main union at 2m, v shaped with exuding liquid down stem. Unions do not show signs of active separation. Minimal natural bracing in crown		-	40+	A2
T264 *	Ash (Fraxinus excelsior)	12	500,400, 400, 400	8	8	8	8	1.0/S	3	Good	M	Fair	Multi stemmed from base. Tight, congested unions between 0.5-2m. No sign of active separation			20+	B2

Tree ID	Species	Estimated Height (m)	Stem Diameter (mm)	Canopy Spread (N)	Canopy Spread (S)	Canopy Spread (E)	Canopy Spread (W)	First Significant Branch (m)	Canopy Clearance (m)	Physiological Condition	Life Stage	Structural Condition	Condition Comments	Preliminary Management Comments	Works to Facilitate Proposed Development	Estimated Remaining Contribution	Category
T265 *	Elder (Sambucus nigra)	4	90#	1	1	1	1	1.0/N	1	Good	Y	Good				10+	C2
T266 *	Hawthorn (Crataegus monogyna)	6	150#	3	3	3	3	1.0/W	1	Good	SM	Good				10+	C2
T267 *	Beech (Fagus sylvatica)	15	760,450	8	8	10	10	1.0/W	1	Good	M	Good	Natural bracing in crown		-	40+	A2
T268 *	Lombardy Poplar (Populus nigra `Italica´)	12	150#	1	1	1	1	5.0/N	5	Dead	SM	Dead		Consider fell If land use changes		<10	U3
T269 *	Beech (Fagus sylvatica)	16	790	8	8	8	8	1.0/S	4	Good	EM	Good	Slight east lean bias. Previous pruning at 5m eastern side		-	40+	A1,2

Tree ID	Species	Estimated Height (m)	Stem Diameter (mm)	Canopy Spread (N)	Canopy Spread (S)	Canopy Spread (E)	Canopy Spread (W)	First Significant Branch (m)	Canopy Clearance (m)	Physiological Condition	Life Stage	Structural Condition	Condition Comments	Preliminary Management Comments	Works to Facilitate Proposed Development	Estimated Remaining Contribution	Category
T270 *	Beech (Fagus sylvatica)	18	800	8	8	8	8	3.0/S	3	Good	M	Good				40+	A1,2
T271 *	Beech (Fagus sylvatica)	12	500,300	8	4	6	7	2.0/S	4	Good	EM	Fair	Co dominant stems fused at multiple points. Crown suppression to south west. Asymmetric form			20+	B2
T272 *	Beech (Fagus sylvatica)	18	860,420,400	10	10	10	10	1.0/S	1	Good	M	Good	Tight, congested unions between 1-4m. Natural bracing apparent within crown			40+	A1,2
T273 *	Hawthorn (Crataegus monogyna)	6	150#	3	3	3	3	1.0/E	1	Good	SM	Good				10+	C2
T274 *	Beech (Fagus sylvatica)	16	300,350,200, 300,200,300	9	9	9	9	2.0/E	2	Good	M	Fair	Multi stemmed from base, not typical of species Stems naturally bracing in places			20+	B2

Tree ID	Species	Estimated Height (m)	Stem Diameter (mm)	Canopy Spread (N)	Canopy Spread (S)	Canopy Spread (E)	Canopy Spread (W)	First Significant Branch (m)	Canopy Clearance (m)	Physiological Condition	Life Stage	Structural Condition	Condition Comments	Preliminary Management Comments	Works to Facilitate Proposed Development	Estimated Remaining Contribution	Category
T275 *	Crab Apple (Malus sylvestris)	8	200,200, 200, 250,200, 200, 200,250#	6	7	7	8		3	Fair	M	Fair	Epicormic growth on mains stems. Unidentified bracket fungus at 4m, eastern aspect			20+	B2
T276 *	Beech (Fagus sylvatica)	14	450	10	5	8	6	2.0/W	3	Good	EM	Fair	Northern lean bias		-	20+	B2
T277 *	Beech (Fagus sylvatica)	14	35	1	8	6	4	1.0/W	3	Good	EM	Fair	Southern lean bias		-	20+	B2
T278 *	Beech (Fagus sylvatica)	16	430	5	5	5	5	2.0/S	0	Good	EM	Good	-		-	20+	B1,2
T279 *	Beech (Fagus sylvatica)	14	430	5	5	5	5	3.0/N	0	Good	EM	Good	-		-	20+	B1,2

Tree ID	Species	Estimated Height (m)	Stem Diameter (mm)	Canopy Spread (N)	Canopy Spread (S)	Canopy Spread (E)	Canopy Spread (W)	First Significant Branch (m)	Canopy Clearance (m)	Physiological Condition	Life Stage	Structural Condition	Condition Comments	Preliminary Management Comments	Works to Facilitate Proposed Development	Estimated Remaining Contribution	Category
T280 *	Beech (Fagus sylvatica)	18	620	5.5	5.5	5.5	5.5	2.0/N	1	Good	M	Good				40+	A1,2
T281 *	Beech (Fagus sylvatica)	15	360#	5	5	5	5	5.0/N	5	Good	EM	Good	Inaccessible, lone beech in group of mostly ash			20+	B1,2
T282 *	Beech (Fagus sylvatica)	16	450	5	5	5	5	2.5/NW	2	Good	EM	Fair	Tight forks with adaptive swelling, upright.			20+	B1,2
T283 *	Beech (Fagus sylvatica)	15	480	5	7	6	7	4.5/N	1	Good	EM	Fair	Tight fork at 2.5m,			20+	B1,2
T284 *	Beech (Fagus sylvatica)	17	900	7	7	7	7	2.0/S	1	Good	M	Good	3 stemmed from 1m but fused, tight forks, unable to measure separately, upright form, some natural bracing			40+	A1,2

Tree ID	Species	Estimated Height (m)	Stem Diameter (mm)	Canopy Spread (N)	Canopy Spread (S)	Canopy Spread (E)	Canopy Spread (W)	First Significant Branch (m)	Canopy Clearance (m)	Physiological Condition	Life Stage	Structural Condition	Condition Comments	Preliminary Management Comments	Works to Facilitate Proposed Development	Estimated Remaining Contribution	Category
T285 *	Scots Pine (Pinus sylvestris)	14	450	4	4	4	4	5.0/W	5	Good	EM	Good				20+	B1,2
T286 *	Ash (Fraxinus excelsior)	19	460,350, 380, 360,180, 180	7	7	7	7	3.0/N	3	Good	M	Fair	Coppice derived			20+	B1,2
T287 *	Beech (Fagus sylvatica)	18	900#	10	10	10	10	0.5/E	0	Good	M	Fair	Inaccessible, pronounced scaffold limb formation from 0.5m, similar tree circa 10m to south		-	40+	A1,2
T288 *	Beech (Fagus sylvatica)	18	650	6	6	9	6	2.5/S	1	Good	M	Good	-		-	40+	A1,2
T289 *	Beech (Fagus sylvatica)	6	380	2	4	4	4	1.5/S	0	Good	EM	Good	-		-	20+	B1,2

Tree ID	Species	Estimated Height (m)	Stem Diameter (mm)	Canopy Spread (N)	Canopy Spread (S)	Canopy Spread (E)	Canopy Spread (W)	First Significant Branch (m)	Canopy Clearance (m)	Physiological Condition	Life Stage	Structural Condition	Condition Comments	Preliminary Management Comments	Works to Facilitate Proposed Development	Estimated Remaining Contribution	Category
T290 *	Beech (Fagus sylvatica)	15	430	5	5	5	5	2.0/E	1	Good	EM	Fair	Tight fork at 3m, upright form			20+	B1,2
T291 *	Beech (Fagus sylvatica)	14	500#	6	6	6	6	2.0/W	0	Good	EM	Good	-		-	20+	B1,2
T292 *	Beech (Fagus sylvatica)	16	560#	7.5	7.5	7.5	7.5	2.0/N	1	Good	EM	Good	Inaccessible		-	40+	A1,2
T293 *	Beech (Fagus sylvatica)	16	450	6	6	6	6	4.0/S	1	Good	EM	Fair	-		-	20+	B1,2
T294	Scots Pine (Pinus sylvestris)	12	230	3	1.5	2.5	1.5	3.5/E	2	Dead	SM	Dead	Dead standing tree adjacent to track	Consider fell if land use changes		<10	U1

Tree ID	Species	Estimated Height (m)	Stem Diameter (mm)	Canopy Spread (N)	Canopy Spread (S)	Canopy Spread (E)	Canopy Spread (W)	First Significant Branch (m)	Canopy Clearance (m)	Physiological Condition	Life Stage	Structural Condition	Condition Comments	Preliminary Management Comments	Works to Facilitate Proposed Development	Estimated Remaining Contribution	Category
T295 *	Beech (Fagus sylvatica)	17	440	5	5	5	5	2.0/N	0	Good	EM	Good	-		-	20+	B1,2
T296 *	Beech (Fagus sylvatica)	17	490	5.5	5.5	5.5	5.5	4.0/S	1	Good	EM	Good	-		-	20+	B1,2
T297 *	Beech (Fagus sylvatica)	14	410	5	5	5	5	2.5/E	0	Good	EM	Good	-		-	20+	B1,2
T298 *	Beech (Fagus sylvatica)	16	430	5	5	5	5	2.0/S , 2.0/NW	2	Good	EM	Good	-		-	20+	B1,2
T299 *	Beech (Fagus sylvatica)	16	390,390	5	6	7	5	5.0/E	3	Good	EM	Poor	Acute tight fork with extensive included bark from 0.5 to 1.5m		-	10+	C1,2

Tree ID	Species	Estimated Height (m)	Stem Diameter (mm)	Canopy Spread (N)	Canopy Spread (S)	Canopy Spread (E)	Canopy Spread (W)	First Significant Branch (m)	Canopy Clearance (m)	Physiological Condition	Life Stage	Structural Condition	Condition Comments	Preliminary Management Comments	Works to Facilitate Proposed Development	Estimated Remaining Contribution	Category
T300*	Beech (Fagus sylvatica)	16	490	6	6	6	6	2.5/N	1	Good	EM	Good	-		-	20+	B1,2
T301*	Beech (Fagus sylvatica)	16	400	5	5	5	5	2.5/E	1	Good	EM	Good	-		-	20+	B1,2
T302*	Beech (Fagus sylvatica)	14	490	6	6	6	6	3.5/W	1	Good	EM	Good	-		-	20+	B1,2
T303*	Scots Pine (Pinus sylvestris)	12	250#	1	1	1.5	1.5	8.0/W	8	Dead	SM	Dead	Dead standing tree adjacent to track	Consider fell if land use changes		<10	U1
T304*	Beech (Fagus sylvatica)	15	450#	5	5	5	5	-	0	Good	EM	Good	Inaccessible		-	20+	B1,2

Tree ID	Species	Estimated Height (m)	Stem Diameter (mm)	Canopy Spread (N)	Canopy Spread (S)	Canopy Spread (E)	Canopy Spread (W)	First Significant Branch (m)	Canopy Clearance (m)	Physiological Condition	Life Stage	Structural Condition	Condition Comments	Preliminary Management Comments	Works to Facilitate Proposed Development	Estimated Remaining Contribution	Category
T305 *	Beech (Fagus sylvatica)	15	560,500	7	7	7	7	3.0/S	0	Good	EM	Fair	Tight fork at 1.5m, semi mature beech 3m to south east		-	20+	B1,2
T306 *	Beech (Fagus sylvatica)	15	490	7	7	7	7	3.5/NW	0	Good	EM	Fair	Tight fork at 3m, seams and expansion bark cracks on lower stem		-	20+	B1,2
T307 *	Beech (Fagus sylvatica)	15	540	7	7	7	7	2.0/W	0	Good	EM	Good	Pock marked lower stem, possibly associated with felted beech scale,		-	40+	A1,2
T308 *	Beech (Fagus sylvatica)	15	370	4	5	5	5	2.5/N	1	Good	EM	Good	Upright form		-	20+	B1,2
T309 *	Beech (Fagus sylvatica)	16	800	7.5	7.5	7.5	7.5	2.0/S	0	Good	M	Fair	Tight fork from 0.5m with fused stems to 2m, slight swelling, upright form,		-	40+	A1,2

Tree ID	Species	Estimated Height (m)	Stem Diameter (mm)	Canopy Spread (N)	Canopy Spread (S)	Canopy Spread (E)	Canopy Spread (W)	First Significant Branch (m)	Canopy Clearance (m)	Physiological Condition	Life Stage	Structural Condition	Condition Comments	Preliminary Management Comments	Works to Facilitate Proposed Development	Estimated Remaining Contribution	Category
T310 *	Beech (Fagus sylvatica)	16	590	6	6	6	6	4.0/E	0	Good	EM	Good				40+	A1,2
T311 *	Beech (Fagus sylvatica)	17	450	5	5	5	3.5	4.0/E	0	Good	EM	Good				20+	B1,2
T312 *	Beech (Fagus sylvatica)	14	530	6	7	7	7	3.0/S	3	Good	EM	Poor	Main fork with split at 5m, tight fork at 2.5m. Branch wound on upper side of limb to West at 4m with decay, no targets, within woodland. Lower stem wound with good woundwood to north			10+	C1,2
T313 *	Beech (Fagus sylvatica)	19	580	7	7	7	7	1.0/W	0	Good	M	Good				40+	A1,2
T314 *	Beech (Fagus sylvatica)	15	450#	4	5	5	5	2.5/N	1	Good	EM	Good				20+	B1,2

Tree ID	Species	Estimated Height (m)	Stem Diameter (mm)	Canopy Spread (N)	Canopy Spread (S)	Canopy Spread (E)	Canopy Spread (W)	First Significant Branch (m)	Canopy Clearance (m)	Physiological Condition	Life Stage	Structural Condition	Condition Comments	Preliminary Management Comments	Works to Facilitate Proposed Development	Estimated Remaining Contribution	Category
T315 *	Scots Pine (Pinus sylvestris)	11	300#	3.5	1	4	1	4.0/E	4	Dead	SM	Dead	Dead standing tree adjacent to track	Consider fell if land use changes		<10	U1
T316 *	Beech (Fagus sylvatica)	16	440#	4	4	4	4	2.0/S	0	Good	EM	Good	Not fully accessible		-	20+	B1,2
T317 *	Beech (Fagus sylvatica)	15	430#	5	5	5	3	2.0/N	0	Good	EM	Good	Inaccessible		-	20+	B1,2
T318 *	Beech (Fagus sylvatica)	16	330,310, 250, 220	5	5	5	5	2.0/S	1	Good	EM	Good	Multi stemmed from 0.5m, tank to south with pipes and unprotected hole presenting a trip hazard		-	20+	B1,2
T319 *	Beech (Fagus sylvatica)	14	650	7	7	7	7	2.0/S	0	Good	M	Fair	-		-	40+	A1,2

Tree ID	Species	Estimated Height (m)	Stem Diameter (mm)	Canopy Spread (N)	Canopy Spread (S)	Canopy Spread (E)	Canopy Spread (W)	First Significant Branch (m)	Canopy Clearance (m)	Physiological Condition	Life Stage	Structural Condition	Condition Comments	Preliminary Management Comments	Works to Facilitate Proposed Development	Estimated Remaining Contribution	Category
T320 *	Beech (Fagus sylvatica)	14	520	6	5	5	5	2.5/N	1	Good	EM	Good	Girdling root to north, 75mm diameter	Carefully expose (by hand) and sever girdling root to north	-	20+	B1,2
T321 *	Beech (Fagus sylvatica)	14	460	4	5	5	5	1.0/S	0	Good	EM	Good	-		-	20+	B1,2
T322 *	Beech (Fagus sylvatica)	16	820	8	8	8	8	3.0/W	0	Good	M	Good	-		-	40+	A1,2
T323 *	Beech (Fagus sylvatica)	19	690,490	9	9	6	9	1.5/S	1	Good	M	Good	Possible bundle planting		-	40+	A1,2
T324 *	Beech (Fagus sylvatica)	15	450#	5	5	5	5	-	0	Good	EM	Good	Inaccessible		-	20+	B1,2

Tree ID	Species	Estimated Height (m)	Stem Diameter (mm)	Canopy Spread (N)	Canopy Spread (S)	Canopy Spread (E)	Canopy Spread (W)	First Significant Branch (m)	Canopy Clearance (m)	Physiological Condition	Life Stage	Structural Condition	Condition Comments	Preliminary Management Comments	Works to Facilitate Proposed Development	Estimated Remaining Contribution	Category
T325 *	Beech (Fagus sylvatica)	17	550,880, 470	9	9	10	7	3.0/W	0	Good	M	Good	3 stemmed from 0.5m		-	40+	A1,2
T326 *	Beech (Fagus sylvatica)	19	890	8	8	8	8	3.0/SW	0	Good	M	Fair	Tight fork from 2.5-3.5m, upright form, adaptive swelling, some natural bracing in crown. Crown impact wounds with good woundwood. Large diameter deadwood over woodland		-	40+	A1,2
T327 *	Beech (Fagus sylvatica)	16	680	7	7	7	8	2.0/N	0	Good	M	Fair	100mm limb failure stub at 4m, storm damage in crown to east with good woundwood		-	40+	A1,2
T328 *	Beech (Fagus sylvatica)	15	250#	4	4	4	4	3.0/N	1	Good	SM	Good	Inaccessible, beech in group of mostly ash		-	20+	B1,2
T329 *	Scots Pine (Pinus sylvestris)	11	240	3.5	1	1	1	4.0/E	4	Dead	SM	Dead	Dead standing tree adjacent track	Consider fell if land use changes		<10	U1

Tree ID	Species	Estimated Height (m)	Stem Diameter (mm)	Canopy Spread (N)	Canopy Spread (S)	Canopy Spread (E)	Canopy Spread (W)	First Significant Branch (m)	Canopy Clearance (m)	Physiological Condition	Life Stage	Structural Condition	Condition Comments	Preliminary Management Comments	Works to Facilitate Proposed Development	Estimated Remaining Contribution	Category
T330 *	Beech (Fagus sylvatica)	14	430	6	4	6	4	1.5/N	0	Good	EM	Good	-			20+	B1,2
T331 *	Beech (Fagus sylvatica)	16	490#	5	5	5	5	-	1	Good	EM	Good	Not accessible		-	20+	B1,2
T332 *	Beech (Fagus sylvatica)	6	520	4.5	4.5	4.5	4.5	2.5/S	1	Good	EM	Fair	Small cavity to north at 1.3m, stubbed pruning cuts to north and west, tight fork at 3m, upright form.		Crown lift to north and east to provide a clear height of 4m	20+	B2
T333 *	Beech (Fagus sylvatica)	6	380	5	4	4	4	2.0/E	1	Good	SM	Fair	Old wound at base to south with good woundwood, stubbed pruning cuts to West for highway clearance.		-	20+	B2
T334 *	Beech (Fagus sylvatica)	6	500	5	5	5	5	2.0/S	1	Good	EM	Good	-		-	20+	B2

Tree ID	Species	Estimated Height (m)	Stem Diameter (mm)	Canopy Spread (N)	Canopy Spread (S)	Canopy Spread (E)	Canopy Spread (W)	First Significant Branch (m)	Canopy Clearance (m)	Physiological Condition	Life Stage	Structural Condition	Condition Comments	Preliminary Management Comments	Works to Facilitate Proposed Development	Estimated Remaining Contribution	Category
T335 *	Beech (Fagus sylvatica)	6	420	4	3.5	4	4	2.5/S	1	Good	SM	Good	-		Fell	20+	B2
T336 *	Beech (Fagus sylvatica)	6	270	2.5	2.5	2.5	2.5	2.0/N	1	Good	SM	Fair	-		Fell	10+	C2
T337 *	Beech (Fagus sylvatica)	6	380	6	4	6	6	2.0/E	0	Good	SM	Good	-		Fell	20+	B2
T338 *	Beech (Fagus sylvatica)	6	510	6	3	6	6	2.5/N	1	Good	EM	Fair	-		-	20+	B2
T339 *	Beech (Fagus sylvatica)	6	440	4	4	4	4	2.5/N	1	Good	EM	Good	-		-	20+	B2

Tree ID	Species	Estimated Height (m)	Stem Diameter (mm)	Canopy Spread (N)	Canopy Spread (S)	Canopy Spread (E)	Canopy Spread (W)	First Significant Branch (m)	Canopy Clearance (m)	Physiological Condition	Life Stage	Structural Condition	Condition Comments	Preliminary Management Comments	Works to Facilitate Proposed Development	Estimated Remaining Contribution	Category
G340*	Hawthorn (Crataegus monogyna), Lombardy Poplar (Populus nigra `Italica´), Common Oak (Quercus robur), Blackthorn (Prunus spinosa), English Elm (Ulmus procera)	7	<150#	2	2	2	2	n/a	n/a	Good - Dead	Y-SM	Good - Dead	Contains scattered dead trees			10+	C2
G341*	Hawthorn (Crataegus monogyna)	6	<150#	3	3	3	3	n/a	n/a	Good	Y-SM	Good				10+	C2
G342*	Ash (Fraxinus excelsior)	16	<500#	8	8	8	8	n/a	n/a	Good	EM-M	Good				20+	B2
W343*	Crab Apple (Malus sylvestris), Ash (Fraxinus excelsior), Hazel (Corylus avellana), Beech (Fagus sylvatica), Hawthorn (Crataegus monogyna), Willow	12	<400#	5	5	5	5	n/a	n/a	Good - Dead	Y-M	Good - Dead	Presumed naturally regenerated woodland			10+	C2,3

Tree ID	Species	Estimated Height (m)	Stem Diameter (mm)	Canopy Spread (N)	Canopy Spread (S)	Canopy Spread (E)	Canopy Spread (W)	First Significant Branch (m)	Canopy Clearance (m)	Physiological Condition	Life Stage	Structural Condition	Condition Comments	Preliminary Management Comments	Works to Facilitate Proposed Development	Estimated Remaining Contribution	Category
	(Salix sp),Blackthorn (Prunus spinosa)																
W344*	Silver Birch (Betula pendula), Ash (Fraxinus excelsior), Blackthorn (Prunus spinosa), Hawthorn (Crataegus monogyna)	18	<500#	8	8	8	8	n/a	n/a	Good - Dead	SM-M	Good - Dead	Presumed naturally regenerated woodland			20+	B1,2,3
W345*	Hawthorn (Crataegus monogyna), Blackthorn (Prunus spinosa), Crab Apple (Malus sylvestris)	12	<400#	6	6	6	6	n/a	n/a	Good - Dead	Y-M	Good - Dead	Presumed naturally regenerated woodland			10+	C2,3
W346*	Crab Apple (Malus sylvestris), Hawthorn (Crataegus monogyna), Blackthorn (Prunus spinosa), Beech (Fagus sylvatica), Ash (Fraxinus excelsior)	10	<250#	3	3	3	3	n/a	n/a	Good - Dead	Y-M	Good - Dead	Presumed natural regeneration of mainly understorey species			10+	C2,3

Tree ID	Species	Estimated Height (m)	Stem Diameter (mm)	Canopy Spread (N)	Canopy Spread (S)	Canopy Spread (E)	Canopy Spread (W)	First Significant Branch (m)	Canopy Clearance (m)	Physiological Condition	Life Stage	Structural Condition	Condition Comments	Preliminary Management Comments	Works to Facilitate Proposed Development	Estimated Remaining Contribution	Category
G347*	Hawthorn (Crataegus monogyna), Elder (Sambucus nigra)	6	<150#	3	3	3	3	n/a	n/a	Good	Y-SM	Good				10+	C2
G348*	Hawthorn (Crataegus monogyna)	6	<150#	3	3	4	3	n/a	n/a	Good	Y-SM	Good				10+	C2
W349*	Scots Pine (Pinus sylvestris), Beech (Fagus sylvatica), Larch (Larix sp)	15	<350#	4	4	4	4	n/a	n/a	Good - Dead	SM-EM	Good - Dead	Predominantly Scots pine and semi mature, bramble, elder, Cornus and thorn understorey			20+	B2
W350*	Ash (Fraxinus excelsior), Silver Birch (Betula pendula), Lombardy Poplar (Populus nigra `Italica´)	18	<400#	6	6	6	6	n/a	n/a	Good - Fair	SM-EM	Good - Fair	Line of Lombardy poplar to south, mostly birch to north			20+	B2
W351*	Ash (Fraxinus excelsior),Silver Birch (Betula pendula)	18	<400#	6	6	6	6	n/a	n/a	Good - Dead	SM-EM	Good - Dead	Some ash with dieback, predominantly ash group, no beech other than those plotted separately			20+	B2

Tree ID	Species	Estimated Height (m)	Stem Diameter (mm)	Canopy Spread (N)	Canopy Spread (S)	Canopy Spread (E)	Canopy Spread (W)	First Significant Branch (m)	Canopy Clearance (m)	Physiological Condition	Life Stage	Structural Condition	Condition Comments	Preliminary Management Comments	Works to Facilitate Proposed Development	Estimated Remaining Contribution	Category
G352*	Hawthorn (Crataegus monogyna), Elder (Sambucus nigra)	8	<300#	3	3	3	3	n/a	n/a	Good - Fair	Y-M	Good - Fair	Dense group of scrub, inaccessible			10+	C2
G353*	Hawthorn (Crataegus monogyna), Elder (Sambucus nigra)	8	<300#	3	3	3	3	n/a	n/a	Good - Fair	Y-M	Good - Fair	Dense group of scrub, inaccessible			10+	C2
W354*	Scots Pine (Pinus sylvestris), Beech (Fagus sylvatica),Larch (Larix sp)	15	<400#	5	5	5	5	n/a	n/a	Good - Dead	SM-EM	Good - Dead	Predominantly Scots pine and semi mature, bramble, elder, Cornus, thorn understorey. Scattered beech <400mm diameter, all larger beech plotted individually.		-	20+	B2
W355*	Hawthorn (Crataegus monogyna), Silver Birch (Betula pendula),Ash (Fraxinus excelsior)	14	<400#	4	4	4	4	n/a	n/a	Good - Fair	Y-M	Good - Fair				20+	B2

Key to Abbreviations Used in the Detailed Survey Schedule

Ref No	Specific identification number given to each tree or group. T=Tree/H=Hedge/G=Group/W=Woodland.	
Species	Common name followed by botanical name shown in italics	
RPA	Root Protection Area (As defined by BS5837)	
Stem diameter	Diameter of main stem, measured in millimetres at 1.5 m above ground level. (MS = Multi-stem tree measured in accordance with BS5837 Annexe C)	Av / Average: indicates an average representative measured dimension for the group or feature
Spread	The width and breadth of the crown. Estimated on the four compass points in metres.	
Crown clearance	The estimated height (in metres) above ground level of the lowest significant branch attachments.	
#	Estimated dimensions	
*	Indicates estimated position of tree (not indicated on topographical survey).	
Category	Categorisation of the quality and benefits of trees on Site as per Table 1 and 2 of BS5837:2012. 1=Arboricultural quality/value 2=Landscape quality/value 3=Cultural quality/value (including conservation)	
	A=High quality/value 40yrs+ (light green). B=Moderate quality/value 20yrs+ (mid blue) C=Low quality/value min 10yrs/stem diameter less than 150mm (grey). U=Unsuitable for retention (dark red).	
Life stage	**Young (Y):** Newly planted tree 0-10 years. **Semi-Mature (SM):** Tree in the first third of its normal life expectancy for the species (significant potential for future growth in size). **Early Mature (EM):** Tree in the second third of its normal life expectancy for the species (some potential for future growth in size) **Mature (M**): Tree in the final third of its normal life expectancy for the species (having typically reached its approximate ultimate size). **Over Mature (OM):** Tree beyond the normal life expectancy for the species. **Veteran (V):** Tree which is of interest biologically, aesthetically or culturally because of its condition, size or age.	
Structural condition	**Good:** No significant structural defects **Fair:** Structural defects which can be resolved via remedial works. **Poor:** Structural defects which cannot be resolved via remedial works. **Dead:** Dead.	
Physiological condition	**Good:** Normal vitality including leaf size, bud growth, density of crown and wound wood development. **Fair:** Lower than normal vitality, reduced bud development, reduced crown density, reduced response to wounds. **Poor:** Low vitality, low development and distribution of buds, discoloured leaves, low crown density, little extension growth for the species. **Dead:** Dead **Fair/Good** = Indicates an intermediate condition **Fair – Good** = Indicates a range of conditions (e.g. within a group)	
Preliminary management recommendations	Works identified during the tree survey as part of sound arboricultural management, based on the current context of the Site (where relevant reference has been made to tree management based on the potential future context of the site).	

Appendix C Precautionary Arboricultural Method Statement

1 Precautionary Arboricultural Method Statement (PAMS)

1.1.1 This document provides the Precautionary Arboriculture Method Statement for the Scheme. Should consent be granted the appointed contractor will produce a detailed Arboricultural Method Statement, this will be secured through the CEMP ~~(the latest version for the Framework CEMP was submitted to the Examination at Deadline 3)~~**.** All site personnel must be made fully aware of its contents and the implications for work they may be involved in. All elements of the ~~-~~detailed Arboricultural Method Statement must be adhered to in full. No changes may take place to the content or application of the detailed Arboricultural Method Statement without the prior written approval of the Arboriculturist.

1.2 Order of operations

1. Formal appointment of an arboriculturist and LPA notification of tree related impacts
2. Confirmation of preliminary tree works by the appointed Arboriculturist (where required)
3. Notification and consent of tree works with relevant landowner and/or LPA (where required)
4. Pre-commencement site meeting
5. Preliminary tree works
6. Scheme briefing for site personnel
7. Programme of site monitoring
8. Installation of protective fencing as advised by the appointed Arboriculturist
9. Construction operations including installation or diversion of services in proximity to trees under arboricultural supervision
10. Site signed off on agreed completion of significant development works
11. Dismantling of tree protection measures

1.3 Preliminary tree works and tree related impacts

1.3.1 Prior to any works taking place, a pre-construction tree survey will be undertaken and the status of trees to be pruned or removed (if required) and a written summary of the anticipated tree related impacts must be compiled by the appointed site Arboriculturist. This should be accompanied by a tree works specification which identifies trees to be felled or pruned to facilitate the Scheme.

1.3.2 The findings of this work will be included within an Arboriculture Report, which will be accompanied by an Arboricultural Method Statement which will set out mitigation and protection measures to be undertaken. The findings and recommendations of these will be taken into account by the appointed contractor.

1.3.3 Any required tree works are to be completed by suitably qualified and insured contractors and must take place before protective fencing is installed and any site works begin.

1.3.4 All tree works must be carried out in line with the principles of BS3998: 2010 Tree work – recommendations will be conducted in such a way that no damage is caused to any tree to be retained. Any appointed tree works contractor must avoid disturbance, such as the production of ruts, on unmade ground.

1.3.5 Tree clearance works should be reviewed within the Order limits in advance and where feasible trees be retained and protected. Consideration should also be given to the potential for trees to be coppiced or formalised into managed hedgerows as an alternative to removal.

1.3.6 Where part of a tree group is to be removed, or, where extensive tree removals are required which could leave retained trees exposed; retained trees must be subject to a walkover assessment by the appointed Arboriculturist to determine the suitability and stability of retained trees and to advise on any additional pruning or removals required to address any loss of companion shelter.

1.3.7 If further additional tree works are deemed to be required during the development, the advice of the appointed Arboriculturist is to be obtained.

1.3.8 Following provision of the detailed Arboricultural Method Statement, prior to the commencement of any tree works a ~~thorough check~~ survey for protected species (including nesting birds, bats and badgers) is to be undertaken. If evidence of any protected species is discovered the advice of the appointed Ecological Clerk of Works must be obtained. This may include further pre-commencement survey and obtained a mitigation licence for the proposed works. Vegetation clearance will be undertaken in advance of construction and at an appropriate time of year (ideally between ~~in~~ September and February~~or October~~, concordant with the requirements for avoidance of nesting birds).

1.3.9 Where reasonably practicable, vegetation clearance works will be undertaken outside the bird breeding season, which is generally between March and August inclusive. Where this is not reasonably practicable, an ecologist will inspect all areas of vegetation prior to clearance, and clearance will only be undertaken subject to the instruction and requirements of the ecologist to protect any birds and their nests;

1.4 Scheme briefing for site personnel

1.4.1 The appointed Arboriculturist is responsible for ensuring that all personnel are made fully aware of the constraints posed by retained trees in relation to the Scheme and the measures in place to ensure that they are protected, including having full on-site access to the detailed Arboricultural Method Statement .

1.4.2 It is good practice for the appointed Arboriculturist to be involved in the Scheme briefing to ensure all constraints and tree protection measures are clearly understood by site construction workers.

1.4.3 A Tool Box Talk shall be provided to the site personnel to highlight the need for safe driving of plant and working within the defined corridor to ensure that the risk of accidents and resulting potential damage to trees not covered by tree protection measures are significantly reduced. A copy of the detailed Arboricultural Method Statement must be available in the designated Scheme main office at all times.

1.5 Site monitoring

1.5.1 An auditable system of site monitoring shall be established to guide contractors on site to ensure that tree protection measures are implemented and adhered to.

1.5.2 This includes site visits by the appointed Arboriculturist to confirm the correct installation of protective fencing, to oversee sensitive elements of works within the Root Protection Areas (RPAs) of retained trees, to review the suitability and stability of retained sections of tree groups following removals and to sign off the Scheme when works are completed and tree protection fencing can be dismantled.

1.6 Installation of tree protection fencing

1.6.1 In advance of tree protection fencing installation, RPA measurements of retained trees shall be confirmed by the appointed Arboriculturist. The final position of fencing must be confirmed on site by the Arboriculturist and will align with the arrangement of protection measures on the final Tree Protection and Removal Plan

1.6.2 The default position as set out by BS 5837:2012 is that retained trees must be protected from construction operations with the erection of robust protective fencing positioned on the outer edge of the RPA or crown spread (whichever is greatest). In accordance with Natural England and The Forestry Commission guidance (2018), RPAs shall be increased for proximal veteran trees as confirmed by the Arboriculturist.

1.6.3 All site operations will be restricted to the area outside of tree protection fencing and this area will form a Construction Exclusion Zone (CEZ) unless agreed otherwise. Protection measures will be installed around the RPA or canopy spread of retained tree features.

1.6.4 The area inside the fence and any additional tree protection measures will be sacrosanct and must not be removed or altered without the prior approval of the Arboriculturist. Any damage to tree protection measures must be reported immediately.

1.6.5 Tree protection fencing shall be constructed with robust vertical and horizontal scaffold framework with weldmesh panels (e.g. Heras or equivalent) firmly attached in accordance with BS 5837:2012 Figure 2. Vertical support poles and bracing poles must be located with care to avoid underground utility services and will be sited to avoid the structural roots of retained trees. Where driven supports are inappropriate or impractical, panels will be footed in block trays or equivalent.

1.6.6 Alternative equivalent robust and immovable fencing specification including site hoarding will also be appropriate. Suitable all-weather signage will be fixed to fencing to notify site staff and visitors of the construction exclusion zone and its purpose.

1.6.7 When entering and exiting the Scheme, the fencing contractor must avoid the production of ruts on unmade ground. Protective fencing and ground protection shall stay in place until all construction operations are completed and removal is agreed with the Arboriculturist.

1.7 Ground Protection

1.7.1 In general, tree protection fencing will ensure an effective CEZ is maintained for all retained trees. This will be positioned as set out in the final Tree Protection and Removal Plan.

1.7.2 Where the Scheme requires unavoidable access within the RPA of a retained tree, fit for purpose ground protection must be in place which is sufficient to protect the structure of the soil from damage based on the heaviest anticipated load. This must be installed prior to the commencement of any development activity in proximity to retained trees on the Site and be signed off by the Arboriculturist. No top soil stripping will be permitted within RPAs.

1.7.3 As set out in section 6.2.3.3 of BS5837:2012, the following ground protection measures will be appropriate if deemed necessary by the Site Arboriculturist:

1.7.4 Suitable ground protection for pedestrian only access will comprise a single thickness of appropriate boarding/ matting set on a compressible layer of 100mm of woodchip or sharp sand on a geotextile separation layer

1.7.5 Pedestrian operated plant up to two tonnes in weight would require the use of a proprietary ground protection system (such as Ground Guards, Eki mats, Eve Trakway or equivalent) set on a minimum depth of 150mm woodchip or sharp sand

1.7.6 Heavier loads will require ground protection to an engineering specification in conjunction with arboricultural advice.

1.7.7 As a guide, the threshold beyond which root development is significantly affected is a bulk density ranging from 1.4g per cm^3 for clay soils, to 1.75g per cm^3 for sandy soils.

1.7.8 The existing hard surfacing will act as suitable ground protection where present and must be retained in situ unless otherwise approved by the Arboriculturist.

1.7.9 Tree protective measures shall stay in place until all construction operations are completed and removal is agreed with the appointed Arboriculturist.

1.8 Movement of Vehicles and People and the Movement and Operation of Machinery

1.8.1 Construction works and in particular the use of machinery must be carefully co-ordinated to avoid damage to retained trees. A banksman must be in place for any operations which occur within 5m of any part of a retained tree. Protective fencing will be in place to ensure tree canopies and root systems are fully protected during the main construction works.

1.8.2 Fencing can be set back at a later stage to facilitate more sensitive works such as the installation of services in proximity to retained trees (where relevant) which will be carried out following approval by the Arboriculturist; by pedestrian only access utilising fit for purpose ground protection as detailed in Section 10.8 (under the supervision of the Arboriculturist).

1.9 Site organisation, storage and mixing of materials

1.9.1 The location of site compounds and storage areas will be agreed in advance with the Arboriculturist.

1.9.2 Before any work begins the outer fence for compounds and stockpile sites will be set out and the Site Arboriculturist will confirm the position of fencing to ensure adjacent retained trees are fully protected.

1.9.3 The storage and mixing of materials and any re-fuelling shall take place at least 5m from the RPA of any retained trees and also take into account any potential for run off. Where this is an issue measures such as bunding with robust impermeable polythene sheeting and sandbags must be put in place to prevent accidental run off reaching the rooting zone of retained trees.

1.9.4 No changes in ground level are permitted within the RPA of a retained tree unless specifically agreed in advance with the Arboriculturist and captured in the detailed Arboricultural Method Statement.

1.9.5 No fires shall take place within an RPA or within 5m of any part of a retained tree. No signs, cables or other items are to be attached to any part of a retained tree (with the exception of approved ecological habitat mitigation features).

1.10 General principles for the management of tree roots

1.10.1 Where agreed by the Site Arboriculturist, excavation by hand tools or compressed air takes place within a RPA the following principles will apply:

1.10.2 Individual or small groups of roots less than 25mm in diameter will be retained where possible but can be severed with a sharp tool such as secateurs or pruning saws to leave a clean-cut end (ideally 100mm back from the face of the excavation to account for future regrowth) where they pose an obstruction.

1.10.3 Where roots are encountered which are larger than 25mm in diameter or where significant groups of smaller roots are found, the advice of the Site Arboriculturist must be sought to decide an appropriate course of action.

1.10.4 Roots must only be exposed for the minimum period possible. In the interim period any exposed roots (including the face of any excavation within an RPA) must be completely covered with dampened hessian sacking (which may require ongoing re-wetting) to avoid drying out and exposure to light. Backfill for excavations should ideally utilise the parent material and must not be significantly compacted.

1.11 Installation of New Access Trackways within RPAs

1.11.1 In order to maintain a growing environment which is able to support the long-term growth of trees, and to avoid the requirement for an excavated subbase (which would result in root severance). Any new surfacing within RPAs where required should be built on top of existing ground levels (using no-dig techniques) and its construction should be engineer designed, adapted to the intended gross vehicle weight. This can be achieved using a proprietary 3D raft or tile system such as Cellweb, ArborRaft or equivalent.

1.11.2 All new installed surfacing should allow a minimum 0.5m distance from the base of trees. Any edging within RPAs must be installed without excavation and can utilise pinned methods including proprietary systems such as StableEDGE or equivalent such as a kerb cast directly into the raft.

1.11.3 Installation within RPAs should be supervised by the appointed Arboriculturist. All machinery and construction activity should be positioned either on ground protection or outside of the RPAs of retained trees at all times to prevent root disturbance. The new surface must be rolled out. Machinery must reach towards retained trees and work backwards to reduce any potential for damage to stems or branches of retained trees. No access onto unprotected soft ground within an RPA will be permitted.

1.12 Earthworks

1.12.1 Any required earthworks shall be positioned outside the RPA or canopy spread (whichever is greatest) of retained trees as confirmed by the Arboriculturist. Where earthworks are required within the RPA or canopy of retained trees, the Arboriculturist will be consulted and a methodology agreed prior to any works being carried out.

1.12.2 Where the movement of any part of any plant is required within 5m of any part of a retained tree a banksman will supervise the operation. If additional tree works are required these will be discussed in advance with the Arboriculturist.

1.12.3 Where non-structural fill involving only small increases (up to 200mm) in ground level is required (such as to tie in to existing levels), this will be agreed with the Arboriculturist in advance and achieved using free draining inert granular material only (such as sharp sand or free draining topsoil) which must not be significantly compacted (e.g. light hand tamping only).

1.13 Installation of tree protection fencing, security fencing and CCTV footings in proximity to retained trees

1.13.1 New CCTV footings and security fencing positions will be adjusted to avoid the canopy spread or RPA (whichever is greatest) of retained trees as confirmed by the Arboriculturist.

1.13.2 Where fencing positions or footings within RPAs are unavoidable, the appointed Arboriculturist shall be notified in advance. Where relevant, positions will be as far from retained trees as possible and the footing will be the smallest dimensions feasible (which could include the use of screw piles or equivalent). The excavation will be dug by hand or vacuum excavator under the supervision of the Arboriculturist and where significant roots are encountered the footing location will be micro-sited locally to avoid the requirement for significant root pruning as fully as possible.

1.13.3 Where uncured concrete is to be applied, this will be the driest mix feasible and the excavation will be lined with an impermeable membrane to prevent leaching into soil.

1.14 Removal of existing services

1.14.1 Where existing services are to be removed or diverted; the default position is that redundant cabling must be winched out from an access/ inspection chamber located outside of an RPA or left in situ.

1.14.2 The final methodology for utility removals will be developed and agreed with the Utility Contractor and appointed Arboriculturist.

1.14.3 Where sewers/ drainage pipes are to be decommissioned within the RPA of a retained tree, pipe work will be sealed off and will not be removed via excavation within the RPA of a retained tree. Redundant pipe work can be filled with an inert material or if confirmed to be fully watertight may be filled with foamed concrete applied from an access point located outside the RPA of all retained trees. Concrete must be managed in accordance with this PAMS.

1.15 Diversion and installation of services (including cables) within RPAs

1.15.1 The default position is that all diverted or new services be located outside of the RPA of retained trees. Where it is not feasible to fully avoid the RPA of retained trees, the final methodology for utility diversion will be developed and agreed with the Utility Contractor and Arboriculturist.

1.15.2 Where possible new or diverted utilities will be installed using trenchless techniques. Where possible, it may be acceptable for shallow service runs to be installed via hand excavation where significant tree roots can be retained and worked around.

1.16 Use of trenchless techniques

1.16.1 Where possible cables will be installed using trenchless methods within or near the RPA of retained trees. Insertion and retrieval pits must be located outside of the RPA of retained trees. The depth of the run must be at least 1.5m below ground level (taking into account tree species and soil type) and should be located as far from the tree as possible. The mole must be lubricated with water only.

1.16.2 Installation must follow the principles set out in the National Joint Utilities Group (NJUG) Vol 4: Guidelines for the planning, installation, and maintenance of utility apparatus in proximity to trees (issue 2) and BS5837 Section 7.7.

1.17 Trenching techniques

1.17.1 Where new cables must be positioned within the RPA of a retained tree and cannot be installed via trenchless methods, the Arboriculturist shall be notified in advance.

1.17.2 Where possible services shall be installed following the principles set out in the National Joint Utilities Group (NJUG) Vol 4: Guidelines for the planning, installation, and maintenance of utility apparatus in proximity to trees (issue 2).

1.17.3 Hand digging may be employed to achieve shallow surface runs which can be positioned to avoid significant tree roots (greater than 25mm diameter). The

excavation will be located as far from the stem of the tree as possible and must be carried out by hand (ideally using compressed air such as an Air Spade and soil vacuum) under the supervision of the appointed Arboriculturist.

1.17.4 Protective fencing will be set back to facilitate localised access to facilitate this work (following the prior approval of the Arboriculturist) and to allow a maximum working space of 0.5m on either side of the trench location. Pedestrian only access will be permitted, and ground protection measures will be employed with fencing positioned immediately adjacent to restrict any further access into RPAs.

1.17.5 Excavation will be supervised by the Site Arboriculturist who will be on hand to advise on the management of any roots encountered and to ensure the approved tree protection methodology is fully adhered to. Roots smaller than 25mm in diameter can be cut with a clean sharp tool where they pose an obstruction.

1.17.6 Should significant roots (larger than 25mm diameter or large clumps of smaller roots) be encountered these will be retained and wrapped in dampened hessian to prevent drying out and pipes will be routed around them wherever possible. If significant roots are encountered which cannot be feasibly worked around and retained the Site Arboriculturist will advise on appropriate next steps.

1.17.7 All spoil/ arisings from excavation will be placed onto ground protection boards to prevent compaction, ground level changes and to assist in removal or reinstatement. Backfill is to utilise the excavated parent material where feasible, applied to restore the soil profile to its original structure (i.e. topsoil will be installed last) and must be lightly hand tamped only.

1.17.8 Following service installation within RPAs, ground protection will be removed, and the original position of protective fencing will be reinstated under supervision of the Arboriculturist.

1.18 Soft landscaping works

1.18.1 Where new soft landscaping is proposed within the RPA of retained trees the Arboriculturist shall be notified in advance and the following principles must be observed:

1.18.2 Soil levels must be maintained at existing levels, not more than a maximum of 200mm of free draining topsoil is to be added to ground within the RPA of retained trees and this must avoid the area immediately around the stem base of existing trees (minimum offset of 0.5m).

1.18.3 No rotovating of the soil will be permitted within RPAs, any excavation for new planting must be hand dug by pedestrian only contractor access. Where significant tree roots are present during excavation for new planting, positions of new plants will be adjusted to avoid root damage.

1.18.4 Soil must be backfilled to match the original soil profile and backfill must not be significantly compacted but can be heeled in layers of 300-400mm.

1.18.5 Any plant or machinery must be positioned outside of RPAs or be sited on fit for purpose ground protection which must be agreed in advance with the Arboriculturist.

1.19 Dismantling of tree protection measures

1.19.1 All protective fencing and ground protection must remain in place until all significant scheme works have been completed and approval has been obtained from the Arboriculturist.

1.20 Contact details in relation to arboricultural works

Scheme Manager:	To be confirmed
Appointed Arboriculturist:	To be confirmed
Local Planning Authority Tree Officer(s):	To be confirmed

Appendix D Tree Protection and Removal Plans

Author: GR Designer: JB Checked: TF Approved: AW

Last saved by: BREWER.I (2023-01-13) Last Plotted: 2023-01-13
Filename: C:\USERS\BREWER.I\ONEDRIVE - AECOM\DESKTOP\SUNNICA FARMS\SUNNICA ENERGY FARN - TPP_001 - OFFLINE COPY\SUNNICA ENERGY FARN - TPP_006(SIMPLIFIED).DWG

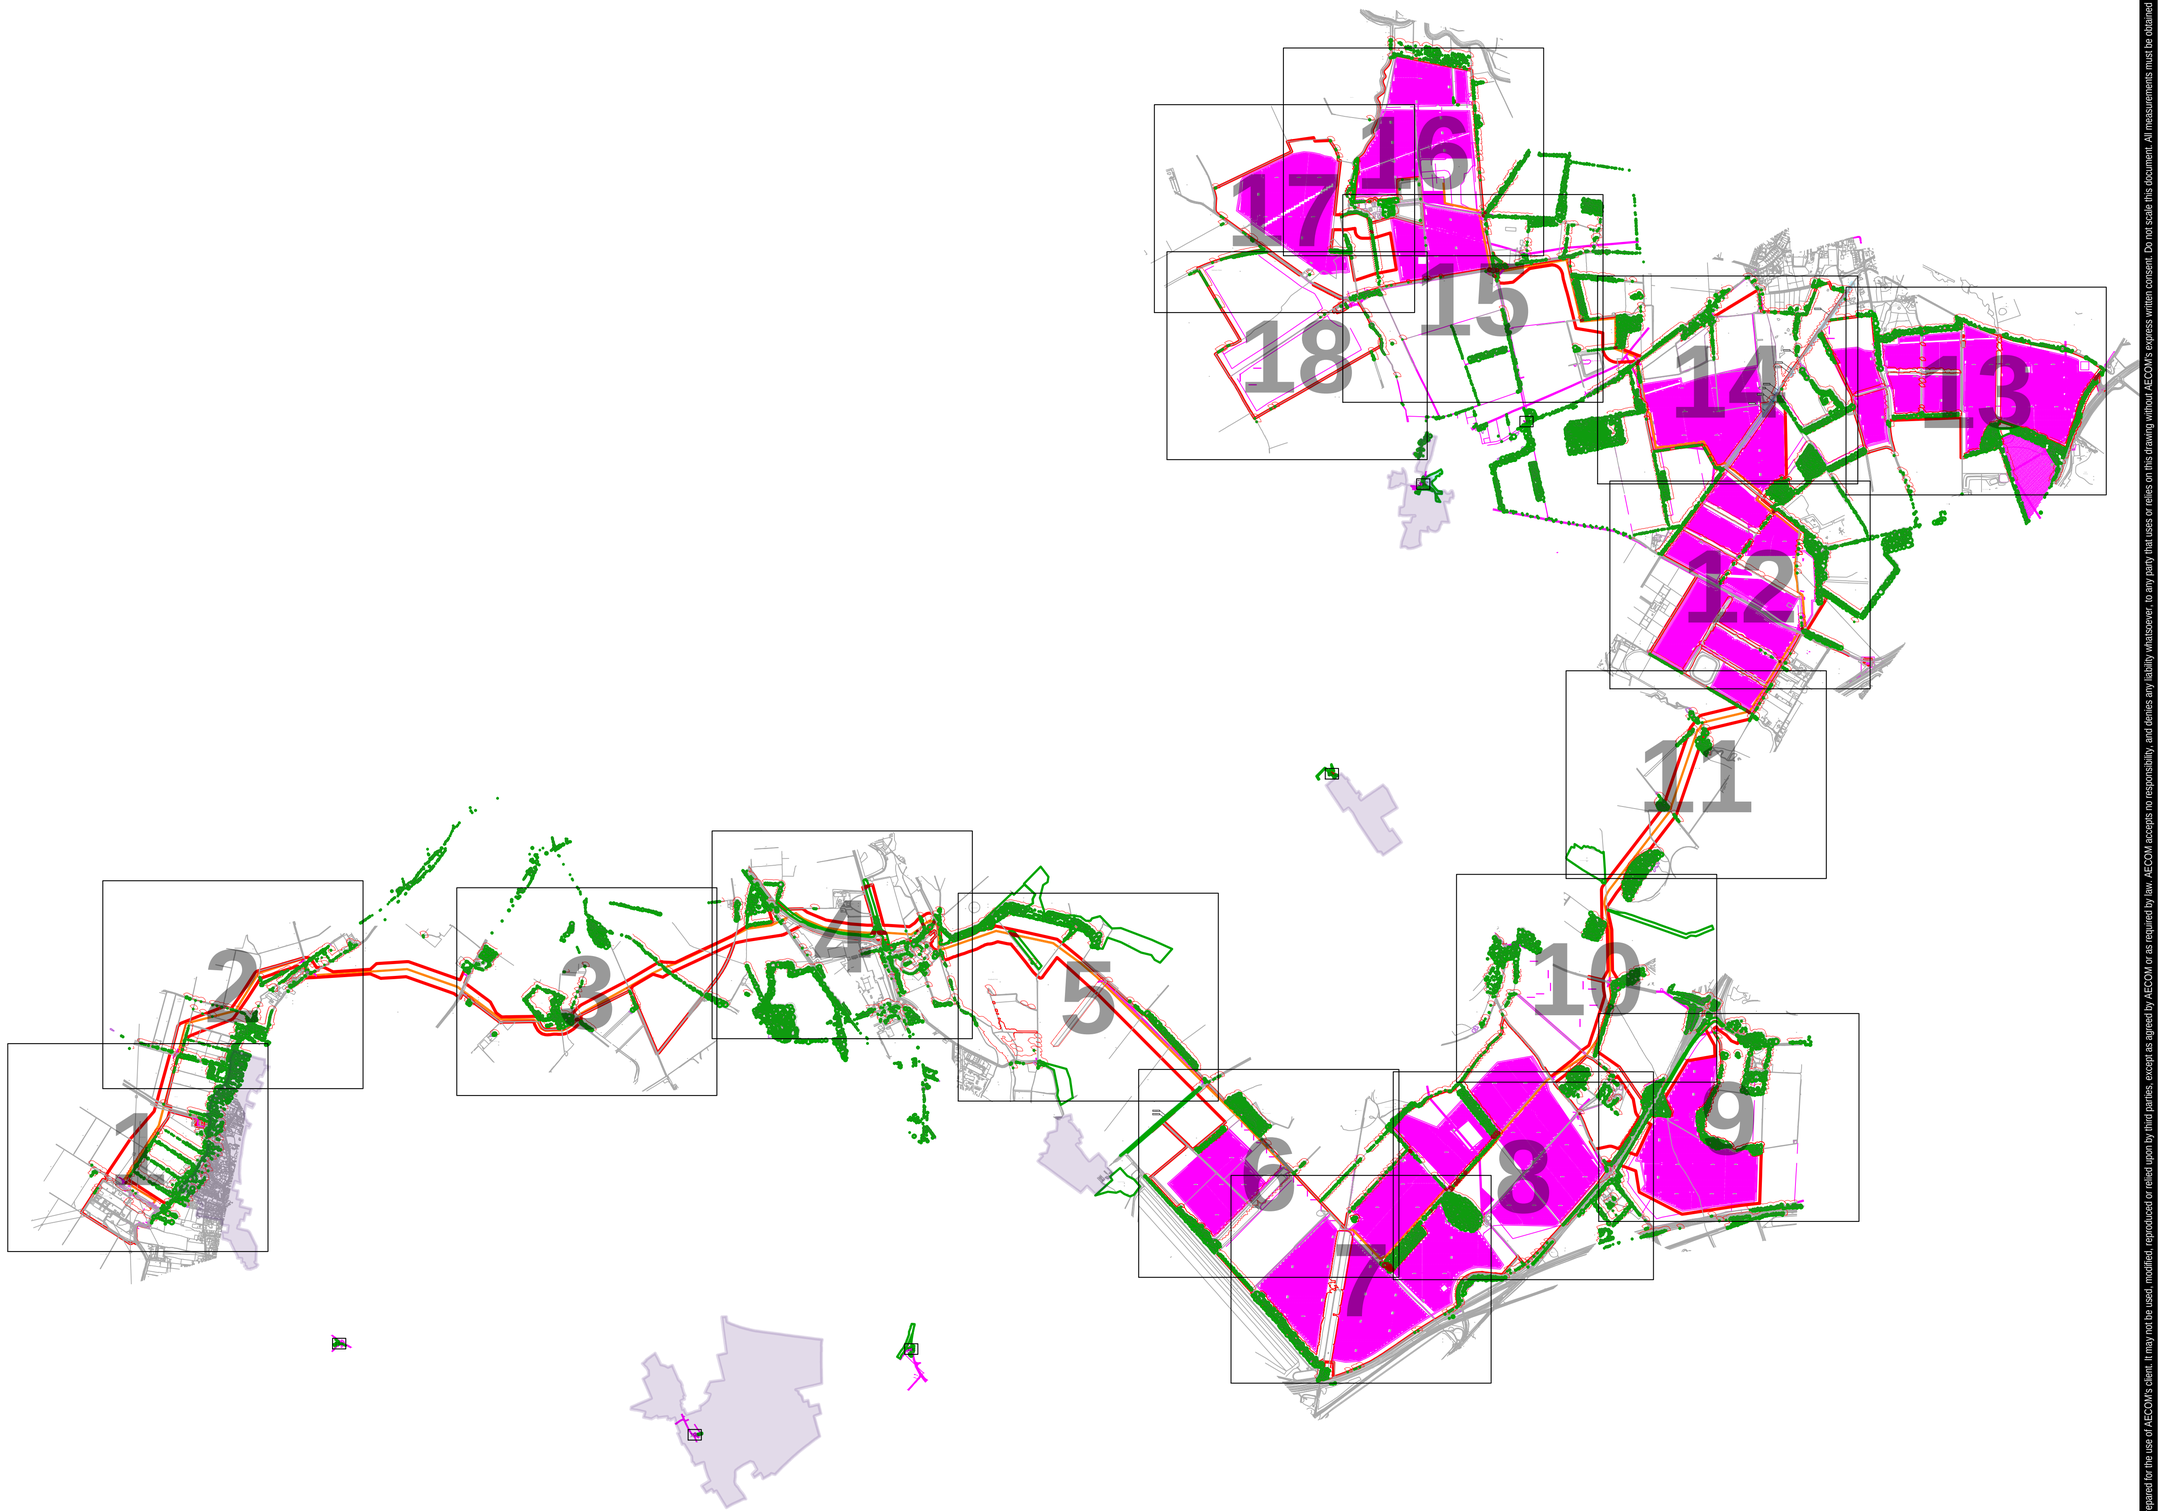

This drawing has been prepared for the use of AECOM's client. It may not be used, modified, reproduced or relied upon by third parties, except as agreed by AECOM or as required by law. AECOM accepts no responsibility, and denies any liability whatsoever, to any party that uses or relies on this drawing without AECOM's express written consent. Do not scale this document. All measurements must be obtained from the stated dimensions.

AECOM

PROJECT

SUNNICA ENERGY FARM

CLIENT

SUNNICA ENERGY FARM

CONSULTANT

AECOM
Plumer House, Third Floor,
East Wing, Tailyour Road
Plymouth, PL6 5DH
Tel +44(0)1752 676700
Fax +44(0)870 238 6023
www.aecom.com

GENERAL NOTES

1. TREE CATEGORIES AS DEFINED BY BS 5837:2012
2. TREE LOCATIONS ARE BASED ON THE TOPOGRAPHICAL SURVEY, AERIAL IMAGERY, AND GPS CO-ORDINATES FROM ON SITE WALKOVER.
3. * INDICATES A TREE / GROUP WHOSE POSITION IS APPROXIMATE AS BASED UPON AERIAL PHOTOGRAPHY AND ON SITE OBSERVATIONS.
4. PLANS SHOULD BE READ IN CONJUNCTION WITH THE AECOM ARBORICULTURAL REPORT.
5. THE ORIGINAL OF THIS DRAWING WAS PRODUCED IN COLOUR - A MONOCHROME COPY SHOULD NOT BE RELIED UPON.
6. DRAWING REFERNCES:
   - xref_topo.dwg
   - TPO.dwg
   - xref_cstastro.dwg
   - MERGED NTM CATA Rev8 Modified (TPP EDITS).dwg
   - Additional data.dwg
   - Shading Arc (Removed).dwg
   - Shading Arc (cent).dwg
   - 20230105_Sunnica_WSP_RLB.dwg
   - 210309_blank_v4 (Modified - West Site B Removed).dwg

KEY PLAN

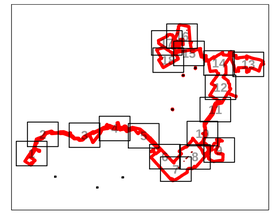

KEY

- **ORDER LIMITS BOUNDARY**
- **EXISTING TREE, GROUP, WOODLAND, OR HEDGE TO BE RETAINED** *(TREE TAGS INDICATE TREES SUBJECT TO DETAILED SURVEY, NO TREE TAG INDICATES TREES BASED ON NTMDESK STUDY)*
- **EXISTING TREE, GROUP, WOODLAND, OR HEDGE TO BE REMOVED** *(TREE TAGS INDICATE TREES SUBJECT TO DETAILED SURVEY, NO TREE TAG INDICATES TREES BASED ON NTMDESK STUDY)*
- **ROOT PROTECTION AREAS (RPA)** *(AS DEFINED BY BS 5837:2012 FOR TREES SUBJECT TO DETAILED SURVEY, ESTIMATED BUFFER ZONE SHOWN INDICATIVELY FOR OTHER TREES)*
- **APPROXIMATE SHADING ARC** *(W/ PREDICTED MAXIMUM GROWTH HEIGHT OUTLINE)*
- **VETERAN/ANCIENT TREE** *(IDENTIFIED BY DETAILED SURVEY)*
- **VETERAN/ANCIENT TREE** *(IDENTIFIED BY WALKOVER/DESK STUDY)*
- **PROPOSED DEVELOPMENT LAYOUT** *(BASED UPON DRAWING REFERENCES LISTED IN THE GENERAL NOTES SECTION)*
- **CONSTRUCTION WORKING ZONE** *(MANAGED CONSTRUCTION PROCESSES PERMITTED IN ACCORDANCE WITH THE PRINCIPLES SET OUT WITHIN THE ARBORICULTURAL IMPACT ASSESSMENT)*
- **TREE PRESERVATION ORDER** *(AREA COVERED BY A TREE PRESERVATION ORDER [TPO])*
- **CONSERVATION AREA** *(AREA COVERED BY A TREE PRESERVATION ORDER [TPO])*
- **PROPOSED CABLE ROUTE**

ISSUE/REVISION

P01	13/01/23	SECOND ISSUE
00	22/11/22	FIRST ISSUE
I/R	DATE	DESCRIPTION

DRAWING STATUS

SUBMITTED AT DEADLINE 5

PROJECT NUMBER

60589004

SHEET TITLE

TREE PROTECTION & REMOVAL PLAN (SHEET 0)

SHEET NUMBER **REV.**

60589004-ACM-XX-XX-AB-TPP-00 P01

Author: GR Designer: JB Checked: TF Approved: AW

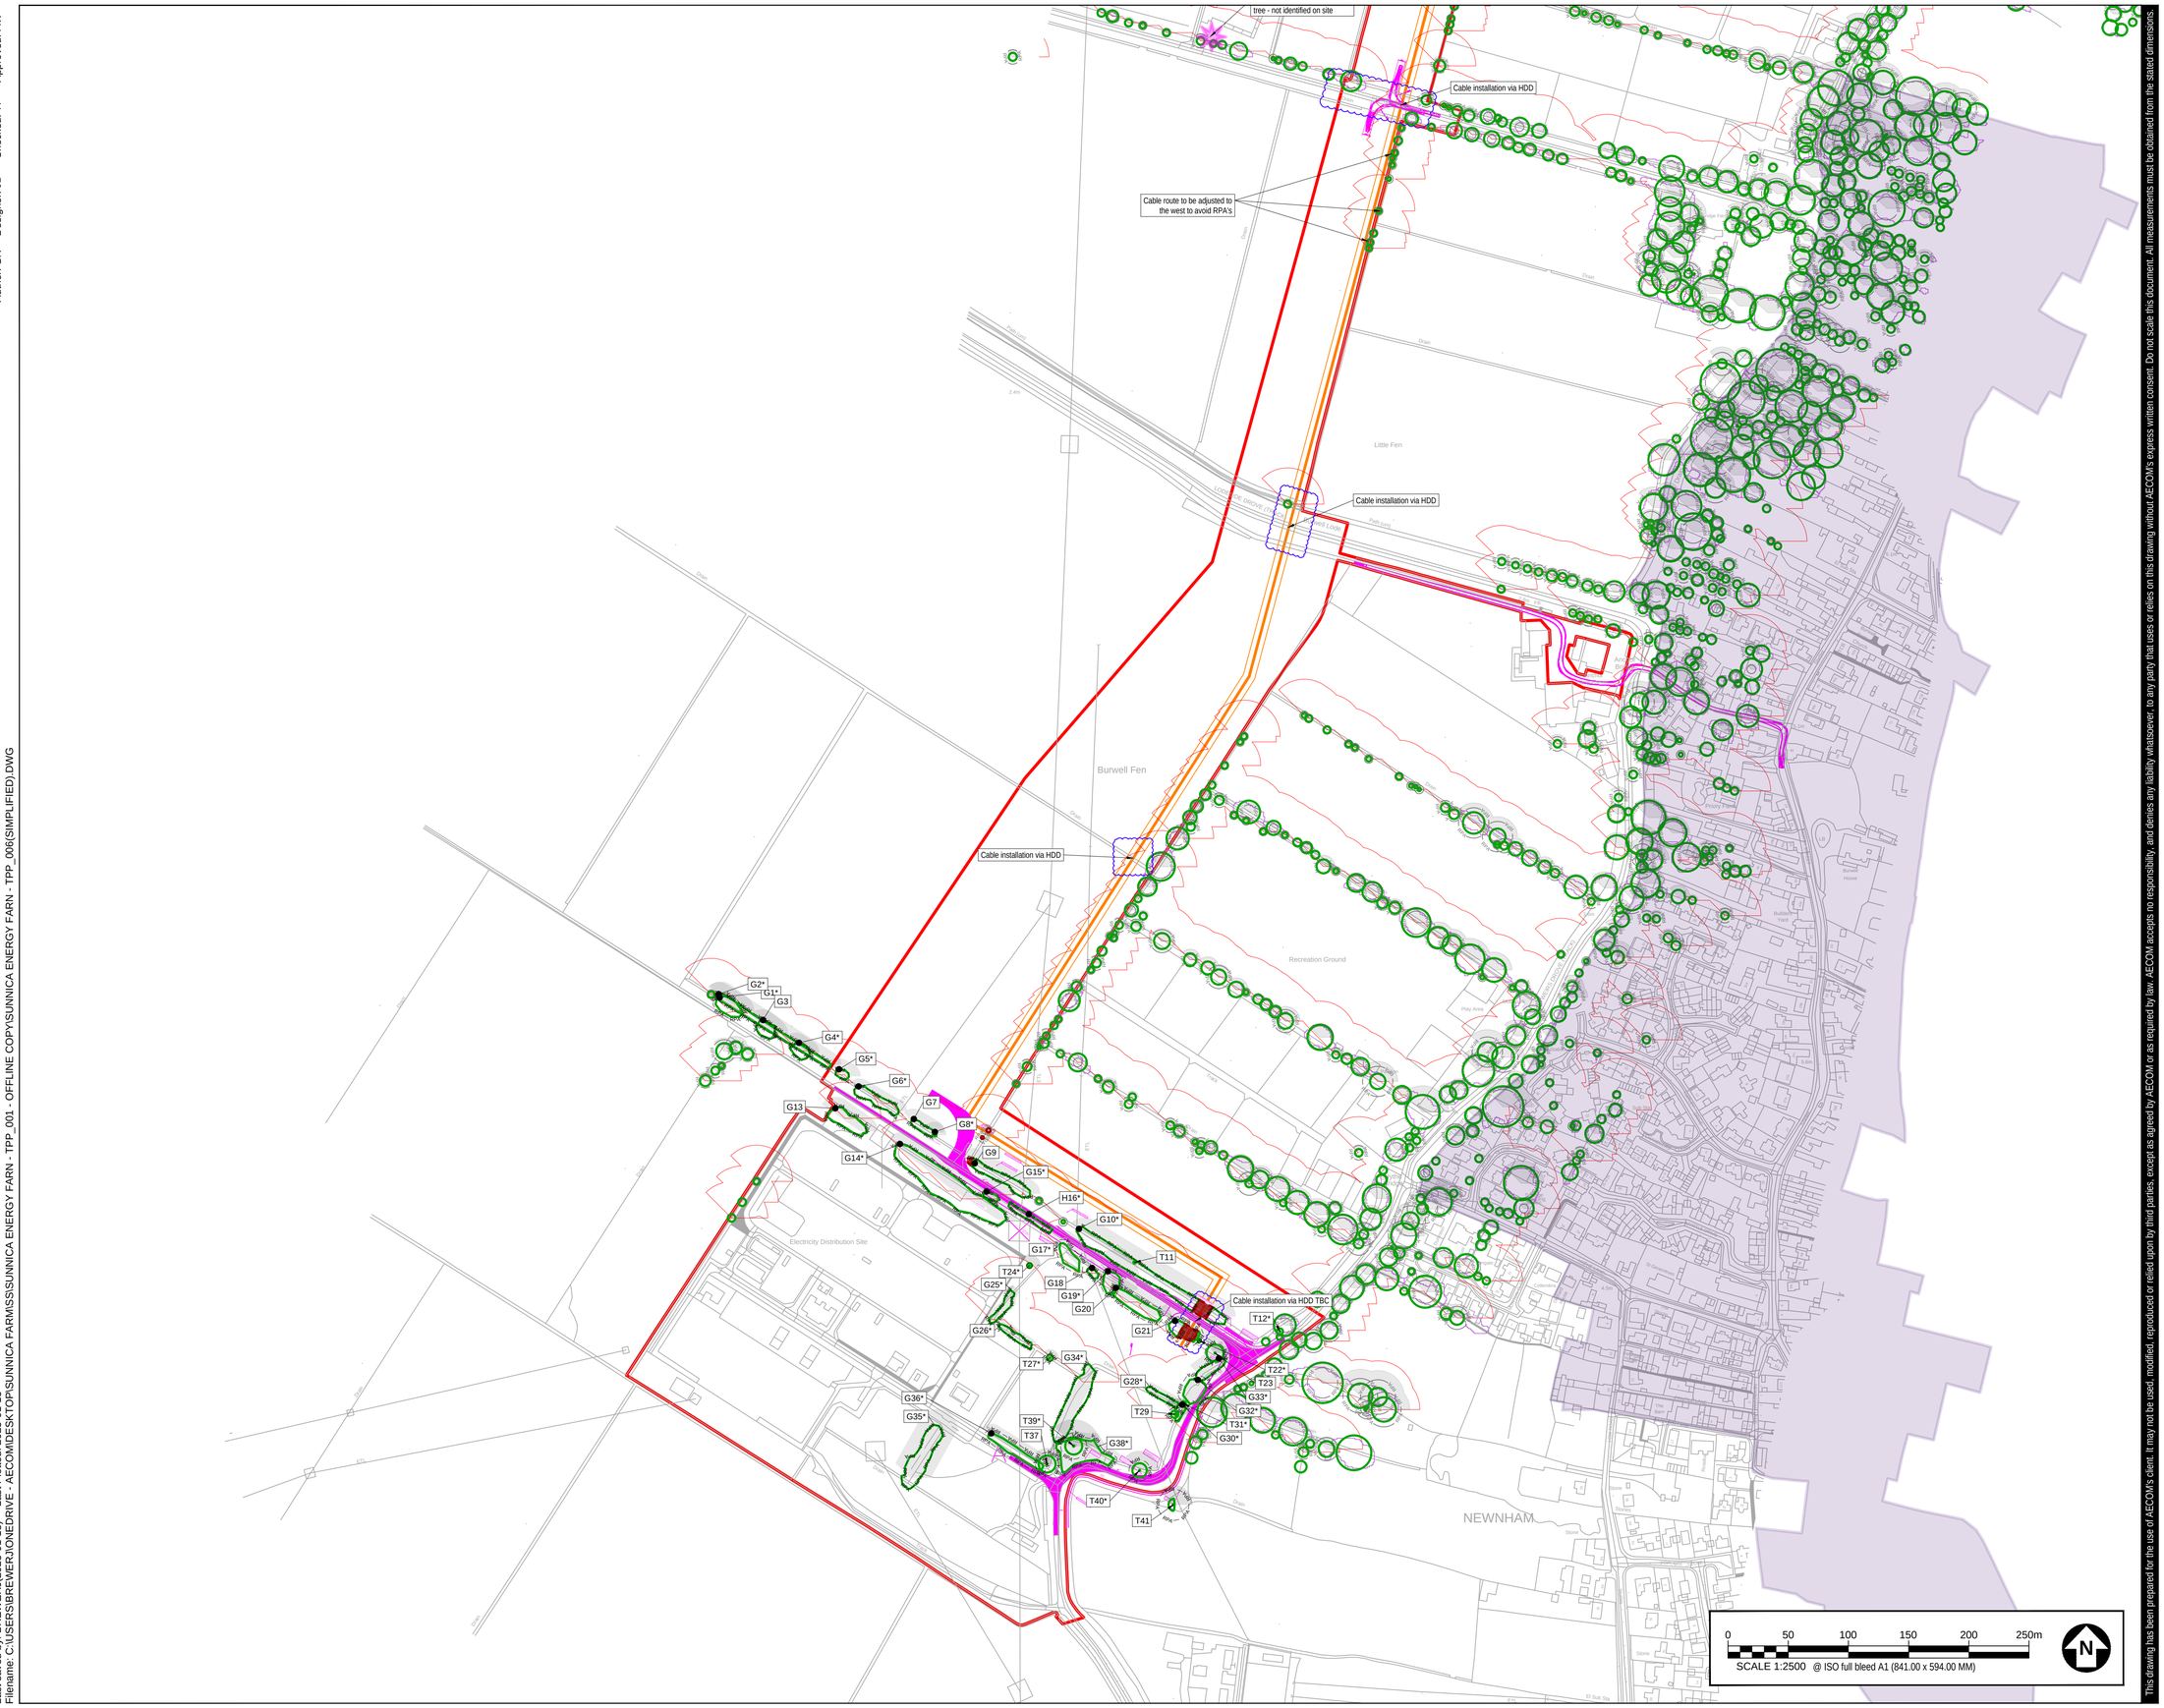

Last saved by: BREWERJ (2023-01-13) Last Plotted: 2023-01-13
Filename: C:\USERS\BREWERJ\ONEDRIVE - AECOM\DESKTOP\SUNNICA FARM\SS\SUNNICA ENERGY FARN - TPP_001 - OFFLINE COPY\SUNNICA ENERGY FARN - TPP_006(SIMPLIFIED).DWG

This drawing has been prepared for the use of AECOM's client. It may not be used, modified, reproduced or relied upon by third parties, except as agreed by AECOM or as required by law. AECOM accepts no responsibility and denies any liability whatsoever, to any party that uses or relies on this drawing without AECOM's express written consent. Do not scale this document. All measurements must be obtained from the stated dimensions.

AECOM

PROJECT

SUNNICA ENERGY FARM

CLIENT

SUNNICA ENERGY FARM

CONSULTANT

AECOM
Plumer House, Third Floor,
East Wing, Tailyour Road
Plymouth, PL6 5DH
Tel +44(0)1752 676700
Fax +44(0)870 238 6023
www.aecom.com

GENERAL NOTES

1. TREE CATEGORIES AS DEFINED BY BS 5837:2012
2. TREE LOCATIONS ARE BASED ON THE TOPOGRAPHICAL SURVEY, AERIAL IMAGERY, AND GPS CO-ORDINATES FROM ON SITE WALKOVER.
3. * INDICATES A TREE / GROUP WHOSE POSITION IS APPROXIMATE AS BASED UPON AERIAL PHOTOGRAPHY AND ON SITE OBSERVATIONS.
4. PLANS SHOULD BE READ IN CONJUNCTION WITH THE AECOM ARBORICULTURAL REPORT.
5. THE ORIGINAL OF THIS DRAWING WAS PRODUCED IN COLOUR - A MONOCHROME COPY SHOULD NOT BE RELIED UPON.
6. DRAWING REFERNCES:
   - xref_topo.dwg
   - TPO.dwg
   - xref_cstastro.dwg
   - MERGED NTM DATA Rev8 Modified (TPP EDITS).dwg
   - Additional data.dwg
   - Shading Arc (corrected).dwg
   - Shading Arc (corrd case).dwg
   - 20230105_Sunnica_WSP_RLB.dwg
   - 210309_blank_ - v4 (Modified - West Site B Removed).dwg

KEY PLAN

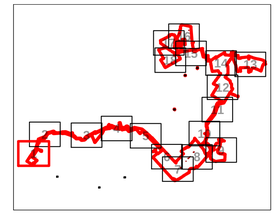

KEY

- **ORDER LIMITS BOUNDARY**
- **EXISTING TREE, GROUP, WOODLAND, OR HEDGE TO BE RETAINED** *(TREE TAGS INDICATE TREES SUBJECT TO DETAILED SURVEY, NO TREE TAG INDICATES TREES BASED ON NTM/DESK STUDY)*
- **EXISTING TREE, GROUP, WOODLAND, OR HEDGE TO BE REMOVED** *(TREE TAGS INDICATE TREES SUBJECT TO DETAILED SURVEY, NO TREE TAG INDICATES TREES BASED ON NTM/DESK STUDY)*
- **ROOT PROTECTION AREAS (RPA)** *(AS DEFINED BY BS 5837:2012 FOR TREES SUBJECT TO DETAILED SURVEY, ESTIMATED BUFFER ZONE SHOWN INDICATIVELY FOR OTHER TREES)*
- **APPROXIMATE SHADING ARC** *(W/ PREDICTED MAXIMUM GROWTH HEIGHT OUTLINE)*
- **VETERAN/ANCIENT TREE** *(IDENTIFIED BY DETAILED SURVEY)*
- **VETERAN/ANCIENT TREE** *(IDENTIFIED BY WALKOVER/DESK STUDY)*
- **PROPOSED DEVELOPMENT LAYOUT** *(BASED UPON DRAWING REFERENCES LISTED IN THE GENERAL NOTES SECTION)*
- **CONSTRUCTION WORKING ZONE** *(MANAGED CONSTRUCTION PROCESSES PERMITTED IN ACCORDANCE WITH THE PRINCIPLES SET OUT WITHIN THE ARBORICULTURAL IMPACT ASSESSMENT)*
- **TREE PRESERVATION ORDER** *(AREA COVERED BY A TREE PRESERVATION ORDER [TPO])*
- **CONSERVATION AREA** *(AREA COVERED BY A TREE PRESERVATION ORDER [TPO])*
- **PROPOSED CABLE ROUTE**

ISSUE/REVISION

I/R	DATE	DESCRIPTION
P01	13/01/23	SECOND ISSUE
00	22/11/22	FIRST ISSUE

DRAWING STATUS

SUBMITTED AT DEADLINE 5

PROJECT NUMBER

60589004

SHEET TITLE

TREE PROTECTION & REMOVAL PLAN (SHEET 1)

SHEET NUMBER 60589004-ACM-XX-XX-AB-TPP-01

REV. P01

Author: GR Designer: JB Checked: TF Approved: AW

Last saved by: BREWERJ(2023-01-13) Last Plotted: 2023-01-13
Filename: C:\USERS\BREWERJ\ONEDRIVE - AECOM\DESKTOP\SUNNICA FARM\SS\SUNNICA ENERGY FARN - TPP_001 - OFFLINE COPY\SUNNICA ENERGY FARN - TPP_006(SIMPLIFIED).DWG

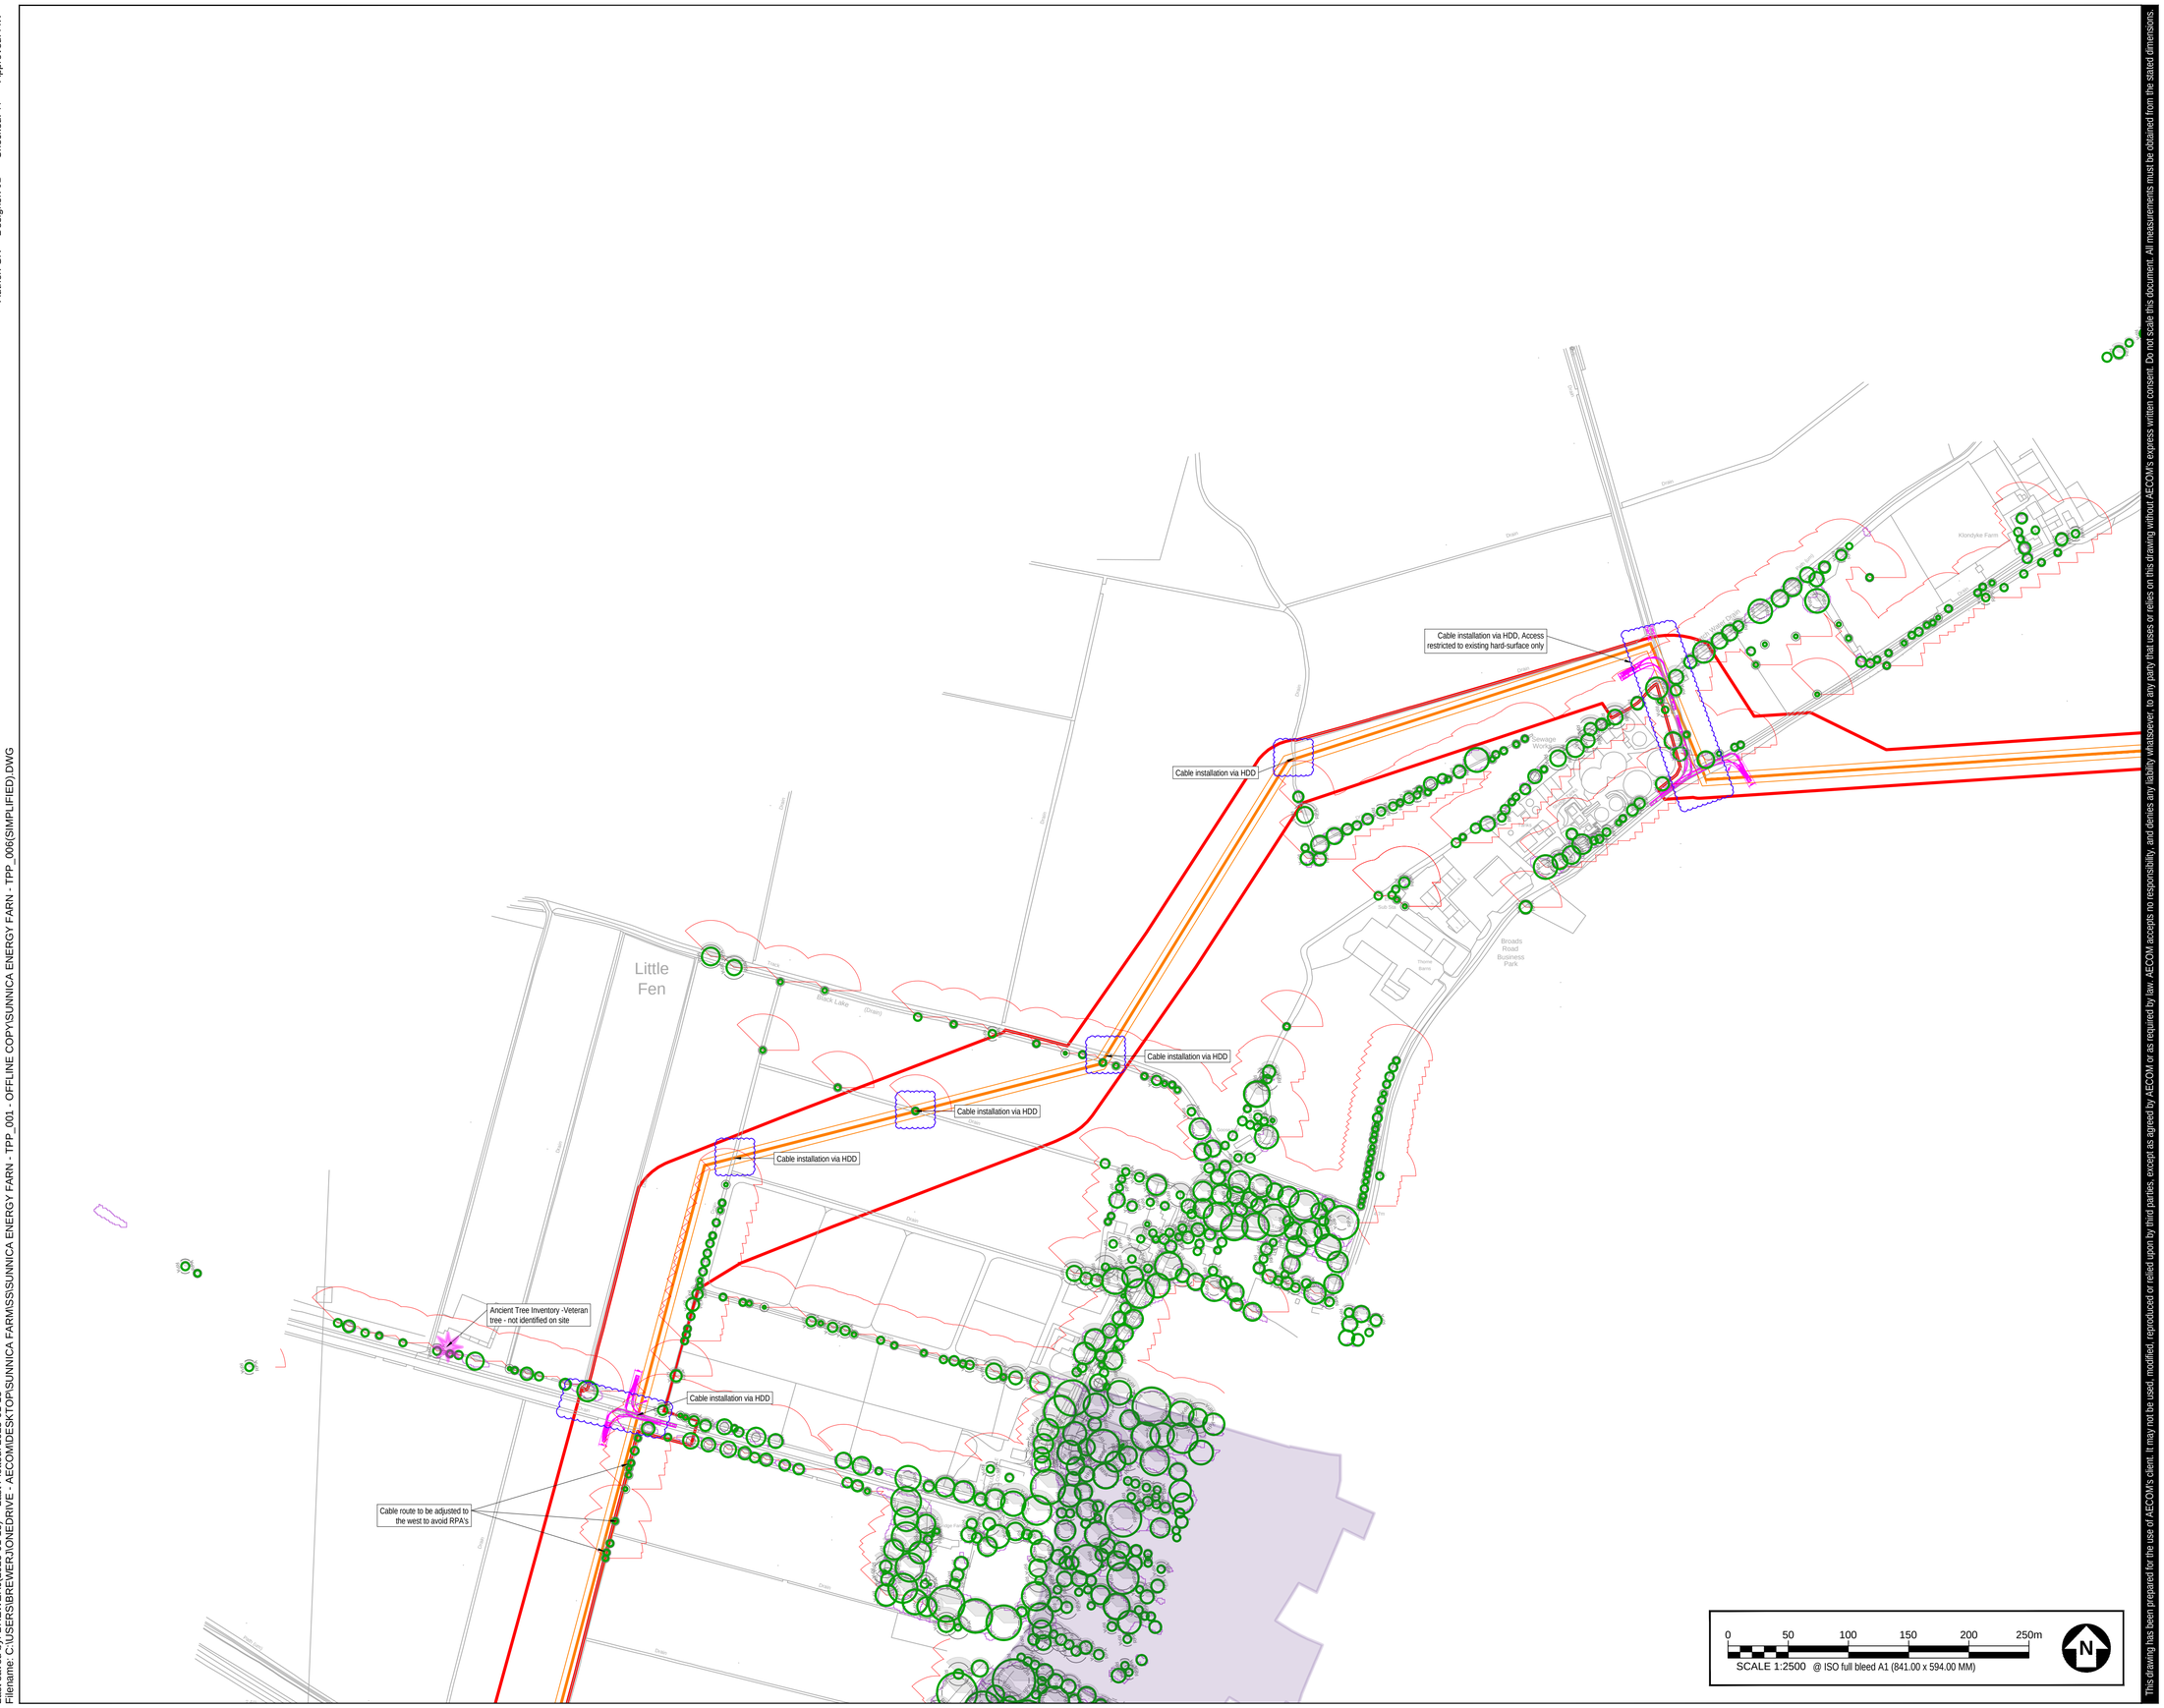

This drawing has been prepared for the use of AECOM's client. It may not be used, modified, reproduced or relied upon by third parties, except as agreed by AECOM or as required by law. AECOM accepts no responsibility, and denies any liability whatsoever, to any party that uses or relies on this drawing without AECOM's express written consent. Do not scale this document. All measurements must be obtained from the stated dimensions.

AECOM

PROJECT

SUNNICA ENERGY FARM

CLIENT

SUNNICA ENERGY FARM

CONSULTANT

AECOM
Plumer House, Third Floor,
East Wing, Tailyour Road
Plymouth, PL6 5DH
Tel +44(0)1752 676700
Fax +44(0)870 238 6023
www.aecom.com

GENERAL NOTES

1. TREE CATEGORIES AS DEFINED BY BS 5837:2012
2. TREE LOCATIONS ARE BASED ON THE TOPOGRAPHICAL SURVEY, AERIAL IMAGERY, AND GPS CO-ORDINATES FROM ON SITE WALKOVER.
3. * INDICATES A TREE / GROUP WHOSE POSITION IS APPROXIMATE AS BASED UPON AERIAL PHOTOGRAPHY AND ON SITE OBSERVATIONS.
4. PLANS SHOULD BE READ IN CONJUNCTION WITH THE AECOM ARBORICULTURAL REPORT.
5. THE ORIGINAL OF THIS DRAWING WAS PRODUCED IN COLOUR - A MONOCHROME COPY SHOULD NOT BE RELIED UPON.
6. DRAWING REFERNCES:
   - xref_topo.dwg
   - TPO.dwg
   - xref_cstastro.dwg
   - MERGED NTM DATA Rev8 Modified (TPP EDITS).dwg
   - Additional data.dwg
   - Shading Arc (corrected).dwg
   - Shading Arc (corrected case).dwg
   - 20230105_Sunnica_WSP_RLB.dwg
   - 210309_blend_-_vt (Modified - West Site B Removed).dwg

KEY PLAN

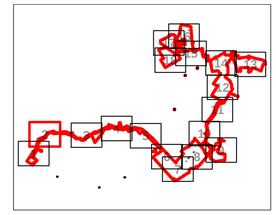

KEY

- **ORDER LIMITS BOUNDARY**
- **EXISTING TREE, GROUP, WOODLAND, OR HEDGE TO BE RETAINED** *(TREE TAGS INDICATE TREES SUBJECT TO DETAILED SURVEY, NO TREE TAG INDICATES TREES BASED ON NTM/DESK STUDY)*
- **EXISTING TREE, GROUP, WOODLAND, OR HEDGE TO BE REMOVED** *(TREE TAGS INDICATE TREES SUBJECT TO DETAILED SURVEY, NO TREE TAG INDICATES TREES BASED ON NTM/DESK STUDY)*
- **ROOT PROTECTION AREAS (RPA)** *(AS DEFINED BY BS 5837:2012 FOR TREES SUBJECT TO DETAILED SURVEY. ESTIMATED BUFFER ZONE SHOWN INDICATIVELY FOR OTHER TREES)*
- **APPROXIMATE SHADING ARC** *(W/ PREDICTED MAXIMUM GROWTH HEIGHT OUTLINE)*
- **VETERAN/ANCIENT TREE** *(IDENTIFIED BY DETAILED SURVEY)*
- **VETERAN/ANCIENT TREE** *(IDENTIFIED BY WALKOVER/DESK STUDY)*
- **PROPOSED DEVELOPMENT LAYOUT** *(BASED UPON DRAWING REFERENCES LISTED IN THE GENERAL NOTES SECTION)*
- **CONSTRUCTION WORKING ZONE** *(MANAGED CONSTRUCTION PROCESSES PERMITTED IN ACCORDANCE WITH THE PRINCIPLES SET OUT WITHIN THE ARBORICULTURAL IMPACT ASSESSMENT)*
- **TREE PRESERVATION ORDER** *(AREA COVERED BY A TREE PRESERVATION ORDER [TPO])*
- **CONSERVATION AREA** *(AREA COVERED BY A TREE PRESERVATION ORDER [TPO])*
- **PROPOSED CABLE ROUTE**

ISSUE/REVISION

I/R	DATE	DESCRIPTION
P01	13/01/23	SECOND ISSUE
00	22/11/22	FIRST ISSUE

DRAWING STATUS

SUBMITTED AT DEADLINE 5

PROJECT NUMBER

60589004

SHEET TITLE

TREE PROTECTION & REMOVAL PLAN (SHEET 2)

SHEET NUMBER **REV.**

60589004-ACM-XX-XX-AB-TPP-02 P01

Author: GR Designer: JB Checked: TF Approved: AW

Last saved by: BREWERJ (2023-01-13) Last Plotted: 2023-01-13
Filename: C:\USERS\BREWERJ\ONEDRIVE - AECOM\DESKTOP\SUNNICA FARM\SS\SUNNICA ENERGY FARN - TPP_001 - OFFLINE COPY\SUNNICA ENERGY FARN - TPP_006(SIMPLIFIED).DWG

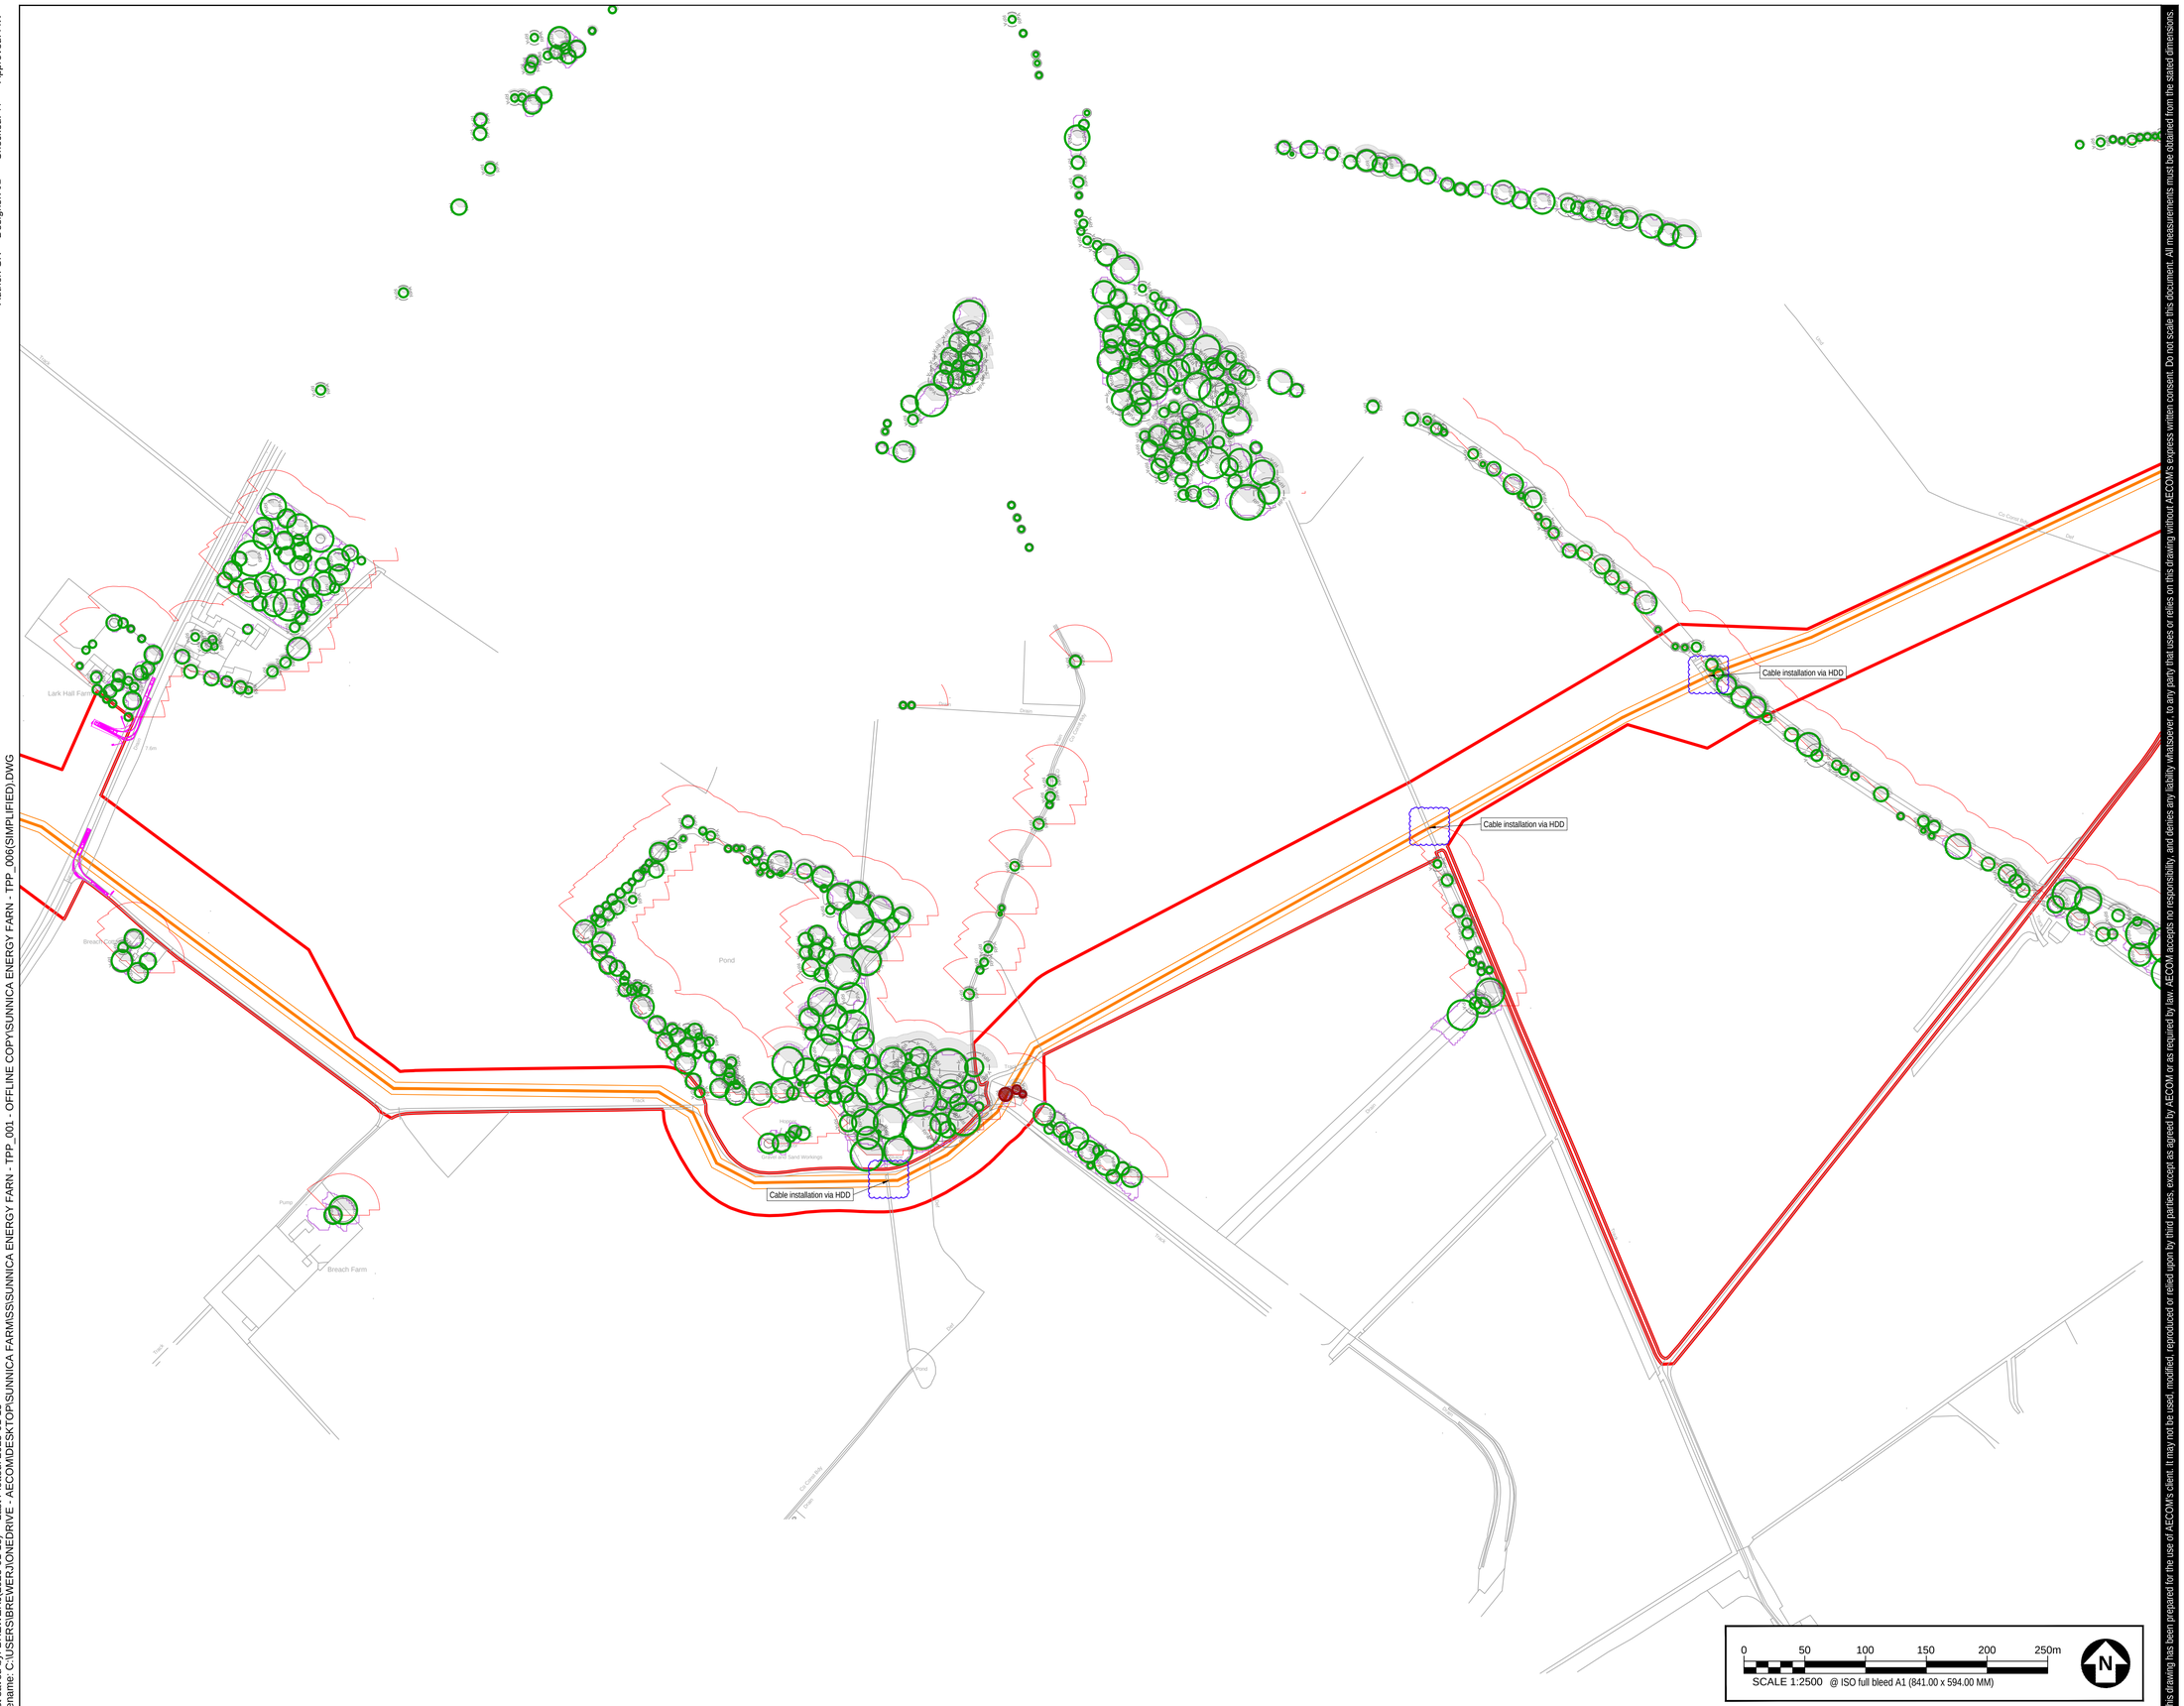
Cable installation via HDD
Cable installation via HDD
Cable installation via HDD
Lark Hall Farm
Breach Farm
Pond
Pond
Pond

Author: GR Designer: JB Checked: TF Approved: AW

Widening of track to north side only (no-dig)

Trees not included in the NTM dataset, identified via review of aerial imagery

Cable installation via HDD

Trees not included in the NTM dataset, identified via review of aerial imagery

Trees not included in the NTM dataset, identified via review of aerial imagery

Cable installation via HDD

Cable installation via HDD

0 50 100 150 200 250m

SCALE 1:2500 @ ISO full bleed A1 (841.00 x 594.00 MM)

This drawing has been prepared for the use of AECOM's client. It may not be used, modified, reproduced or relied upon by third parties, except as agreed by AECOM or as required by law. AECOM accepts no responsibility, and denies any liability whatsoever, to any party that uses or relies on this drawing without AECOM's express written consent. Do not scale this document. All measurements must be obtained from the stated dimensions.

AECOM

PROJECT

SUNNICA ENERGY FARM

CLIENT

SUNNICA ENERGY FARM

CONSULTANT

AECOM
Plumer House, Third Floor,
East Wing, Tailyour Road
Plymouth, PL6 5DH
Tel +44(0)1752 676700
Fax +44(0)870 238 6023
www.aecom.com

GENERAL NOTES

1. TREE CATEGORIES AS DEFINED BY BS 5837:2012
2. TREE LOCATIONS ARE BASED ON THE TOPOGRAPHICAL SURVEY, AERIAL IMAGERY, AND GPS CO-ORDINATES FROM ON SITE WALKOVER.
3. * INDICATES A TREE / GROUP WHOSE POSITION IS APPROXIMATE AS BASED UPON AERIAL PHOTOGRAPHY AND ON SITE OBSERVATIONS.
4. PLANS SHOULD BE READ IN CONJUNCTION WITH THE AECOM ARBORICULTURAL REPORT.
5. THE ORIGINAL OF THIS DRAWING WAS PRODUCED IN COLOUR - A MONOCHROME COPY SHOULD NOT BE RELIED UPON.
6. DRAWING REFERNCES:
   - xref_topo.dwg
   - TPO.dwg
   - xref_cstastro.dwg
   - MERGED NTM DATA Rev8 Modified (TPP EDITS).dwg
   - Additional data.dwg
   - Shading Arc (Updated).dwg
   - Shading Arc (worst case).dwg
   - 20230105_Sunnica_WSP_RLB.dwg
   - 210309_blank_v4 (Modified - West Site B Removed).dwg

KEY PLAN

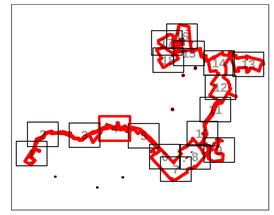

KEY

- **ORDER LIMITS BOUNDARY**
- **EXISTING TREE, GROUP, WOODLAND, OR HEDGE TO BE RETAINED** *(TREE TAGS INDICATE TREES SUBJECT TO DETAILED SURVEY, NO TREE TAG INDICATES TREES BASED ON NTM/DESK STUDY)*
- **EXISTING TREE, GROUP, WOODLAND, OR HEDGE TO BE REMOVED** *(TREE TAGS INDICATE TREES SUBJECT TO DETAILED SURVEY, NO TREE TAG INDICATES TREES BASED ON NTM/DESK STUDY)*
- **ROOT PROTECTION AREAS (RPA)** *(AS DEFINED BY BS 5837:2012 FOR TREES SUBJECT TO DETAILED SURVEY. ESTIMATED BUFFER ZONE SHOWN INDICATIVELY FOR OTHER TREES)*
- **APPROXIMATE SHADING ARC** *(W/ PREDICTED MAXIMUM GROWTH HEIGHT OUTLINE)*
- **VETERAN/ANCIENT TREE** *(IDENTIFIED BY DETAILED SURVEY)*
- **VETERAN/ANCIENT TREE** *(IDENTIFIED BY WALKOVER/DESK STUDY)*
- **PROPOSED DEVELOPMENT LAYOUT** *(BASED UPON DRAWING REFERENCES LISTED IN THE GENERAL NOTES SECTION)*
- **CONSTRUCTION WORKING ZONE** *(MANAGED CONSTRUCTION PROCESSES PERMITTED IN ACCORDANCE WITH THE PRINCIPLES SET OUT WITHIN THE ARBORICULTURAL IMPACT ASSESSMENT)*
- **TREE PRESERVATION ORDER** *(AREA COVERED BY A TREE PRESERVATION ORDER [TPO])*
- **CONSERVATION AREA** *(AREA COVERED BY A TREE PRESERVATION ORDER [TPO])*
- **PROPOSED CABLE ROUTE**

ISSUE/REVISION

P01	13/01/23	SECOND ISSUE
00	22/11/22	FIRST ISSUE
I/R	DATE	DESCRIPTION

DRAWING STATUS

SUBMITTED AT DEADLINE 5

PROJECT NUMBER

60589004

SHEET TITLE

TREE PROTECTION & REMOVAL PLAN (SHEET 4)

SHEET NUMBER **REV.**

60589004-ACM-XX-XX-AB-TPP-04 P01

Last saved by: BREWERJ(2023-01-13) Last Plotted: 2023-01-13
Filename: C:\USERS\BREWERJ\ONEDRIVE - AECOM\DESKTOP\SUNNICA FARM\SS\SUNNICA ENERGY FARN - TPP_001 - OFFLINE COPY\SUNNICA ENERGY FARN - TPP_006(SIMPLIFIED).DWG

Author: GR Designer: JB Checked: TF Approved: AW

Last saved by: BREWERJ(2023-01-13) Last Plotted: 2023-01-13
Filename: C:\USERS\BREWERJ\ONEDRIVE - AECOM\DESKTOP\SUNNICA FARM\SS\SUNNICA ENERGY FARN - TPP_001 - OFFLINE COPY\SUNNICA ENERGY FARN - TPP_006(SIMPLIFIED).DWG

AECOM

PROJECT

SUNNICA ENERGY FARM

CLIENT

SUNNICA ENERGY FARM

CONSULTANT

AECOM
Plumer House, Third Floor,
East Wing, Tailyour Road
Plymouth, PL6 5DH
Tel +44(0)1752 676700
Fax +44(0)870 238 6023
www.aecom.com

GENERAL NOTES

1. TREE CATEGORIES AS DEFINED BY BS 5837:2012
2. TREE LOCATIONS ARE BASED ON THE TOPOGRAPHICAL SURVEY, AERIAL IMAGERY, AND GPS CO-ORDINATES FROM ON SITE WALKOVER.
3. * INDICATES A TREE / GROUP WHOSE POSITION IS APPROXIMATE AS BASED UPON AERIAL PHOTOGRAPHY AND ON SITE OBSERVATIONS.
4. PLANS SHOULD BE READ IN CONJUNCTION WITH THE AECOM ARBORICULTURAL REPORT.
5. THE ORIGINAL OF THIS DRAWING WAS PRODUCED IN COLOUR - A MONOCHROME COPY SHOULD NOT BE RELIED UPON.
6. DRAWING REFERNCES:
   - xref_topo.dwg
   - TPO.dwg
   - xref_cstastro.dwg
   - MERGED NTM CATA Rev8 Modified (TPP EDITS).dwg
   - Additional data.dwg
   - Shading Arc (Layered).dwg
   - Shading Arc (xxxm).dwg
   - 20230105_Sunnica_WSP_RLB.dwg
   - 210309_blank_ _v4 (MetalBed - West Site B Removed).dwg

KEY PLAN

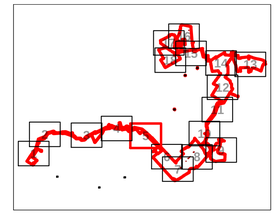

KEY

- **ORDER LIMITS BOUNDARY**
- **EXISTING TREE, GROUP, WOODLAND, OR HEDGE TO BE RETAINED** *(TREE TAGS INDICATE TREES SUBJECT TO DETAILED SURVEY, NO TREE TAG INDICATES TREES BASED ON NTM/DESK STUDY)*
- **EXISTING TREE, GROUP, WOODLAND, OR HEDGE TO BE REMOVED** *(TREE TAGS INDICATE TREES SUBJECT TO DETAILED SURVEY, NO TREE TAG INDICATES TREES BASED ON NTM/DESK STUDY)*
- **ROOT PROTECTION AREAS (RPA)** *(AS DEFINED BY BS 5837:2012 FOR TREES SUBJECT TO DETAILED SURVEY. ESTIMATED BUFFER ZONE SHOWN INDICATIVELY FOR OTHER TREES)*
- **APPROXIMATE SHADING ARC** *(W/ PREDICTED MAXIMUM GROWTH HEIGHT OUTLINE)*
- **VETERAN/ANCIENT TREE** *(IDENTIFIED BY DETAILED SURVEY)*
- **VETERAN/ANCIENT TREE** *(IDENTIFIED BY WALKOVER/DESK STUDY)*
- **PROPOSED DEVELOPMENT LAYOUT** *(BASED UPON DRAWING REFERENCES LISTED IN THE GENERAL NOTES SECTION)*
- **CONSTRUCTION WORKING ZONE** *(MANAGED CONSTRUCTION PROCESSES PERMITTED IN ACCORDANCE WITH THE PRINCIPLES SET OUT WITHIN THE ARBORICULTURAL IMPACT ASSESSMENT)*
- **TREE PRESERVATION ORDER** *(AREA COVERED BY A TREE PRESERVATION ORDER [TPO])*
- **CONSERVATION AREA** *(AREA COVERED BY A TREE PRESERVATION ORDER [TPO])*
- **PROPOSED CABLE ROUTE**

ISSUE/REVISION

P01	13/01/23	SECOND ISSUE
00	22/11/22	FIRST ISSUE
I/R	DATE	DESCRIPTION

DRAWING STATUS

SUBMITTED AT DEADLINE 5

PROJECT NUMBER

60589004

SHEET TITLE

TREE PROTECTION & REMOVAL PLAN (SHEET 5)

SHEET NUMBER **REV.**

60589004-ACM-XX-XX-AB-TPP-05 P01

This drawing has been prepared for the use of AECOM's client. It may not be used, modified, reproduced or relied upon by third parties, except as agreed by AECOM or as required by law. AECOM accepts no responsibility, and denies any liability whatsoever, to any party that uses or relies on this drawing without AECOM's express written consent. Do not scale this document. All measurements must be obtained from the stated dimensions.

Author: GR Designer: JB Checked: TF Approved: AW

Last saved by: BREWERJ(2023-01-13) Last Plotted: 2023-01-13
Filename: C:\USERS\BREWERJ\ONEDRIVE - AECOM\DESKTOP\SUNNICA FARM\SS\SUNNICA ENERGY FARN - TPP_001 - OFFLINE COPY\SUNNICA ENERGY FARN - TPP_006(SIMPLIFIED).DWG

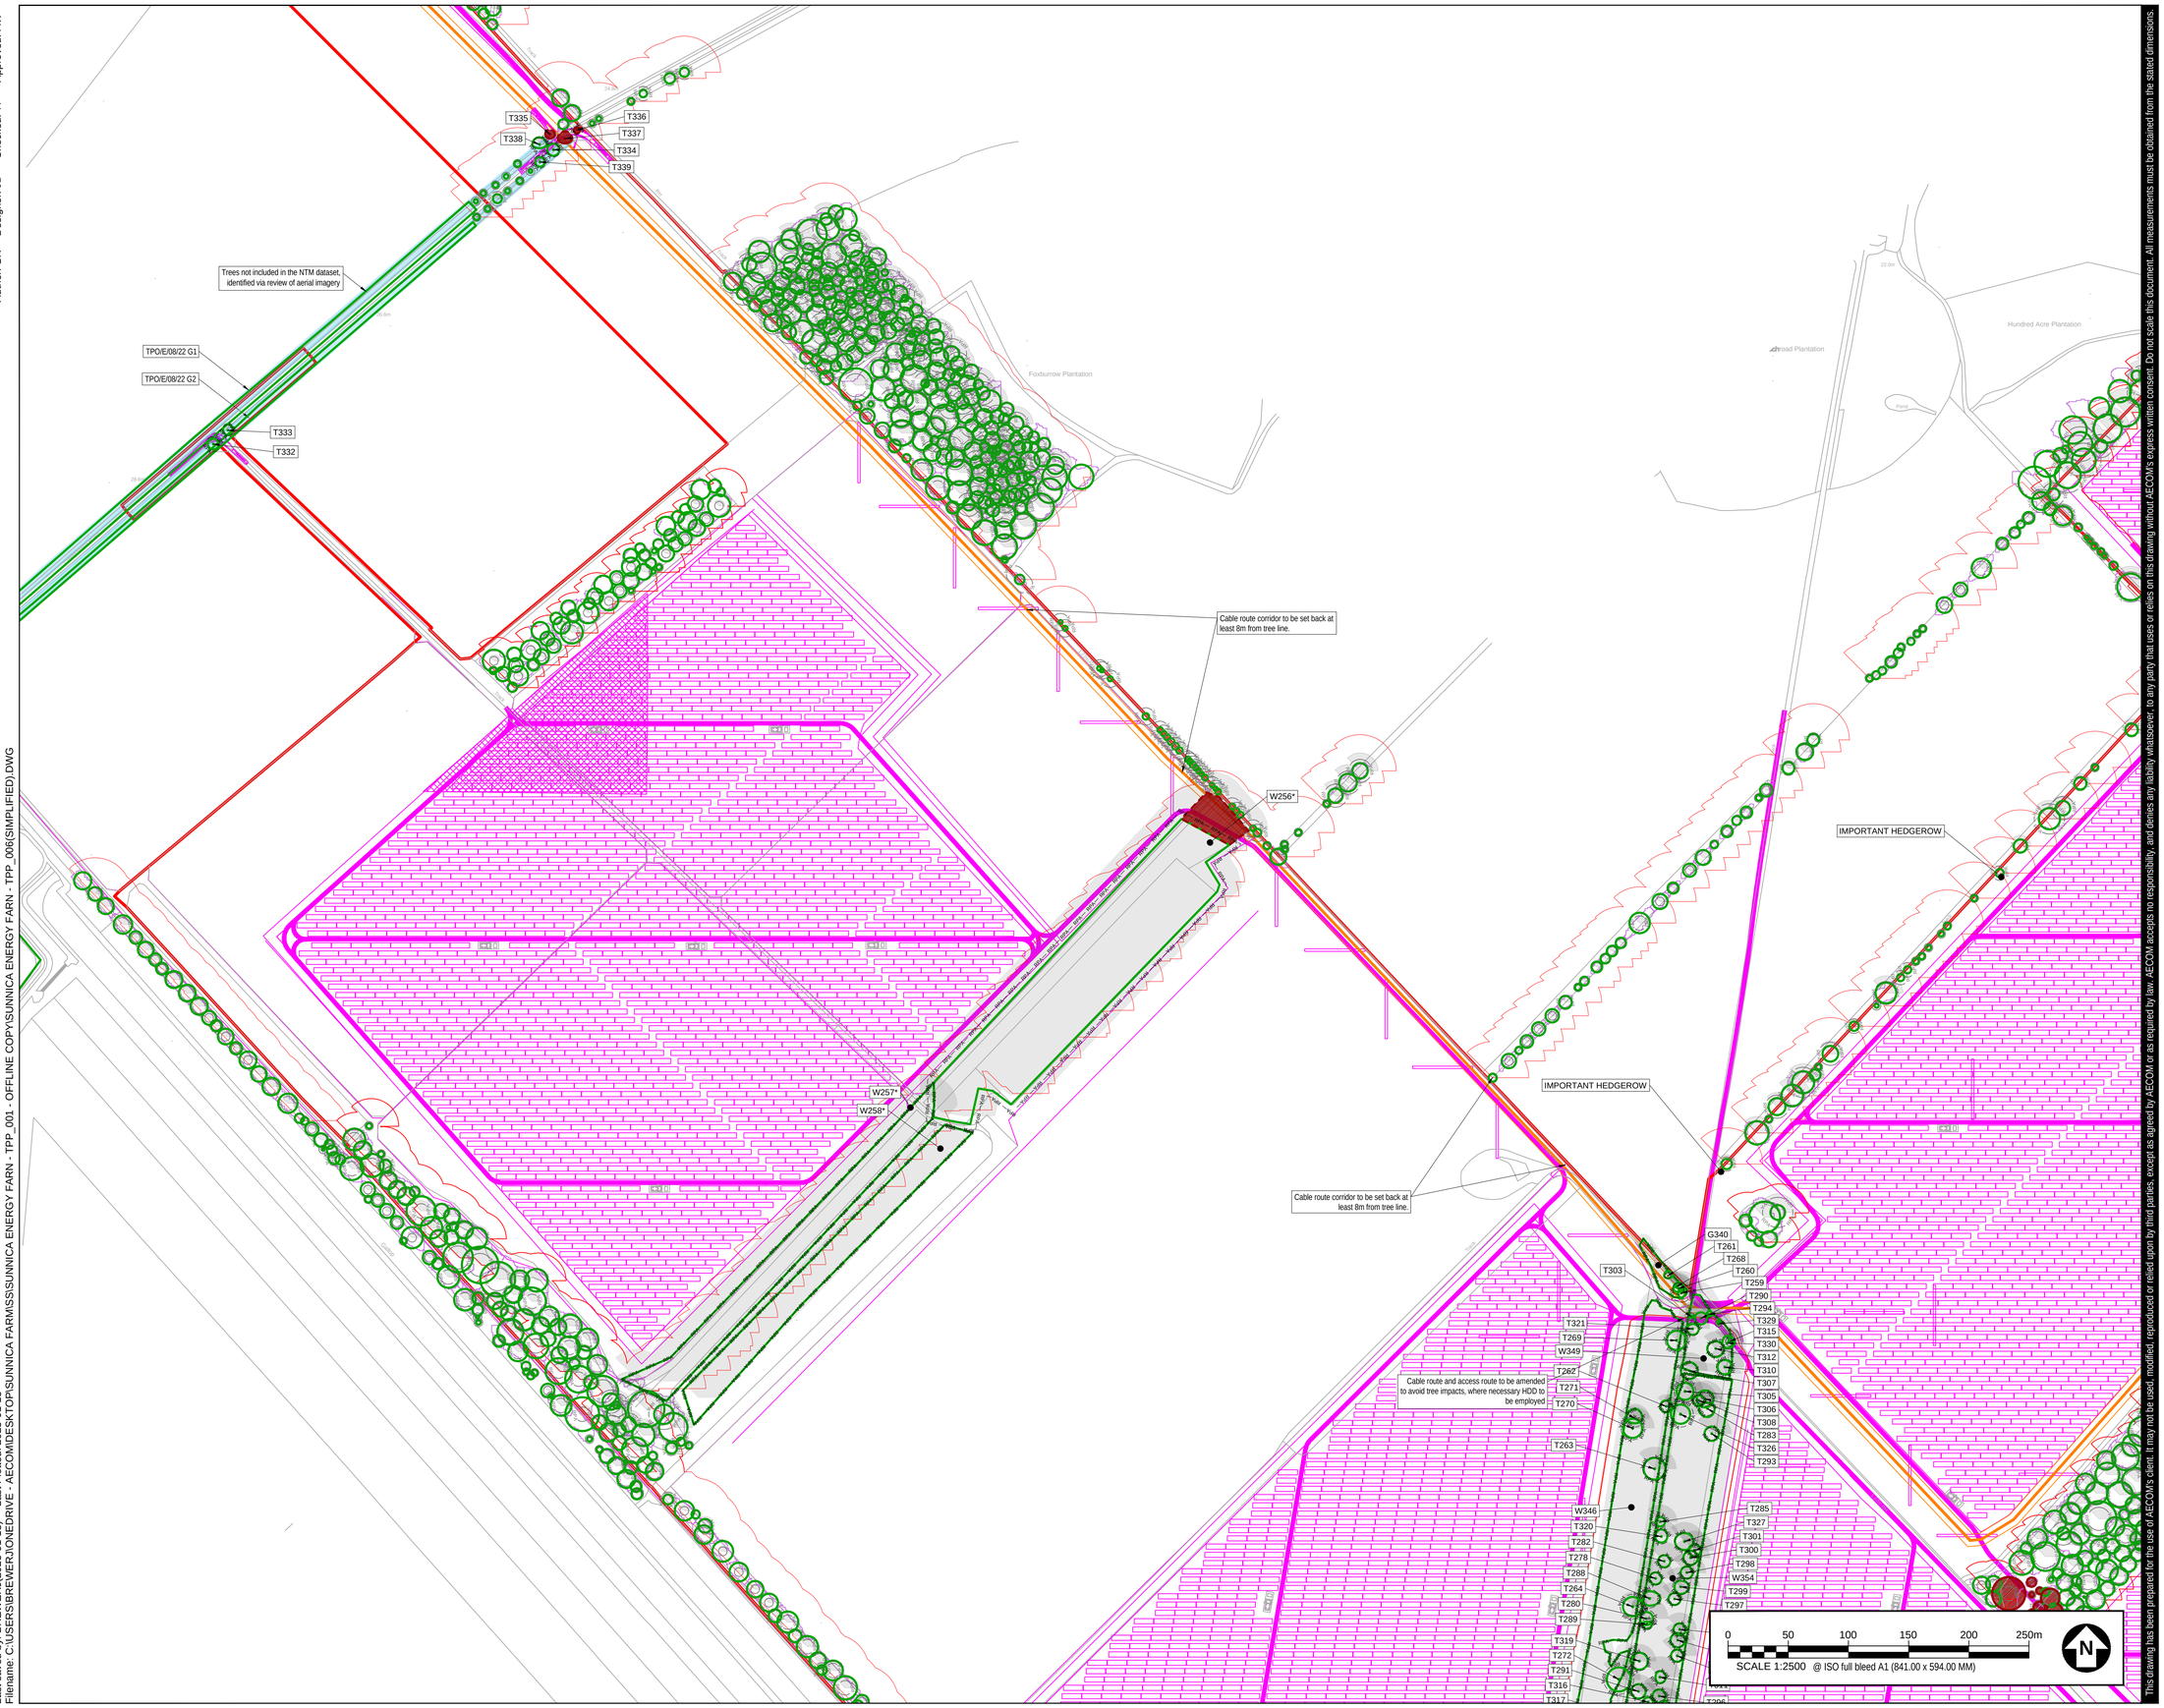

This drawing has been prepared for the use of AECOM's client. It may not be used, modified, reproduced or relied upon by third parties, except as agreed by AECOM or as required by law. AECOM accepts no responsibility, and denies any liability whatsoever, to any party that uses or relies on this drawing without AECOM's express written consent. Do not scale this document. All measurements must be obtained from the stated dimensions.

AECOM

PROJECT

SUNNICA ENERGY FARM

CLIENT

SUNNICA ENERGY FARM

CONSULTANT

AECOM
Plumer House, Third Floor,
East Wing, Tailyour Road
Plymouth, PL6 5DH
Tel +44(0)1752 676700
Fax +44(0)870 238 6023
www.aecom.com

GENERAL NOTES

1. TREE CATEGORIES AS DEFINED BY BS 5837:2012
2. TREE LOCATIONS ARE BASED ON THE TOPOGRAPHICAL SURVEY, AERIAL IMAGERY, AND GPS CO-ORDINATES FROM ON SITE WALKOVER.
3. * INDICATES A TREE / GROUP WHOSE POSITION IS APPROXIMATE AS BASED UPON AERIAL PHOTOGRAPHY AND ON SITE OBSERVATIONS.
4. PLANS SHOULD BE READ IN CONJUNCTION WITH THE AECOM ARBORICULTURAL REPORT.
5. THE ORIGINAL OF THIS DRAWING WAS PRODUCED IN COLOUR - A MONOCHROME COPY SHOULD NOT BE RELIED UPON.
6. DRAWING REFERNCES:
   - xref_topo.dwg
   - TPO.dwg
   - xref_catastro.dwg
   - MERGED NTM DATA Rev8 Modified (TPP EDITS).dwg
   - Additional data.dwg
   - Shading Arc (corrected).dwg
   - Shading Arc (corrected).dwg
   - 20230105_Sunnica_WSP_RLB.dwg
   - 210309_Issue1_v4 (Modified - West Site B Removed).dwg

KEY PLAN

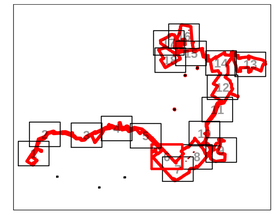

KEY

- **ORDER LIMITS BOUNDARY**
- **EXISTING TREE, GROUP, WOODLAND, OR HEDGE TO BE RETAINED** *(TREE TAGS INDICATE TREES SUBJECT TO DETAILED SURVEY. NO TREE TAG INDICATES TREES BASED ON NTM/DESK STUDY)*
- **EXISTING TREE, GROUP, WOODLAND, OR HEDGE TO BE REMOVED** *(TREE TAGS INDICATE TREES SUBJECT TO DETAILED SURVEY, NO TREE TAG INDICATES TREES BASED ON NTM/DESK STUDY)*
- **ROOT PROTECTION AREAS (RPA)** *(AS DEFINED BY BS 5837:2012 FOR TREES SUBJECT TO DETAILED SURVEY. ESTIMATED BUFFER ZONE SHOWN INDICATIVELY FOR OTHER TREES)*
- **APPROXIMATE SHADING ARC** *(W PREDICTED MAXIMUM GROWTH HEIGHT OUTLINE)*
- **VETERAN/ANCIENT TREE** *(IDENTIFIED BY DETAILED SURVEY)*
- **VETERAN/ANCIENT TREE** *(IDENTIFIED BY WALKOVER/DESK STUDY)*
- **PROPOSED DEVELOPMENT LAYOUT** *(BASED UPON DRAWING REFERENCES LISTED IN THE GENERAL NOTES SECTION)*
- **CONSTRUCTION WORKING ZONE** *(MANAGED CONSTRUCTION PROCESSES PERMITTED IN ACCORDANCE WITH THE PRINCIPLES SET OUT WITHIN THE ARBORICULTURAL IMPACT ASSESSMENT)*
- **TREE PRESERVATION ORDER** *(AREA COVERED BY A TREE PRESERVATION ORDER (TPO))*
- **CONSERVATION AREA** *(AREA COVERED BY A TREE PRESERVATION ORDER (TPO))*
- **PROPOSED CABLE ROUTE**

ISSUE/REVISION

P01	13/01/23	SECOND ISSUE
00	22/11/22	FIRST ISSUE
I/R	DATE	DESCRIPTION

DRAWING STATUS

SUBMITTED AT DEADLINE 5

PROJECT NUMBER

60589004

SHEET TITLE

TREE PROTECTION & REMOVAL PLAN (SHEET 6)

SHEET NUMBER **REV.**

60589004-ACM-XX-XX-AB-TPP-06 P01

Author: GR Designer: JB Checked: TF Approved: AW

Last saved by: BREWERJ(2023-01-13) Last Plotted: 2023-01-13
Filename: C:\USERS\BREWERJ\ONEDRIVE - AECOM\DESKTOP\SUNNICA FARM\SS\SUNNICA ENERGY FARN - TPP_001 - OFFLINE COPY\SUNNICA ENERGY FARN - TPP_006(SIMPLIFIED).DWG

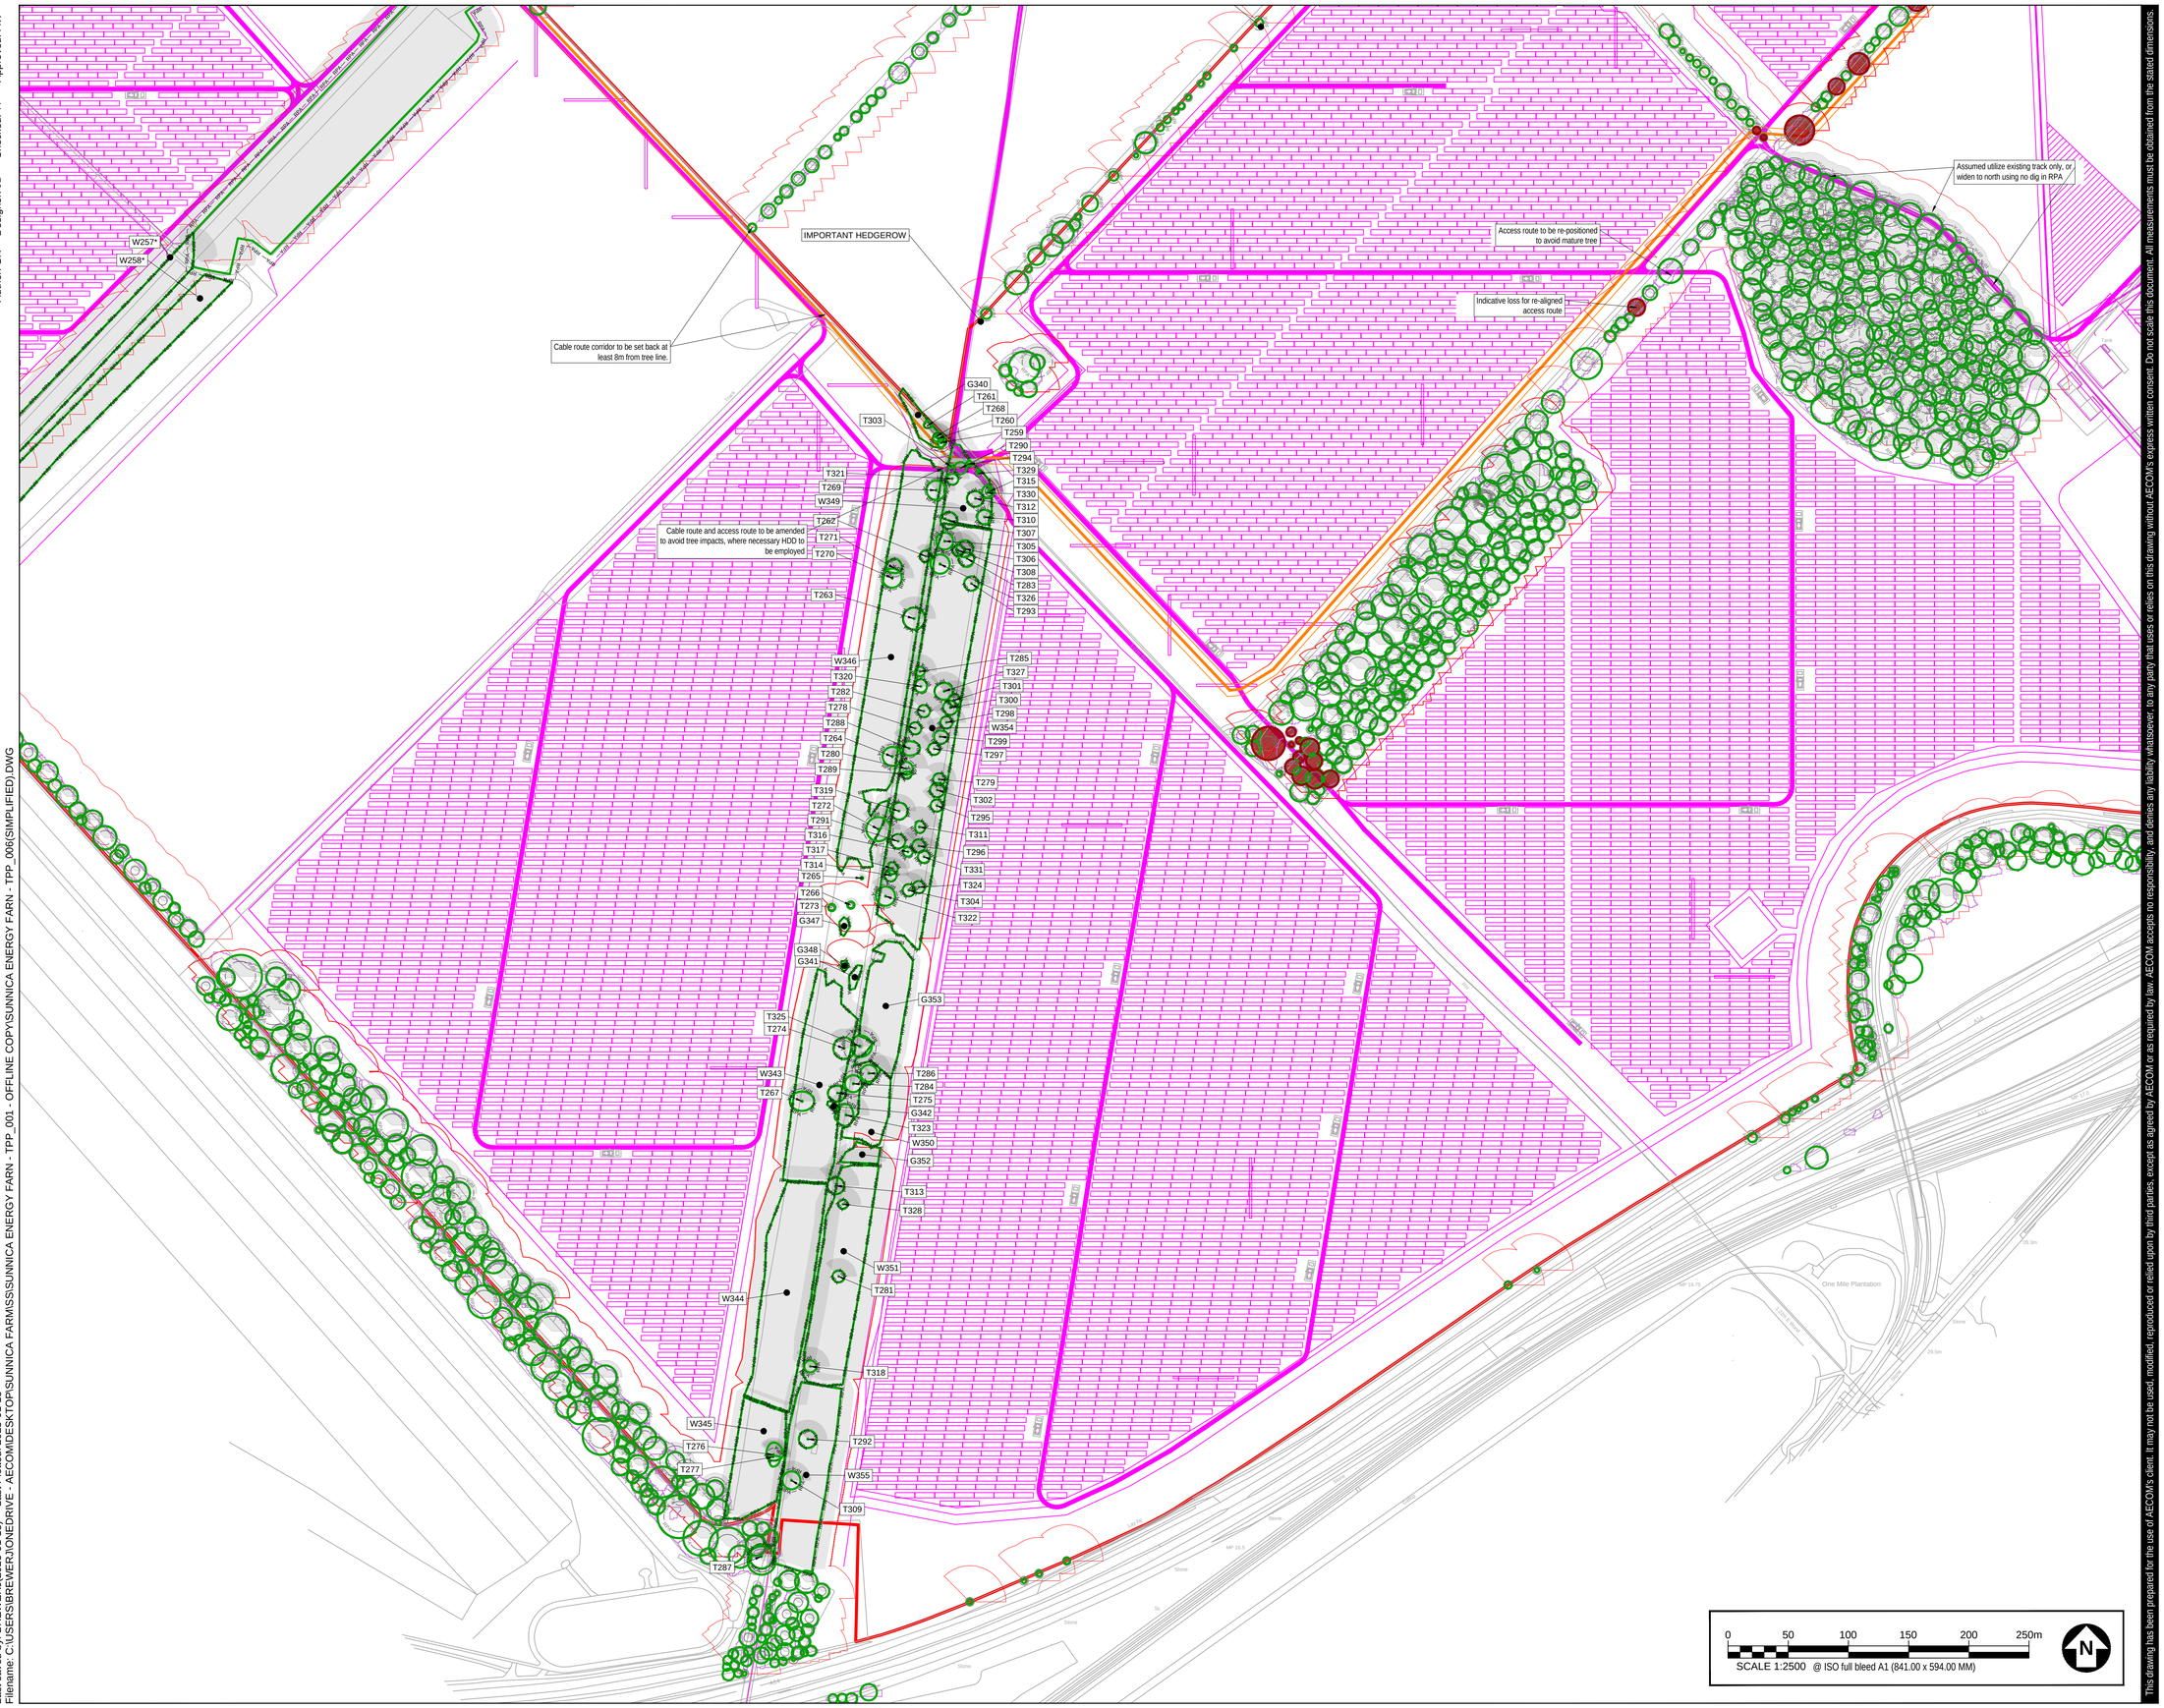

This drawing has been prepared for the use of AECOM's client. It may not be used, modified, reproduced or relied upon by third parties, except as agreed by AECOM or as required by law. AECOM accepts no responsibility and denies any liability whatsoever to any party that uses or relies on this drawing without AECOM's express written consent. Do not scale this document. All measurements must be obtained from the stated dimensions.

AECOM

PROJECT

SUNNICA ENERGY FARM

CLIENT

SUNNICA ENERGY FARM

CONSULTANT

AECOM
Plumer House, Third Floor,
East Wing, Tailyour Road
Plymouth, PL6 5DH
Tel +44(0)1752 676700
Fax +44(0)870 238 6023
www.aecom.com

GENERAL NOTES

1. TREE CATEGORIES AS DEFINED BY BS 5837:2012
2. TREE LOCATIONS ARE BASED ON THE TOPOGRAPHICAL SURVEY, AERIAL IMAGERY, AND GPS CO-ORDINATES FROM ON SITE WALKOVER.
3. * INDICATES A TREE / GROUP WHOSE POSITION IS APPROXIMATE AS BASED UPON AERIAL PHOTOGRAPHY AND ON SITE OBSERVATIONS.
4. PLANS SHOULD BE READ IN CONJUNCTION WITH THE AECOM ARBORICULTURAL REPORT.
5. THE ORIGINAL OF THIS DRAWING WAS PRODUCED IN COLOUR - A MONOCHROME COPY SHOULD NOT BE RELIED UPON.
6. DRAWING REFERNCES:
   - xref_topo.dwg
   - TPO.dwg
   - xref_catastro.dwg
   - MERGED NTM CATA Rev8 Modified (TPP EDITS).dwg
   - Additional data.dwg
   - Shading Arc (Amended).dwg
   - 20230105_Sunnica_WSP_RLB.dwg
   - 210309_block_-_v4 (Modified - West Site B Removed).dwg

KEY PLAN

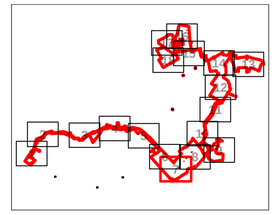

KEY

- **ORDER LIMITS BOUNDARY**
- **EXISTING TREE, GROUP, WOODLAND, OR HEDGE TO BE RETAINED** *(TREE TAGS INDICATE TREES SUBJECT TO DETAILED SURVEY, NO TREE TAG INDICATES TREES BASED ON NTM/DESK STUDY)*
- **EXISTING TREE, GROUP, WOODLAND, OR HEDGE TO BE REMOVED** *(TREE TAGS INDICATE TREES SUBJECT TO DETAILED SURVEY, NO TREE TAG INDICATES TREES BASED ON NTM/DESK STUDY)*
- **ROOT PROTECTION AREAS (RPA)** *(AS DEFINED BY BS 5837:2012 FOR TREES SUBJECT TO DETAILED SURVEY, ESTIMATED BUFFER ZONE SHOWN INDICATIVELY FOR OTHER TREES)*
- **APPROXIMATE SHADING ARC** *(W/ PREDICTED MAXIMUM GROWTH HEIGHT OUTLINE)*
- **VETERAN/ANCIENT TREE** *(IDENTIFIED BY DETAILED SURVEY)*
- **VETERAN/ANCIENT TREE** *(IDENTIFIED BY WALKOVER/DESK STUDY)*
- **PROPOSED DEVELOPMENT LAYOUT** *(BASED UPON DRAWING REFERENCES LISTED IN THE GENERAL NOTES SECTION)*
- **CONSTRUCTION WORKING ZONE** *(MANAGED CONSTRUCTION PROCESSES PERMITTED IN ACCORDANCE WITH THE PRINCIPLES SET OUT WITHIN THE ARBORICULTURAL IMPACT ASSESSMENT)*
- **TREE PRESERVATION ORDER** *(AREA COVERED BY A TREE PRESERVATION ORDER (TPO))*
- **CONSERVATION AREA** *(AREA COVERED BY A TREE PRESERVATION ORDER (TPO))*
- **PROPOSED CABLE ROUTE**

ISSUE/REVISION

P01	13/01/23	SECOND ISSUE
00	22/11/22	FIRST ISSUE
I/R	DATE	DESCRIPTION

DRAWING STATUS

SUBMITTED AT DEADLINE 5

PROJECT NUMBER

60589004

SHEET TITLE

TREE PROTECTION & REMOVAL PLAN (SHEET 7)

SHEET NUMBER / REV.

60589004-ACM-XX-XX-AB-TPP-07 P01

Author: GR Designer: JB Checked: TF Approved: AW

Utilise no-dig construction and existing access to minimise impacts

Cable installation via HDD

Assumed utilize existing track only, or widen to north using no dig in RPA

Access route to be re-positioned to avoid mature tree

Indicative loss for re-aligned access route

0 50 100 150 200 250m

SCALE 1:2500 @ ISO full bleed A1 (841.00 x 594.00 MM)

N

Last saved by: BREWERJ (2023-01-13) Last Plotted: 2023-01-13
Filename: C:\USERS\BREWERJ\ONEDRIVE - AECOM\DESKTOP\SUNNICA FARM\SS\SUNNICA ENERGY FARN - TPP_001 - OFFLINE_COPY\SUNNICA ENERGY FARN - TPP_006(SIMPLIFIED).DWG

This drawing has been prepared for the use of AECOM's client. It may not be used, modified, reproduced or relied upon by third parties, except as agreed by AECOM or as required by law. AECOM accepts no responsibility, and denies any liability whatsoever, to any party that uses or relies on this drawing without AECOM's express written consent. Do not scale this document. All measurements must be obtained from the stated dimensions.

AECOM

PROJECT

SUNNICA ENERGY FARM

CLIENT

SUNNICA ENERGY FARM

CONSULTANT

AECOM
Plumer House, Third Floor,
East Wing, Tailyour Road
Plymouth, PL6 5DH
Tel +44(0)1752 676700
Fax +44(0)870 238 6023
www.aecom.com

GENERAL NOTES

1. TREE CATEGORIES AS DEFINED BY BS 5837:2012
2. TREE LOCATIONS ARE BASED ON THE TOPOGRAPHICAL SURVEY, AERIAL IMAGERY, AND GPS CO-ORDINATES FROM ON SITE WALKOVER.
3. * INDICATES A TREE / GROUP WHOSE POSITION IS APPROXIMATE AS BASED UPON AERIAL PHOTOGRAPHY AND ON SITE OBSERVATIONS.
4. PLANS SHOULD BE READ IN CONJUNCTION WITH THE AECOM ARBORICULTURAL REPORT.
5. THE ORIGINAL OF THIS DRAWING WAS PRODUCED IN COLOUR - A MONOCHROME COPY SHOULD NOT BE RELIED UPON.
6. DRAWING REFERNCES:
   - xref_topo.dwg
   - TPO.dwg
   - xref_catastro.dwg
   - MERGED NTM DATA Rev8 Modified (TPP EDITS).dwg
   - Additional data.dwg
   - Shading Arc (Merged).dwg
   - Shading Arc (point case).dwg
   - 20230105_Sunnica_WSP_RLB.dwg
   - 210309_Issue_1_v4 (Modified - West Site B Removed).dwg

KEY PLAN

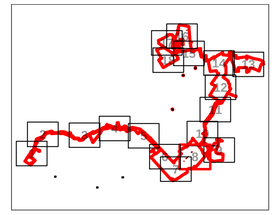

KEY

- **ORDER LIMITS BOUNDARY**
- **EXISTING TREE, GROUP, WOODLAND, OR HEDGE TO BE RETAINED** *(TREE TAGS INDICATE TREES SUBJECT TO DETAILED SURVEY, NO TREE TAG INDICATES TREES BASED ON NTM/DESK STUDY)*
- **EXISTING TREE, GROUP, WOODLAND, OR HEDGE TO BE REMOVED** *(TREE TAGS INDICATE TREES SUBJECT TO DETAILED SURVEY, NO TREE TAG INDICATES TREES BASED ON NTM/DESK STUDY)*
- **ROOT PROTECTION AREAS (RPA)** *(AS DEFINED BY BS 5837:2012 FOR TREES SUBJECT TO DETAILED SURVEY. ESTIMATED BUFFER ZONE SHOWN INDICATIVELY FOR OTHER TREES)*
- **APPROXIMATE SHADING ARC** *(W/ PREDICTED MAXIMUM GROWTH HEIGHT OUTLINE)*
- **VETERAN/ANCIENT TREE** *(IDENTIFIED BY DETAILED SURVEY)*
- **VETERAN/ANCIENT TREE** *(IDENTIFIED BY WALKOVER/DESK STUDY)*
- **PROPOSED DEVELOPMENT LAYOUT** *(BASED UPON DRAWING REFERENCES LISTED IN THE GENERAL NOTES SECTION)*
- **CONSTRUCTION WORKING ZONE** *(MANAGED CONSTRUCTION PROCESSES PERMITTED IN ACCORDANCE WITH THE PRINCIPLES SET OUT WITHIN THE ARBORICULTURAL IMPACT ASSESSMENT)*
- **TREE PRESERVATION ORDER** *(AREA COVERED BY A TREE PRESERVATION ORDER [TPO])*
- **CONSERVATION AREA** *(AREA COVERED BY A TREE PRESERVATION ORDER [TPO])*
- **PROPOSED CABLE ROUTE**

ISSUE/REVISION

I/R	DATE	DESCRIPTION
P01	13/01/23	SECOND ISSUE
00	22/11/22	FIRST ISSUE

DRAWING STATUS

SUBMITTED AT DEADLINE 5

PROJECT NUMBER

60589004

SHEET TITLE

TREE PROTECTION & REMOVAL PLAN (SHEET 8)

SHEET NUMBER **REV.**

60589004-ACM-XX-XX-AB-TPP-08 P01

Potential Veteran tree's identified by site walkover [2019]. Shown with 30M Buffer zone

Cable installation via HDD

Cable installation via HDD

0 50 100 150 200 250m

SCALE 1:2500 @ ISO full bleed A1 (841.00 x 594.00 MM)

Author: GR Designer: JB Checked: TF Approved: AW

Last saved by: BREWERJ(2023-01-13) Last Plotted: 2023-01-13
Filename: C:\USERS\BREWERJ\ONEDRIVE - AECOM\DESKTOP\SUNNICA FARM\SS\SUNNICA ENERGY FARN - TPP_001 - OFFLINE COPY\SUNNICA ENERGY FARN - TPP_006(SIMPLIFIED).DWG

This drawing has been prepared for the use of AECOM's client. It may not be used, modified, reproduced or relied upon by third parties, except as agreed by AECOM or as required by law. AECOM accepts no responsibility, and denies any liability whatsoever, to any party that uses or relies on this drawing without AECOM's express written consent. Do not scale this document. All measurements must be obtained from the stated dimensions.

AECOM

PROJECT

SUNNICA ENERGY FARM

CLIENT

SUNNICA ENERGY FARM

CONSULTANT

AECOM
Plumer House, Third Floor,
East Wing, Tailyour Road
Plymouth, PL6 5DH
Tel +44(0)1752 676700
Fax +44(0)870 238 6023
www.aecom.com

GENERAL NOTES

1. TREE CATEGORIES AS DEFINED BY BS 5837:2012
2. TREE LOCATIONS ARE BASED ON THE TOPOGRAPHICAL SURVEY, AERIAL IMAGERY, AND GPS CO-ORDINATES FROM ON SITE WALKOVER.
3. * INDICATES A TREE / GROUP WHOSE POSITION IS APPROXIMATE AS BASED UPON AERIAL PHOTOGRAPHY AND ON SITE OBSERVATIONS.
4. PLANS SHOULD BE READ IN CONJUNCTION WITH THE AECOM ARBORICULTURAL REPORT.
5. THE ORIGINAL OF THIS DRAWING WAS PRODUCED IN COLOUR - A MONOCHROME COPY SHOULD NOT BE RELIED UPON.
6. DRAWING REFERNCES:
   - xref_topo.dwg
   - TPO.dwg
   - xref_cstastro.dwg
   - MERGED NTM DATA Rev8 Modified (TPP EDITS).dwg
   - Additional data.dwg
   - Shading Arc (used case).dwg
   - 20230105_Sunnica_WSP_RLB.dwg
   - 210309_blank_ _v4 (Modified - West Site B Removed).dwg

KEY PLAN

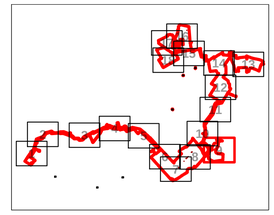

KEY

- **ORDER LIMITS BOUNDARY**
- **EXISTING TREE, GROUP, WOODLAND, OR HEDGE TO BE RETAINED**
  (TREE TAGS INDICATE TREES SUBJECT TO DETAILED SURVEY, NO TREE TAG INDICATES TREES BASED ON NTM/DESK STUDY)
- **EXISTING TREE, GROUP, WOODLAND, OR HEDGE TO BE REMOVED**
  (TREE TAGS INDICATE TREES SUBJECT TO DETAILED SURVEY, NO TREE TAG INDICATES TREES BASED ON NTM/DESK STUDY)
- **ROOT PROTECTION AREAS (RPA)**
  (AS DEFINED BY BS 5837:2012 FOR TREES SUBJECT TO DETAILED SURVEY. ESTIMATED BUFFER ZONE SHOWN INDICATIVELY FOR OTHER TREES)
- **APPROXIMATE SHADING ARC**
  (W PREDICTED MAXIMUM GROWTH HEIGHT OUTLINE)
- **VETERAN/ANCIENT TREE**
  (IDENTIFIED BY DETAILED SURVEY)
- **VETERAN/ANCIENT TREE**
  (IDENTIFIED BY WALKOVER/DESK STUDY)
- **PROPOSED DEVELOPMENT LAYOUT**
  (BASED UPON DRAWING REFERENCES LISTED IN THE GENERAL NOTES SECTION)
- **CONSTRUCTION WORKING ZONE**
  (MANAGED CONSTRUCTION PROCESSES PERMITTED IN ACCORDANCE WITH THE PRINCIPLES SET OUT WITHIN THE ARBORICULTURAL IMPACT ASSESSMENT)
- **TREE PRESERVATION ORDER**
  (AREA COVERED BY A TREE PRESERVATION ORDER [TPO])
- **CONSERVATION AREA**
  (AREA COVERED BY A TREE PRESERVATION ORDER [TPO])
- **PROPOSED CABLE ROUTE**

ISSUE/REVISION

P01	13/01/23	SECOND ISSUE
00	22/11/22	FIRST ISSUE
I/R	DATE	DESCRIPTION

DRAWING STATUS

SUBMITTED AT DEADLINE 5

PROJECT NUMBER

60589004

SHEET TITLE

TREE PROTECTION & REMOVAL PLAN (SHEET 9)

SHEET NUMBER **REV.**

60589004-ACM-XX-XX-AB-TPP-09 P01

Author: GR Designer: JB Checked: TF Approved: AW

Last saved by: BREWERJ (2023-01-13) Last Plotted: 2023-01-13
Filename: C:\USERS\BREWERJ\ONEDRIVE - AECOM\DESKTOP\SUNNICA FARM\SS\SUNNICA ENERGY FARN - TPP_001 - OFFLINE COPY\SUNNICA ENERGY FARN - TPP_006(SIMPLIFIED).DWG

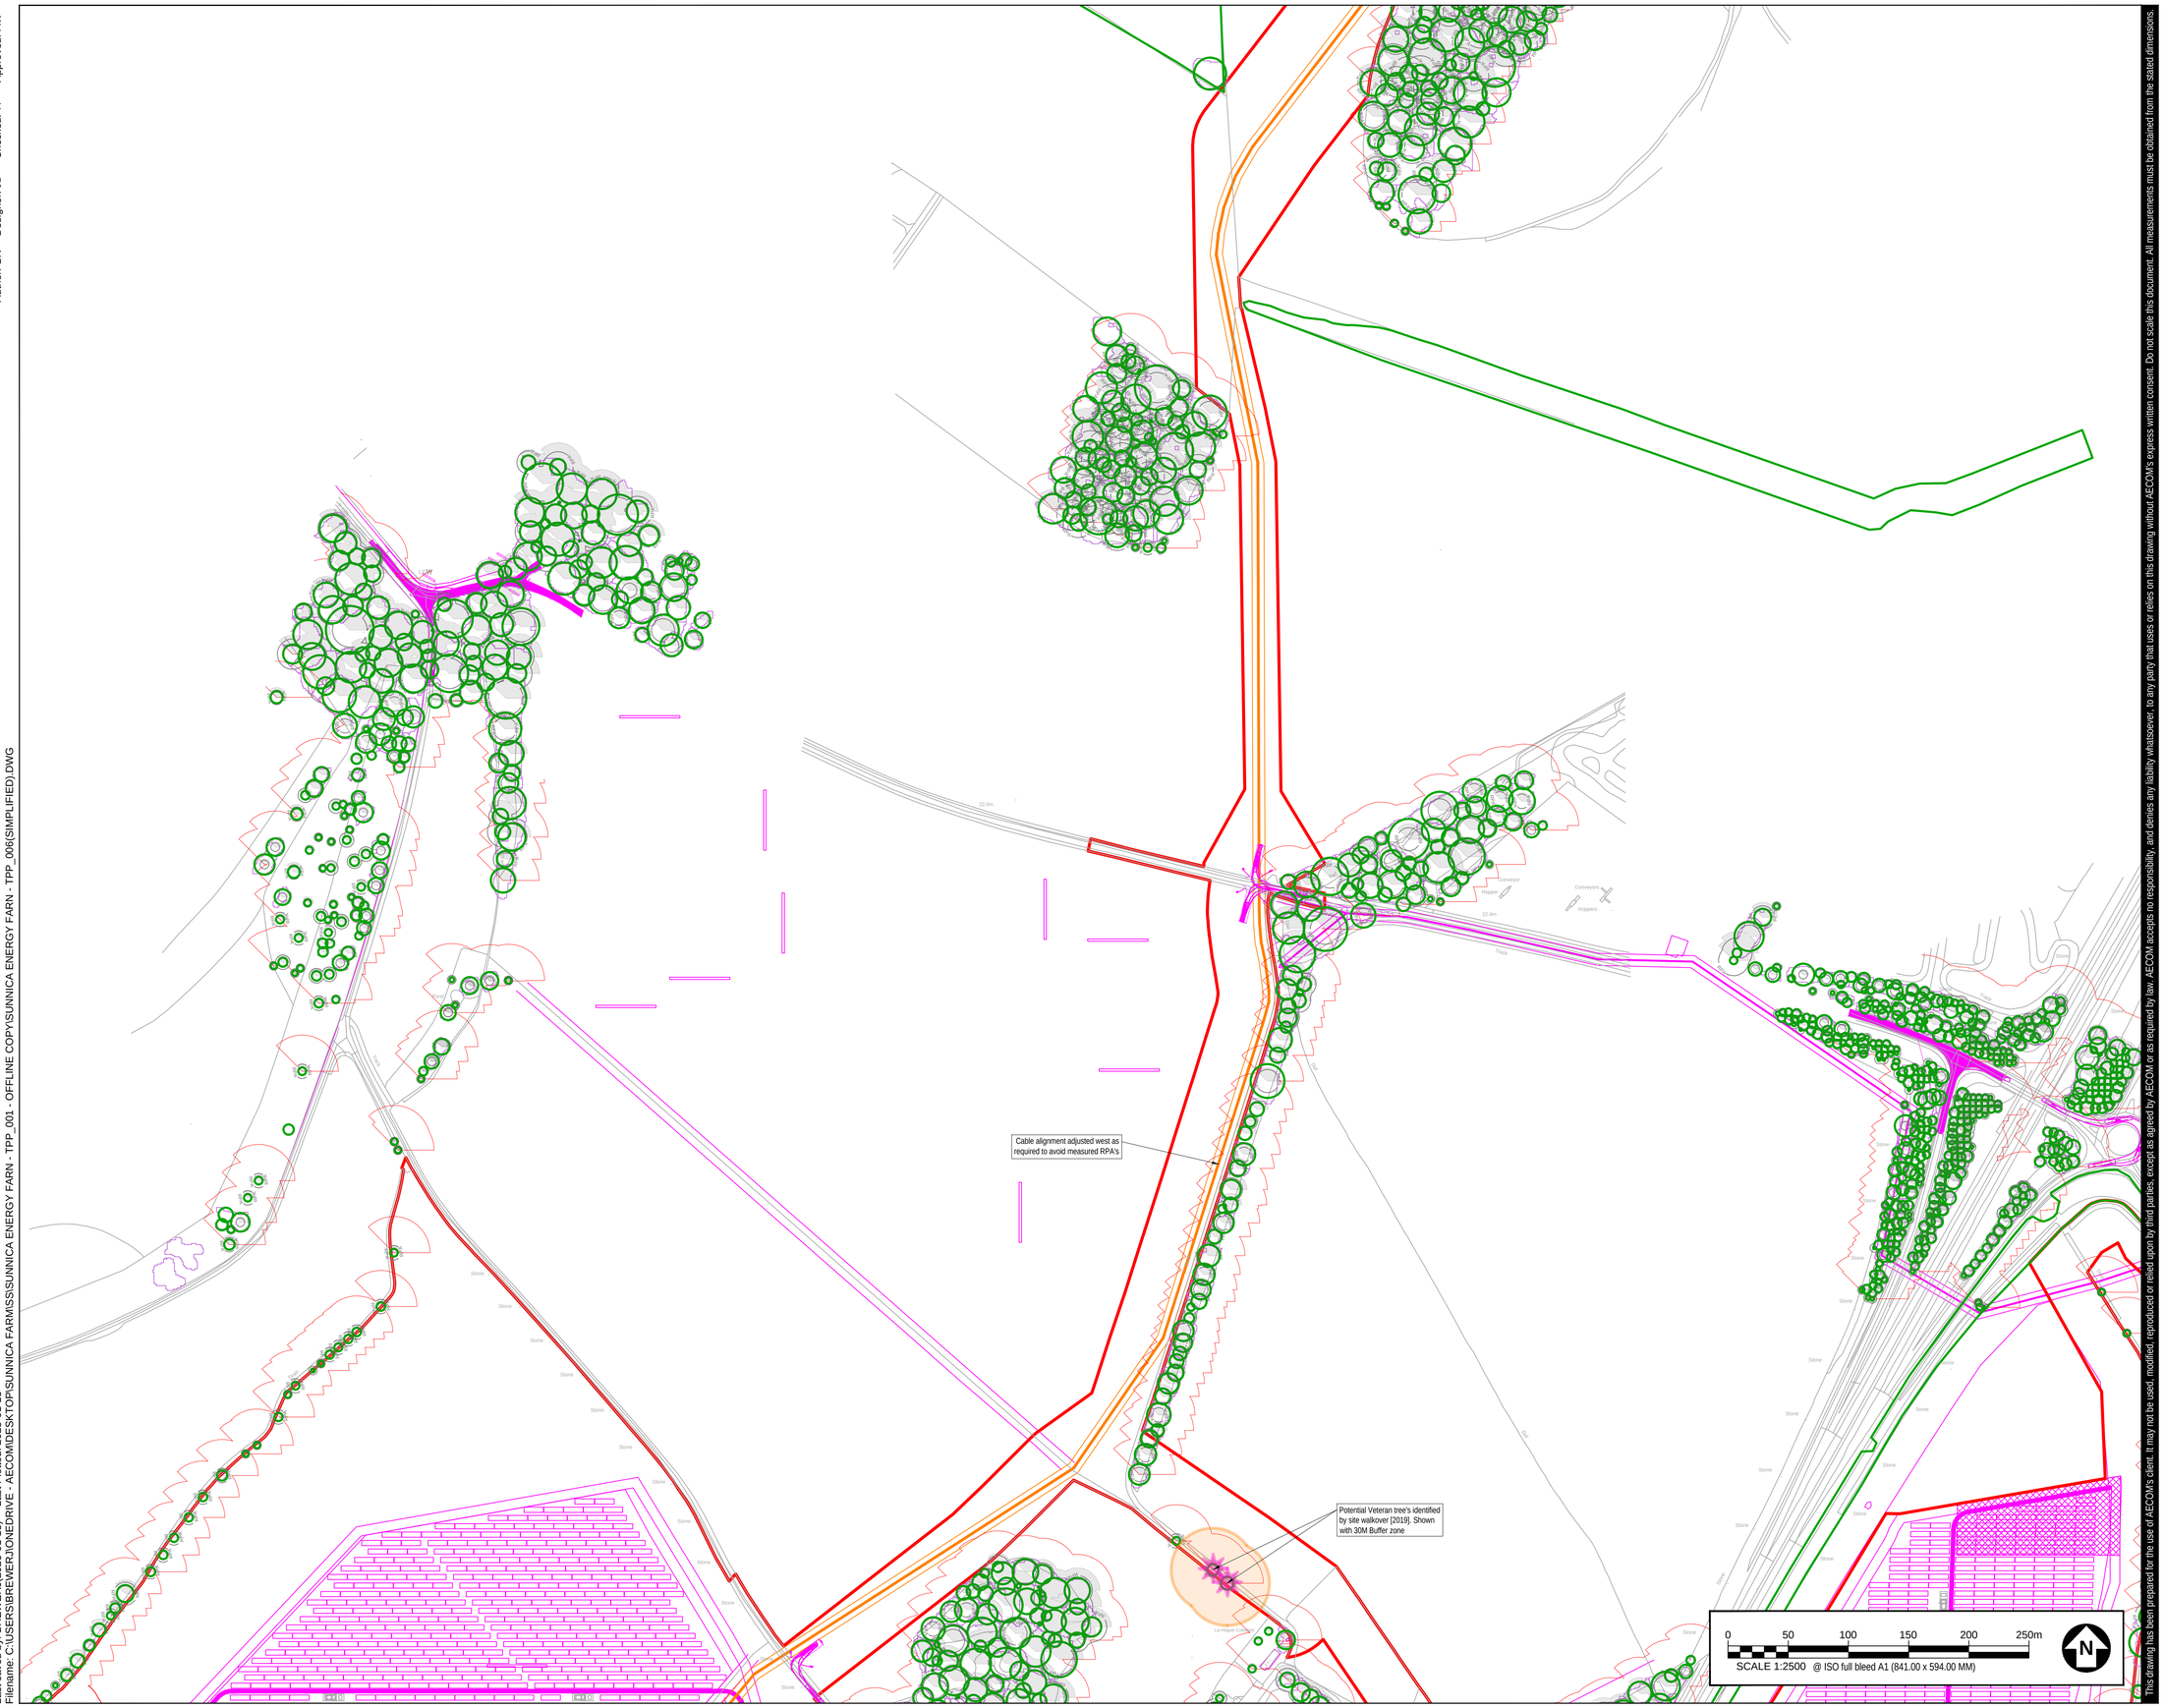

This drawing has been prepared for the use of AECOM's client. It may not be used, modified, reproduced or relied upon by third parties, except as agreed by AECOM or as required by law. AECOM accepts no responsibility, and denies any liability whatsoever, to any party that uses or relies on this drawing without AECOM's express written consent. Do not scale this document. All measurements must be obtained from the stated dimensions.

AECOM

PROJECT

SUNNICA ENERGY FARM

CLIENT

SUNNICA ENERGY FARM

CONSULTANT

AECOM
Plumer House, Third Floor,
East Wing, Tailyour Road
Plymouth, PL6 5DH
Tel +44(0)1752 676700
Fax +44(0)870 238 6023
www.aecom.com

GENERAL NOTES

1. TREE CATEGORIES AS DEFINED BY BS 5837:2012
2. TREE LOCATIONS ARE BASED ON THE TOPOGRAPHICAL SURVEY, AERIAL IMAGERY, AND GPS CO-ORDINATES FROM ON SITE WALKOVER.
3. * INDICATES A TREE / GROUP WHOSE POSITION IS APPROXIMATE AS BASED UPON AERIAL PHOTOGRAPHY AND ON SITE OBSERVATIONS.
4. PLANS SHOULD BE READ IN CONJUNCTION WITH THE AECOM ARBORICULTURAL REPORT.
5. THE ORIGINAL OF THIS DRAWING WAS PRODUCED IN COLOUR - A MONOCHROME COPY SHOULD NOT BE RELIED UPON.
6. DRAWING REFERNCES:
   - xref_topo.dwg
   - TPO.dwg
   - xref_cstastro.dwg
   - MERGED NTM CATA Rev8 Modified (TPP EDITS).dwg
   - Additional data.dwg
   - Shading Arc (corrected).dwg
   - Shading Arc (corrected).dwg
   - 20230105_Sunnica_WSP_RLB.dwg
   - 210309_blank_-_v4 (Modified) - West Site B Removed).dwg

KEY PLAN

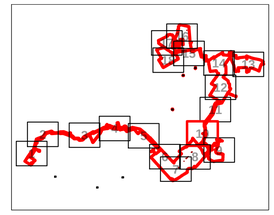

KEY

- **ORDER LIMITS BOUNDARY**
- **EXISTING TREE, GROUP, WOODLAND, OR HEDGE TO BE RETAINED** *(TREE TAGS INDICATE TREES SUBJECT TO DETAILED SURVEY, NO TREE TAG INDICATES TREES BASED ON NTM/DESK STUDY)*
- **EXISTING TREE, GROUP, WOODLAND, OR HEDGE TO BE REMOVED** *(TREE TAGS INDICATE TREES SUBJECT TO DETAILED SURVEY, NO TREE TAG INDICATES TREES BASED ON NTM/DESK STUDY)*
- **ROOT PROTECTION AREAS (RPA)** *(AS DEFINED BY BS 5837:2012 FOR TREES SUBJECT TO DETAILED SURVEY. ESTIMATED BUFFER ZONE SHOWN INDICATIVELY FOR OTHER TREES)*
- **APPROXIMATE SHADING ARC** *(W/ PREDICTED MAXIMUM GROWTH HEIGHT OUTLINE)*
- **VETERAN/ANCIENT TREE** *(IDENTIFIED BY DETAILED SURVEY)*
- **VETERAN/ANCIENT TREE** *(IDENTIFIED BY WALKOVER/DESK STUDY)*
- **PROPOSED DEVELOPMENT LAYOUT** *(BASED UPON DRAWING REFERENCES LISTED IN THE GENERAL NOTES SECTION)*
- **CONSTRUCTION WORKING ZONE** *(MANAGED CONSTRUCTION PROCESSES PERMITTED IN ACCORDANCE WITH THE PRINCIPLES SET OUT WITHIN THE ARBORICULTURAL IMPACT ASSESSMENT)*
- **TREE PRESERVATION ORDER** *(AREA COVERED BY A TREE PRESERVATION ORDER [TPO])*
- **CONSERVATION AREA** *(AREA COVERED BY A TREE PRESERVATION ORDER [TPO])*
- **PROPOSED CABLE ROUTE**

ISSUE/REVISION

P01	13/01/23	SECOND ISSUE
00	22/11/22	FIRST ISSUE
I/R	DATE	DESCRIPTION

DRAWING STATUS

SUBMITTED AT DEADLINE 5

PROJECT NUMBER

60589004

SHEET TITLE

TREE PROTECTION & REMOVAL PLAN (SHEET 10)

SHEET NUMBER **REV.**

60589004-ACM-XX-XX-AB-TPP-010 P01

Author: GR Designer: JB Checked: TF Approved: AW

Last saved by: BREWERJ(2023-01-13) Last Plotted: 2023-01-13
Filename: C:\USERS\BREWERJ\ONEDRIVE - AECOM\DESKTOP\SUNNICA FARM\SS\SUNNICA ENERGY FARN - TPP_001 - OFFLINE COPY\SUNNICA ENERGY FARN - TPP_006(SIMPLIFIED).DWG

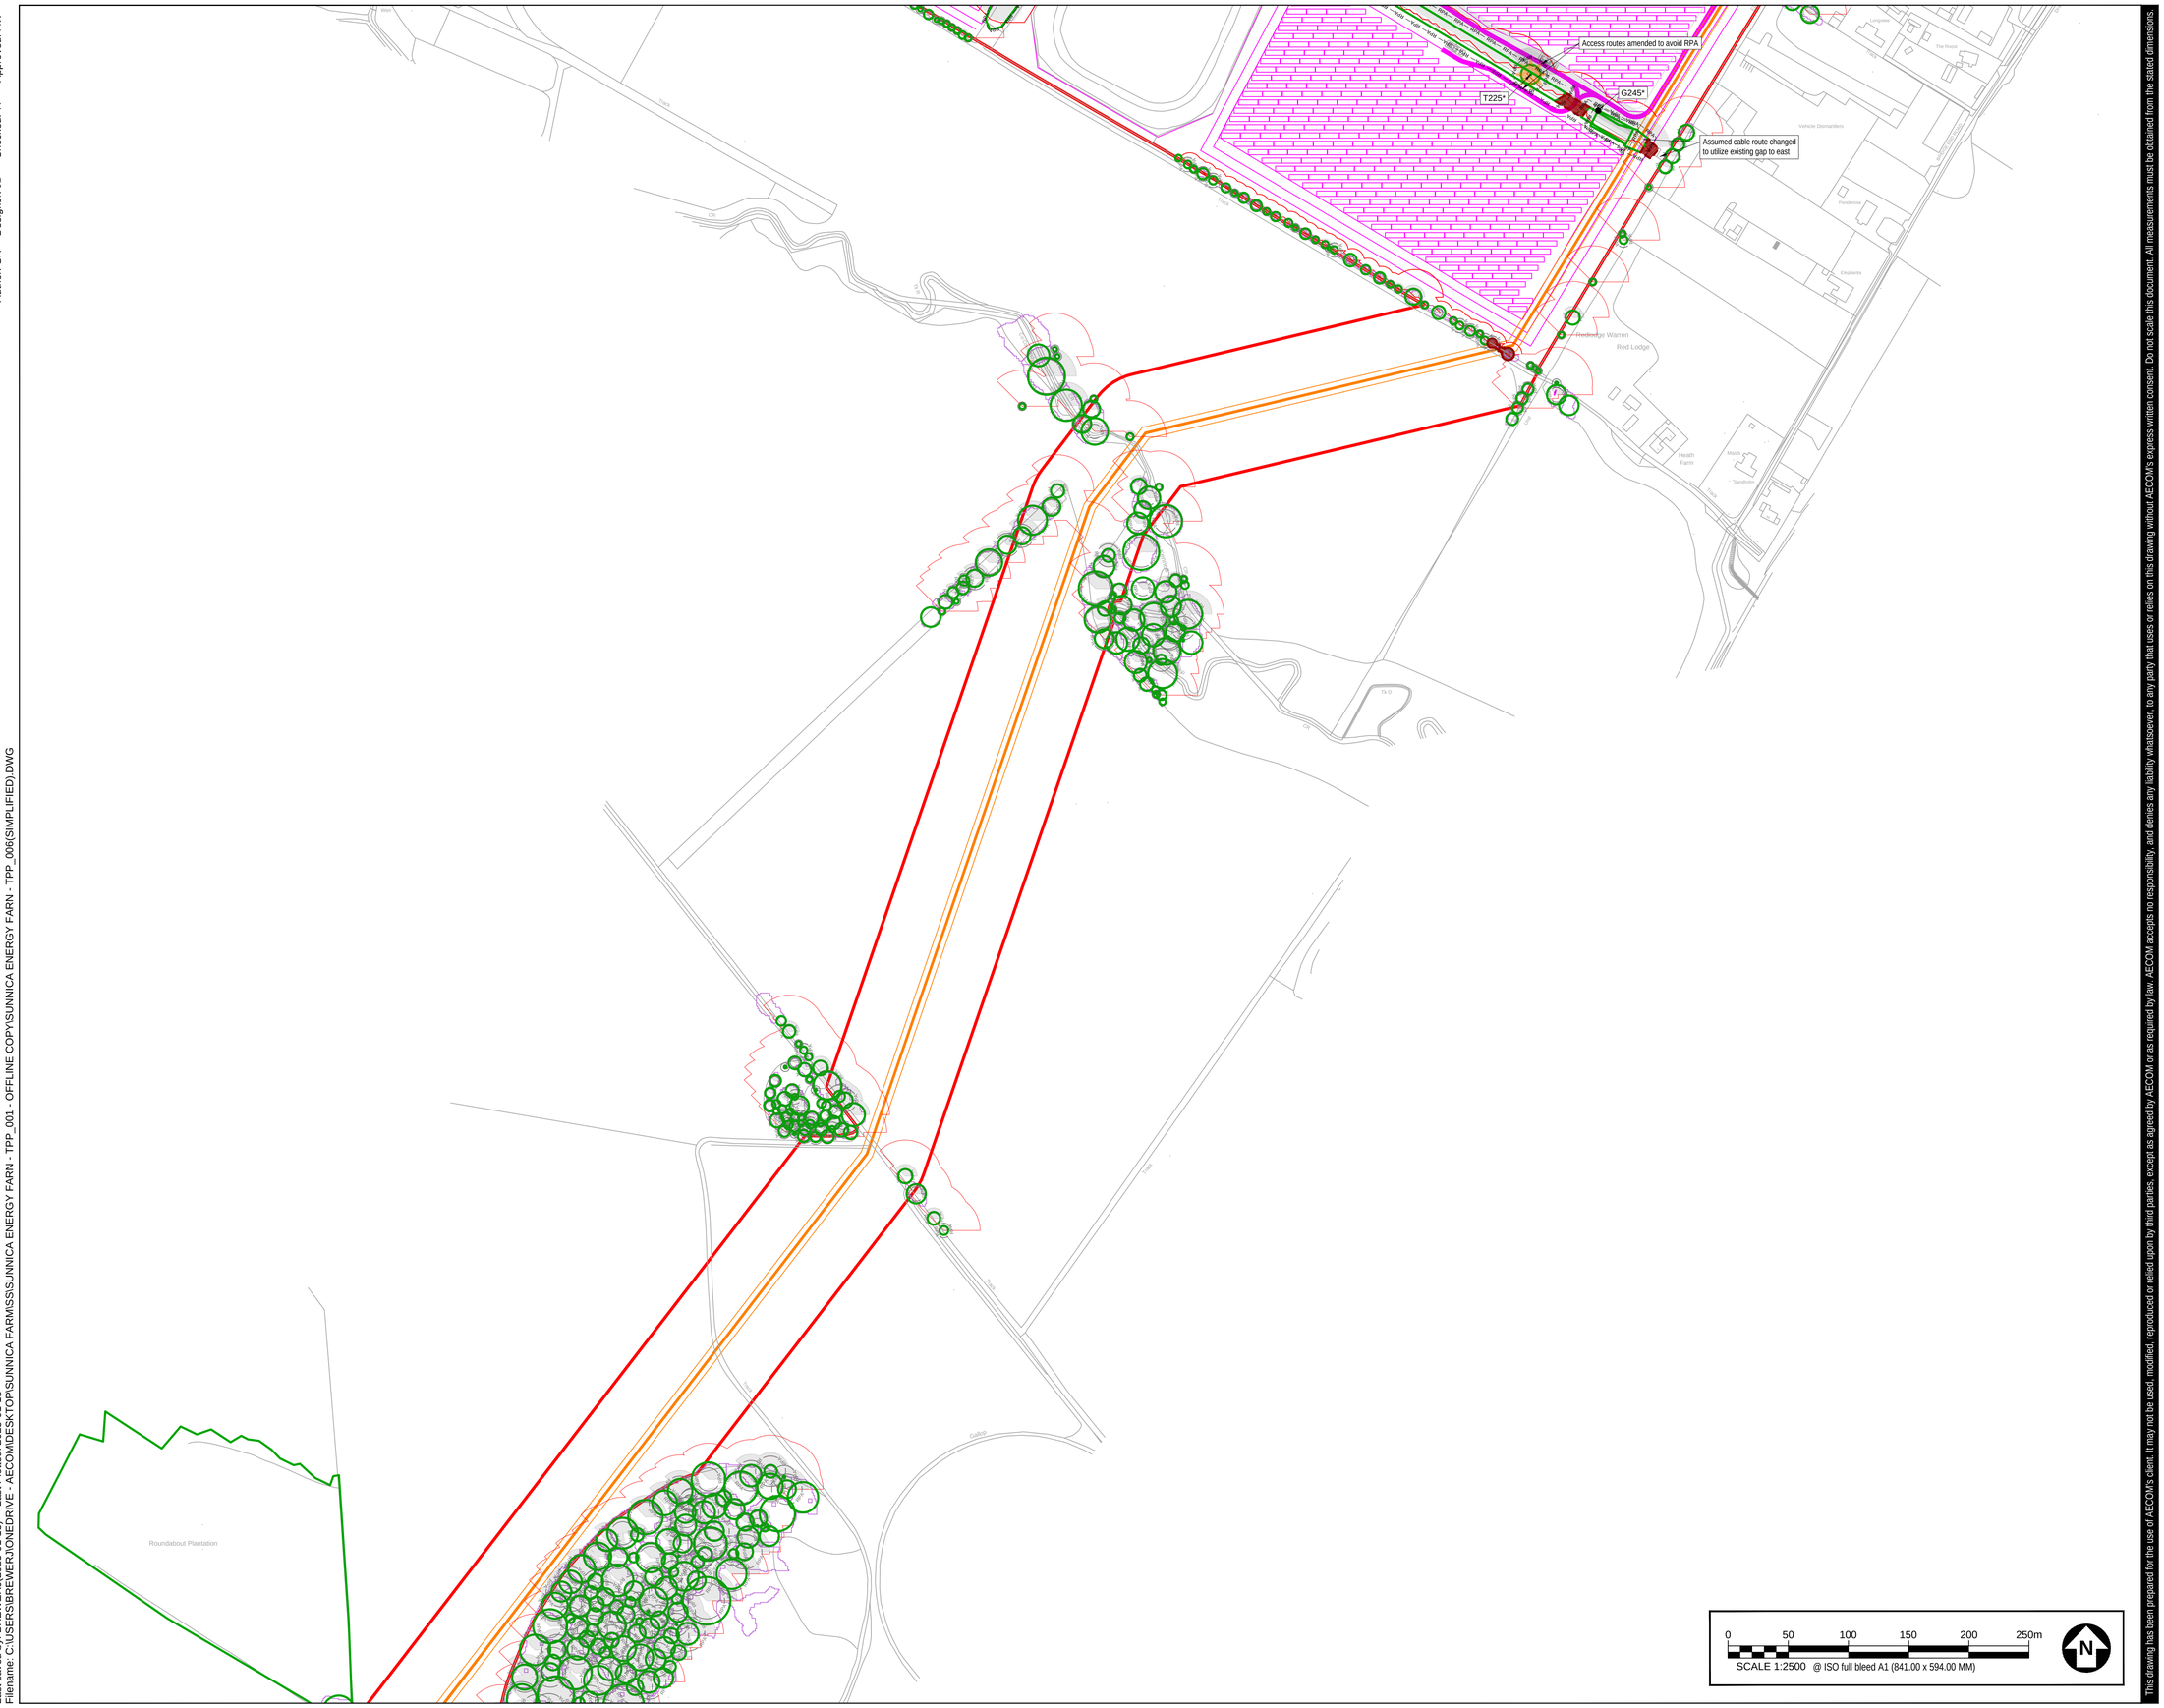

This drawing has been prepared for the use of AECOM's client. It may not be used, modified, reproduced or relied upon by third parties, except as agreed by AECOM or as required by law. AECOM accepts no responsibility, and denies any liability whatsoever, to any party that uses or relies on this drawing without AECOM's express written consent. Do not scale this document. All measurements must be obtained from the stated dimensions.

AECOM

PROJECT

SUNNICA ENERGY FARM

CLIENT

SUNNICA ENERGY FARM

CONSULTANT

AECOM
Plumer House, Third Floor,
East Wing, Tailyour Road
Plymouth, PL6 5DH
Tel +44(0)1752 676700
Fax +44(0)870 238 6023
www.aecom.com

GENERAL NOTES

1. TREE CATEGORIES AS DEFINED BY BS 5837:2012
2. TREE LOCATIONS ARE BASED ON THE TOPOGRAPHICAL SURVEY, AERIAL IMAGERY, AND GPS CO-ORDINATES FROM ON SITE WALKOVER.
3. * INDICATES A TREE / GROUP WHOSE POSITION IS APPROXIMATE AS BASED UPON AERIAL PHOTOGRAPHY AND ON SITE OBSERVATION.
4. PLANS SHOULD BE READ IN CONJUNCTION WITH THE AECOM ARBORICULTURAL REPORT.
5. THE ORIGINAL OF THIS DRAWING WAS PRODUCED IN COLOUR - A MONOCHROME COPY SHOULD NOT BE RELIED UPON.
6. DRAWING REFERNCES:
   - xref_topo.dwg
   - TPO.dwg
   - xref_cstastro.dwg
   - MERGED NTM DATA Rev8 Modified (TPP EDITS).dwg
   - Additional data.dwg
   - Shading Arc (corrected).dwg
   - Shading Arc (corrected case).dwg
   - 20230105_Sunnica_WSP_RLB.dwg
   - 210309_blank_-_v4 (Modified - West Site B Removed).dwg

KEY PLAN

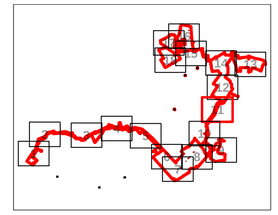

KEY

- **ORDER LIMITS BOUNDARY**
- **EXISTING TREE, GROUP, WOODLAND, OR HEDGE TO BE RETAINED** *(TREE TAGS INDICATE TREES SUBJECT TO DETAILED SURVEY, NO TREE TAG INDICATES TREES BASED ON NTM/DESK STUDY)*
- **EXISTING TREE, GROUP, WOODLAND, OR HEDGE TO BE REMOVED** *(TREE TAGS INDICATE TREES SUBJECT TO DETAILED SURVEY, NO TREE TAG INDICATES TREES BASED ON NTM/DESK STUDY)*
- **ROOT PROTECTION AREAS (RPA)** *(AS DEFINED BY BS 5837:2012 FOR TREES SUBJECT TO DETAILED SURVEY. ESTIMATED BUFFER ZONE SHOWN INDICATIVELY FOR OTHER TREES)*
- **APPROXIMATE SHADING ARC** *(W PREDICTED MAXIMUM GROWTH HEIGHT OUTLINE)*
- **VETERAN/ANCIENT TREE** *(IDENTIFIED BY DETAILED SURVEY)*
- **VETERAN/ANCIENT TREE** *(IDENTIFIED BY WALKOVER/DESK STUDY)*
- **PROPOSED DEVELOPMENT LAYOUT** *(BASED UPON DRAWING REFERENCES LISTED IN THE GENERAL NOTES SECTION)*
- **CONSTRUCTION WORKING ZONE** *(MANAGED CONSTRUCTION PROCESSES PERMITTED IN ACCORDANCE WITH THE PRINCIPLES SET OUT WITHIN THE ARBORICULTURAL IMPACT ASSESSMENT)*
- **TREE PRESERVATION ORDER** *(AREA COVERED BY A TREE PRESERVATION ORDER [TPO])*
- **CONSERVATION AREA** *(AREA COVERED BY A TREE PRESERVATION ORDER [TPO])*
- **PROPOSED CABLE ROUTE**

ISSUE/REVISION

I/R	DATE	DESCRIPTION
P01	13/01/23	SECOND ISSUE
00	22/11/22	FIRST ISSUE

DRAWING STATUS

SUBMITTED AT DEADLINE 5

PROJECT NUMBER

60589004

SHEET TITLE

TREE PROTECTION & REMOVAL PLAN (SHEET 11)

SHEET NUMBER **REV.**

60589004-ACM-XX-XX-AB-TPP-011 P01

Author: GR Designer: JB Checked: TF Approved: AW

Last saved by: BREWERJ (2023-01-13) Last Plotted: 2023-01-13
Filename: C:\USERS\BREWERJ\ONEDRIVE - AECOM\DESKTOP\SUNNICA FARM\SS\SUNNICA ENERGY FARN - TPP_001 - OFFLINE COPY\SUNNICA ENERGY FARN - TPP_006(SIMPLIFIED).DWG

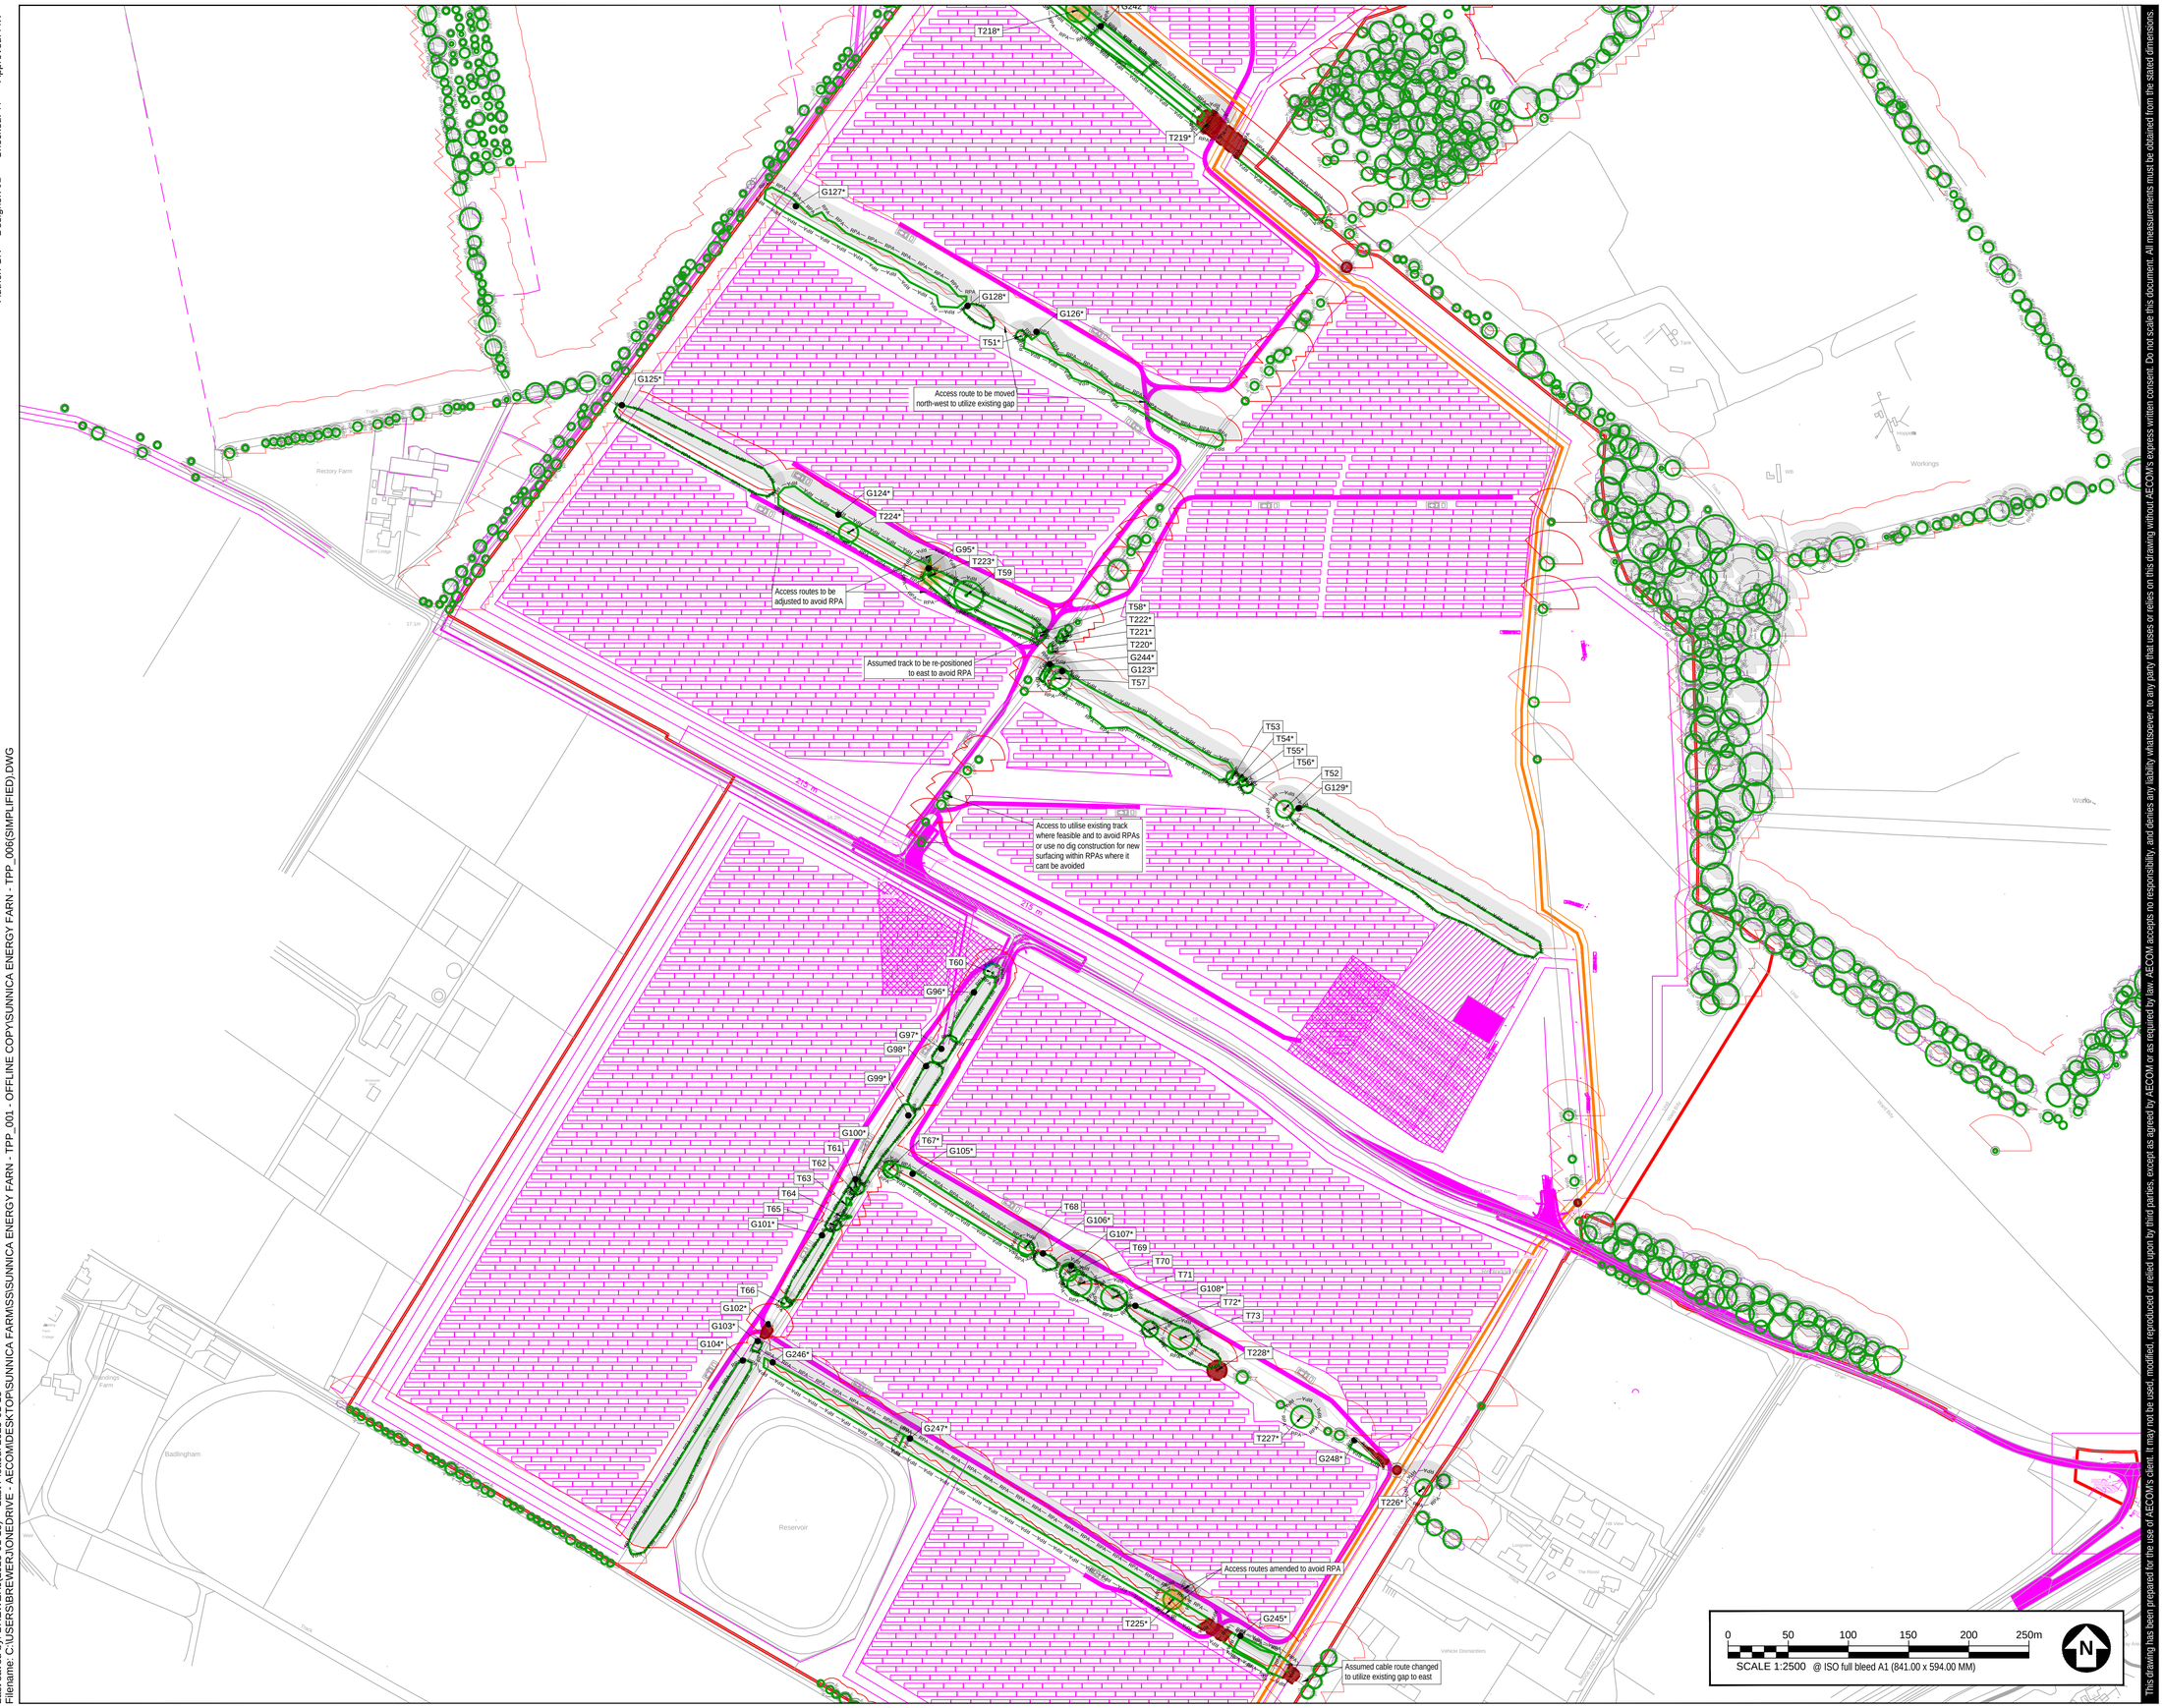

AECOM

PROJECT

SUNNICA ENERGY FARM

CLIENT

SUNNICA ENERGY FARM

CONSULTANT

AECOM
Plumer House, Third Floor,
East Wing, Tailyour Road
Plymouth, PL6 5DH
Tel +44(0)1752 676700
Fax +44(0)870 238 6023
www.aecom.com

GENERAL NOTES

1. TREE CATEGORIES AS DEFINED BY BS 5837:2012
2. TREE LOCATIONS ARE BASED ON THE TOPOGRAPHICAL SURVEY, AERIAL IMAGERY, AND GPS CO-ORDINATES FROM ON SITE WALKOVER.
3. * INDICATES A TREE / GROUP WHOSE POSITION IS APPROXIMATE AS BASED UPON AERIAL PHOTOGRAPHY AND ON SITE OBSERVATIONS.
4. PLANS SHOULD BE READ IN CONJUNCTION WITH THE AECOM ARBORICULTURAL REPORT.
5. THE ORIGINAL OF THIS DRAWING WAS PRODUCED IN COLOUR - A MONOCHROME COPY SHOULD NOT BE RELIED UPON.
6. DRAWING REFERNCES:
   - xref_topo.dwg
   - TPO.dwg
   - xref_cstastro.dwg
   - MERGED NTM CAT A Rev8 Modified (TPP EDITS).dwg
   - Additional data.dwg
   - Shading Arc (Updated).dwg
   - Shading Arc (worst case).dwg
   - 20230105_Sunnica_WSP_RLB.dwg
   - 210309_block_ref (WestBec - West Site B Removed).dwg

KEY PLAN

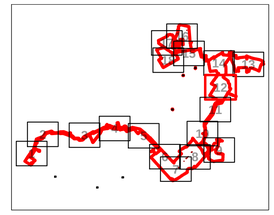

KEY

- **ORDER LIMITS BOUNDARY**
- **EXISTING TREE, GROUP, WOODLAND, OR HEDGE TO BE RETAINED** *(TREE TAGS INDICATE TREES SUBJECT TO DETAILED SURVEY, NO TREE TAG INDICATES TREES BASED ON NTM/DESK STUDY)*
- **EXISTING TREE, GROUP, WOODLAND, OR HEDGE TO BE REMOVED** *(TREE TAGS INDICATE TREES SUBJECT TO DETAILED SURVEY, NO TREE TAG INDICATES TREES BASED ON NTM/DESK STUDY)*
- **ROOT PROTECTION AREAS (RPA)** *(AS DEFINED BY BS 5837:2012 FOR TREES SUBJECT TO DETAILED SURVEY, ESTIMATED BUFFER ZONE SHOWN INDICATIVELY FOR OTHER TREES)*
- **APPROXIMATE SHADING ARC** *(W/ PREDICTED MAXIMUM GROWTH HEIGHT OUTLINE)*
- **VETERAN/ANCIENT TREE** *(IDENTIFIED BY DETAILED SURVEY)*
- **VETERAN/ANCIENT TREE** *(IDENTIFIED BY WALKOVER/DESK STUDY)*
- **PROPOSED DEVELOPMENT LAYOUT** *(BASED UPON DRAWING REFERENCES LISTED IN THE GENERAL NOTES SECTION)*
- **CONSTRUCTION WORKING ZONE** *(MANAGED CONSTRUCTION PROCESSES PERMITTED IN ACCORDANCE WITH THE PRINCIPLES SET OUT WITHIN THE ARBORICULTURAL IMPACT ASSESSMENT)*
- **TREE PRESERVATION ORDER** *(AREA COVERED BY A TREE PRESERVATION ORDER [TPO])*
- **CONSERVATION AREA** *(AREA COVERED BY A TREE PRESERVATION ORDER [TPO])*
- **PROPOSED CABLE ROUTE**

ISSUE/REVISION

P01	13/01/23	SECOND ISSUE
00	22/11/22	FIRST ISSUE
I/R	DATE	DESCRIPTION

DRAWING STATUS

SUBMITTED AT DEADLINE 5

PROJECT NUMBER

60589004

SHEET TITLE

TREE PROTECTION & REMOVAL PLAN (SHEET 12)

SHEET NUMBER **REV.**

60589004-ACM-XX-XX-AB-TPP-012 P01

This drawing has been prepared for the use of AECOM's client. It may not be used, modified, reproduced or relied upon by third parties, except as agreed by AECOM or as required by law. AECOM accepts no responsibility, and denies any liability whatsoever, to any party that uses or relies on this drawing without AECOM's express written consent. Do not scale this document. All measurements must be obtained from the stated dimensions.

Author: GR Designer: JB Checked: TF Approved: AW

Last saved by: BREWERJ(2023-01-13) Last Plotted: 2023-01-13
Filename: C:\USERS\BREWERJ\ONEDRIVE - AECOM\DESKTOP\SUNNICA FARM\SS\SUNNICA ENERGY FARN - TPP_001 - OFFLINE COPY\SUNNICA ENERGY FARN - TPP_006(SIMPLIFIED).DWG

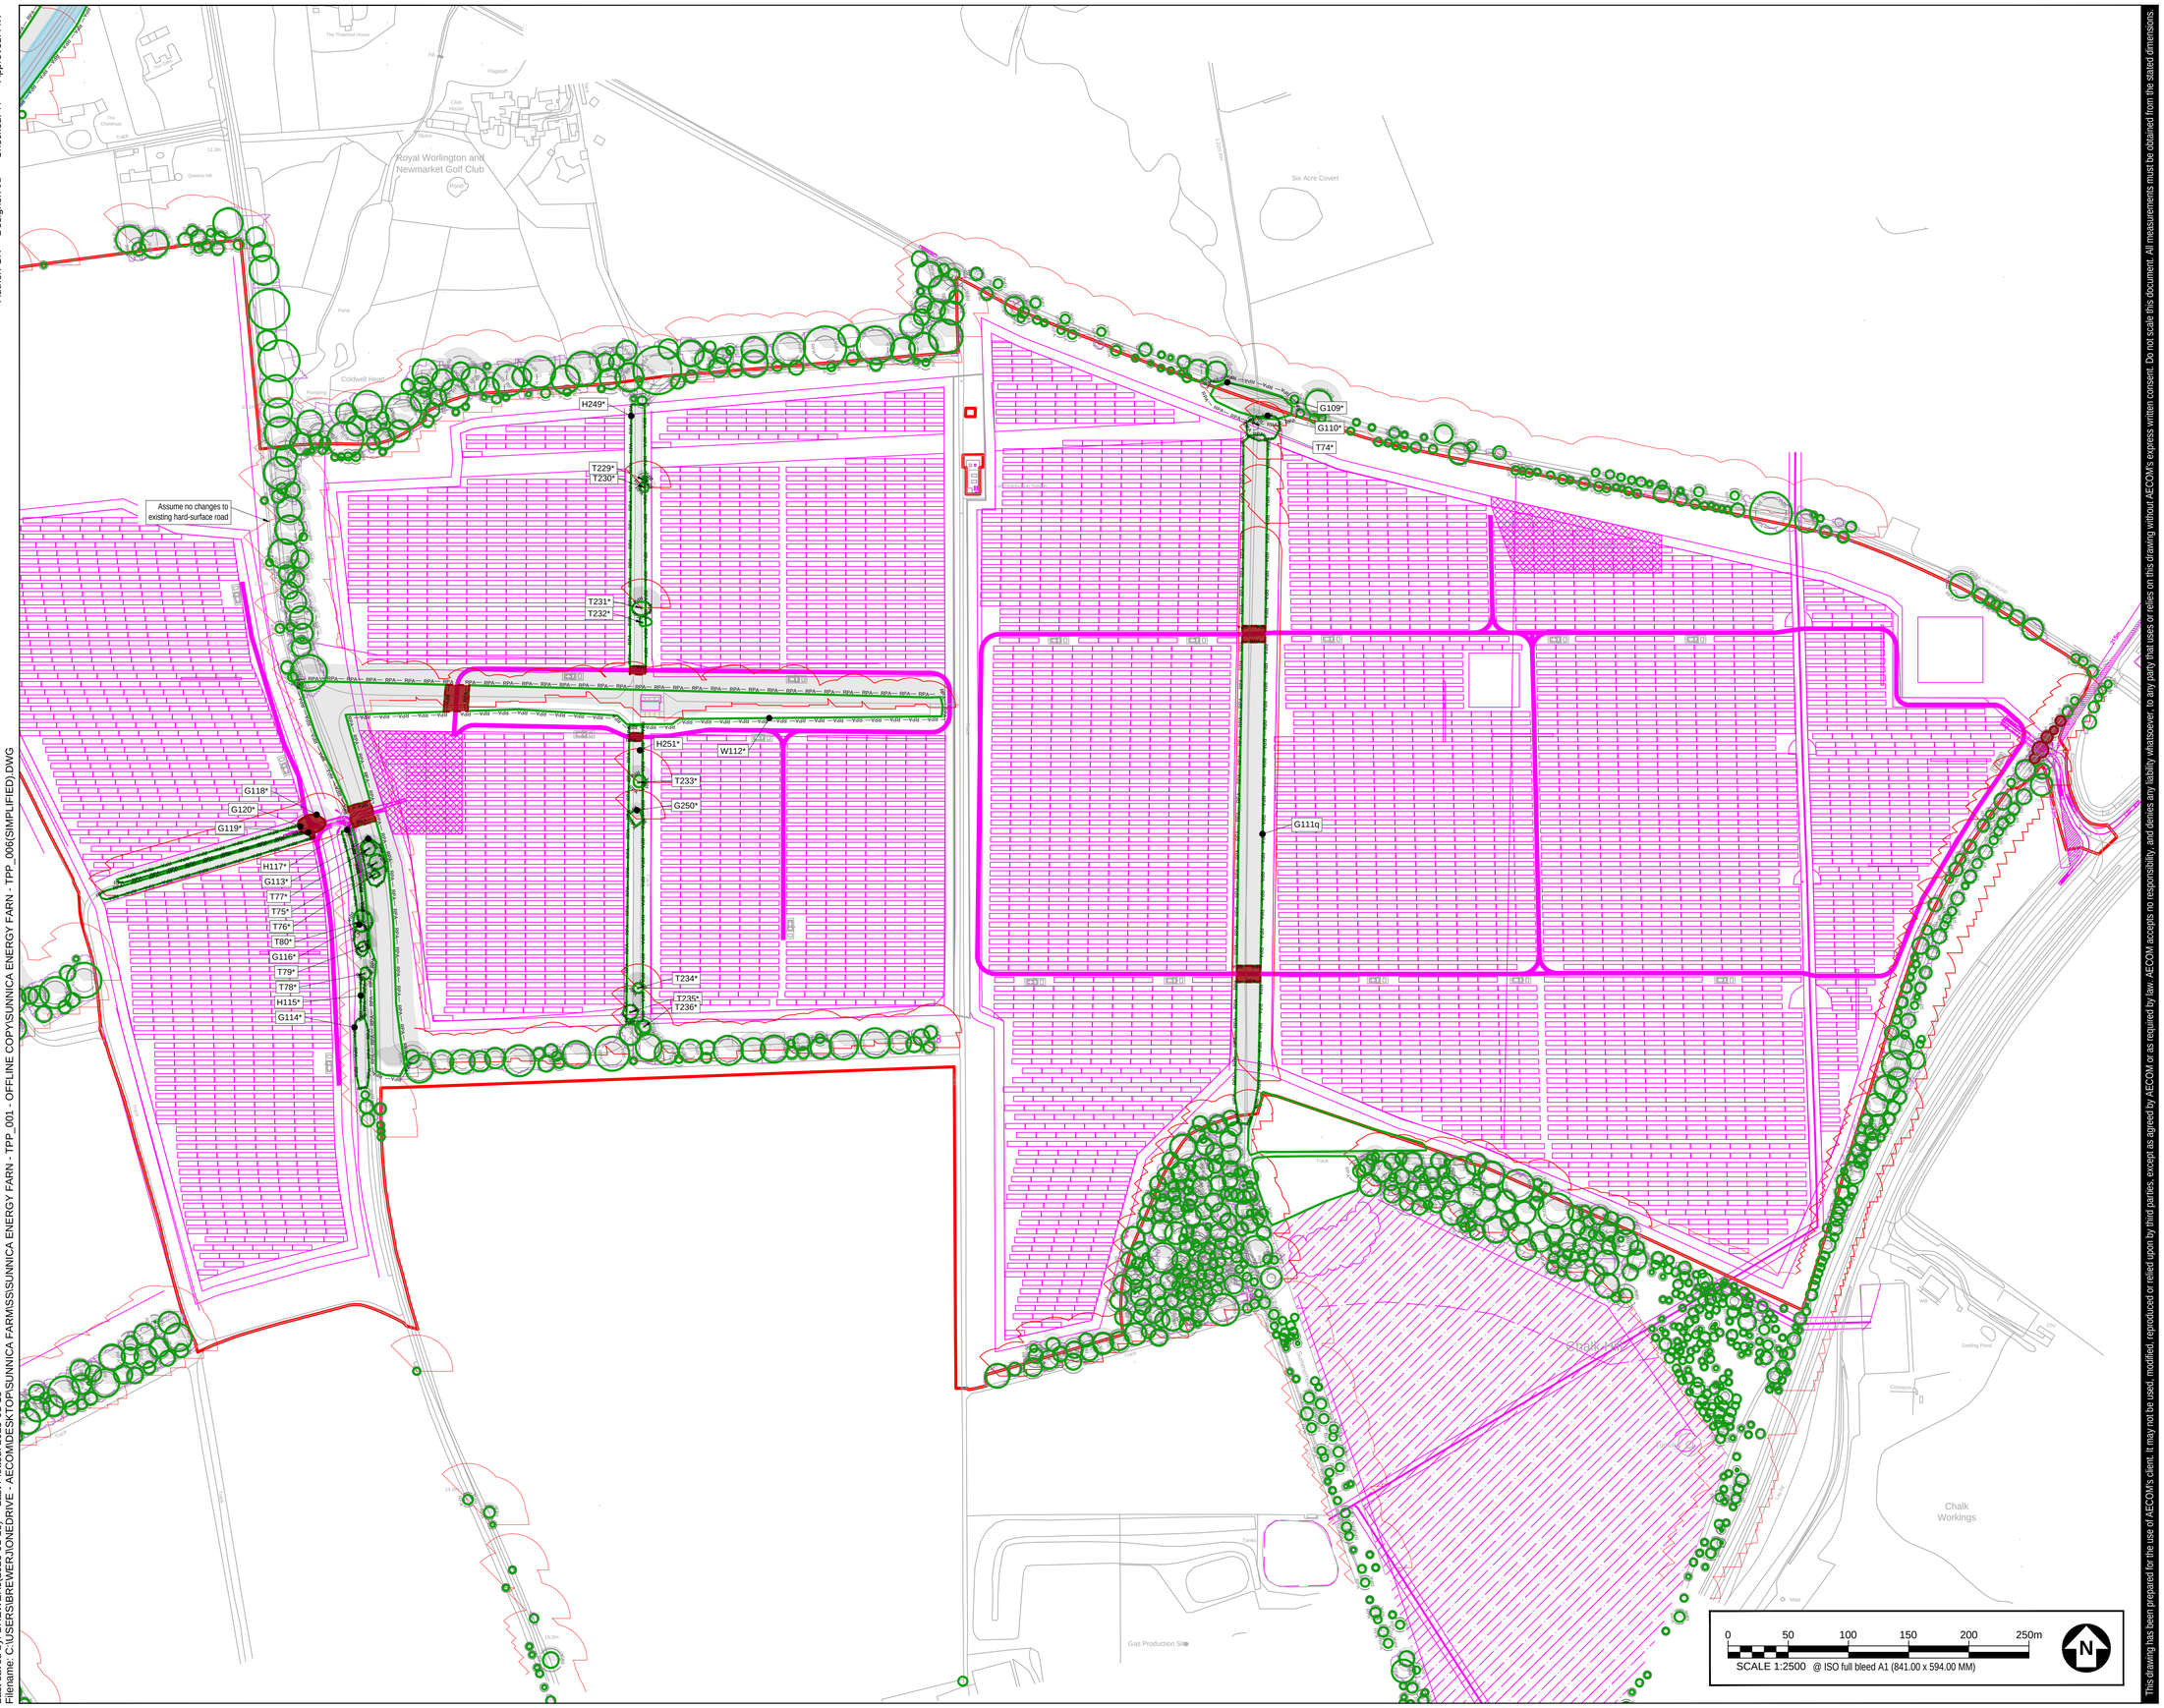

This drawing has been prepared for the use of AECOM's client. It may not be used, modified, reproduced or relied upon by third parties, except as agreed by AECOM or as required by law. AECOM accepts no responsibility, and denies any liability whatsoever, to any party that uses or relies on this drawing without AECOM's express written consent. Do not scale this document. All measurements must be obtained from the stated dimensions.

AECOM

PROJECT

SUNNICA ENERGY FARM

CLIENT

SUNNICA ENERGY FARM

CONSULTANT

AECOM
Plumer House, Third Floor,
East Wing, Tailyour Road
Plymouth, PL6 5DH
Tel +44(0)1752 676700
Fax +44(0)870 238 6023
www.aecom.com

GENERAL NOTES

1. TREE CATEGORIES AS DEFINED BY BS 5837:2012
2. TREE LOCATIONS ARE BASED ON THE TOPOGRAPHICAL SURVEY, AERIAL IMAGERY, AND GPS CO-ORDINATES FROM ON SITE WALKOVER.
3. * INDICATES A TREE / GROUP WHOSE POSITION IS APPROXIMATE AS BASED UPON AERIAL PHOTOGRAPHY AND ON SITE OBSERVATIONS.
4. PLANS SHOULD BE READ IN CONJUNCTION WITH THE AECOM ARBORICULTURAL REPORT.
5. THE ORIGINAL OF THIS DRAWING WAS PRODUCED IN COLOUR - A MONOCHROME COPY SHOULD NOT BE RELIED UPON.
6. DRAWING REFERNCES:
   - xref_topo.dwg
   - TPO.dwg
   - xref_catastro.dwg
   - MERGED NTM DATA Rev8 Modified (TPP EDITS).dwg
   - Additional data.dwg
   - Shading Arc (joined).dwg
   - Shading Arc (joint case).dwg
   - 20230105_Sunnica_WSP_RLB.dwg
   - 210309_block_ _v4 (Modified - West Site B Removed).dwg

KEY PLAN

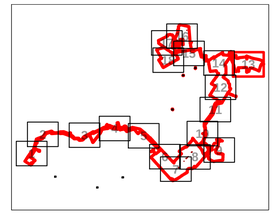

KEY

- **ORDER LIMITS BOUNDARY**
- **EXISTING TREE, GROUP, WOODLAND, OR HEDGE TO BE RETAINED** *(TREE TAGS INDICATE TREES SUBJECT TO DETAILED SURVEY, NO TREE TAG INDICATES TREES BASED ON NTM/DESK STUDY)*
- **EXISTING TREE, GROUP, WOODLAND, OR HEDGE TO BE REMOVED** *(TREE TAGS INDICATE TREES SUBJECT TO DETAILED SURVEY, NO TREE TAG INDICATES TREES BASED ON NTM/DESK STUDY)*
- **ROOT PROTECTION AREAS (RPA)** *(AS DEFINED BY BS 5837:2012 FOR TREES SUBJECT TO DETAILED SURVEY. ESTIMATED BUFFER ZONE SHOWN INDICATIVELY FOR OTHER TREES)*
- **APPROXIMATE SHADING ARC** *(W PREDICTED MAXIMUM GROWTH HEIGHT OUTLINE)*
- **VETERAN/ANCIENT TREE** *(IDENTIFIED BY DETAILED SURVEY)*
- **VETERAN/ANCIENT TREE** *(IDENTIFIED BY WALKOVER/DESK STUDY)*
- **PROPOSED DEVELOPMENT LAYOUT** *(BASED UPON DRAWING REFERENCES LISTED IN THE GENERAL NOTES SECTION)*
- **CONSTRUCTION WORKING ZONE** *(MANAGED CONSTRUCTION PROCESSES PERMITTED IN ACCORDANCE WITH THE PRINCIPLES SET OUT WITHIN THE ARBORICULTURAL IMPACT ASSESSMENT)*
- **TREE PRESERVATION ORDER** *(AREA COVERED BY A TREE PRESERVATION ORDER [TPO])*
- **CONSERVATION AREA** *(AREA COVERED BY A TREE PRESERVATION ORDER [TPO])*
- **PROPOSED CABLE ROUTE**

ISSUE/REVISION

P01	13/01/23	SECOND ISSUE
00	22/11/22	FIRST ISSUE
I/R	DATE	DESCRIPTION

DRAWING STATUS

SUBMITTED AT DEADLINE 5

PROJECT NUMBER

60589004

SHEET TITLE

TREE PROTECTION & REMOVAL PLAN (SHEET 13)

SHEET NUMBER **REV.**

60589004-ACM-XX-XX-AB-TPP-013 P01

Author: GR Designer: JB Checked: TF Approved: AW

Last saved by: BREWERJ(2023-01-13) Last Plotted: 2023-01-13
Filename: C:\USERS\BREWERJ\ONEDRIVE - AECOM\DESKTOP\SUNNICA FARM\SSI\SUNNICA ENERGY FARN - TPP_001 - OFFLINE COPY\SUNNICA ENERGY FARN - TPP_006(SIMPLIFIED).DWG

Cable alignment moved west to avoid tree RPA's

Assumed cable alignment & working width adjusted east to avoid RPA's

Crossing Point N°1 (Lines from Bay farm to the substation).

Crossing Point N°2 (Crossing point into manor farm lands crossing U6006 road).

Access route to be re-routed to utilise proposed clearance area to north or south

Cable route and working width to be amended to avoid RPA's

TPO/002(2022)

W94*
G93*
G241*
G121*
G92*
G91*
T50*
T48*
T47*
T49*
T46*
G239*
G90*
T45*
T212*
G238*
T44*
G89*
T43*
G88*
G87*
G237*
T211*
T210*
T209*
G86*
G85*
T42*
G84*
G83*
G81*
T208*
T207*
G82*q
G243*
T216*
T217*
G242*
T218*
G240*
T214*
T213*
T215*
G122*

0 50 100 150 200 250m
SCALE 1:2500 @ ISO full bleed A1 (841.00 x 594.00 MM)

This drawing has been prepared for the use of AECOM's client. It may not be used, modified, reproduced or relied upon by third parties, except as agreed by AECOM or as required by law. AECOM accepts no responsibility, and denies any liability whatsoever, to any party that uses or relies on this drawing without AECOM's express written consent. Do not scale this document. All measurements must be obtained from the stated dimensions.

AECOM

PROJECT

SUNNICA ENERGY FARM

CLIENT

SUNNICA ENERGY FARM

CONSULTANT

AECOM
Plumer House, Third Floor,
East Wing, Tailyour Road
Plymouth, PL6 5DH
Tel +44(0)1752 676700
Fax +44(0)870 238 6023
www.aecom.com

GENERAL NOTES

1. TREE CATEGORIES AS DEFINED BY BS 5837:2012
2. TREE LOCATIONS ARE BASED ON THE TOPOGRAPHICAL SURVEY, AERIAL IMAGERY, AND GPS CO-ORDINATES FROM ON SITE WALKOVER.
3. * INDICATES A TREE / GROUP WHOSE POSITION IS APPROXIMATE AS BASED UPON AERIAL PHOTOGRAPHY AND ON SITE OBSERVATIONS.
4. PLANS SHOULD BE READ IN CONJUNCTION WITH THE AECOM ARBORICULTURAL REPORT.
5. THE ORIGINAL OF THIS DRAWING WAS PRODUCED IN COLOUR - A MONOCHROME COPY SHOULD NOT BE RELIED UPON.
6. DRAWING REFERNCES:
   - xref_topo.dwg
   - TPO.dwg
   - xref_catastro.dwg
   - MERGED NTM CATA Rev8 Modified (TPP EDITS).dwg
   - Additional data.dwg
   - Shading Arc (joined).dwg
   - Shading Arc (joint).dwg
   - 20230105_Sunnica_WSP_RLB.dwg
   - 210309_block_-_vf_(Modified - West Site B Removed).dwg

KEY PLAN

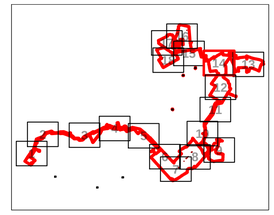

KEY

- **ORDER LIMITS BOUNDARY**
- **EXISTING TREE, GROUP, WOODLAND, OR HEDGE TO BE RETAINED** *(TREE TAGS INDICATE TREES SUBJECT TO DETAILED SURVEY, NO TREE TAG INDICATES TREES BASED ON NTM/DESK STUDY)*
- **EXISTING TREE, GROUP, WOODLAND, OR HEDGE TO BE REMOVED** *(TREE TAGS INDICATE TREES SUBJECT TO DETAILED SURVEY, NO TREE TAG INDICATES TREES BASED ON NTM/DESK STUDY)*
- **ROOT PROTECTION AREAS (RPA)** *(AS DEFINED BY BS 5837:2012 FOR TREES SUBJECT TO DETAILED SURVEY, ESTIMATED BUFFER ZONE SHOWN INDICATIVELY FOR OTHER TREES)*
- **APPROXIMATE SHADING ARC** *(W/ PREDICTED MAXIMUM GROWTH HEIGHT OUTLINE)*
- **VETERAN/ANCIENT TREE** *(IDENTIFIED BY DETAILED SURVEY)*
- **VETERAN/ANCIENT TREE** *(IDENTIFIED BY WALKOVER/DESK STUDY)*
- **PROPOSED DEVELOPMENT LAYOUT** *(BASED UPON DRAWING REFERENCES LISTED IN THE GENERAL NOTES SECTION)*
- **CONSTRUCTION WORKING ZONE** *(MANAGED CONSTRUCTION PROCESSES PERMITTED IN ACCORDANCE WITH THE PRINCIPLES SET OUT WITHIN THE ARBORICULTURAL IMPACT ASSESSMENT)*
- **TREE PRESERVATION ORDER** *(AREA COVERED BY A TREE PRESERVATION ORDER [TPO])*
- **CONSERVATION AREA** *(AREA COVERED BY A TREE PRESERVATION ORDER [TPO])*
- **PROPOSED CABLE ROUTE**

ISSUE/REVISION

P01	13/01/23	SECOND ISSUE
00	22/11/22	FIRST ISSUE
I/R	DATE	DESCRIPTION

DRAWING STATUS

SUBMITTED AT DEADLINE 5

PROJECT NUMBER

60589004

SHEET TITLE

TREE PROTECTION & REMOVAL PLAN (SHEET 14)

SHEET NUMBER **REV.**

60589004-ACM-XX-XX-AB-TPP-014 P01

Author: GR Designer: JB Checked: TF Approved: AW

Estimated tree loss for 10m corridor for 33kv cable

10m corridor for 33kv cable to be positioned to avoid tree loss or impact

Assumed to avoid RPA's or no-dig construction within RPA's

Cable alignment moved west to avoid tree RPA's

AS1. Please note:

0 50 100 150 200 250m

SCALE 1:2500 @ ISO full bleed A1 (841.00 x 594.00 MM)

Last saved by: BREWERJ (2023-01-13) Last Plotted: 2023-01-13
Filename: C:\USERS\BREWERJ\ONEDRIVE - AECOM\DESKTOP\SUNNICA FARM\SS\SUNNICA ENERGY FARN - TPP_001 - OFFLINE COPY\SUNNICA ENERGY FARN - TPP_006(SIMPLIFIED).DWG

This drawing has been prepared for the use of AECOM's client. It may not be used, modified, reproduced or relied upon by third parties, except as agreed by AECOM or as required by law. AECOM accepts no responsibility, and denies any liability whatsoever, to any party that uses or relies on this drawing without AECOM's express written consent. Do not scale this document. All measurements must be obtained from the stated dimensions.

AECOM

PROJECT

SUNNICA ENERGY FARM

CLIENT

SUNNICA ENERGY FARM

CONSULTANT

AECOM
Plumer House, Third Floor,
East Wing, Tailyour Road
Plymouth, PL6 5DH
Tel +44(0)1752 676700
Fax +44(0)870 238 6023
www.aecom.com

GENERAL NOTES

1. TREE CATEGORIES AS DEFINED BY BS 5837:2012
2. TREE LOCATIONS ARE BASED ON THE TOPOGRAPHICAL SURVEY, AERIAL IMAGERY, AND GPS CO-ORDINATES FROM ON SITE WALKOVER.
3. * INDICATES A TREE / GROUP WHOSE POSITION IS APPROXIMATE AS BASED UPON AERIAL PHOTOGRAPHY AND ON SITE OBSERVATIONS.
4. PLANS SHOULD BE READ IN CONJUNCTION WITH THE AECOM ARBORICULTURAL REPORT.
5. THE ORIGINAL OF THIS DRAWING WAS PRODUCED IN COLOUR - A MONOCHROME COPY SHOULD NOT BE RELIED UPON.
6. DRAWING REFERNCES:
   - xref_topo.dwg
   - TPO.dwg
   - xref_cotastro.dwg
   - MERGED NTM DATA Rev8 Modified (TPP EDITS).dwg
   - Additional data.dwg
   - Shading Arc (Joined).dwg
   - Shading Arc (joint case).dwg
   - 20230105_Sunnica_WSP_RLB.dwg
   - 210309_blend__v4 (WestBec - West Site B Removed).dwg

KEY PLAN

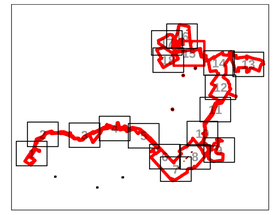

KEY

- **ORDER LIMITS BOUNDARY**
- **EXISTING TREE, GROUP, WOODLAND, OR HEDGE TO BE RETAINED** *(TREE TAGS INDICATE TREES SUBJECT TO DETAILED SURVEY, NO TREE TAG INDICATES TREES BASED ON NTM/DESK STUDY)*
- **EXISTING TREE, GROUP, WOODLAND, OR HEDGE TO BE REMOVED** *(TREE TAGS INDICATE TREES SUBJECT TO DETAILED SURVEY, NO TREE TAG INDICATES TREES BASED ON NTM/DESK STUDY)*
- **ROOT PROTECTION AREAS (RPA)** *(AS DEFINED BY BS 5837:2012 FOR TREES SUBJECT TO DETAILED SURVEY. ESTIMATED BUFFER ZONE SHOWN INDICATIVELY FOR OTHER TREES)*
- **APPROXIMATE SHADING ARC** *(W PREDICTED MAXIMUM GROWTH HEIGHT OUTLINE)*
- **VETERAN/ANCIENT TREE** *(IDENTIFIED BY DETAILED SURVEY)*
- **VETERAN/ANCIENT TREE** *(IDENTIFIED BY WALKOVER/DESK STUDY)*
- **PROPOSED DEVELOPMENT LAYOUT** *(BASED UPON DRAWING REFERENCES LISTED IN THE GENERAL NOTES SECTION)*
- **CONSTRUCTION WORKING ZONE** *(MANAGED CONSTRUCTION PROCESSES PERMITTED IN ACCORDANCE WITH THE PRINCIPLES SET OUT WITHIN THE ARBORICULTURAL IMPACT ASSESSMENT)*
- **TREE PRESERVATION ORDER** *(AREA COVERED BY A TREE PRESERVATION ORDER [TPO])*
- **CONSERVATION AREA** *(AREA COVERED BY A TREE PRESERVATION ORDER [TPO])*
- **PROPOSED CABLE ROUTE**

ISSUE/REVISION

P01	13/01/23	SECOND ISSUE
00	22/11/22	FIRST ISSUE
I/R	DATE	DESCRIPTION

DRAWING STATUS

SUBMITTED AT DEADLINE 5

PROJECT NUMBER

60589004

SHEET TITLE

TREE PROTECTION & REMOVAL PLAN (SHEET 15)

SHEET NUMBER 60589004-ACM-XX-XX-AB-TPP-015

REV. P01

Potential Veteran tree's identified by site walkover [2019] [CONSIDERED NO LONGER PRESENT ON SITE - 2022]

Estimated tree loss for 10m corridor for 33kv cable

0 50 100 150 200 250m

SCALE 1:2500 @ ISO full bleed A1 (841.00 x 594.00 MM)

Author: GR Designer: JB Checked: TF Approved: AW

Last saved by: BREWER.J (2023-01-13) Last Plotted: 2023-01-13
Filename: C:\USERS\BREWER.J\ONEDRIVE - AECOM\DESKTOP\SUNNICA FARM\SS\SUNNICA ENERGY FARN - TPP_001 - OFFLINE COPY\SUNNICA ENERGY FARN - TPP_006(SIMPLIFIED).DWG

This drawing has been prepared for the use of AECOM's client. It may not be used, modified, reproduced or relied upon by third parties, except as agreed by AECOM or as required by law. AECOM accepts no responsibility, and denies any liability whatsoever, to any party that uses or relies on this drawing without AECOM's express written consent. Do not scale this document. All measurements must be obtained from the stated dimensions.

AECOM

PROJECT

SUNNICA ENERGY FARM

CLIENT

SUNNICA ENERGY FARM

CONSULTANT

AECOM
Plumer House, Third Floor,
East Wing, Tailyour Road
Plymouth, PL6 5DH
Tel +44(0)1752 676700
Fax +44(0)870 238 6023
www.aecom.com

GENERAL NOTES

1. TREE CATEGORIES AS DEFINED BY BS 5837:2012
2. TREE LOCATIONS ARE BASED ON THE TOPOGRAPHICAL SURVEY, AERIAL IMAGERY, AND GPS CO-ORDINATES FROM ON SITE WALKOVER.
3. * INDICATES A TREE / GROUP WHOSE POSITION IS APPROXIMATE AS BASED UPON AERIAL PHOTOGRAPHY AND ON SITE OBSERVATIONS.
4. PLANS SHOULD BE READ IN CONJUNCTION WITH THE AECOM ARBORICULTURAL REPORT.
5. THE ORIGINAL OF THIS DRAWING WAS PRODUCED IN COLOUR - A MONOCHROME COPY SHOULD NOT BE RELIED UPON.
6. DRAWING REFERNCES:
   - xref_topo.dwg
   - TPO.dwg
   - xref_cstastro.dwg
   - MERGED NTM CATA Rev8 Modified (TPP EDITS).dwg
   - Additional data.dwg
   - Shading Arc (corrected).dwg
   - Shading Arc (corrct case).dwg
   - 20230105_Sunnica_WSP_RLB.dwg
   - 210309_blend_-_vt (WestBed - West Site B Removed).dwg

KEY PLAN

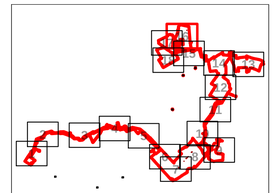

KEY

- **ORDER LIMITS BOUNDARY**
- **EXISTING TREE, GROUP, WOODLAND, OR HEDGE TO BE RETAINED** *(TREE TAGS INDICATE TREES SUBJECT TO DETAILED SURVEY, NO TREE TAG INDICATES TREES BASED ON NTM/DESK STUDY)*
- **EXISTING TREE, GROUP, WOODLAND, OR HEDGE TO BE REMOVED** *(TREE TAGS INDICATE TREES SUBJECT TO DETAILED SURVEY, NO TREE TAG INDICATES TREES BASED ON NTM/DESK STUDY)*
- **ROOT PROTECTION AREAS (RPA)** *(AS DEFINED BY BS 5837:2012 FOR TREES SUBJECT TO DETAILED SURVEY, ESTIMATED BUFFER ZONE SHOWN INDICATIVELY FOR OTHER TREES)*
- **APPROXIMATE SHADING ARC** *(W/ PREDICTED MAXIMUM GROWTH HEIGHT OUTLINE)*
- **VETERAN/ANCIENT TREE** *(IDENTIFIED BY DETAILED SURVEY)*
- **VETERAN/ANCIENT TREE** *(IDENTIFIED BY WALKOVER/DESK STUDY)*
- **PROPOSED DEVELOPMENT LAYOUT** *(BASED UPON DRAWING REFERENCES LISTED IN THE GENERAL NOTES SECTION)*
- **CONSTRUCTION WORKING ZONE** *(MANAGED CONSTRUCTION PROCESSES PERMITTED IN ACCORDANCE WITH THE PRINCIPLES SET OUT WITHIN THE ARBORICULTURAL IMPACT ASSESSMENT)*
- **TREE PRESERVATION ORDER** *(AREA COVERED BY A TREE PRESERVATION ORDER [TPO])*
- **CONSERVATION AREA** *(AREA COVERED BY A TREE PRESERVATION ORDER [TPO])*
- **PROPOSED CABLE ROUTE**

ISSUE/REVISION

I/R	DATE	DESCRIPTION
P01	13/01/23	SECOND ISSUE
00	22/11/22	FIRST ISSUE

DRAWING STATUS

SUBMITTED AT DEADLINE 5

PROJECT NUMBER

60589004

SHEET TITLE

TREE PROTECTION & REMOVAL PLAN (SHEET 16)

SHEET NUMBER / REV.

60589004-ACM-XX-XX-AB-TPP-016 P01

Author: GR Designer: JB Checked: TF Approved: AW

Potential Veteran tree's identified by site walkover [2019] [CONSIDERED NO LONGER PRESENT ON SITE - 2022]

Estimated tree loss for 10m corridor for 33kv cable

10m corridor for 33kv cable to be positioned to avoid tree loss or impact

Ark Church

Isleham Field

Lee Farm

Beck Bridge

Lee Bridge

Reservoir

Drain

Store

Dismantled Railway

0 50 100 150 200 250m

SCALE 1:2500 @ ISO full bleed A1 (841.00 x 594.00 MM)

N

This drawing has been prepared for the use of AECOM's client. It may not be used, modified, reproduced or relied upon by third parties, except as agreed by AECOM or as required by law. AECOM accepts no responsibility, and denies any liability whatsoever, to any party that uses or relies on this drawing without AECOM's express written consent. Do not scale this document. All measurements must be obtained from the stated dimensions.

AECOM

PROJECT

SUNNICA ENERGY FARM

CLIENT

SUNNICA ENERGY FARM

CONSULTANT

AECOM
Plumer House, Third Floor,
East Wing, Tailyour Road
Plymouth, PL6 5DH
Tel +44(0)1752 676700
Fax +44(0)870 238 6023
www.aecom.com

GENERAL NOTES

1. TREE CATEGORIES AS DEFINED BY BS 5837:2012
2. TREE LOCATIONS ARE BASED ON THE TOPOGRAPHICAL SURVEY, AERIAL IMAGERY, AND GPS CO-ORDINATES FROM ON SITE WALKOVER.
3. * INDICATES A TREE / GROUP WHOSE POSITION IS APPROXIMATE AS BASED UPON AERIAL PHOTOGRAPHY AND ON SITE OBSERVATIONS.
4. PLANS SHOULD BE READ IN CONJUNCTION WITH THE AECOM ARBORICULTURAL REPORT.
5. THE ORIGINAL OF THIS DRAWING WAS PRODUCED IN COLOUR - A MONOCHROME COPY SHOULD NOT BE RELIED UPON.
6. DRAWING REFERNCES:
   - xref_topo.dwg
   - TPO.dwg
   - xref_cstastro.dwg
   - MERGED NTM DATA Rev8 Modified (TPP EDITS).dwg
   - Additional data.dwg
   - Shading Arc (Amended).dwg
   - Shading Arc (cent).cast.dwg
   - 20230105_Sunnica_WSP_RLB.dwg
   - 210309_Item4__v4 (Modified - West Site B Removed).dwg

KEY PLAN

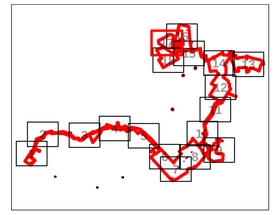

KEY

- **ORDER LIMITS BOUNDARY**
- **EXISTING TREE, GROUP, WOODLAND, OR HEDGE TO BE RETAINED** *(TREE TAGS INDICATE TREES SUBJECT TO DETAILED SURVEY, NO TREE TAG INDICATES TREES BASED ON NTM/DESK STUDY)*
- **EXISTING TREE, GROUP, WOODLAND, OR HEDGE TO BE REMOVED** *(TREE TAGS INDICATE TREES SUBJECT TO DETAILED SURVEY, NO TREE TAG INDICATES TREES BASED ON NTM/DESK STUDY)*
- **ROOT PROTECTION AREAS (RPA)** *(AS DEFINED BY BS 5837:2012 FOR TREES SUBJECT TO DETAILED SURVEY. ESTIMATED BUFFER ZONE SHOWN INDICATIVELY FOR OTHER TREES)*
- **APPROXIMATE SHADING ARC** *(W/ PREDICTED MAXIMUM GROWTH HEIGHT OUTLINE)*
- **VETERAN/ANCIENT TREE** *(IDENTIFIED BY DETAILED SURVEY)*
- **VETERAN/ANCIENT TREE** *(IDENTIFIED BY WALKOVER/DESK STUDY)*
- **PROPOSED DEVELOPMENT LAYOUT** *(BASED UPON DRAWING REFERENCES LISTED IN THE GENERAL NOTES SECTION)*
- **CONSTRUCTION WORKING ZONE** *(MANAGED CONSTRUCTION PROCESSES PERMITTED IN ACCORDANCE WITH THE PRINCIPLES SET OUT WITHIN THE ARBORICULTURAL IMPACT ASSESSMENT)*
- **TREE PRESERVATION ORDER** *(AREA COVERED BY A TREE PRESERVATION ORDER (TPO))*
- **CONSERVATION AREA** *(AREA COVERED BY A TREE PRESERVATION ORDER (TPO))*
- **PROPOSED CABLE ROUTE**

ISSUE/REVISION

P01	13/01/23	SECOND ISSUE
00	22/11/22	FIRST ISSUE
I/R	DATE	DESCRIPTION

DRAWING STATUS

SUBMITTED AT DEADLINE 5

PROJECT NUMBER

60589004

SHEET TITLE

TREE PROTECTION & REMOVAL PLAN (SHEET 17)

SHEET NUMBER / REV.

60589004-ACM-XX-XX-AB-TPP-017 P01

Last saved by: BREWERJ (2023-01-13) Last Plotted: 2023-01-13
Filename: C:\USERS\BREWERJ\ONEDRIVE - AECOM\DESKTOP\SUNNICA FARM\SS\SUNNICA ENERGY FARN - TPP_001 - OFFLINE COPY\SUNNICA ENERGY FARN - TPP_006(SIMPLIFIED).DWG

Author: GR Designer: JB Checked: TF Approved: AW

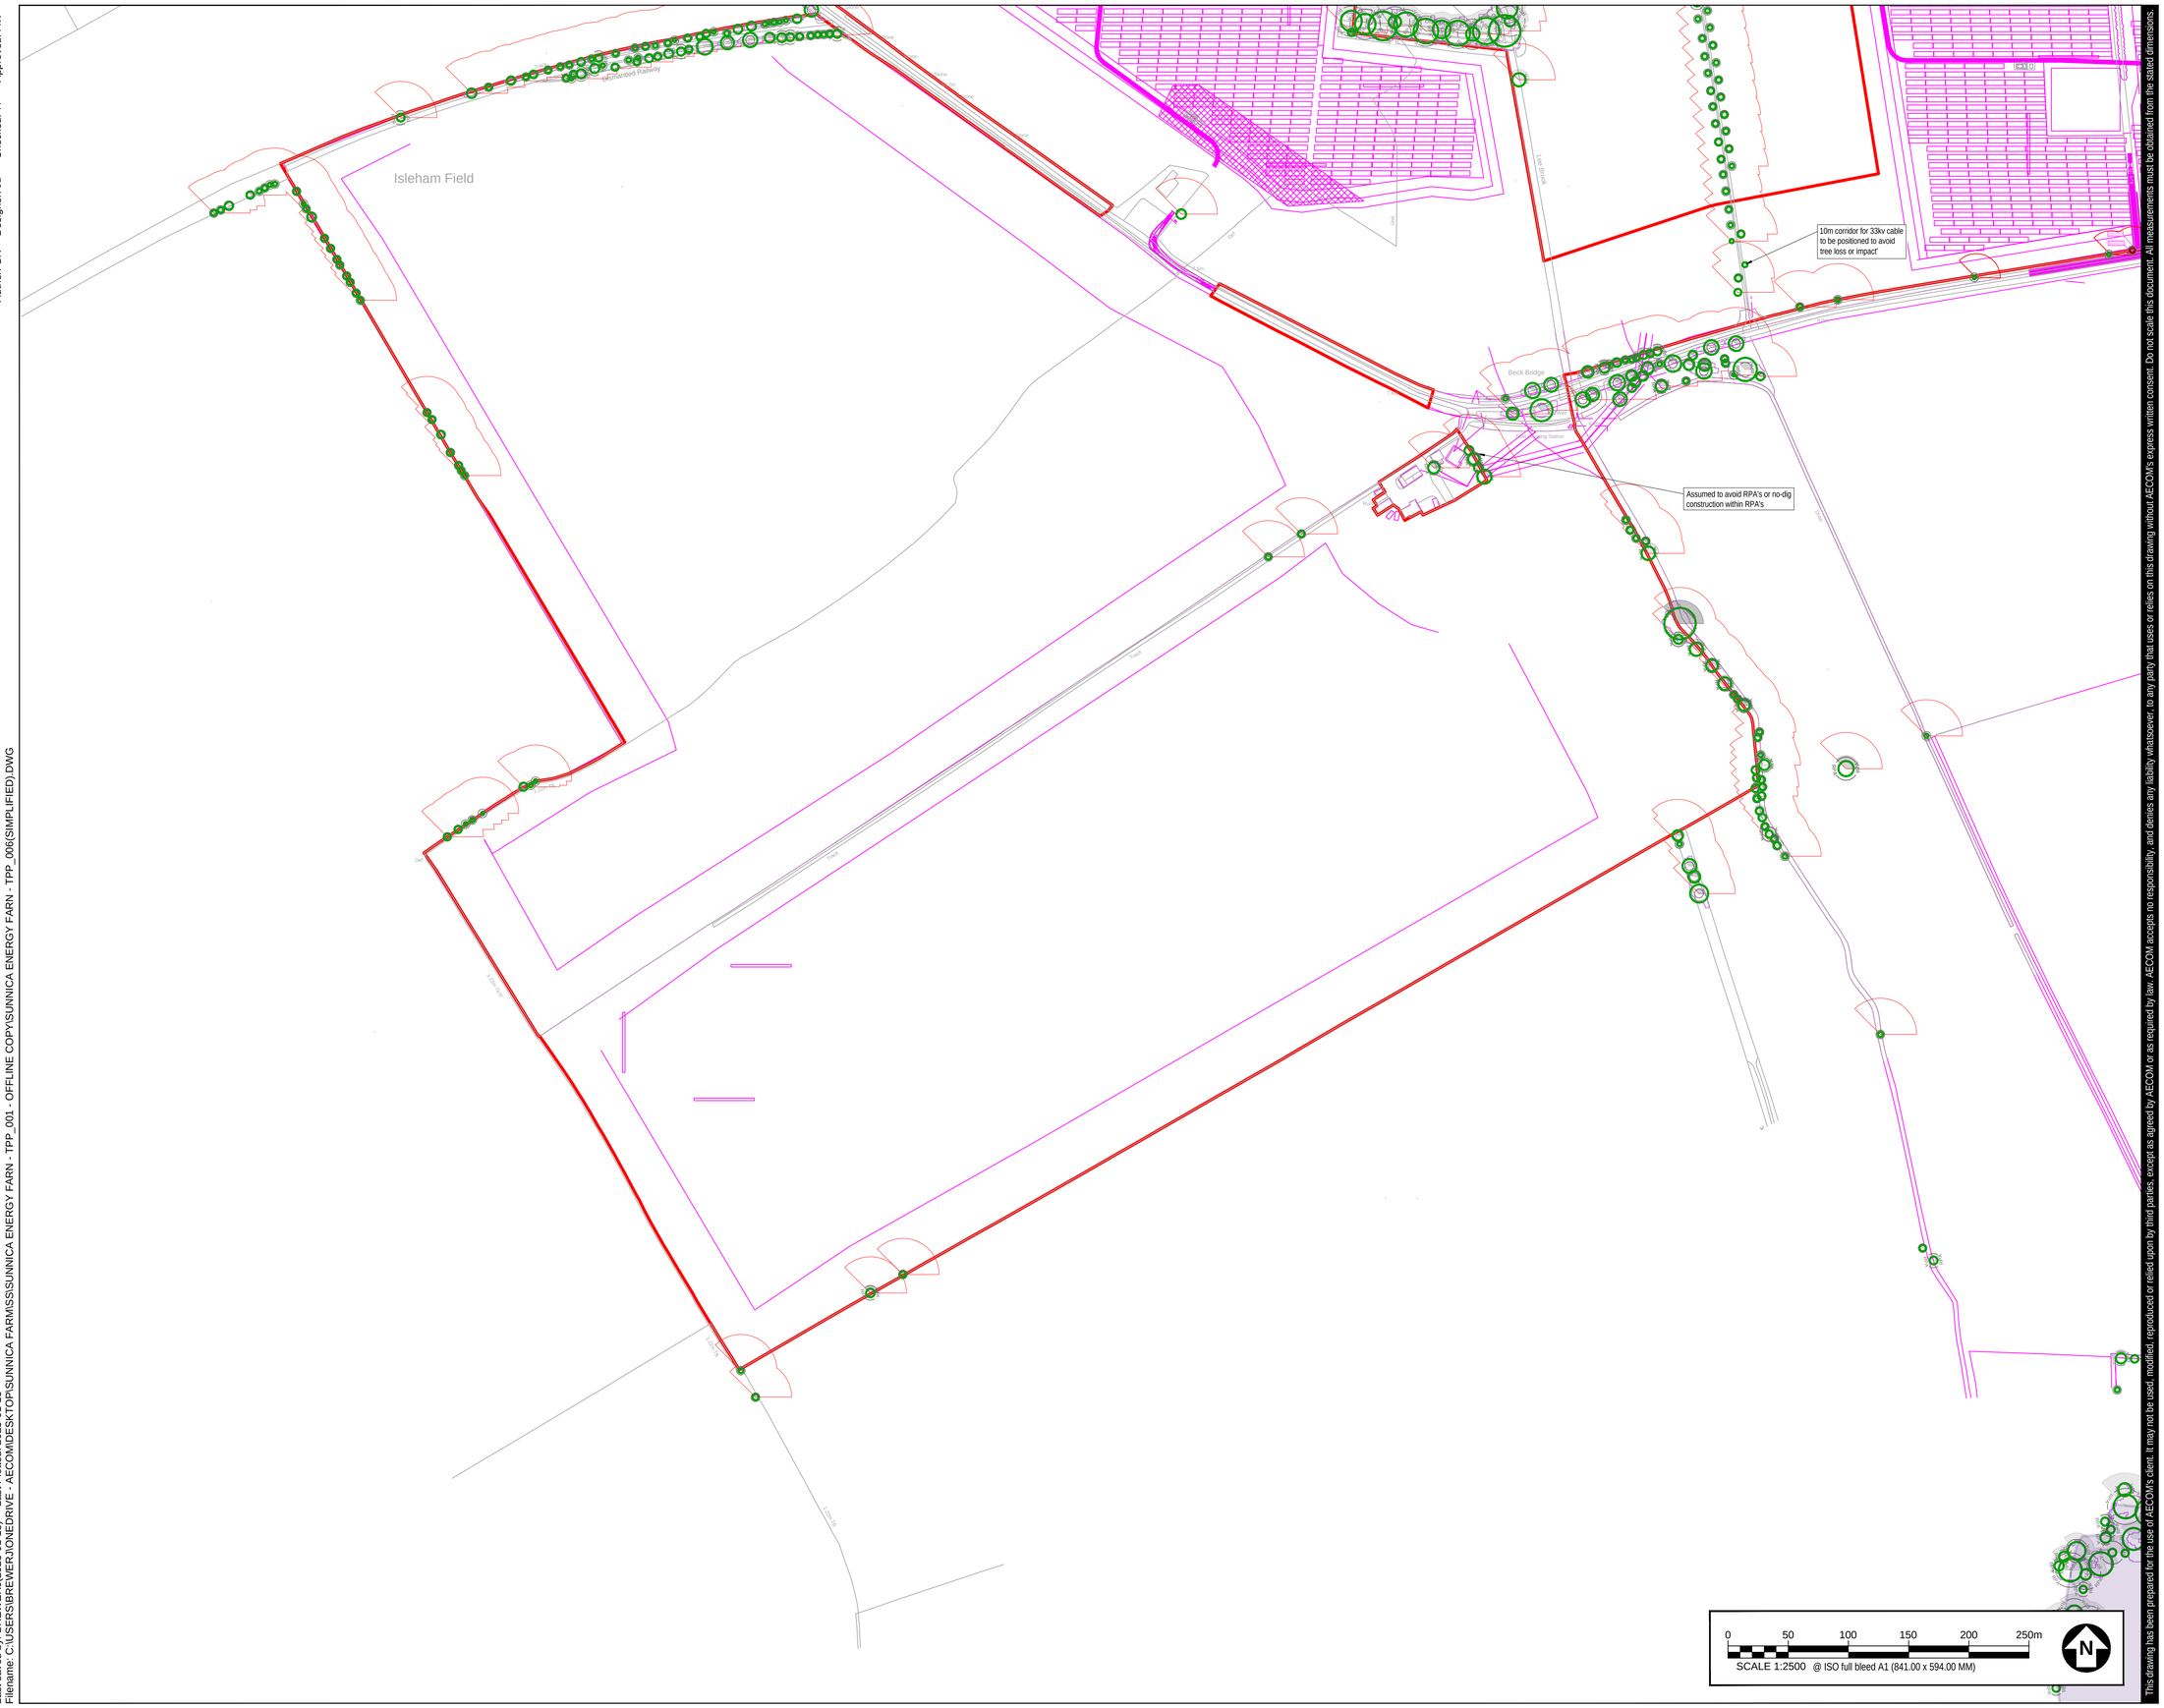

This drawing has been prepared for the use of AECOM's client. It may not be used, modified, reproduced or relied upon by third parties, except as agreed by AECOM or as required by law. AECOM accepts no responsibility, and denies any liability whatsoever, to any party that uses or relies on this drawing without AECOM's express written consent. Do not scale this document. All measurements must be obtained from the stated dimensions.

AECOM

PROJECT

SUNNICA ENERGY FARM

CLIENT

SUNNICA ENERGY FARM

CONSULTANT

AECOM
Plumer House, Third Floor,
East Wing, Tailyour Road
Plymouth, PL6 5DH
Tel +44(0)1752 676700
Fax +44(0)870 238 6023
www.aecom.com

GENERAL NOTES

1. TREE CATEGORIES AS DEFINED BY BS 5837:2012
2. TREE LOCATIONS ARE BASED ON THE TOPOGRAPHICAL SURVEY, AERIAL IMAGERY, AND GPS CO-ORDINATES FROM ON SITE WALKOVER.
3. * INDICATES A TREE / GROUP WHOSE POSITION IS APPROXIMATE AS BASED UPON AERIAL PHOTOGRAPHY AND ON SITE OBSERVATIONS.
4. PLANS SHOULD BE READ IN CONJUNCTION WITH THE AECOM ARBORICULTURAL REPORT.
5. THE ORIGINAL OF THIS DRAWING WAS PRODUCED IN COLOUR - A MONOCHROME COPY SHOULD NOT BE RELIED UPON.
6. DRAWING REFERNCES:
   - xref_topo.dwg
   - TPO.dwg
   - xref_cstastro.dwg
   - MERGED NTM DATA Rev8 Modified (TPP EDITS).dwg
   - Additional data.dwg
   - Shading Arc Combined.dwg
   - Shading Arc (centr cable).dwg
   - 20230105_Sunnica_WSP_RLB.dwg
   - 210309_blank_ _v4 (Modified - West Site B Removed).dwg

KEY PLAN

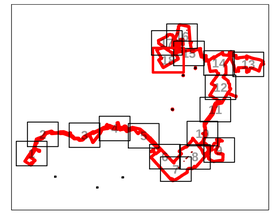

KEY

- **ORDER LIMITS BOUNDARY**
- **EXISTING TREE, GROUP, WOODLAND, OR HEDGE TO BE RETAINED** *(TREE TAGS INDICATE TREES SUBJECT TO DETAILED SURVEY, NO TREE TAG INDICATES TREES BASED ON NTM/DESK STUDY)*
- **EXISTING TREE, GROUP, WOODLAND, OR HEDGE TO BE REMOVED** *(TREE TAGS INDICATE TREES SUBJECT TO DETAILED SURVEY, NO TREE TAG INDICATES TREES BASED ON NTM/DESK STUDY)*
- **ROOT PROTECTION AREAS (RPA)** *(AS DEFINED BY BS 5837:2012 FOR TREES SUBJECT TO DETAILED SURVEY. ESTIMATED BUFFER ZONE SHOWN INDICATIVELY FOR OTHER TREES)*
- **APPROXIMATE SHADING ARC** *(W/ PREDICTED MAXIMUM GROWTH HEIGHT OUTLINE)*
- **VETERAN/ANCIENT TREE** *(IDENTIFIED BY DETAILED SURVEY)*
- **VETERAN/ANCIENT TREE** *(IDENTIFIED BY WALKOVER/DESK STUDY)*
- **PROPOSED DEVELOPMENT LAYOUT** *(BASED UPON DRAWING REFERENCES LISTED IN THE GENERAL NOTES SECTION)*
- **CONSTRUCTION WORKING ZONE** *(MANAGED CONSTRUCTION PROCESSES PERMITTED IN ACCORDANCE WITH THE PRINCIPLES SET OUT WITHIN THE ARBORICULTURAL IMPACT ASSESSMENT)*
- **TREE PRESERVATION ORDER** *(AREA COVERED BY A TREE PRESERVATION ORDER [TPO])*
- **CONSERVATION AREA** *(AREA COVERED BY A TREE PRESERVATION ORDER [TPO])*
- **PROPOSED CABLE ROUTE**

ISSUE/REVISION

P01	13/01/23	SECOND ISSUE
00	22/11/22	FIRST ISSUE
I/R	DATE	DESCRIPTION

DRAWING STATUS

SUBMITTED AT DEADLINE 5

PROJECT NUMBER

60589004

SHEET TITLE

TREE PROTECTION & REMOVAL PLAN (SHEET 18)

SHEET NUMBER 60589004-ACM-XX-XX-AB-TPP-018

REV. P01

Last saved by: BREWERJ (2023-01-13) Last Plotted: 2023-01-13
Filename: C:\USERS\BREWERJ\ONEDRIVE - AECOM\DESKTOP\SUNNICA FARM\SS\SUNNICA ENERGY FARN - TPP_001 - OFFLINE COPY\SUNNICA ENERGY FARN - TPP_006(SIMPLIFIED).DWG

Author: GR Designer: JB Checked: TF Approved: AW

B1103 Newmarket Road / B1102 Isaacson Road Junction (Scale 1:500)

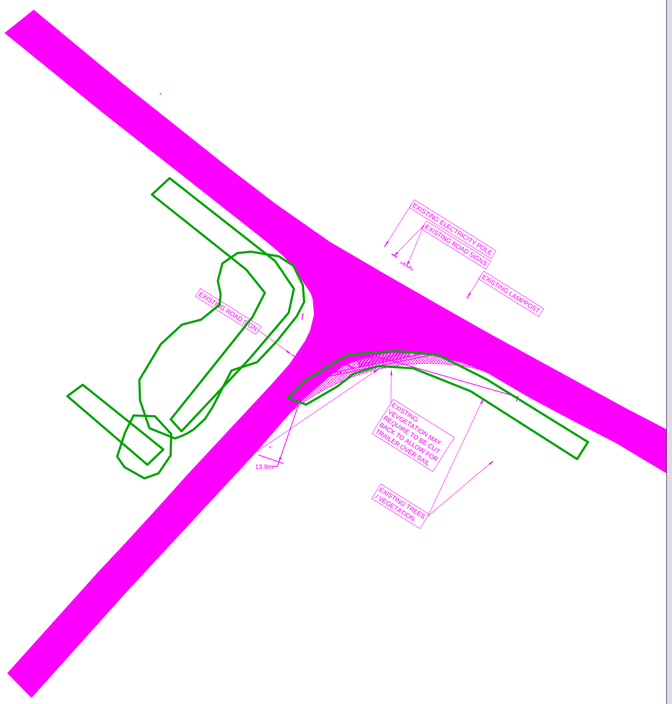

B1103 Swan Lane / Oxford Street Junction (Scale 1:500)

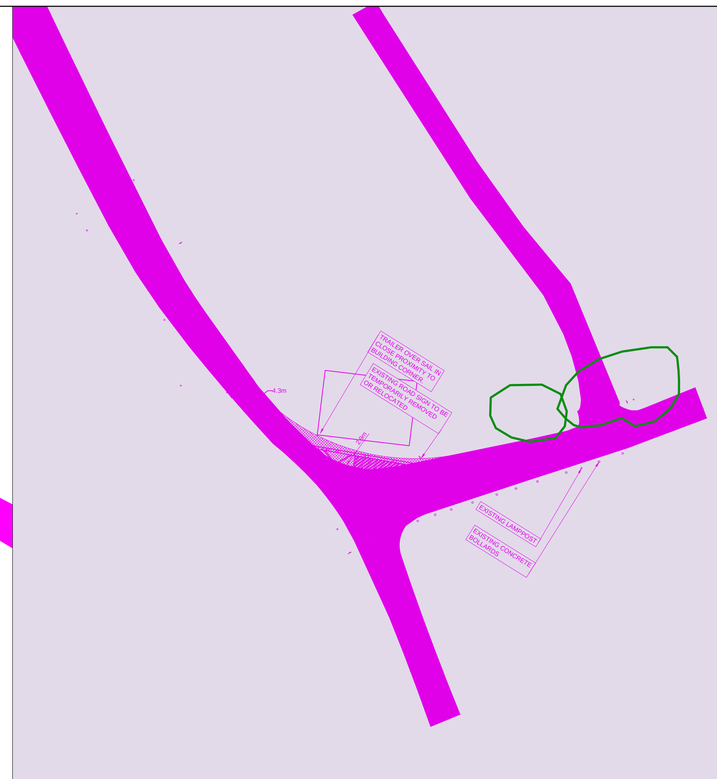

A142 Fordham Road / Windmill Road Junction (Scale 1:500)

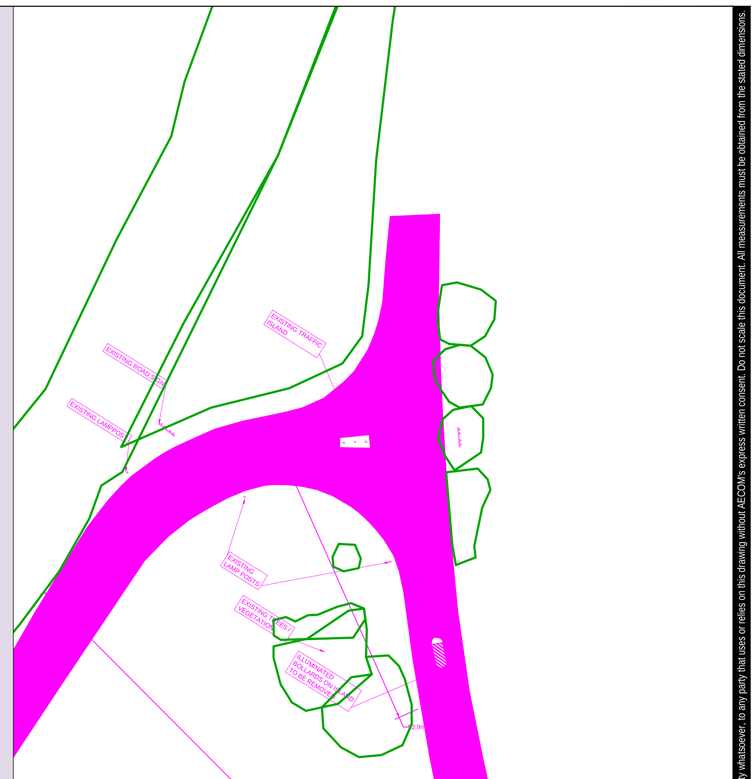

B1104 / Chippenham road junction (Scale 1:500)

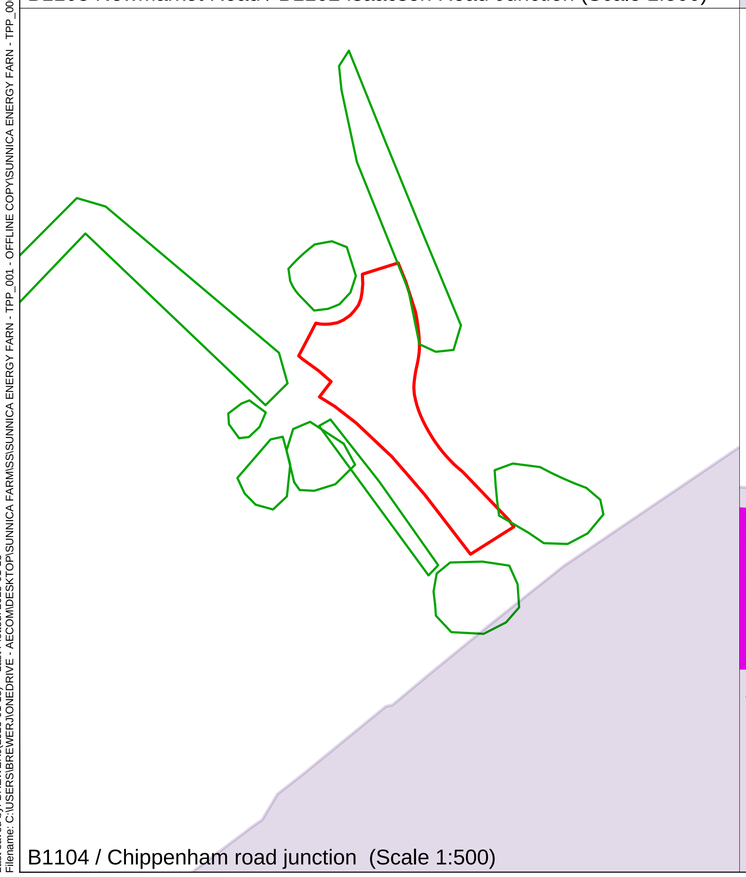

B1102 The Street / Mildenhall Road Junction (Scale 1:500)

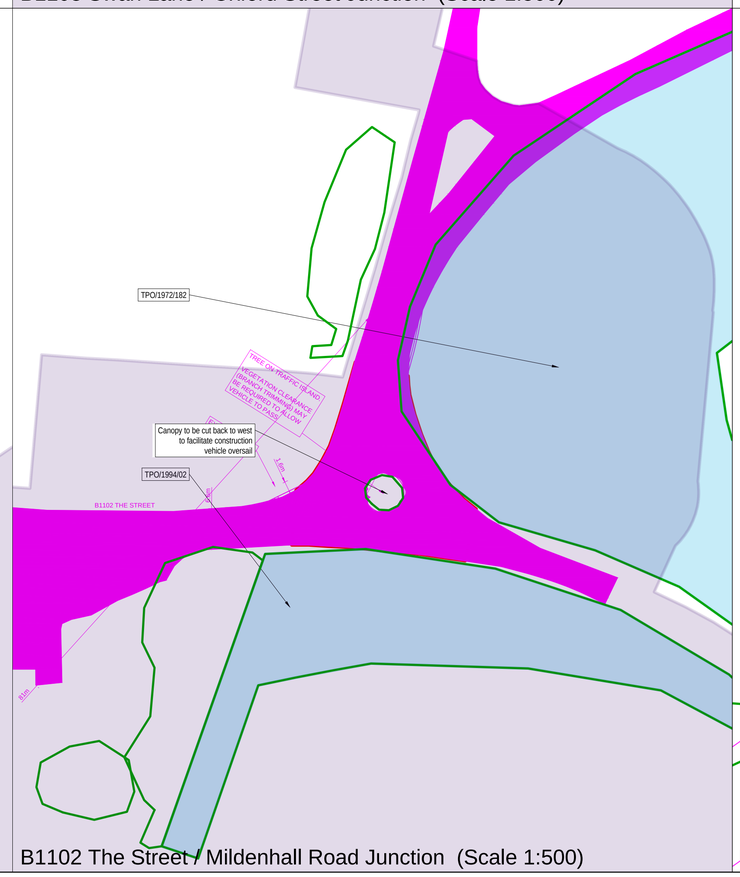


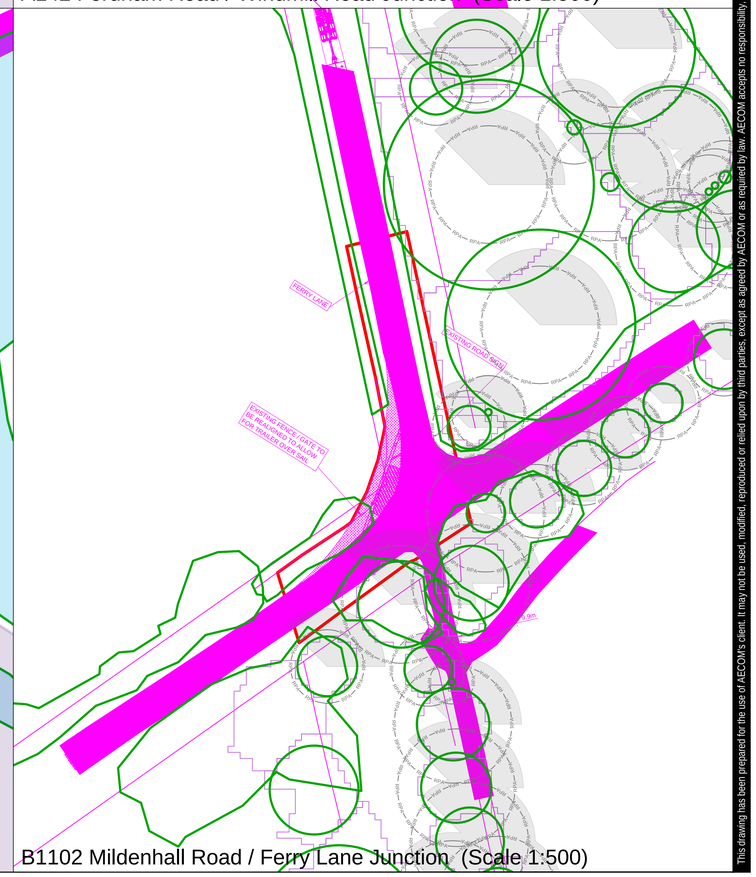

This drawing has been prepared for the use of AECOM's client. It may not be used, modified, reproduced or relied upon by third parties, except as agreed by AECOM or as required by law. AECOM accepts no responsibility, and denies any liability whatsoever, to any party that uses or relies on this drawing without AECOM's express written consent. Do not scale this document. All measurements must be obtained from the stated dimensions.

AECOM

PROJECT

SUNNICA ENERGY FARM

CLIENT

SUNNICA ENERGY FARM

CONSULTANT

AECOM
Plumer House, Third Floor,
East Wing, Tailyour Road
Plymouth, PL6 5DH
Tel +44(0)1752 676700
Fax +44(0)870 238 6023
www.aecom.com

GENERAL NOTES

1. TREE CATEGORIES AS DEFINED BY BS 5837:2012
2. TREE LOCATIONS ARE BASED ON THE TOPOGRAPHICAL SURVEY, AERIAL IMAGERY, AND GPS CO-ORDINATES FROM ON SITE WALKOVER.
3. * INDICATES A TREE / GROUP WHOSE POSITION IS APPROXIMATE AS BASED UPON AERIAL PHOTOGRAPHY AND ON SITE OBSERVATIONS.
4. PLANS SHOULD BE READ IN CONJUNCTION WITH THE AECOM ARBORICULTURAL REPORT.
5. THE ORIGINAL OF THIS DRAWING WAS PRODUCED IN COLOUR - A MONOCHROME COPY SHOULD NOT BE RELIED UPON.
6. DRAWING REFERNCES:
   - xref_topo.dwg
   - TPO.dwg
   - xref_cstatnto.dwg
   - MERGED NTM DATA Rev8 Modified (TPP EDITS).dwg
   - Additional data.dwg
   - Shading Arc (Combined).dwg
   - Shading Arc (worst case).dwg
   - 20230505_Sunnica_WSP_RLB.dwg
   - 210309_blank_v4 (Modified - West Site B Removed).dwg

KEY PLAN

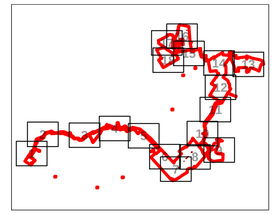

KEY

- **ORDER LIMITS BOUNDARY**
- **EXISTING TREE, GROUP, WOODLAND, OR HEDGE TO BE RETAINED** *(TREE TAGS INDICATE TREES SUBJECT TO DETAILED SURVEY, NO TREE TAG INDICATES TREES BASED ON NTM/DESK STUDY)*
- **EXISTING TREE, GROUP, WOODLAND, OR HEDGE TO BE REMOVED** *(TREE TAGS INDICATE TREES SUBJECT TO DETAILED SURVEY, NO TREE TAG INDICATES TREES BASED ON NTM/DESK STUDY)*
- **ROOT PROTECTION AREAS (RPA)** *(AS DEFINED BY BS 5837:2012 FOR TREES SUBJECT TO DETAILED SURVEY. ESTIMATED BUFFER ZONE SHOWN INDICATIVELY FOR OTHER TREES)*
- **APPROXIMATE SHADING ARC** *(WI PREDICTED MAXIMUM GROWTH HEIGHT OUTLINE)*
- **VETERAN/ANCIENT TREE** *(IDENTIFIED BY DETAILED SURVEY)*
- **VETERAN/ANCIENT TREE** *(IDENTIFIED BY WALKOVER/DESK STUDY)*
- **PROPOSED DEVELOPMENT LAYOUT** *(BASED UPON DRAWING REFERENCES LISTED IN THE GENERAL NOTES SECTION)*
- **CONSTRUCTION WORKING ZONE** *(MANAGED CONSTRUCTION PROCESSES PERMITTED IN ACCORDANCE WITH THE PRINCIPLES SET OUT WITHIN THE ARBORICULTURAL IMPACT ASSESSMENT)*
- **TREE PRESERVATION ORDER** *(AREA COVERED BY A TREE PRESERVATION ORDER [TPO])*
- **CONSERVATION AREA** *(AREA COVERED BY A TREE PRESERVATION ORDER [TPO])*
- **PROPOSED CABLE ROUTE**

ISSUE/REVISION

I/R	DATE	DESCRIPTION
P01	13/01/23	SECOND ISSUE
00	22/11/22	FIRST ISSUE

DRAWING STATUS

SUBMITTED AT DEADLINE 5

PROJECT NUMBER

60589004

SHEET TITLE

TREE PROTECTION & REMOVAL PLAN (SHEET 19)

SHEET NUMBER 60589004-ACM-XX-XX-AB-TPP-019

REV. P01

Last saved by: BREWERJ(2023-01-13) Last Plotted: 2023-01-13
Filename: C:\USERS\BREWERJ\ONEDRIVE - AECOM\DESKTOP\SUNNICA FARM\SS\SUNNICA ENERGY FARN - TPP_001 - OFFLINE COPY\SUNNICA ENERGY FARN - TPP_006(SIMPLIFIED).DWG