



BEACON FEN

ENERGY PARK

Planning Inspectorate Reference: EN010151

Bicker Fen Substation sectional drawings (Change Request)

Document Reference: 2.28

December 2025



Quality information

Prepared by	Checked by	Verified by	Approved by
SKYRAY	EZA	ABO	GDA




Spatial Reference System
British National Grid

Drawing Title

Notes

1. DO NOT SCALE FROM THIS DRAWING. USE ONLY PRINTED DIMENSIONS
2. THIS DRAWING IS TO BE READ IN CONJUNCTION WITH ALL OTHER RELEVANT DOCUMENTATION.
3. ALL DIMENSIONS, CHANGES, LEVELS AND COORDINATES ARE IN MILLIMETERS UNLESS DEFINED OTHERWISE.
4. THE DRAWING IS THE COPYRIGHT OF BEACON FEN ENERGY PARK LIMITED AND CANNOT BE REPRODUCED IN ANY FORM WITHOUT THE EXPRESS CONSENT OF THE COMPANY. WRITTEN AND SCALED DIMENSIONS TO BE CHECKED ON SITE, AND ANY DISCREPANCIES SHOULD BE REPORTED TO SKYRAY prior TO WORK COMMENCING ON SITE.
5. THIS DRAWING IS ONLY INDICATIVE AND SHOULD NOT BE USED FOR CONSTRUCTION.
6. AS BUILT DIMENSIONS PROVIDED BY NGET AND ARE APPROXIMATE AND BASED ON CONTEMPORARY DRAWINGS

CB	-	CIRCUIT BREAKER
CSE	-	CABLE SEALING END
CT	-	CURRENT TRANSFORMER
CVT	-	CAPACITIVE VOLTAGE TRANSFORMER
DISC	-	DISCONNECT
SA	-	SURGE ARRESTOR
		400kV BUSBAR
		400kV CABLE
		PROPOSED CHANGE INFRASTRUCTURE
		PROPOSED SUBSTATION EXTENSION
		EXISTING EQUIPMENT

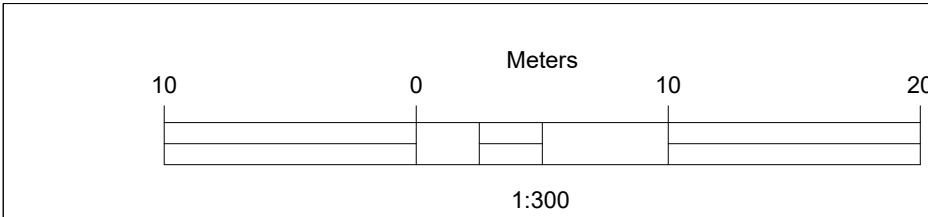

47 Rue Maurice Flandin,
69003 Lyon FRANCE
contact@skyrayengineering.com
<https://www.skyrayengineering.com>