

Green Hill Solar Farm

EN010170

Land Plan

Revision ~~A~~B (Tracked)

Prepared by: Bruton Knowles

Date: ~~July~~November 2025


Document Reference: ~~PEX~~EX1/GH2.2_~~AB~~

APFP Regulation 5(2)(i)



Schedule of Changes

Figure Reference	Page	Description of Changes	Reason for Revision
[cover]		Updated document reference to Revision B	As required for submission at Deadline 1.
All Sheets	3-21	Updated document references and annotations	As required for submission at Deadline 1.
Sheet 5 and 6	8-9	Plot 05-055 split into plots 05-055a and 05-055b.	To record changes to plot descriptions in Book of Reference.
Sheet 12 and 13	15-16	Plot 12-163 split into plots 12-163a and 12-163b.	To record changes to plot descriptions in Book of Reference.
Sheet 15	18	Extension of plots 14-194 and 15-200 to meet Order Limits.	Applicant's due diligence, correction of plotting error.

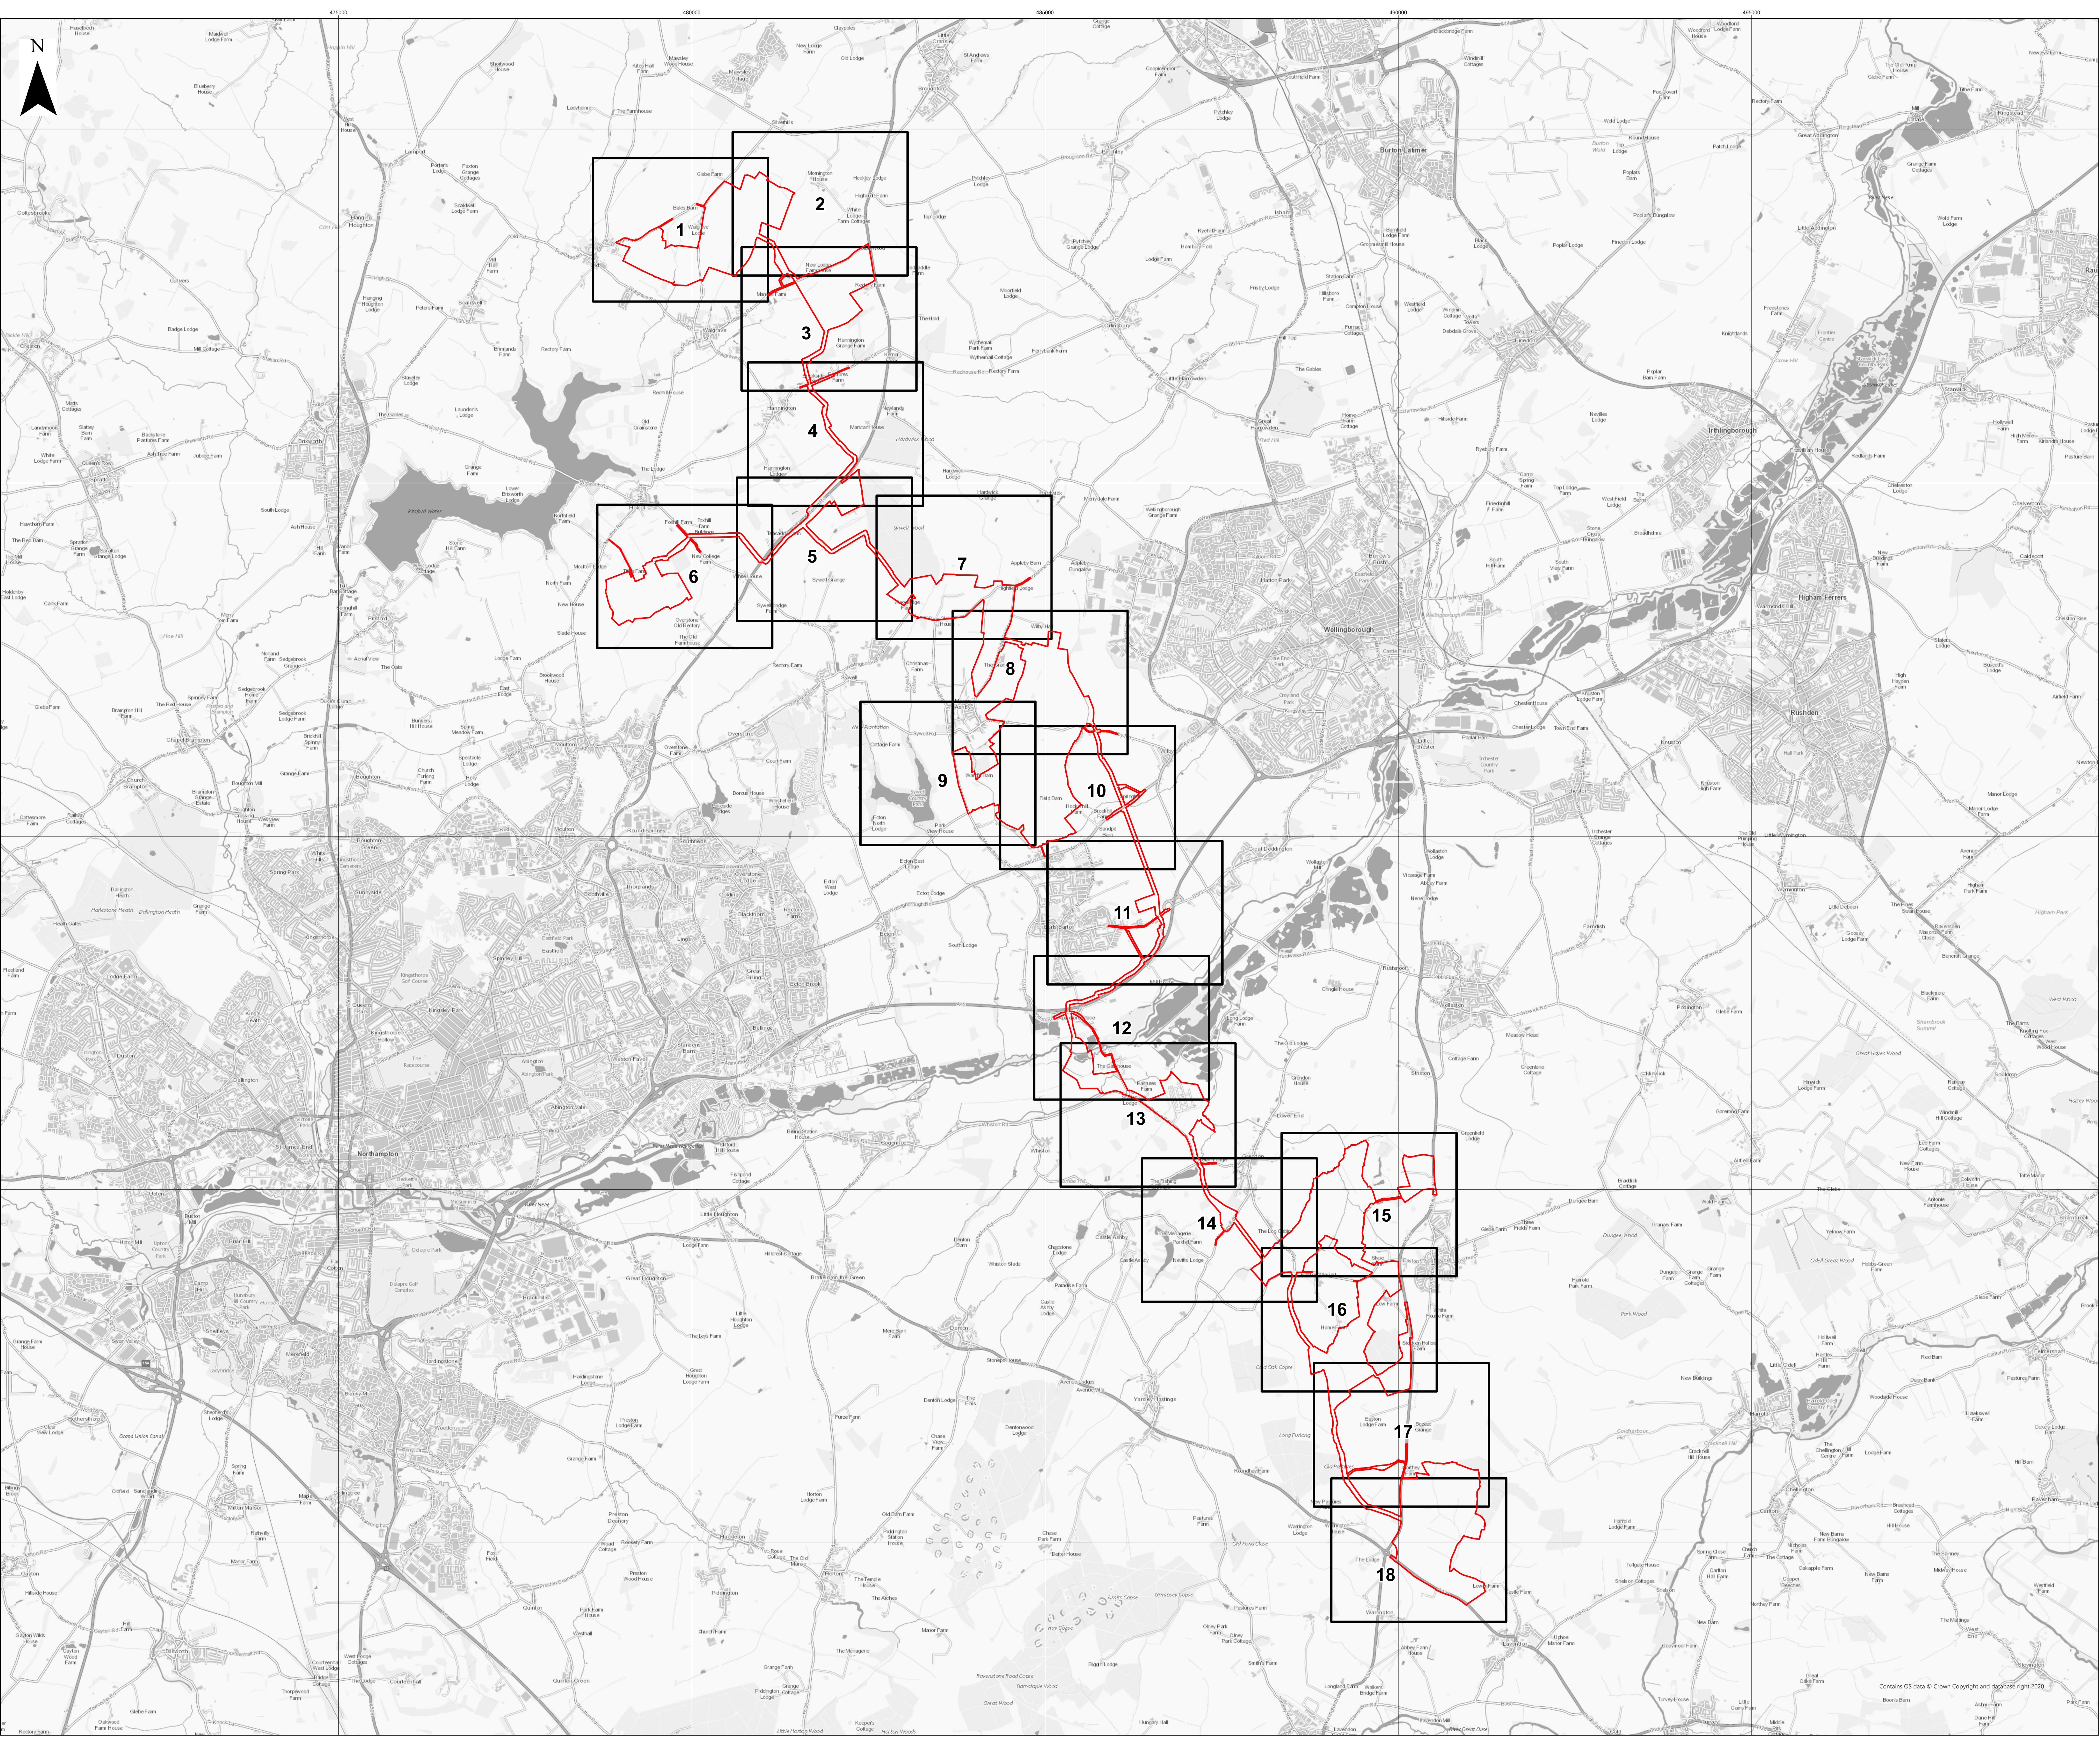

Key

 Sheet

 Order Limits

Base map: © Crown Copyright and database rights 2025 OS Licence no. AC000849896. All rights reserved.

010030400
Indicated
Metres


Scale: 1:30,000@A0

APFP Regulation: 5(2)(i)	Application Doc No. EX1/GH2.2_B
Ref: IGP_GH_DCO_Land_Plan	Date: 28/10/2025
Drawn by: DLG	Checked by: AT

Overview Land Plan
Revision B
Sheet 0



Contains OS data © Crown Copyright and database right 2020.

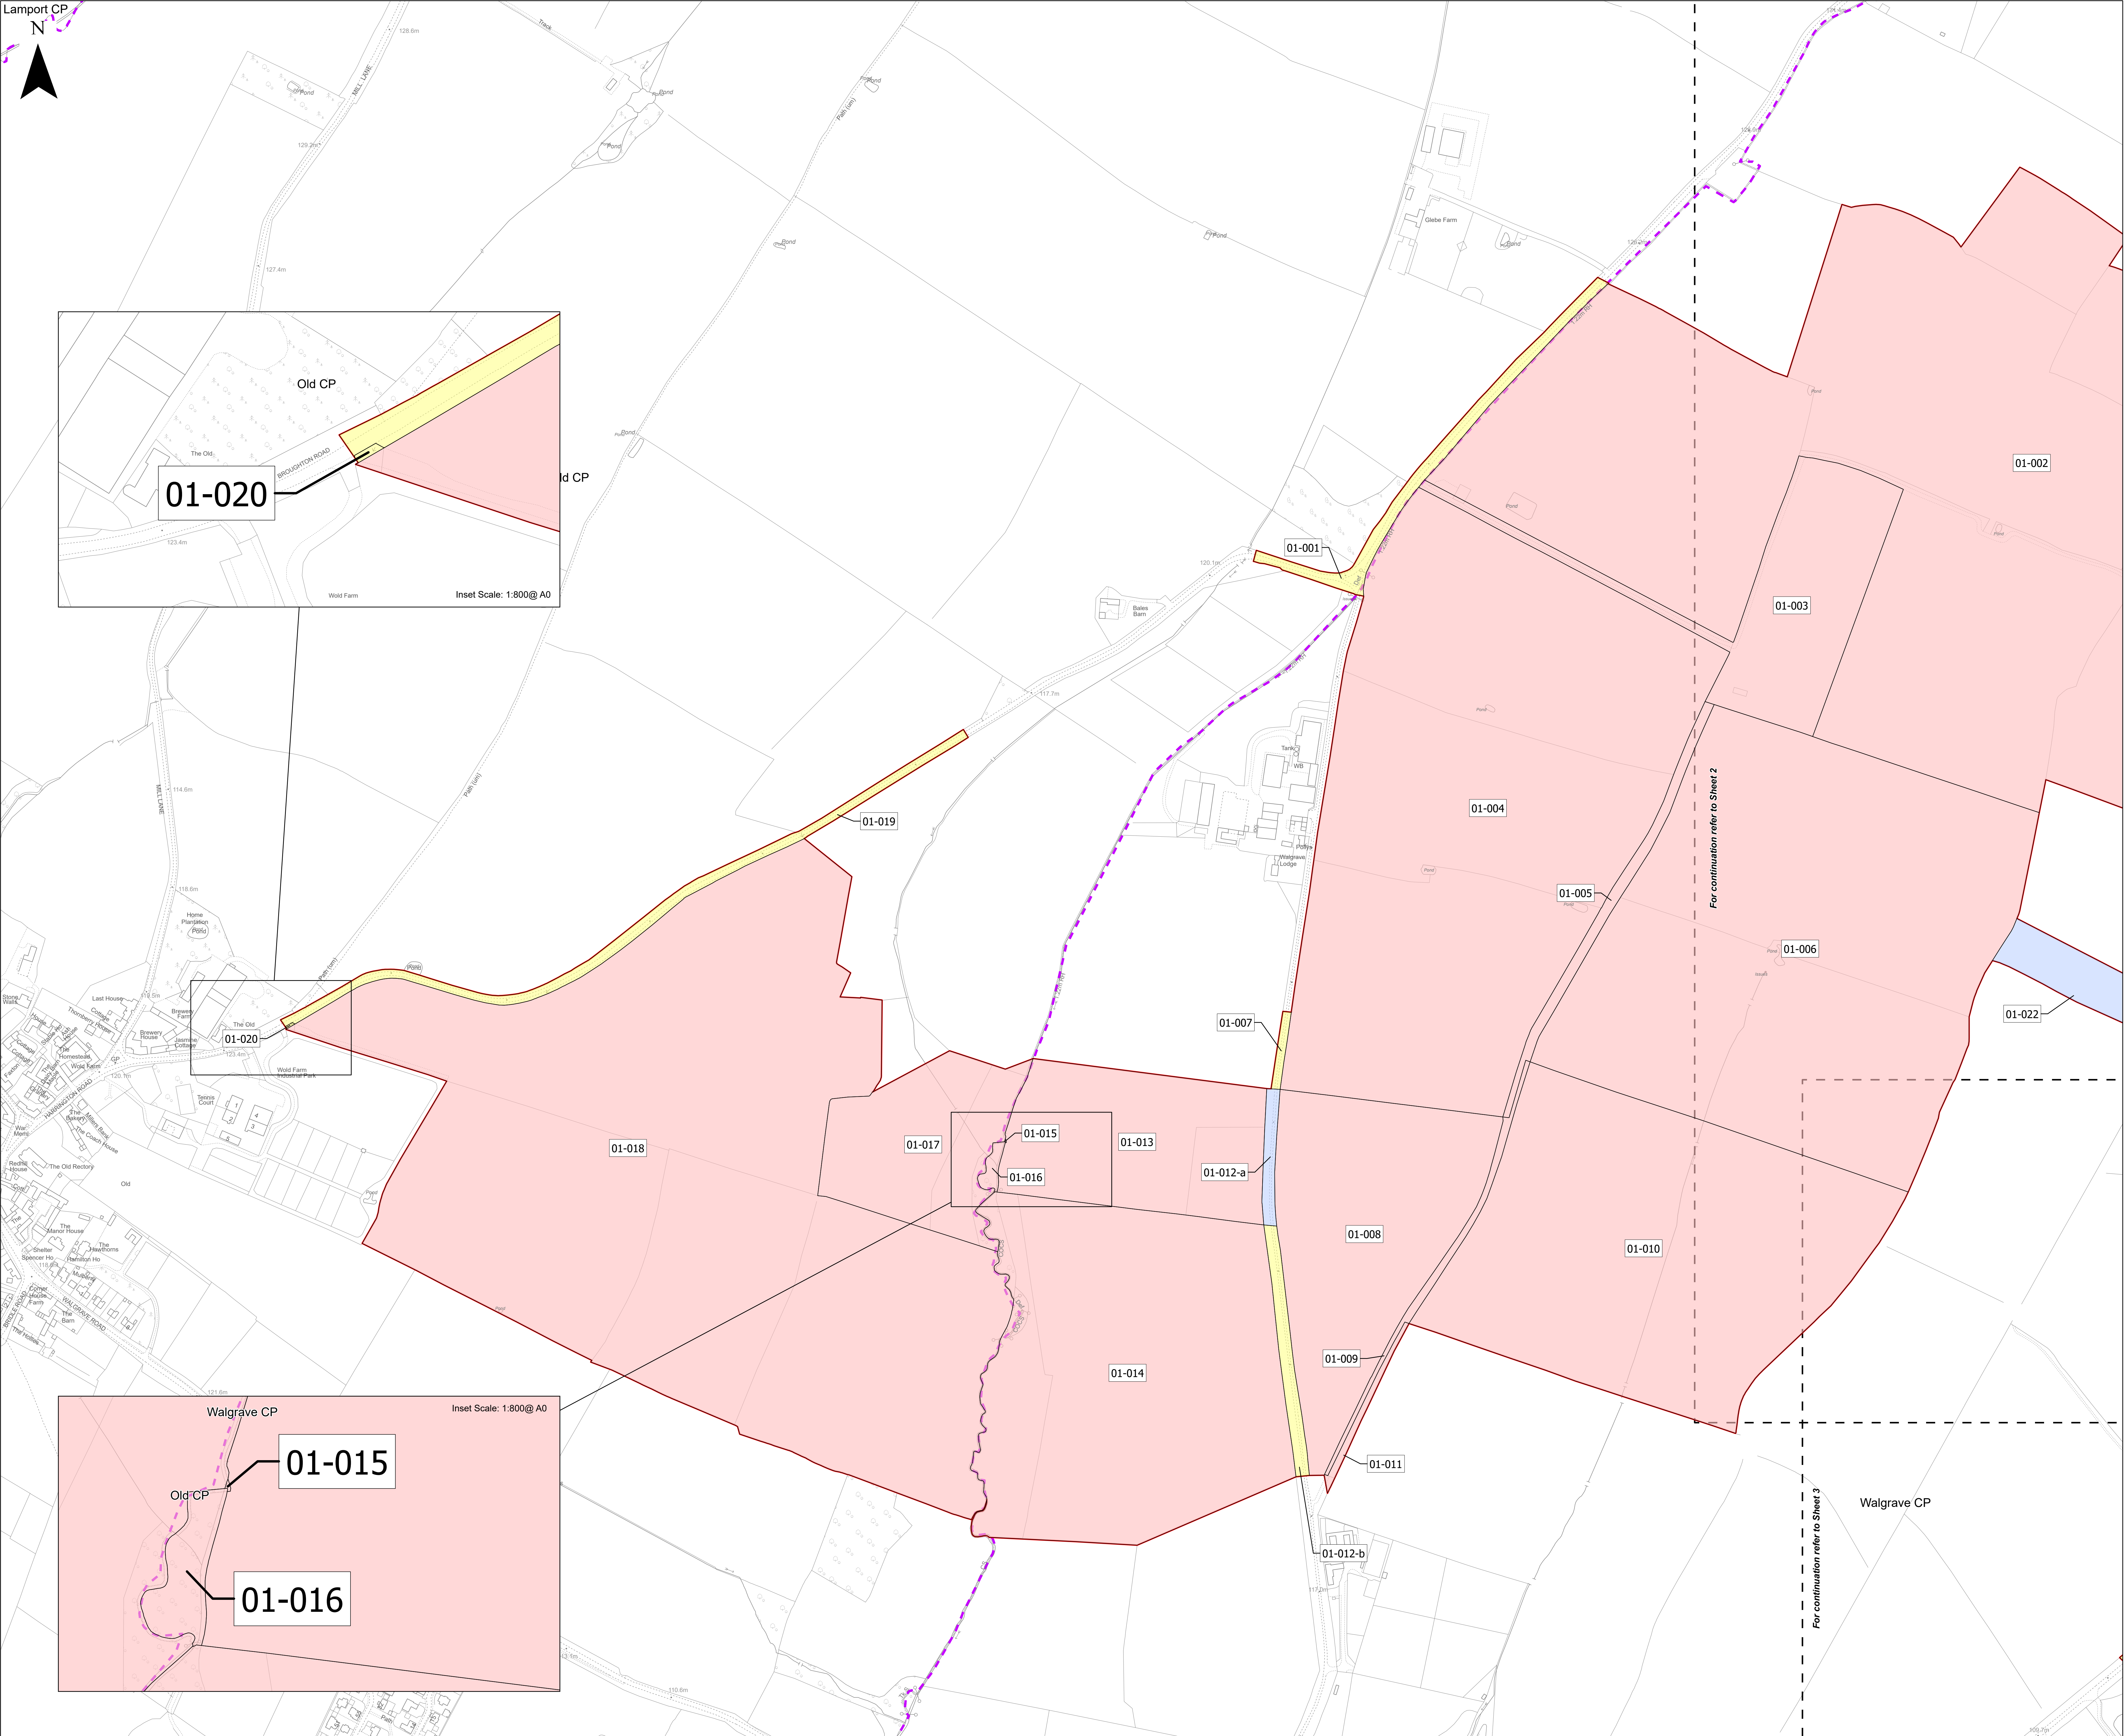



Key

- Order Limits
- Freehold to be compulsorily acquired and temporary use of land and in relation to which it is proposed that easements, servitudes and other private rights will cease to have effect
- Temporary use of land and in relation to which it is proposed to temporarily suspend easements, servitudes and other private rights
- New rights (including restrictions) to be compulsorily acquired and temporary use of land and in relation to which it is proposed that easements, servitudes and other private rights will be suspended or cease to have effect
- No Land Take
- Local Authority / Parish Boundary
- Cut Line

Base map: © Crown Copyright and database rights 2025 OS Licence no. AC0000849896. All rights reserved.


0 100 200 300 400 Metres

Scale: 1:2,500@ A0

APFP Regulation: 5(2)(i)	Application Doc No. EX1/GH2.2_B
Ref: IGP_GH_DCO_Land_Plan	Date: 28/10/2025
Drawn by: DLG	Checked by: AT


Land Plan
Revision B
Sheet 1 of 18



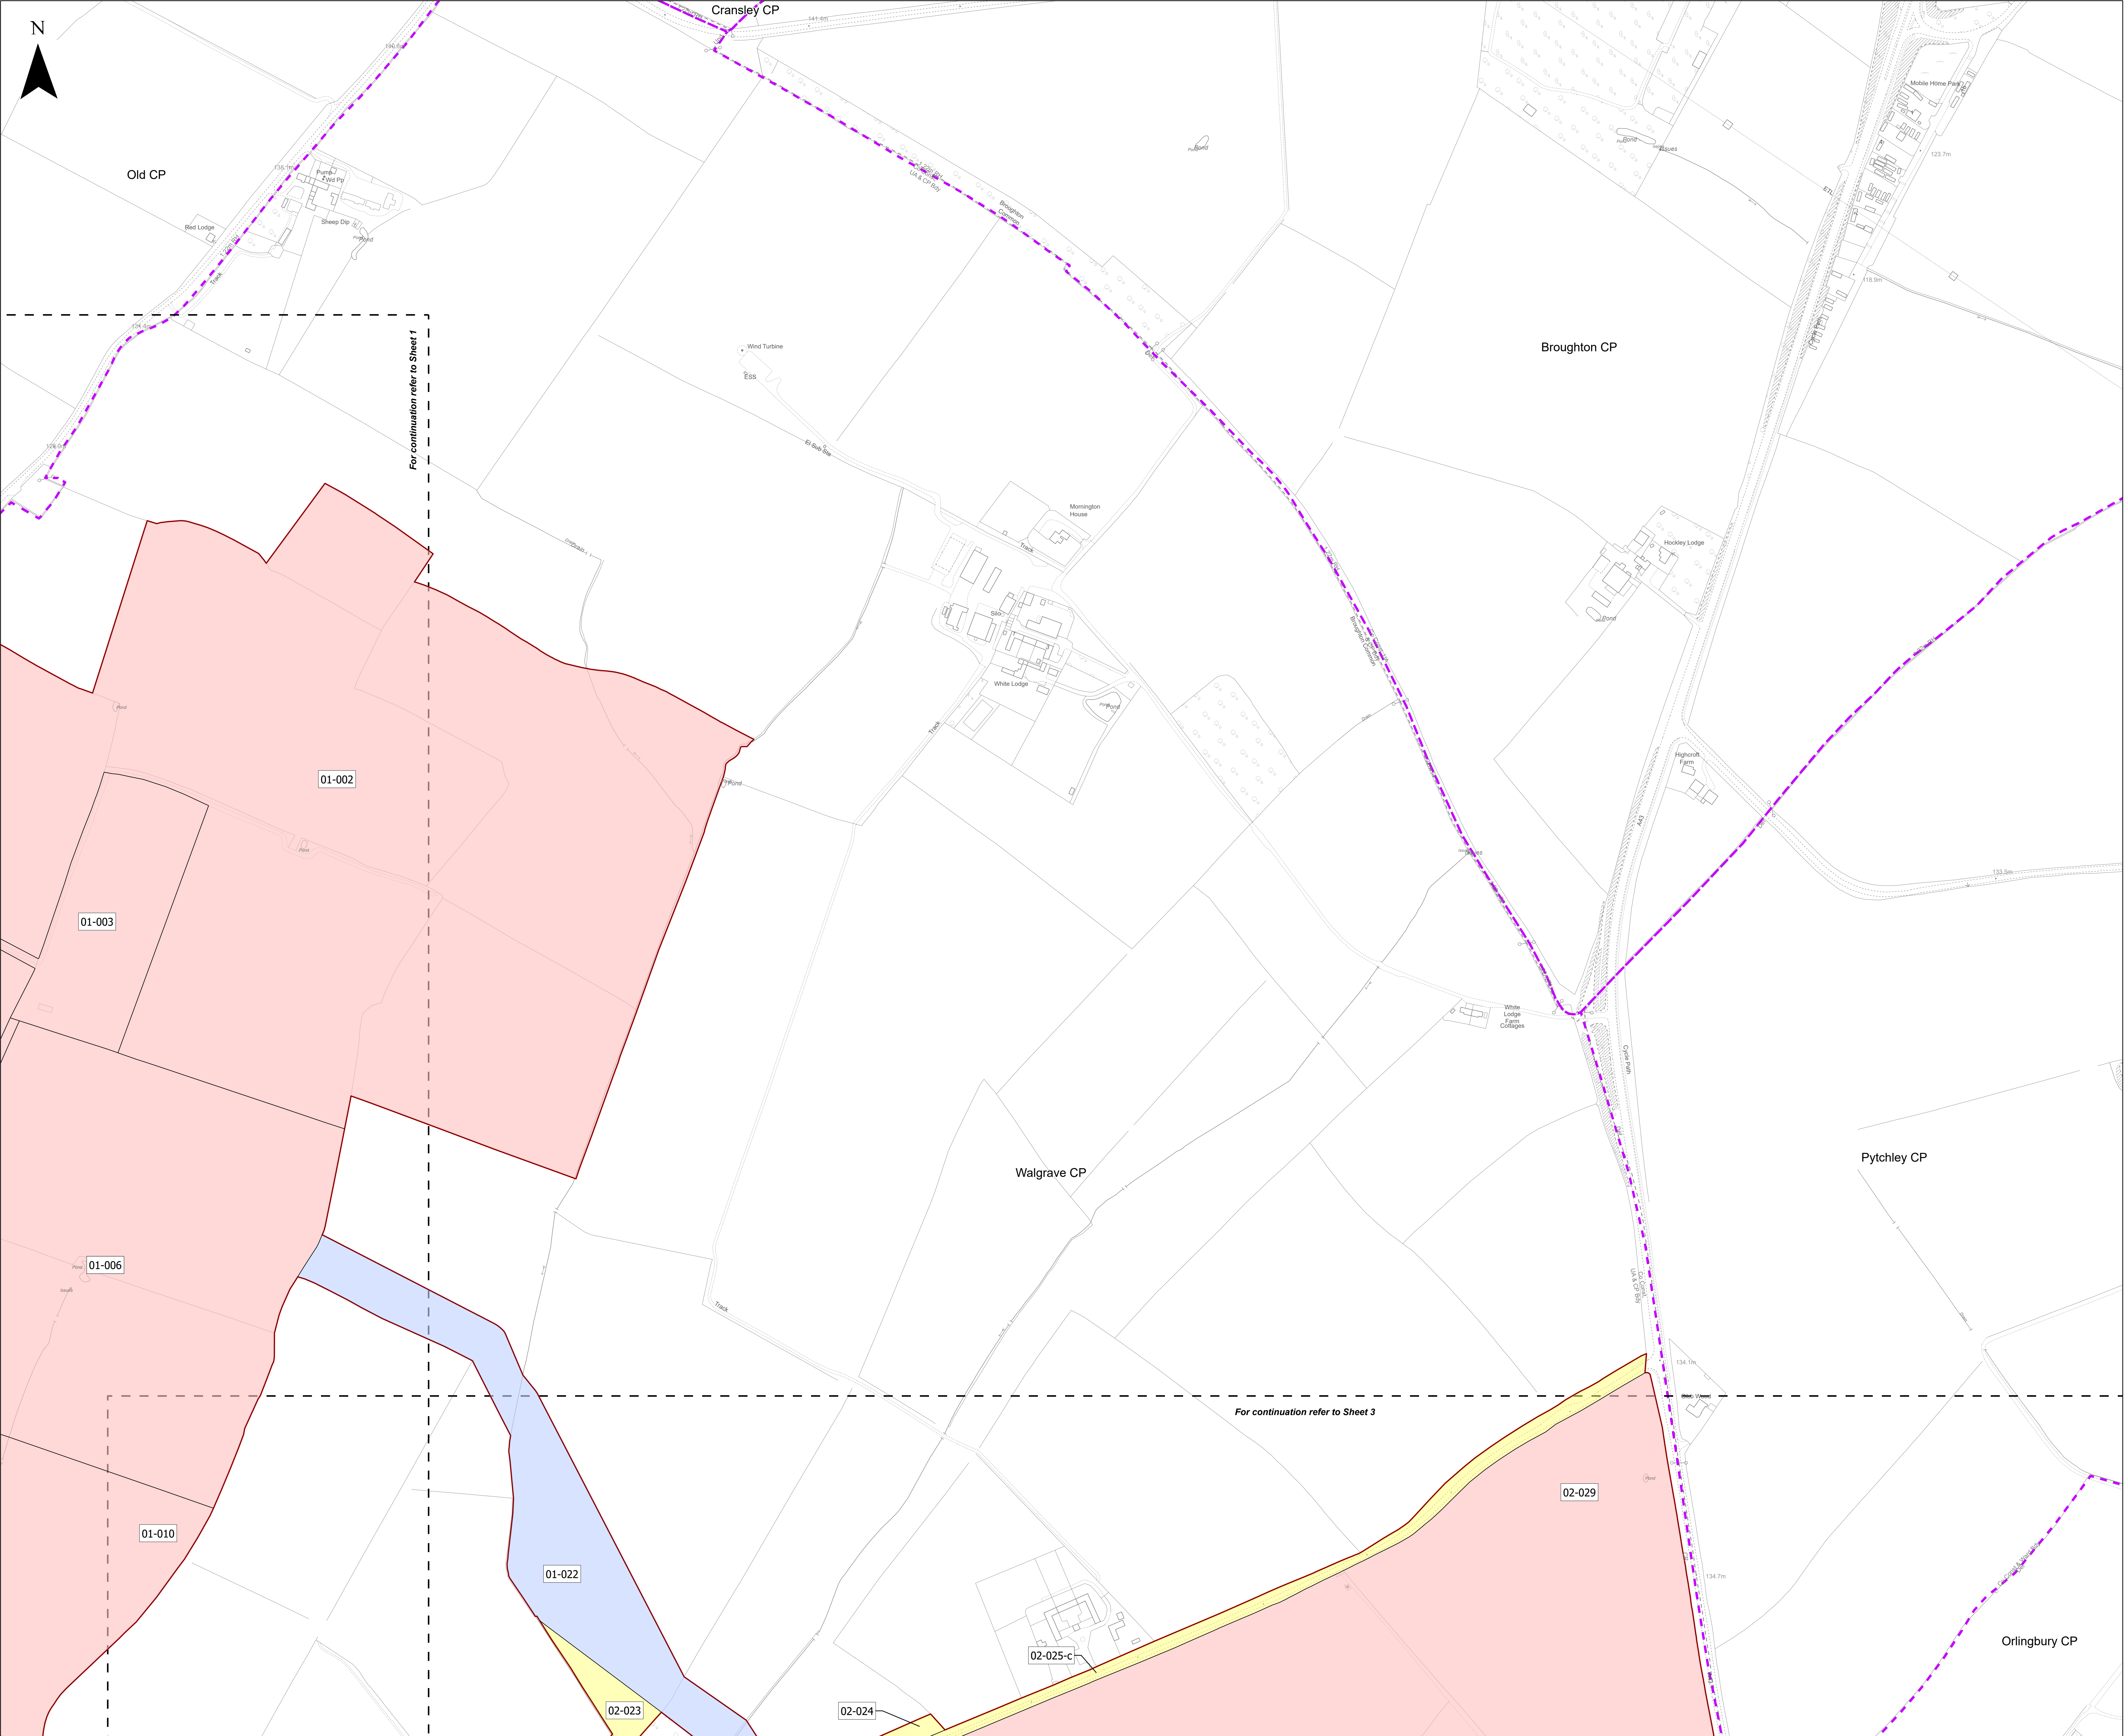

- Key**
- Order Limits
 - Freehold to be compulsorily acquired and temporary use of land and in relation to which it is proposed that easements, servitudes and other private rights will cease to have effect
 - Temporary use of land and in relation to which it is proposed to temporarily suspend easements, servitudes and other private rights
 - New rights (including restrictions) to be compulsorily acquired and temporary use of land and in relation to which it is proposed that easements, servitudes and other private rights will be suspended or cease to have effect
 - No Land Take
 - Local Authority / Parish Boundary
 - Cut Line

Base map: © Crown Copyright and database rights 2025 OS Licence no. AC0000849896. All rights reserved.

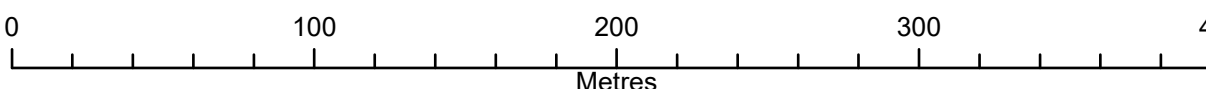


Scale: 1:2,500@ A0

APFP Regulation: 5(2)(i)	Application Doc No. EX1/GH2.2_B
Ref: IGP_GH_DCO_Land_Plan	Date: 28/10/2025
Drawn by: DLG	Checked by: AT

Land Plan
Revision B
Sheet 2 of 18



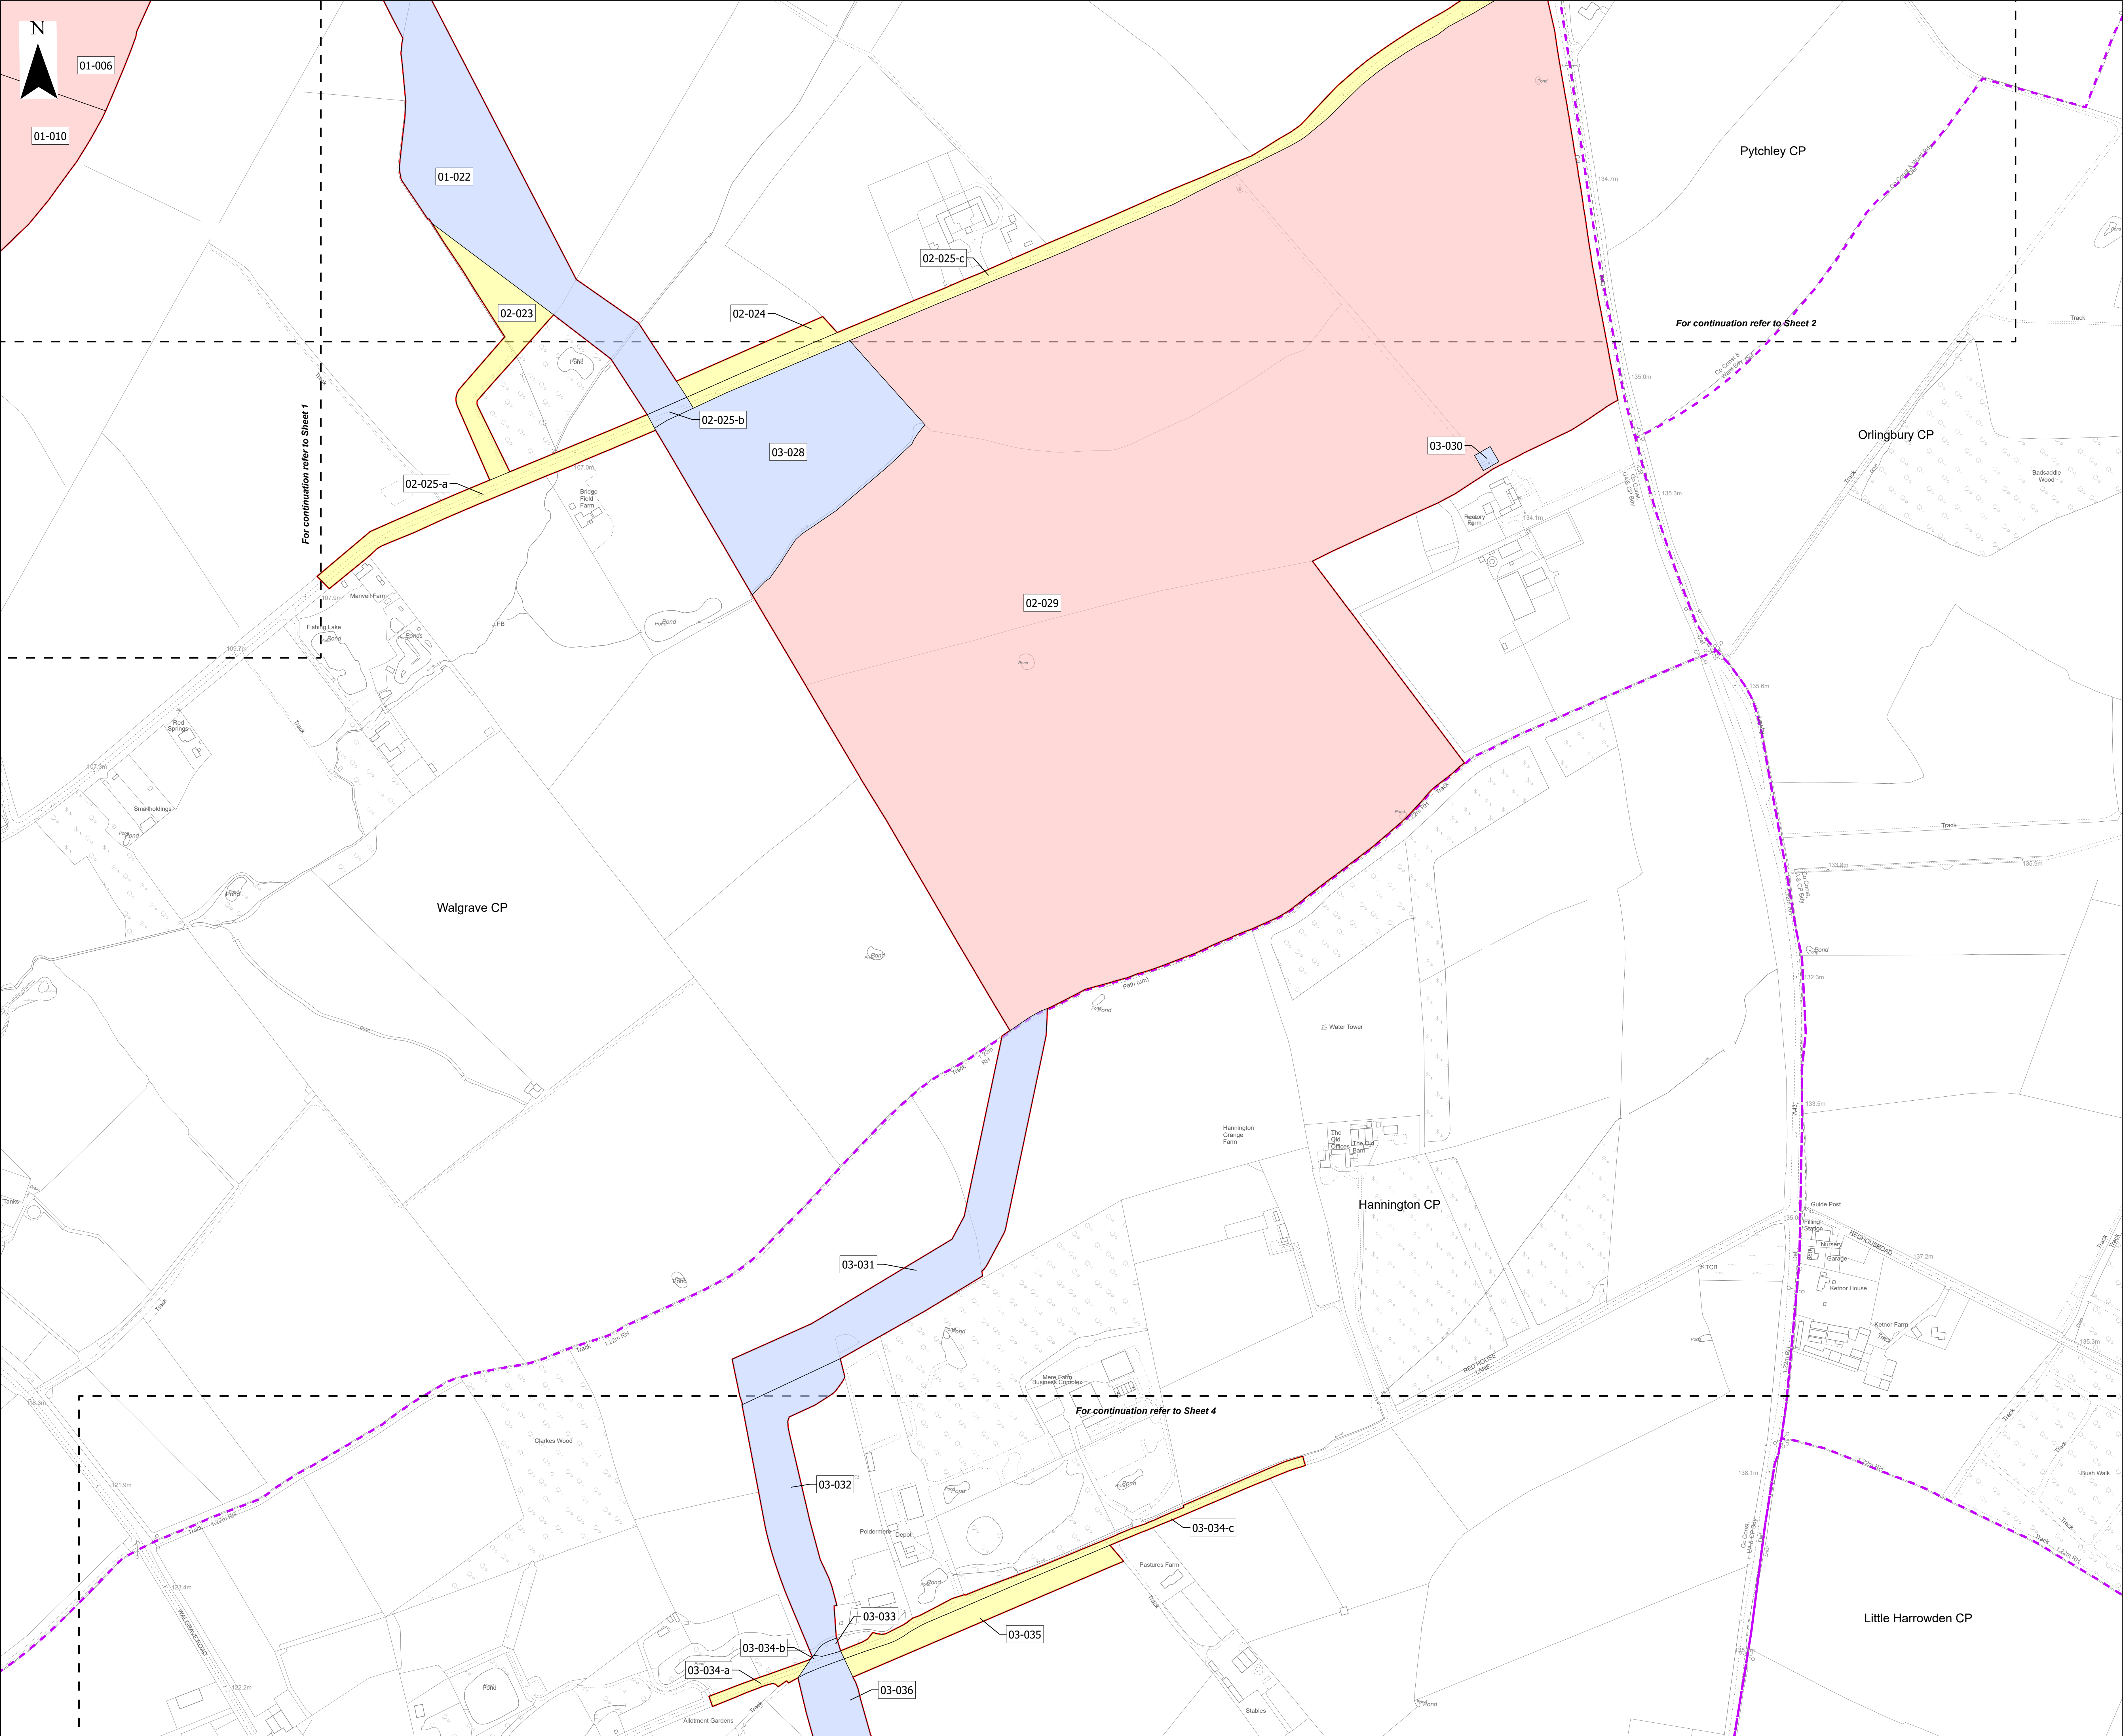

- Key**
- Order Limits
 - Freehold to be compulsorily acquired and temporary use of land and in relation to which it is proposed that easements, servitudes and other private rights will cease to have effect
 - Temporary use of land and in relation to which it is proposed to temporarily suspend easements, servitudes and other private rights
 - New rights (including restrictions) to be compulsorily acquired and temporary use of land and in relation to which it is proposed that easements, servitudes and other private rights will be suspended or cease to have effect
 - No Land Take
 - Local Authority / Parish Boundary
 - Cut Line

Base map: © Crown Copyright and database rights 2025 OS Licence no. AC000849896. All rights reserved.


0 100 200 300 400
Metres

Scale: 1:2,500@ A0


APFP Regulation: 5(2)(i)	Application Doc No. EX1/GH2.2_B
Ref: IGP_GH_DCO_Land_Plan	Date: 28/10/2025
Drawn by: DLG	Checked by: AT

Land Plan
Revision B
Sheet 3 of 18



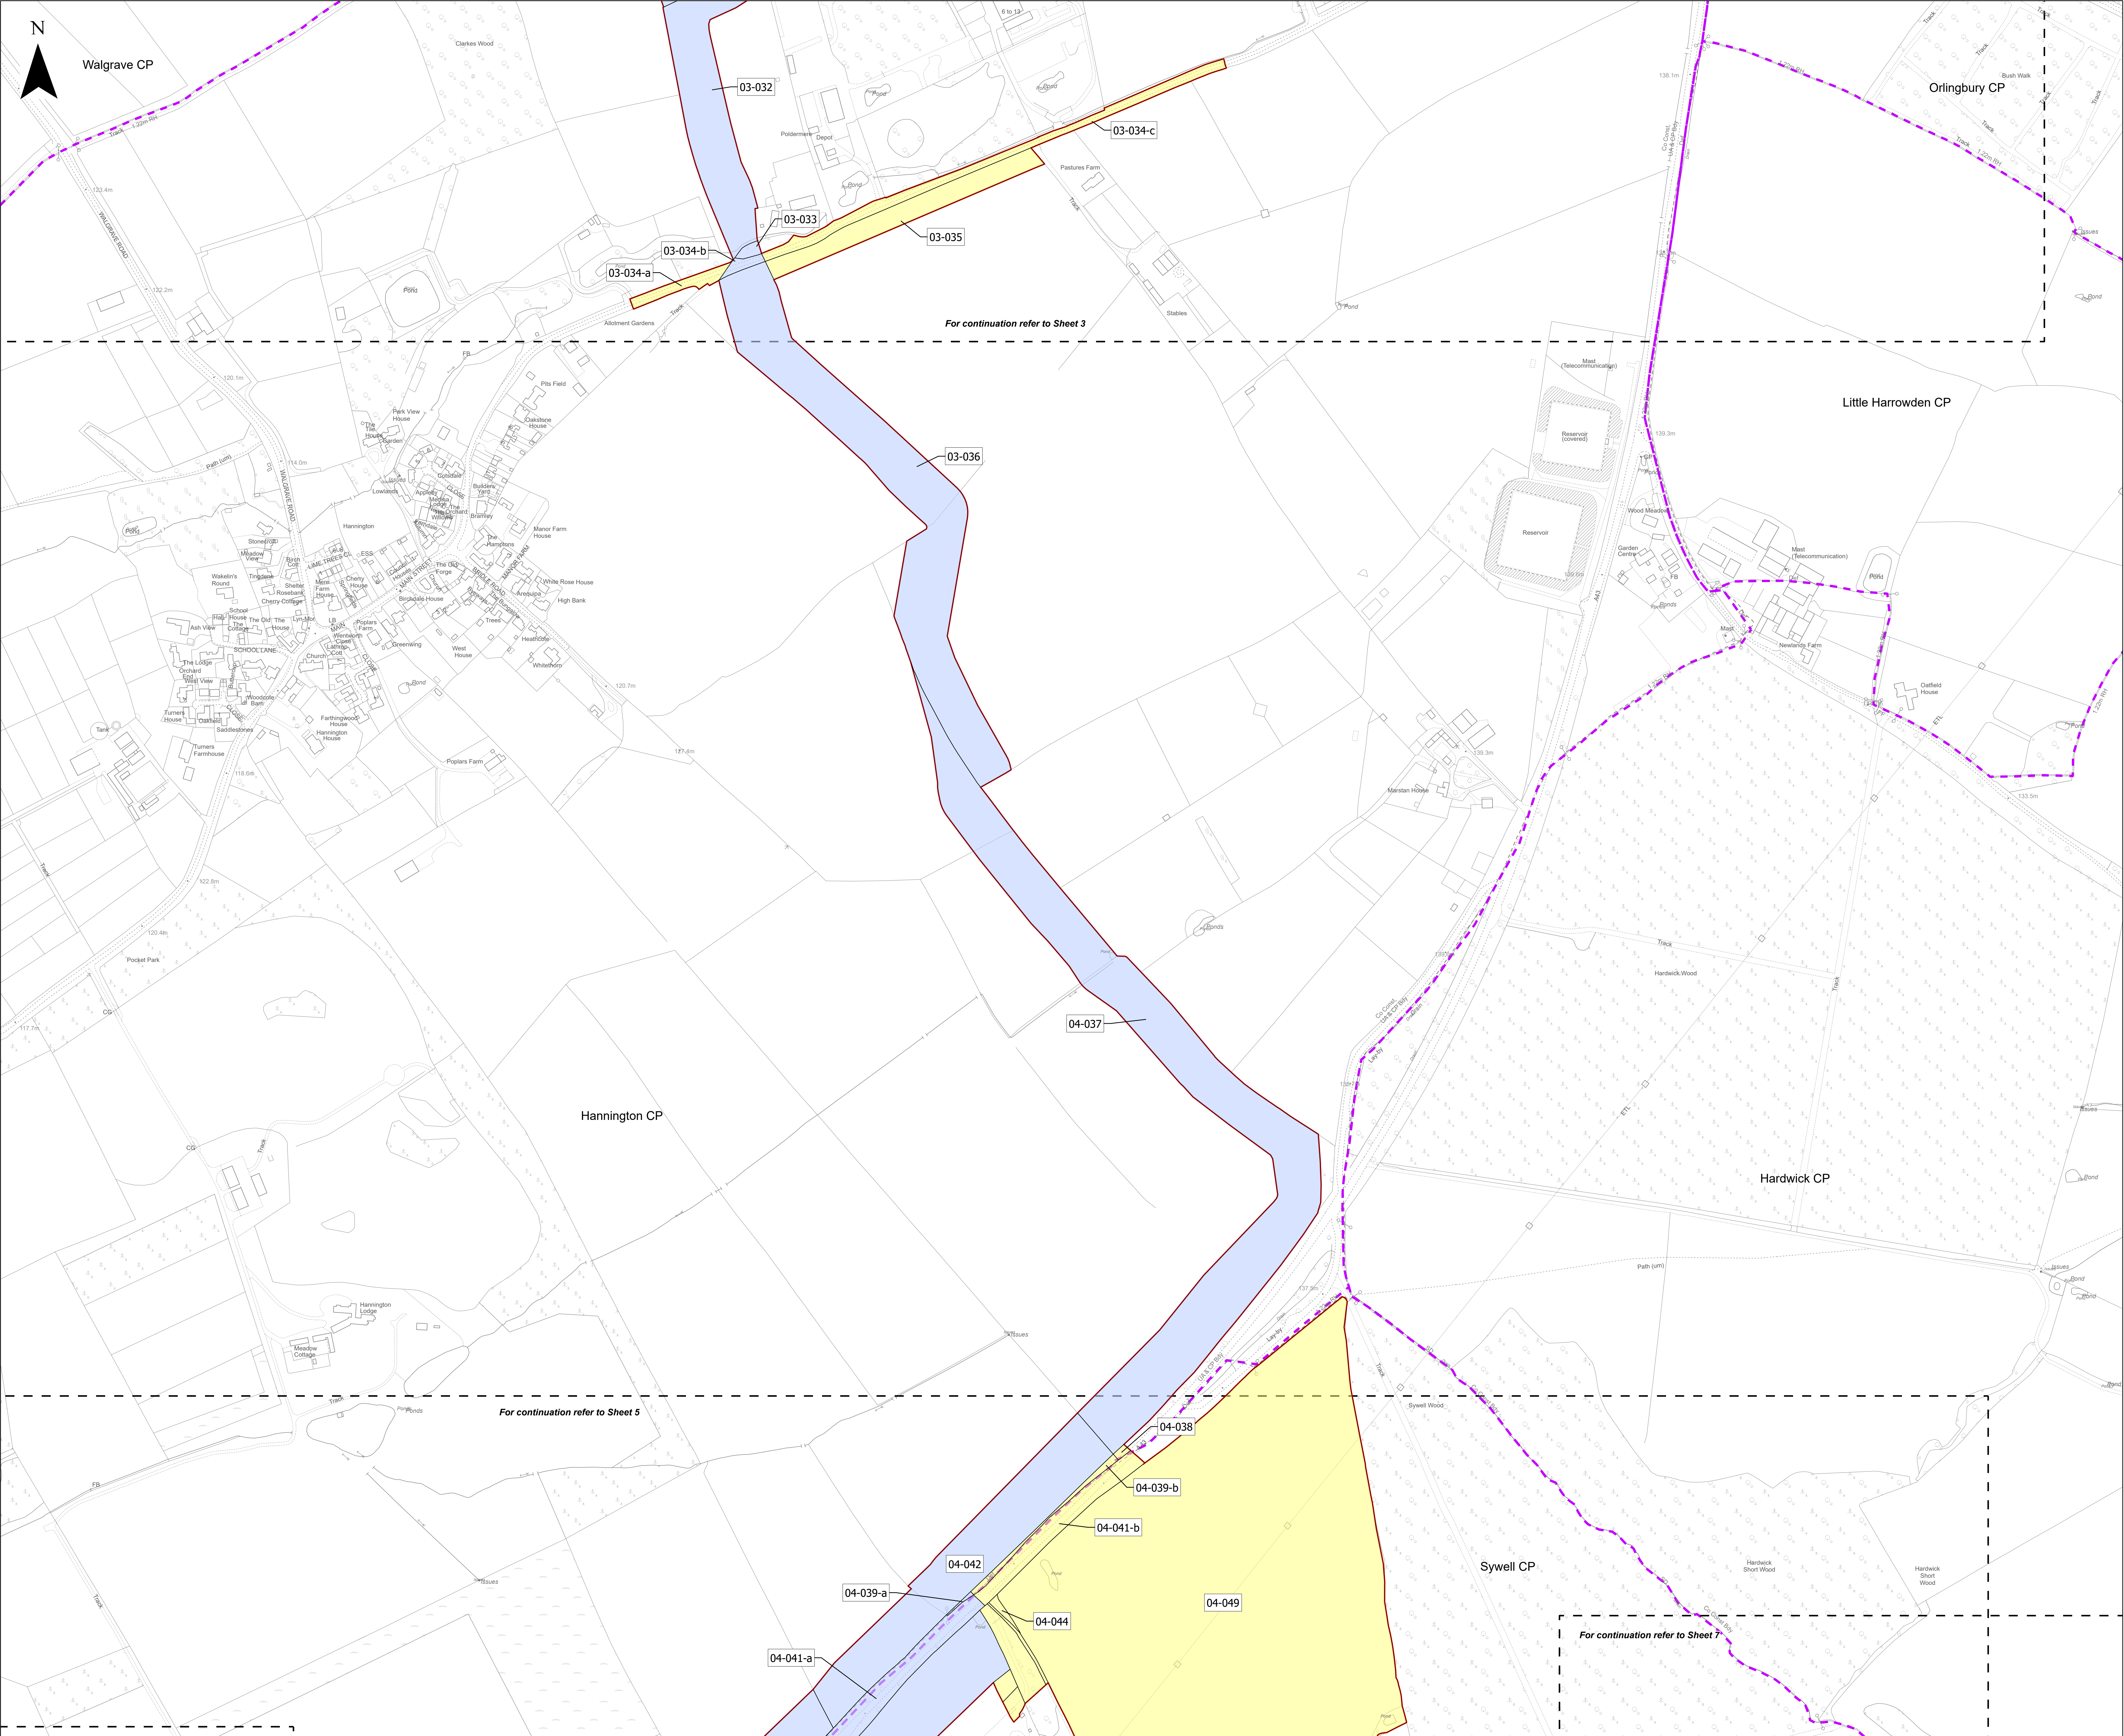


- Key**
- Order Limits
 - Freehold to be compulsorily acquired and temporary use of land and in relation to which it is proposed that easements, servitudes and other private rights will cease to have effect
 - Temporary use of land and in relation to which it is proposed to temporarily suspend easements, servitudes and other private rights
 - New rights (including restrictions) to be compulsorily acquired and temporary use of land and in relation to which it is proposed that easements, servitudes and other private rights will be suspended or cease to have effect
 - No Land Take
 - Local Authority / Parish Boundary
 - Cut Line

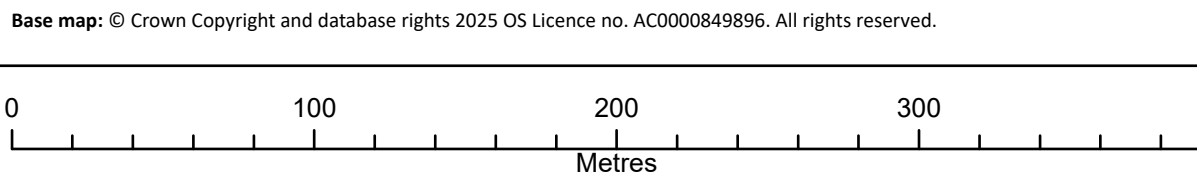

APFP Regulation: 5(2)(i)	Application Doc No. EX1/GH2.2_B
Ref: IGP_GH_DCO_Land_Plan	Date: 28/10/2025
Drawn by: DLG	Checked by: AT

Land Plan
Revision B
Sheet 4 of 18

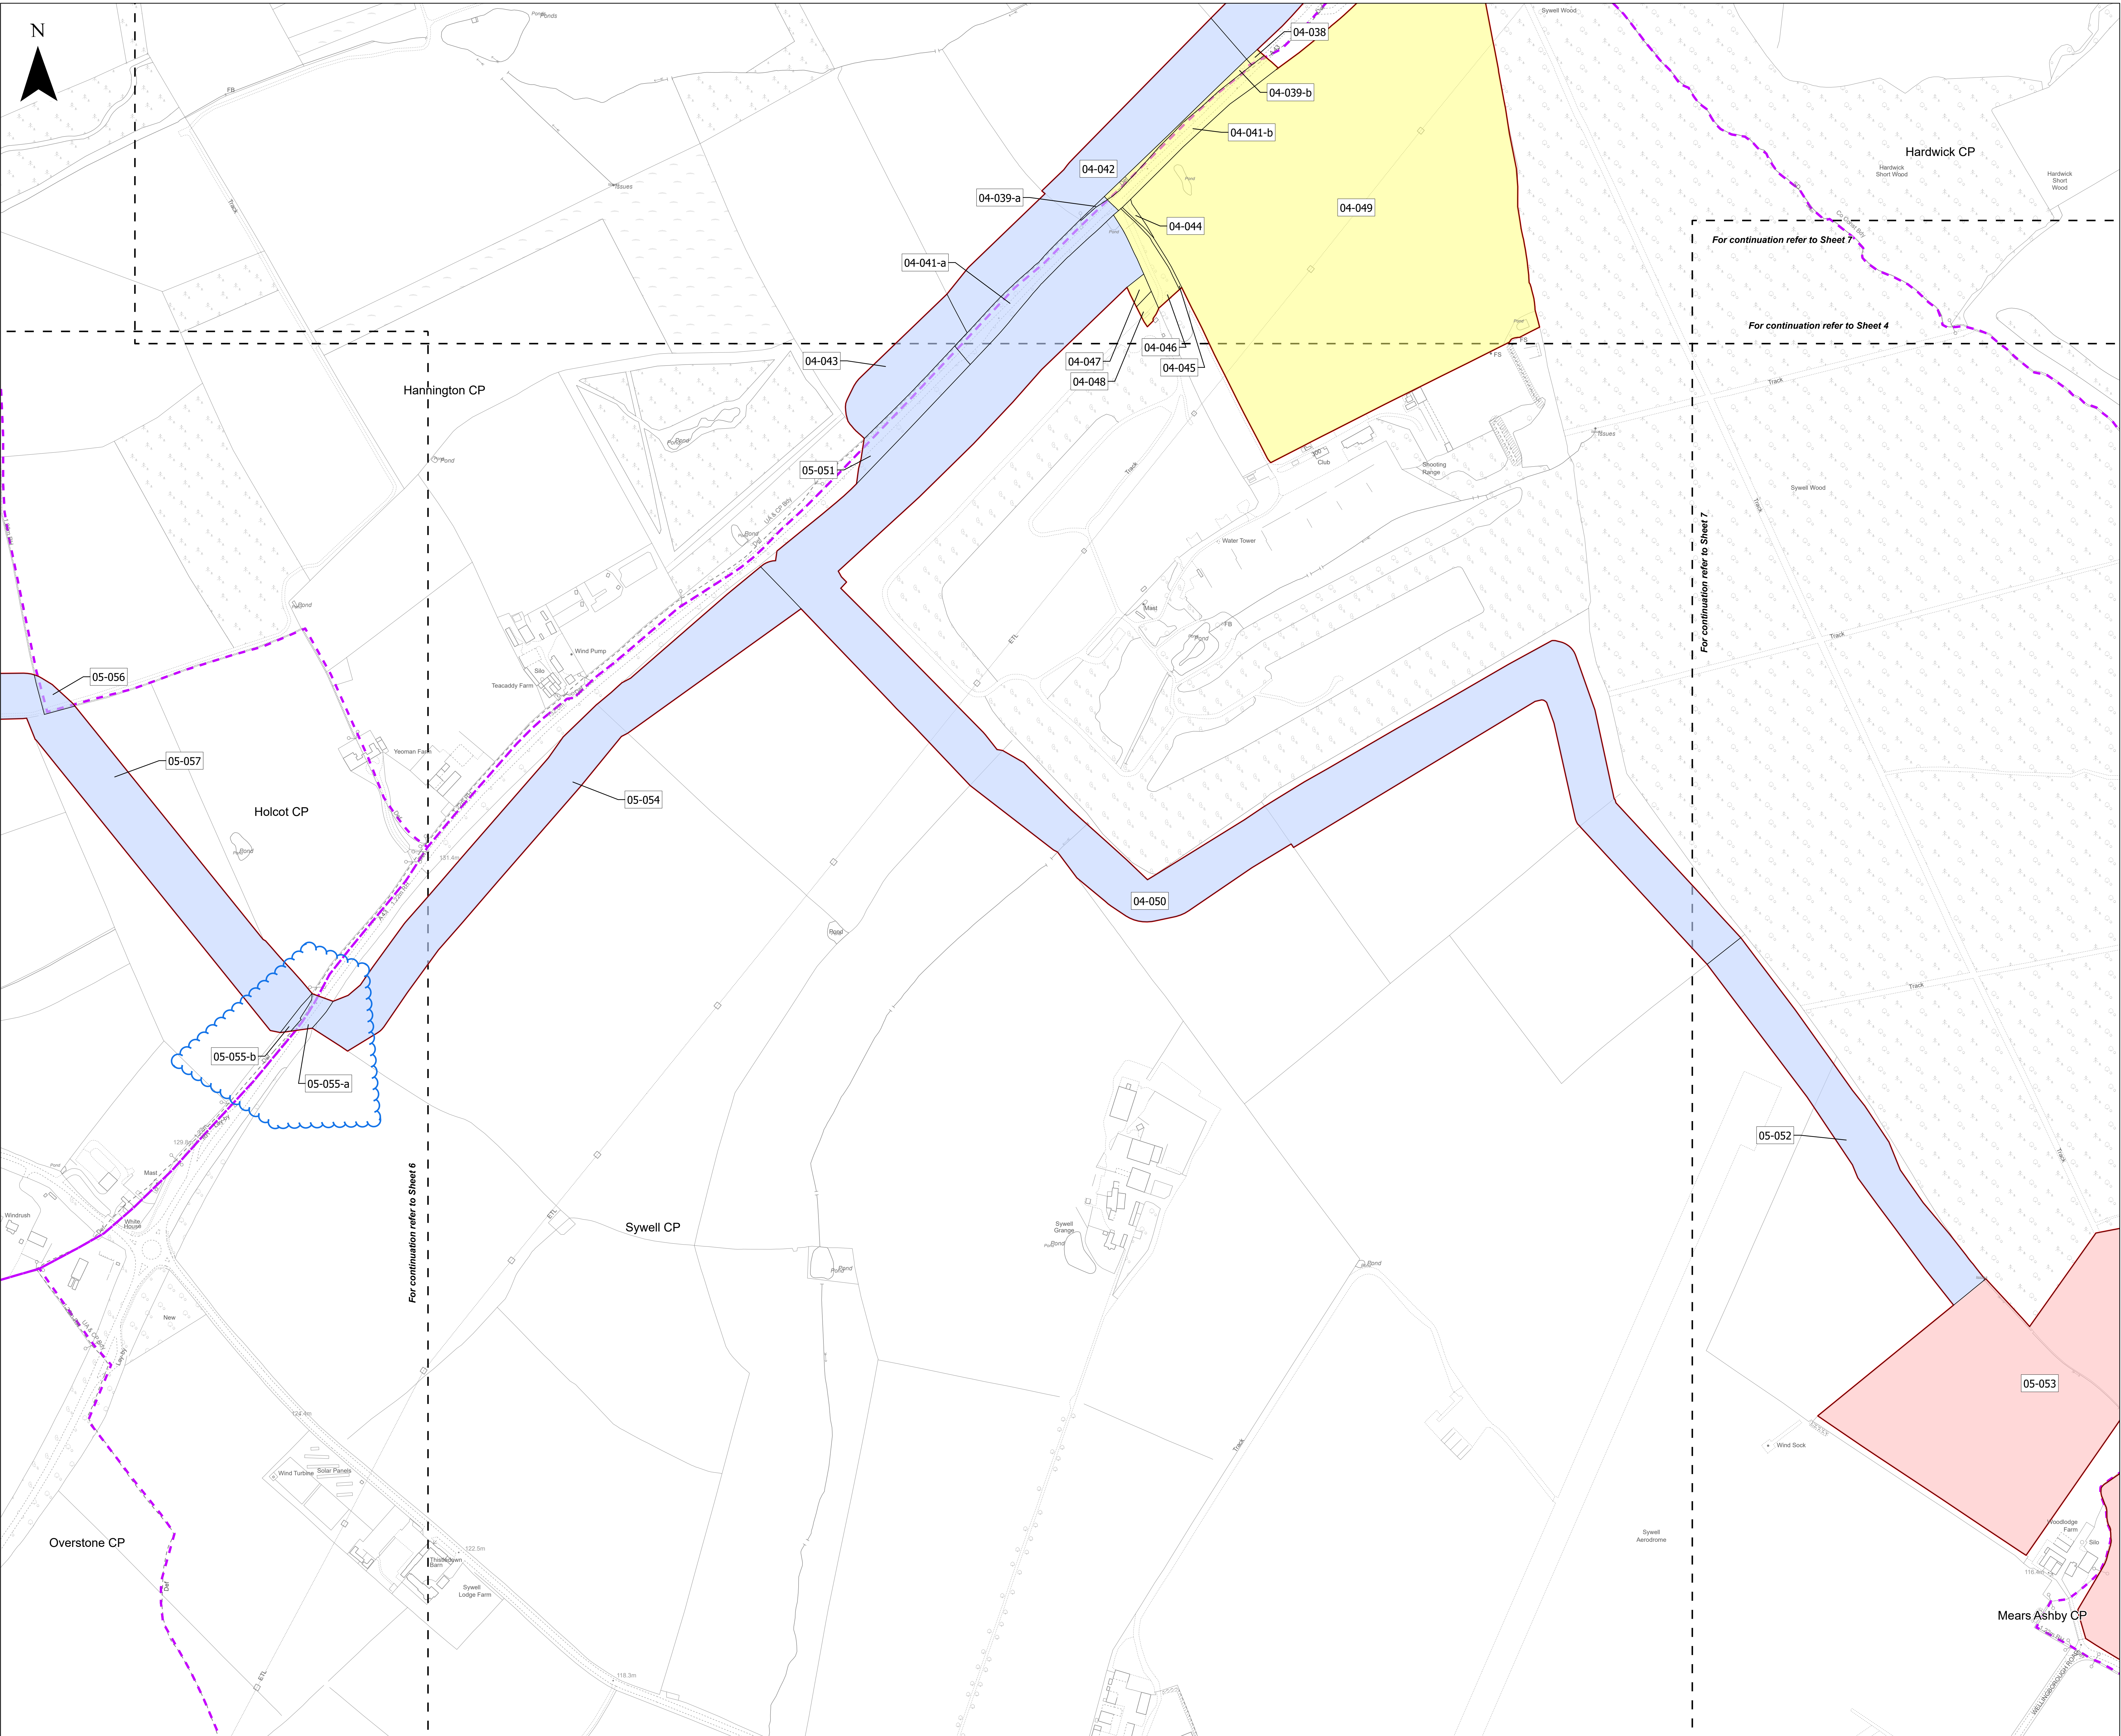

Key


- Order Limits
- Freehold to be compulsorily acquired and temporary use of land and in relation to which it is proposed that easements, servitudes and other private rights will cease to have effect
- Temporary use of land and in relation to which it is proposed to temporarily suspend easements, servitudes and other private rights
- New rights (including restrictions) to be compulsorily acquired and temporary use of land and in relation to which it is proposed that easements, servitudes and other private rights will be suspended or cease to have effect
- No Land Take
- Local Authority / Parish Boundary
- Cut Line

Base map: © Crown Copyright and database rights 2025 OS Licence no. AC0000849896. All rights reserved.

Scale: 1:2,500@ A0

APFP Regulation: 5(2)(i)	Application Doc No. EX1/GH2.2_B
Ref: IGP_GH_DCO_Land_Plan	Date: 28/10/2025
Drawn by: DLG	Checked by: AT

Land Plan
Revision B
Sheet 5 of 18

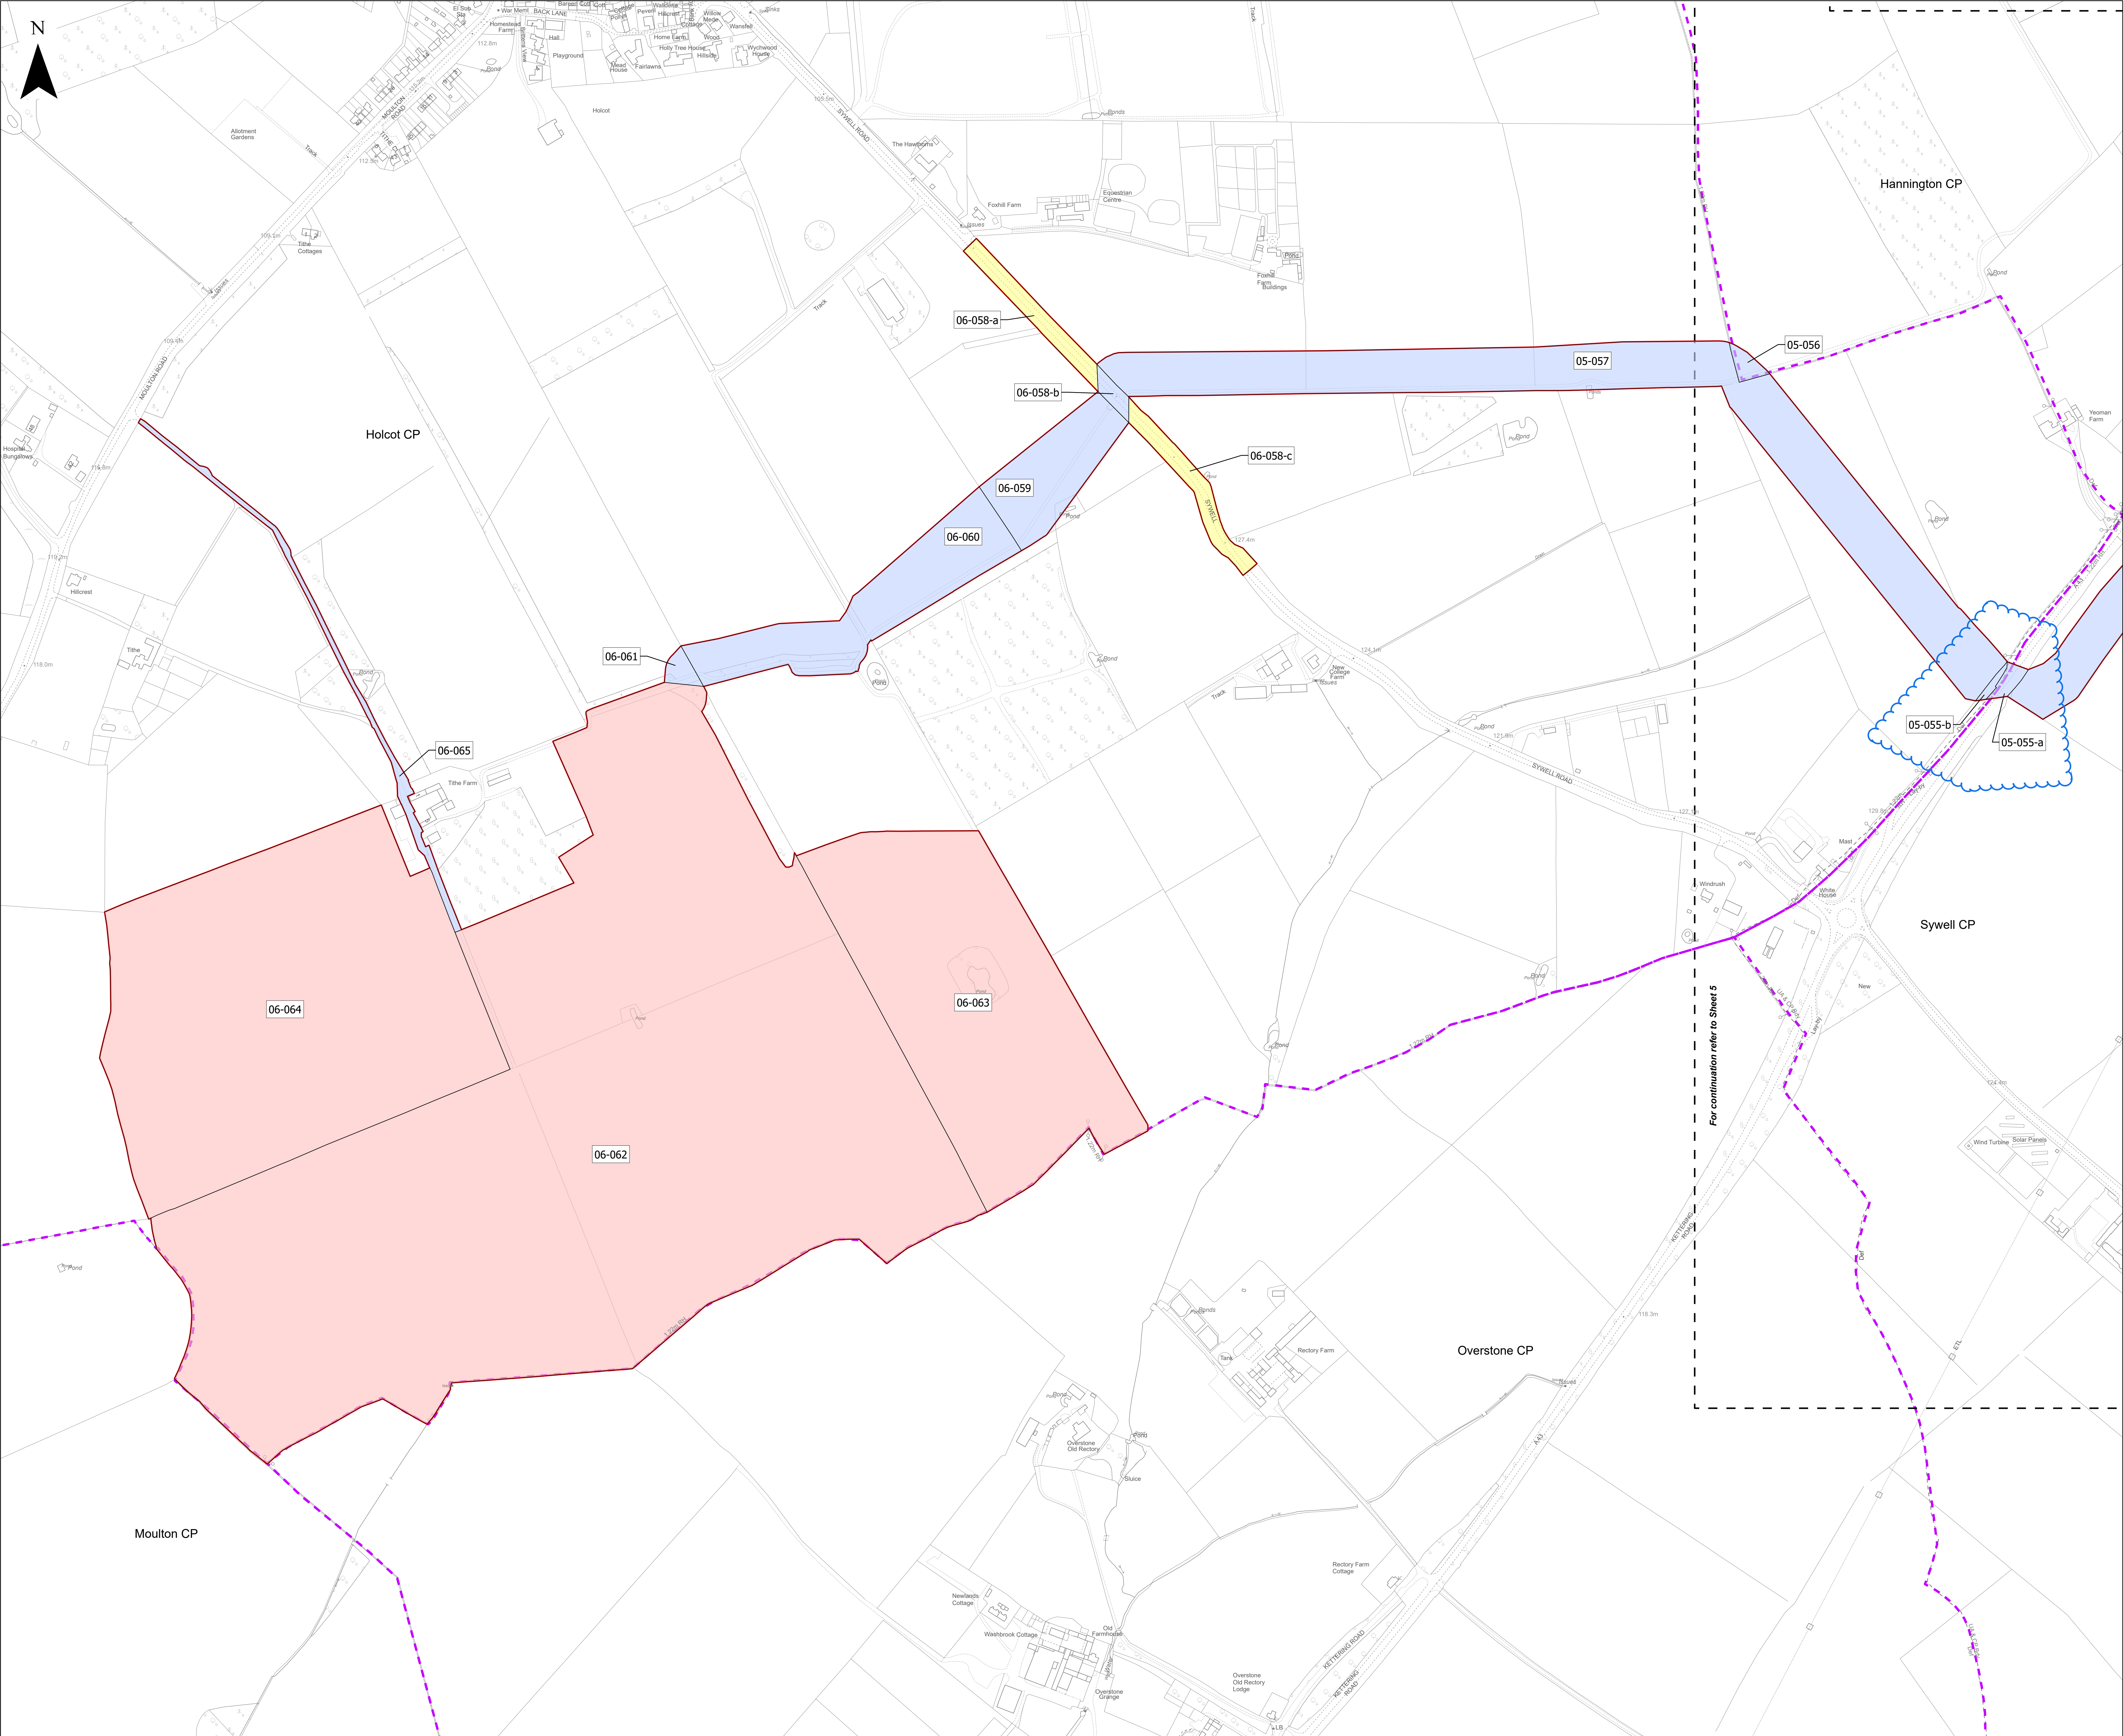


- Key**
- Order Limits
 - Freehold to be compulsorily acquired and temporary use of land and in relation to which it is proposed that easements, servitudes and other private rights will cease to have effect
 - Temporary use of land and in relation to which it is proposed to temporarily suspend easements, servitudes and other private rights
 - New rights (including restrictions) to be compulsorily acquired and temporary use of land and in relation to which it is proposed that easements, servitudes and other private rights will be suspended or cease to have effect
 - No Land Take
 - Local Authority / Parish Boundary
 - Cut Line

Base map: © Crown Copyright and database rights 2025 OS Licence no. AC000849896. All rights reserved.


0 100 200 300 400
Metres

Scale: 1:2,500@ A0

APFP Regulation: 5(2)(i)	Application Doc No. EX1/GH2.2_B
Ref: IGP_GH_DCO_Land_Plan	Date: 28/10/2025
Drawn by: DLG	Checked by: AT

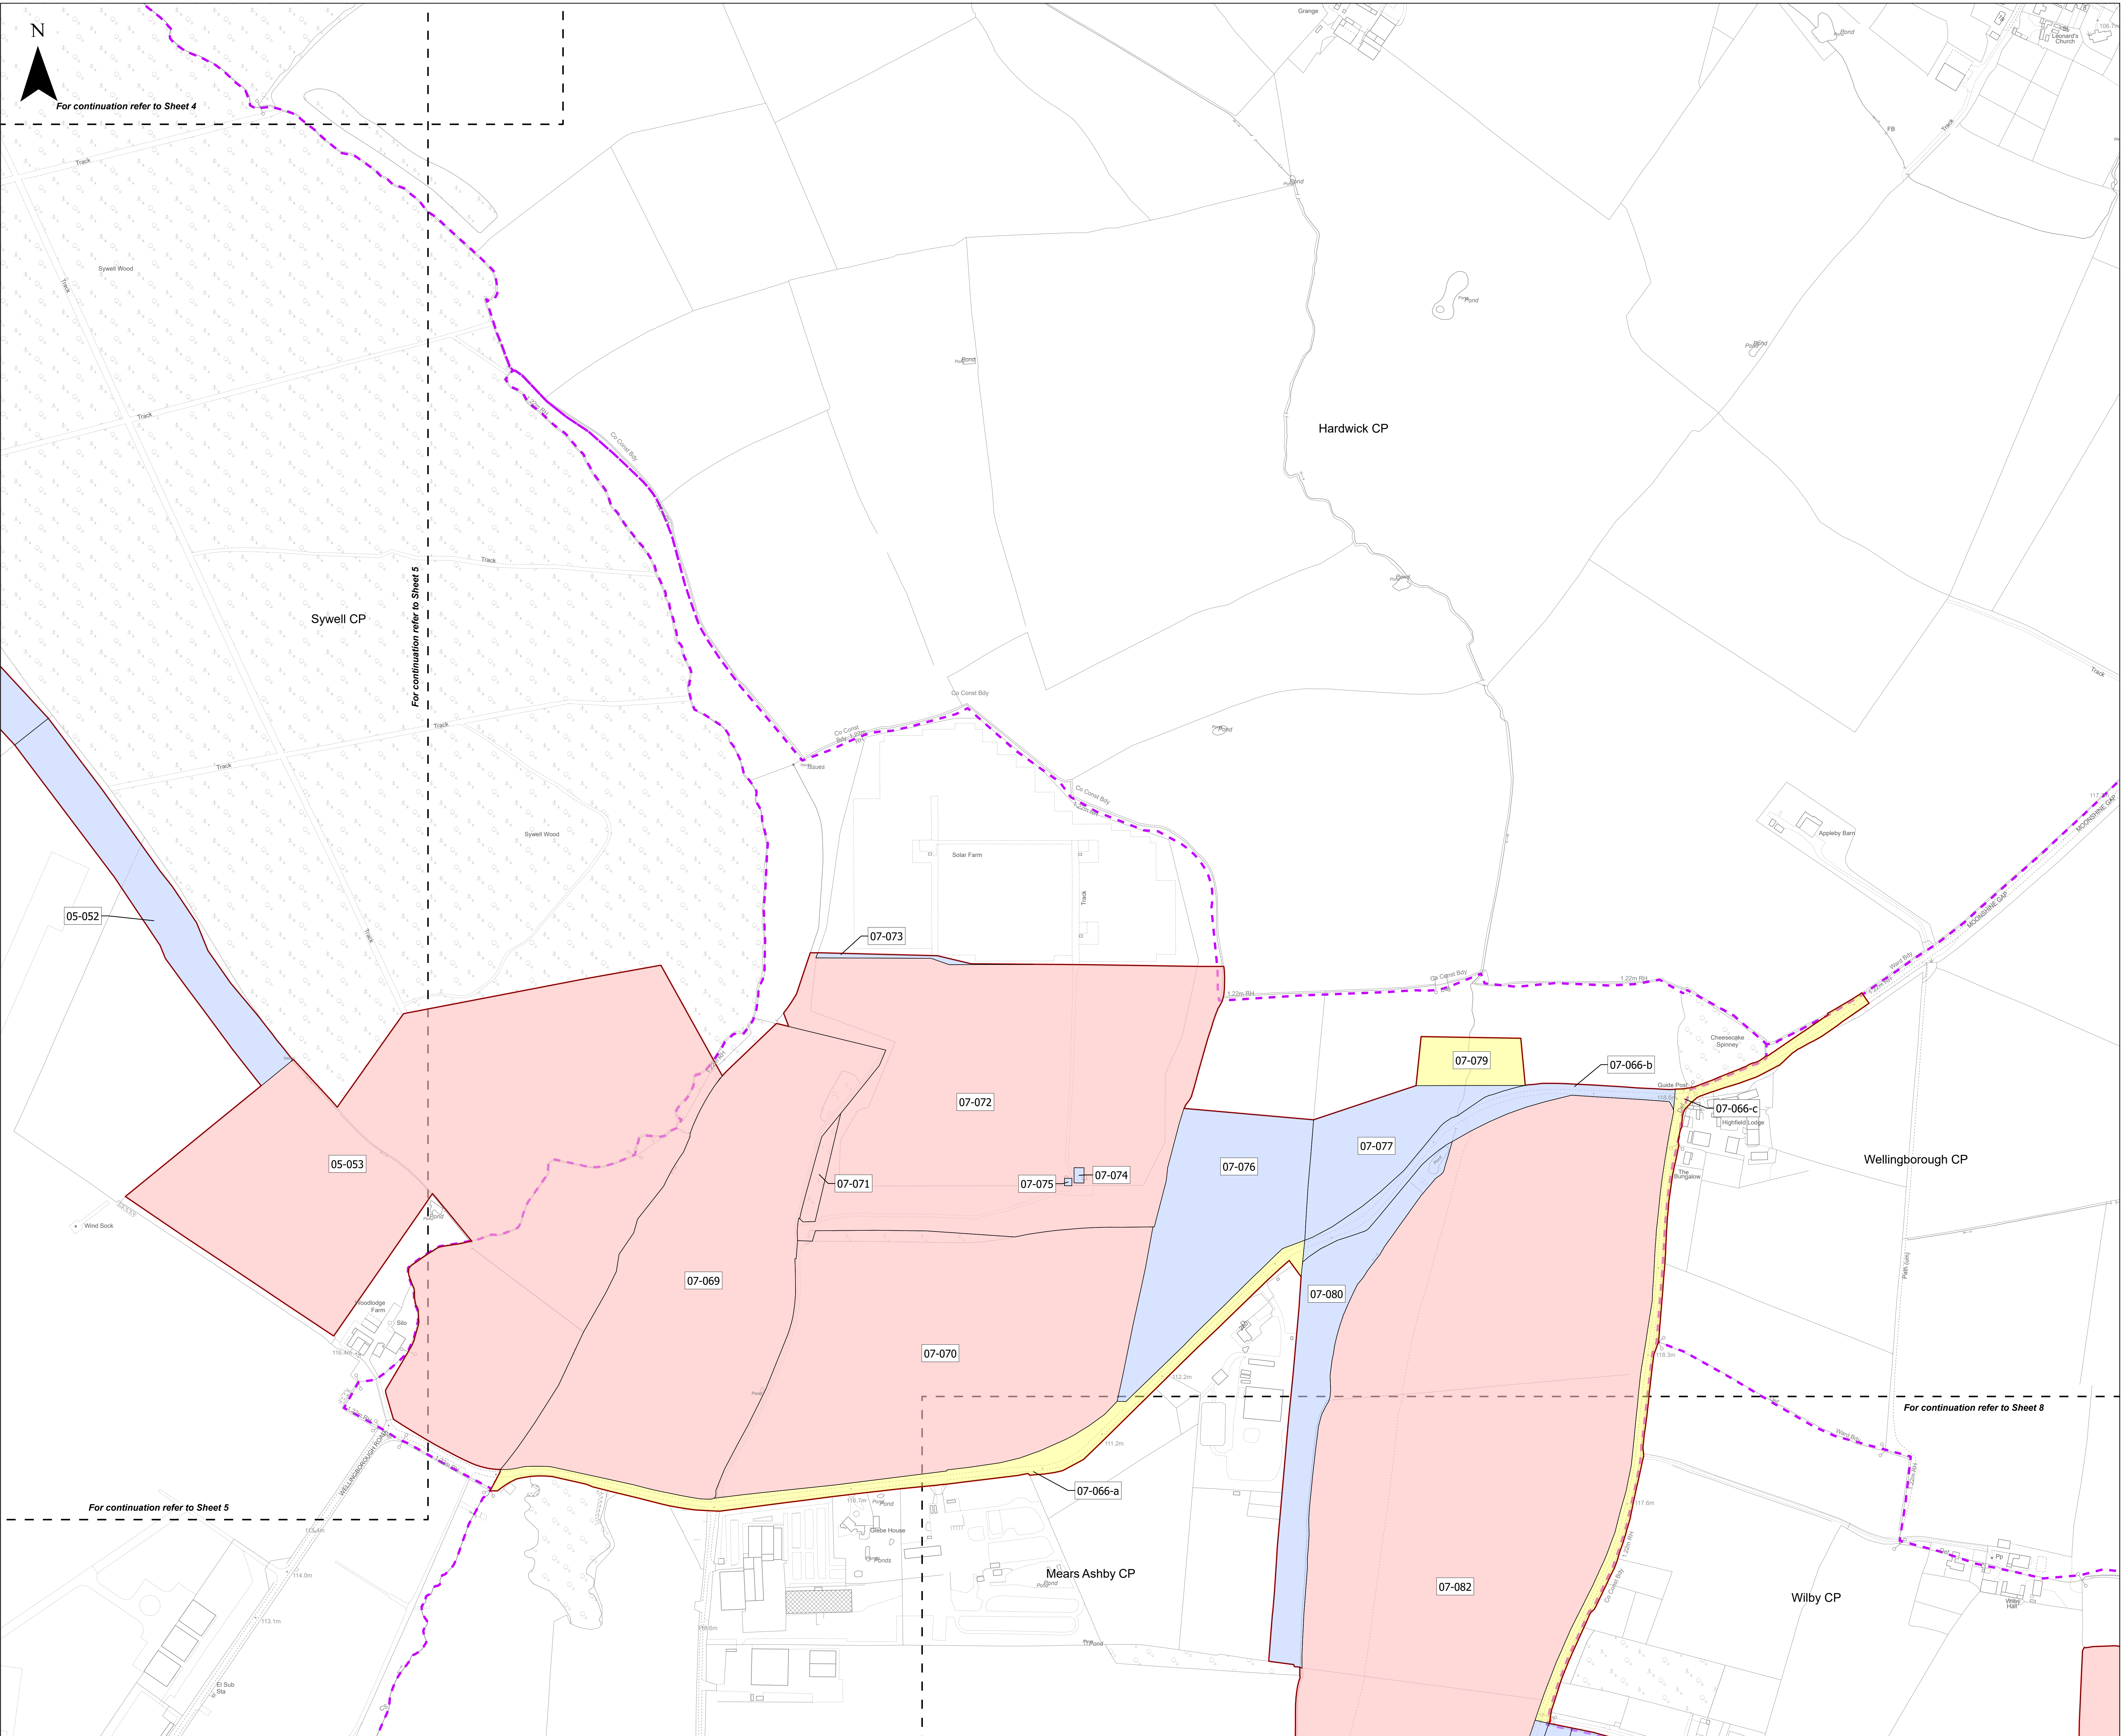

- Key**
- Order Limits
 - Freehold to be compulsorily acquired and temporary use of land and in relation to which it is proposed that easements, servitudes and other private rights will cease to have effect
 - Temporary use of land and in relation to which it is proposed to temporarily suspend easements, servitudes and other private rights
 - New rights (including restrictions) to be compulsorily acquired and temporary use of land and in relation to which it is proposed that easements, servitudes and other private rights will be suspended or cease to have effect
 - No Land Take
 - Local Authority / Parish Boundary
 - Cut Line

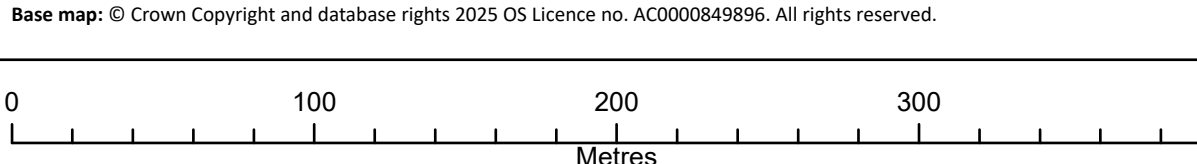


Scale: 1:2,500@ A0

APFP Regulation: 5(2)(i)	Application Doc No. EX1/GH2.2_B
Ref: IGP_GH_DCO_Land_Plan	Date: 28/10/2025
Drawn by: DLG	Checked by: AT


Land Plan
Revision B
Sheet 7 of 18



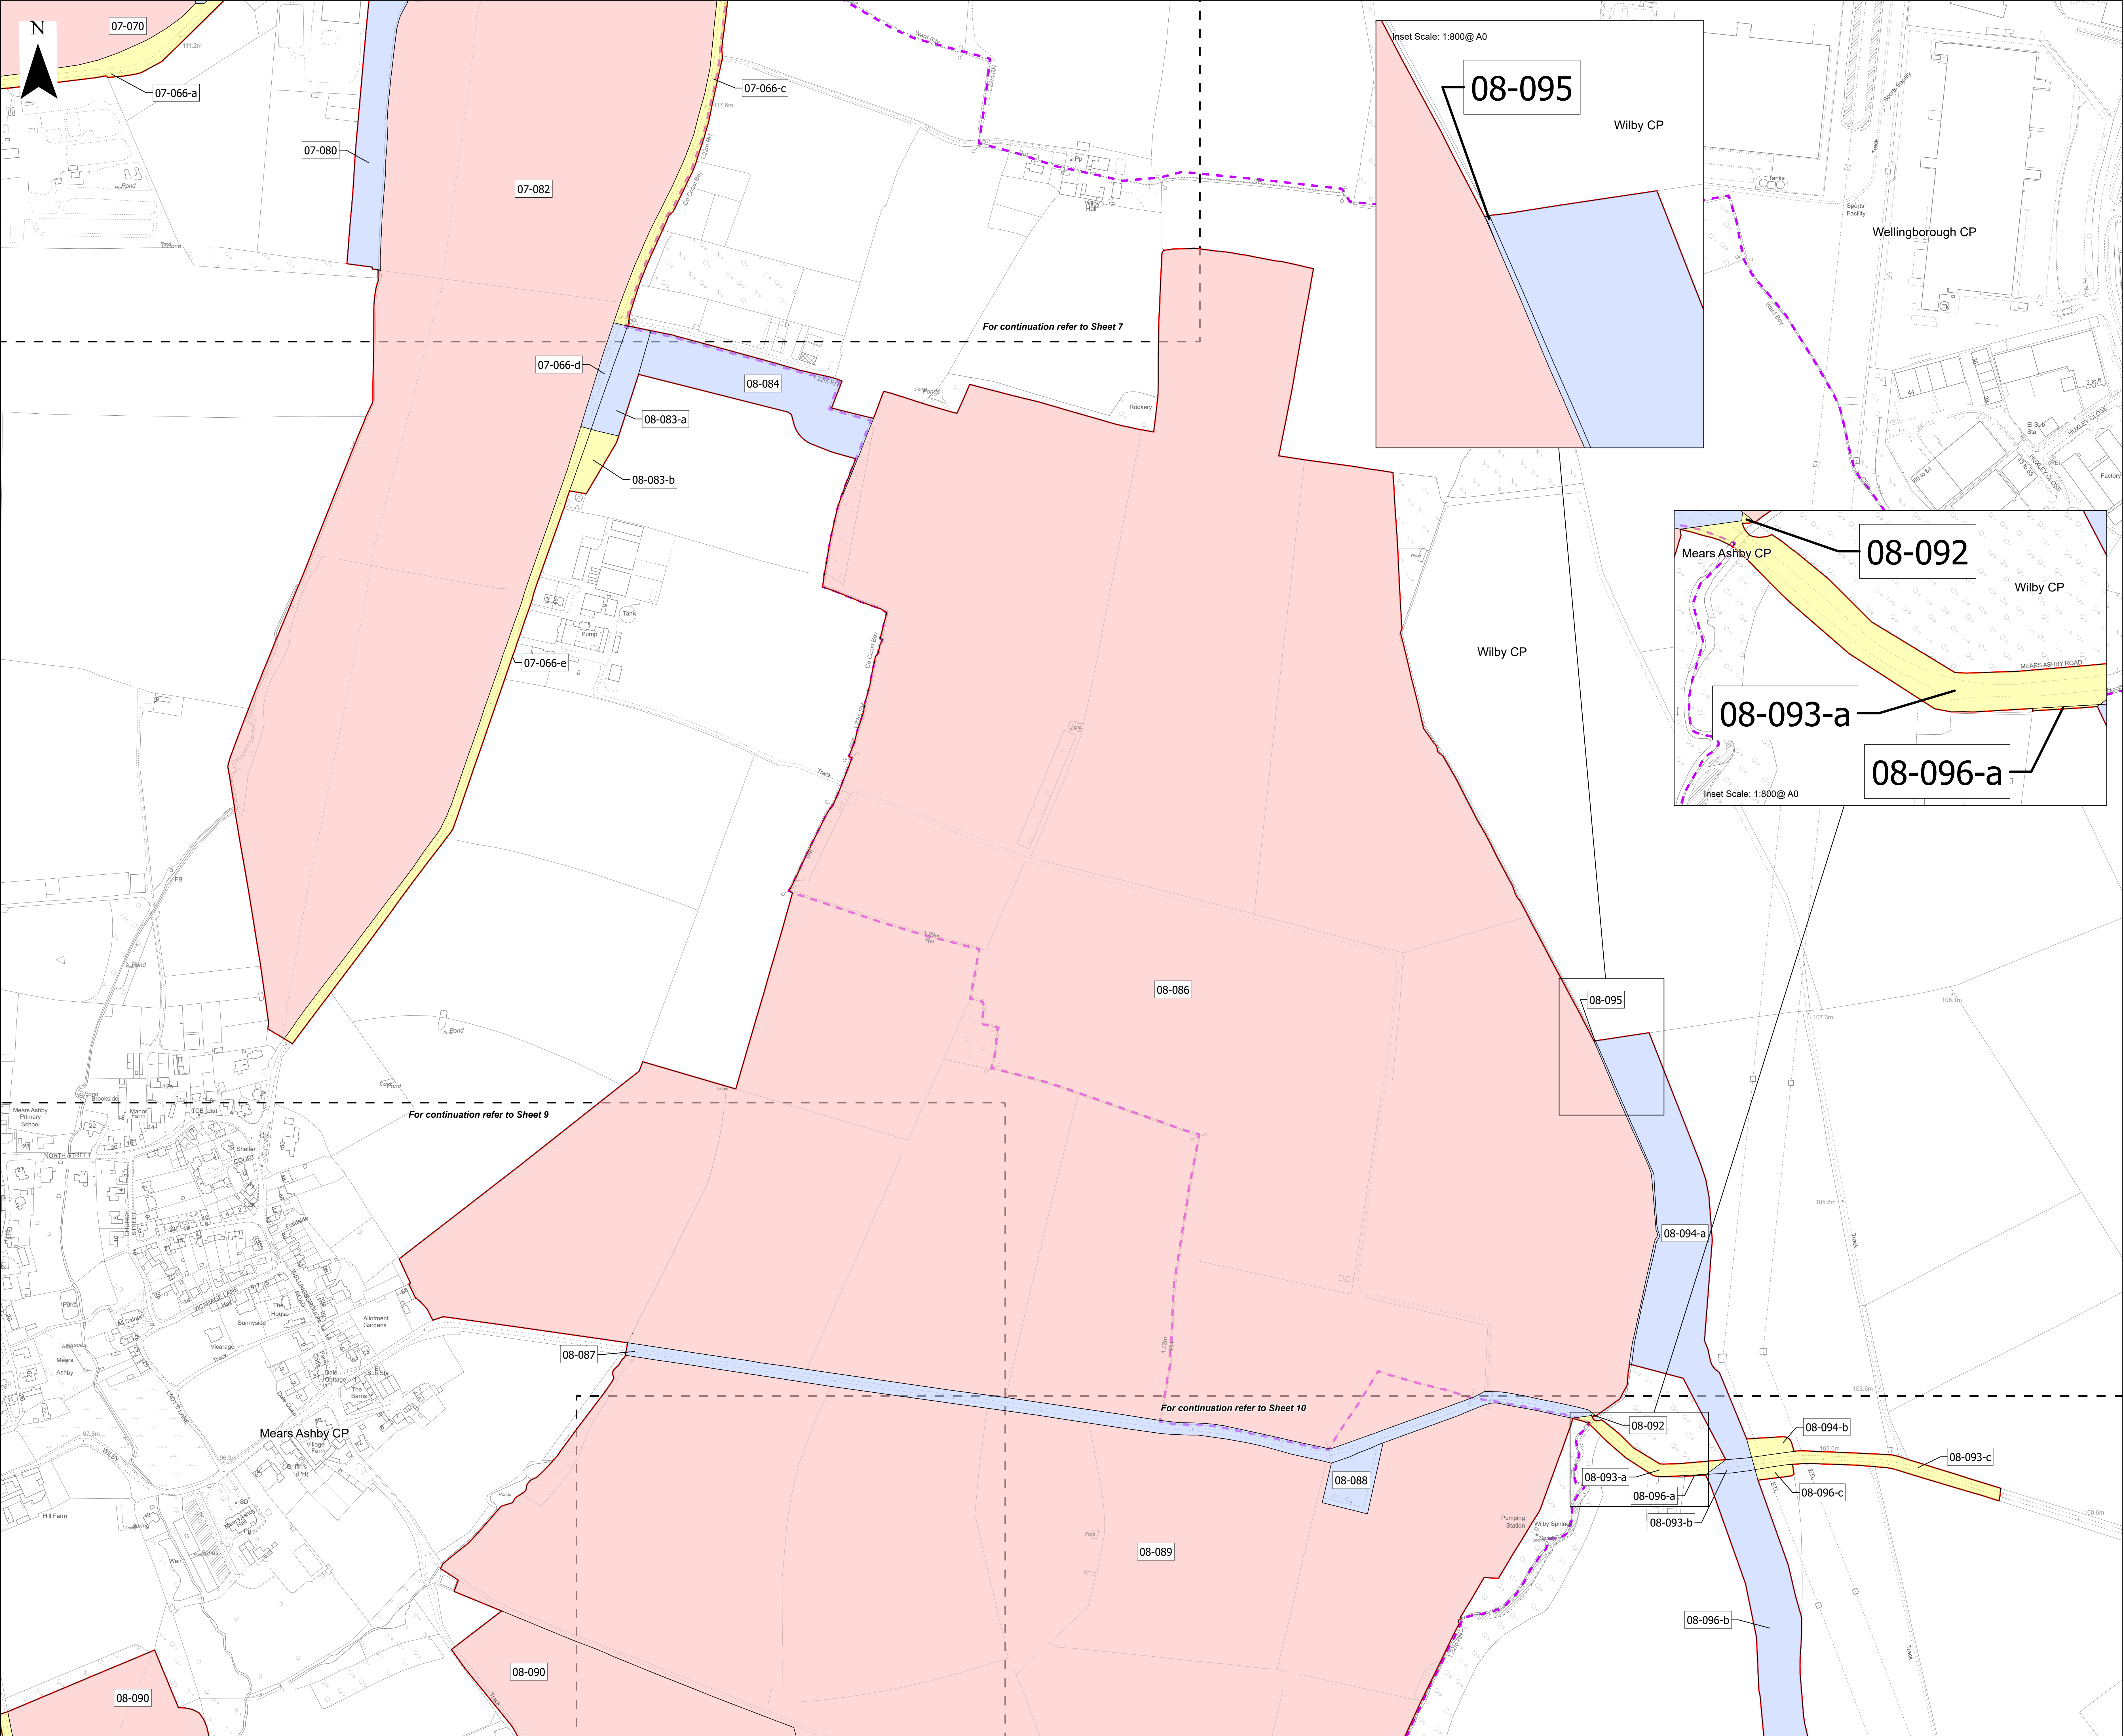

- Key**
- Order Limits
 - Freehold to be compulsorily acquired and temporary use of land and in relation to which it is proposed that easements, servitudes and other private rights will cease to have effect
 - Temporary use of land and in relation to which it is proposed to temporarily suspend easements, servitudes and other private rights
 - New rights (including restrictions) to be compulsorily acquired and temporary use of land and in relation to which it is proposed that easements, servitudes and other private rights will be suspended or cease to have effect
 - No Land Take
 - Local Authority / Parish Boundary
 - Cut Line


Base map: © Crown Copyright and database rights 2025 OS Licence no. AC000849896. All rights reserved.

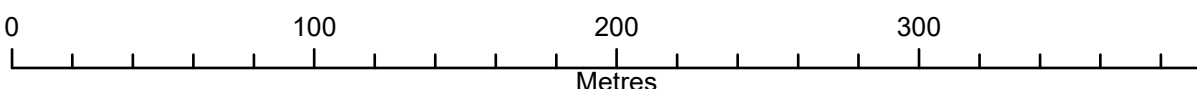

Scale: 1:2,500@ A0	
APFP Regulation: 5(2)(i)	Application Doc No. EX1/GH2.2_B
Ref: IGP_GH_DCO_Land_Plan	Date: 28/10/2025
Drawn by: DLG	Checked by: AT


Land Plan
Revision B
Sheet 8 of 18



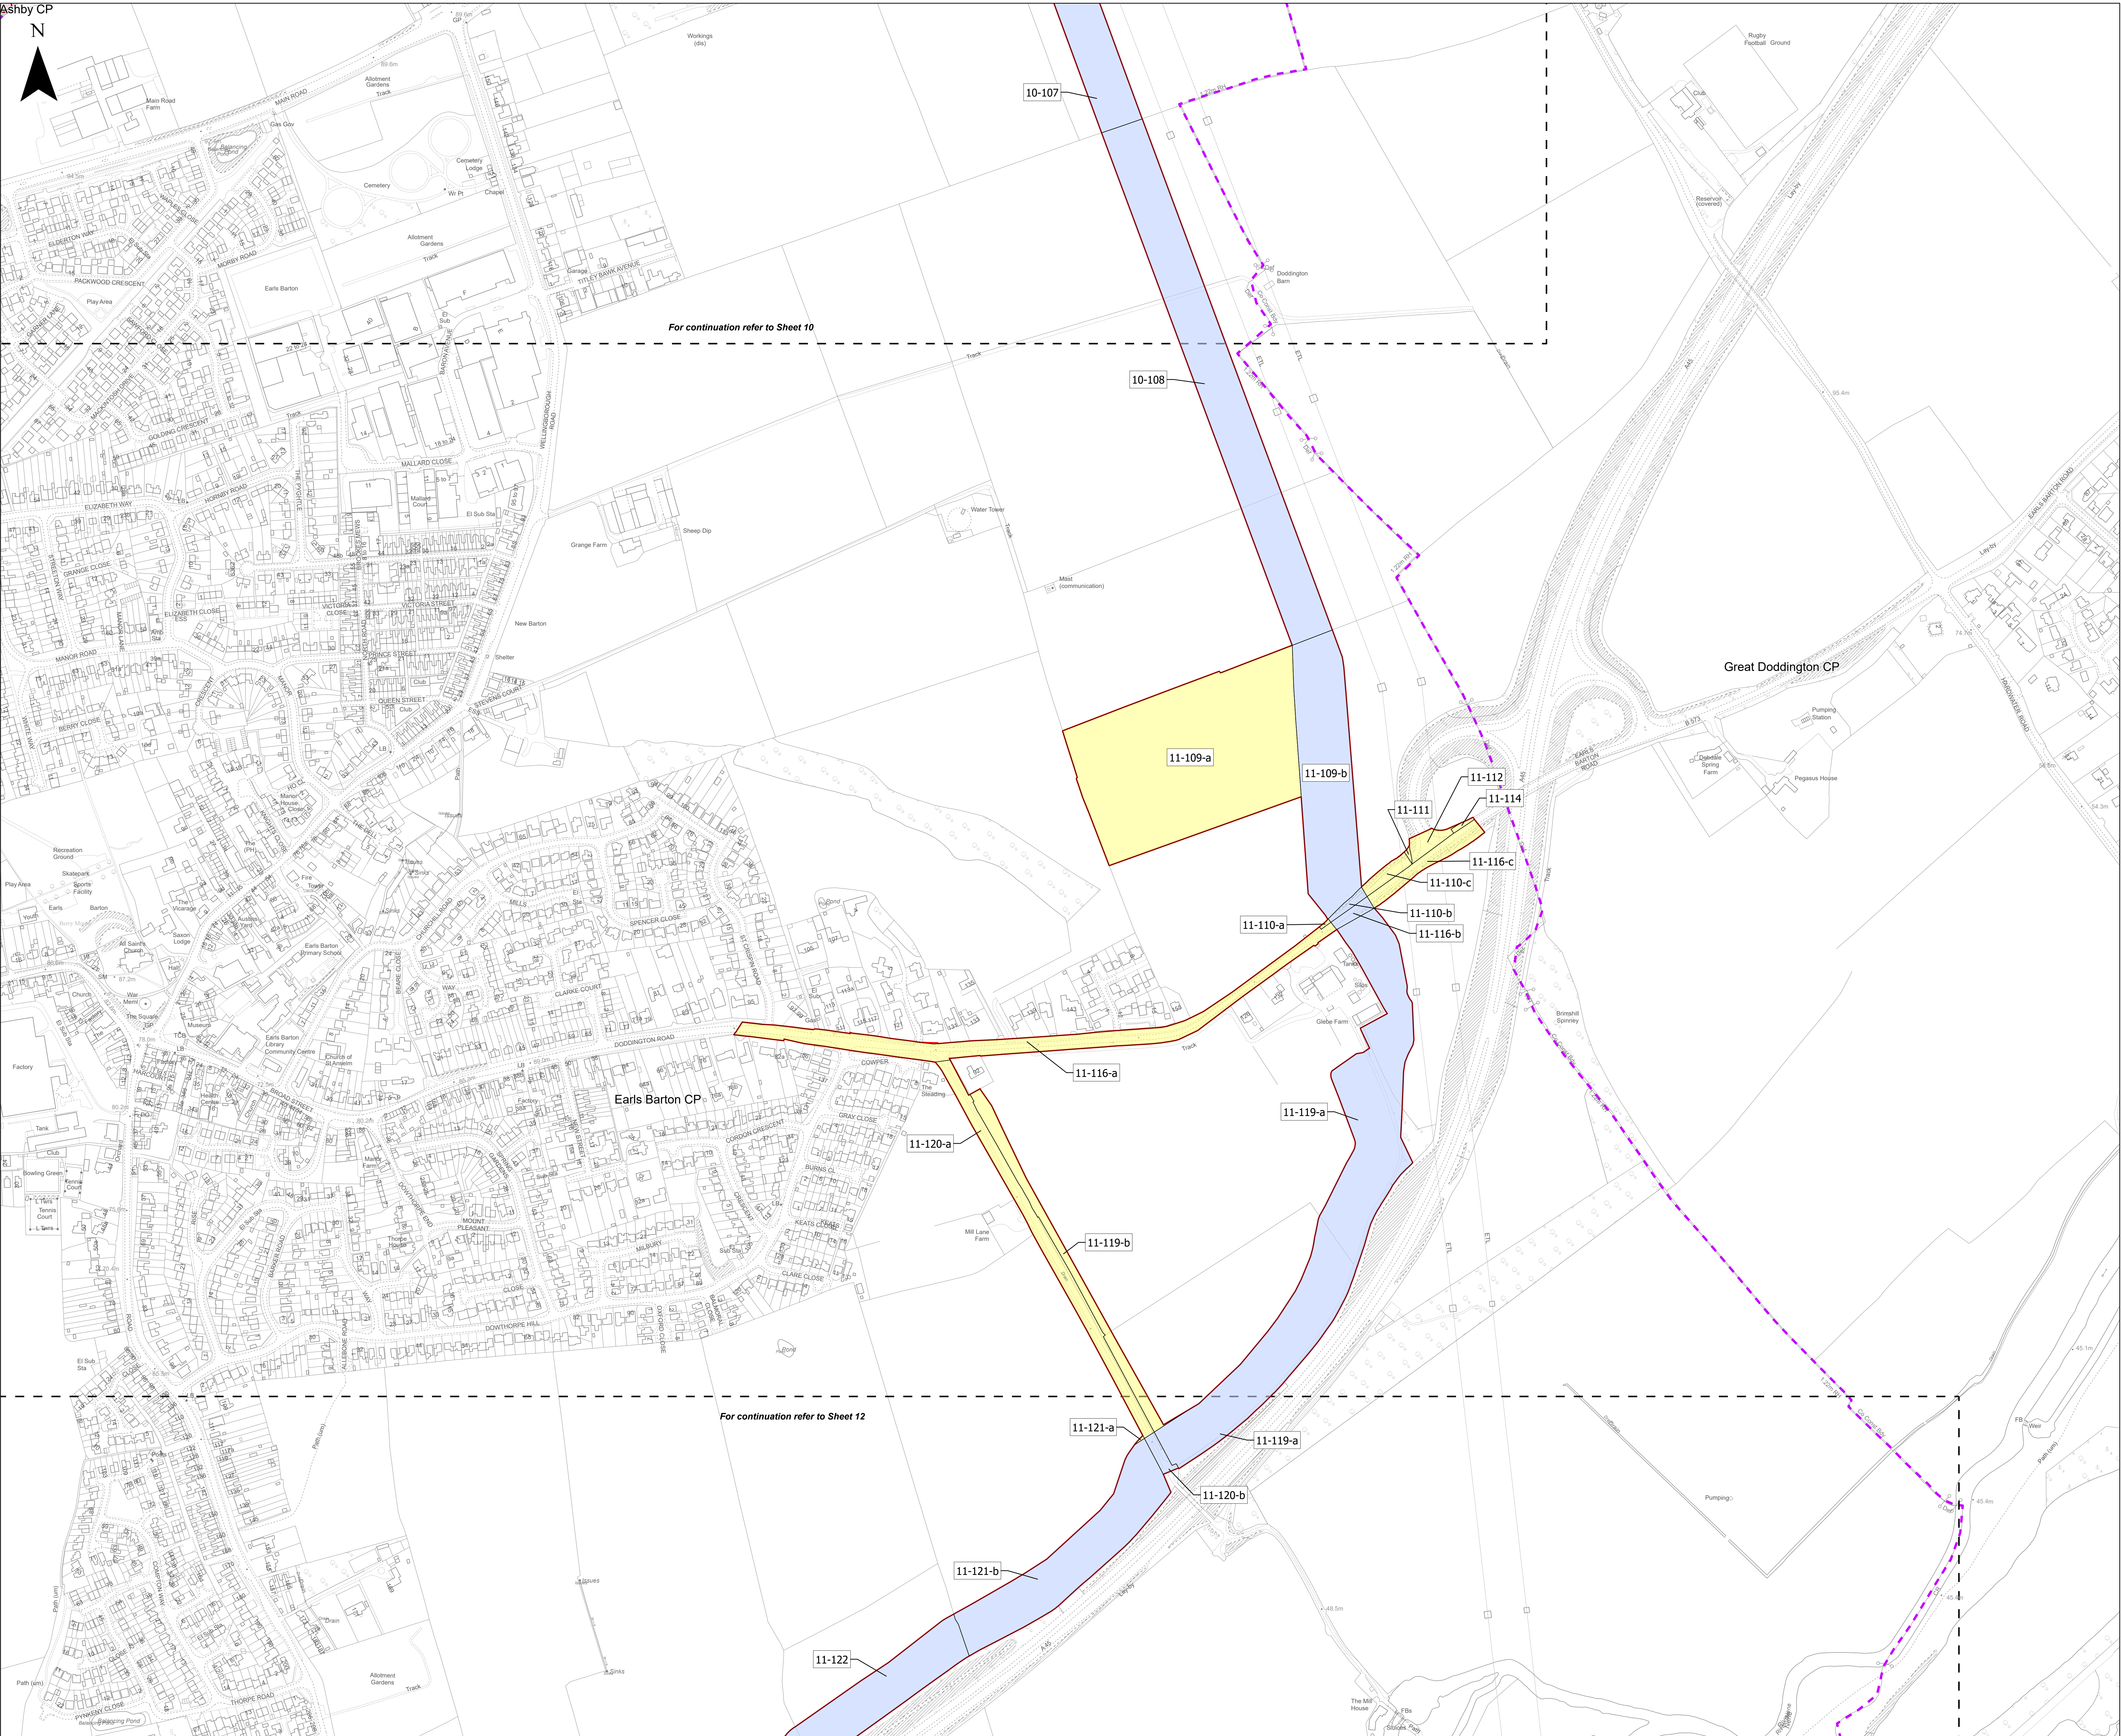

- Key**
- Order Limits
 - Freehold to be compulsorily acquired and temporary use of land and in relation to which it is proposed that easements, servitudes and other private rights will cease to have effect
 - Temporary use of land and in relation to which it is proposed to temporarily suspend easements, servitudes and other private rights
 - New rights (including restrictions) to be compulsorily acquired and temporary use of land and in relation to which it is proposed that easements, servitudes and other private rights will be suspended or cease to have effect
 - No Land Take
 - Local Authority / Parish Boundary
 - Cut Line

Base map: © Crown Copyright and database rights 2025 OS Licence no. AC0000849896. All rights reserved.

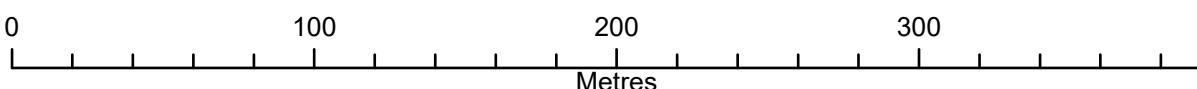


Scale: 1:2,500@ A0

APFP Regulation: 5(2)(i)	Application Doc No. EX1/GH2.2_B
Ref: IGP_GH_DCO_Land_Plan	Date: 28/10/2025
Drawn by: DLG	Checked by: AT


Land Plan
Revision B
Sheet 11 of 18



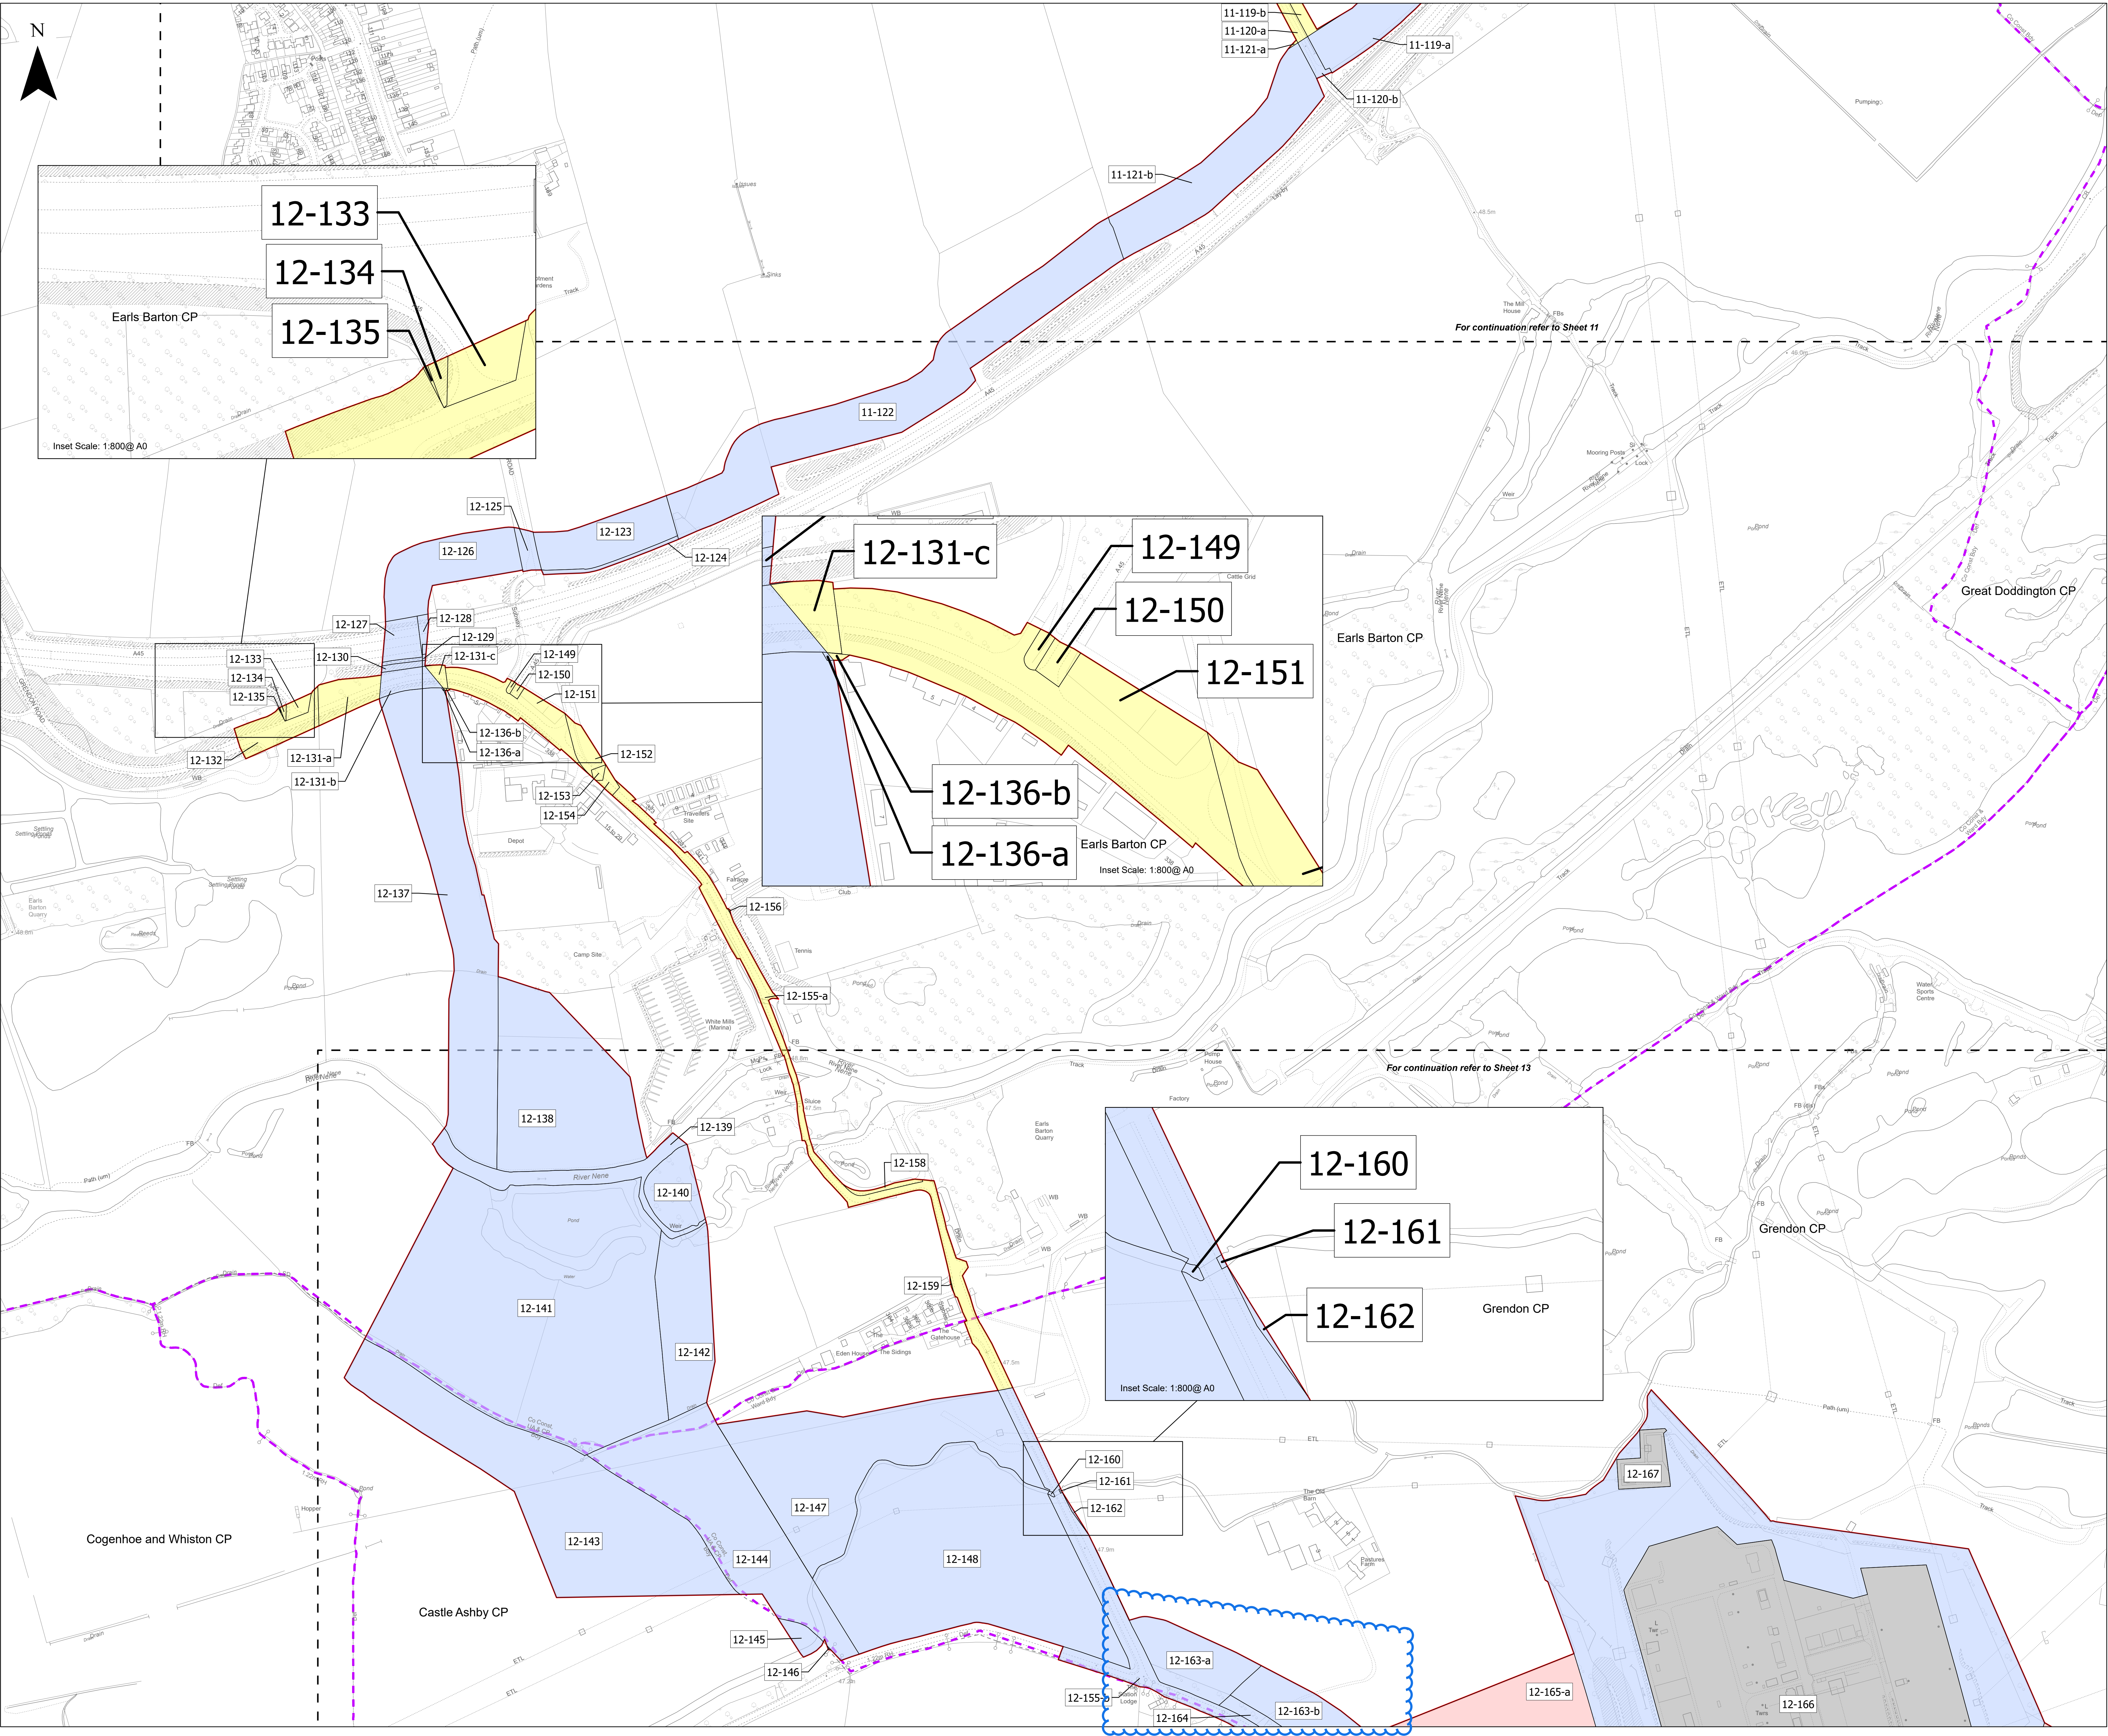

- Key**
- Order Limits
 - Freehold to be compulsorily acquired and temporary use of land and in relation to which it is proposed that easements, servitudes and other private rights will cease to have effect
 - Temporary use of land and in relation to which it is proposed to temporarily suspend easements, servitudes and other private rights
 - New rights (including restrictions) to be compulsorily acquired and temporary use of land and in relation to which it is proposed that easements, servitudes and other private rights will be suspended or cease to have effect
 - No Land Take
 - Local Authority / Parish Boundary
 - Cut Line

Base map: © Crown Copyright and database rights 2025 OS Licence no. AC0000849896. All rights reserved.

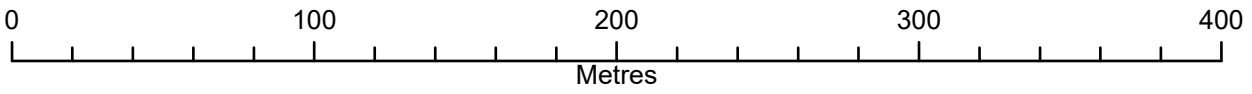


Scale: 1:2,500@ A0

APFP Regulation: 5(2)(i)	Application Doc No. EX1/GH2.2_B
Ref: IGP_GH_DCO_Land_Plan	Date: 06/11/2025
Drawn by: DLG	Checked by: AT

Land Plan
Revision B
Sheet 12 of 18



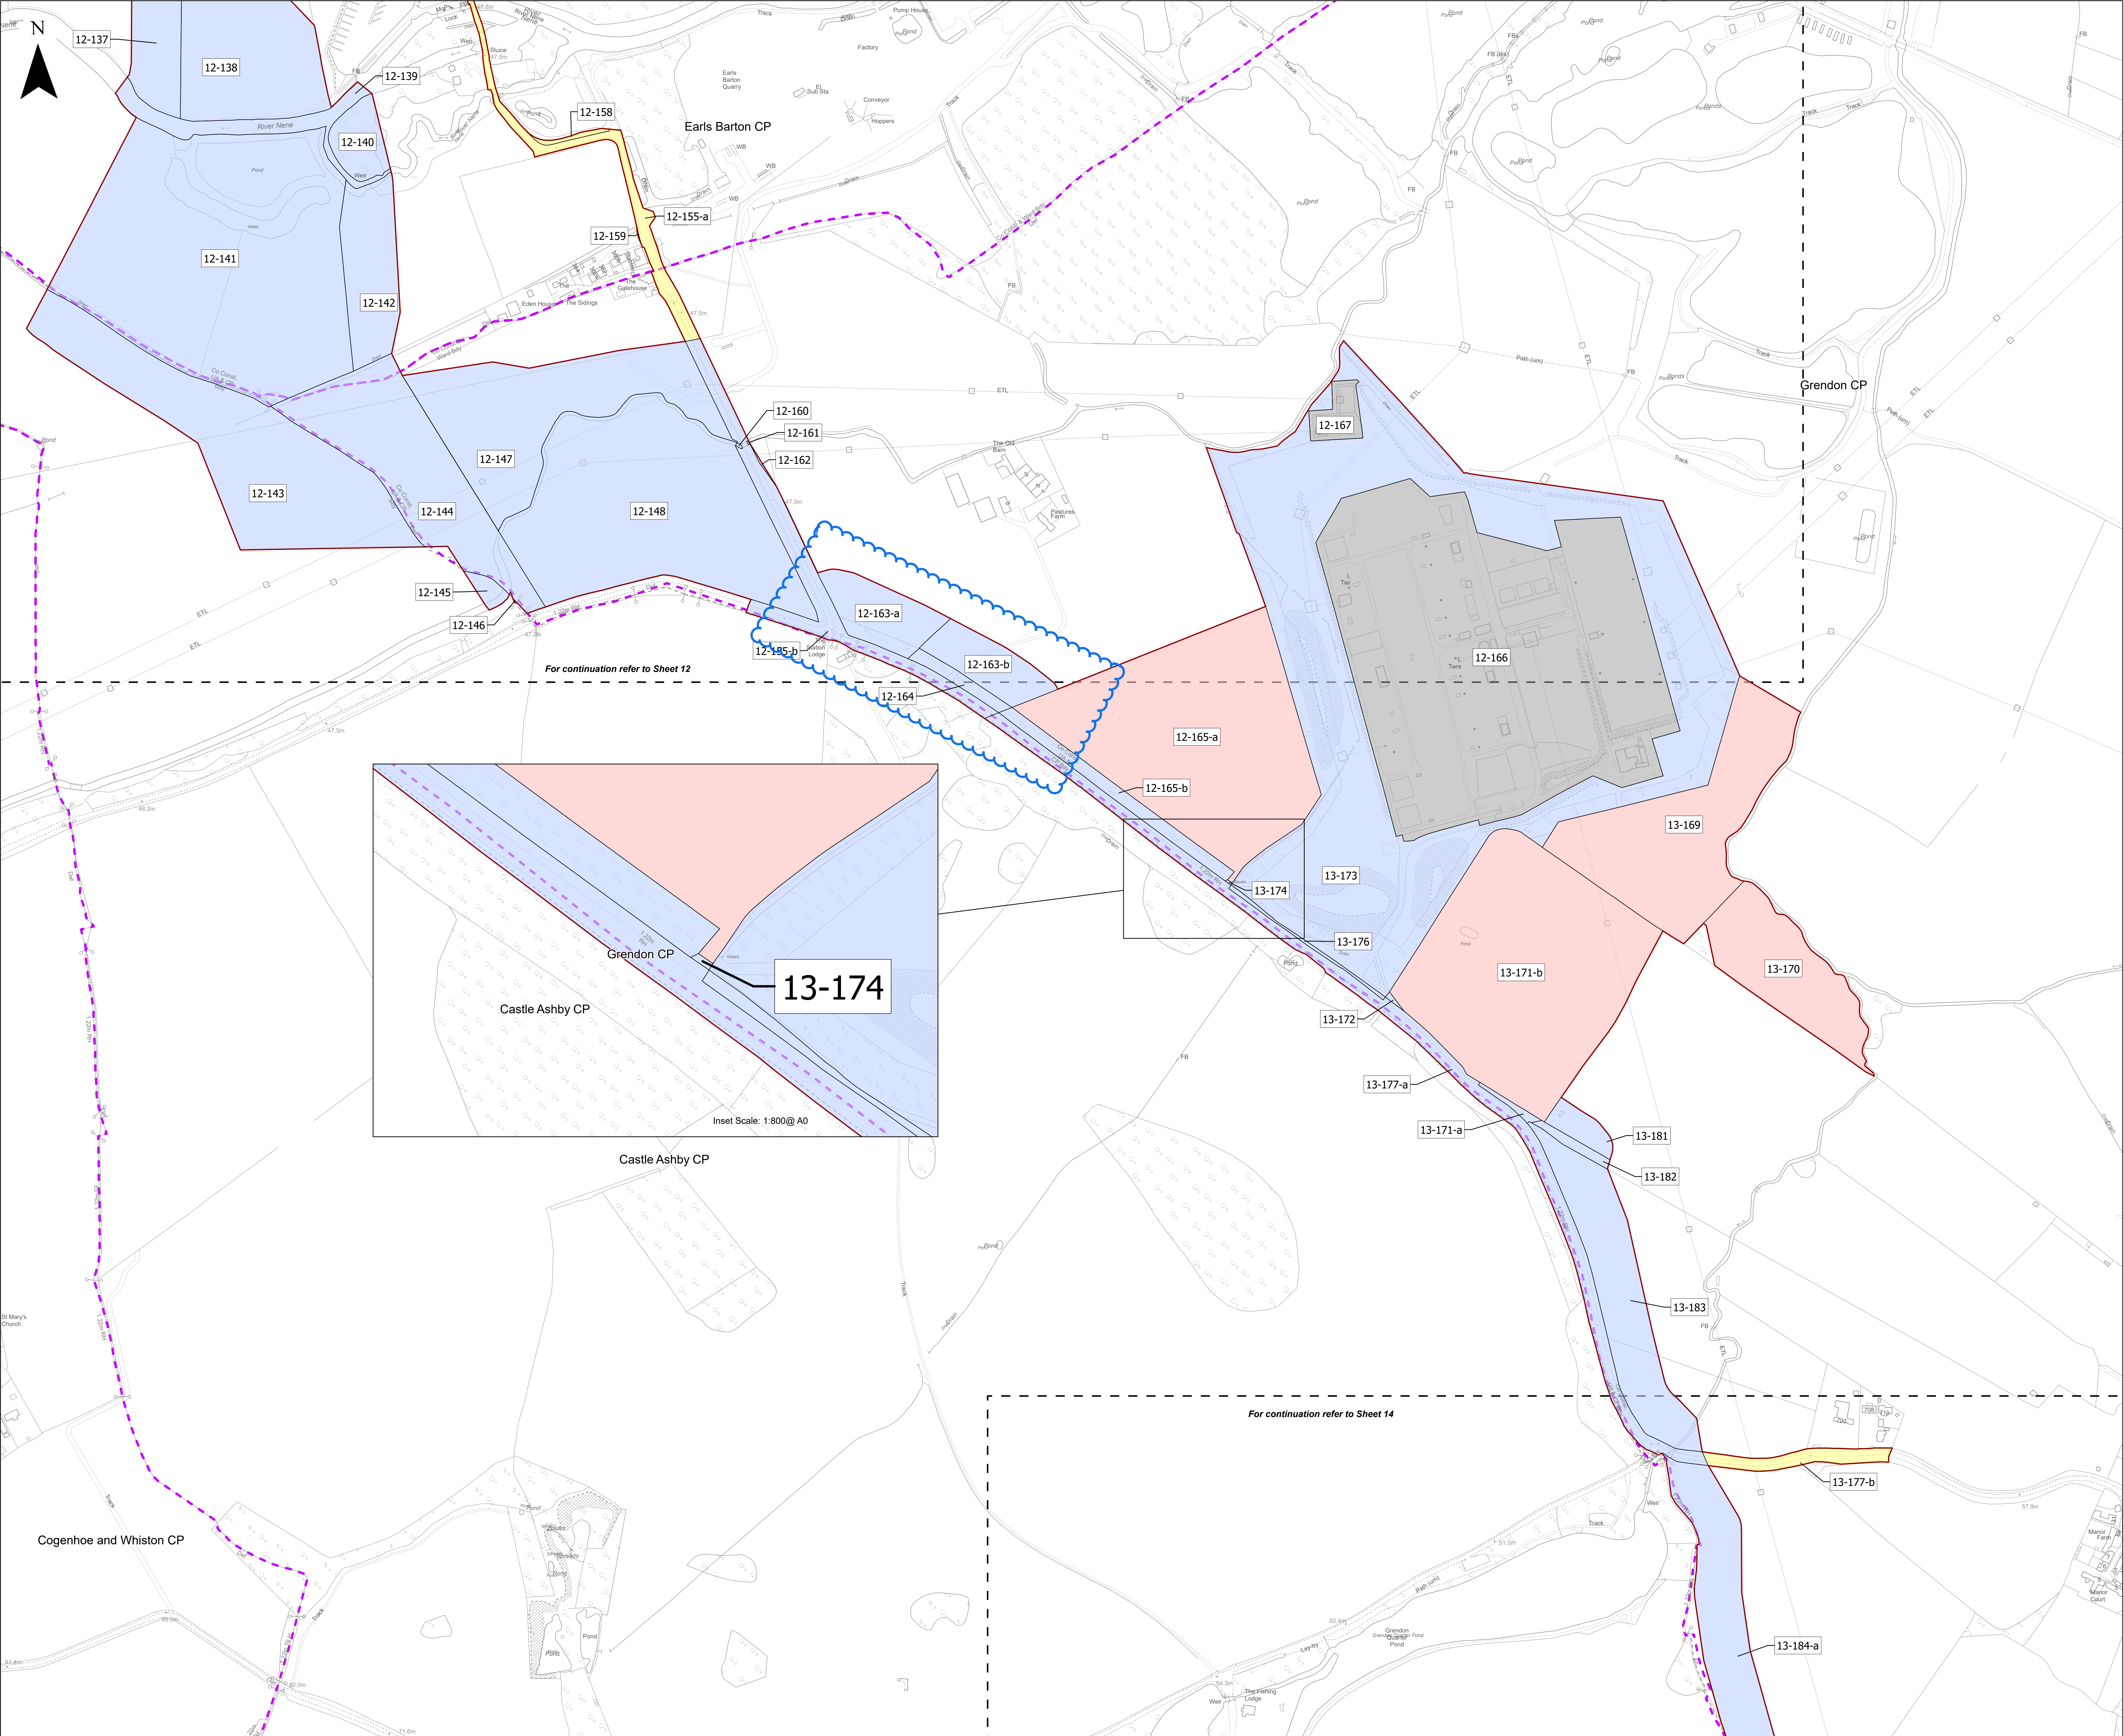



Key

- Order Limits
- Freehold to be compulsorily acquired and temporary use of land and in relation to which it is proposed that easements, servitudes and other private rights will cease to have effect
- Temporary use of land and in relation to which it is proposed to temporarily suspend easements, servitudes and other private rights
- New rights (including restrictions) to be compulsorily acquired and temporary use of land and in relation to which it is proposed that easements, servitudes and other private rights will be suspended or cease to have effect
- No Land Take
- Local Authority / Parish Boundary
- Cut Line

Base map: © Crown Copyright and database rights 2025 OS Licence no. AC000849896. All rights reserved.



0 100 200 300 400 Metres

Scale: 1:2,500@ A0


APFP Regulation: 5(2)(i)	Application Doc No. EX1/GH2.2_B
Ref: IGP_GH_DCO_Land_Plan	Date: 06/11/2025
Drawn by: DLG	Checked by: AT

Land Plan
Revision B
Sheet 13 of 18



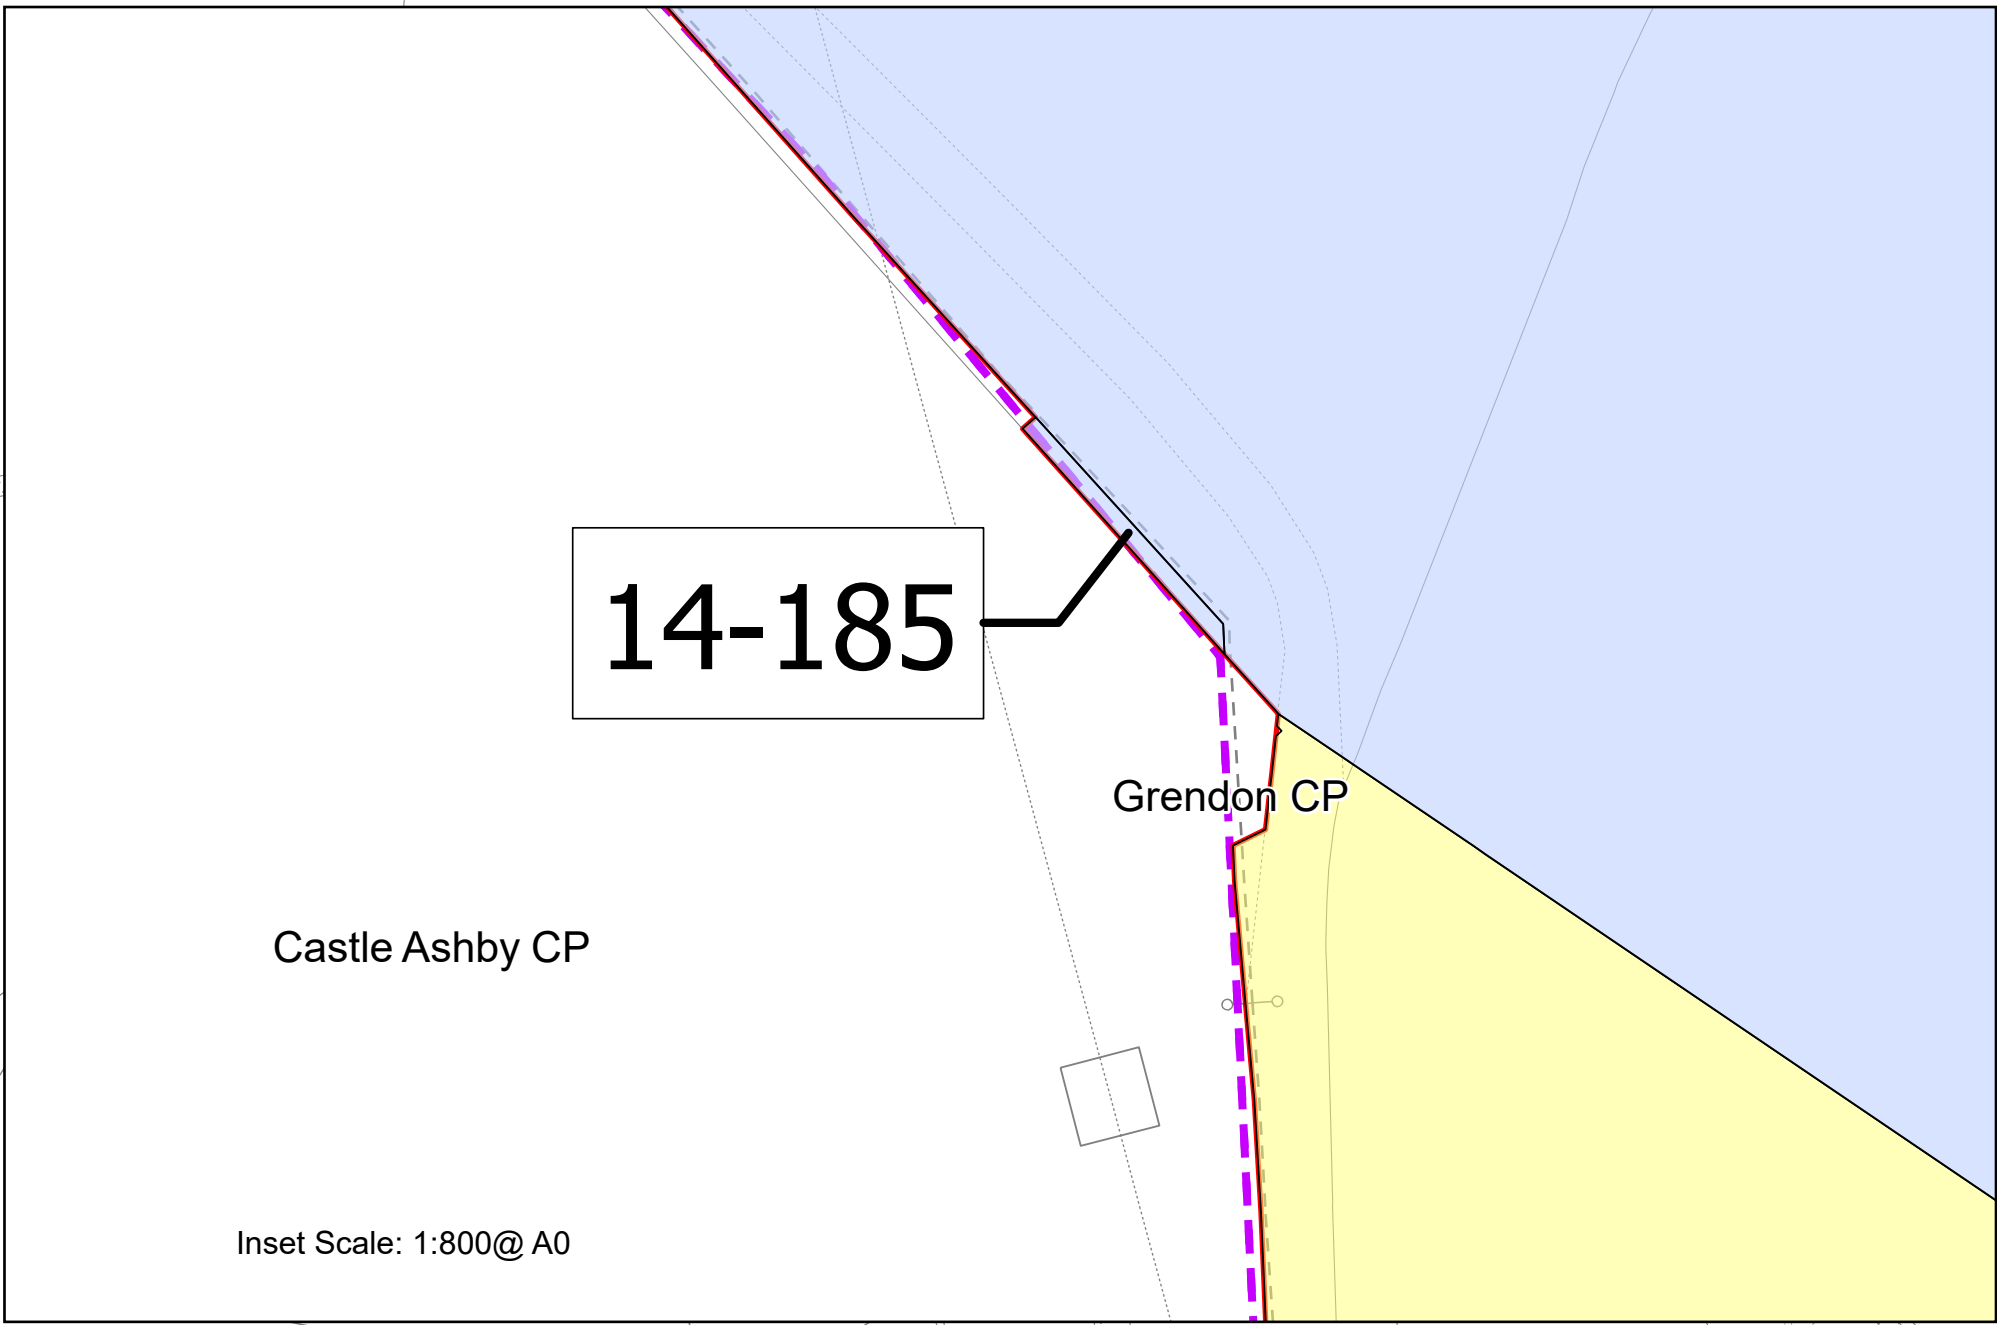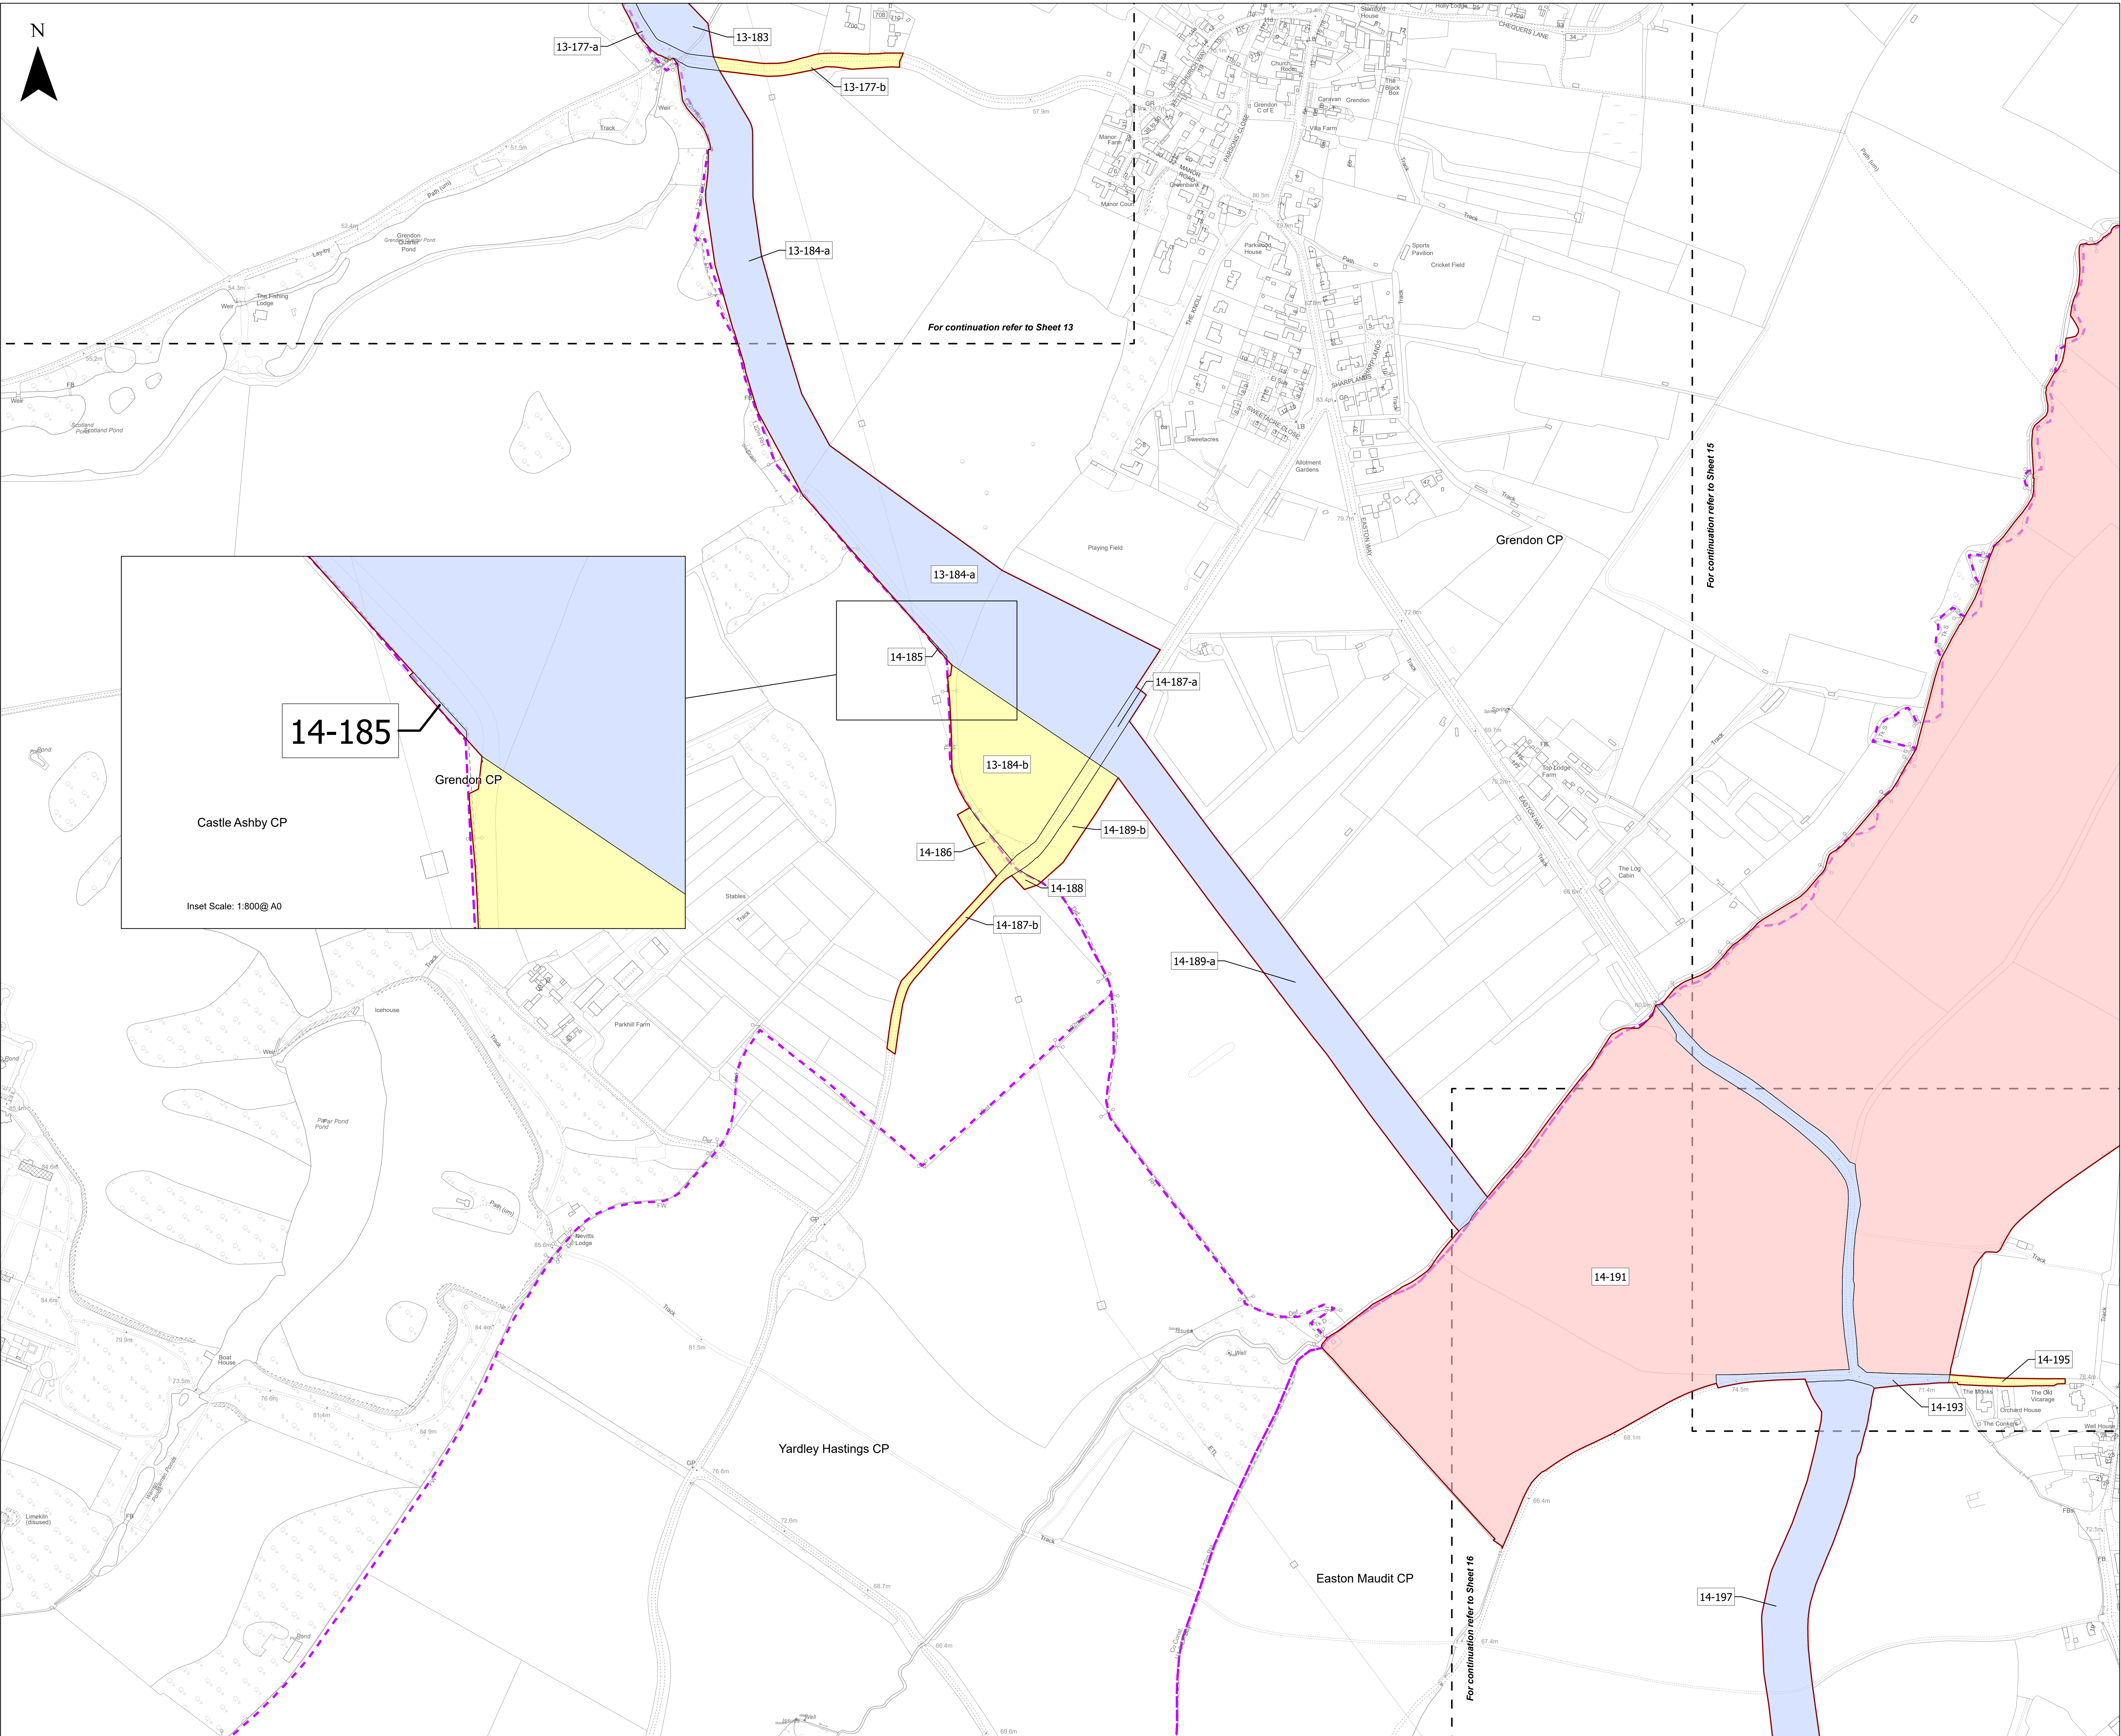


- Key**
- Order Limits
 - Freehold to be compulsorily acquired and temporary use of land and in relation to which it is proposed that easements, servitudes and other private rights will cease to have effect
 - Temporary use of land and in relation to which it is proposed to temporarily suspend easements, servitudes and other private rights
 - New rights (including restrictions) to be compulsorily acquired and temporary use of land and in relation to which it is proposed that easements, servitudes and other private rights will be suspended or cease to have effect
 - No Land Take
 - Local Authority / Parish Boundary
 - Cut Line

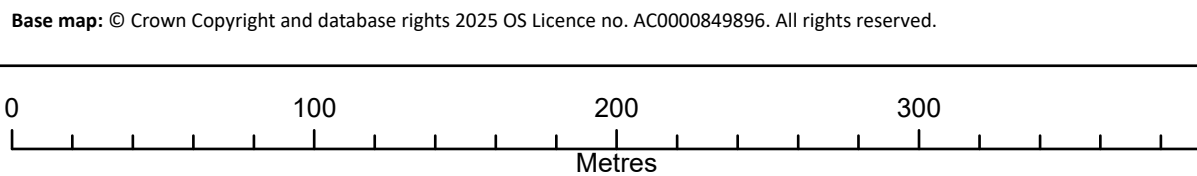

Scale: 1:2,500@ A0

APFP Regulation: 5(2)(i)	Application Doc No. EX1/GH2.2_B
Ref: IGP_GH_DCO_Land_Plan	Date: 28/10/2025
Drawn by: DLG	Checked by: AT

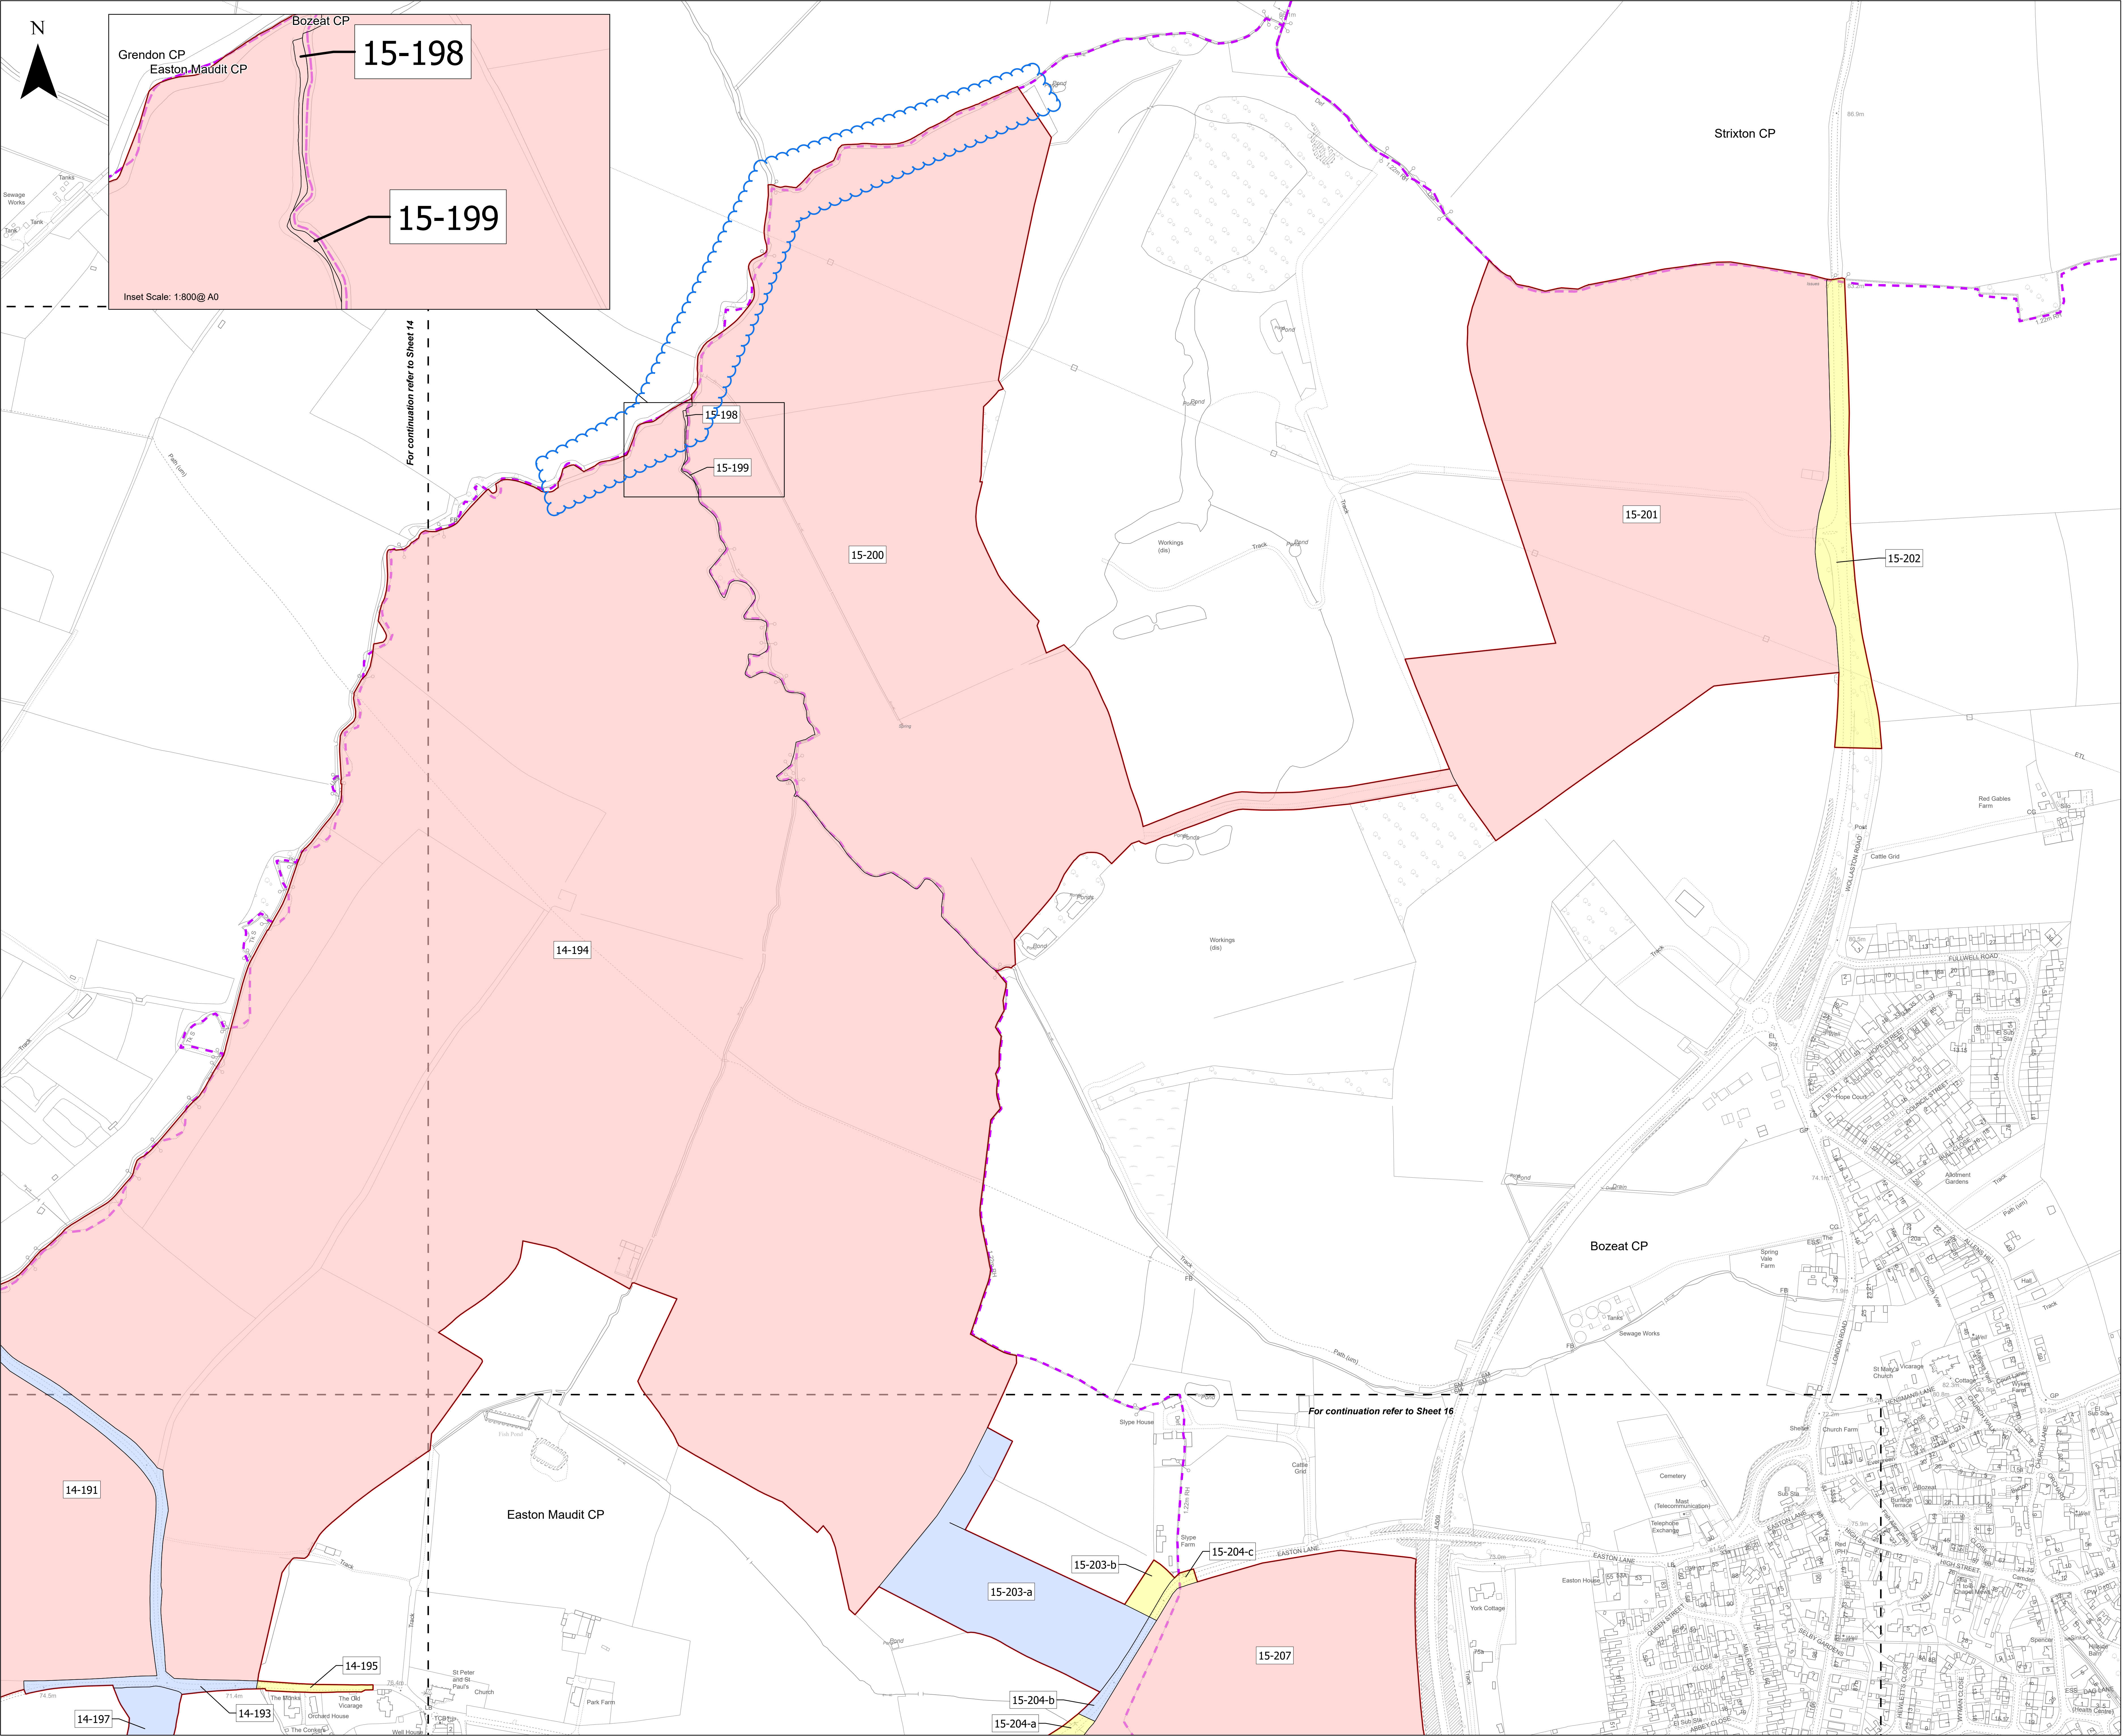



Key

- Order Limits
- Freehold to be compulsorily acquired and temporary use of land and in relation to which it is proposed that easements, servitudes and other private rights will cease to have effect
- Temporary use of land and in relation to which it is proposed to temporarily suspend easements, servitudes and other private rights
- New rights (including restrictions) to be compulsorily acquired and temporary use of land and in relation to which it is proposed that easements, servitudes and other private rights will be suspended or cease to have effect
- No Land Take
- Local Authority / Parish Boundary
- Cut Line

Base map: © Crown Copyright and database rights 2025 OS Licence no. AC000849896. All rights reserved.



0 100 200 300 400 Metres

Scale: 1:2,500@A0

APFP Regulation: 5(2)(i)	Application Doc No. EX1/GH2.2_B
Ref: IGP_GH_DCO_Land_Plan	Date: 28/10/2025
Drawn by: DLG	Checked by: AT


Land Plan
Revision B
Sheet 15 of 18



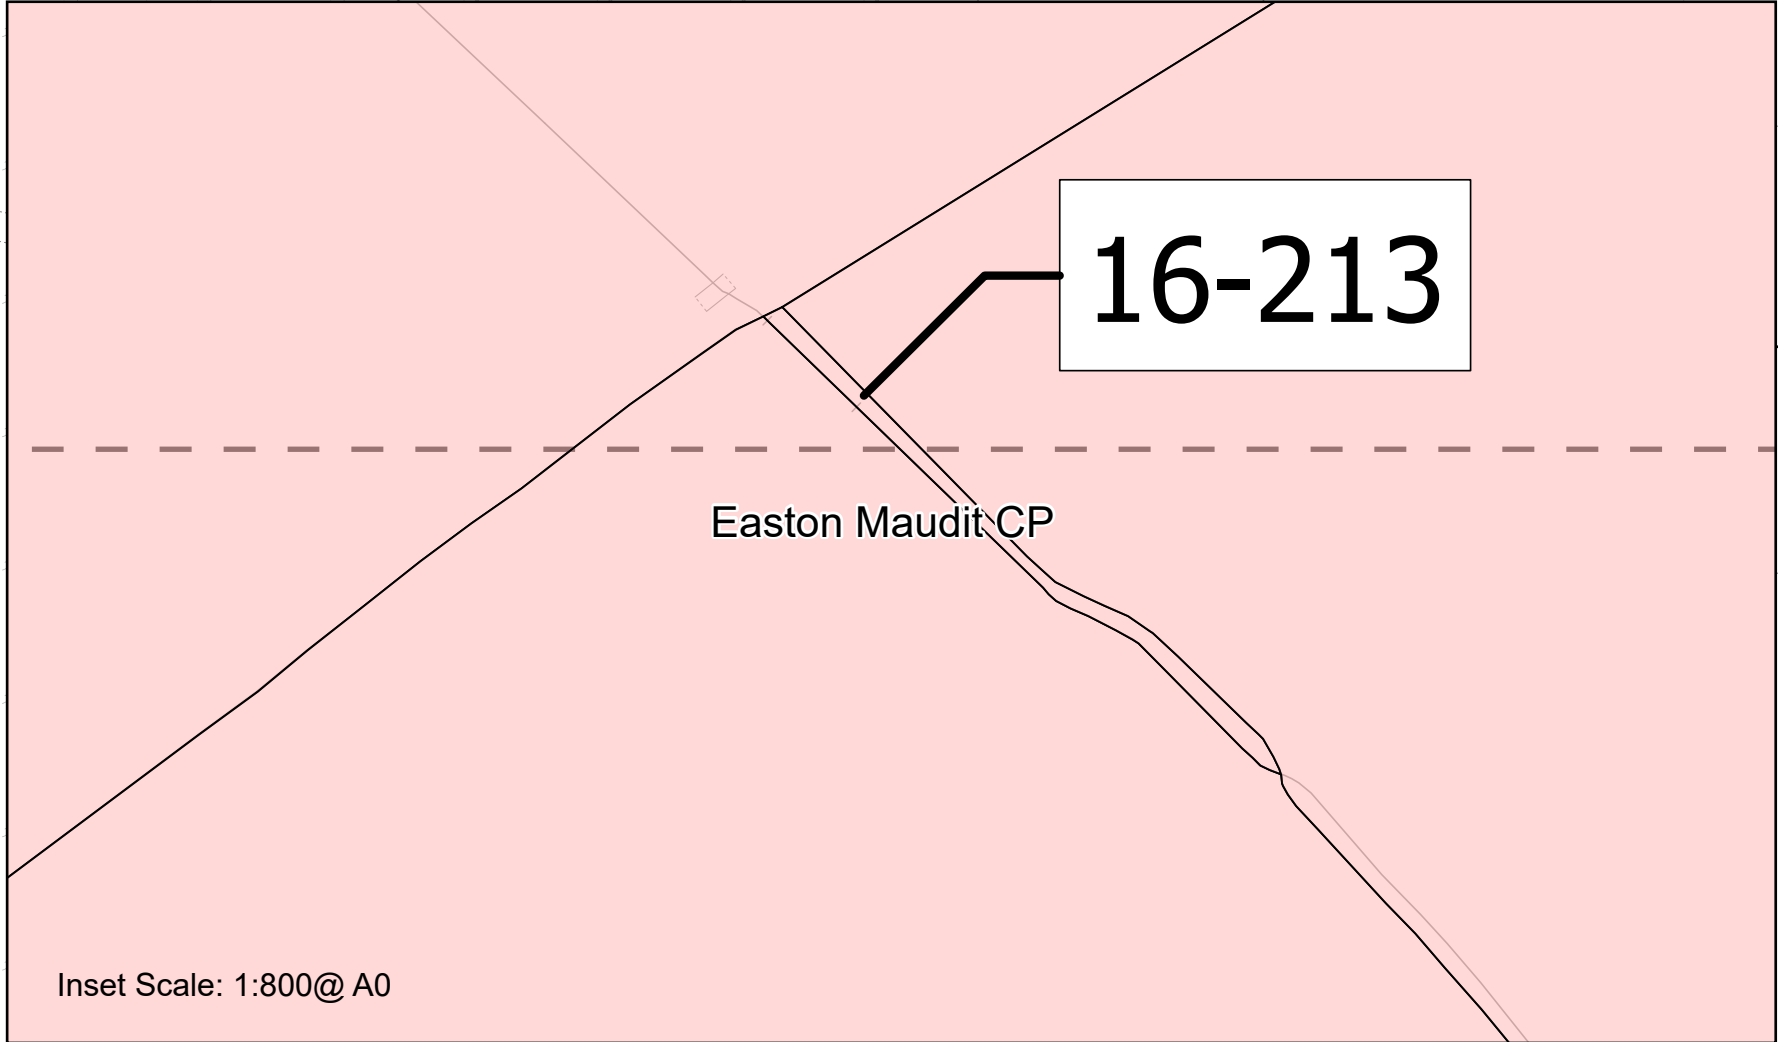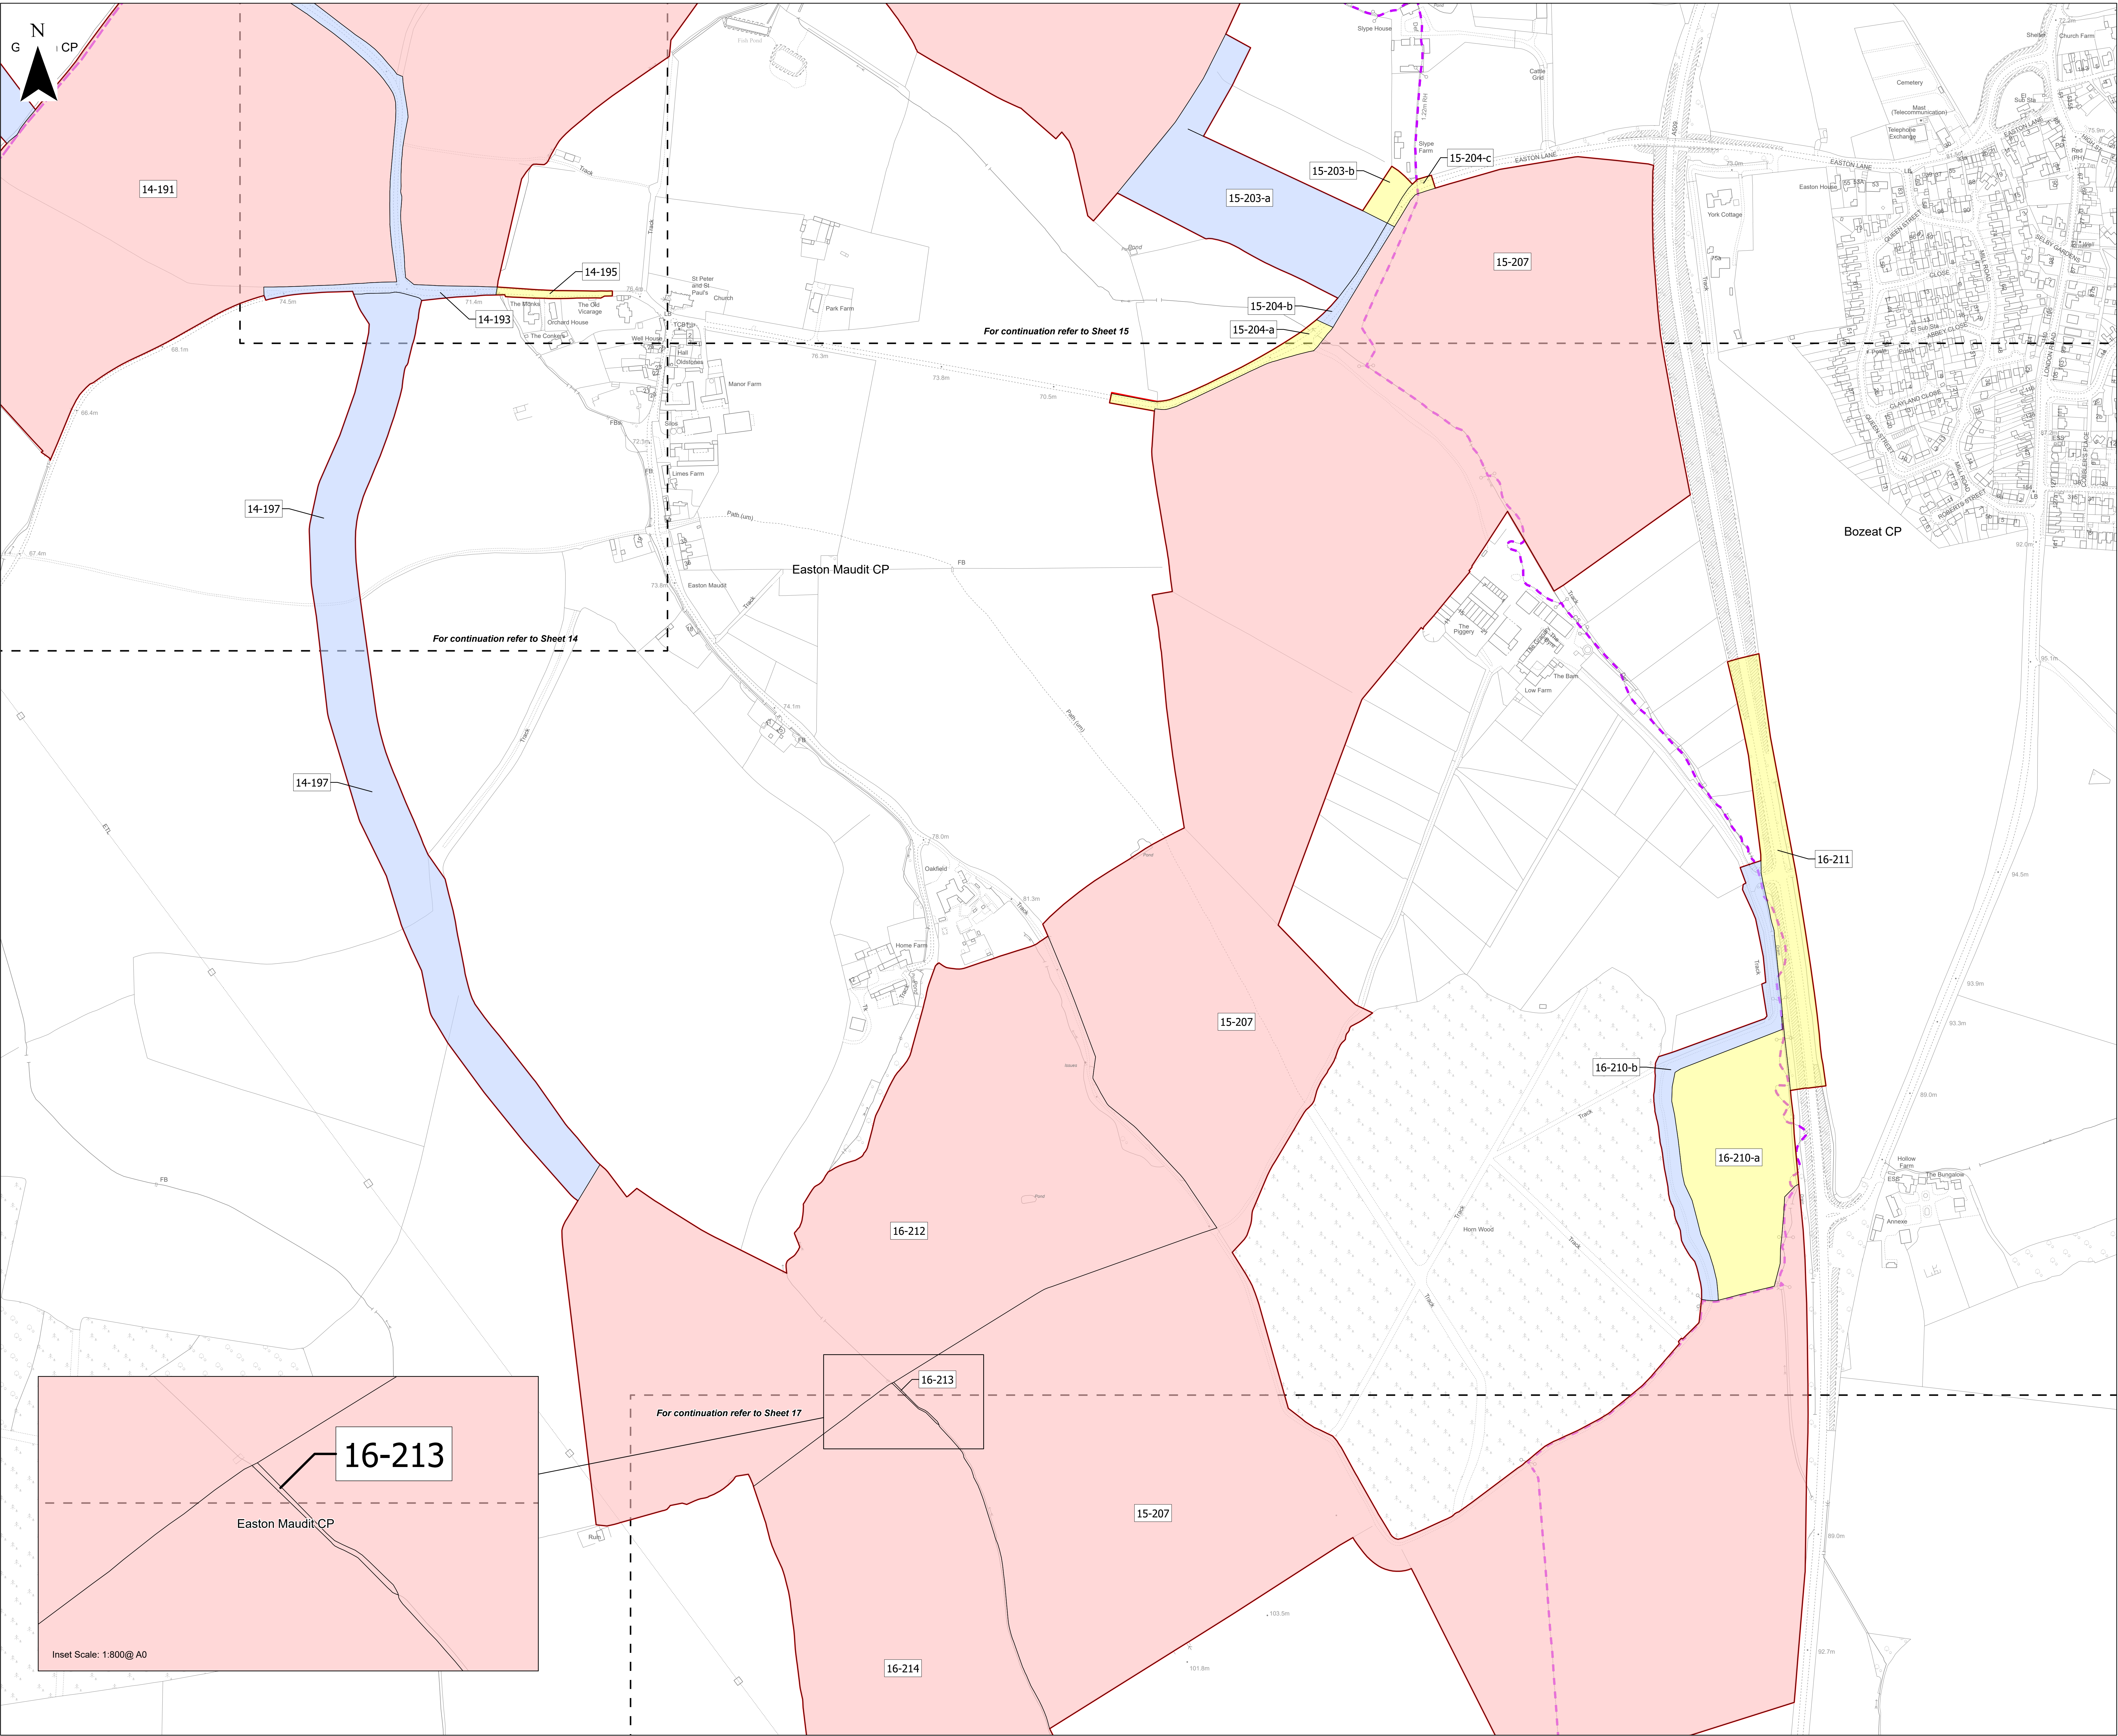


- Key**
- Order Limits
 - Freehold to be compulsorily acquired and temporary use of land and in relation to which it is proposed that easements, servitudes and other private rights will cease to have effect
 - Temporary use of land and in relation to which it is proposed to temporarily suspend easements, servitudes and other private rights
 - New rights (including restrictions) to be compulsorily acquired and temporary use of land and in relation to which it is proposed that easements, servitudes and other private rights will be suspended or cease to have effect
 - No Land Take
 - Local Authority / Parish Boundary
 - Cut Line

Base map: © Crown Copyright and database rights 2025 OS Licence no. AC000849896. All rights reserved.

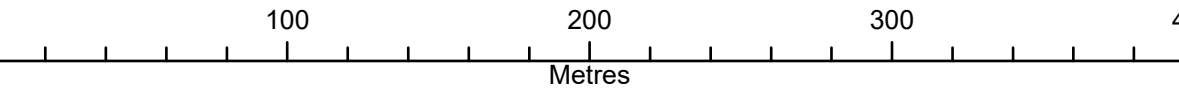


APFP Regulation: 5(2)(i)	Application Doc No. EX1/GH2.2_B
Ref: IGP_GH_DCO_Land_Plan	Date: 28/10/2025
Drawn by: DLG	Checked by: AT

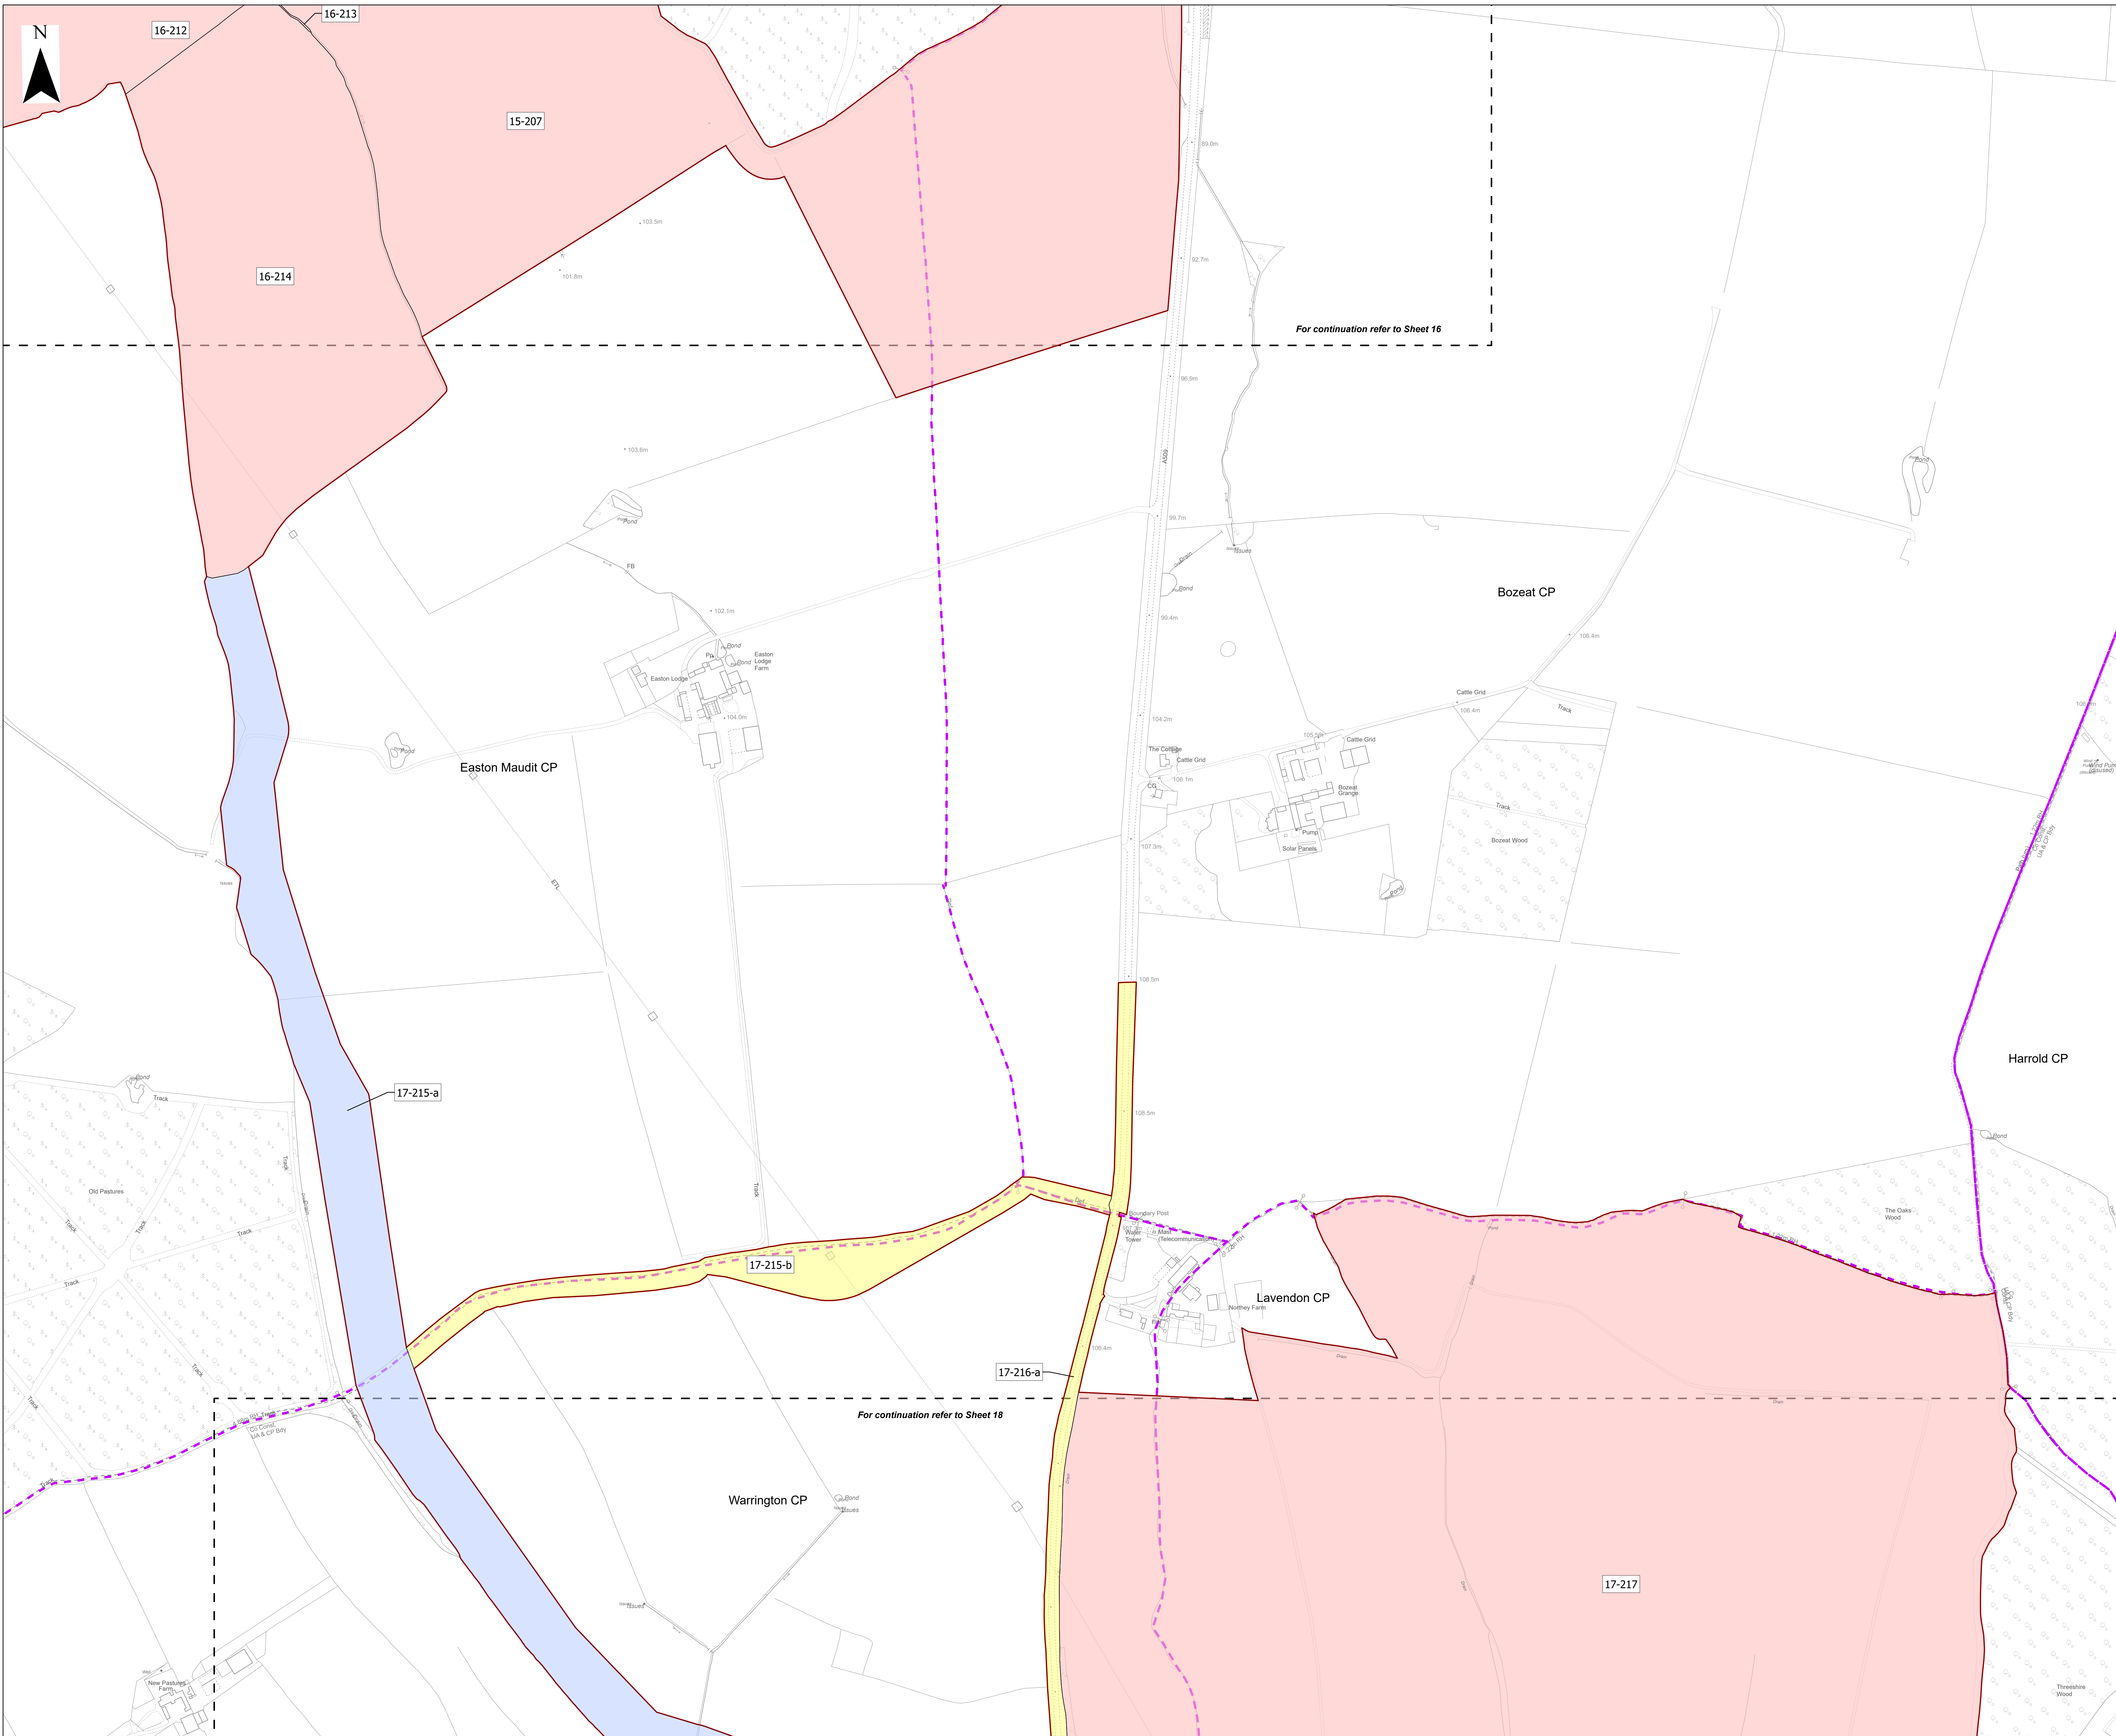

Key

-  **Order Limits**
-  Freehold to be compulsorily acquired and temporary use of land and in relation to which it is proposed that easements, servitudes and other private rights will cease to have effect
-  Temporary use of land and in relation to which it is proposed to temporarily suspend easements, servitudes and other private rights
-  New rights (including restrictions) to be compulsorily acquired and temporary use of land and in relation to which it is proposed that easements, servitudes and other private rights will be suspended or cease to have effect
-  No Land Take
-  Local Authority / Parish Boundary
-  Cut Line

Base map: © Crown Copyright and database rights 2025 OS Licence no. AC0000849896. All rights reserved.

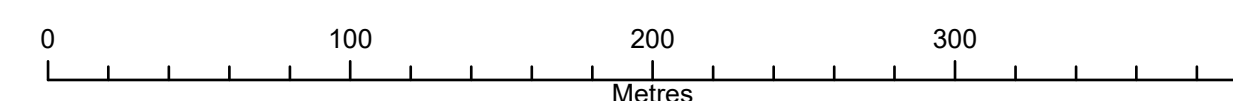


Scale: 1:2,500@ A0

APFP Regulation: 5(2)(i)	Application Doc No. EX1/GH2.2_B
Ref: IGP_GH_DCO_Land_Plan	Date: 28/10/2025
Drawn by: DLG	Checked by: AT

Land Plan
Revision B
Sheet 17 of 18



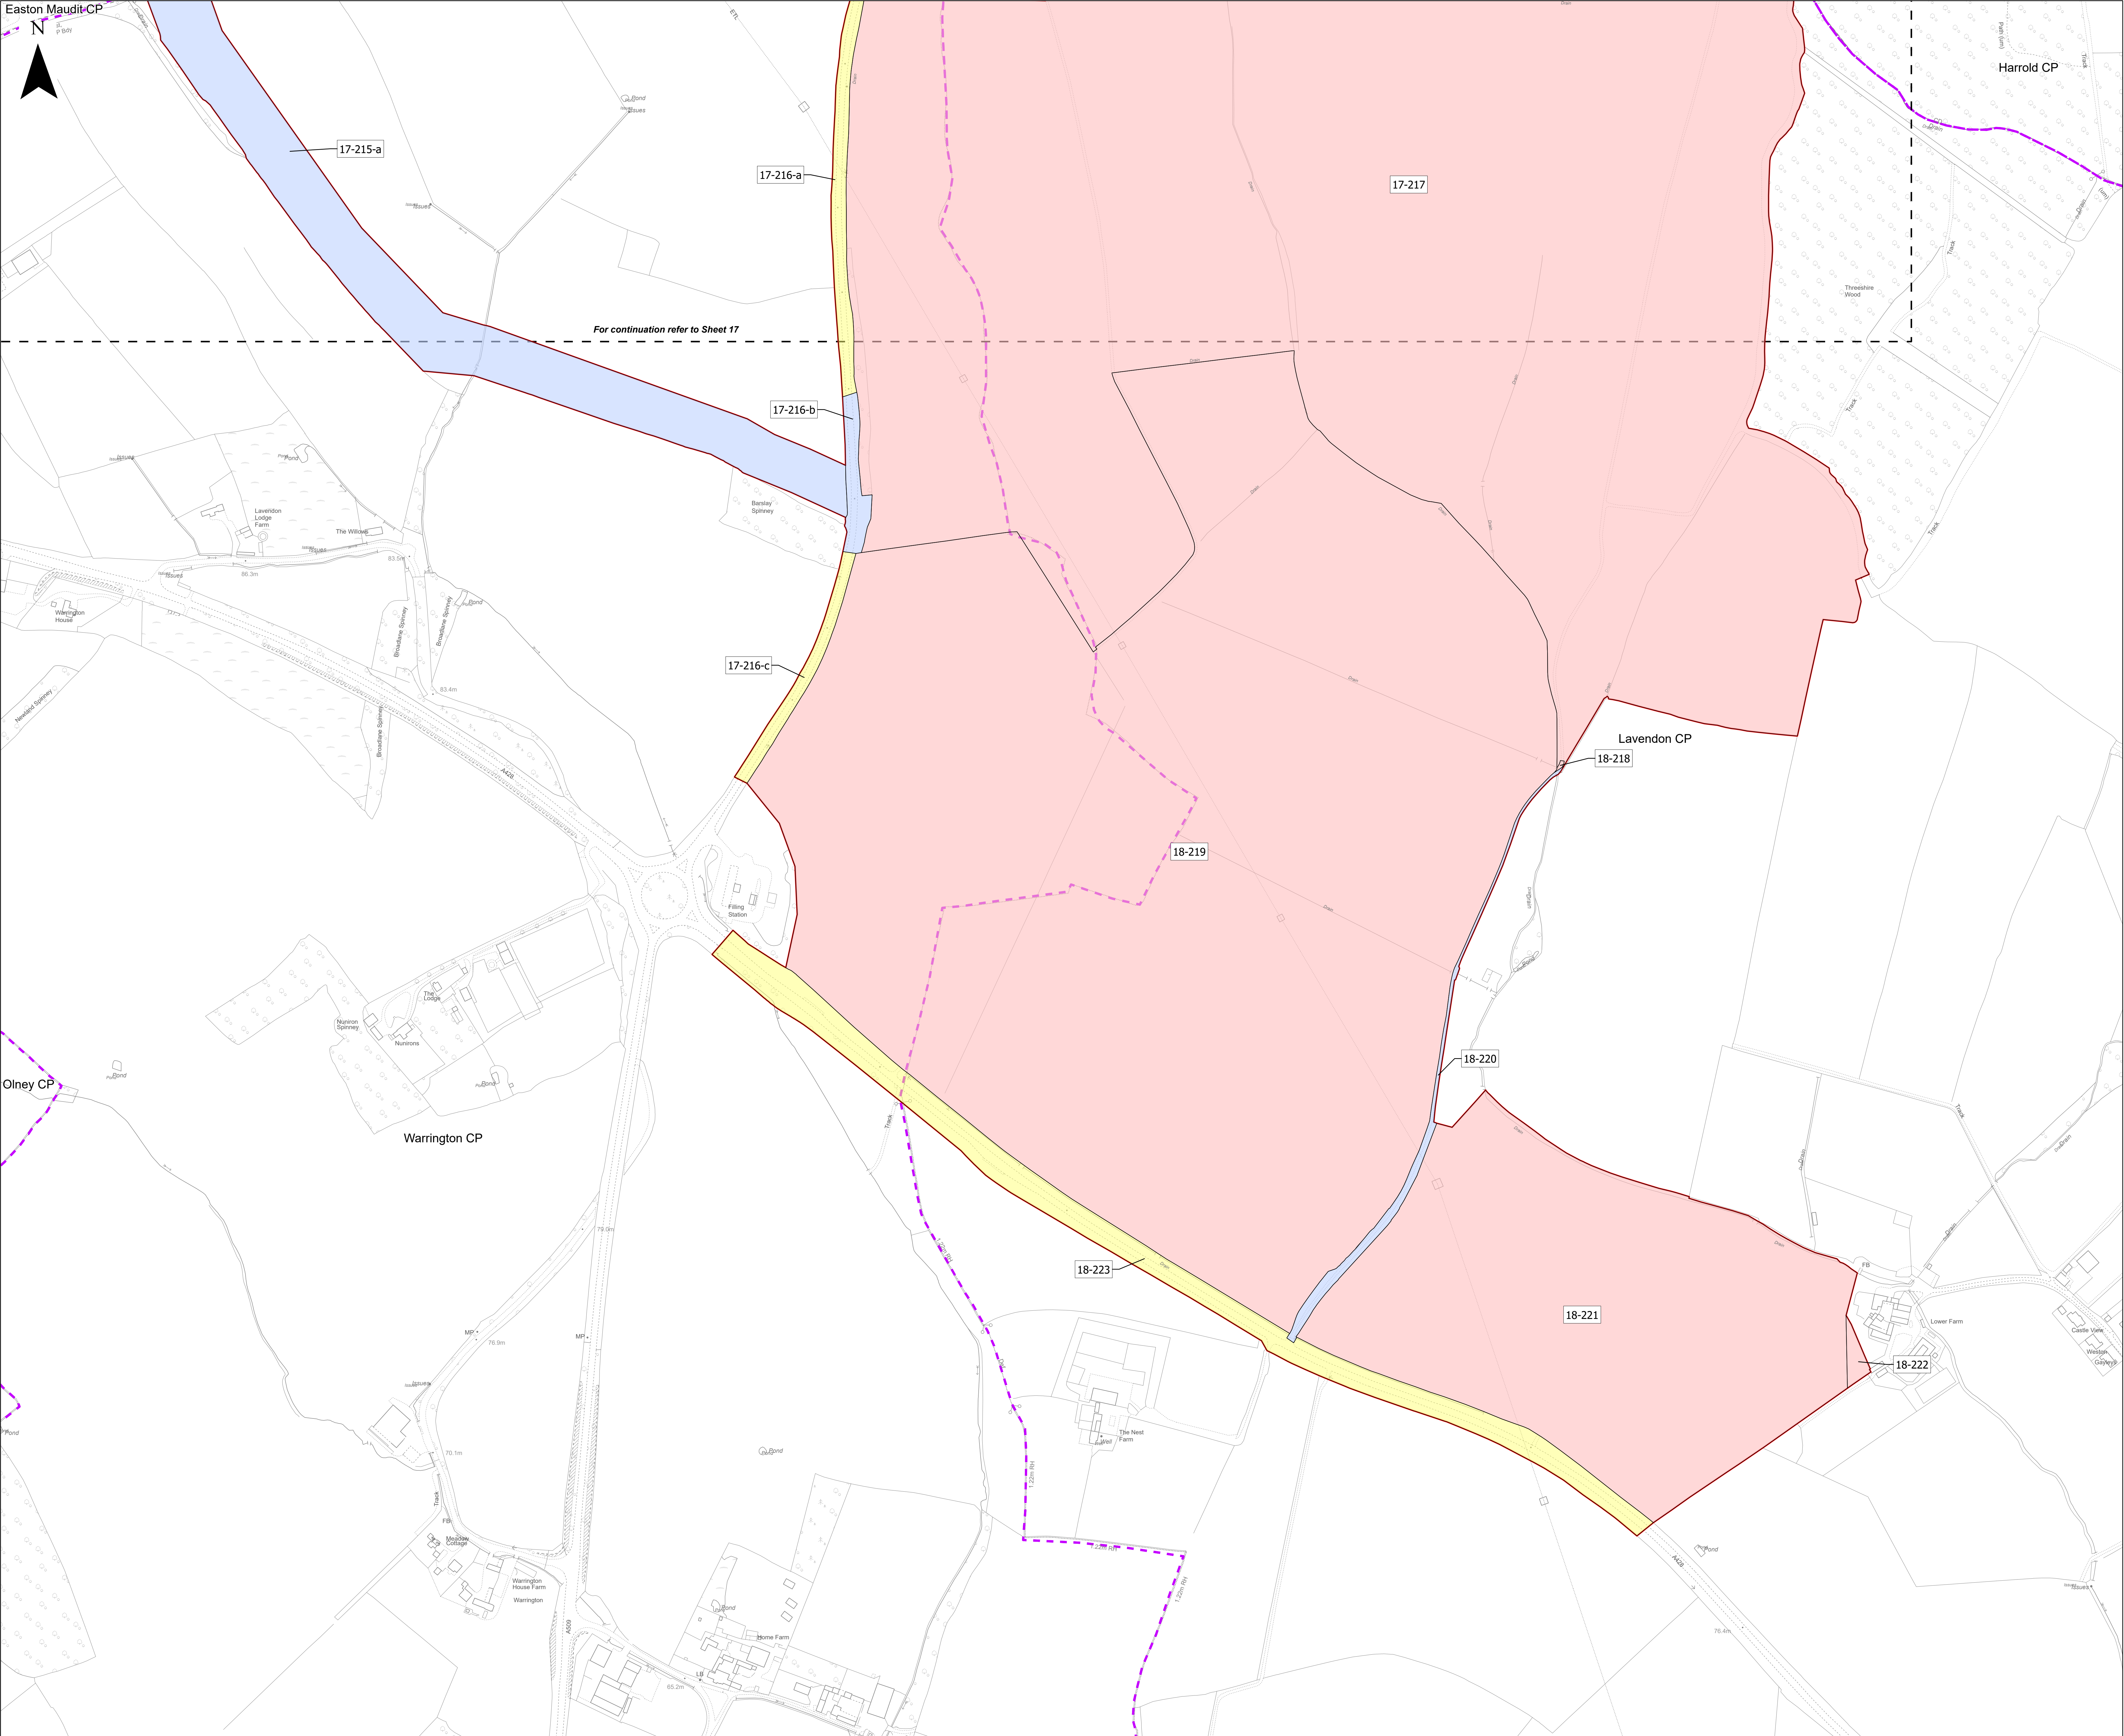



Key

- Order Limits
- Freehold to be compulsorily acquired and temporary use of land and in relation to which it is proposed that easements, servitudes and other private rights will cease to have effect
- Temporary use of land and in relation to which it is proposed to temporarily suspend easements, servitudes and other private rights
- New rights (including restrictions) to be compulsorily acquired and temporary use of land and in relation to which it is proposed that easements, servitudes and other private rights will be suspended or cease to have effect
- No Land Take
- Local Authority / Parish Boundary
- Cut Line

Base map: © Crown Copyright and database rights 2025 OS Licence no. AC0000849896. All rights reserved.

0 100 200 300 400 Metres

Scale: 1:2,500@ A0

APFP Regulation: 5(2)(i)	Application Doc No. EX1/GH2.2_B
Ref: IGP_GH_DCO_Land_Plan	Date: 28/10/2025
Drawn by: DLG	Checked by: AT

Land Plan
Revision B
Sheet 18 of 18

