Green Hill Solar Farm

EN010170

Hedgerow and Tree Protection Order Plan

Revision A (Tracked)

Prepared by: Lanpro

Date: ~~May~~ November 2025

Document Reference: ~~APP~~CR1/GH2.11_A

APFP Regulation 5(2)(q)

Schedule of Changes

Figure Reference	**Page**	**Description of Changes**	**Reason for Revision**
[cover]		Updated document reference to Revision A	As required for submission of Change Application.
All Sheets	3-21	Updated document references and annotations	As required for submission of Change Application.
Sheet 1	4	Order Limits extended	Presentation of Change 1 requested in Change Application **[EN010170/CR1/GH9.2]**
Sheet 3	6	Order Limits extended	Presentation of Change 3 requested in Change Application **[EN010170/CR1/GH9.2]**
Sheet 8	11	Order Limits extended	Presentation of Change 6 requested in Change Application **[EN010170/CR1/GH9.2]**
Sheet 9	12	Order Limits extended	Presentation of Change 6 requested in Change Application **[EN010170/CR1/GH9.2]**
Sheet 12	15	Order Limits extended Length of hedgerow CR5aB47 extended Length of hedgerow CR5aB48 extended	Presentation of Change 7 requested in Change Application **[EN010170/CR1/GH9.2]**
Sheet 15	18	Order Limits reduced	Presentation of Change 8 requested in Change Application **[EN010170/CR1/GH9.2]**
Sheet 16	19	Order Limits reduced	Presentation of Change 9 requested in Change Application **[EN010170/CR1/GH9.2]**
Sheet 17	20	Order Limits reduced	Presentation of Change 9 requested in Change Application **[EN010170/CR1/GH9.2]**

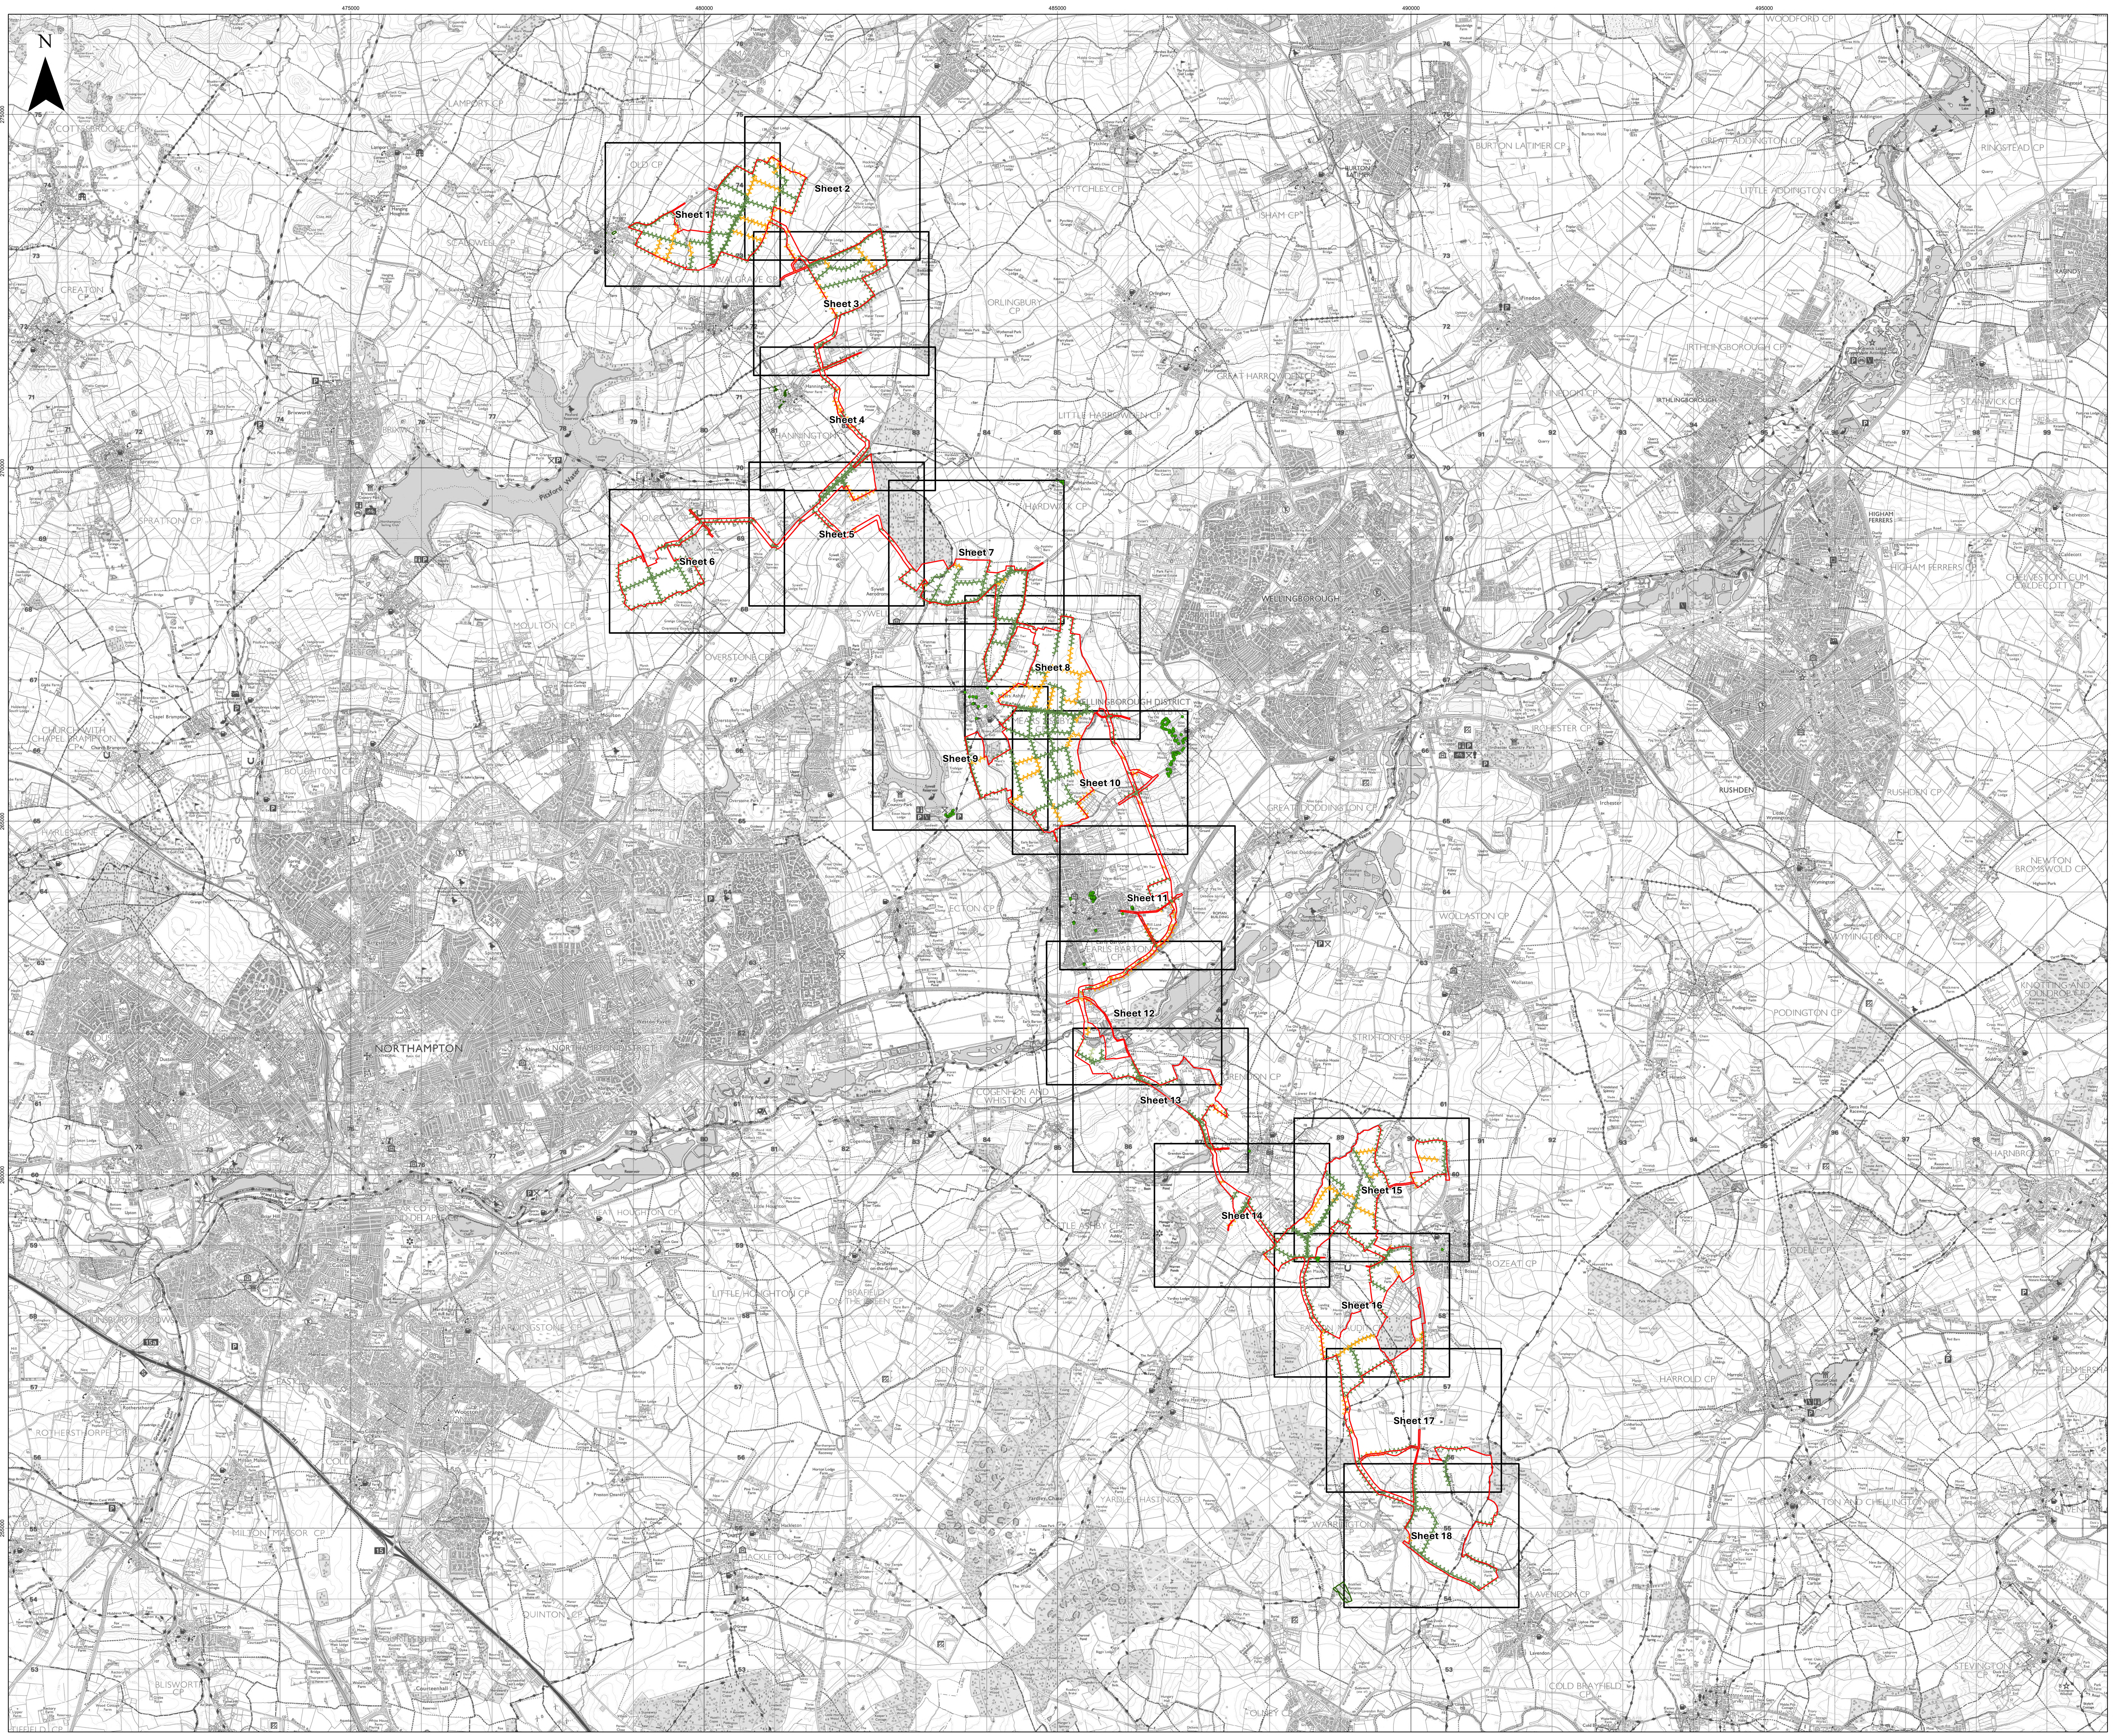
N
475000
480000
485000
490000
495000
270000
265000
260000
255000
Sheet 1
Sheet 2
Sheet 3
Sheet 4
Sheet 5
Sheet 6
Sheet 7
Sheet 8
Sheet 9
Sheet 10
Sheet 11
Sheet 12
Sheet 13
Sheet 14
Sheet 15
Sheet 16
Sheet 17
Sheet 18
NORTHAMPTON
WELLINGBOROUGH
BURTON LATIMER CP
IRTHLINGBOROUGH CP
HIGHAM FERRERS CP
RUSHDEN CP
WOLLASTON CP
EARLS BARTON CP
SYWELL
HARDWICK CP
WELLINGBOROUGH DISTRICT
GREAT DODDINGTON CP
STRIXTON CP
BOZEAT CP
HARROLD CP
LAVENDON CP
COLD BRAYFIELD
YARDLEY HASTINGS CP
DENTON CP
CASTLE ASHBY CP
COGENHOE AND WHISTON CP
GRENDON CP
OLD CP
WALGRAVE CP
ORLINGBURY CP
LITTLE HARROWDEN CP
GREAT HARROWDEN CP
HANNINGTON CP
HOLCOT CP
MOULTON CP
OVERSTONE CP
ISHAM CP
PYTCHLEY CP
FINEDON CP
LAMPORT CP
SCALDWELL CP
BRIXWORTH CP
SPRATTON CP
CREATON CP
COTTESBROOKE CP
CHAPEL BRAMPTON CP
BOUGHTON CP
HARLESTONE CP
BRAFIELD ON THE GREEN CP
LITTLE HOUGHTON CP
HACKLETON CP
QUINTON CP
MILTON MALSOR CP
ROTHERSTHORPE CP
BLISWORTH CP
WOODFORD CP
GREAT ADDINGTON CP
LITTLE ADDINGTON CP
RINGSTEAD CP
STANWICK CP
CHELVESTON CUM CALDECOTT CP
NEWTON BROMSWOLD CP
KNOTTING AND SOULDROP CP
PODINGTON CP
WYMINGTON CP
SHARNBROOK CP
IRCHESTER CP
STEVINGTON CP
Pitsford Water

Island GREEN POWER

Lanpro

Key

- 🟥 Order Limits
- ▭ Sheet Index
- Important Hedgerow
- Potentially Important Hedgerow
- Hedgerow

Tree Protection Order (TPO)

- ● Points
- ▨ Group

Layers: Lanpro, 2025; IGP, 2025

0 1 2 3 4 Kilometers

Scale: 1:30,000@ A0

APFP Regulation: 5(2)(q)	Application Doc No. CR1/GH2.11_B
Ref: P3535_LPR_ZZ_XX_DR_Z_0280	Date: 05/11/2025
Drawn by: BH	Checked by: JC

Hedgerow and Tree Protection Order Plan (Change Application Version)

Index Sheet

Revision B

GREEN HILL SOLAR FARM

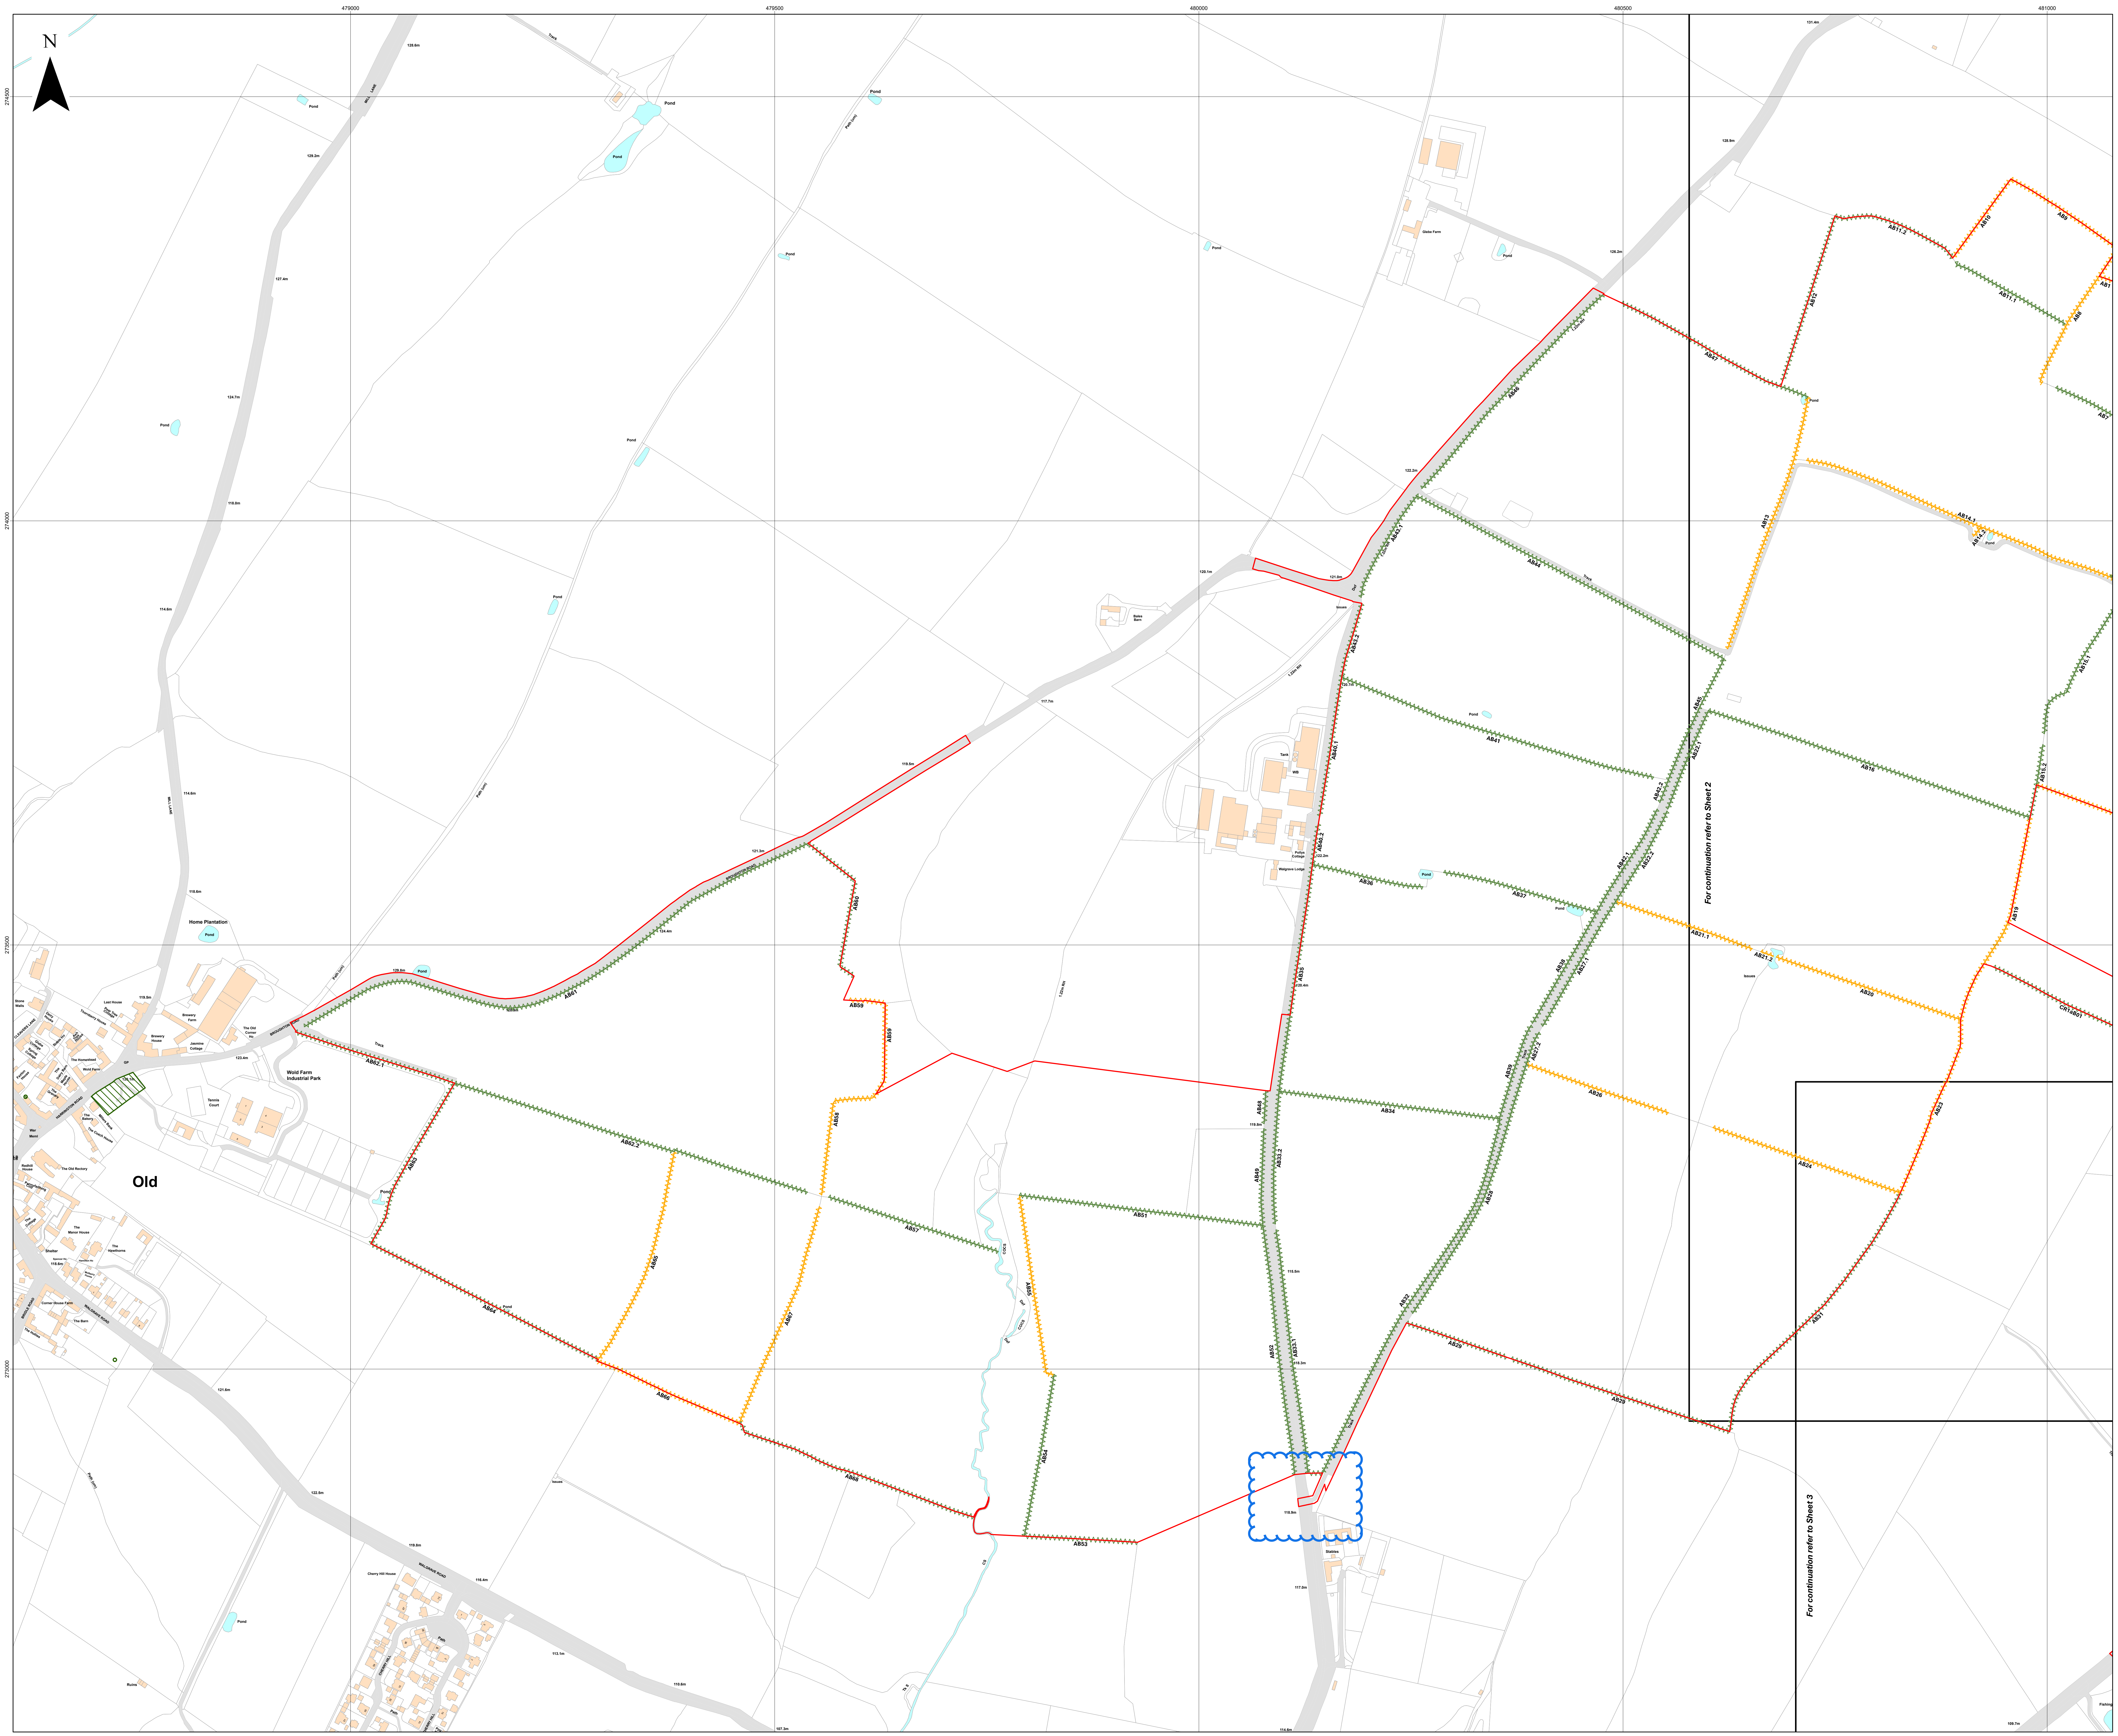
N
479000
479500
480000
480500
481000
Old
Home Plantation
Wold Farm Industrial Park
Pond
AB41
AB62.1
AB62.2
AB64
AB65
AB66
AB67
AB57
AB51
AB53
AB58
AB59
AB60
AB34
AB36
AB37
AB40
AB41
AB44
AB20
AB21.1
AB24
AB25
AB26
AB27
AB29
AB31
AB18
AB19
AB11.1
AB11.2
AB12
AB13
AB14.1
AB8
AB9
AB10
AB1
For continuation refer to Sheet 2
For continuation refer to Sheet 3

Key

- 🟥 Order Limits
- ⬛ Sheet Index
- Important Hedgerow
- Hedgerow

Tree Protection Order (TPO)

- ▨ Group

Layers: Lanpro, 2025; IGP, 2025
Base map: Reproduced from Ordnance Survey digital map data © Crown copyright 2025. All rights reserved. License number 0100031673

0 100 200 300 Meters

Scale: 1:2,500@ A0

APFP Regulation: 5(2)(q)	Application Doc No. CR1/GH2.11_B
Ref: P3535_LPR_ZZ_XX_DR_Z_0280	Date: 05/11/2025
Drawn by: BH	Checked by: JC

Important Hedgerows Plan (Change Request Version)

Sheet 1 of 18
Revision B

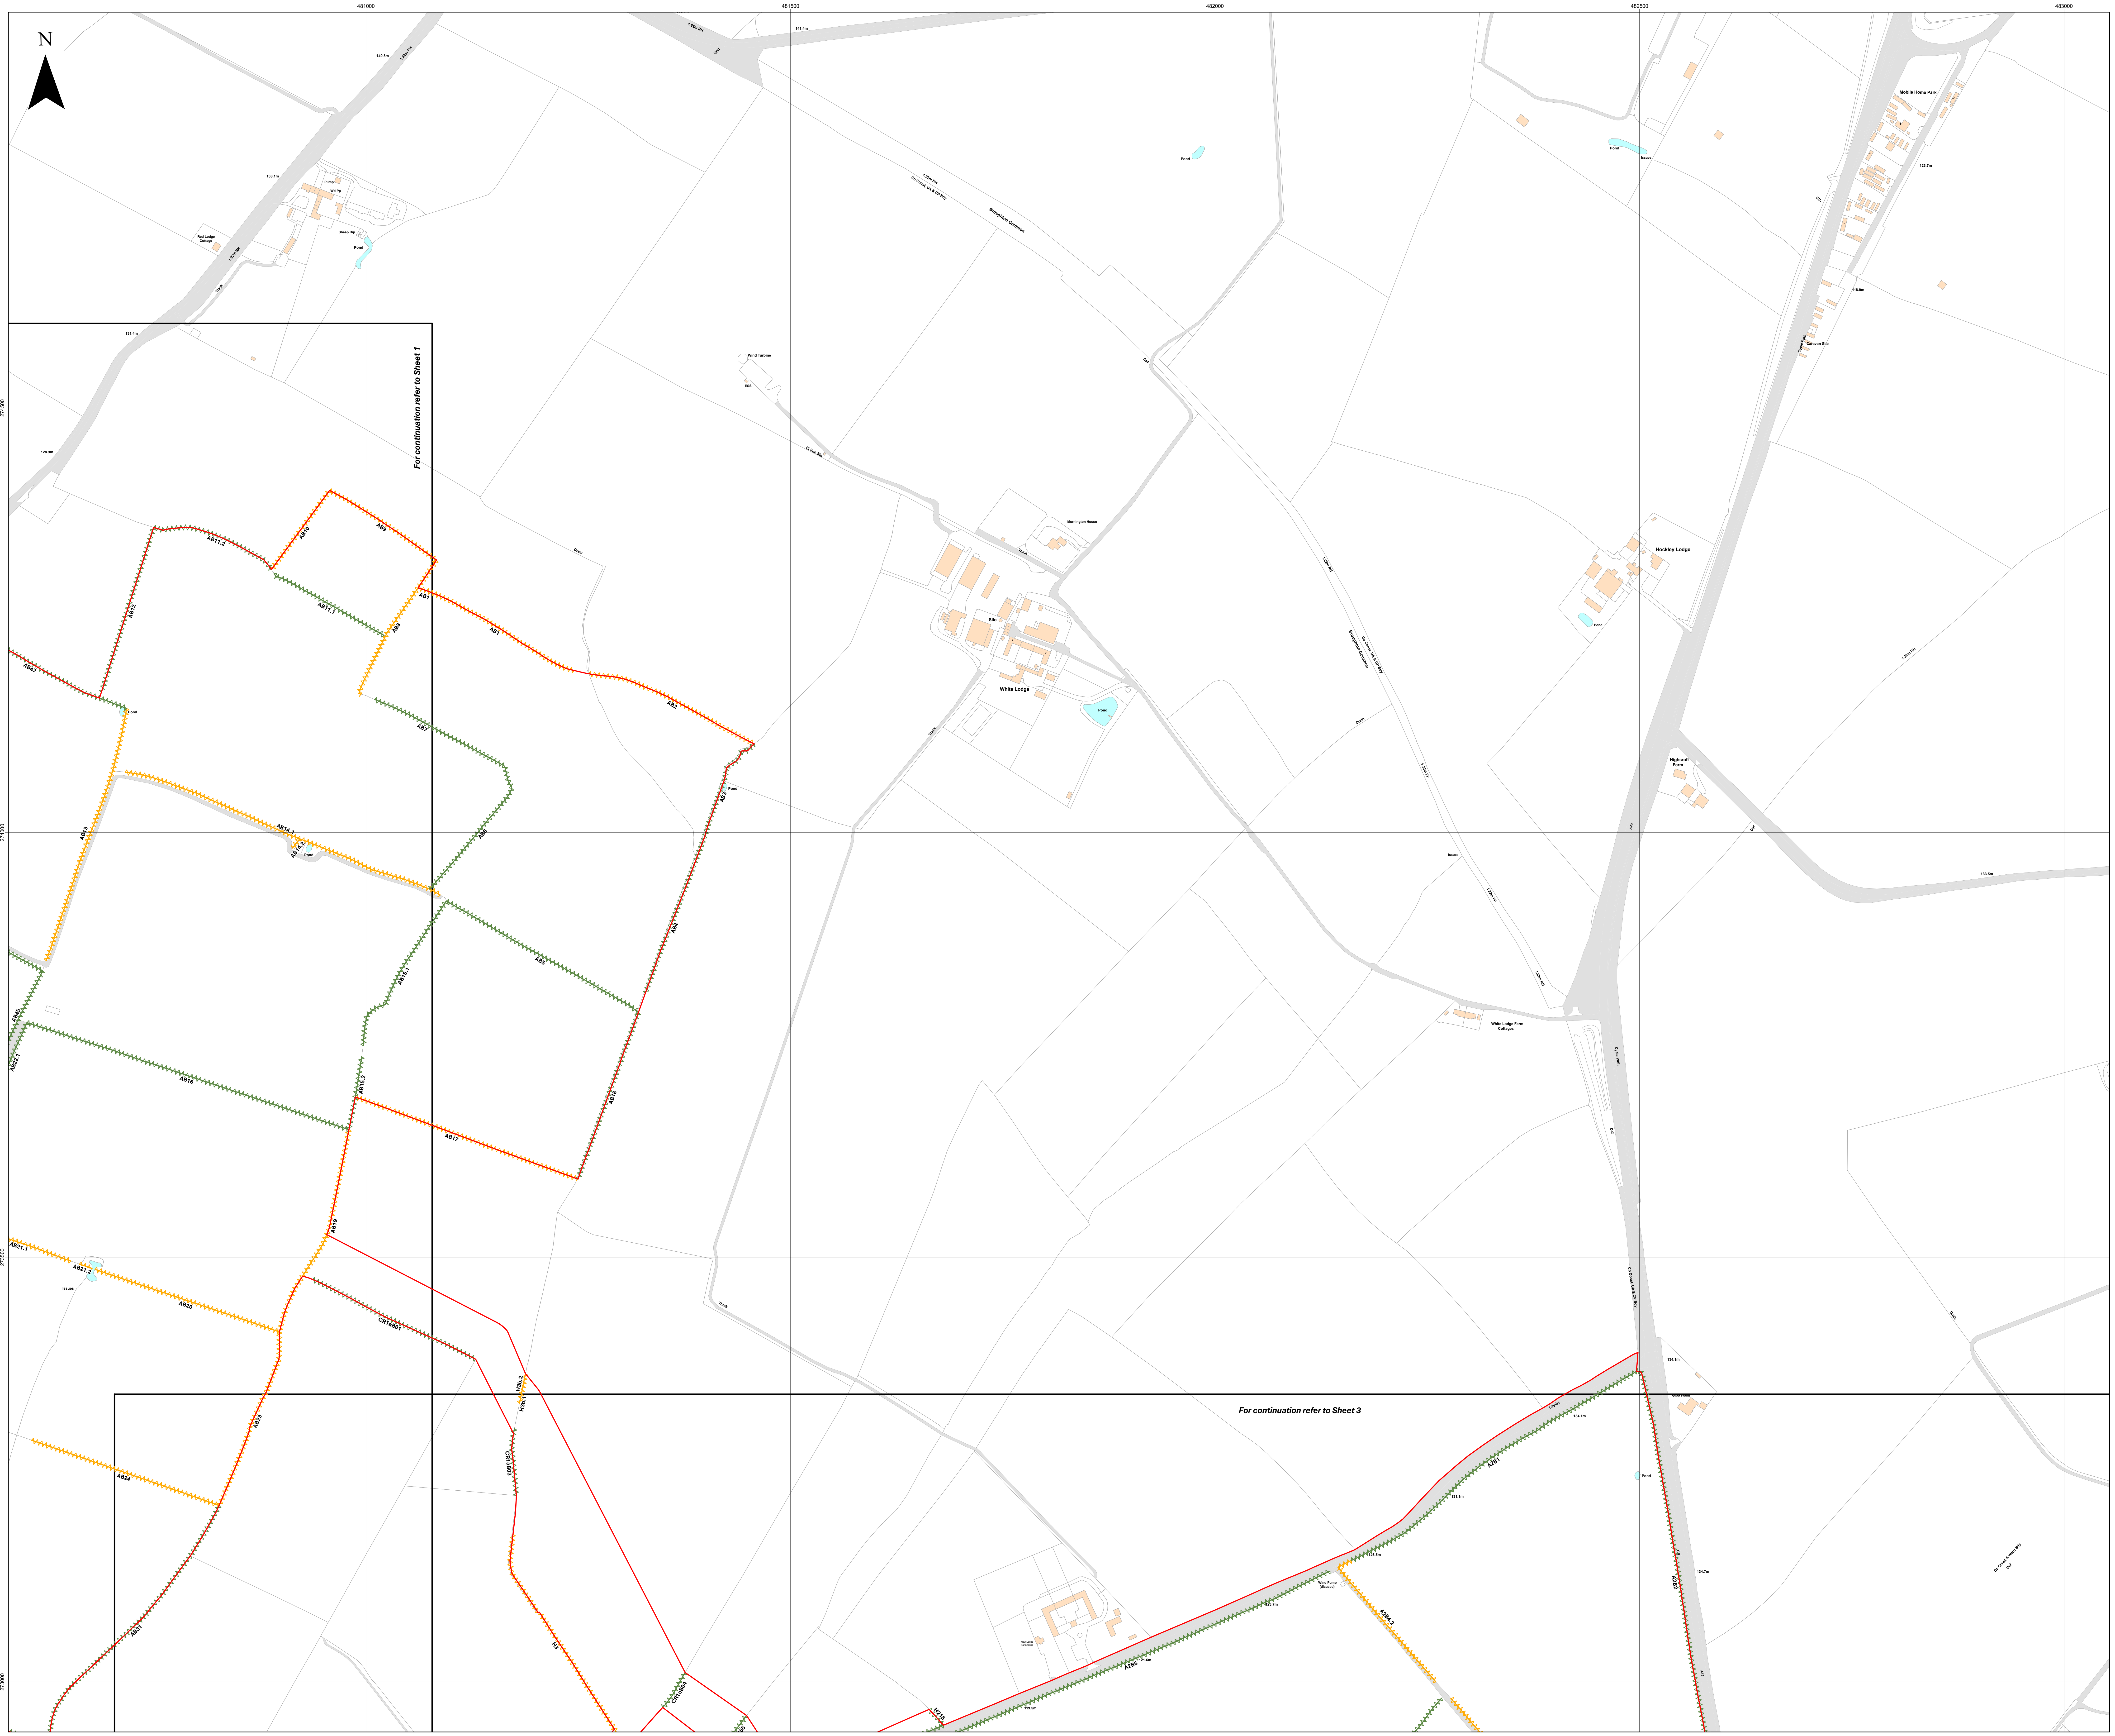
N
481000
481500
482000
482500
483000
274500
274000
273500
273000
For continuation refer to Sheet 1
For continuation refer to Sheet 3
AB1
AB2
AB3
AB4
AB5
AB6
AB7
AB8
AB9
AB10
AB11.1
AB11.2
AB12
AB13
AB14.1
AB14.2
AB15.1
AB15.2
AB16
AB17
AB18
AB19
AB20
AB21.1
AB21.2
AB22.1
AB23
AB24
AB31
AB45
AB47
CR1aB01
CR1aB03
CR1aB04
H3
H3b.1
H3b.2
H215
A2B1
A2B2
A2B4.2
A2B5
Pond
Issues
Drain
Track
El Sub Sta
Wind Turbine
White Lodge
Silo
Hockley Lodge
Highcroft Farm
White Lodge Farm Cottages
Mobile Home Park
Caravan Site
Wind Pump (disused)
New Lodge Farmhouse
Lay-by
Co Const, UA & CP Bdy
Co Const & Ward Bdy
128.9m
134.1m
134.7m
131.1m
126.5m
123.7m
121.6m
119.5m

Key

- 🟥 Order Limits
- ▭ Sheet Index
- Important Hedgerow
- Hedgerow

Layers: Lanpro, 2025; IGP, 2025
Base map: Reproduced from Ordnance Survey digital map data © Crown copyright 2025. All rights reserved. License number 0100031673

0 100 200 300 Meters

Scale: 1:2,500@ A0

APFP Regulation: 5(2)(q)	Application Doc No. CR1/GH2.11_B
Ref: P3535_LPR_ZZ_XX_DR_Z_0280	Date: 05/11/2025
Drawn by: BH	Checked by: JC

Important Hedgerows Plan (Change Request Version)

Sheet 2 of 18
Revision B

GREEN HILL
SOLAR FARM

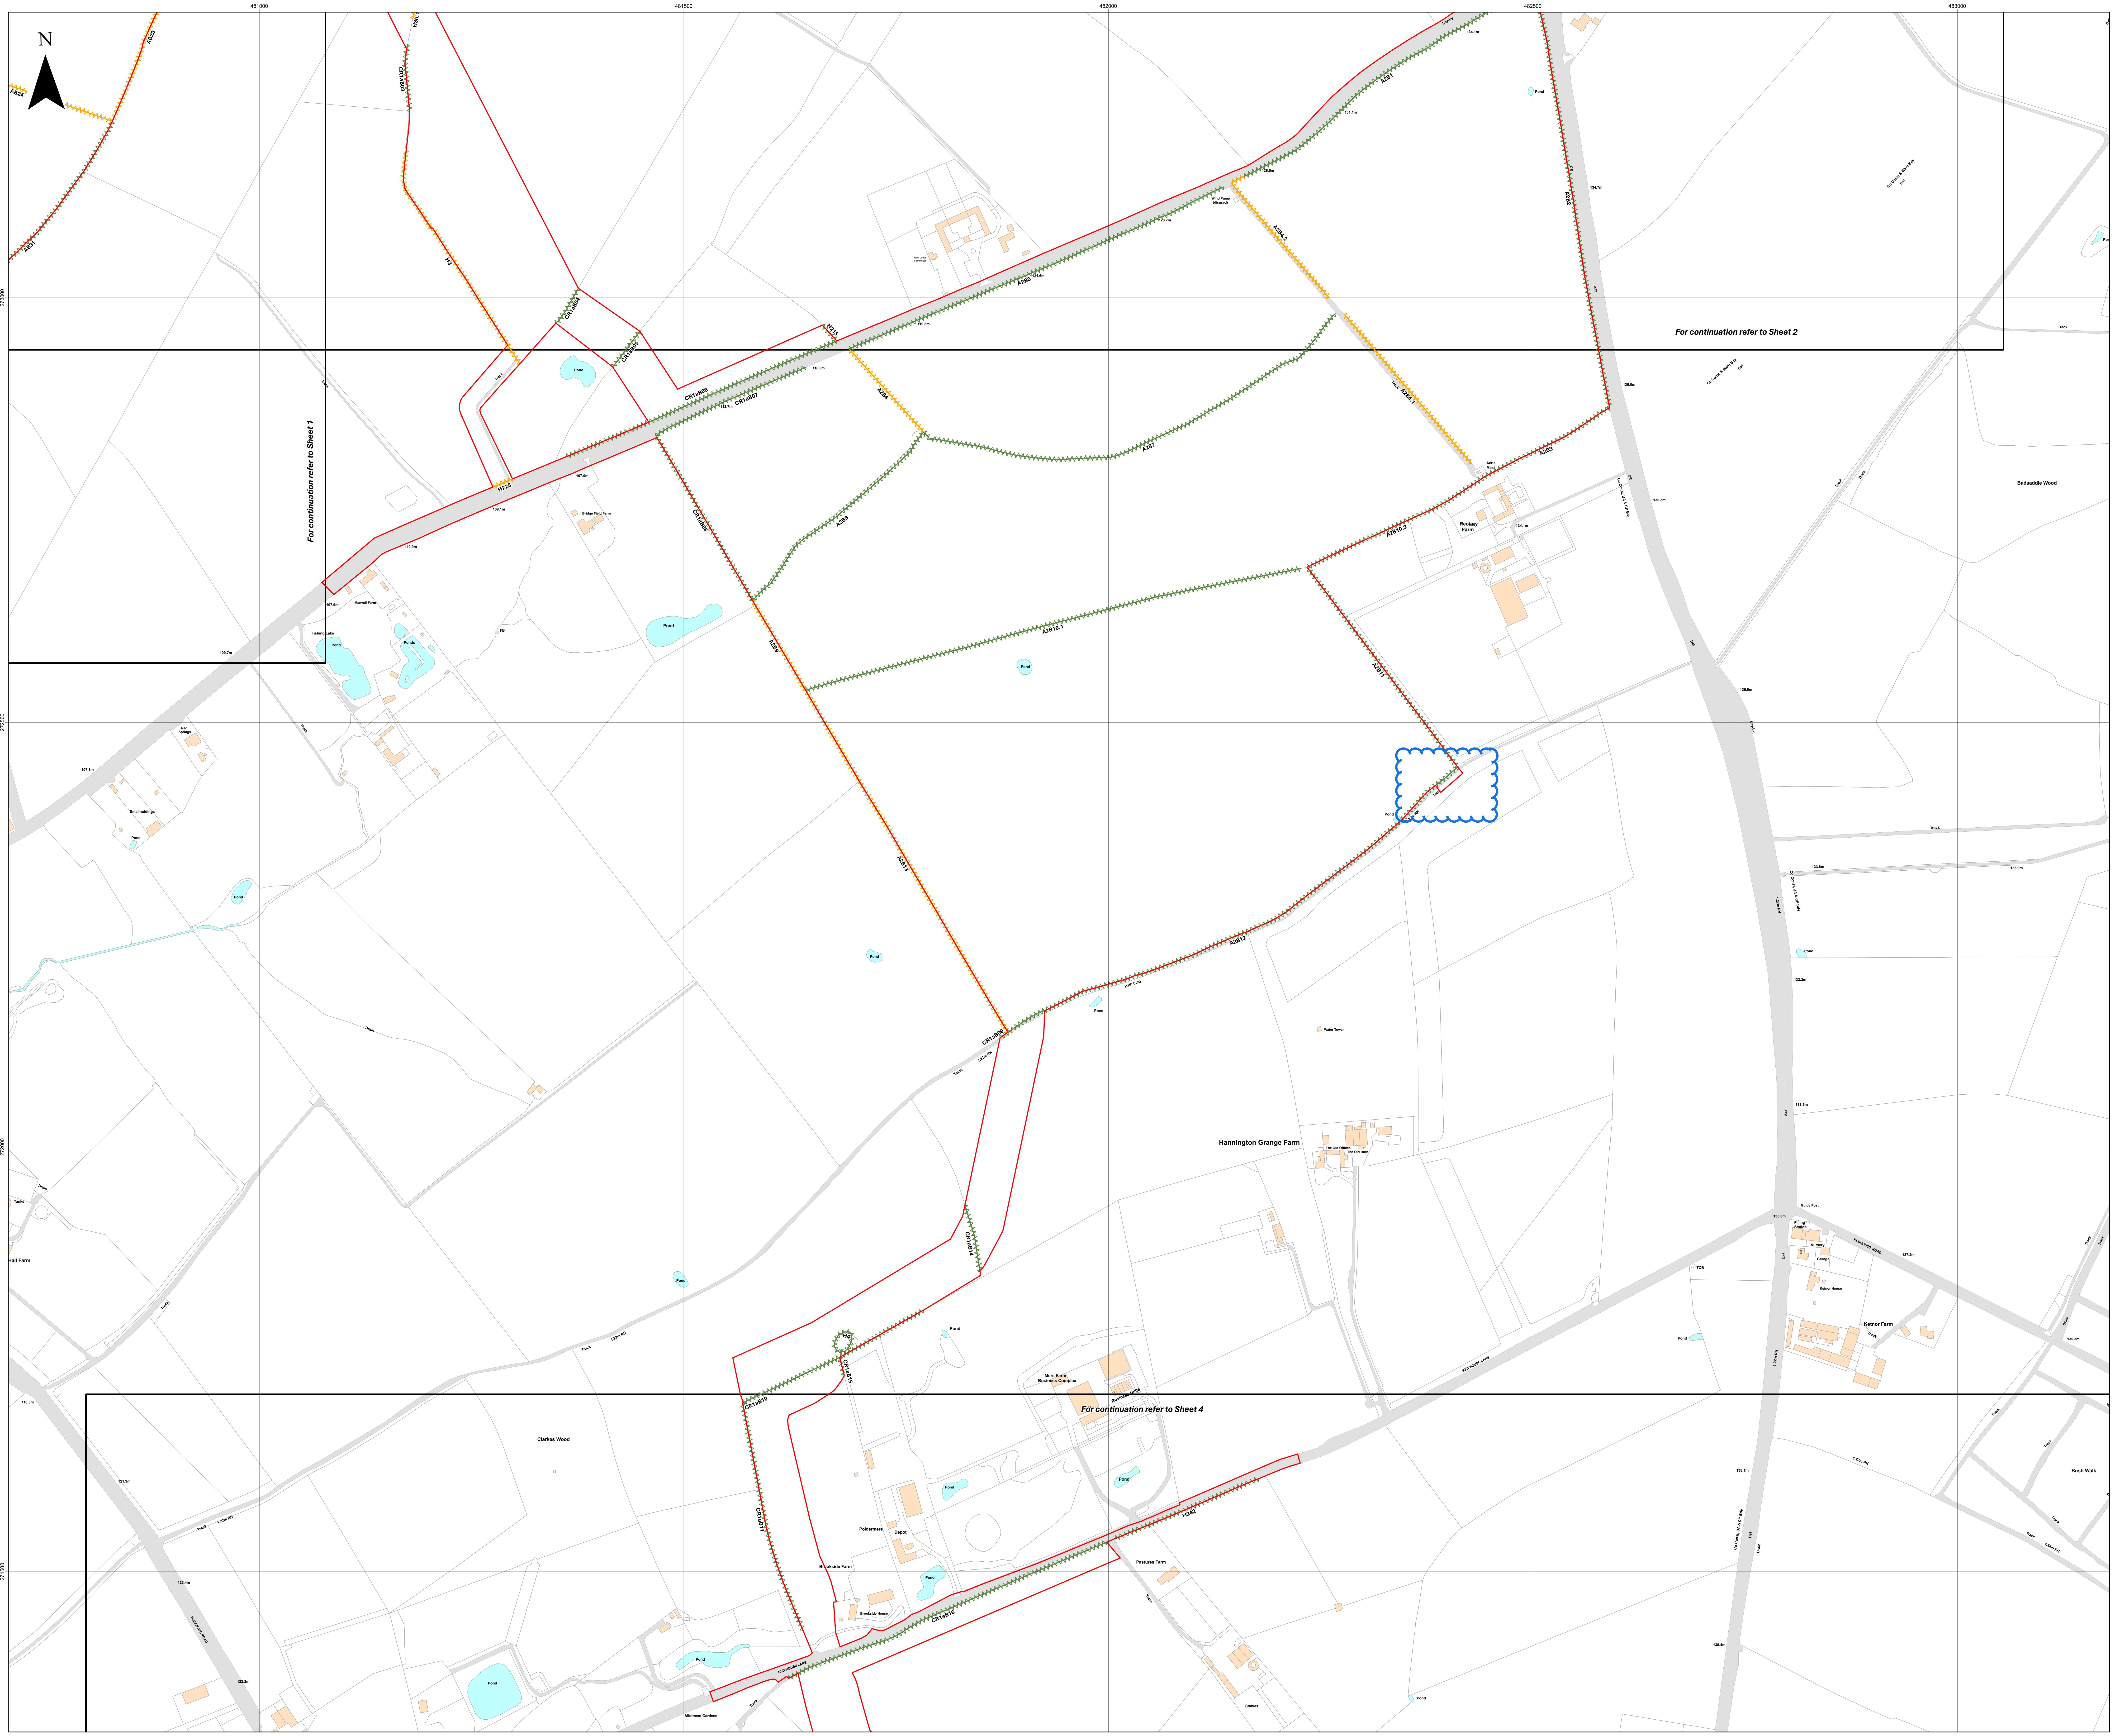
N
481000
481500
482000
482500
483000
272500
272000
271500
271000
For continuation refer to Sheet 1
For continuation refer to Sheet 2
For continuation refer to Sheet 4
H3
H3b.1
H215
H228
H4
H242
CR1aB03
CR1aB04
CR1aB05
CR1aB06
CR1aB07
CR1aB08
CR1aB09
CR1aB10
CR1aB11
CR1aB14
CR1aB15
CR1aB16
A2B1
A2B2
A2B3
A2B4.1
A2B4.2
A2B5
A2B6
A2B7
A2B8
A2B9
A2B10.1
A2B10.2
A2B11
A2B12
A2B13
A2B20
A2B21
A43
Wind Pump (disused)
New Lodge Farmhouse
Bridge Field Farm
Manvell Farm
Rectory Farm
Aerial Mast
Badsaddle Wood
Water Tower
Hannington Grange Farm
The Old Offices
The Old Barn
Mere Farm Business Complex
Business Units
Poldermere
Depot
Brookside Farm
Brookside House
Pastures Farm
Stables
Allotment Gardens
RED HOUSE LANE
Clarkes Wood
Kelmor Farm
Bush Walk
Hall Farm
Smithsdales
Pond
Track
Lay-by
Path (um)
Co Const, UA & CP Bdy
1.22m RH
135.6m
134.1m
131.1m
126.5m
123.7m
121.6m
119.5m
118.0m
113.7m
109.1m
110.9m
107.0m
107.9m
133.8m
132.3m
133.5m

Island GREEN POWER

Lanpro

Key

□ Order Limits
□ Sheet Index
〰 Important Hedgerow
〰 Hedgerow

Layers: Lanpro, 2025; IGP, 2025

0 100 200 300 Meters

Scale: 1:2,500@ A0

APFP Regulation: 5(2)(q)	Application Doc No. CR1/GH2.11_B
Ref: P3535_LPR_ZZ_XX_DR_Z_0280	Date: 05/11/2025
Drawn by: BH	Checked by: JC

Important Hedgerows Plan (Change Request Version)

Sheet 3 of 18
Revision B

GREEN HILL SOLAR FARM

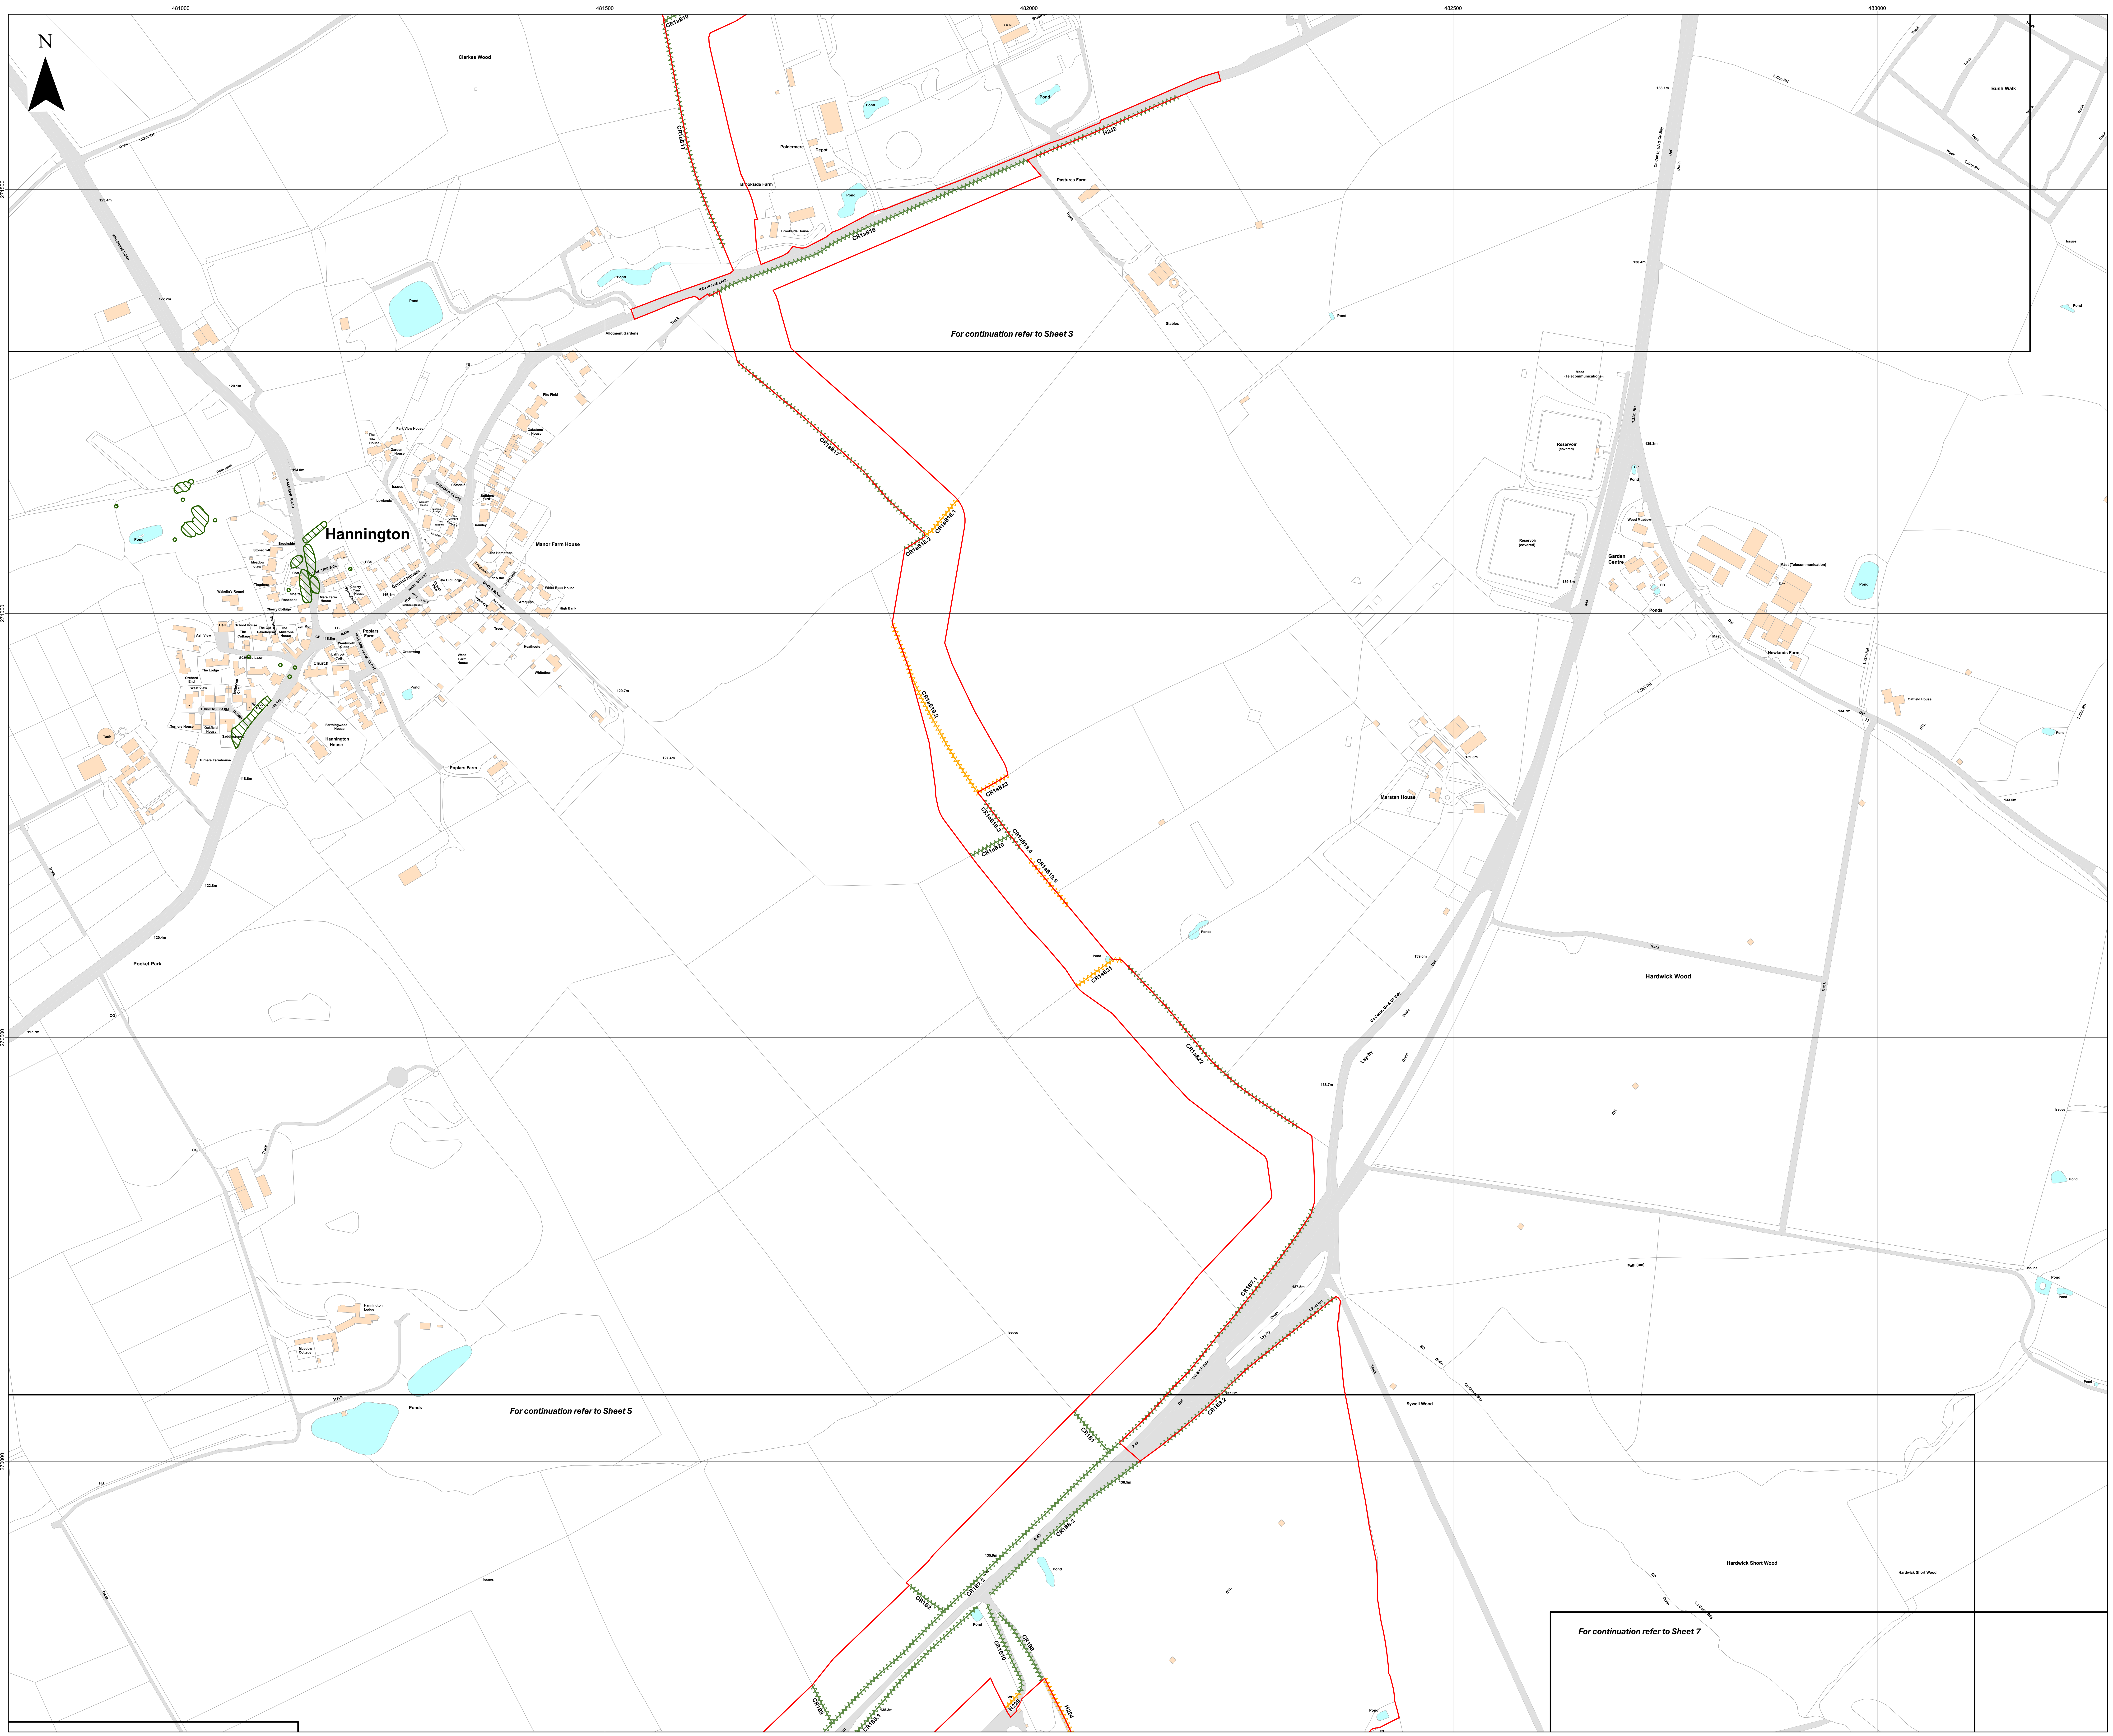
481000
481500
482000
482500
483000
N
Clarkes Wood
Hannington
Manor Farm House
Poplars Farm
Church
Hannington House
Pocket Park
Hannington Lodge
Meadow Cottage
Ponds
Pond
Poldermere
Depot
Brookside Farm
Brookside House
Pastures Farm
Stables
Allotment Gardens
RED HOUSE LANE
Track
Reservoir (covered)
Garden Centre
Newlands Farm
Marston House
Hardwick Wood
Hardwick Short Wood
Sywell Wood
Bush Walk
Lay-by
Drain
A 43
Issues
ETL
CR1aB10
CR1aB11
CR1aB16
H242
CR1aB17
CR1aB18.1
CR1aB18.2
CR1aB19.2
CR1aB23
CR1aB19.3
CR1aB19.4
CR1aB19.5
CR1aB20
CR1aB21
CR1aB22
CR1B7.1
CR1B7.2
CR1B8.1
CR1B8.2
CR1B1
CR1B2
CR1B3
CR1B9
CR1B10
H229
H224
138.7m
137.5m
136.5m
135.9m
135.3m

For continuation refer to Sheet 3

For continuation refer to Sheet 5

For continuation refer to Sheet 7

Island GREEN POWER

Lanpro

Key

- 🟥 Order Limits
- ▭ Sheet Index
- Important Hedgerow
- Hedgerow

Tree Protection Order (TPO)

- ▨ Group

Layers: Lanpro, 2025; IGP, 2025

0 100 200 300 Meters

Scale: 1:2,500@ A0

APFP Regulation: 5(2)(q)	Application Doc No. CR1/GH2.11_B
Ref: P3535_LPR_ZZ_XX_DR_Z_0280	Date: 05/11/2025
Drawn by: BH	Checked by: JC

Important Hedgerows Plan (Change Request Version)

Sheet 4 of 18
Revision B

GREEN HILL SOLAR FARM

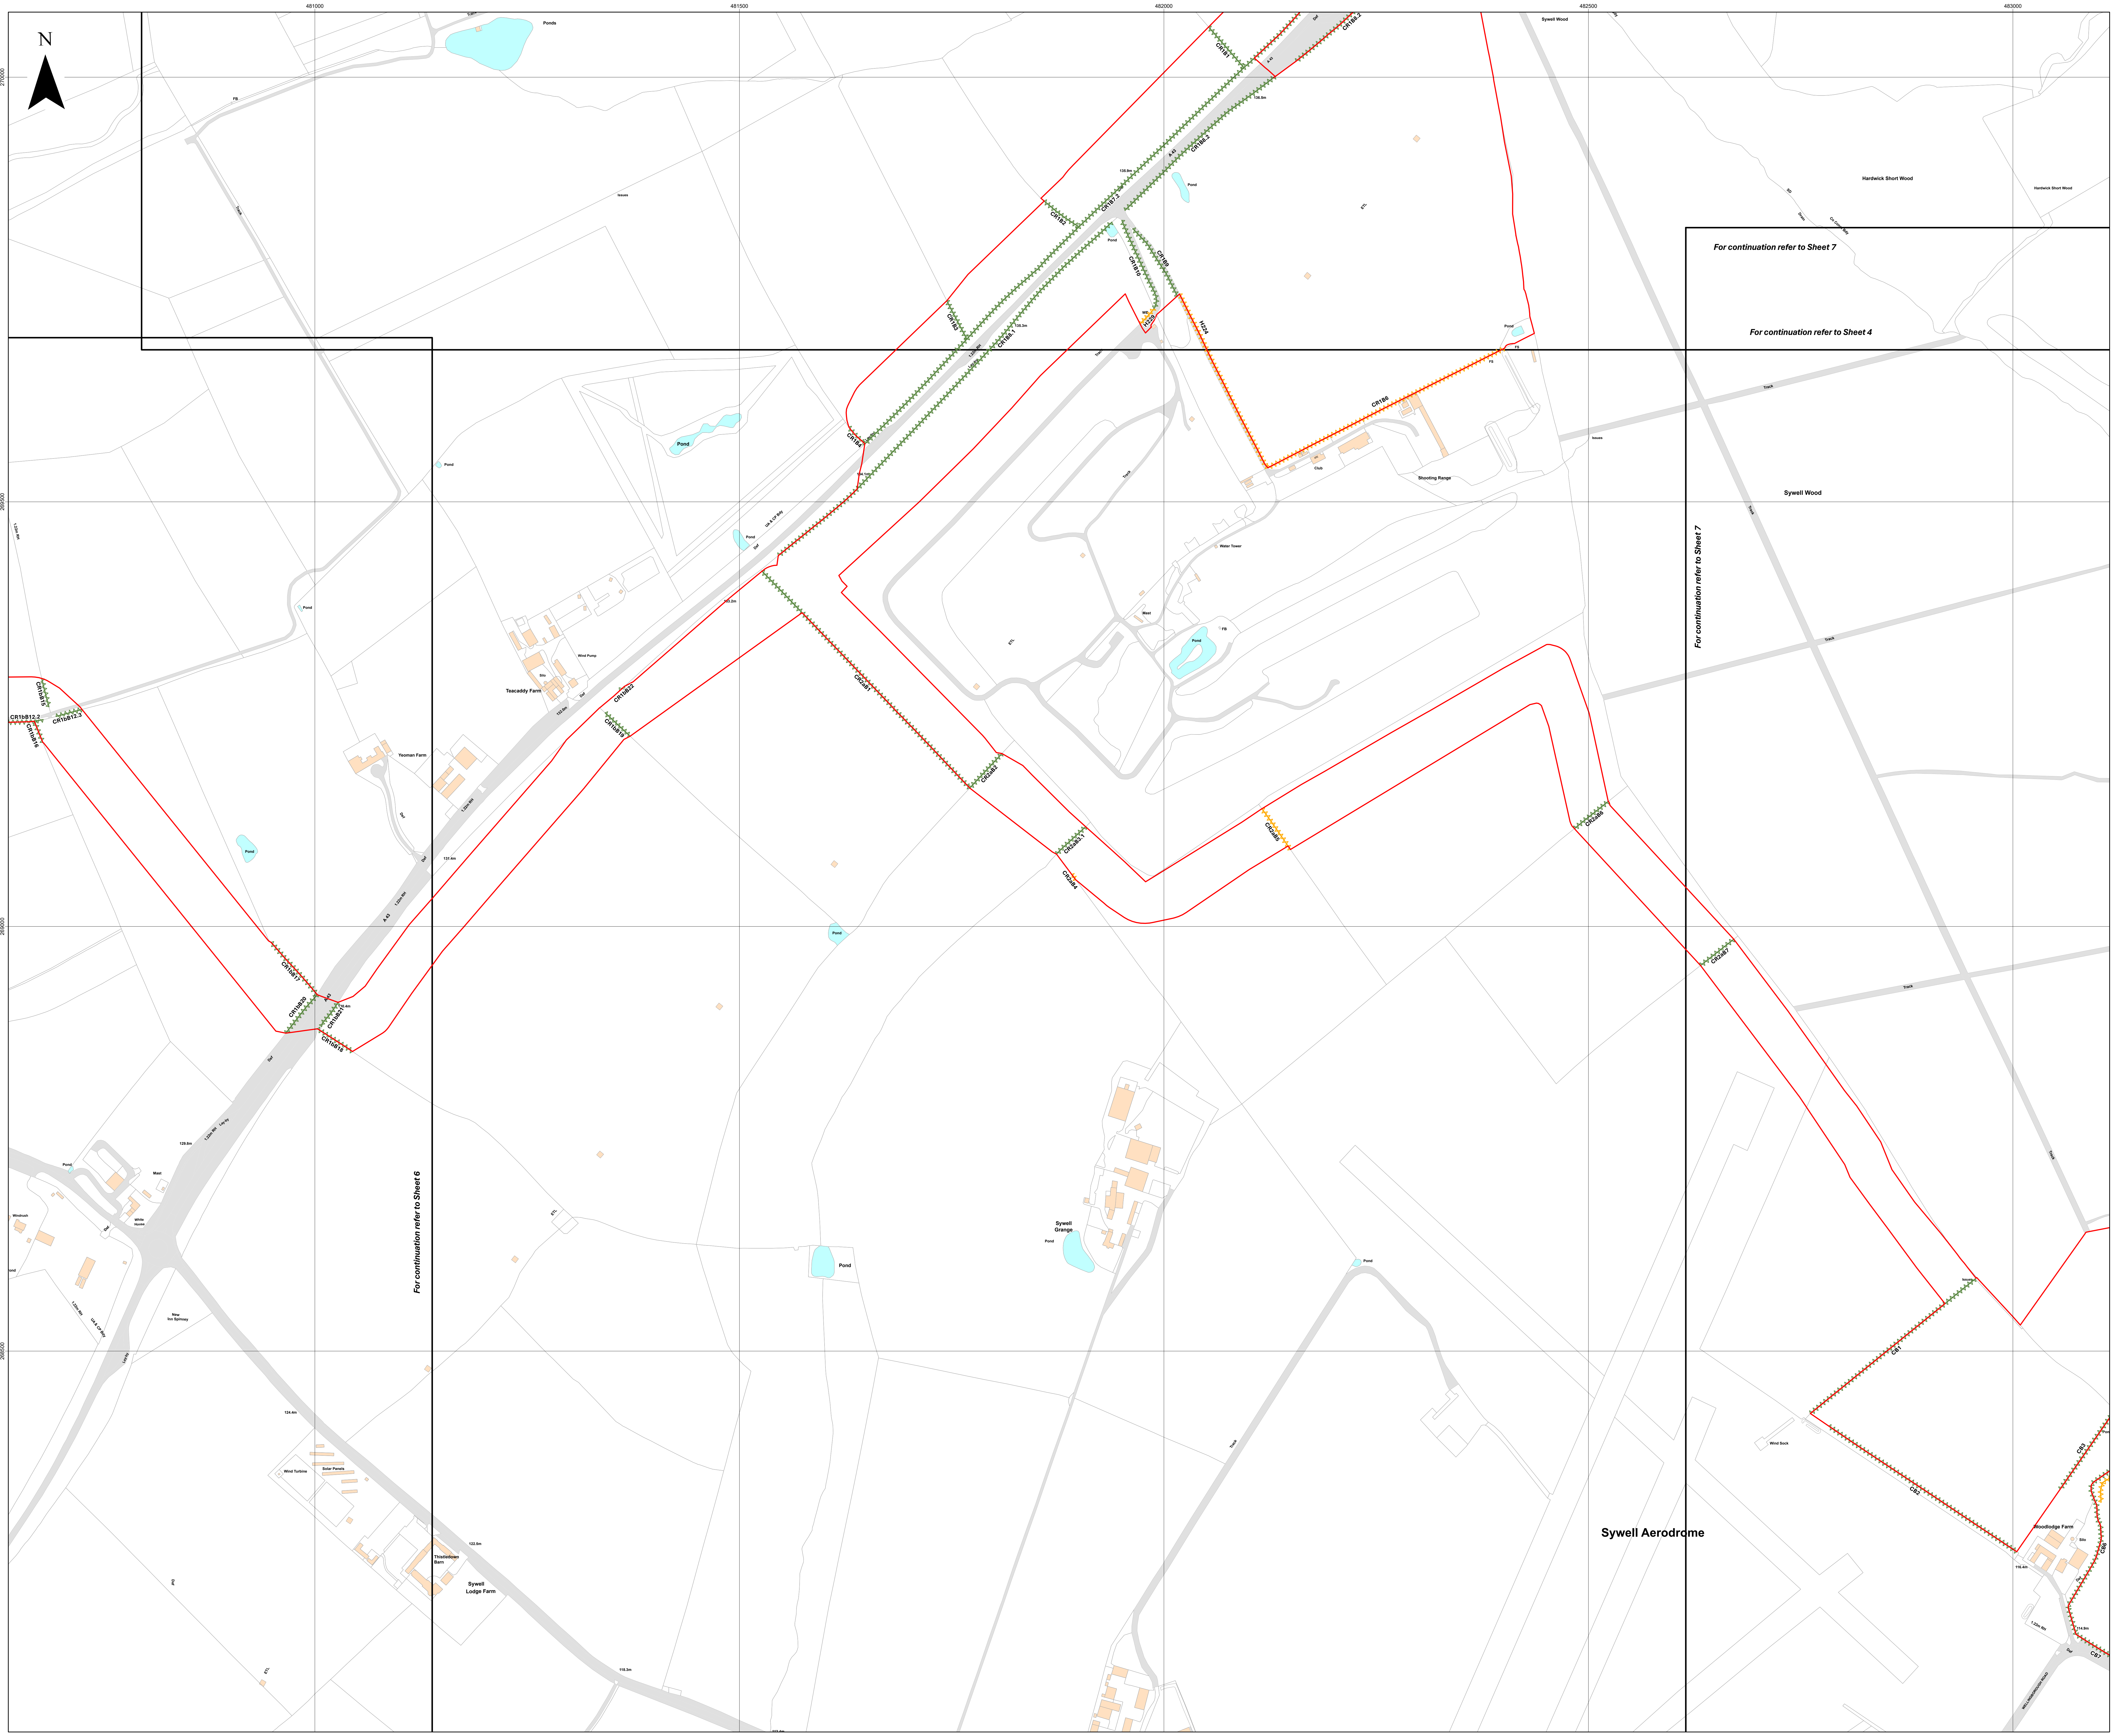
N
481000
481500
482000
482500
483000
For continuation refer to Sheet 7
For continuation refer to Sheet 4
For continuation refer to Sheet 6
Sywell Aerodrome
Sywell Wood
Hardwick Short Wood
Sywell Grange
Teacaddy Farm
Yeoman Farm
Sywell Lodge Farm
Woodlodge Farm
Shooting Range
Water Tower
Pond
Ponds
CB1
CB2
CB3
CB6
CB7

Island GREEN POWER

Lanpro

Key

- 🟥 Order Limits
- ⬛ Sheet Index
- Important Hedgerow
- Hedgerow

Layers: Lanpro, 2025; IGP, 2025

Base map: Reproduced from Ordnance Survey digital map data © Crown copyright 2025. All rights reserved. License number 0100031673

0 100 200 300 Meters

Scale: 1:2,500@ A0

APFP Regulation: 5(2)(q)	Application Doc No. CR1/GH2.11_B
Ref: P3535_LPR_ZZ_XX_DR_Z_0280	Date: 05/11/2025
Drawn by: BH	Checked by: JC

Important Hedgerows Plan (Change Request Version)

Sheet 5 of 18

Revision B

GREEN HILL SOLAR FARM

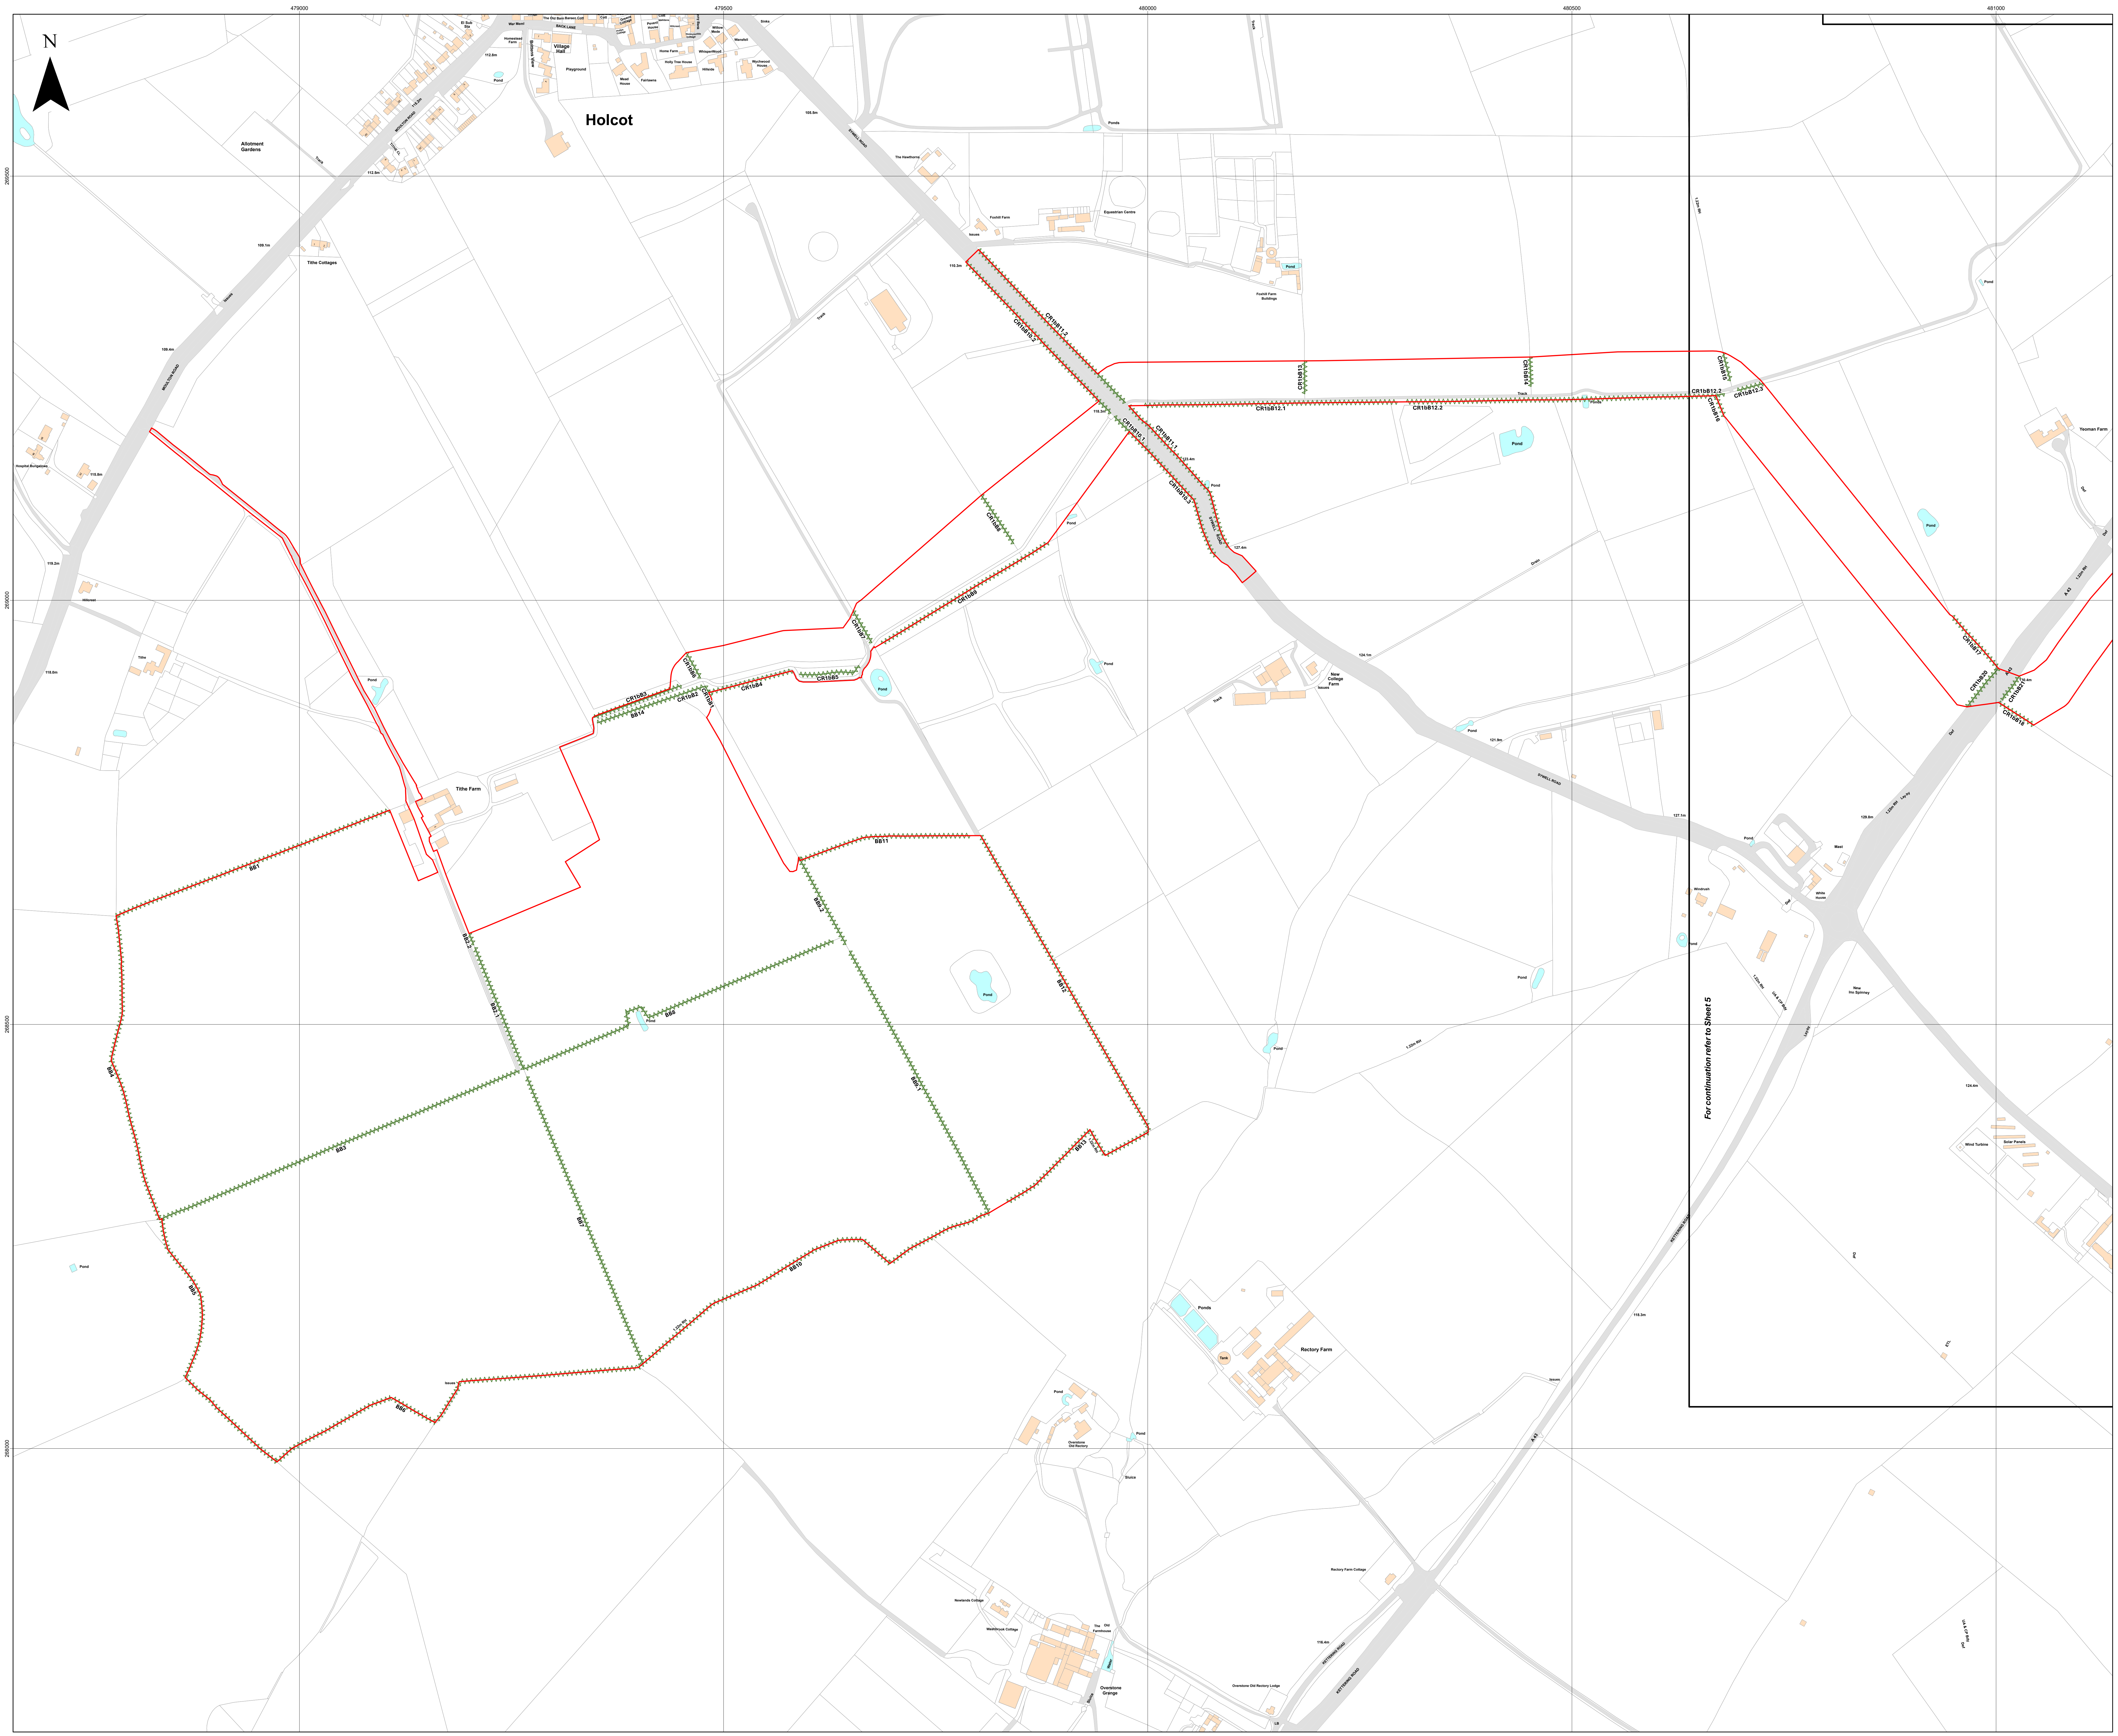
N
479000
479500
480000
480500
481000
Holcot
Allotment Gardens
Tithe Cottages
Tithe Farm
Foxhill Farm
Equestrian Centre
Foxhill Farm Buildings
Issues
Pond
Ponds
Track
SYWELL ROAD
New College Farm
Yeoman Farm
Rectory Farm
Overstone Old Rectory
Sluice
A 43
Def
Lay-by
1.22m RH
110.3m
118.3m
123.4m
127.4m
124.1m
130.4m
For continuation refer to Sheet 5
CR1bB1
CR1bB2
CR1bB3
CR1bB4
CR1bB5
CR1bB6
CR1bB7
CR1bB8
CR1bB9
CR1bB10.1
CR1bB10.2
CR1bB10.3
CR1bB11.1
CR1bB11.2
CR1bB12.1
CR1bB12.2
CR1bB12.3
CR1bB13
CR1bB14
CR1bB15
CR1bB16
CR1bB17
CR1bB18
CR1bB20
CR1bB21
BB1
BB2.1
BB2.2
BB3
BB4
BB5
BB6
BB7
BB8
BB9.1
BB9.2
BB10
BB11
BB12
BB13
BB14

Key

- 🟥 Order Limits
- ⬜ Sheet Index
- ⩘⩘⩘ Important Hedgerow

Layers: Lanpro, 2025; IGP, 2025

Base map: Reproduced from Ordnance Survey digital map data © Crown copyright 2025. All rights reserved. License number 0100031673

0 100 200 300 Meters

Scale: 1:2,500@ A0

APFP Regulation: 5(2)(q)	Application Doc No. CR1/GH2.11_B
Ref: P3535_LPR_ZZ_XX_DR_Z_0280	Date: 05/11/2025
Drawn by: BH	Checked by: JC

Important Hedgerows Plan (Change Request Version)

Sheet 6 of 18

Revision B

GREEN HILL SOLAR FARM

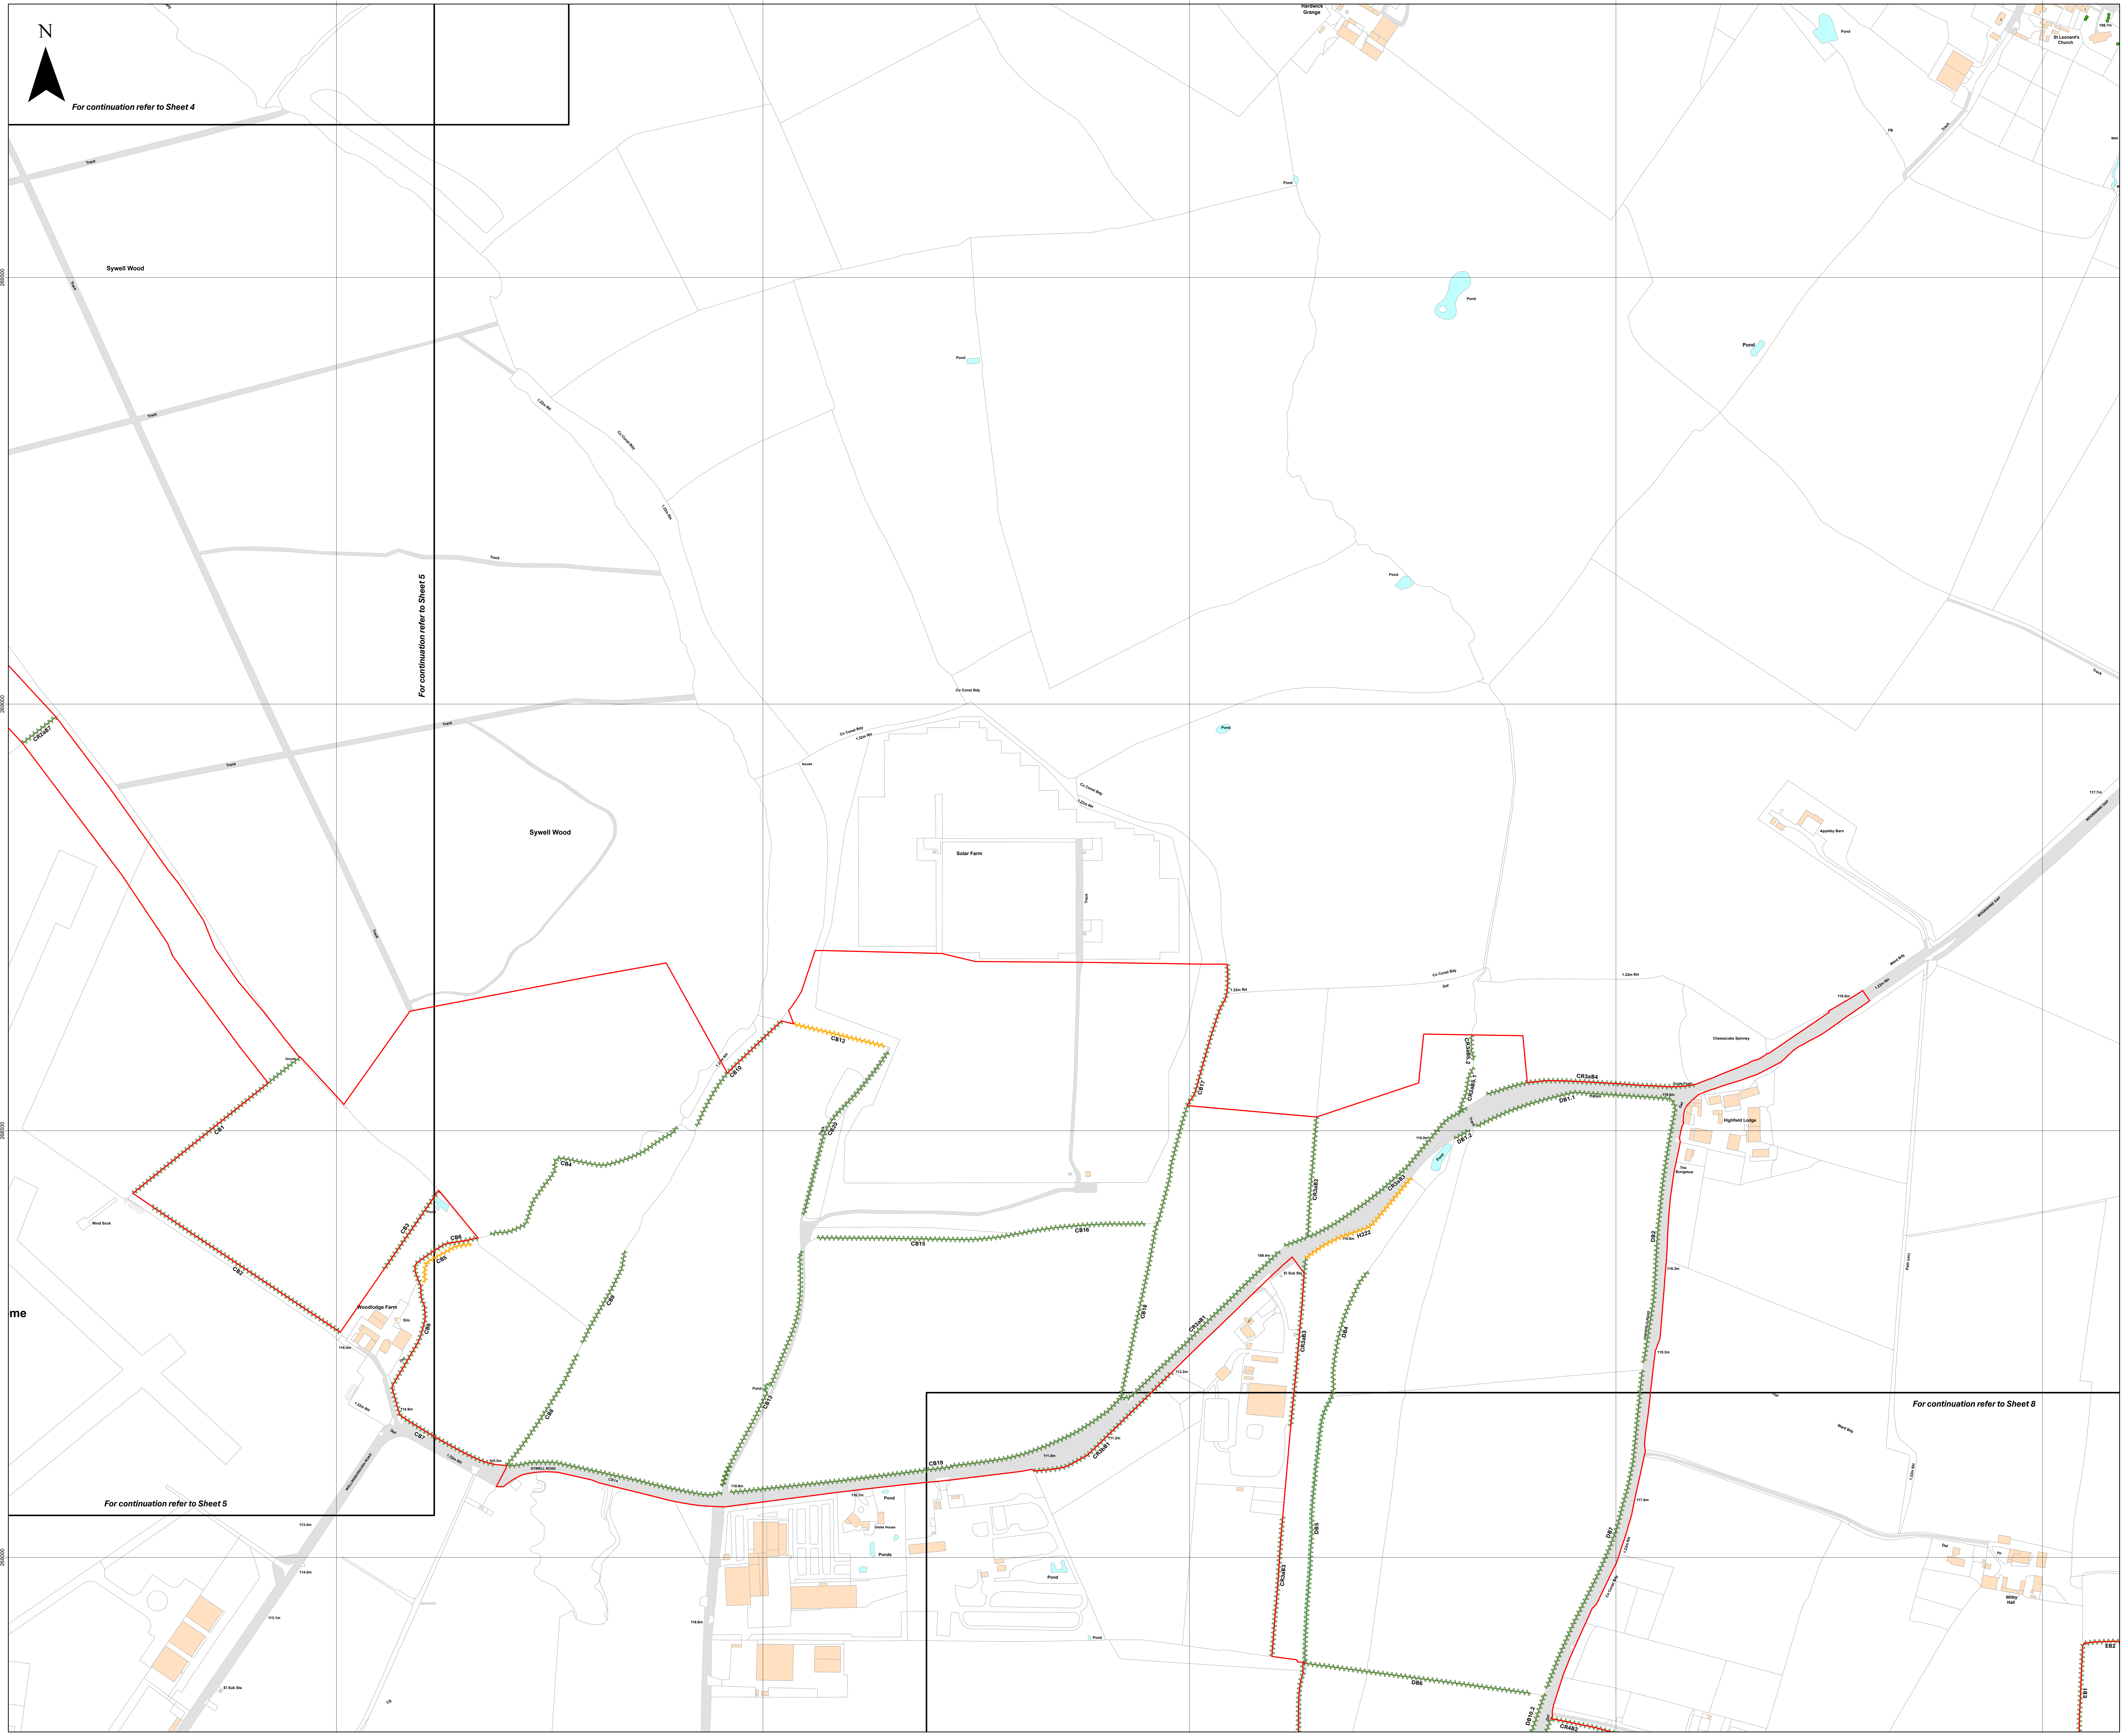
N
483000
483500
484000
484500
485000
269500
269000
268500
268000
For continuation refer to Sheet 4
For continuation refer to Sheet 5
For continuation refer to Sheet 5
For continuation refer to Sheet 8
Sywell Wood
Sywell Wood
Solar Farm
Track
Hardwick Grange
St Leonard's Church
Pond
Co Const Bdy
Woodlodge Farm
Wind Sock
Silo
Highfield Lodge
The Bungalow
Cheesecake Spinney
Glebe House
Ponds
Wilby Hall
El Sub Sta
Guide Post
Ward Bdy
SYWELL ROAD
WELLINGBOROUGH ROAD
HIGHFIELD ROAD
1.22m RH
CR2aB7
CB1
CB2
CB3
CB4
CB5
CB6
CB7
CB8
CB9
CB10
CB12
CB13
CB14
CB15
CB16
CB17
CB18
CB19
CB20
CR3aB1
CR3aB2
CR3aB3
CR3aB4
CR3aB5.1
CR3aB5.2
CR3bB1
H222
DB1.1
DB1.2
DB2
DB4
DB5
DB6
DB7
DB10.2
CR4B2
EB1
EB2

Island GREEN POWER

Lanpro

Key

- 🟥 Order Limits
- ☐ Sheet Index
- Important Hedgerow
- Hedgerow

Tree Protection Order (TPO)

- ● Points

Layers: Lanpro, 2025; IGP, 2025

Base map: Reproduced from Ordnance Survey digital map data © Crown copyright 2025. All rights reserved. License number 0100031673

0 100 200 300 Meters

Scale: 1:2,500@ A0

APFP Regulation: 5(2)(q)	Application Doc No. CR1/GH2.11_B
Ref: P3535_LPR_ZZ_XX_DR_Z_0280	Date: 05/11/2025
Drawn by: BH	Checked by: JC

Important Hedgerows Plan (Change Request Version)

Sheet 7 of 18

Revision B

GREEN HILL SOLAR FARM

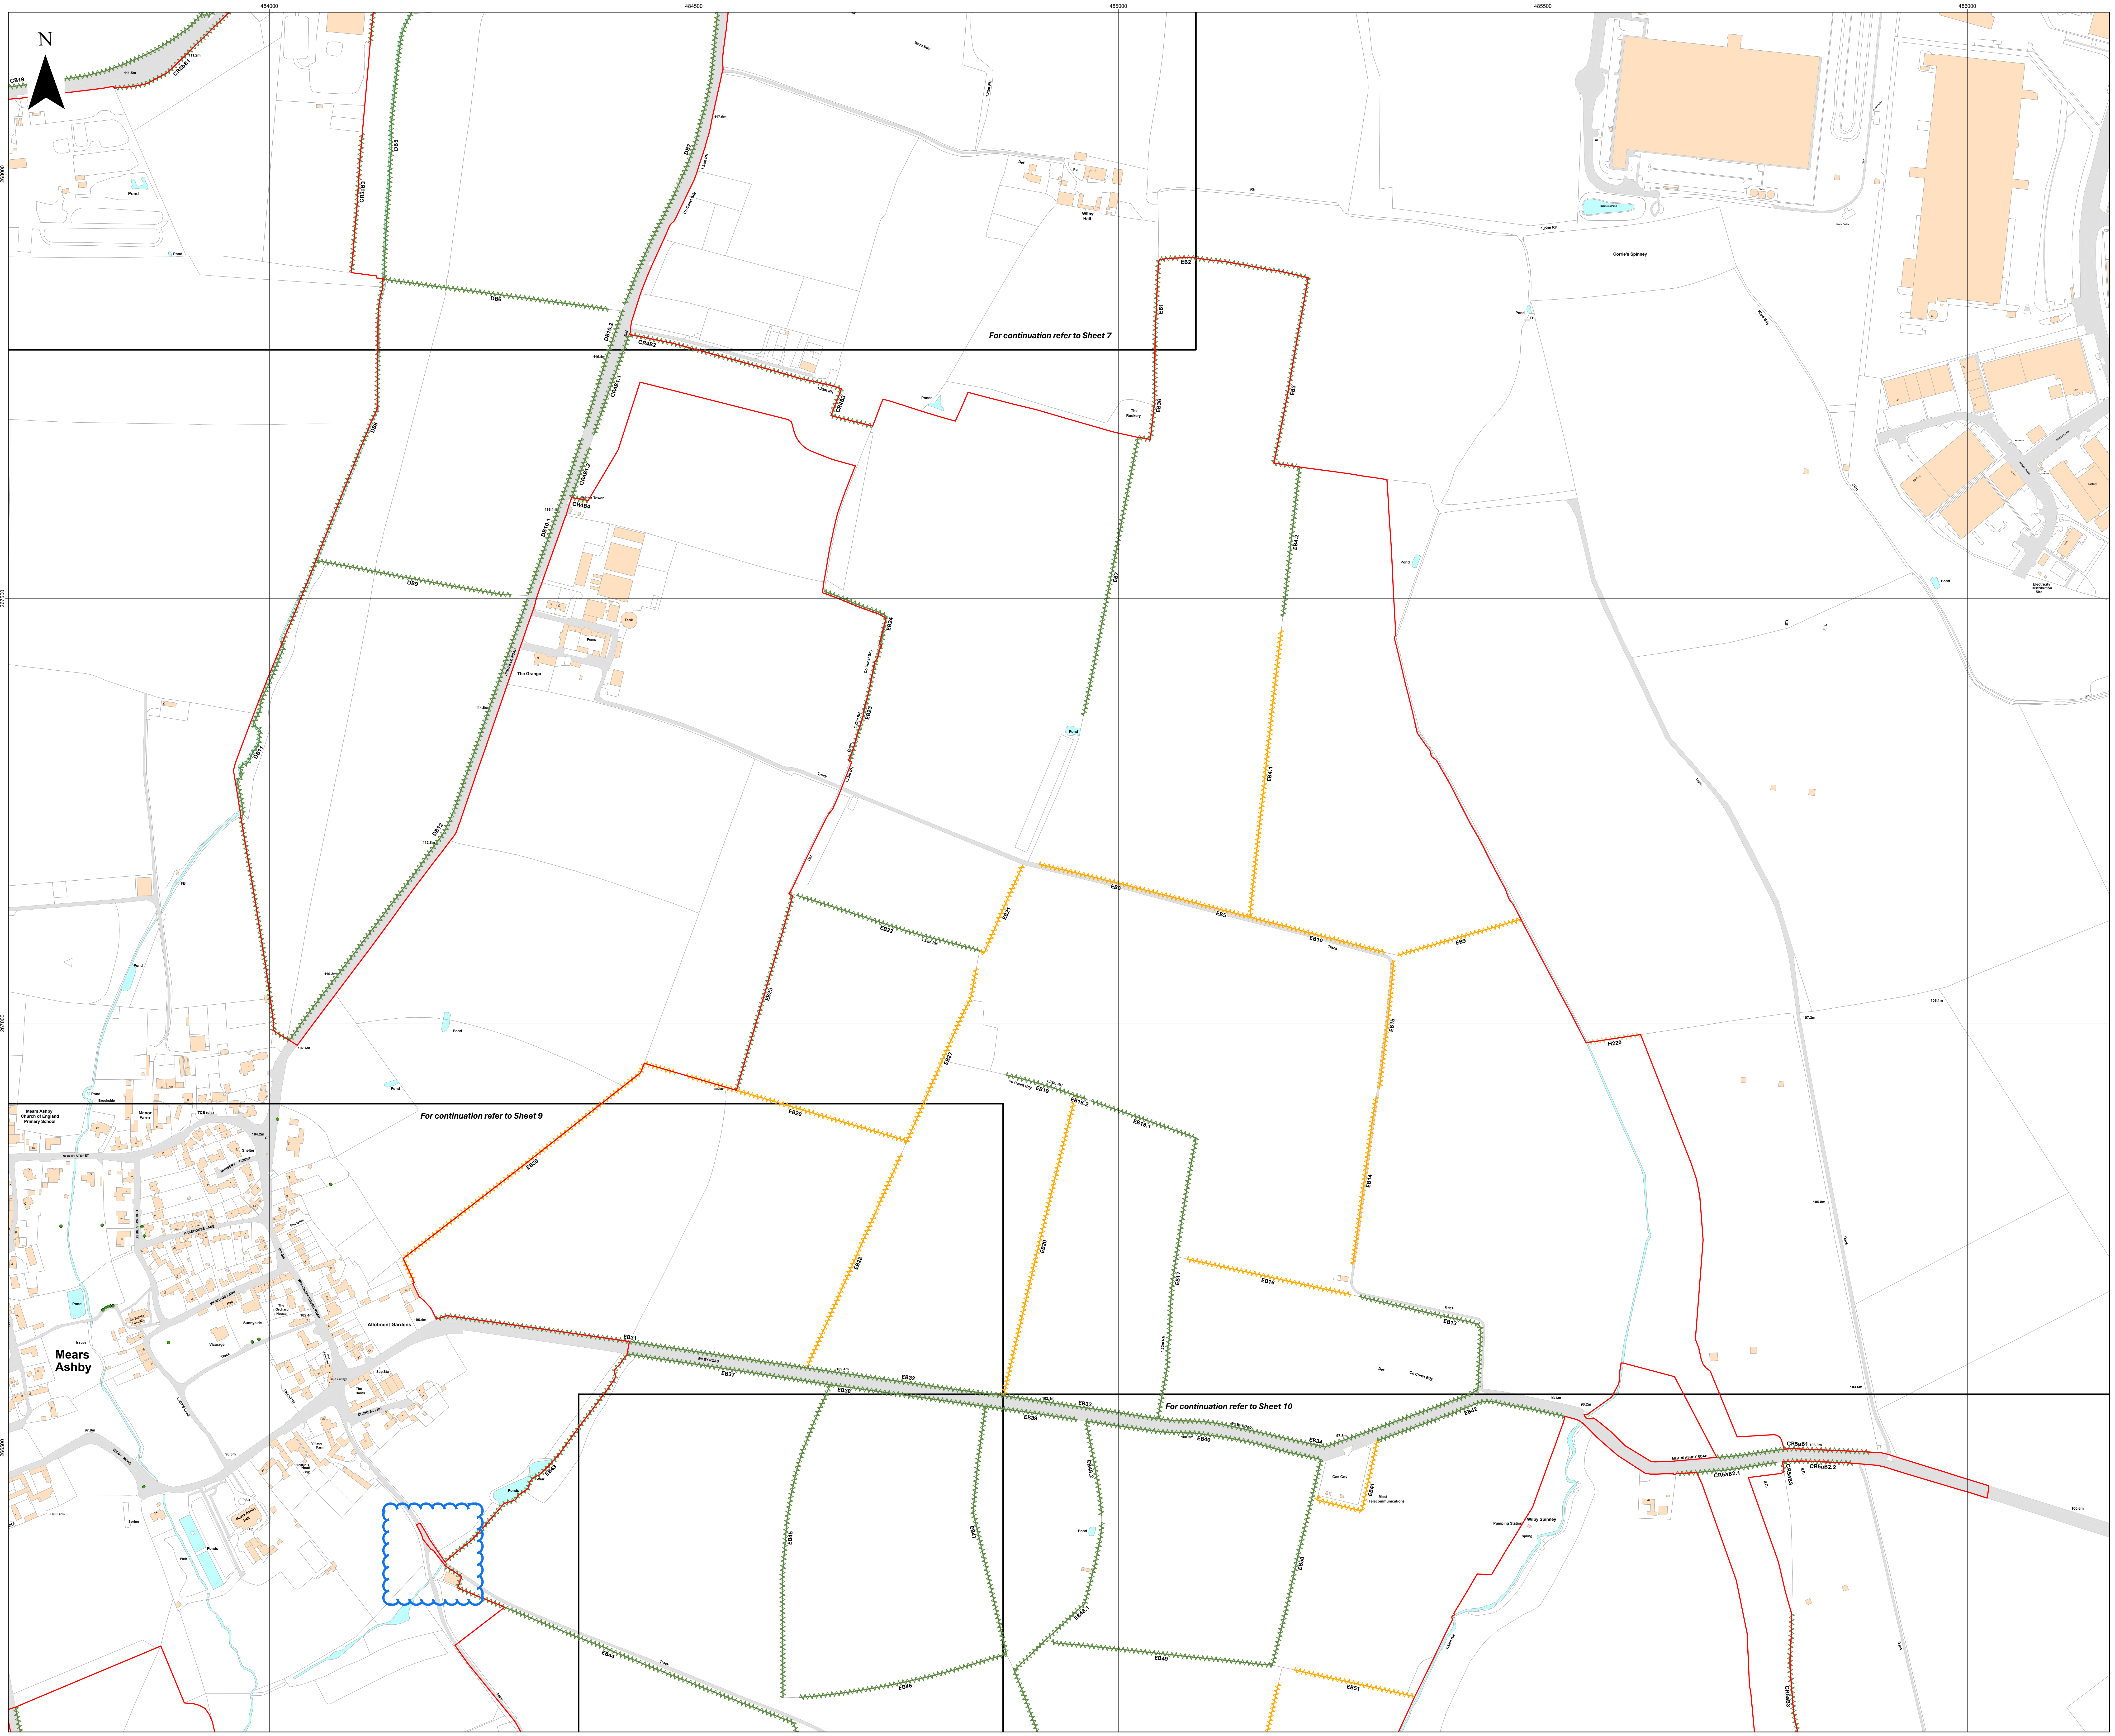
N
484000
484500
485000
485500
486000
268000
267500
267000
266500
For continuation refer to Sheet 7
For continuation refer to Sheet 9
For continuation refer to Sheet 10
Mears Ashby
Allotment Gardens
The Grange
Wilby Hall
Corrie's Spinney
Wilby Spinney
Pond
Mears Ashby Church of England Primary School
Manor Farm
NORTH STREET
H220
EB2
EB3
EB4.1
EB4.2
EB8
EB9
EB10
EB15
EB16
EB18
EB21
EB22
EB23
EB24
EB25
EB26
EB27
EB28
EB29
EB30
EB31
EB32
EB33
EB34
EB37
EB40
EB42
EB44
EB46
EB49
EB51
DB5
DB6
DB7
DB8
DB11
DB12
CR482
CR484
CRSeB1
CRSeB2.1
CRSeB2.2

Island GREEN POWER

Lanpro

Key

- 🟥 Order Limits
- ⬛ Sheet Index
- Important Hedgerow
- Potentially Important Hedgerow
- Hedgerow

Tree Protection Order (TPO)

- ● Points

Layers: Lanpro, 2025; IGP, 2025

Base map: Reproduced from Ordnance Survey digital map data © Crown copyright 2025. All rights reserved. License number 0100031673

0 100 200 300 Meters

Scale: 1:2,500@ A0

APFP Regulation: 5(2)(q)	Application Doc No. CR1/GH2.11_B
Ref: P3535_LPR_ZZ_XX_DR_Z_0280	Date: 05/11/2025
Drawn by: BH	Checked by: JC

Important Hedgerows Plan (Change Request Version)

Sheet 8 of 18

Revision B

GREEN HILL SOLAR FARM

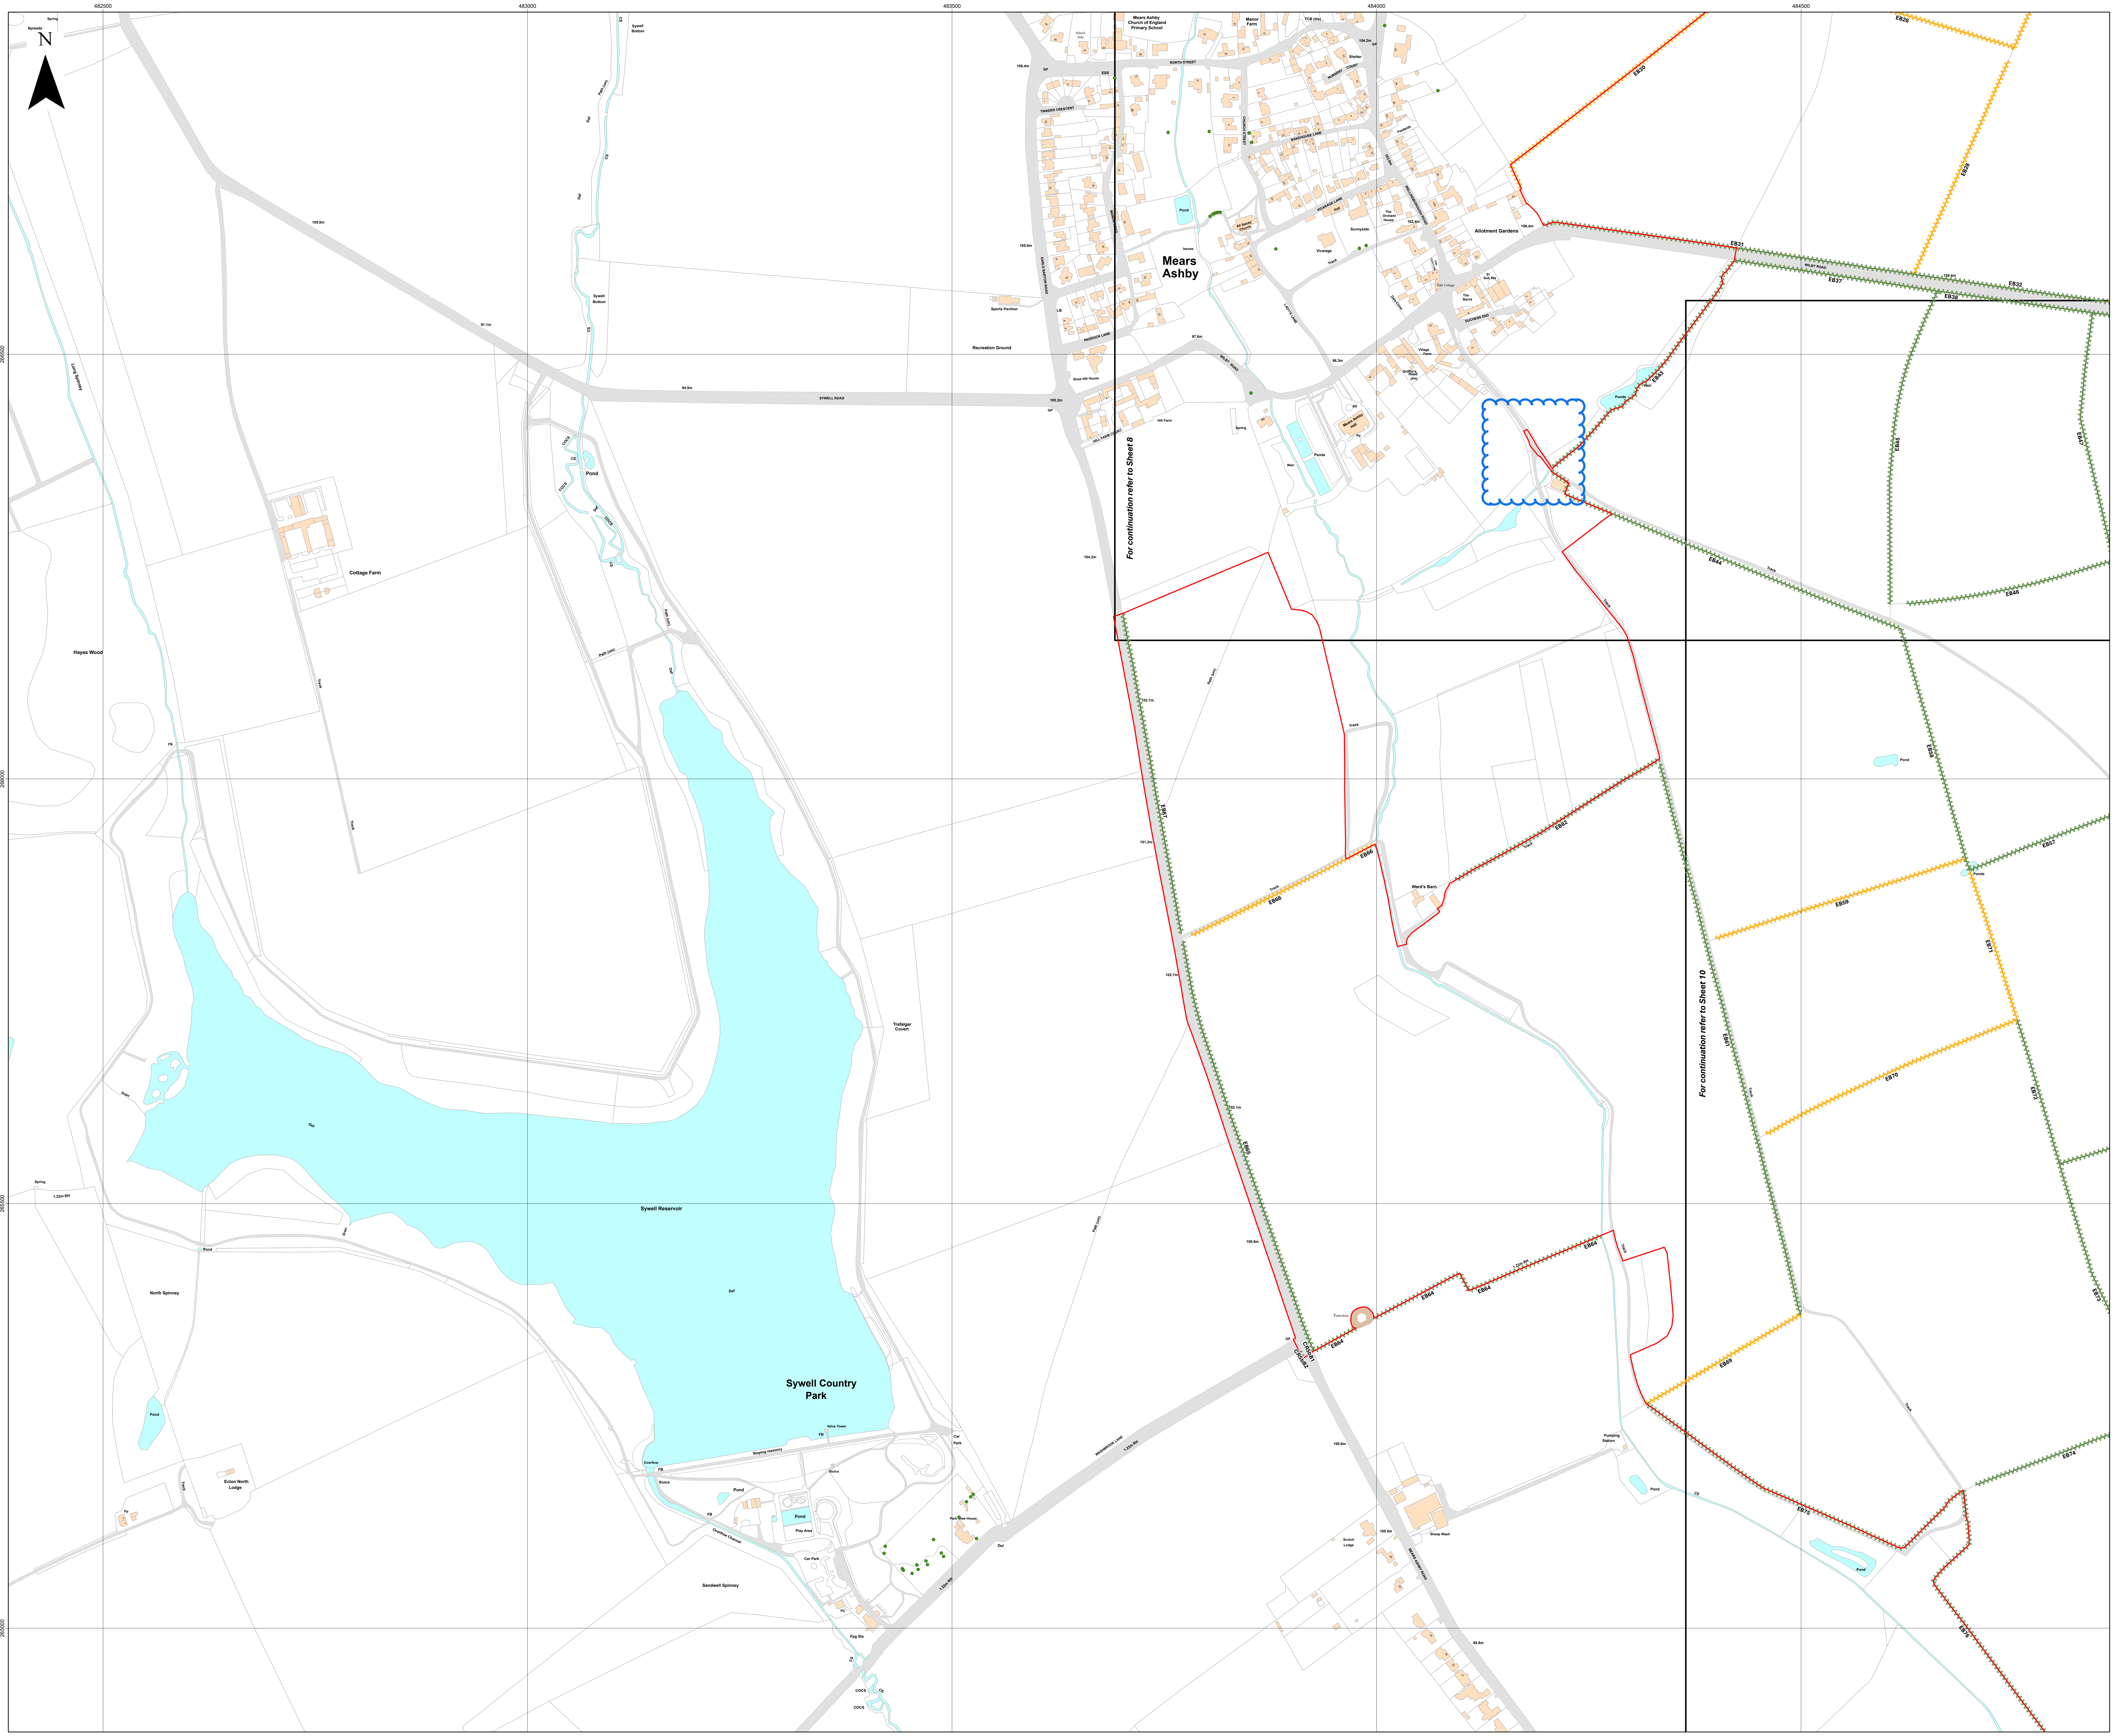
N
482500
483000
483500
484000
484500
Mears Ashby
Sywell Country Park
Sywell Reservoir
Cottage Farm
Hayes Wood
Recreation Ground
Allotment Gardens
Ward's Barn
Trafalgar Covert
North Spinney
Sandwell Spinney
Ecton North Lodge
Pond
SYWELL ROAD
For continuation refer to Sheet 8
For continuation refer to Sheet 10

Key

- 🟥 Order Limits
- ▭ Sheet Index
- Important Hedgerow
- Hedgerow

Tree Protection Order (TPO)

- ● Points

Layers: Lanpro, 2025; IGP, 2025

0 100 200 300 Meters

Scale: 1:2,500@ A0

APFP Regulation: 5(2)(q)	Application Doc No. CR1/GH2.11_B
Ref: P3535_LPR_ZZ_XX_DR_Z_0280	Date: 05/11/2025
Drawn by: BH	Checked by: JC

Important Hedgerows Plan (Change Request Version)

Sheet 9 of 18

Revision B

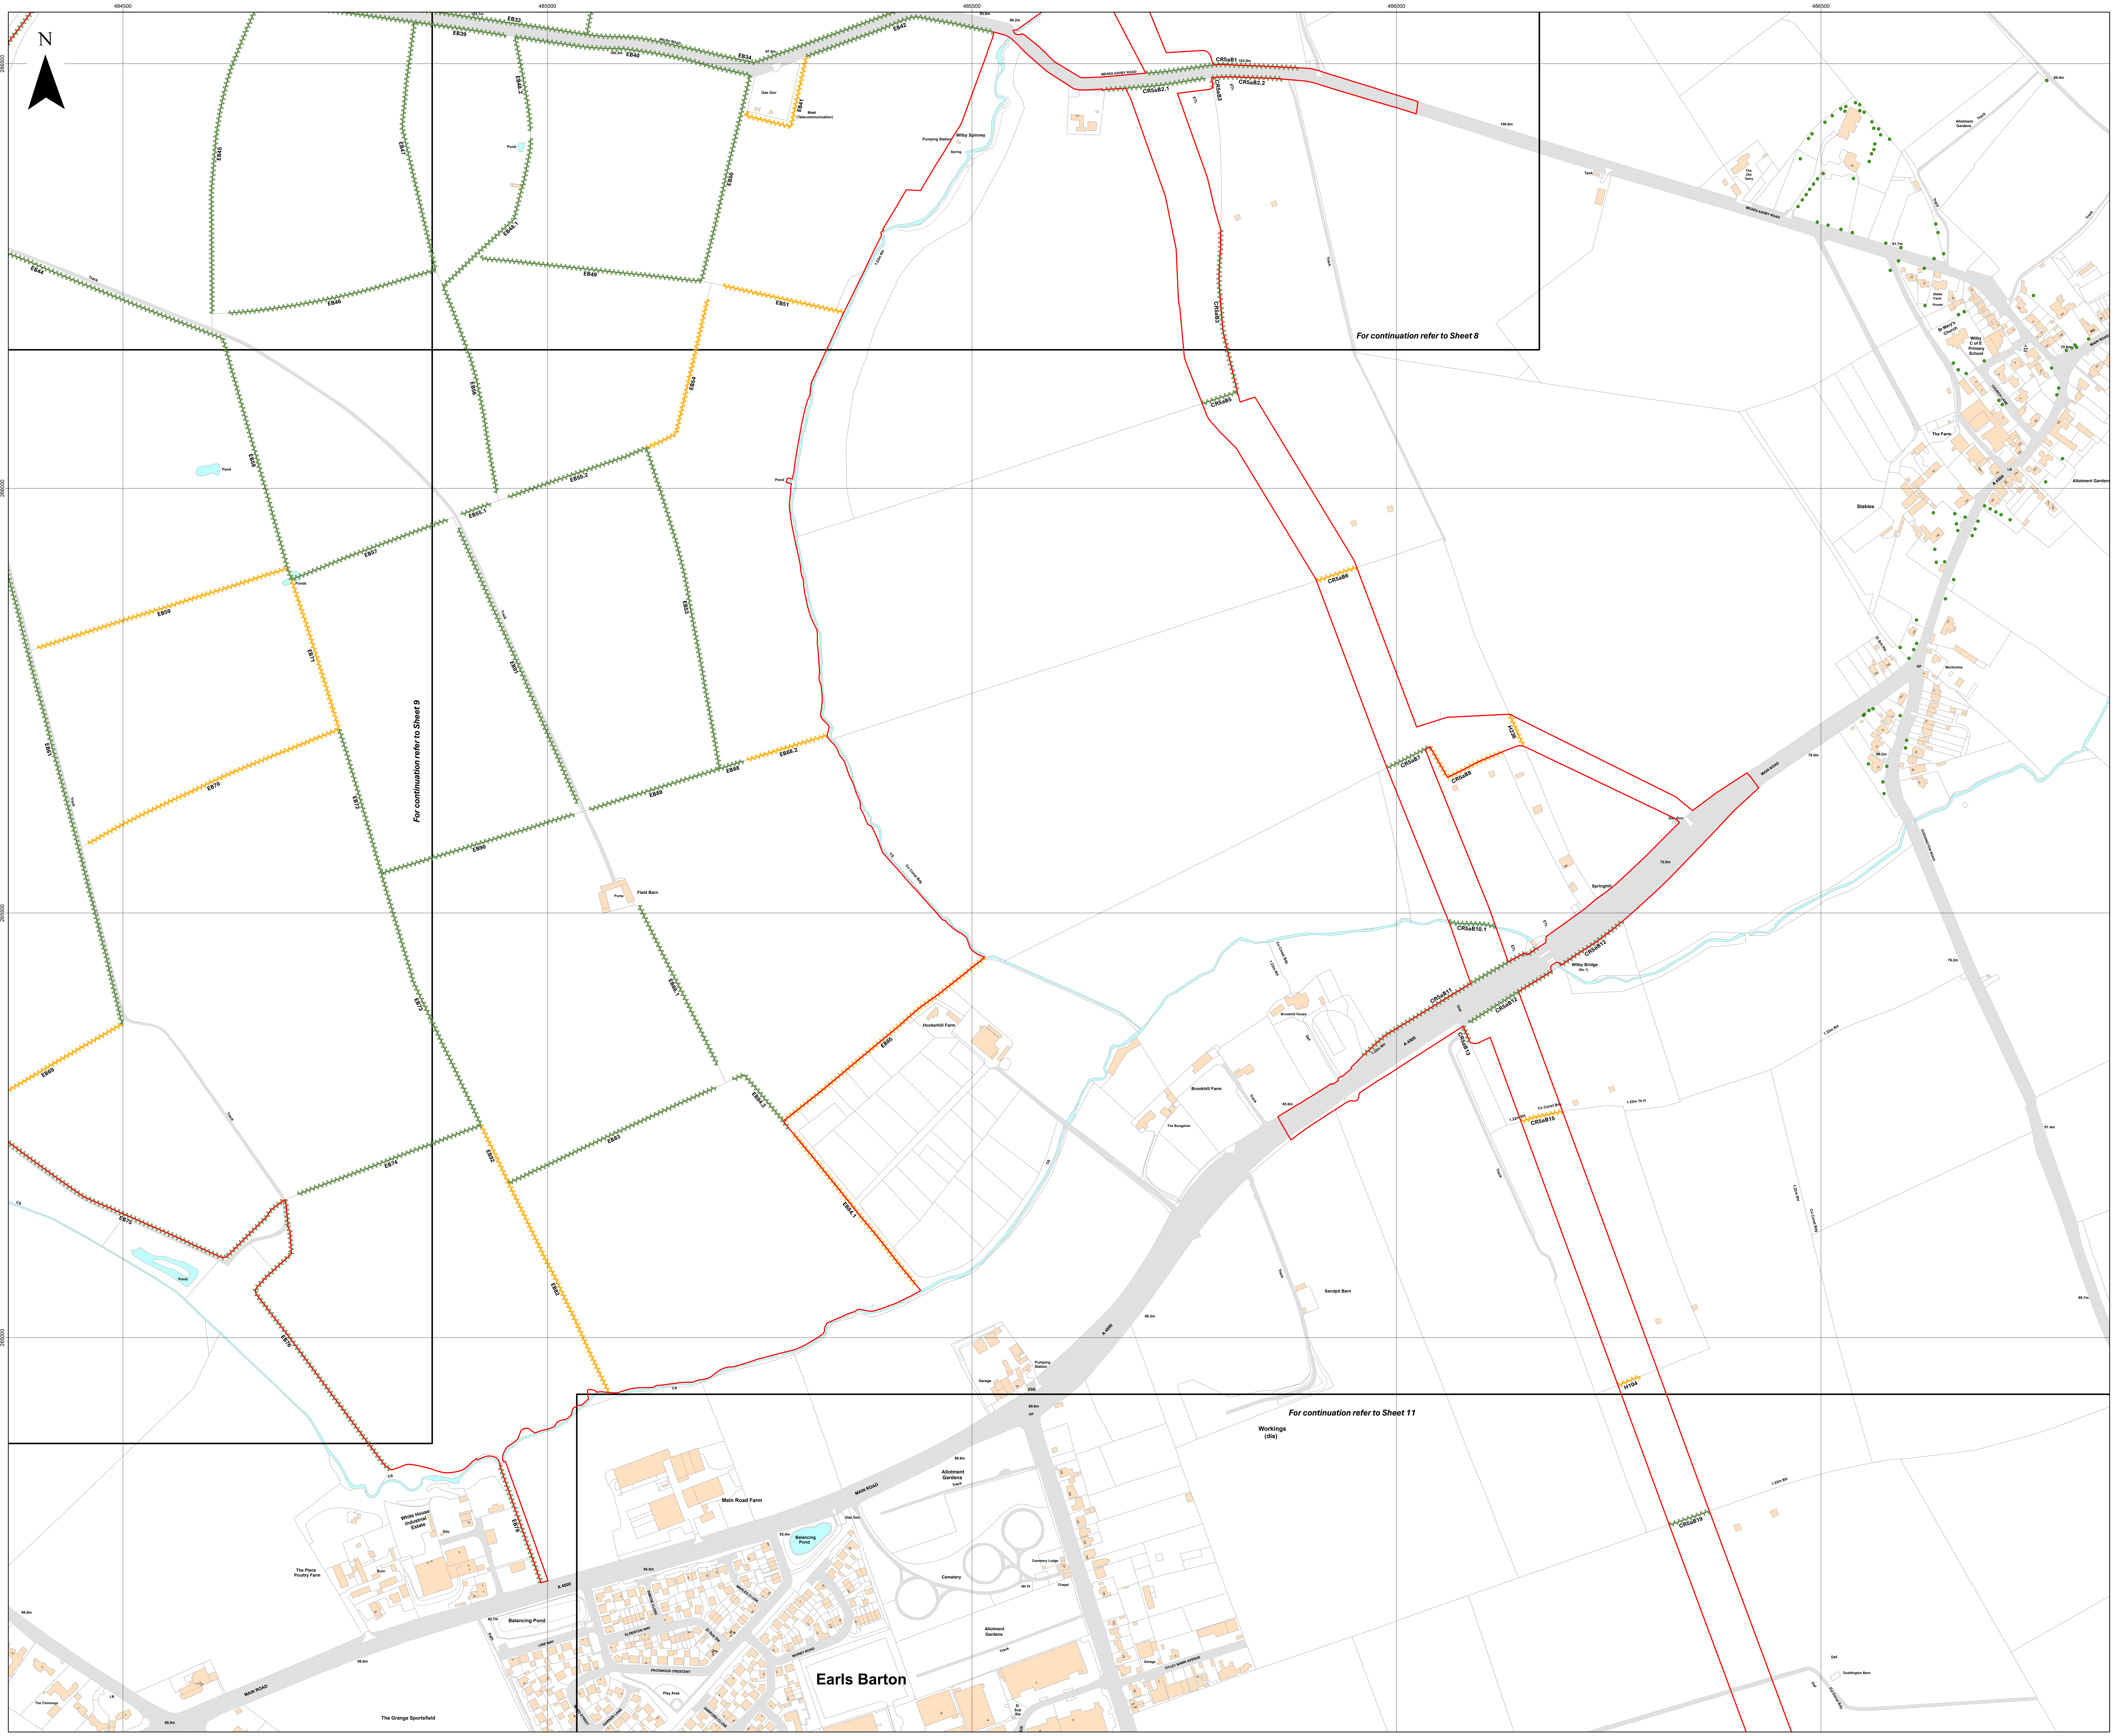
N
484500
485000
485500
486000
486500
266500
266000
265500
265000
EB33
EB34
EB39
EB40
EB41
EB42
EB44
EB45
EB46
EB47
EB48.1
EB48.2
EB49
EB50
EB51
EB53
EB54
EB55.1
EB55.2
EB56
EB57
EB58
EB59
EB61
EB69
EB70
EB71
EB72
EB73
EB74
EB75
EB76
EB78
EB82
EB83
EB84.1
EB84.2
EB85
EB86.1
EB88
EB88.2
EB89
EB90
EB91
EB92
WILBY ROAD
MEARS ASHBY ROAD
CR5aB1
CR5aB2.1
CR5aB2.2
CR5aB3
CR5aB5
CR5aB6
CR5aB7
CR5aB8
H236
CR5aB10.1
CR5aB11
CR5aB12
CR5aB13
CR5aB15
H104
CR5aB19
Gas Gov
Mast (Telecommunication)
Pond
Ponds
Track
Field Barn
Pump
Hockerhill Farm
Brookhill House
Brookhill Farm
Springhill
Wilby Bridge (No 1)
A 4500
MAIN ROAD
Stables
The Farm
Sandpit Barn
White House Industrial Estate
Main Road Farm
Allotment Gardens
Balancing Pond
Cemetery
Earls Barton
The Grange Sportsfield
Workings (dis)
Co Const Bdy
ETL
For continuation refer to Sheet 8
For continuation refer to Sheet 9
For continuation refer to Sheet 11

Island GREEN POWER

Lanpro

Key

- 🟥 Order Limits
- ☐ Sheet Index
- Important Hedgerow
- Hedgerow

Tree Protection Order (TPO)

- ● Points

Layers: Lanpro, 2025; IGP, 2025
Base map: Reproduced from Ordnance Survey digital map data © Crown copyright 2025. All rights reserved. License number 0100031673

0 100 200 300 Meters

Scale: 1:2,500@ A0

APFP Regulation: 5(2)(q)	Application Doc No. CR1/GH2.11_B
Ref: P3535_LPR_ZZ_XX_DR_Z_0280	Date: 05/11/2025
Drawn by: BH	Checked by: JC

Important Hedgerows Plan (Change Request Version)

Sheet 10 of 18

Revision B

GREEN HILL SOLAR FARM

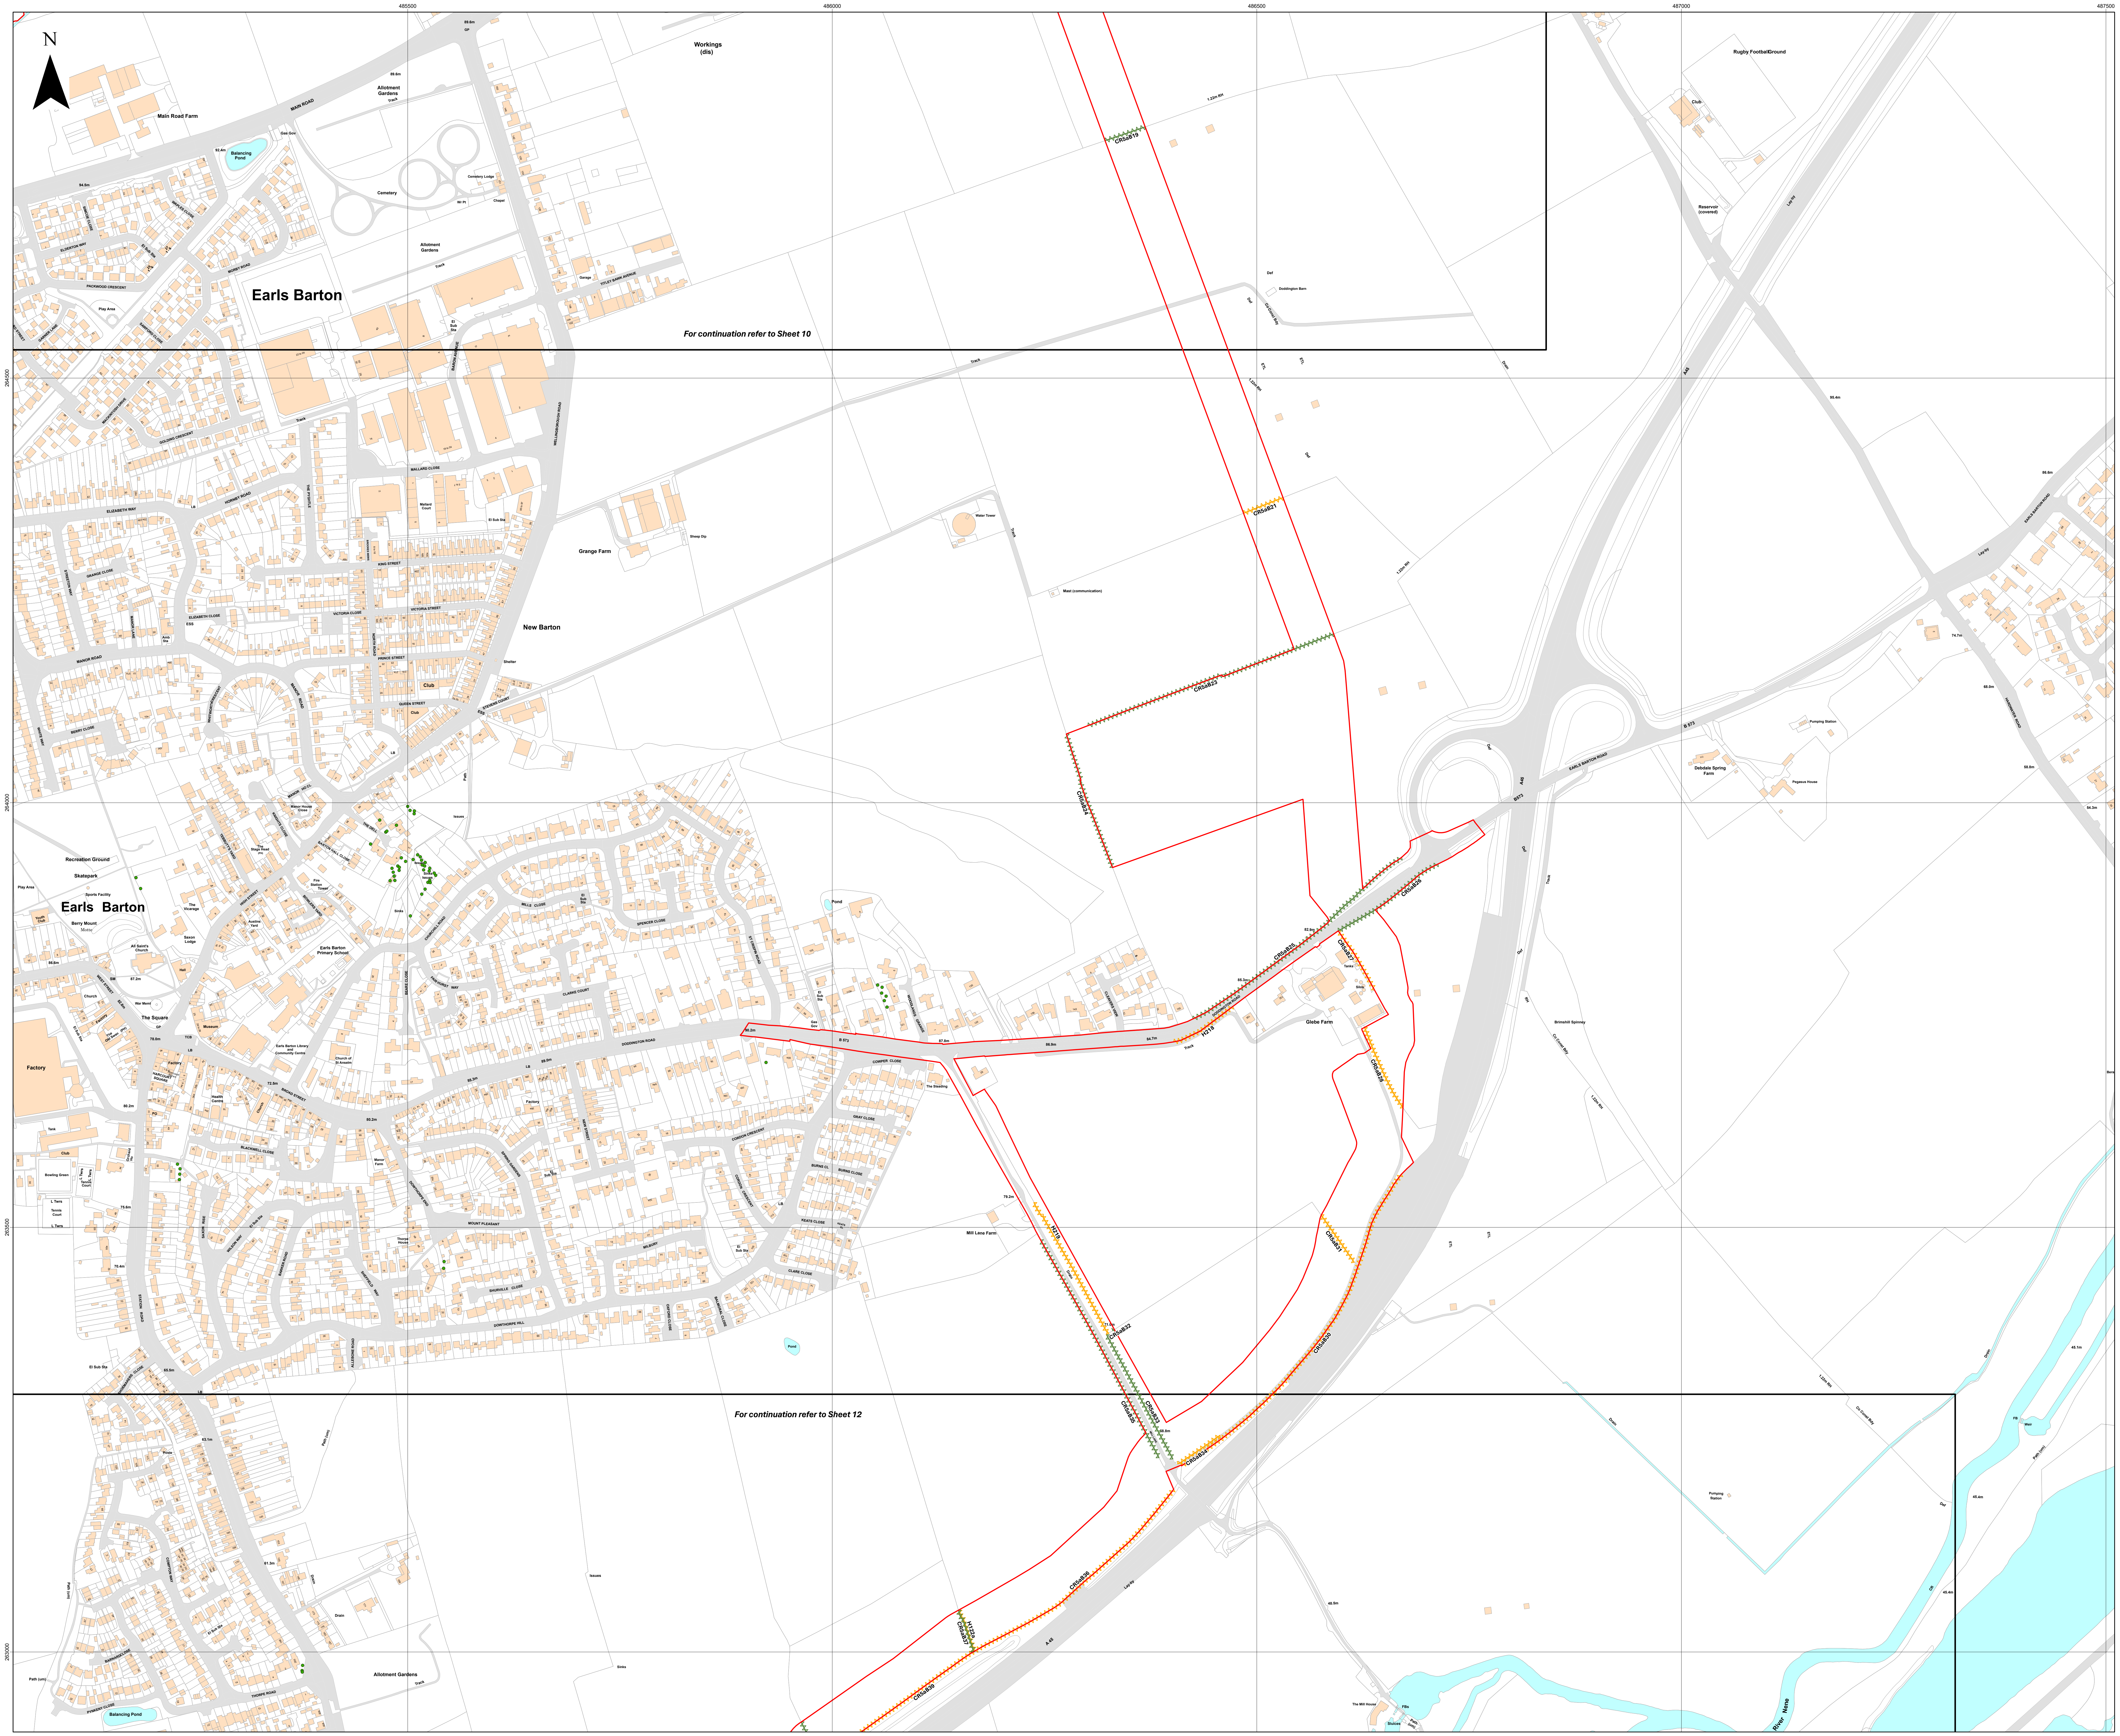
N
485500
486000
486500
487000
487500
264500
264000
263500
263000
Earls Barton
New Barton
Grange Farm
Glebe Farm
Mill Lane Farm
Doddington Barn
Mast (communication)
Rugby Football Ground
DODDINGTON ROAD
MILL LANE
A 45
Lay-by
Track
Drain
Tanks
Silos
For continuation refer to Sheet 10
For continuation refer to Sheet 12
CR5aB19
CR5aB21
CR5aB23
CR5aB24
CR5aB25
CR5aB26
CR5aB27
CR5aB28
CR5aB30
CR5aB31
CR5aB32
CR5aB33
CR5aB34
CR5aB35
CR5aB36
CR5aB37
CR5aB39
H218
H219
H122a
River Nene

Island GREEN POWER

Lanpro

Key

- 🟥 Order Limits
- ▭ Sheet Index
- Important Hedgerow
- Hedgerow

Tree Protection Order (TPO)

- ● Points

Layers: Lanpro, 2025; IGP, 2025
Base map: Reproduced from Ordnance Survey digital map data © Crown copyright 2025. All rights reserved. License number 0100031673

0 100 200 300 Meters

Scale: 1:2,500@ A0

APFP Regulation: 5(2)(q)	Application Doc No. CR1/GH2.11_B
Ref: P3535_LPR_ZZ_XX_DR_Z_0280	Date: 05/11/2025
Drawn by: BH	Checked by: JC

Important Hedgerows Plan (Change Request Version)

Sheet 11 of 18
Revision B

GREEN HILL SOLAR FARM

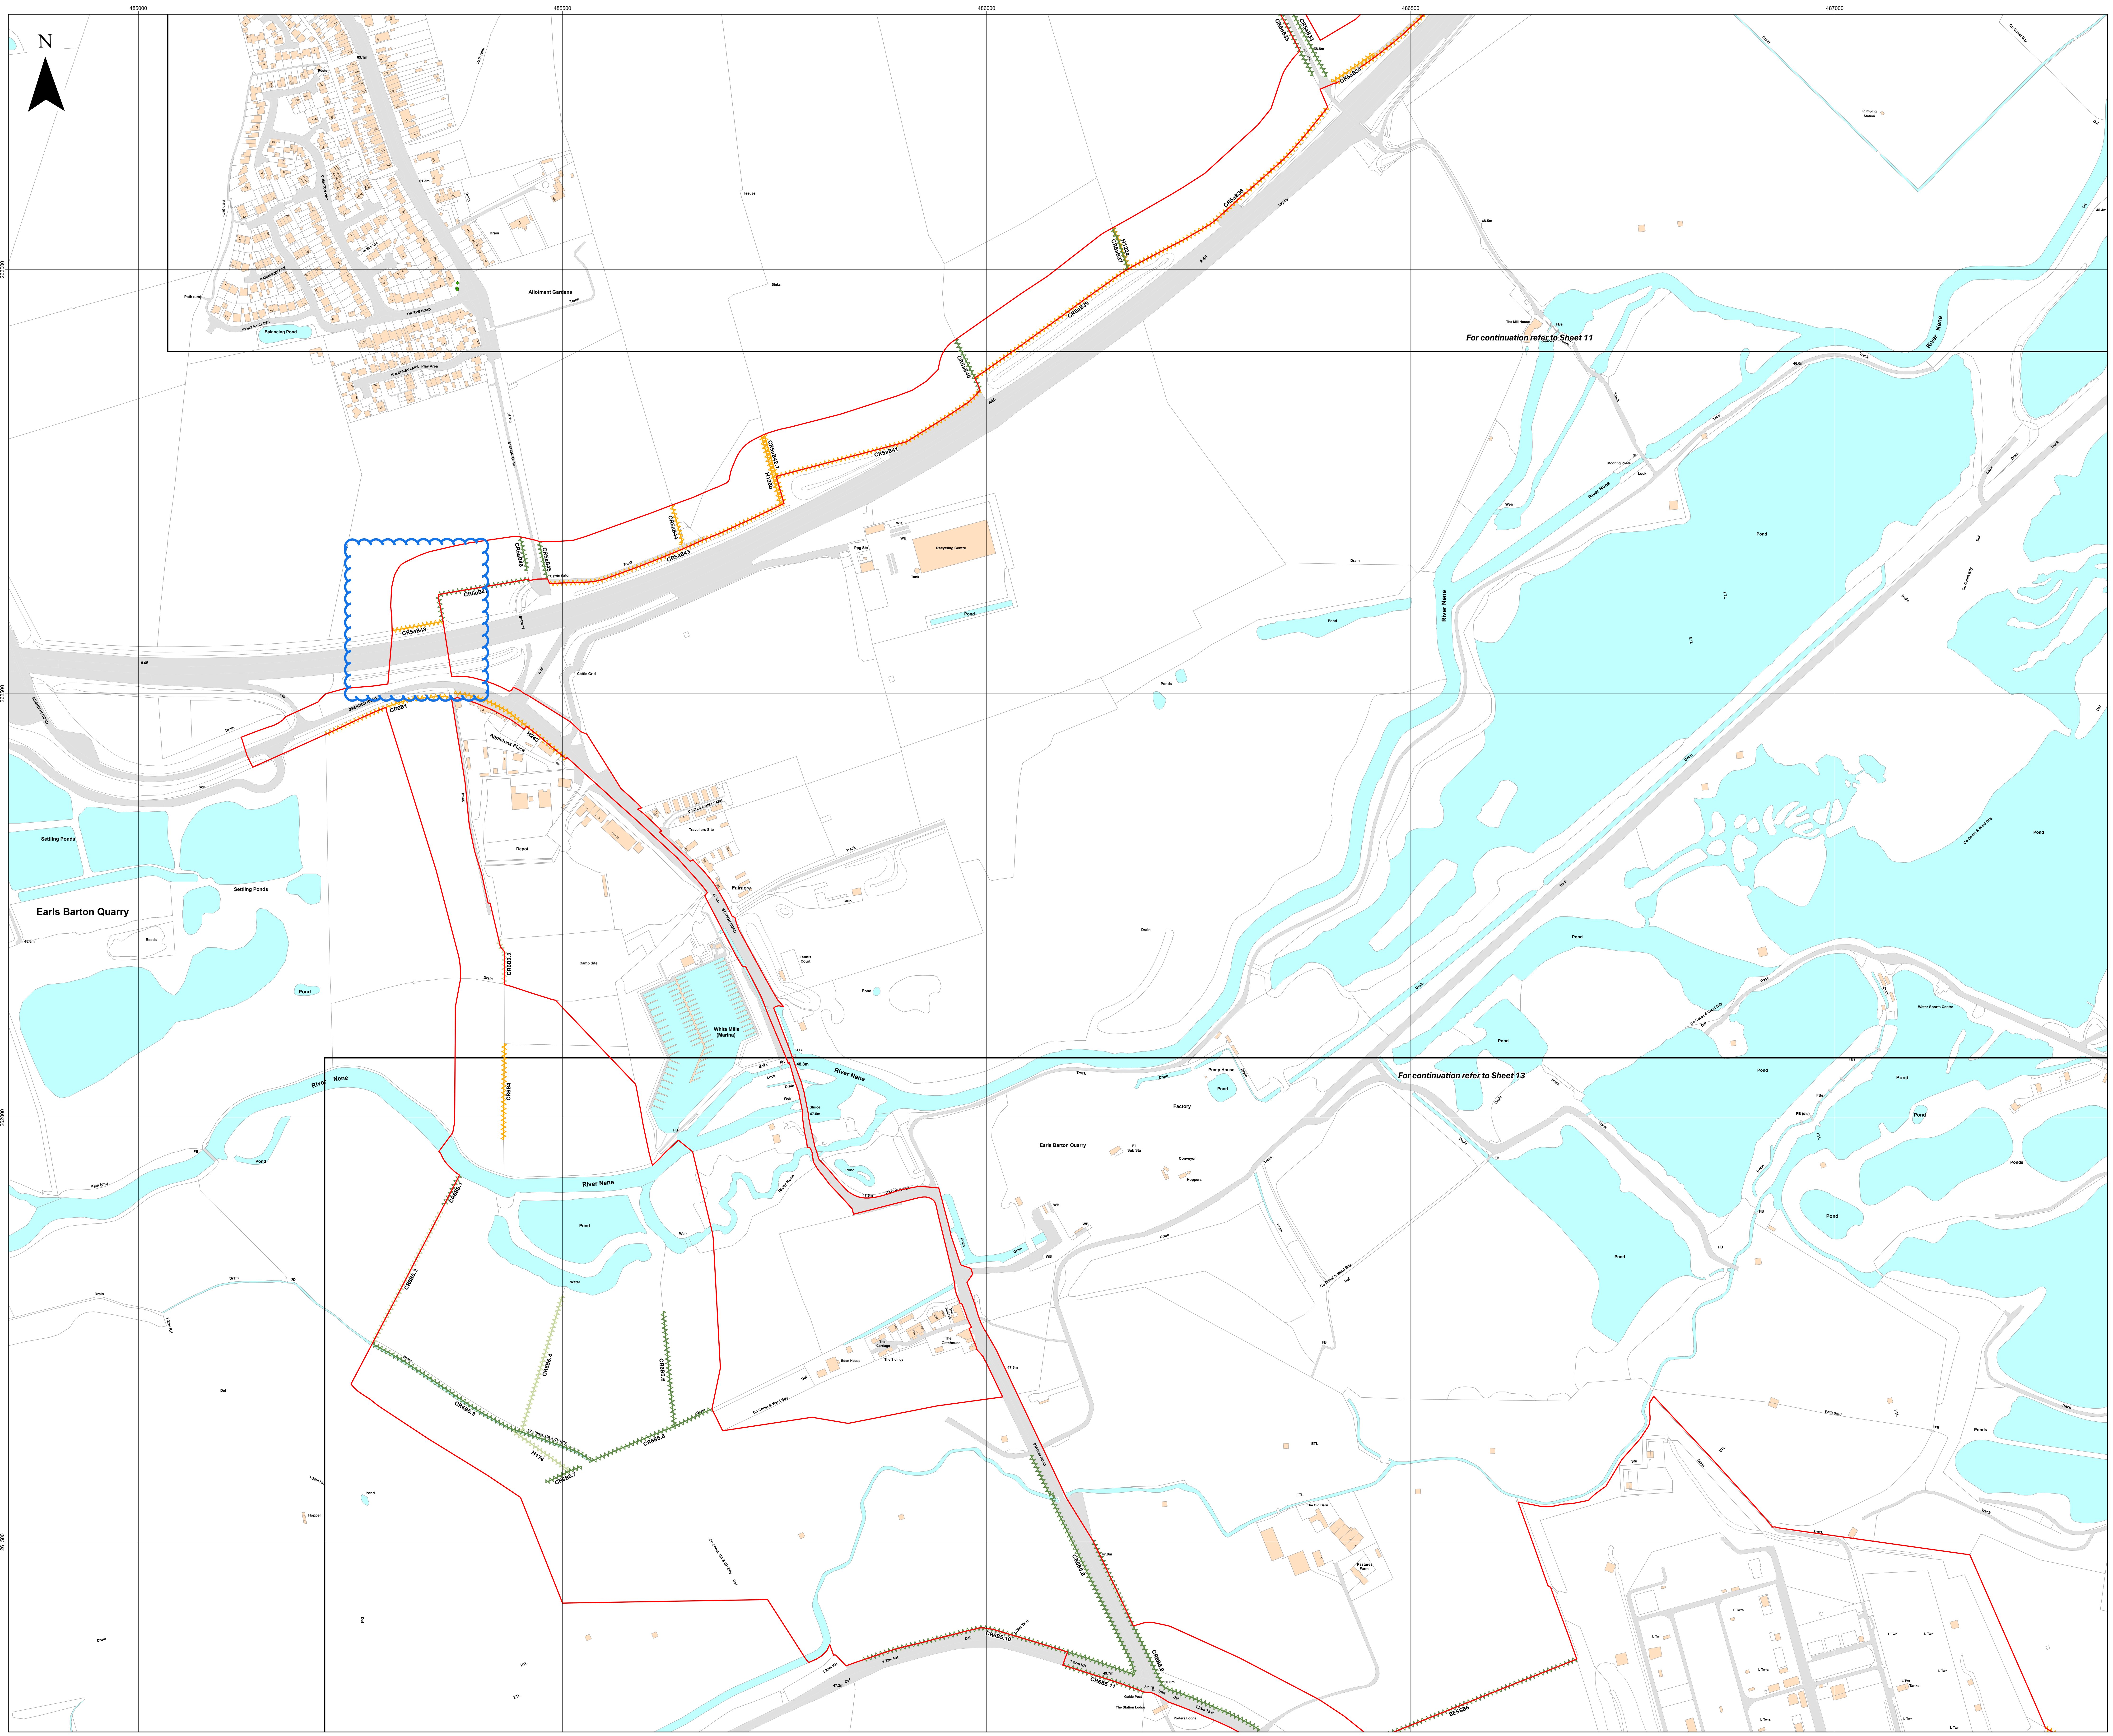
N
485000
485500
486000
486500
487000
For continuation refer to Sheet 11
For continuation refer to Sheet 13
Allotment Gardens
Balancing Pond
Recycling Centre
A45
Earls Barton Quarry
Settling Ponds
River Nene
White Mills (Marina)
Pond
Factory
Water Sports Centre
Travellers Site
Depot
Camp Site
Pumping Station

Island GREEN POWER

Lanpro

Key

- ▭ Order Limits
- ▭ Sheet Index
- Important Hedgerow
- Potentially Important Hedgerow
- Hedgerow

Tree Protection Order (TPO)

- ● Points

Layers: Lanpro, 2025; IGP, 2025

0 100 200 300 Meters

Scale: 1:2,500@ A0

APFP Regulation: 5(2)(q)	Application Doc No. CR1/GH2.11_B
Ref: P3535_LPR_ZZ_XX_DR_Z_0280	Date: 05/11/2025
Drawn by: BH	Checked by: JC

Important Hedgerows Plan (Change Request Version)

Sheet 12 of 18

Revision B

GREEN HILL SOLAR FARM

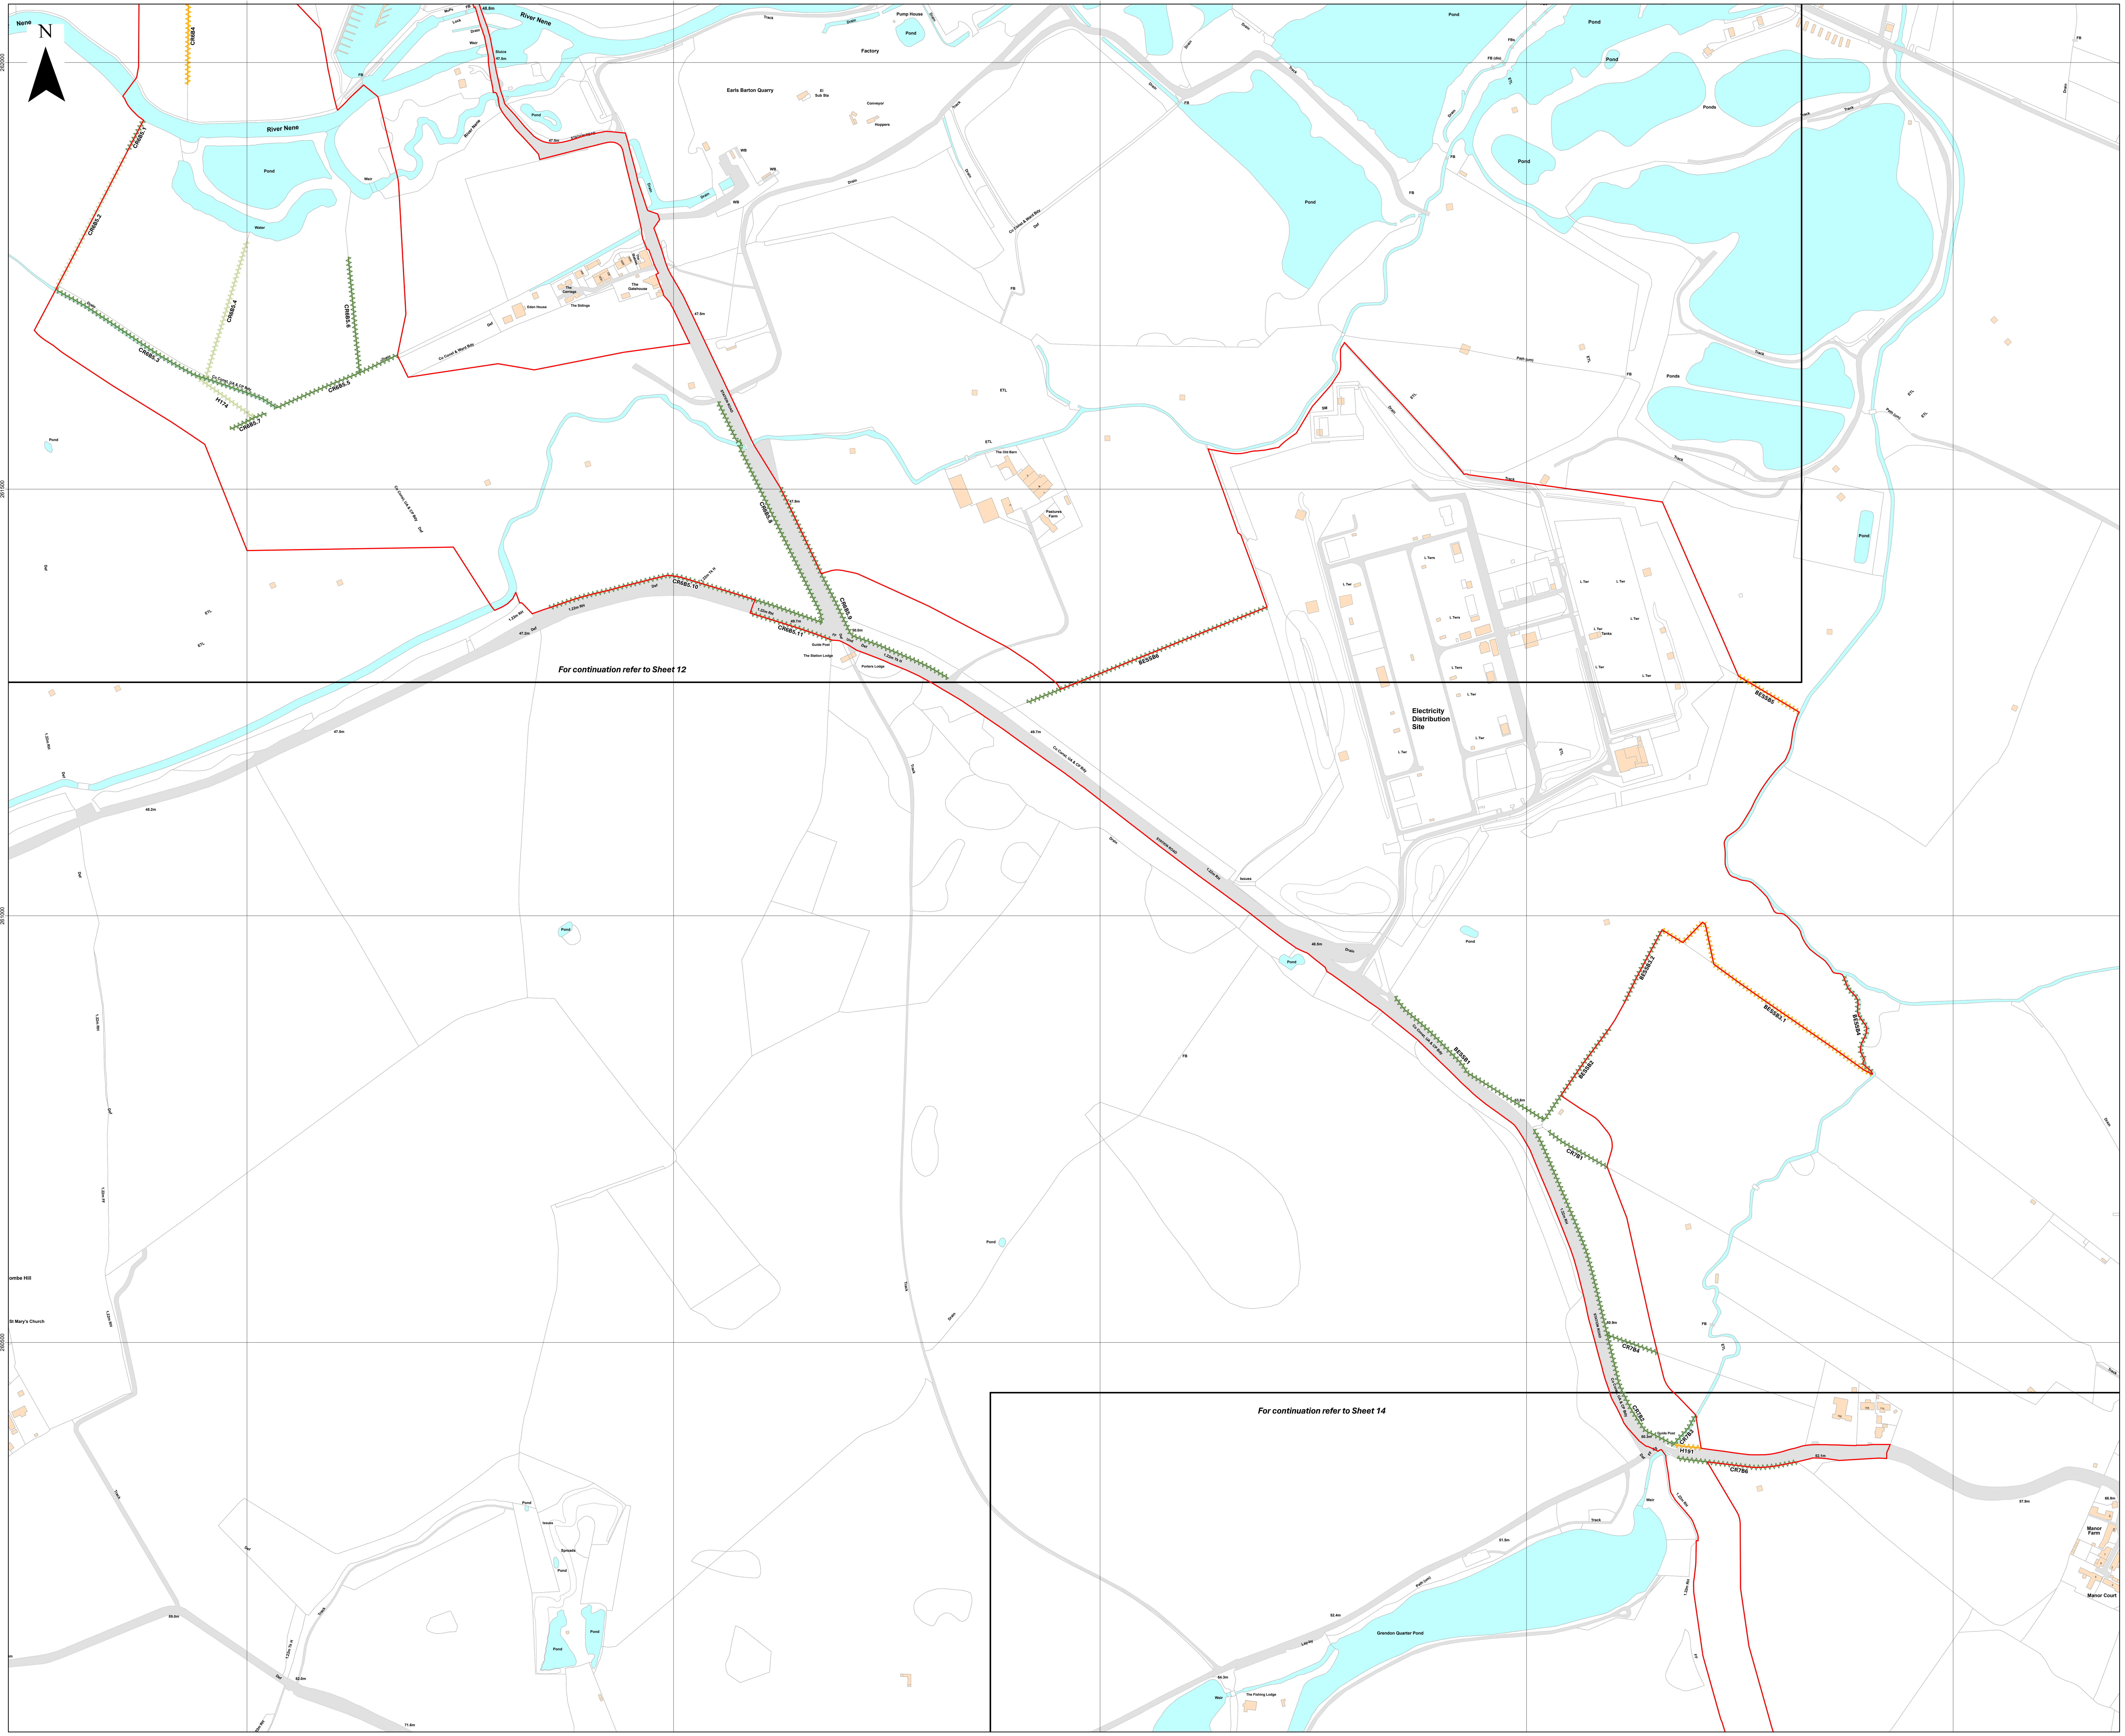
N
485500
486000
486500
487000
487500
262000
261500
261000
260500
River Nene
Earls Barton Quarry
CR6B4
CR6B5.1
CR6B5.2
CR6B5.3
CR6B5.4
CR6B5.5
CR6B5.6
CR6B5.7
H174
CR6B5.8
CR6B5.9
CR6B5.10
CR6B5.11
STATION ROAD
Pastures Farm
The Old Barn
The Station Lodge
Porters Lodge
Guide Post
BESSB6
BESSB5
Electricity Distribution Site
BESSB1
BESSB2
BESSB3.1
BESSB3.2
BESSB4
CR7B1
CR7B2
CR7B3
CR7B4
CR7B6
H191
Grendon Quarter Pond
Manor Farm
Manor Court
St Mary's Church

For continuation refer to Sheet 12

For continuation refer to Sheet 14

Island GREEN POWER

Lanpro

Key

- 🟥 Order Limits
- ⬛ Sheet Index
- Important Hedgerow
- Potentially Important Hedgerow
- Hedgerow

Layers: Lanpro, 2025; IGP, 2025

Base map: Reproduced from Ordnance Survey digital map data © Crown copyright 2025. All rights reserved. License number 0100031673

0 100 200 300 Meters

Scale: 1:2,500@ A0

APFP Regulation: 5(2)(q)	Application Doc No. CR1/GH2.11_B
Ref: P3535_LPR_ZZ_XX_DR_Z_0280	Date: 05/11/2025
Drawn by: BH	Checked by: JC

Important Hedgerows Plan (Change Request Version)

Sheet 13 of 18

Revision B

GREEN HILL SOLAR FARM

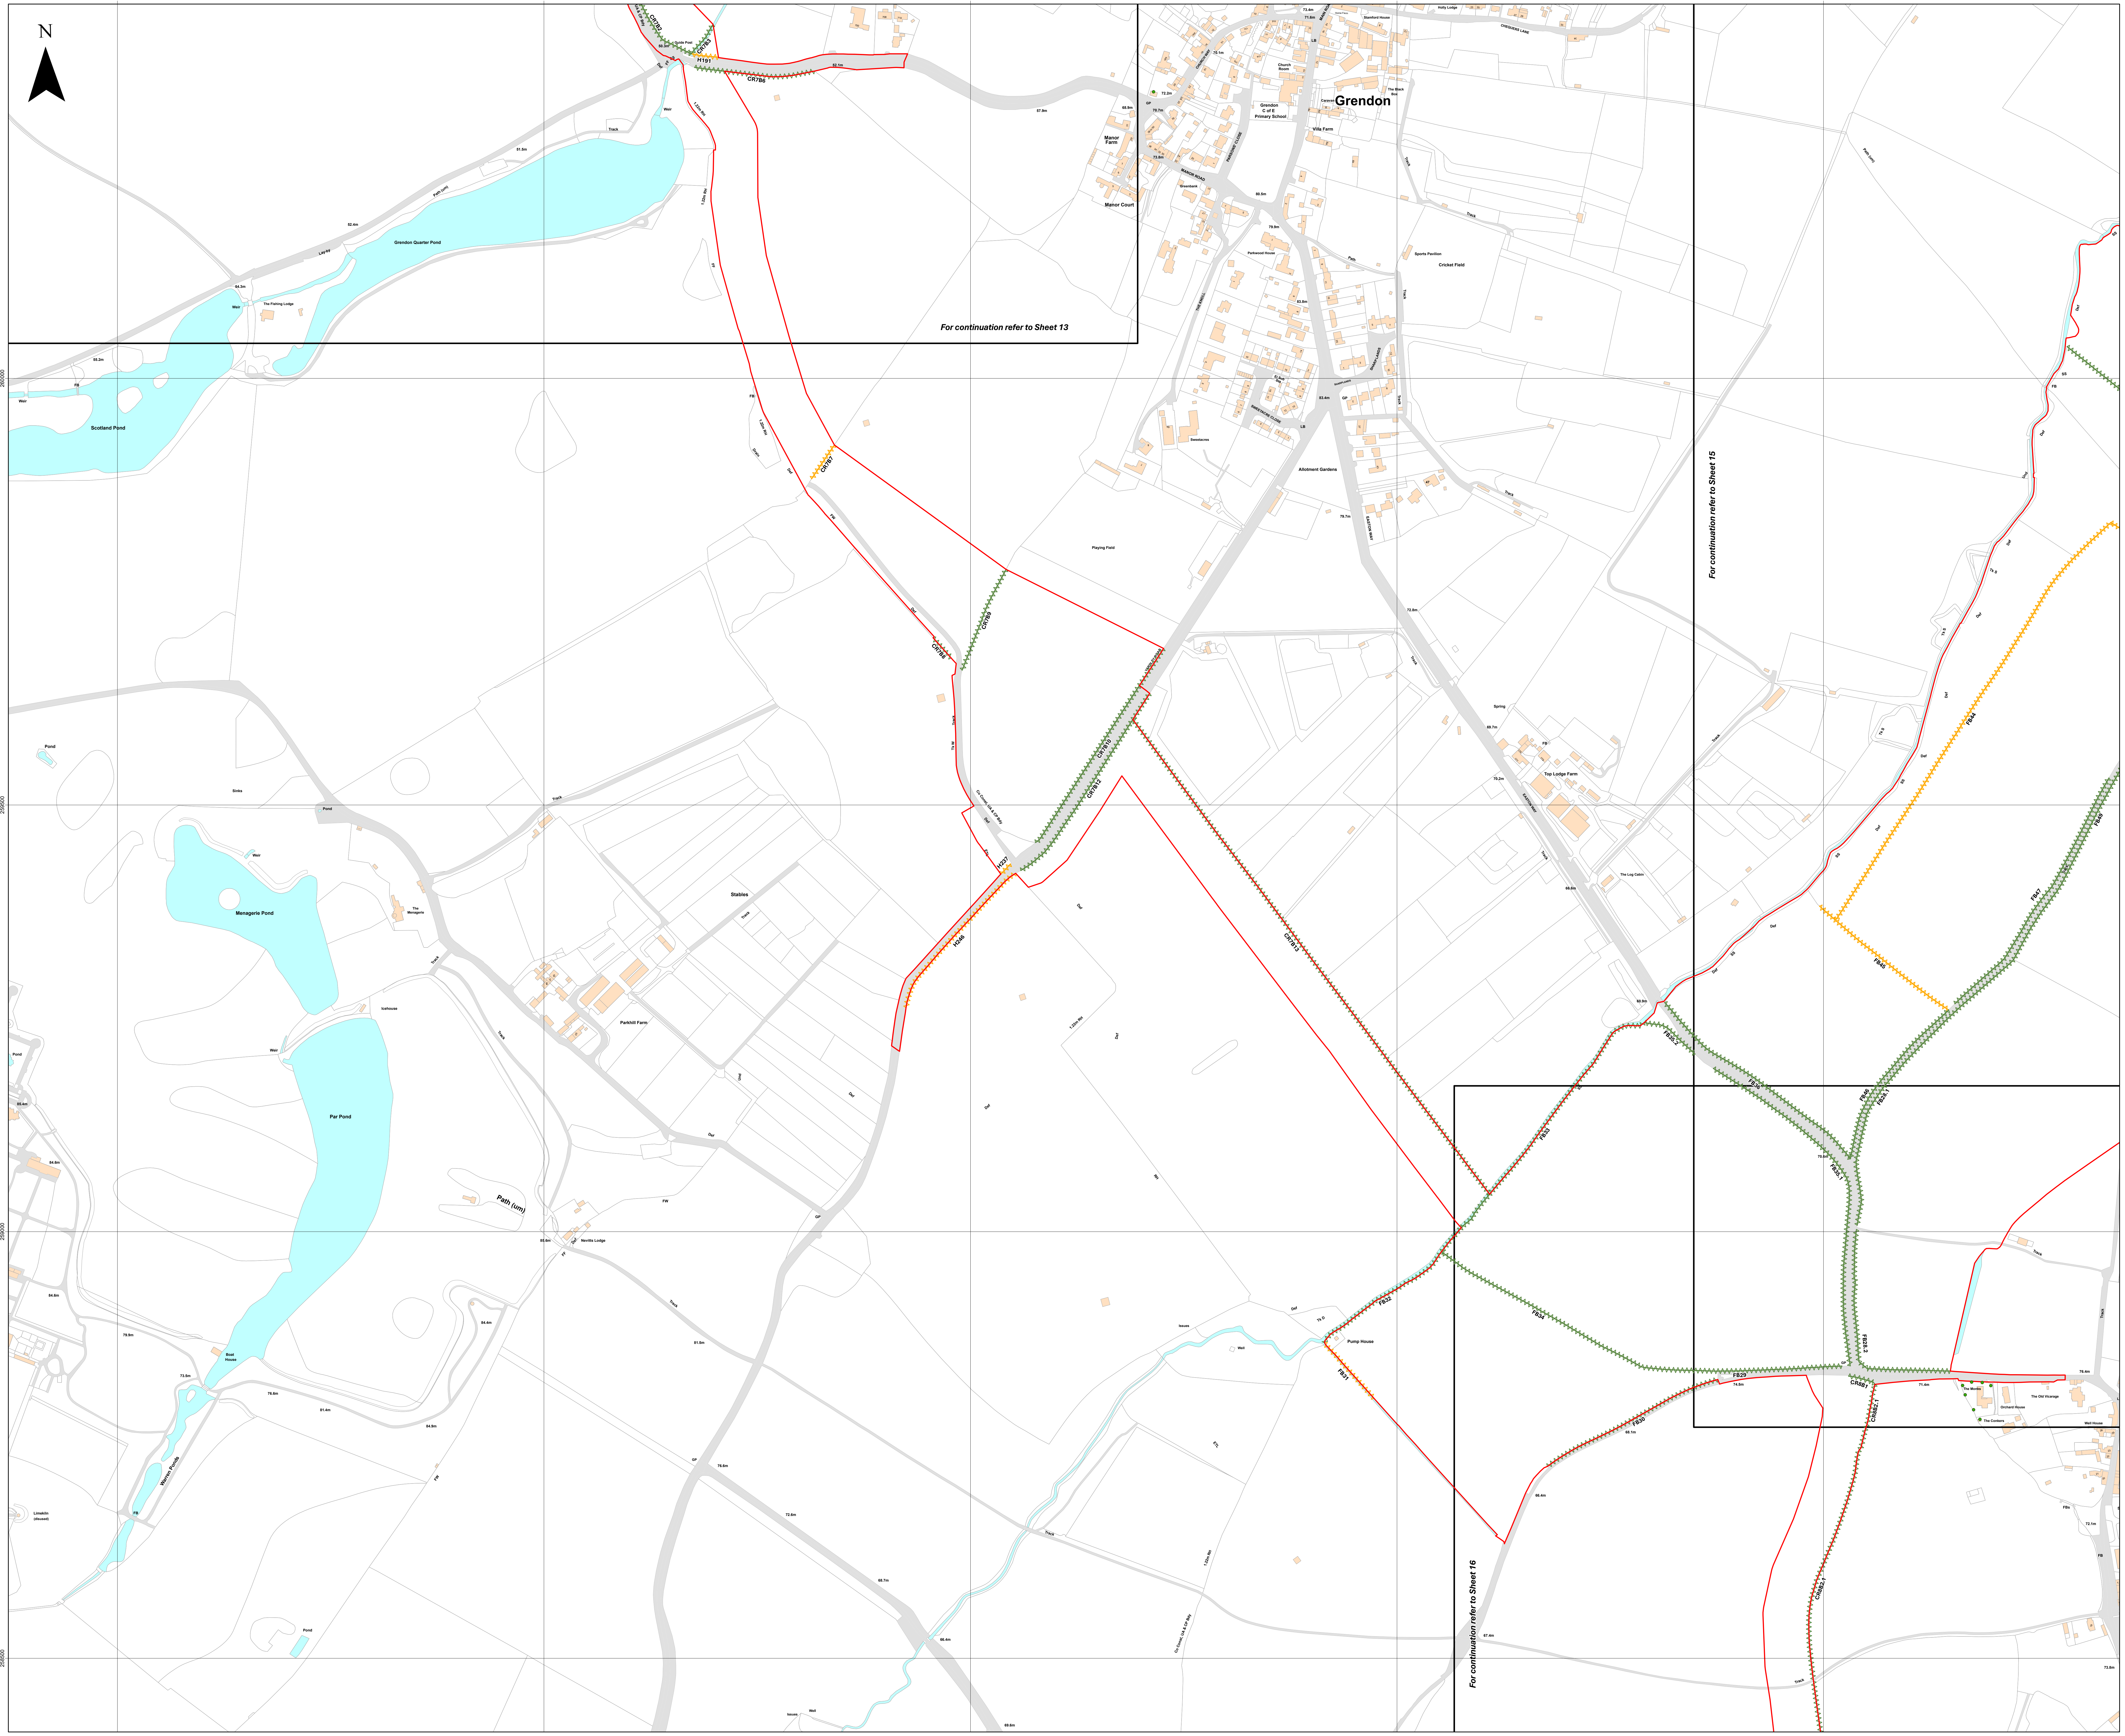
N
486500
487000
487500
488000
488500
Grendon
Grendon Quarter Pond
Scotland Pond
Menagerie Pond
Par Pond
Stables
Parkhill Farm
Manor Farm
Manor Court
Playing Field
Allotment Gardens
Top Lodge Farm
Pump House
The Monks
Orchard House
The Old Vicarage
The Conkers
Well House
CR7B2
CR7B3
H191
CR7B6
CR7B7
CR7B8
CR7B9
CR7B10
CR7B12
CR7B13
H237
H246
FB29
FB30
FB31
FB32
FB33
FB34
FB35.1
FB35.2
FB36
FB44
FB45
FB46
FB47
FB49
FB28.1
FB28.2
CR8B1
CR8B2.1
For continuation refer to Sheet 13
For continuation refer to Sheet 15
For continuation refer to Sheet 16

Key

- 🟥 Order Limits
- ▭ Sheet Index
- Important Hedgerow
- Hedgerow

Tree Protection Order (TPO)

- ● Points

Layers: Lanpro, 2025; IGP, 2025

Base map: Reproduced from Ordnance Survey digital map data © Crown copyright 2025. All rights reserved. License number 0100031673

0 100 200 300 Meters

Scale: 1:2,500@ A0

APFP Regulation: 5(2)(q)	Application Doc No. CR1/GH2.11_B
Ref: P3535_LPR_ZZ_XX_DR_Z_0280	Date: 05/11/2025
Drawn by: BH	Checked by: JC

Important Hedgerows Plan (Change Request Version)

Sheet 14 of 18

Revision B

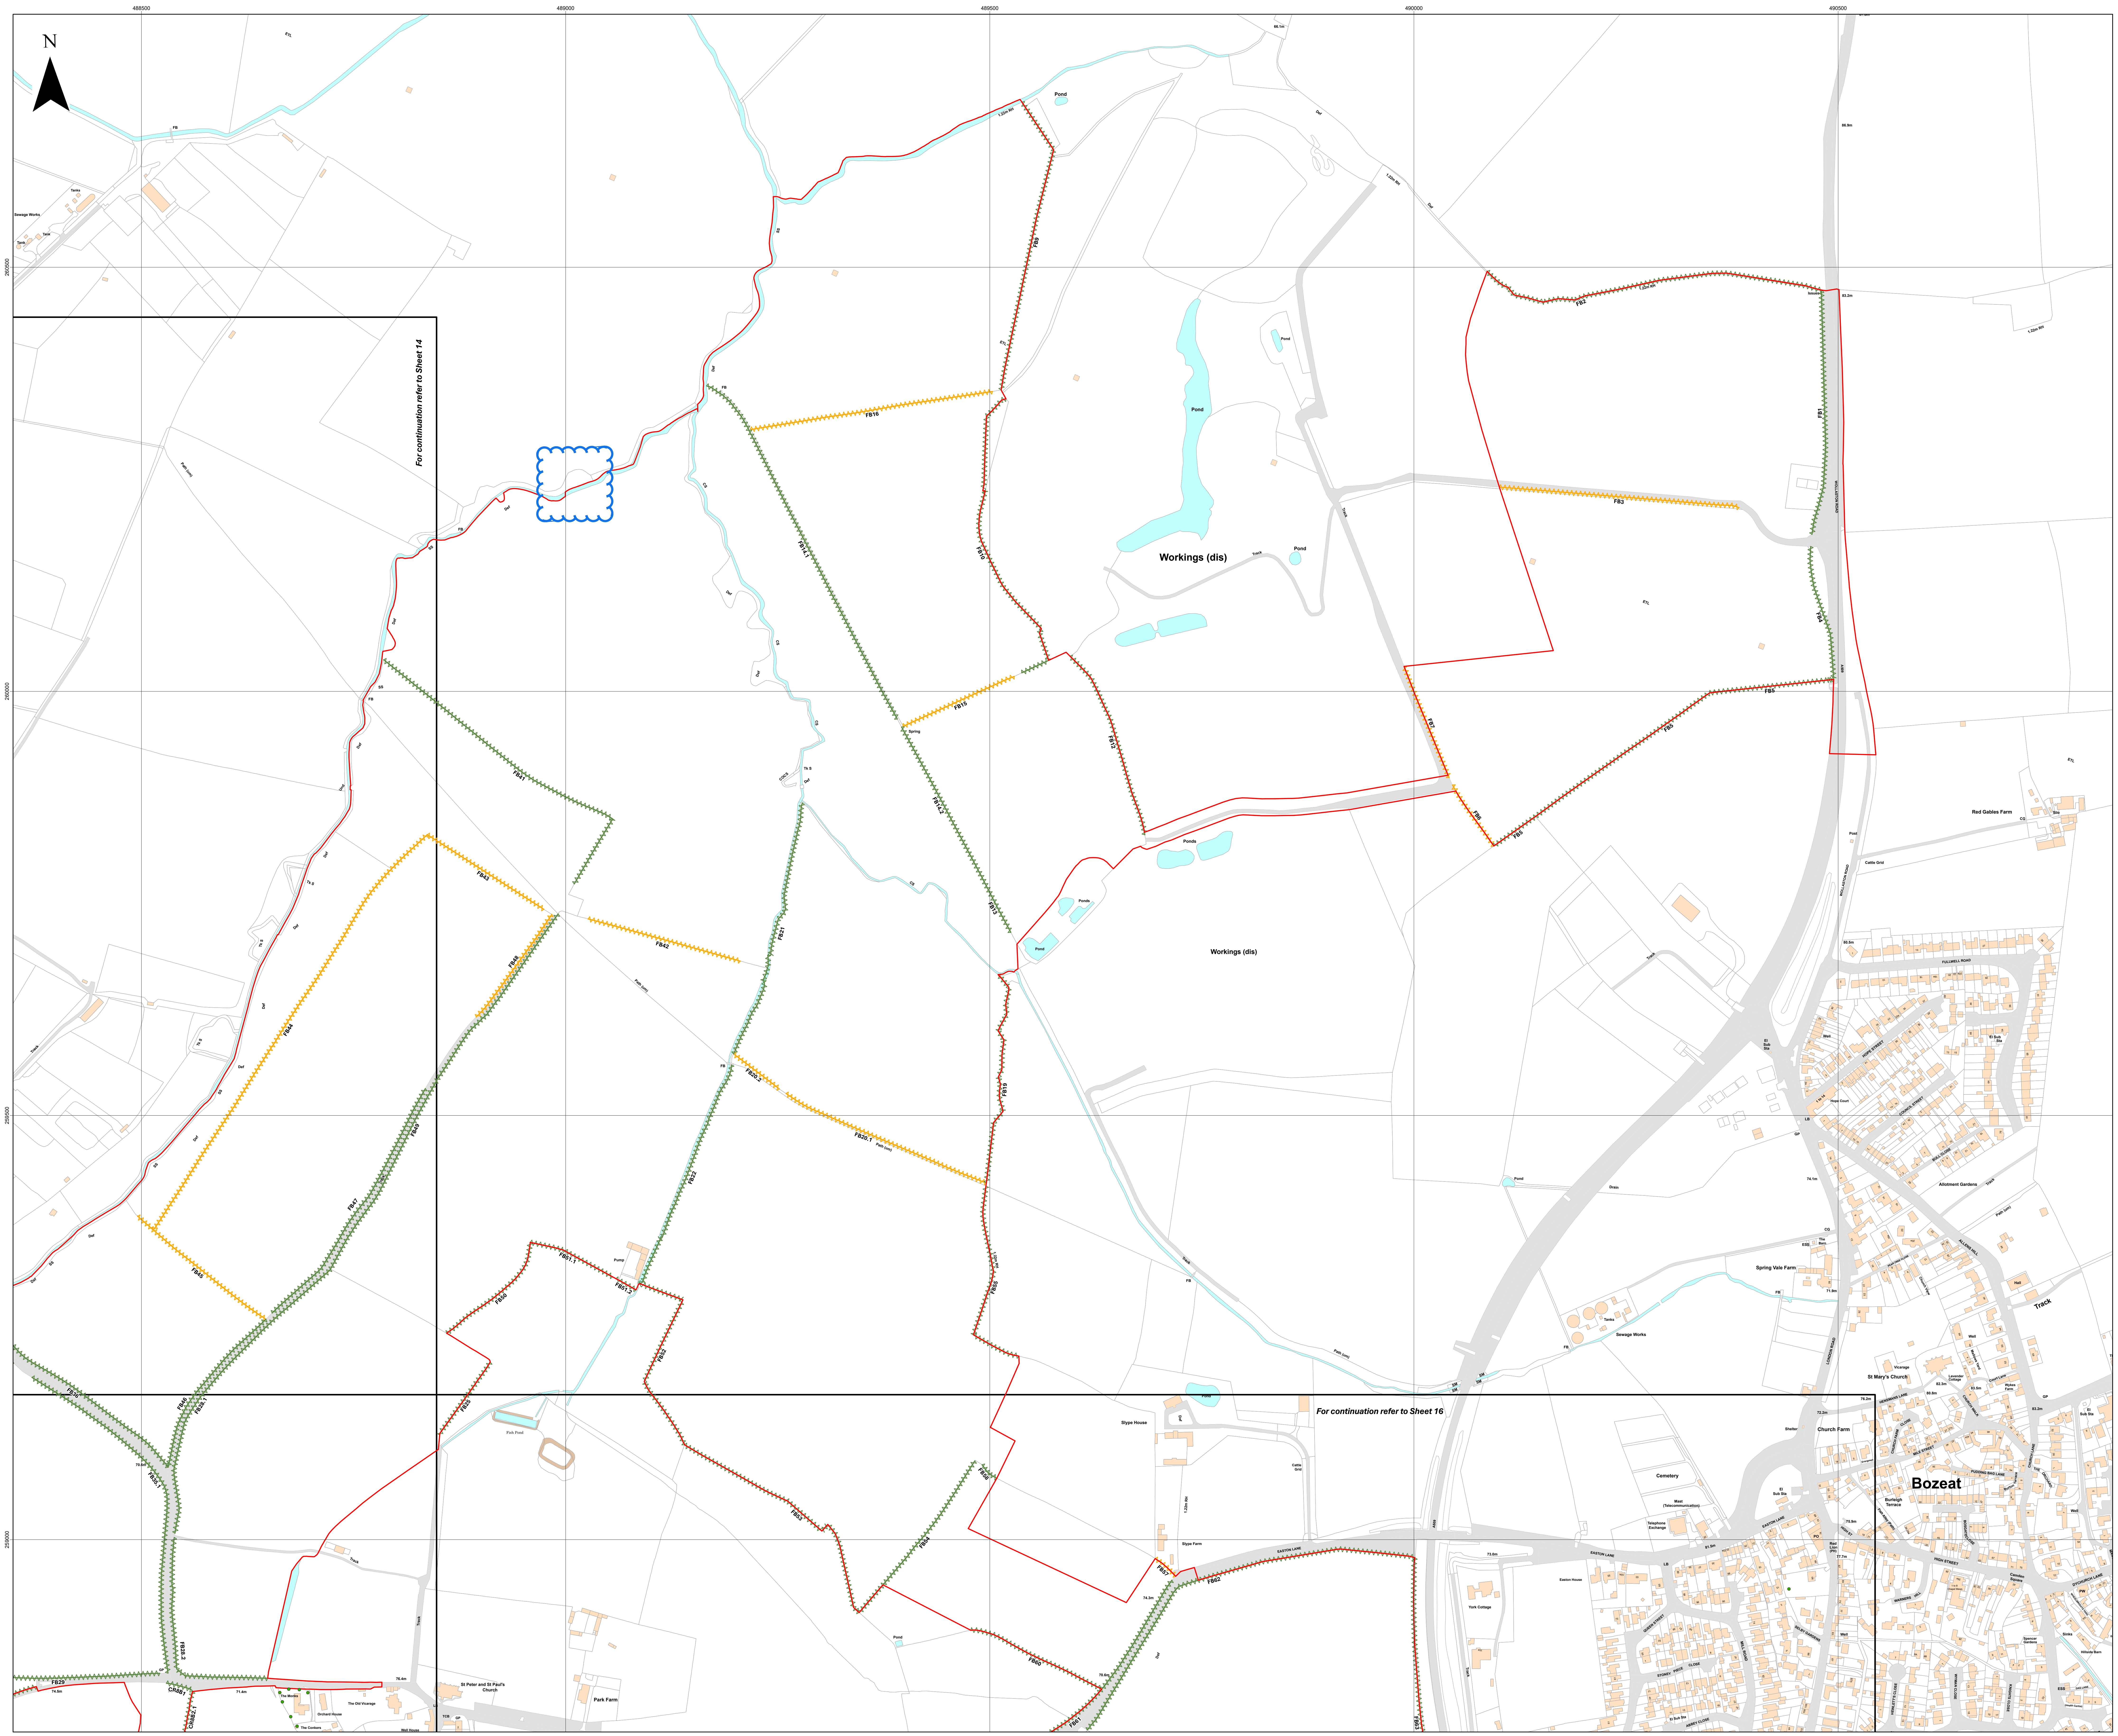
N
488500
489000
489500
490000
490500
For continuation refer to Sheet 14
For continuation refer to Sheet 16
Workings (dis)
Pond
Ponds
Bozeat
Red Gables Farm
Spring Vale Farm
Sewage Works
Allotment Gardens
St Mary's Church
Church Farm
Cemetery
Stype House
Stype Farm
Easton House
St Peter and St Paul's Church
Park Farm
FB16
FB15
FB3
FB2
FB5
FB6
FB42
FB43
FB44
FB45
FB46
FB47
FB20.1
FB29

Key

- 🟥 Order Limits
- ▭ Sheet Index
- Important Hedgerow
- Hedgerow

Tree Protection Order (TPO)

- ● Points

Layers: Lanpro, 2025; IGP, 2025
Base map: Reproduced from Ordnance Survey digital map data © Crown copyright 2025. All rights reserved. License number 0100031673

0 100 200 300 Meters

Scale: 1:2,500@ A0

APFP Regulation: 5(2)(q)	Application Doc No. CR1/GH2.11_B
Ref: P3535_LPR_ZZ_XX_DR_Z_0280	Date: 05/11/2025
Drawn by: BH	Checked by: JC

Important Hedgerows Plan (Change Request Version)

Sheet 15 of 18
Revision B

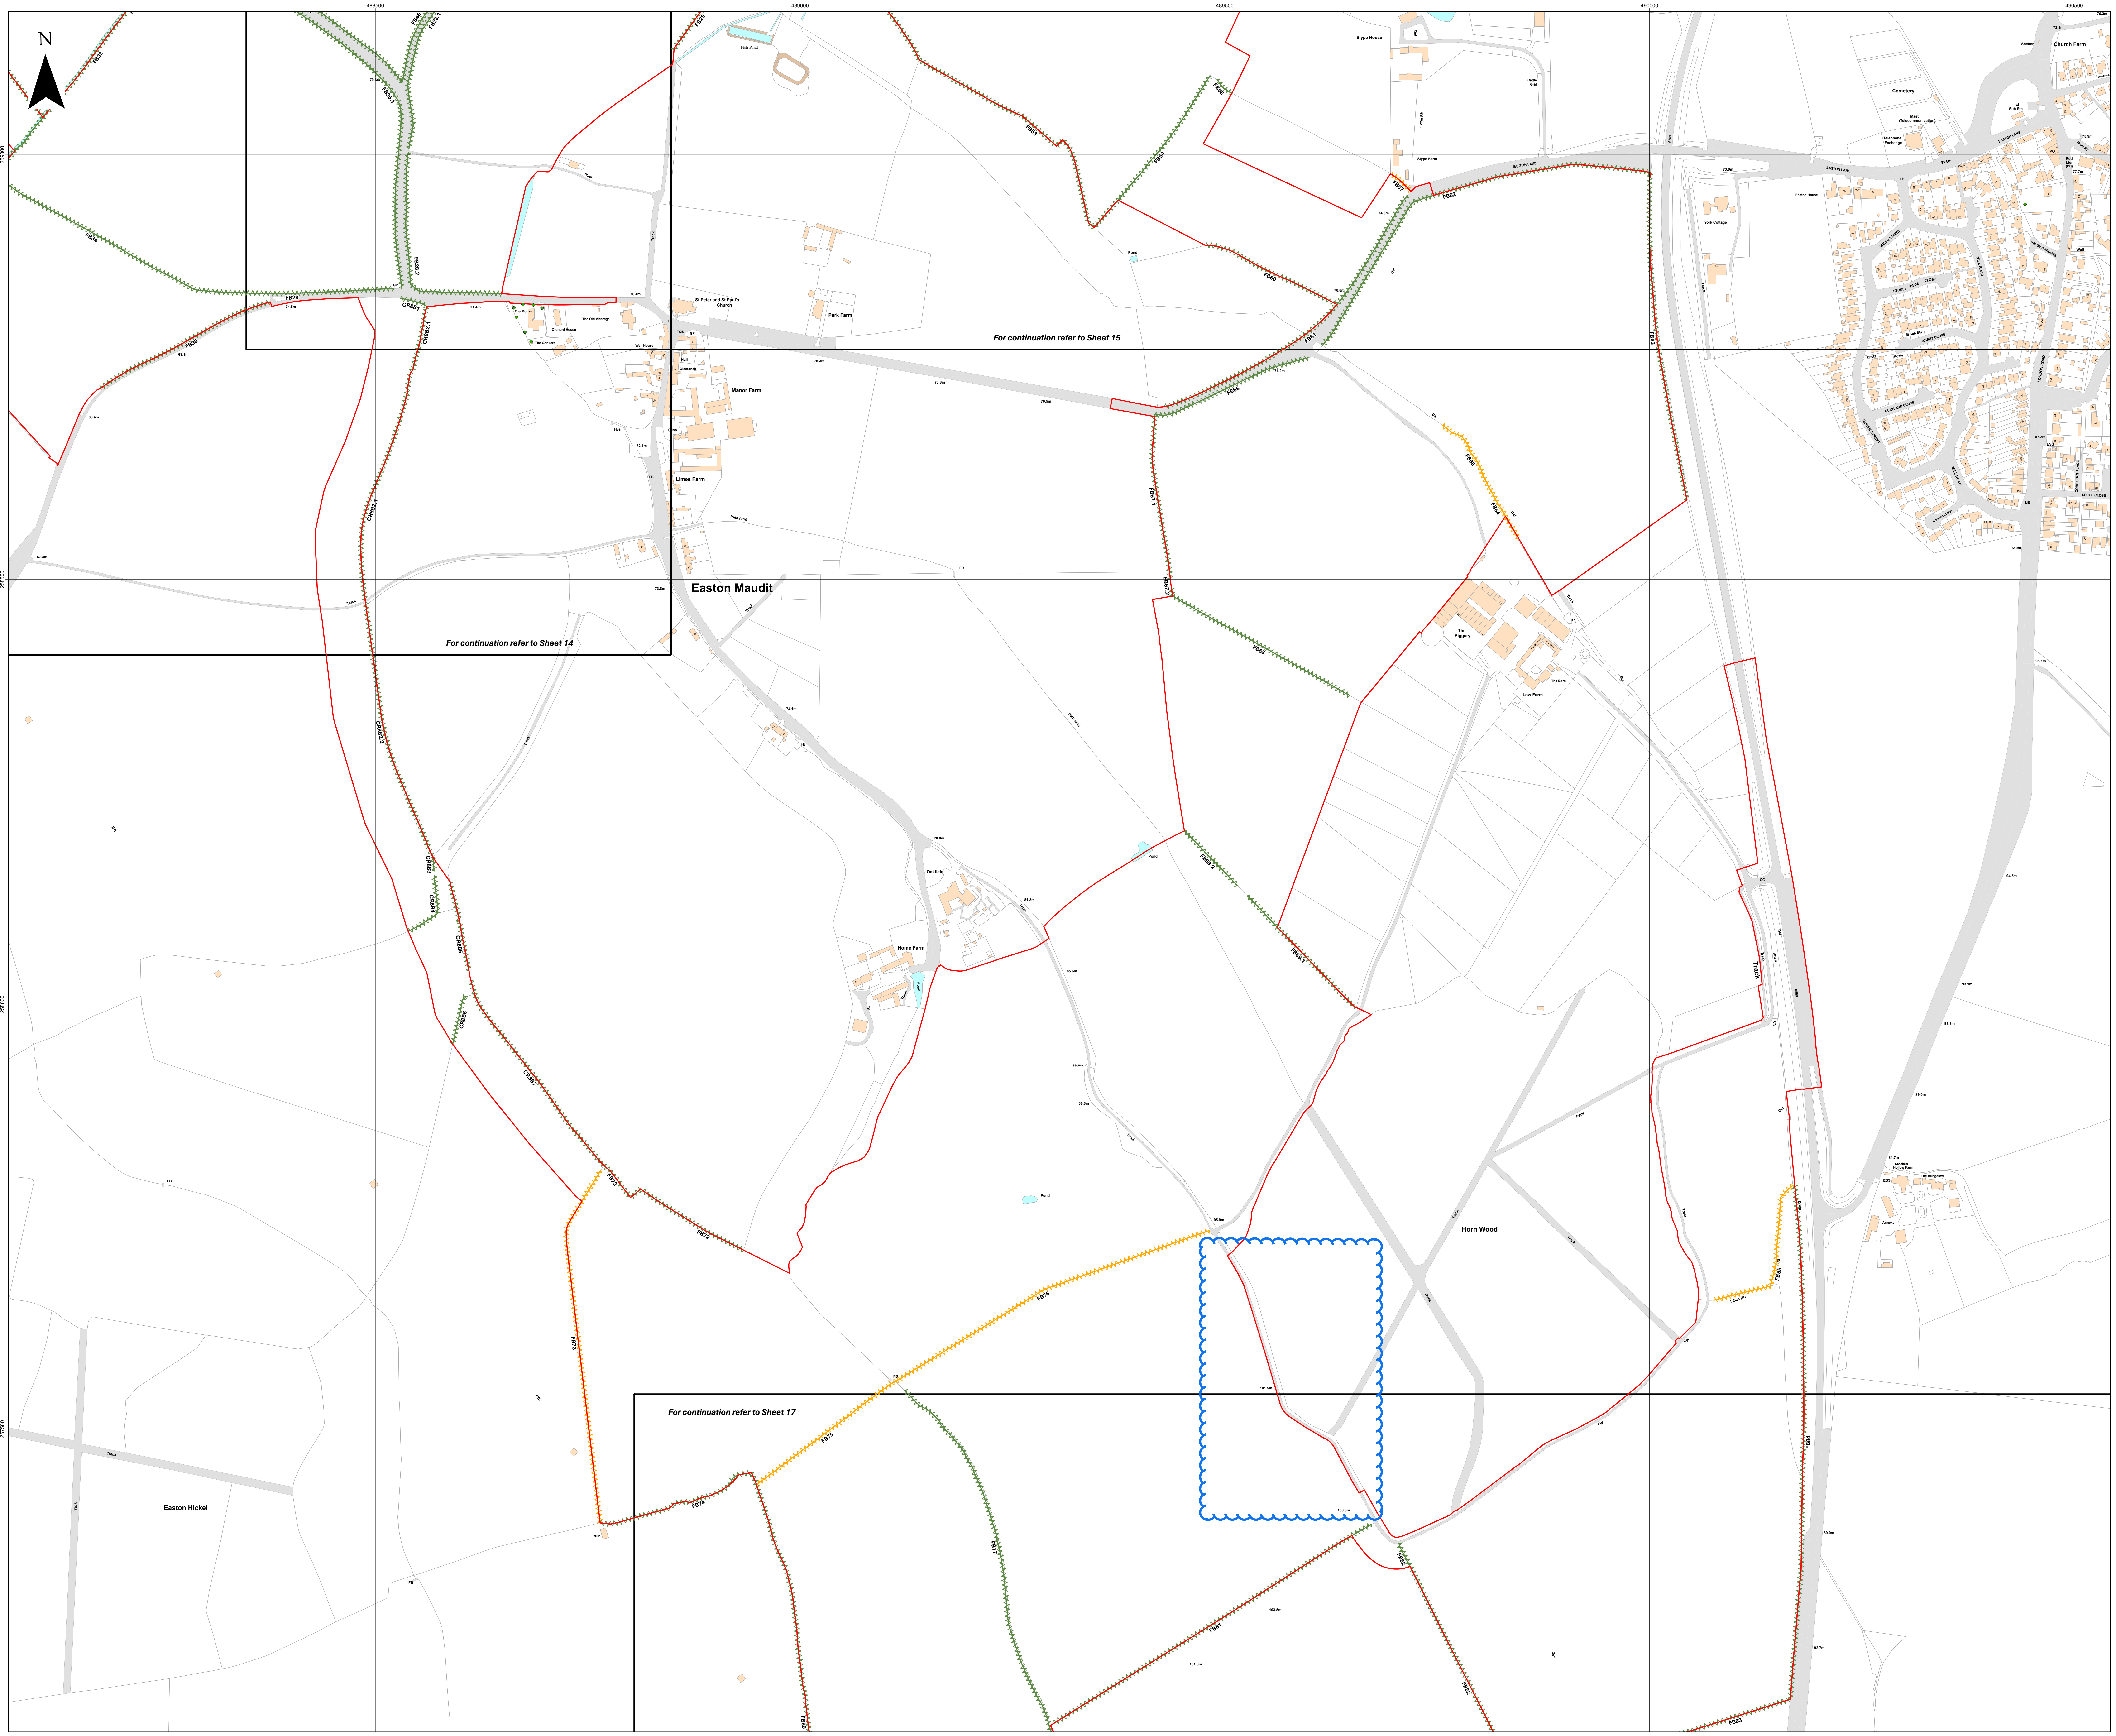
N
488500
489000
489500
490000
490500
258500
258000
257500
For continuation refer to Sheet 15
For continuation refer to Sheet 14
For continuation refer to Sheet 17
Easton Maudit
Manor Farm
Limes Farm
St Peter and St Paul's Church
The Old Vicarage
Orchard House
The Monks
The Conkers
Well House
Hall
Oldstones
Park Farm
Fish Pond
Slype House
Slype Farm
Cattle Grid
York Cottage
EASTON LANE
A509
Church Farm
Cemetery
HIGH ST
QUEEN STREET
The Piggery
Low Farm
The Barn
Oakfield
Home Farm
Horn Wood
Pond
Track
Ruin
Easton Hickel
FB25
FB28.1
FB28.2
FB29
FB30
FB35.1
FB46
FB53
FB54
FB57
FB58
FB60
FB61
FB62
FB63
FB64
FB65
FB66
FB67.1
FB67.2
FB68
FB69.1
FB69.2
FB72
FB73
FB74
FB75
FB76
FB77
FB80
FB81
FB82
FB83
FB84
FB85
CR8B1
CR8B2.1
CR8B2.2
CR8B3
CR8B4
CR8B5
CR8B6
CR8B7

Island GREEN POWER

Lanpro

Key

☐	Order Limits
☐	Sheet Index
^^^^	Important Hedgerow
^^^^	Hedgerow

Tree Protection Order (TPO)

●	Points

Layers: Lanpro, 2025; IGP, 2025

Base map: Reproduced from Ordnance Survey digital map data © Crown copyright 2025. All rights reserved. License number 0100031673

0 100 200 300 Meters

Scale: 1:2,500@ A0

APFP Regulation: 5(2)(q)	Application Doc No. CR1/GH2.11_B
Ref: P3535_LPR_ZZ_XX_DR_Z_0280	Date: 05/11/2025
Drawn by: BH	Checked by: JC

Important Hedgerows Plan (Change Request Version)

Sheet 16 of 18

Revision B

GREEN HILL SOLAR FARM

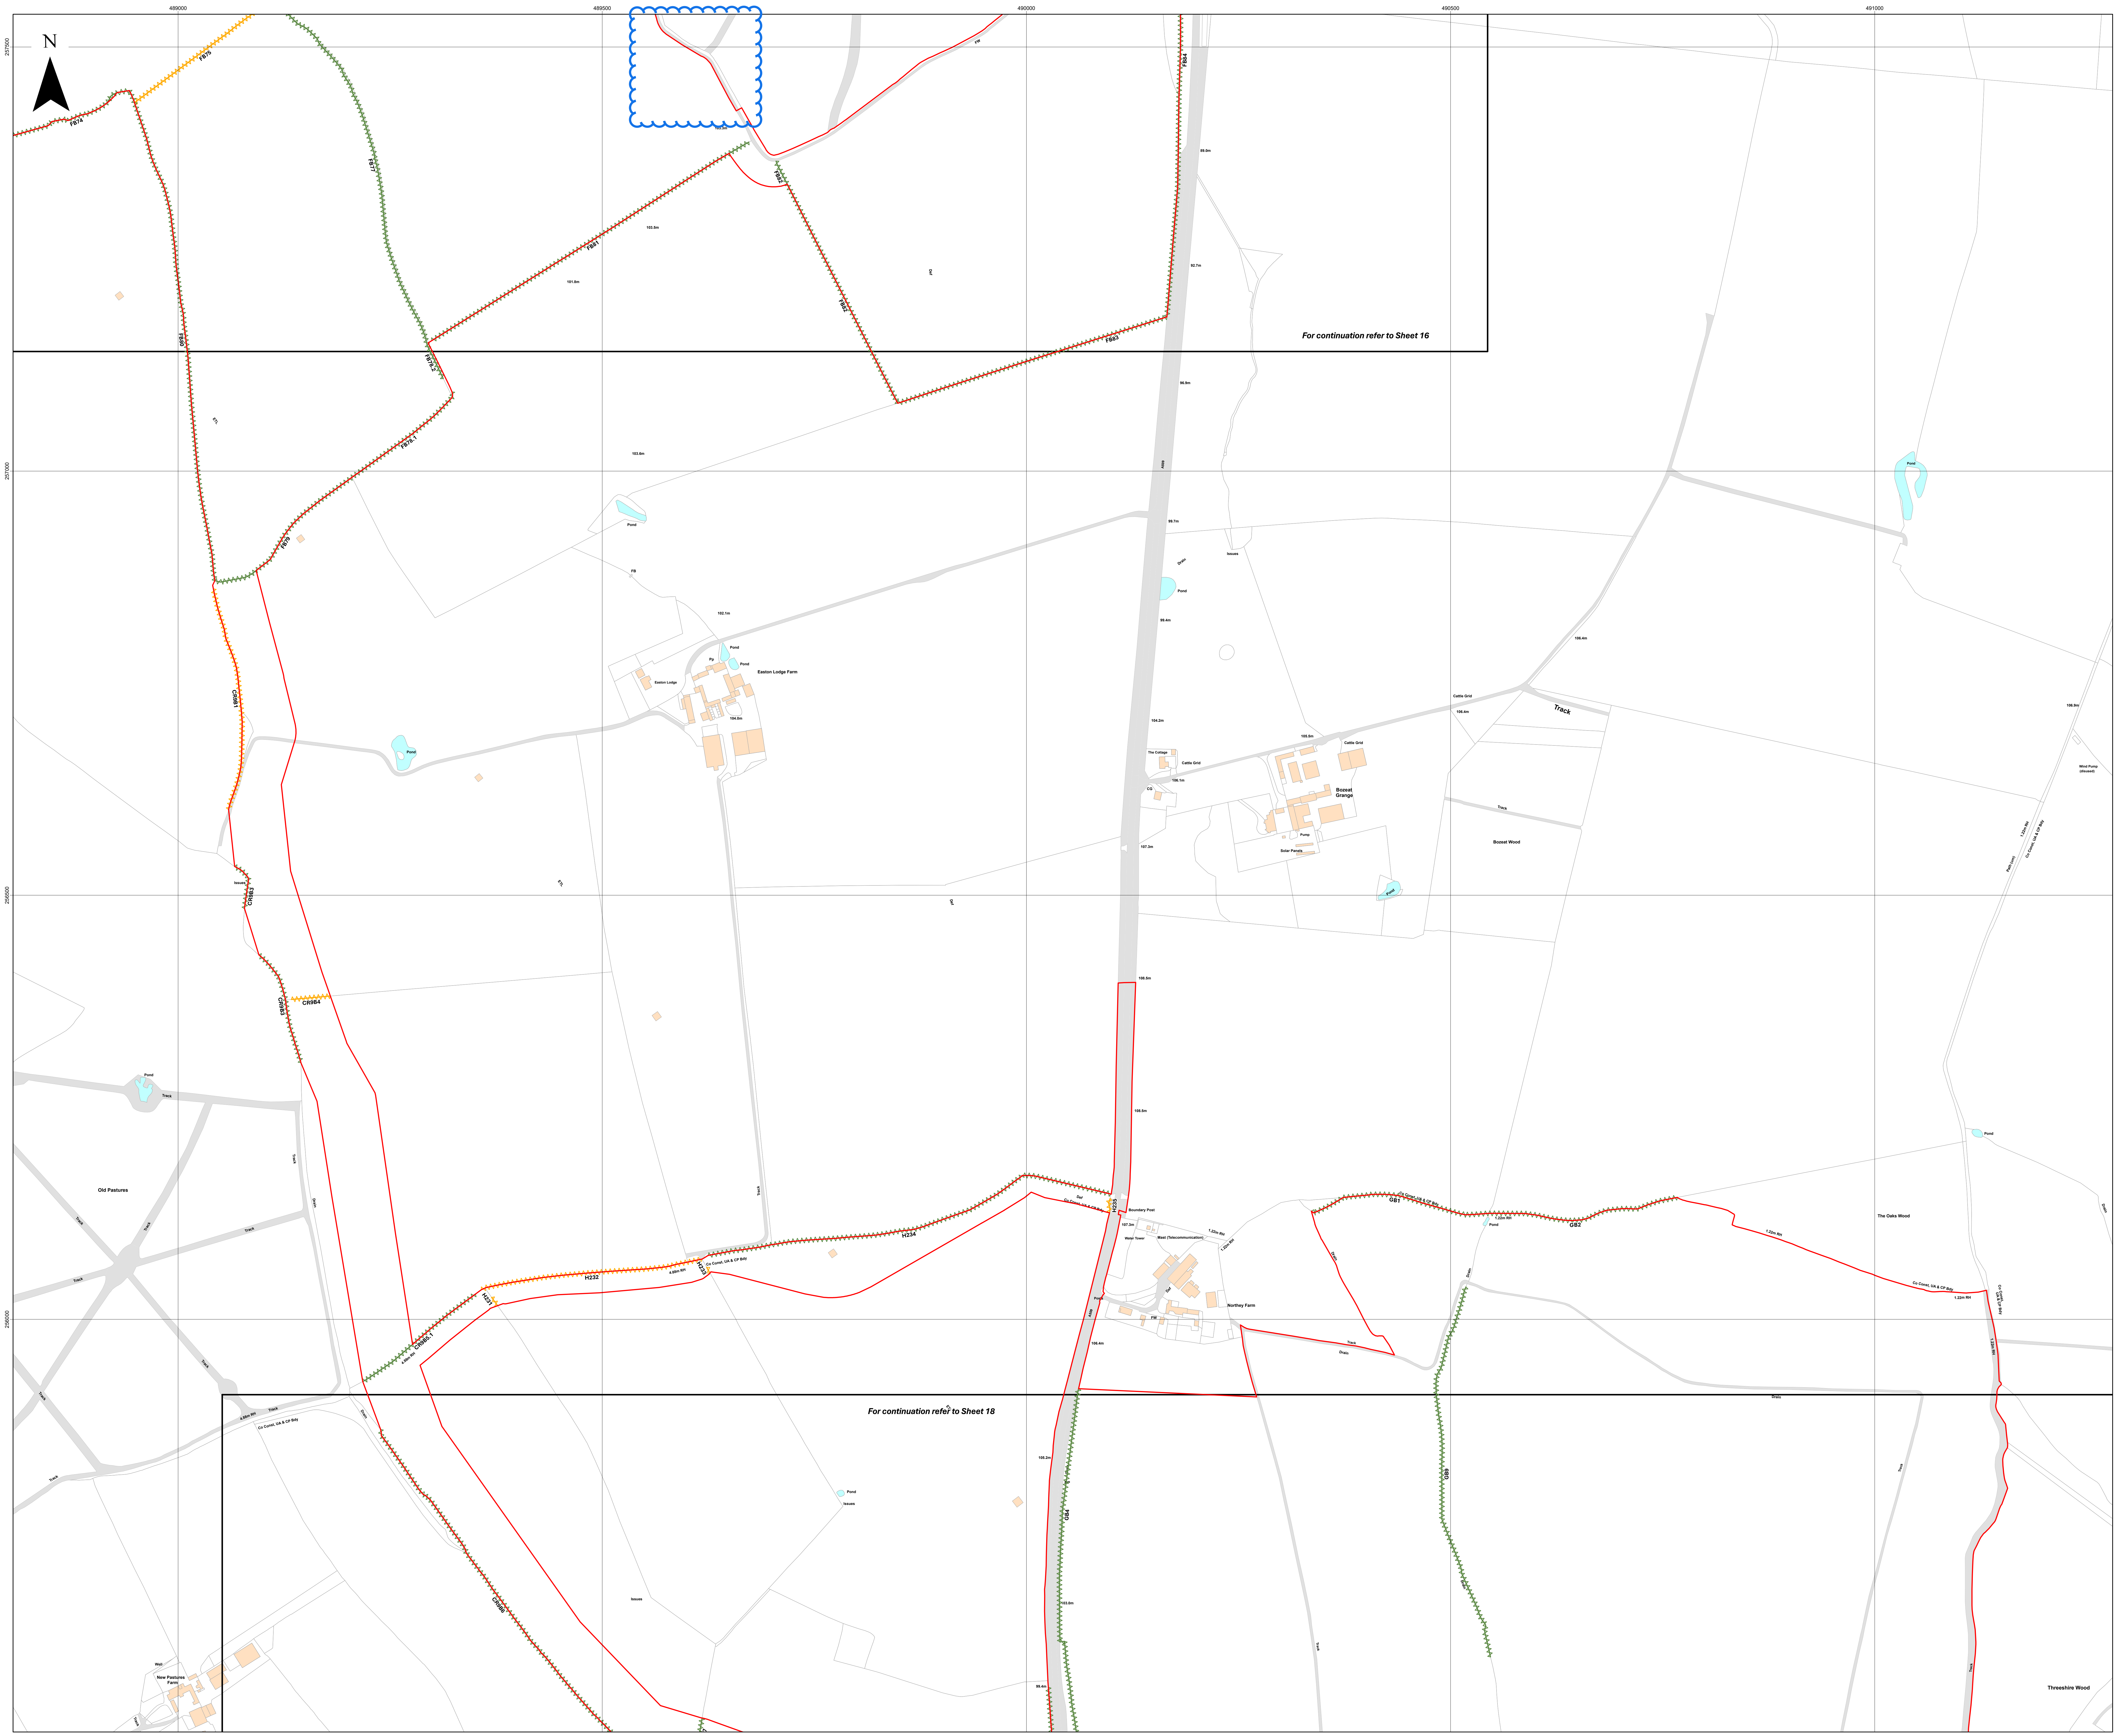

N
489000
489500
490000
490500
491000
257500
257000
256500
256000
FB74
FB75
FB77
FB80
FB81
FB82
FB83
FB84
FB78.1
FB78.2
FB79
CR9B1
CR9B3
CR9B4
CR9B5.1
CR9B6
H231
H232
H233
H234
H235
GB1
GB2
GB4
GB9
103.3m
103.5m
101.8m
103.6m
102.1m
104.0m
89.0m
92.7m
96.9m
99.4m
104.2m
105.5m
106.1m
106.4m
107.3m
108.5m
105.2m
103.0m
ETL
Def
FW
FB
Pp
A509
Pond
Easton Lodge
Easton Lodge Farm
Issues
Drain
The Cottage
Cattle Grid
CG
Bozeat Grange
Pump
Solar Panels
Track
Bozeat Wood
Old Pastures
New Pastures Farm
4.88m RH
1.22m RH
Co Const, UA & CP Bdy
Boundary Post
Water Tower
Mast (Telecommunication)
Posts
Northey Farm
The Oaks Wood
Threeshire Wood

For continuation refer to Sheet 16

For continuation refer to Sheet 18

Island GREEN POWER

Lanpro

Key

- ☐ Order Limits
- ☐ Sheet Index
- ⋀⋀⋀ Important Hedgerow
- ⋀⋀⋀ Hedgerow

Layers: Lanpro, 2025; IGP, 2025

0 100 200 300 Meters

Scale: 1:2,500@ A0

APFP Regulation: 5(2)(q)	Application Doc No. CR1/GH2.11_B
Ref: P3535_LPR_ZZ_XX_DR_Z_0280	Date: 05/11/2025
Drawn by: BH	Checked by: JC

Important Hedgerows Plan (Change Request Version)

Sheet 17 of 18

Revision B

GREEN HILL SOLAR FARM

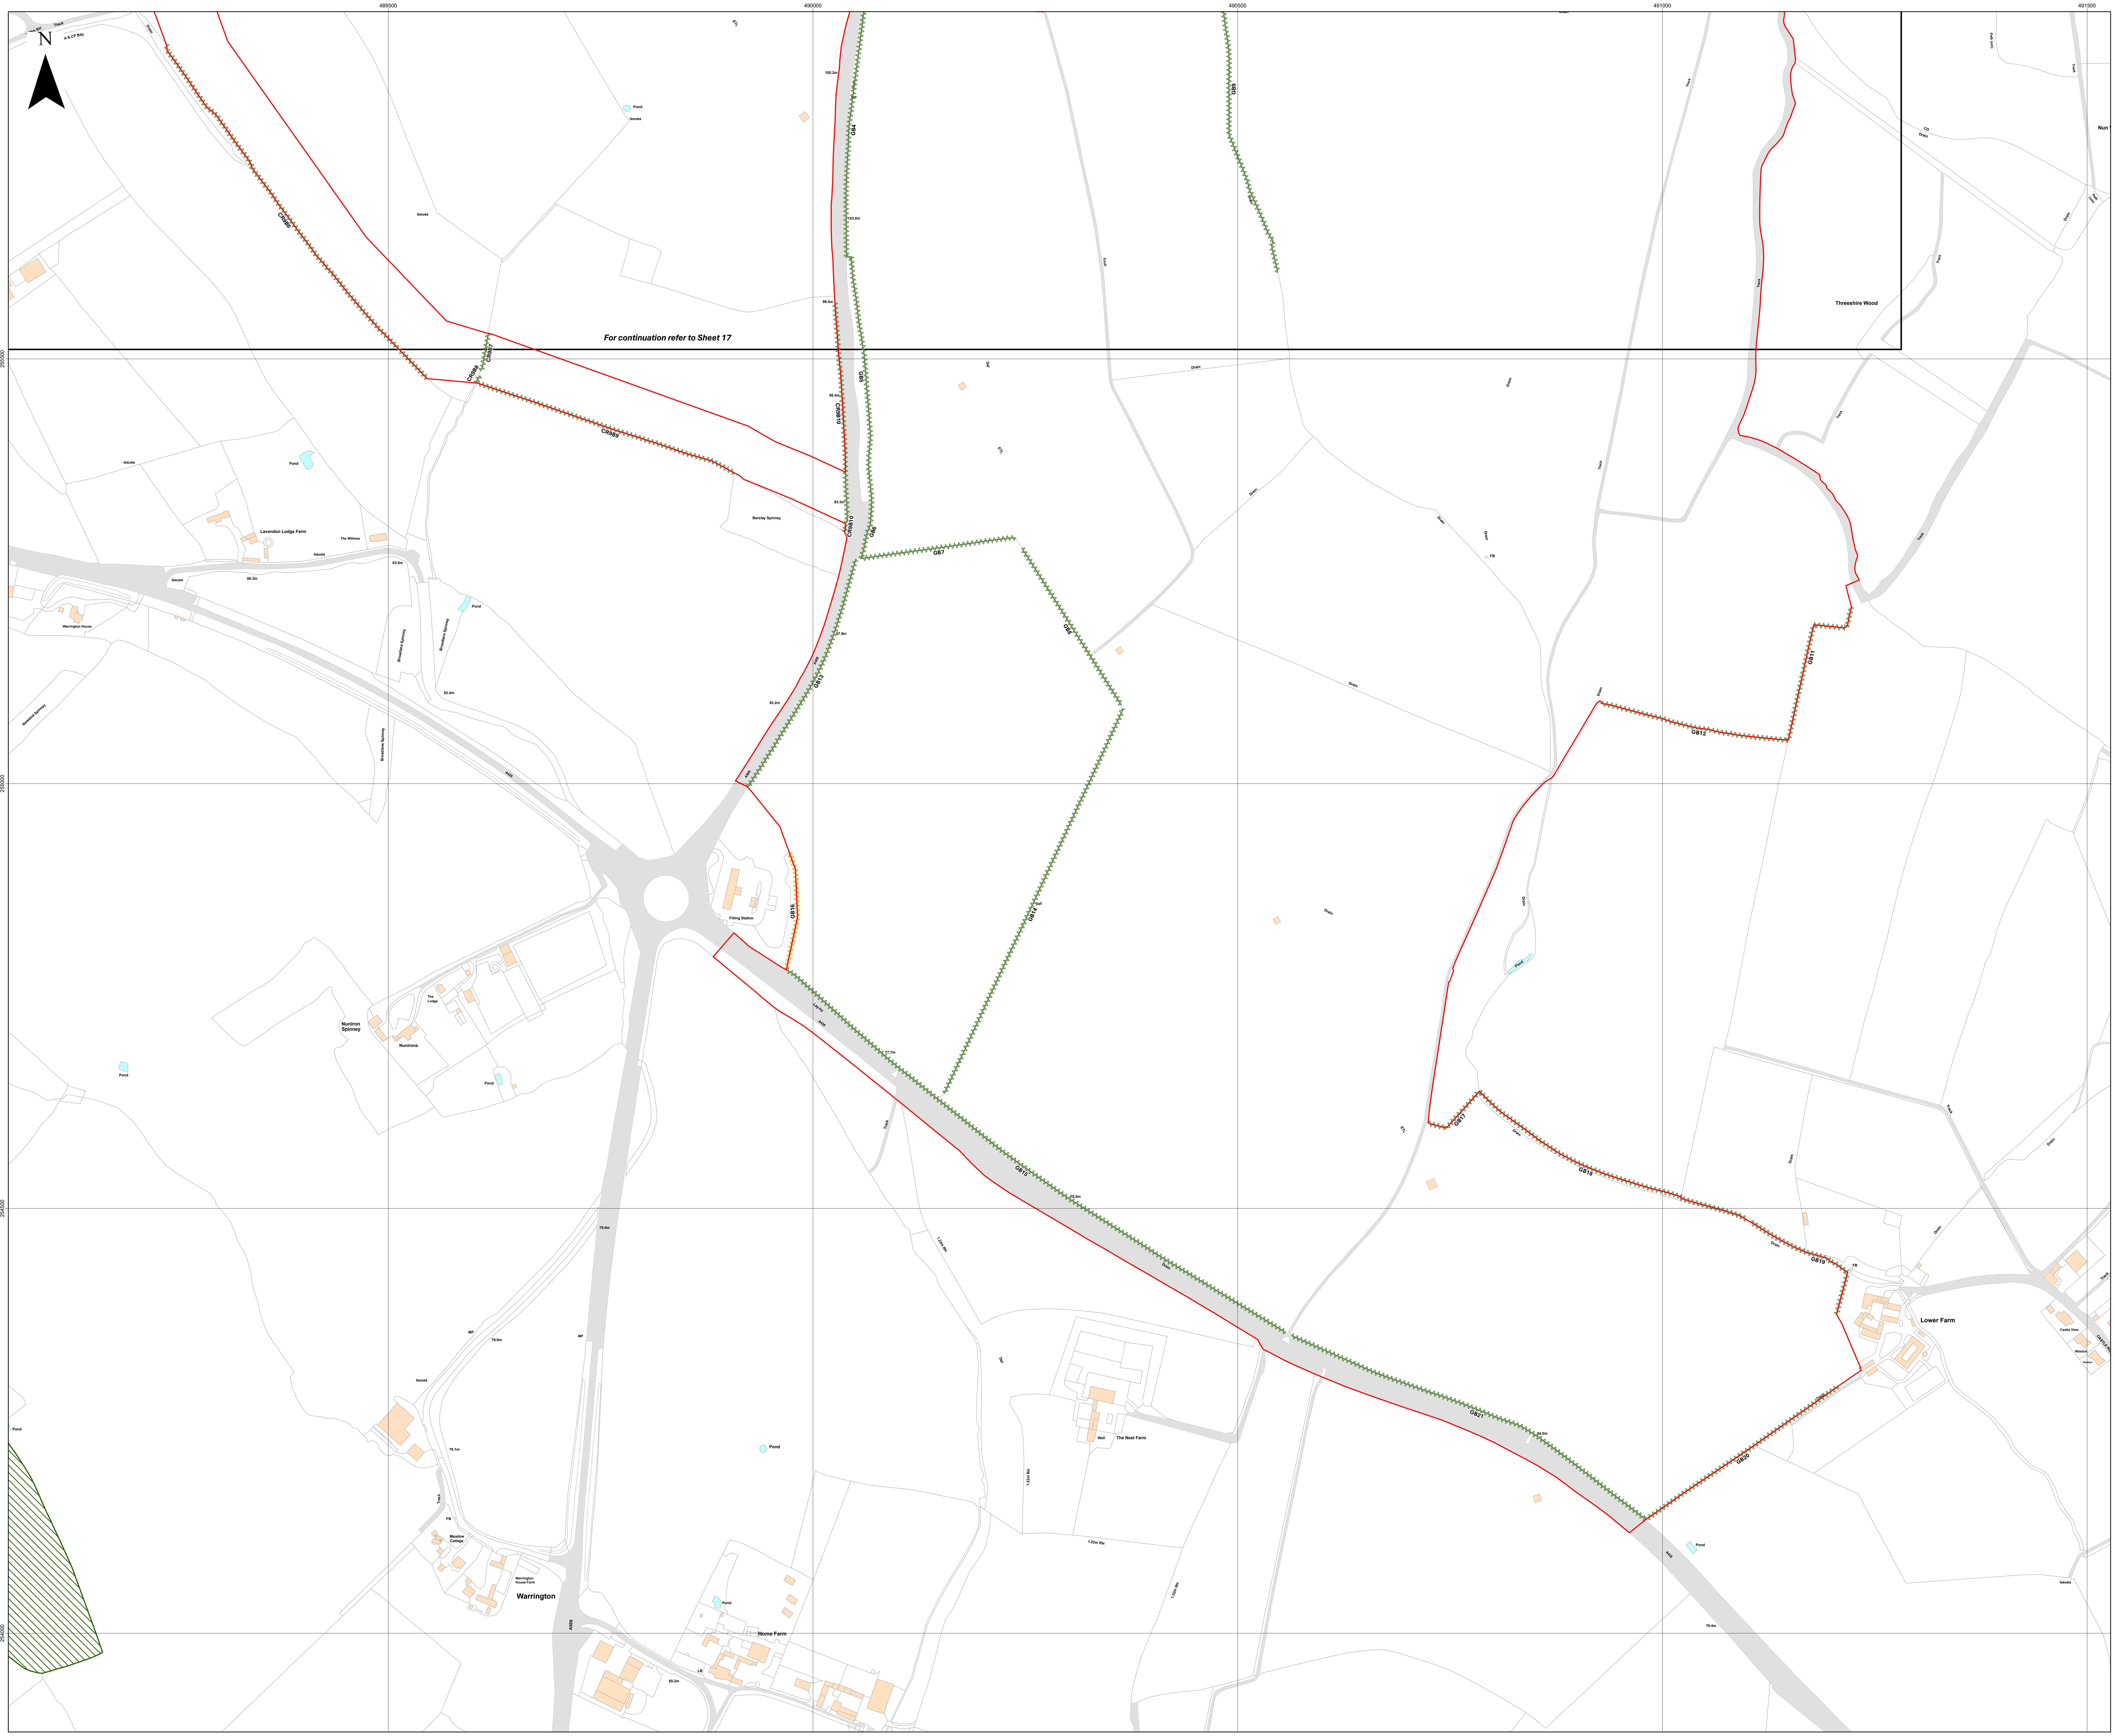
N
489500
490000
490500
491000
491500
For continuation refer to Sheet 17
CR9B6
CR9B7
CR9B8
CR9B9
CR9B10
GB4
GB5
GB6
GB7
GB8
GB11
GB12
GB13
GB14
GB15
GB16
GB17
GB18
GB19
GB20
GB21
Threeshire Wood
Barslay Spinney
Broadlane Spinney
Lavendon Lodge Farm
Filling Station
Lower Farm
Warrington
Home Farm
The Nest Farm
A509
A428
Pond
Drain
Track
ETL
FB

Key

- 🟥 Order Limits
- ▭ Sheet Index
- Important Hedgerow
- Hedgerow

Tree Protection Order (TPO)

- ▨ Group

Layers: Lanpro, 2025; IGP, 2025
Base map: Reproduced from Ordnance Survey digital map data © Crown copyright 2025. All rights reserved. License number 0100031673

0 100 200 300 Meters

Scale: 1:2,500@ A0

APFP Regulation: 5(2)(q)	Application Doc No. CR1/GH2.11_B
Ref: P3535_LPR_ZZ_XX_DR_Z_0280	Date: 05/11/2025
Drawn by: BH	Checked by: JC

Important Hedgerows Plan (Change Request Version)

Sheet 18 of 18
Revision B