Green Hill Solar Farm
EN010170

Public Rights of Way Plan
Revision ~~A~~B (Tracked)

Prepared by: Lanpro

Date: ~~June~~ November 2025

Document Reference: ~~PEX~~CR1/GH2.6_B~~A~~

APFP Regulation 5(2)(k)

Schedule of Changes

Figure Reference	Page	Description of Changes	Reason for Revision
[cover]		Updated document reference to Revision B	As required for submission of Change Application.
All Sheets	3-21	Updated document references and annotations	As required for submission of Change Application.
Sheet 1	4	Order Limits extended	Presentation of Change 1 requested in Change Application **[EN010170/CR1/GH9.2]**
Sheet 3	6	Order Limits extended Addition of public right of way 3d/i-3d/ii on 3d - NN|CT|3	Presentation of Change 3 requested in Change Application **[EN010170/CR1/GH9.2]**
Sheet 8	11	Order Limits extended Addition of public right of way 8b/i-8b/ii on 3d - TN/010	Presentation of Change 6 requested in Change Application **[EN010170/CR1/GH9.2]**
Sheet 9	12	Order Limits extended Addition of public right of way 8b/i-8b/ii on 3d - TN/010	Presentation of Change 6 requested in Change Application **[EN010170/CR1/GH9.2]**
Sheet 12	15	Order Limits extended	Presentation of Change 7 requested in Change Application **[EN010170/CR1/GH9.2]**
Sheet 15	18	Order Limits reduced	Presentation of Change 8 requested in Change Application **[EN010170/CR1/GH9.2]**
Sheet 16	19	Order Limits reduced Splitting of public right of way 16a/i-16b/ii on 16a - TD/005 into separate public rights of way 16a/i-16a/ii on 16a - TD/005 and 16e/i-16e/ii on 16e - TD/005	Presentation of Change 9 requested in Change Application **[EN010170/CR1/GH9.2]**
Sheet 17	20	Order Limits reduced Splitting of public right of way 16a/i-16b/ii on 16a - TD/005 into separate public rights of way 16a/i-16a/ii on 16a - TD/005 and 16e/i-16e/ii on 16e - TD/005	Presentation of Change 9 requested in Change Application **[EN010170/CR1/GH9.2]**

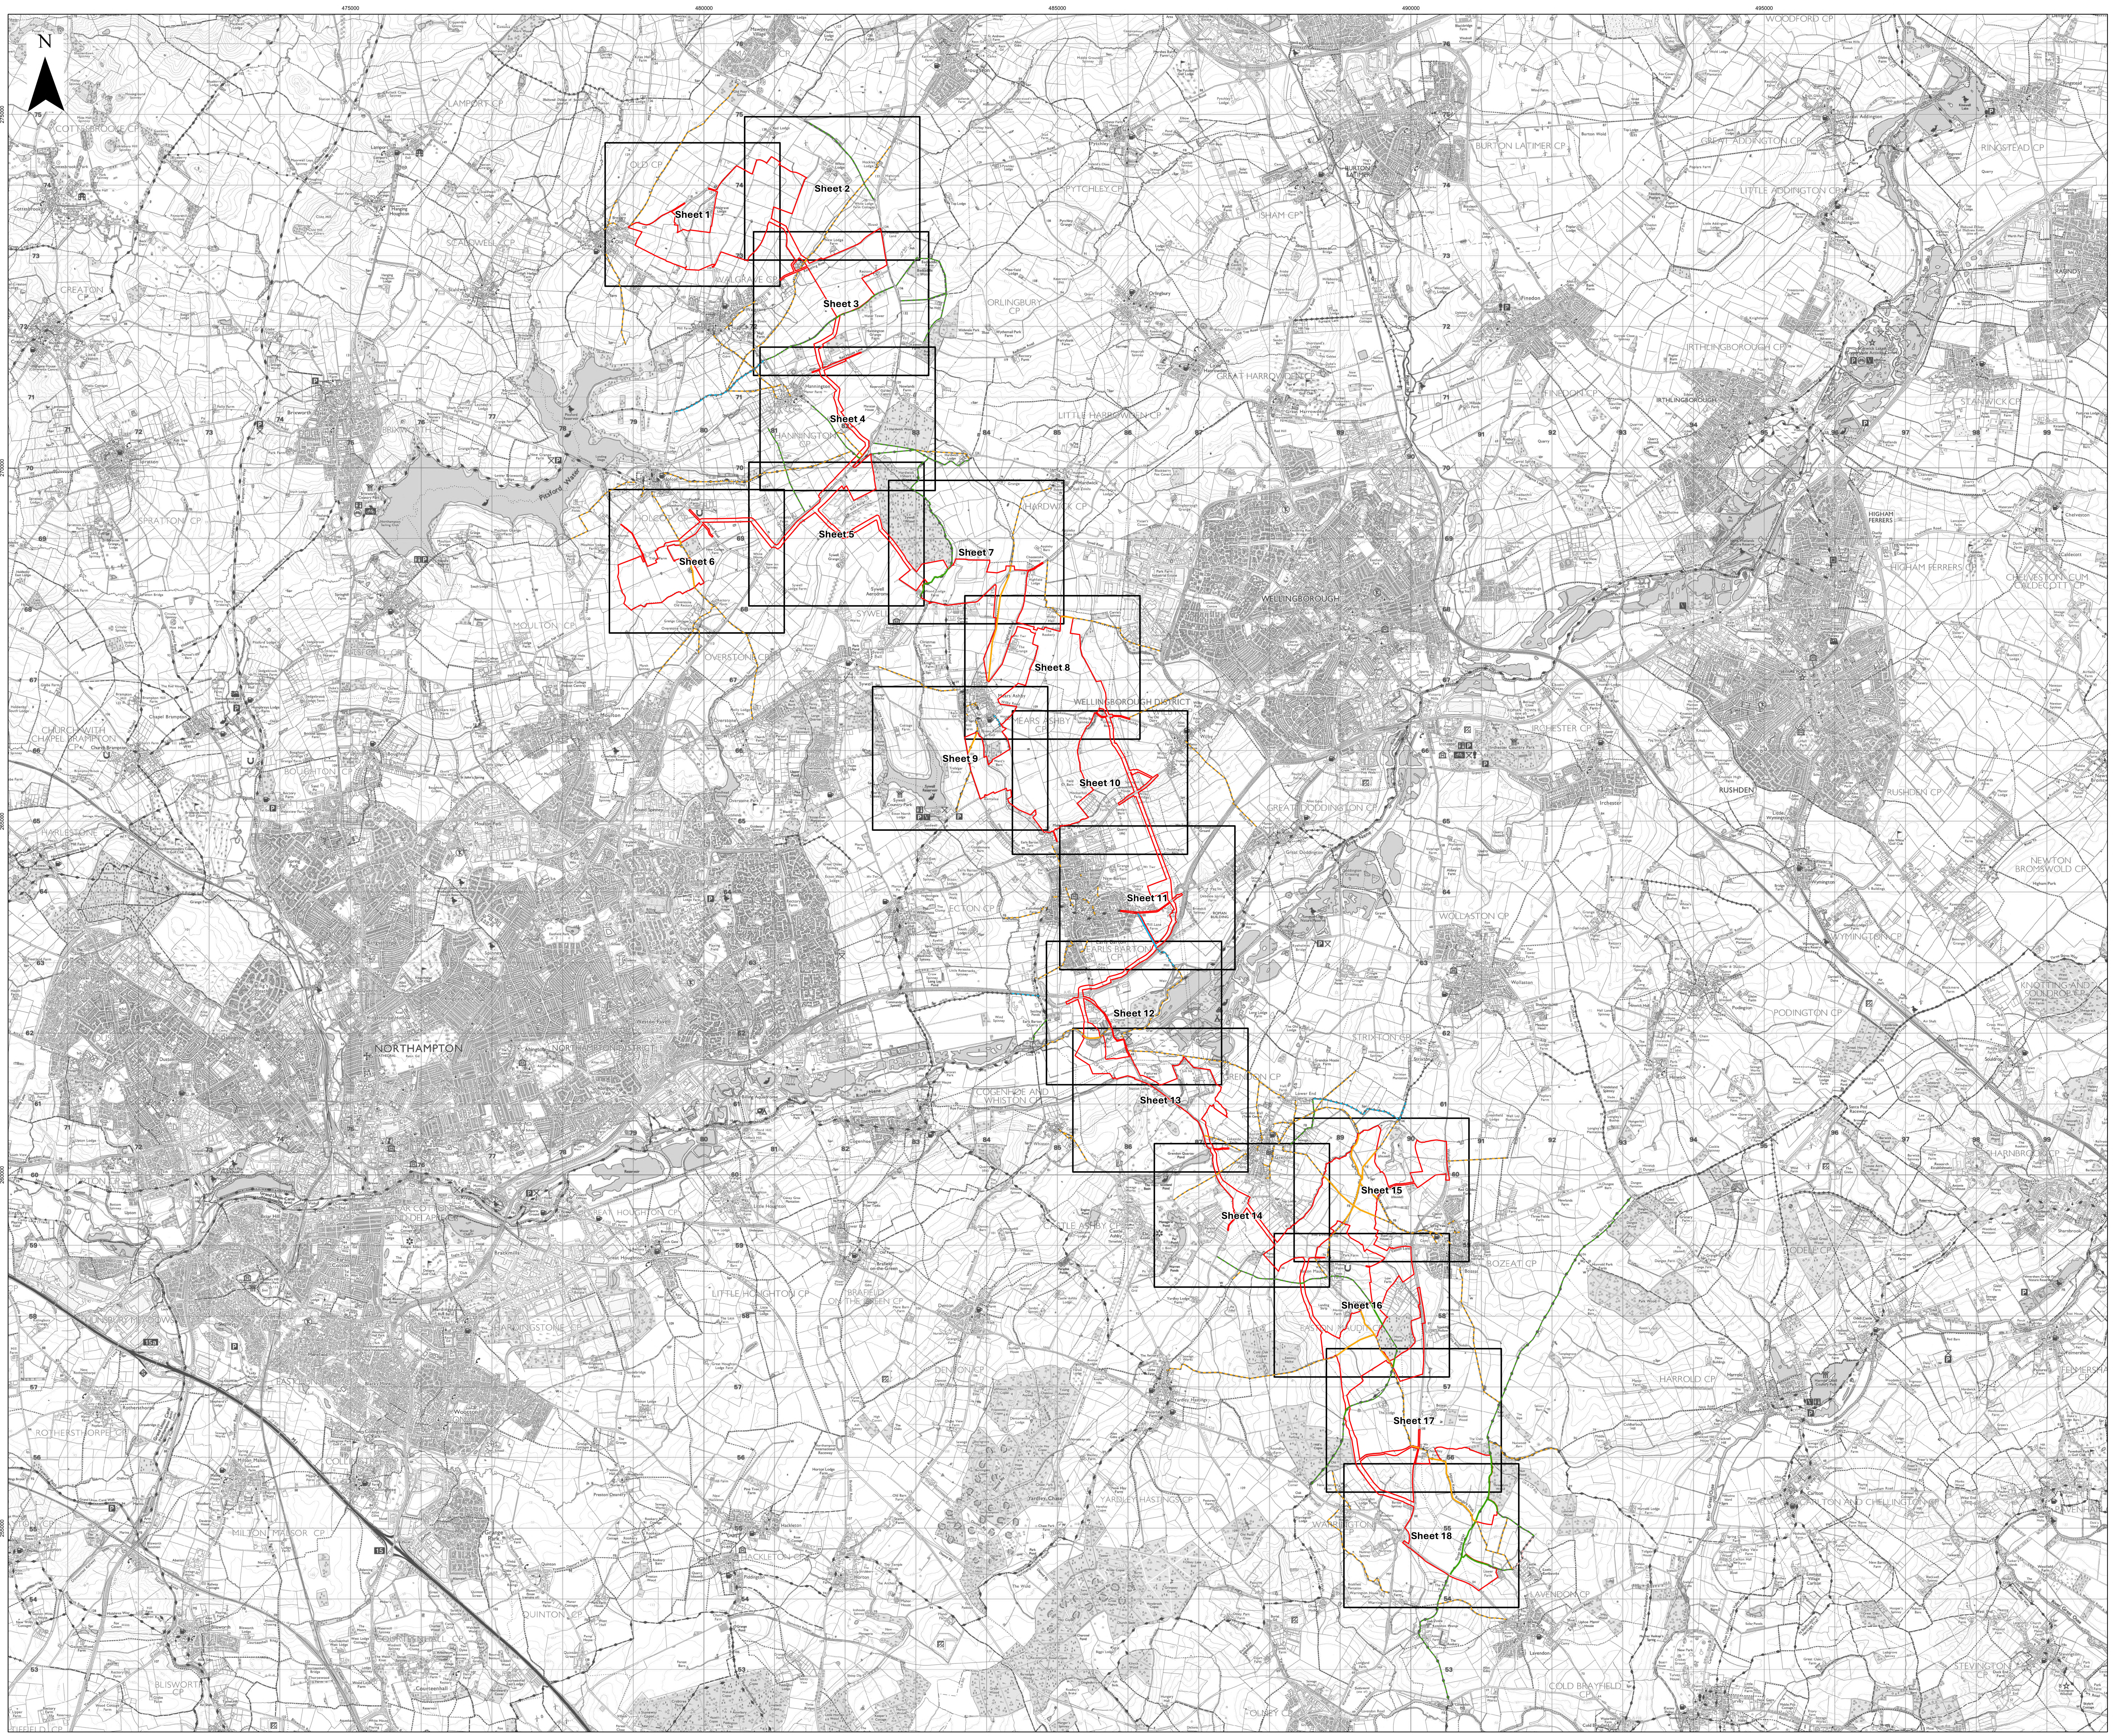
N
475000
480000
485000
490000
495000
Sheet 1
Sheet 2
Sheet 3
Sheet 4
Sheet 5
Sheet 6
Sheet 7
Sheet 8
Sheet 9
Sheet 10
Sheet 11
Sheet 12
Sheet 13
Sheet 14
Sheet 15
Sheet 16
Sheet 17
Sheet 18
NORTHAMPTON
WELLINGBOROUGH
WELLINGBOROUGH DISTRICT
RUSHDEN
HIGHAM FERRERS
IRTHLINGBOROUGH
BURTON LATIMER CP
WOODFORD CP
SYWELL
MEARS ASHBY
EARLS BARTON
GREAT DODDINGTON CP
WOLLASTON CP
BOZEAT CP
LAVENDON CP
COLD BRAYFIELD
YARDLEY HASTINGS CP
CASTLE ASHBY
DENTON CP
COGENHOE AND WHISTON CP
LITTLE HOUGHTON CP
HACKLETON
QUINTON CP
MILTON MALSOR CP
ROTHERSTHORPE CP
BLISWORTH CP
MOULTON CP
OVERSTONE CP
HARDWICK CP
LITTLE HARROWDEN CP
GREAT HARROWDEN CP
ORLINGBURY CP
PYTCHLEY CP
ISHAM CP
WALGRAVE CP
OLD CP
LAMPORT CP
SCALDWELL CP
BRIXWORTH CP
SPRATTON CP
CREATON CP
COTTESBROOKE CP
HOLCOT CP
HANNINGTON CP
Pitsford Water
CHURCH WITH CHAPEL BRAMPTON CP
BOUGHTON CP
HARLESTONE CP
IRCHESTER CP
RUSHDEN CP
NEWTON BROMSWOLD CP
WYMINGTON CP
PODINGTON CP
KNOTTING AND SOUTHOE CP
STRIXTON CP
HARROLD CP
GREAT ADDINGTON CP
LITTLE ADDINGTON CP
RINGSTEAD CP
STANWICK CP
CHELVESTON CUM CALDECOTT CP
STEVINGTON CP
TURVEY CP
BRAFIELD ON THE GREEN CP
GRENDON CP
ECTON CP

Island GREEN POWER

Lanpro

Key

🟥 Order Limits

☐ Sheet Index

Public Right of Way (PRoW)

- Byway Open To All Traffic
- Bridleway
- Footpath
- Restricted Byway

PRoW to be temporarily stopped up

- Byway Open To All Traffic
- Bridleway
- Footpath
- Restricted Byway

Layers: Lanpro, 2025; IGP, 2025

Base map: Reproduced from Ordnance Survey digital map data © Crown copyright 2025. All rights reserved. License number 0100031673

0 1 2 3 4 Kilometers

Scale: 1:30,000@ A0

APFP Regulation: 5(2)(j)

Application Doc No. CR1/GH2.6_B

Ref: P3535_LPR_ZZ_XX_DR_Z_0275

Date: 05/11/2025

Drawn by: BH

Checked by: JC

Public Rights of Way Plan (Change Application Version)

Index Sheet

Revision B

GREEN HILL SOLAR FARM

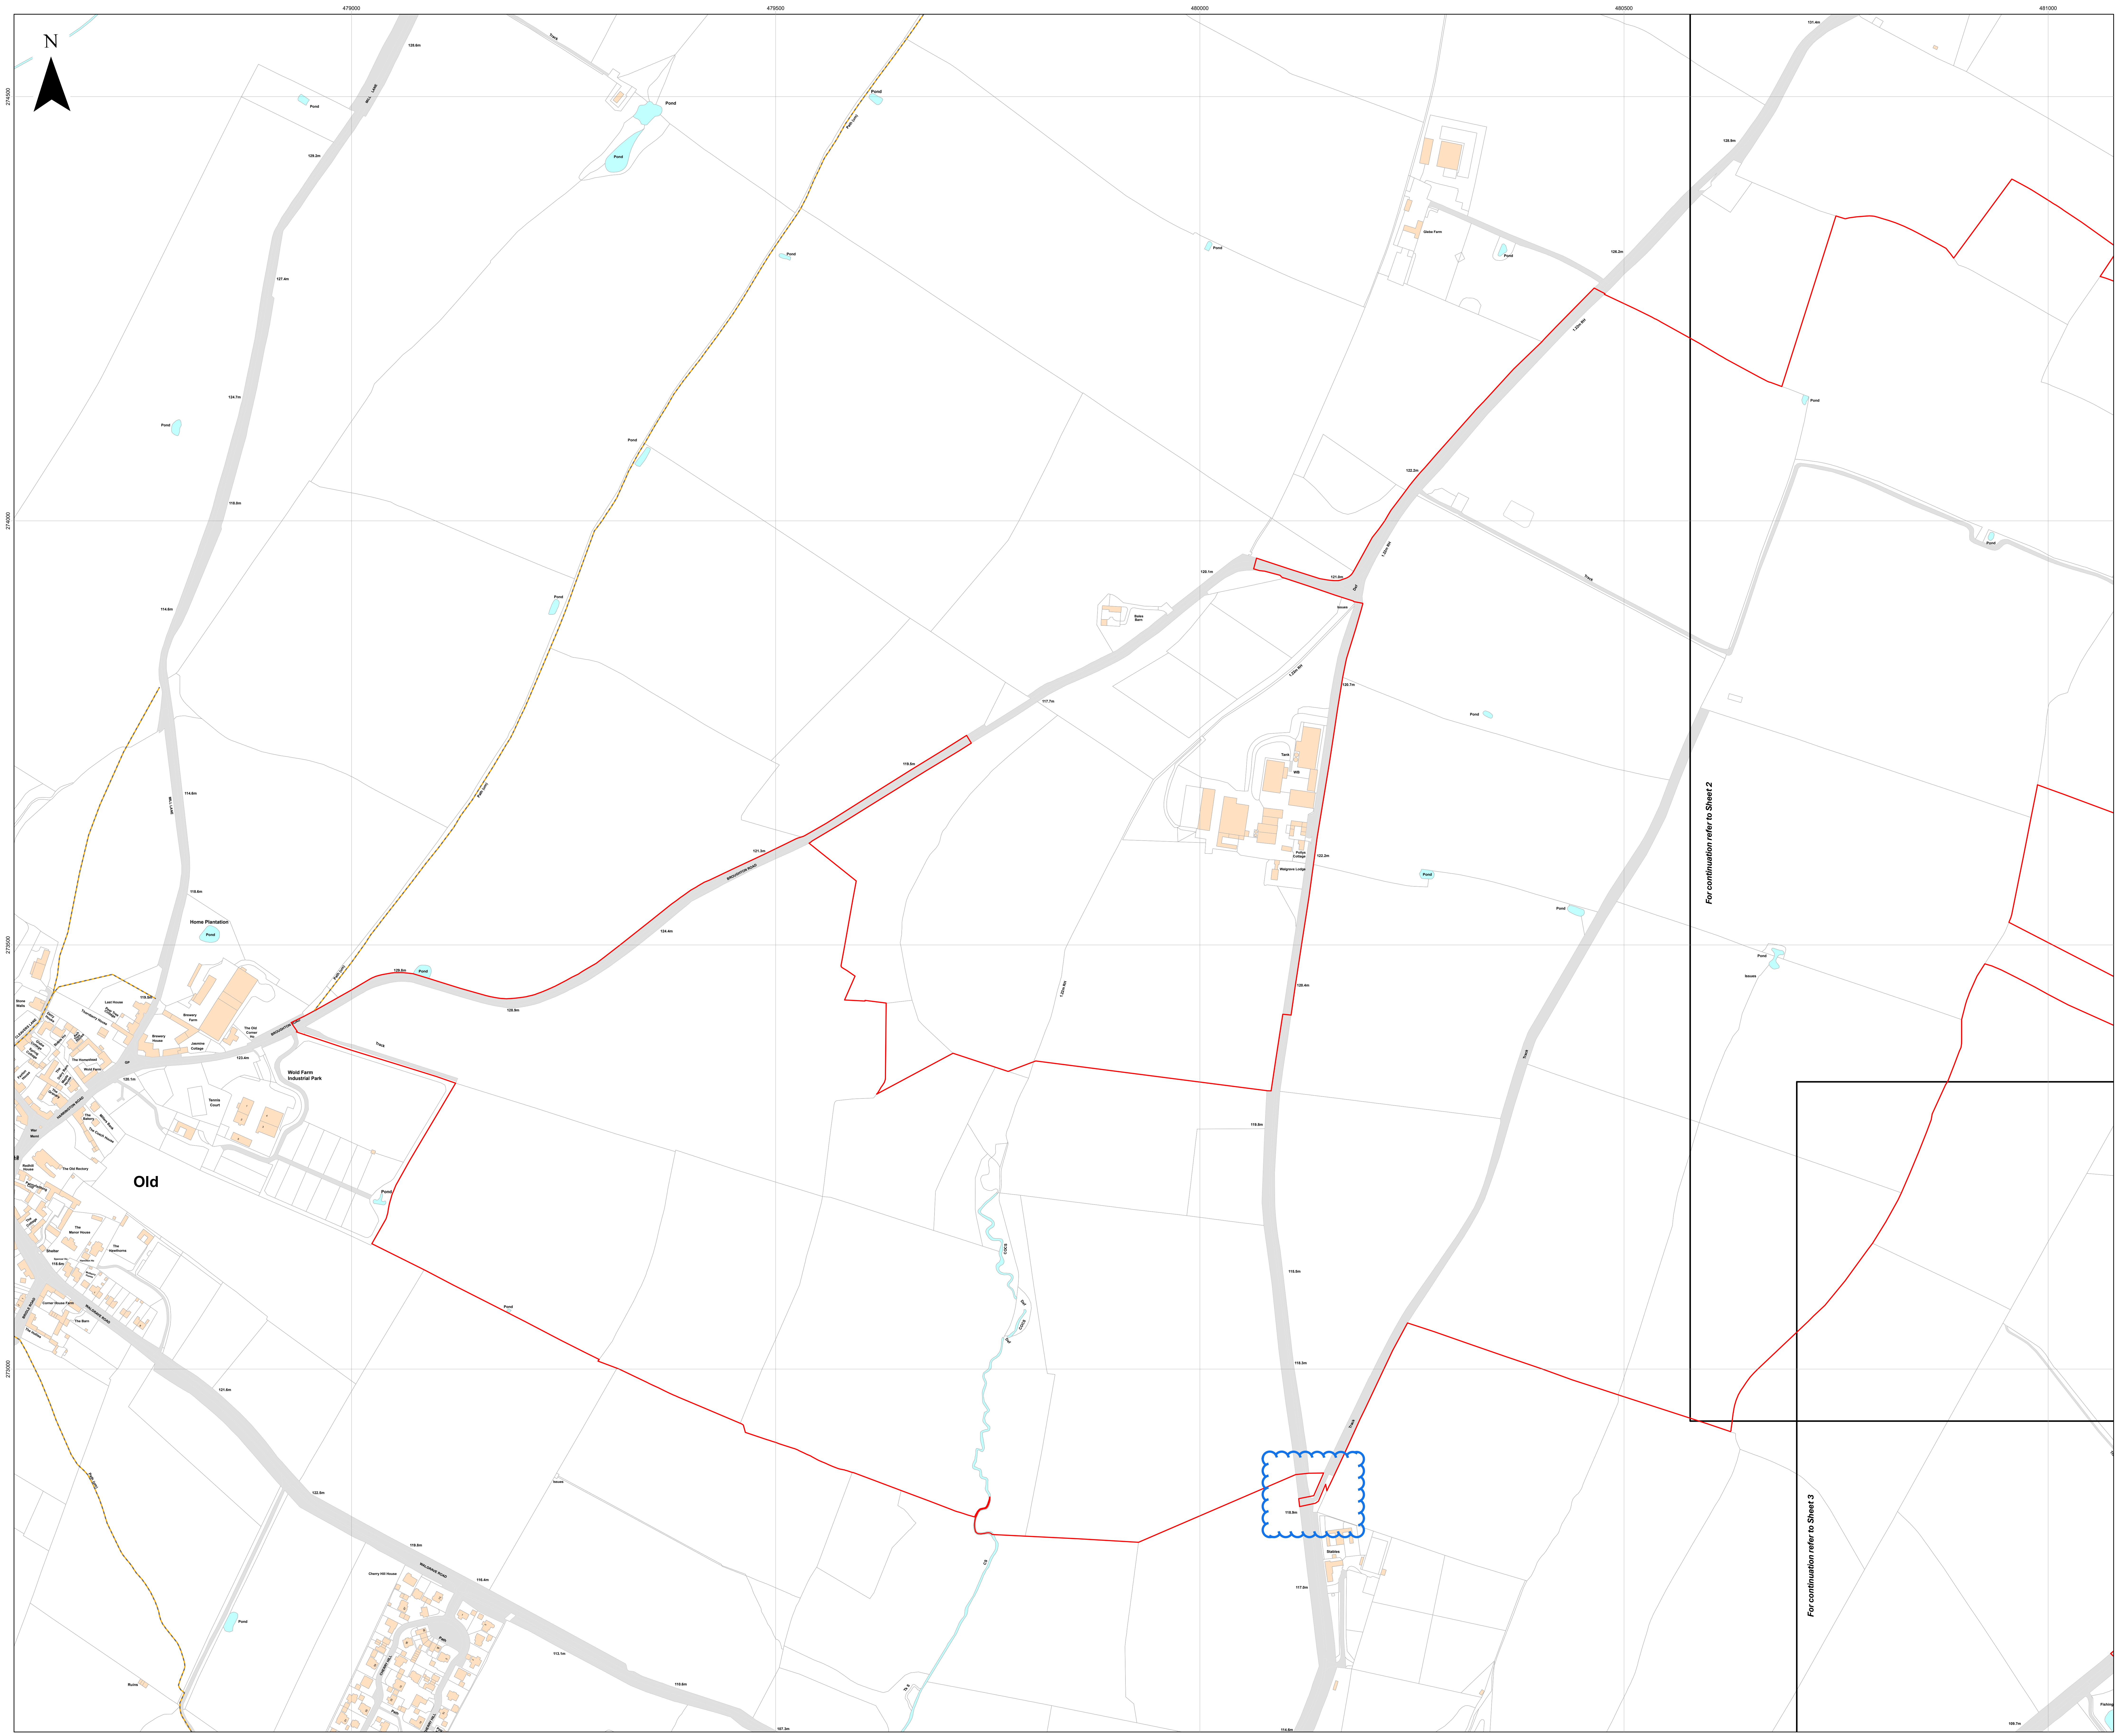
N
479000
479500
480000
480500
481000
274500
274000
273500
273000
Home Plantation
Wold Farm Industrial Park
Old
For continuation refer to Sheet 2
For continuation refer to Sheet 3

Key

- 🟥 Order Limits
- ▭ Sheet Index

Public Right of Way (PRoW)

- ---- Footpath

Layers: Lanpro, 2025; IGP, 2025
Base map: Reproduced from Ordnance Survey digital map data © Crown copyright 2025. All rights reserved. License number 0100031673

0 100 200 300 Meters

Scale: 1:2,500@ A0

APFP Regulation: 5(2)(j)	Application Doc No. CR1/GH2.6_B
Ref: P3535_LPR_ZZ_XX_DR_Z_0275	Date: 05/11/2025
Drawn by: BH	Checked by: JC

Public Rights of Way Plan
(Change Application Version)

Sheet 1 of 18
Revision B

GREEN HILL
SOLAR FARM

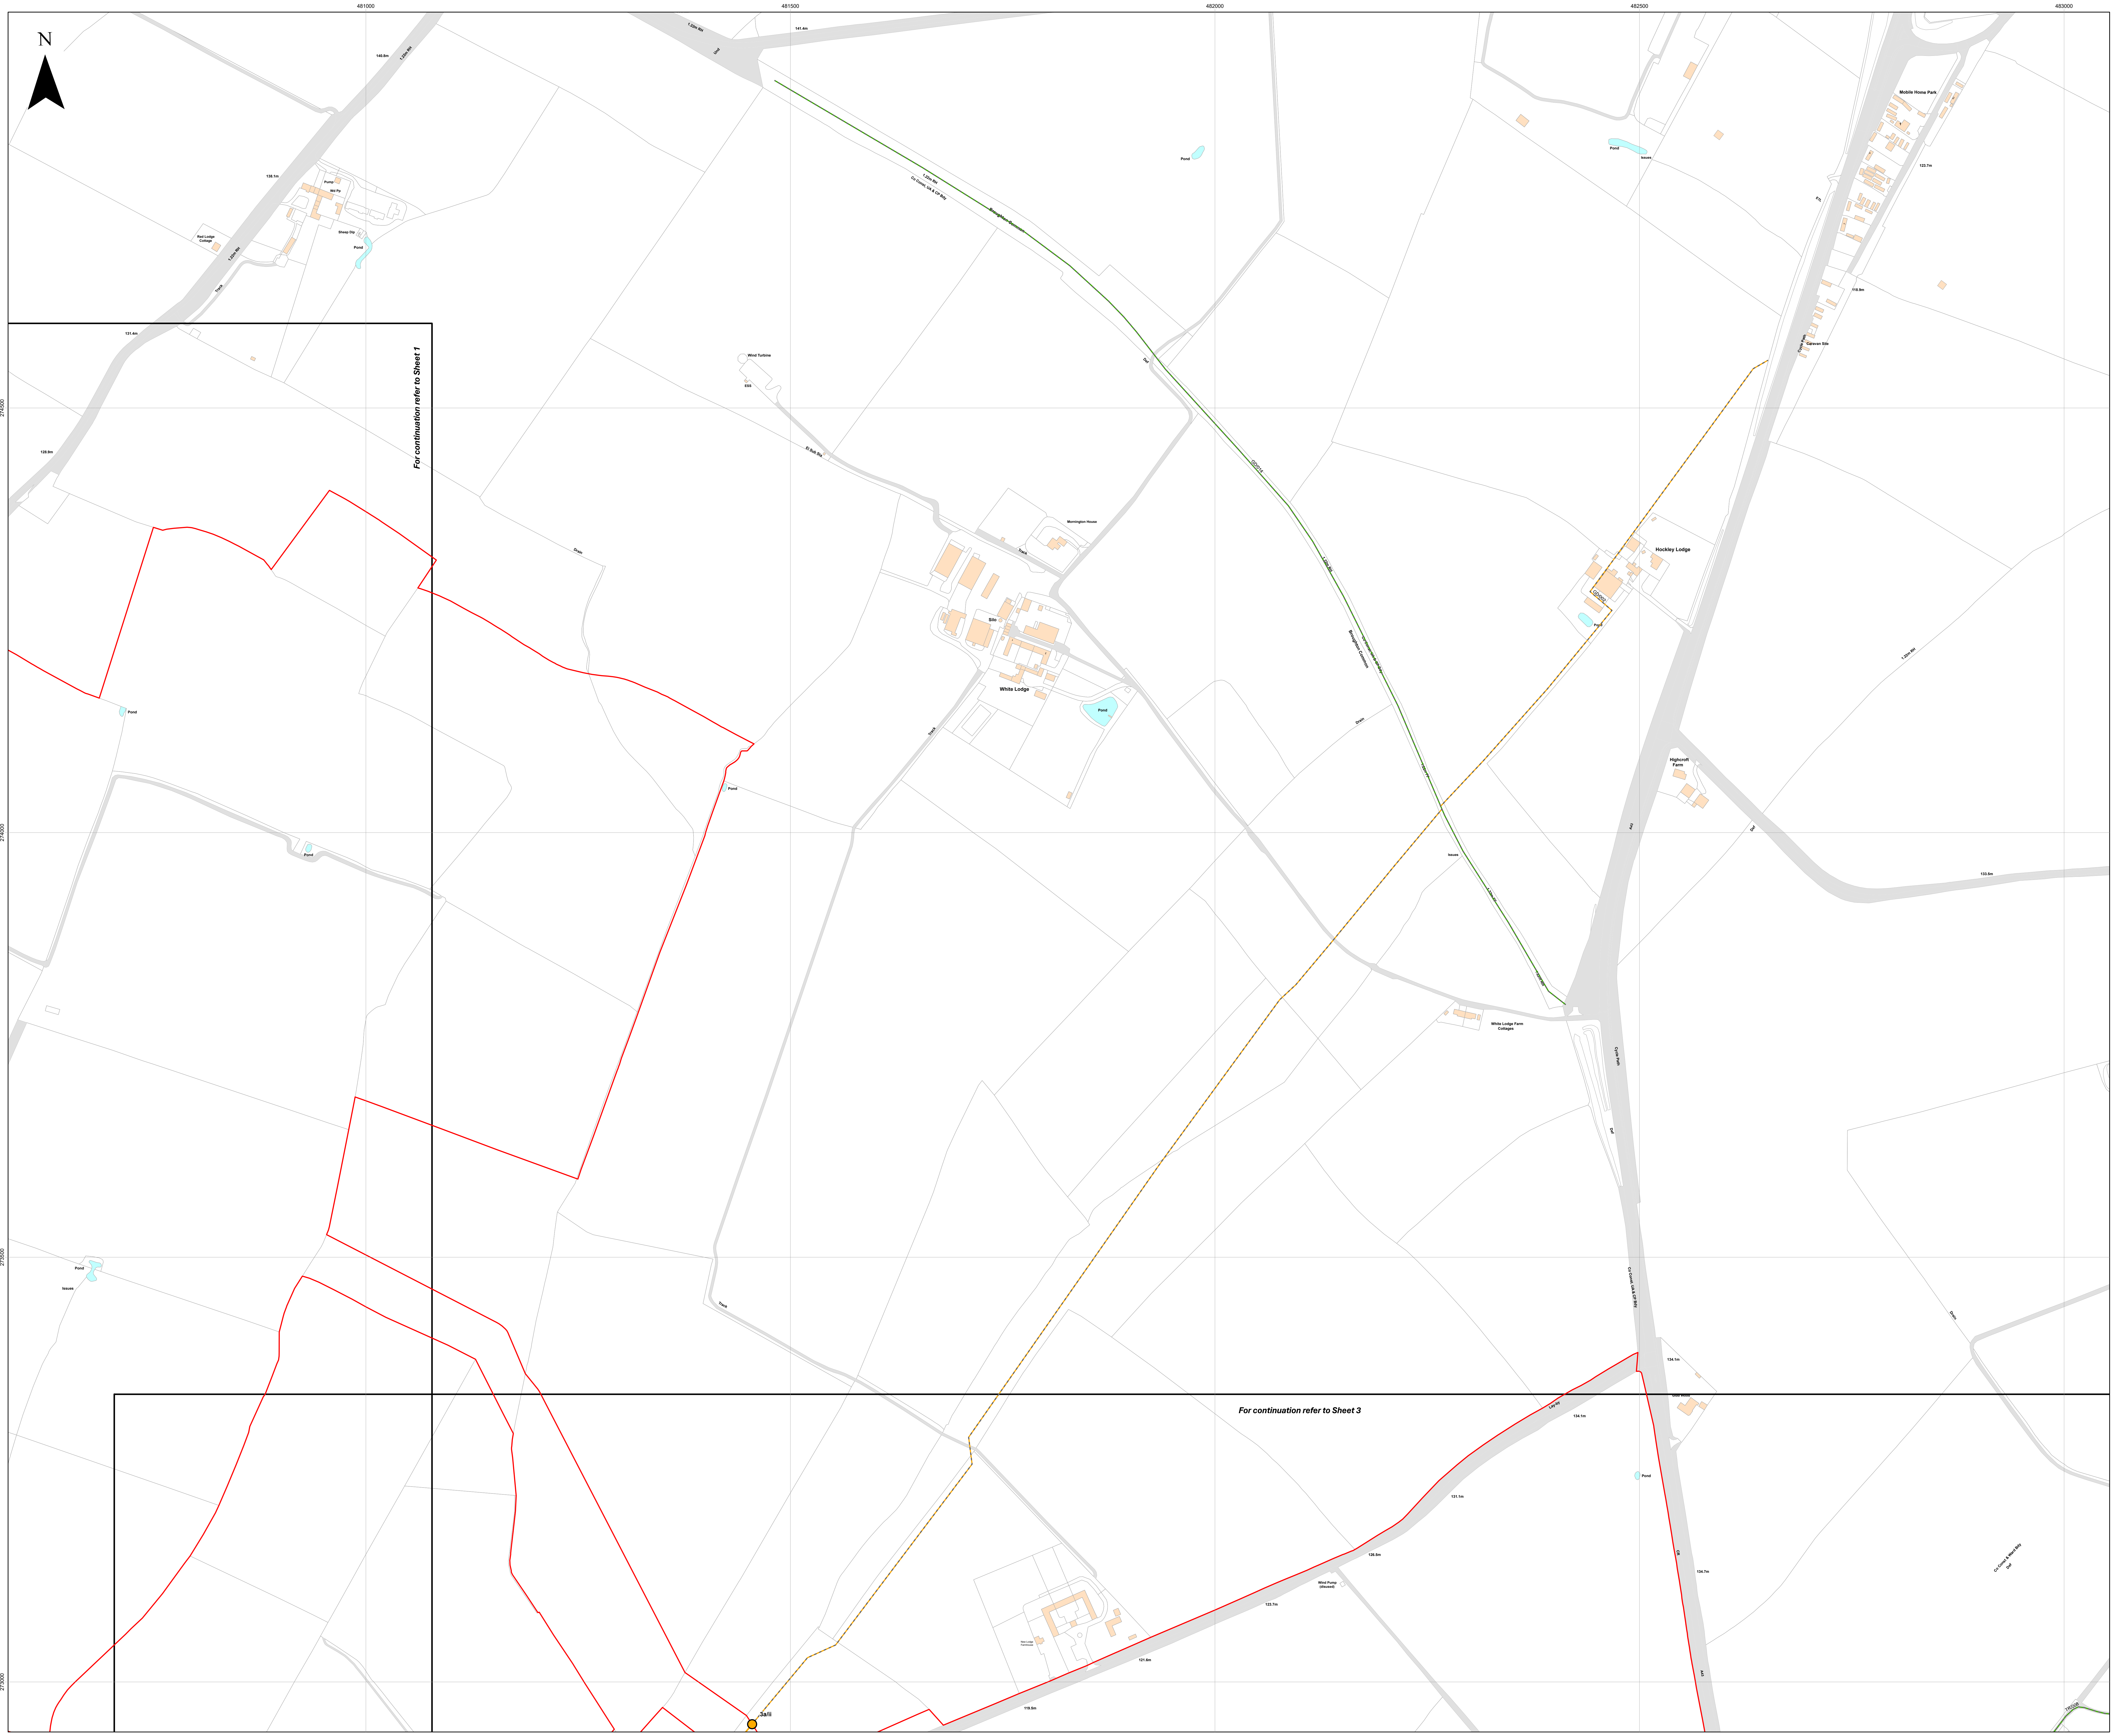
N
481000
481500
482000
482500
483000
274500
274000
273500
273000
For continuation refer to Sheet 1
For continuation refer to Sheet 3
White Lodge
Hockley Lodge
Mobile Home Park
Caravan Site
Highcroft Farm
White Lodge Farm Cottages
Silo
Pond
Wind Turbine
Track
Drain
Issues

Island GREEN POWER

Lanpro

Key

🟥	Order Limits
▭	Sheet Index

Public Right of Way (PRoW)

----	Bridleway
----	Footpath

PRoW to be temporarily stopped up

—	Footpath

PRoW to be temporarily stopped up - start and end points

●	Footpath

Layers: Lanpro, 2025; IGP, 2025
Base map: Reproduced from Ordnance Survey digital map data © Crown copyright 2025. All rights reserved. License number 0100031673

0 100 200 300 Meters

Scale: 1:2,500@ A0

APFP Regulation: 5(2)(j)	Application Doc No. CR1/GH2.6_B
Ref: P3535_LPR_ZZ_XX_DR_Z_0275	Date: 05/11/2025
Drawn by: BH	Checked by: JC

Public Rights of Way Plan (Change Application Version)

Sheet 2 of 18
Revision B

GREEN HILL SOLAR FARM

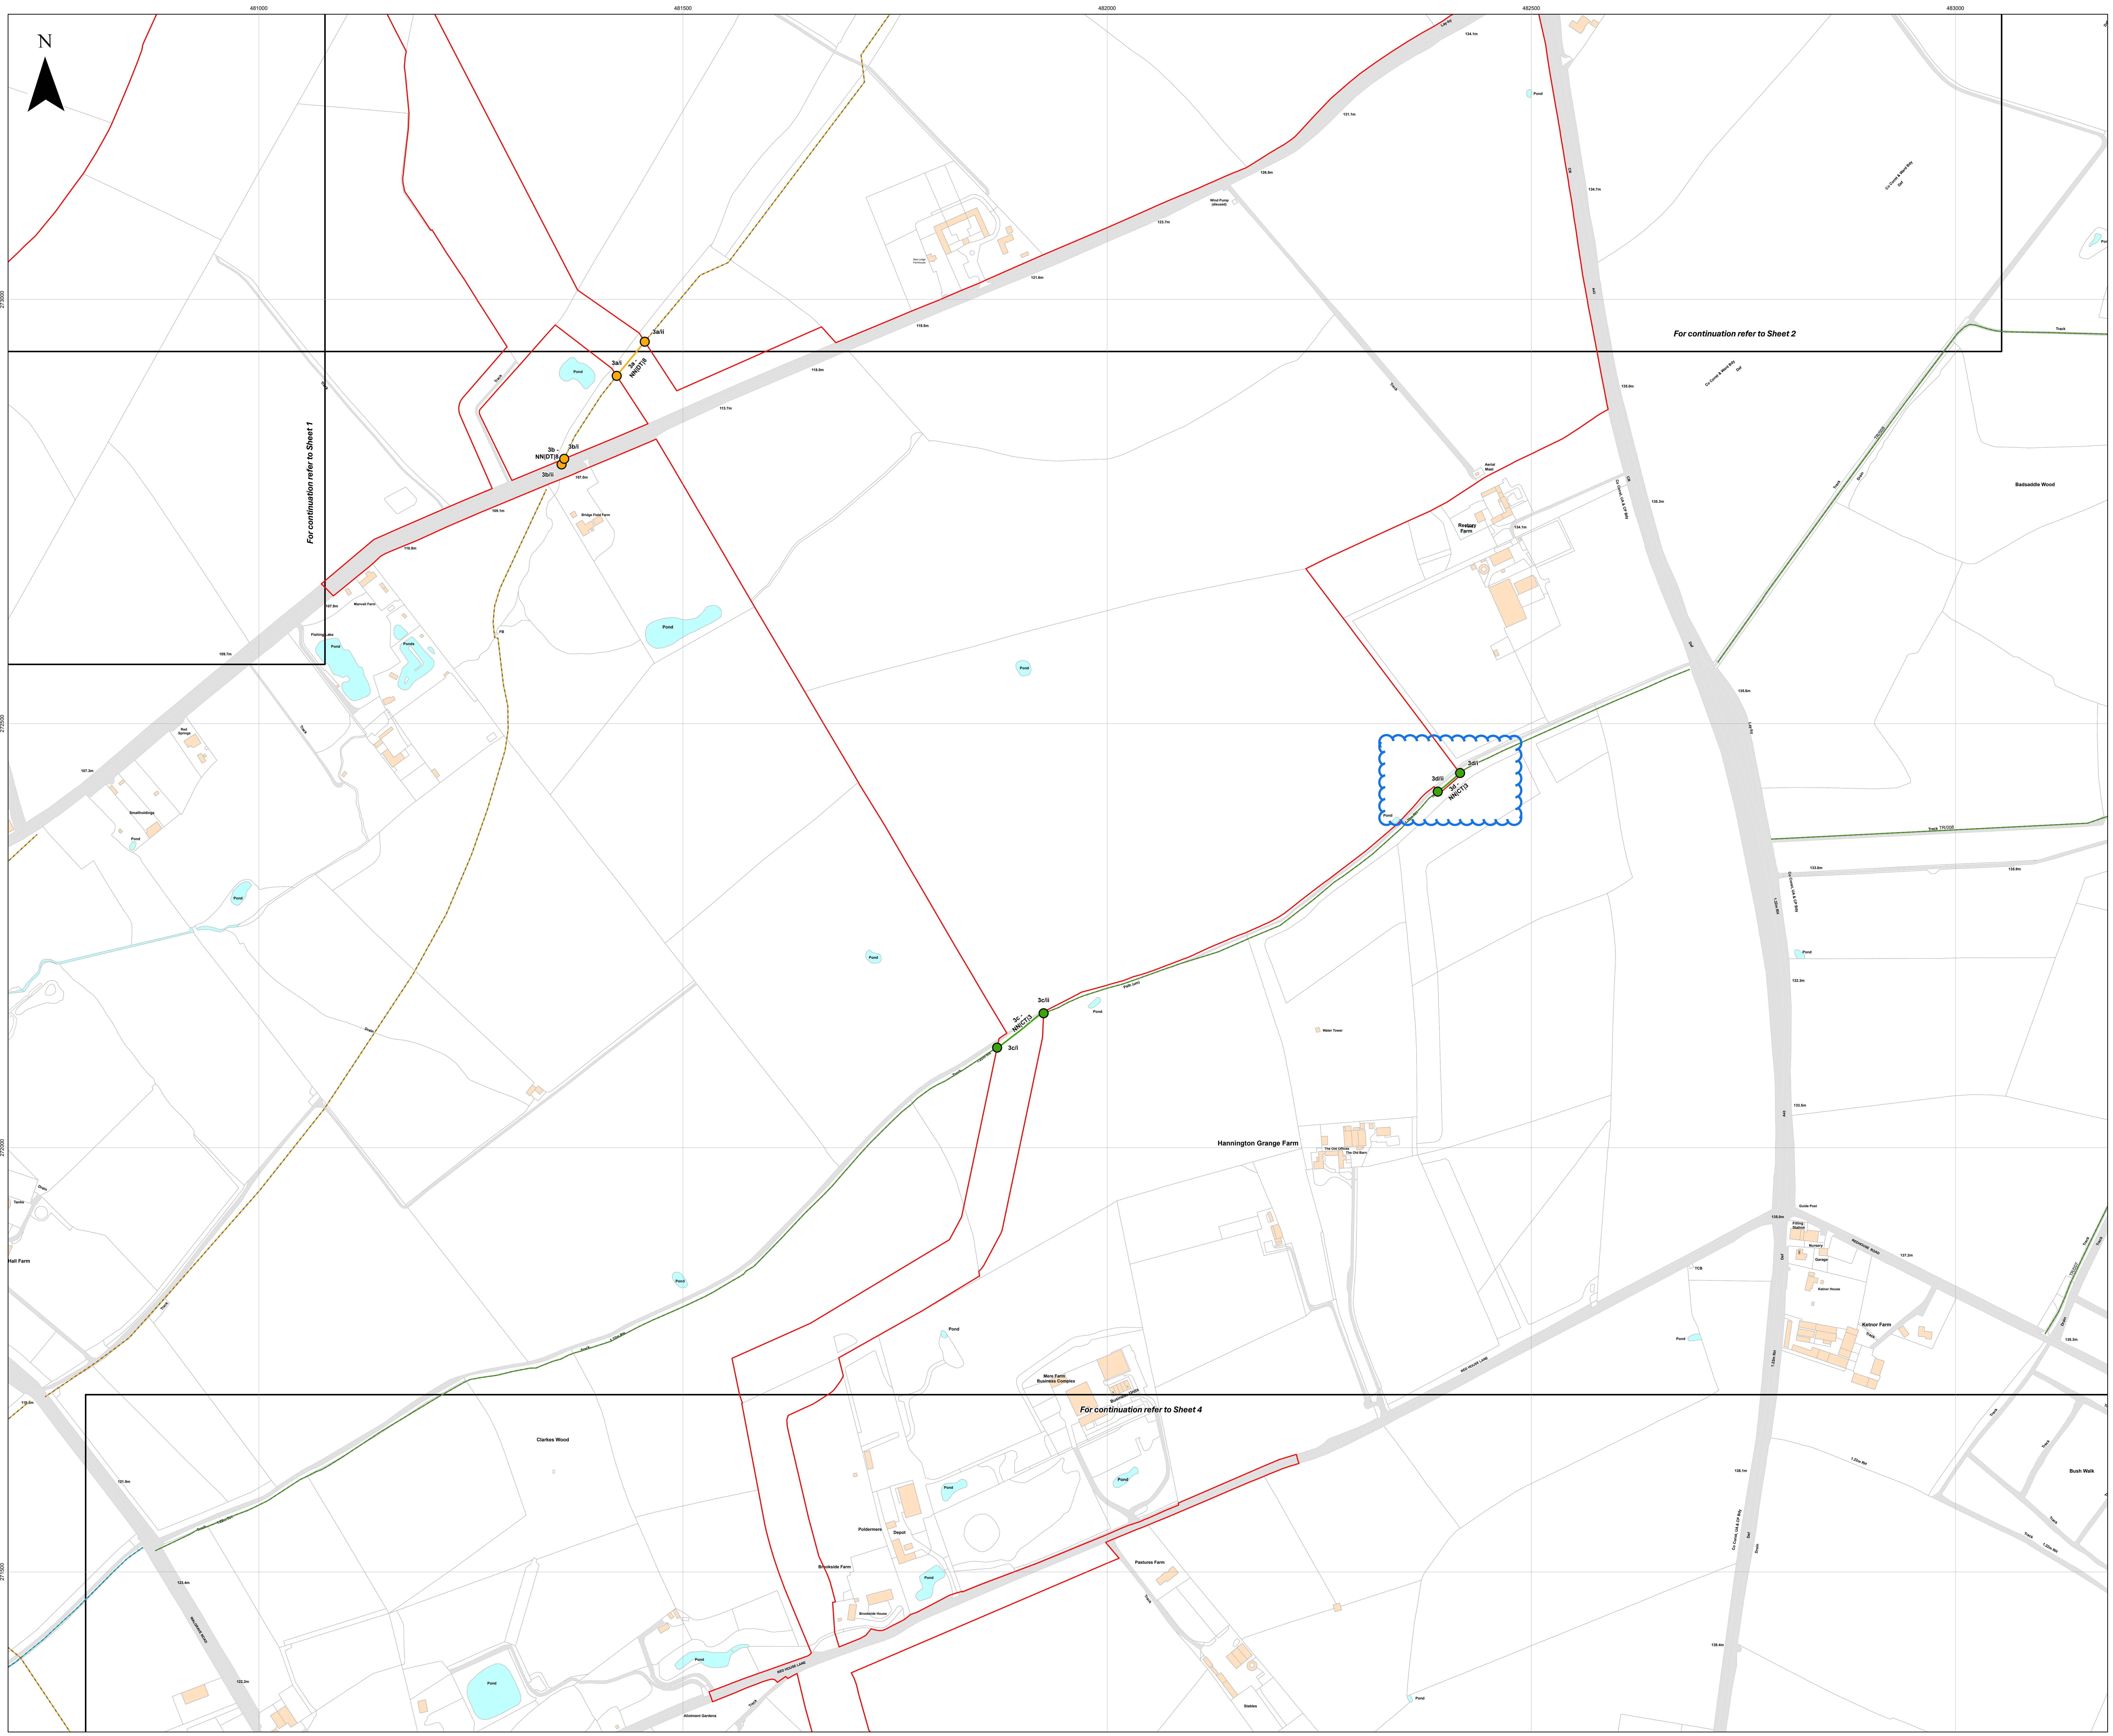
N
481000
481500
482000
482500
483000
273000
272500
272000
271500
For continuation refer to Sheet 1
For continuation refer to Sheet 2
For continuation refer to Sheet 4
3a/ii
3a/i
3a - NN|DT|8
3b - NN|DT|8
3b/i
3b/ii
3c - NN|CT|3
3c/i
3c/ii
3d - NN|CT|3
3d/i
3d/ii
Pond
Track
Path (um)
Bridge Field Farm
Rectory Farm
Badsaddle Wood
Hannington Grange Farm
Water Tower
Kelmor Farm
Clarkes Wood
Poplars Farm
Bush Walk
Hall Farm
107.0m
109.1m
113.7m

Island GREEN POWER

Lanpro

Key

- ▭ Order Limits
- ▭ Sheet Index

Public Right of Way (PRoW)

- Byway Open To All Traffic
- Bridleway
- Footpath

PRoW to be temporarily stopped up

- Bridleway
- Footpath

PRoW to be temporarily stopped up - start and end points

- ● Bridleway
- ● Footpath

Layers: Lanpro, 2025; IGP, 2025
Base map: Reproduced from Ordnance Survey digital map data © Crown copyright 2025. All rights reserved. License number 0100031673

0 100 200 300 Meters

Scale: 1:2,500@ A0

APFP Regulation: 5(2)(j)	Application Doc No. CR1/GH2.6_B
Ref: P3535_LPR_ZZ_XX_DR_Z_0275	Date: 05/11/2025
Drawn by: BH	Checked by: JC

Public Rights of Way Plan
(Change Application Version)

Sheet 3 of 18
Revision B

GREEN HILL
SOLAR FARM

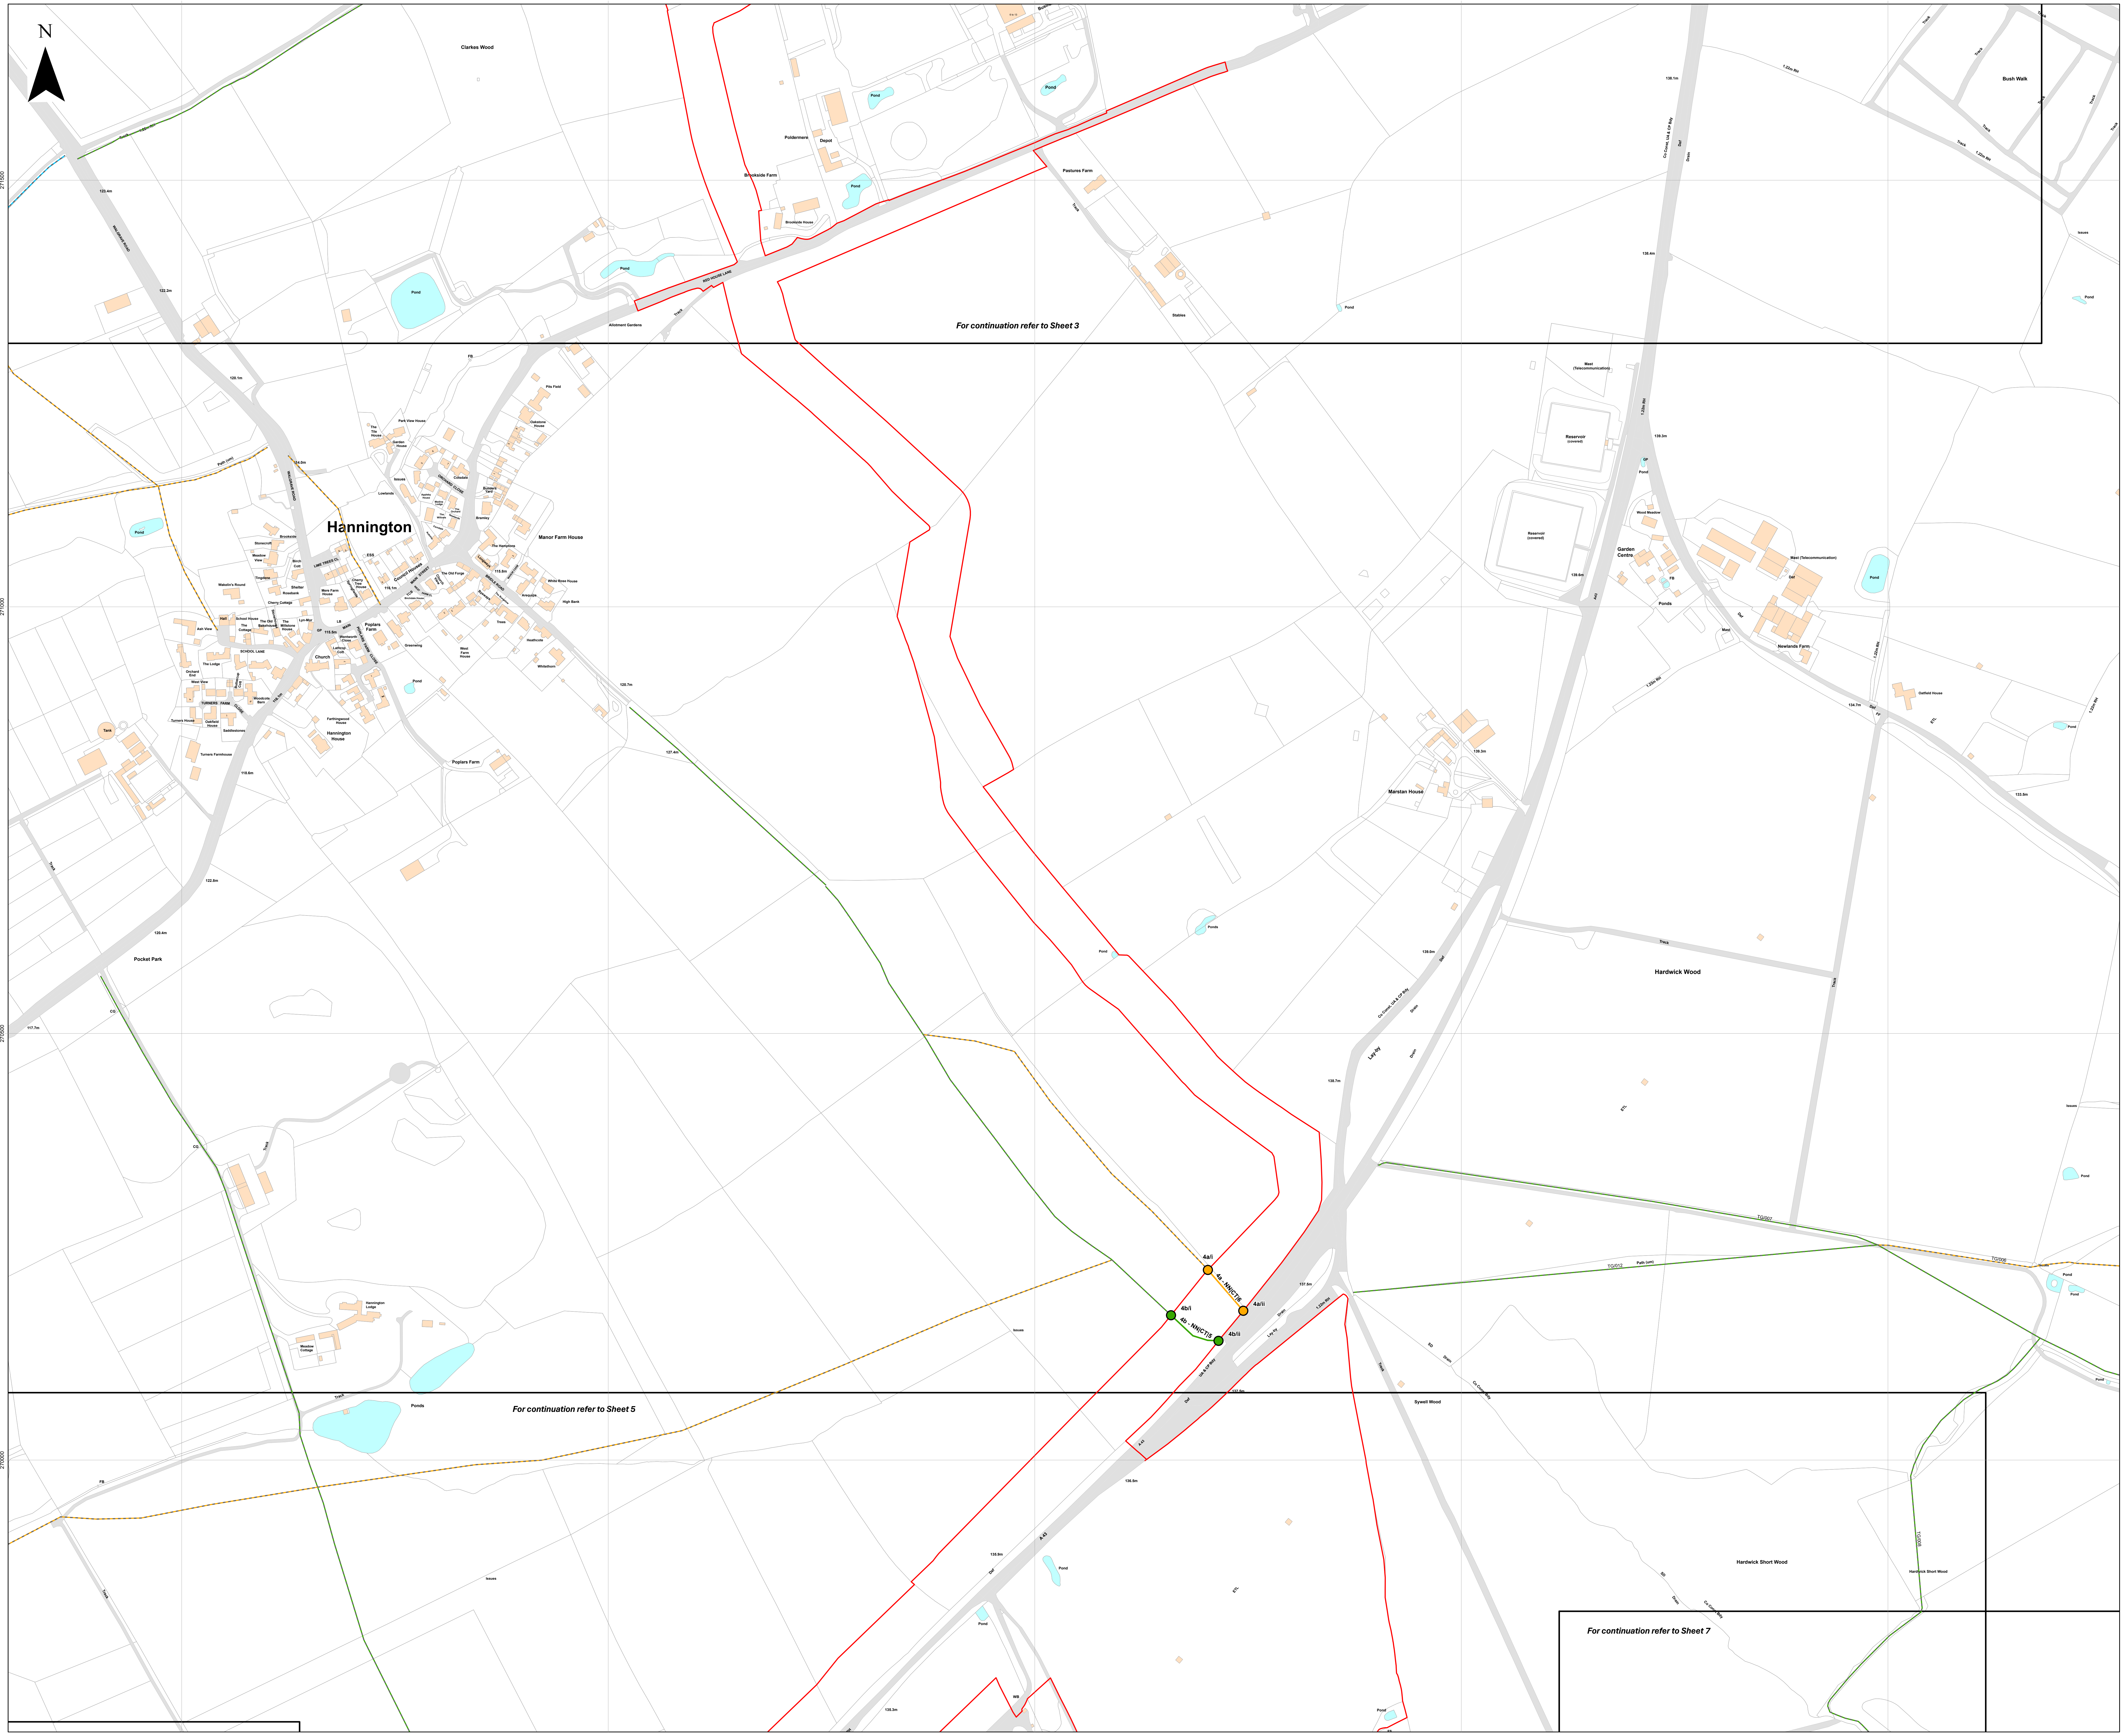
N
481000
481500
482000
482500
483000
271500
271000
270500
270000
Hannington
Clarkes Wood
Manor Farm House
Poplars Farm
Hannington House
Pocket Park
Pastures Farm
Allotment Gardens
Reservoir (covered)
Garden Centre
Newlands Farm
Marston House
Hardwick Wood
Hardwick Short Wood
Sywell Wood
Bush Walk
For continuation refer to Sheet 3
For continuation refer to Sheet 5
For continuation refer to Sheet 7
4a/i
4a - NN|CT|6
4a/ii
4b/i
4b - NN|CT|5
4b/ii
A 43
UA & CP Bdy
Lay-by
Drain
137.5m
1.22m RH

Key

- 🟥 Order Limits
- ▭ Sheet Index

Public Right of Way (PRoW)

- Byway Open To All Traffic
- Bridleway
- Footpath

PRoW to be temporarily stopped up

- Bridleway
- Footpath

PRoW to be temporarily stopped up - start and end points

- ● Bridleway
- ● Footpath

Layers: Lanpro, 2025; IGP, 2025

0 100 200 300 Meters

Scale: 1:2,500@ A0

APFP Regulation: 5(2)(j)	Application Doc No. CR1/GH2.6_B
Ref: P3535_LPR_ZZ_XX_DR_Z_0275	Date: 05/11/2025
Drawn by: BH	Checked by: JC

Public Rights of Way Plan (Change Application Version)

Sheet 4 of 18

Revision B

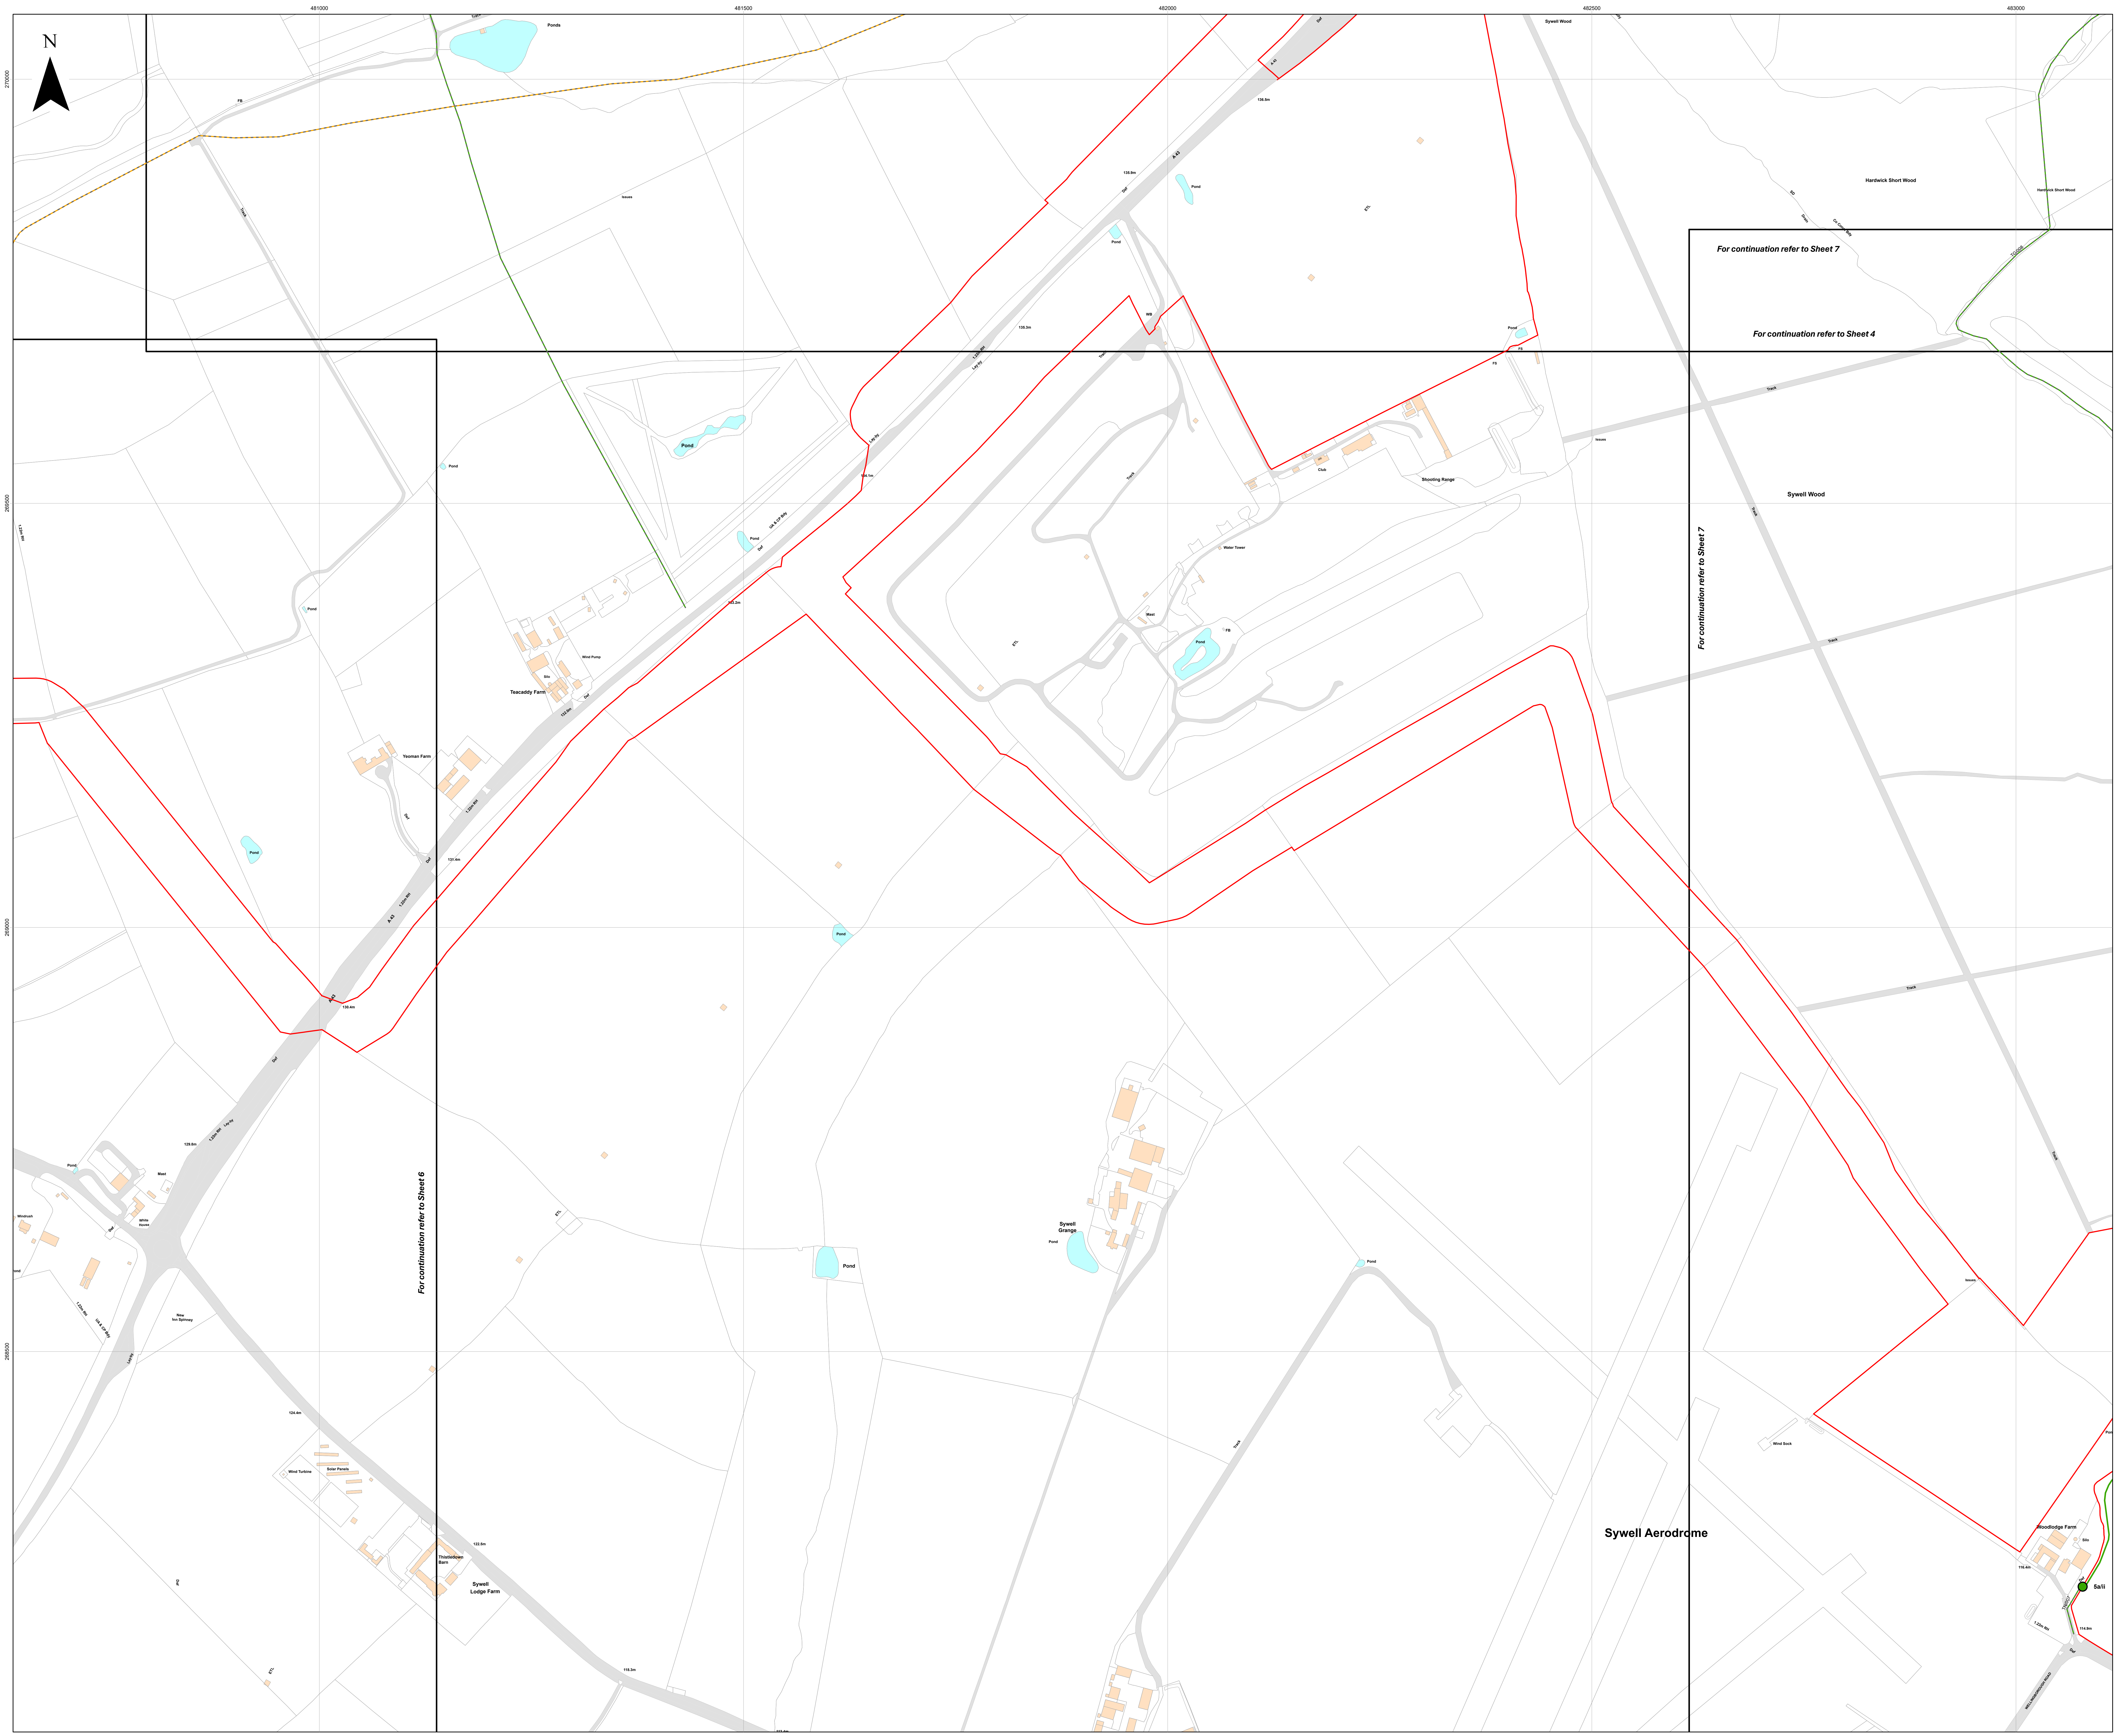
N
481000
481500
482000
482500
483000
270000
269500
269000
268500
Ponds
Sywell Wood
Hardwick Short Wood
Issues
A 43
Def
136.5m
135.9m
135.3m
Pond
ETL
WB
FS
Track
1.22m RH
Lay-by
For continuation refer to Sheet 7
For continuation refer to Sheet 4
For continuation refer to Sheet 6
Club
Shooting Range
Water Tower
Mast
FB
Teacaddy Farm
Wind Pump
Silo
Yeoman Farm
Sywell Grange
Sywell Aerodrome
Wind Sock
Woodlodge Farm
116.4m
114.9m
5a/ii
TN/007
WELLINGBOROUGH ROAD
Windrush
White House
129.8m
New Inn Spinney
UA & CP Bdy
124.4m
Wind Turbine
Solar Panels
Thistledown Barn
Sywell Lodge Farm
122.5m

Island GREEN POWER

Lanpro

Key

🟥 Order Limits

▭ Sheet Index

Public Right of Way (PRoW)

--- Bridleway

--- Footpath

PRoW to be temporarily stopped up

— Bridleway

PRoW to be temporarily stopped up - start and end points

● Bridleway

Layers: Lanpro, 2025; IGP, 2025
Base map: Reproduced from Ordnance Survey digital map data © Crown copyright 2025. All rights reserved. License number 0100031673

0 100 200 300 Meters

Scale: 1:2,500@ A0

APFP Regulation: 5(2)(j)	Application Doc No. CR1/GH2.6_B
Ref: P3535_LPR_ZZ_XX_DR_Z_0275	Date: 05/11/2025
Drawn by: BH	Checked by: JC

Public Rights of Way Plan (Change Application Version)

Sheet 5 of 18
Revision B

GREEN HILL
SOLAR FARM

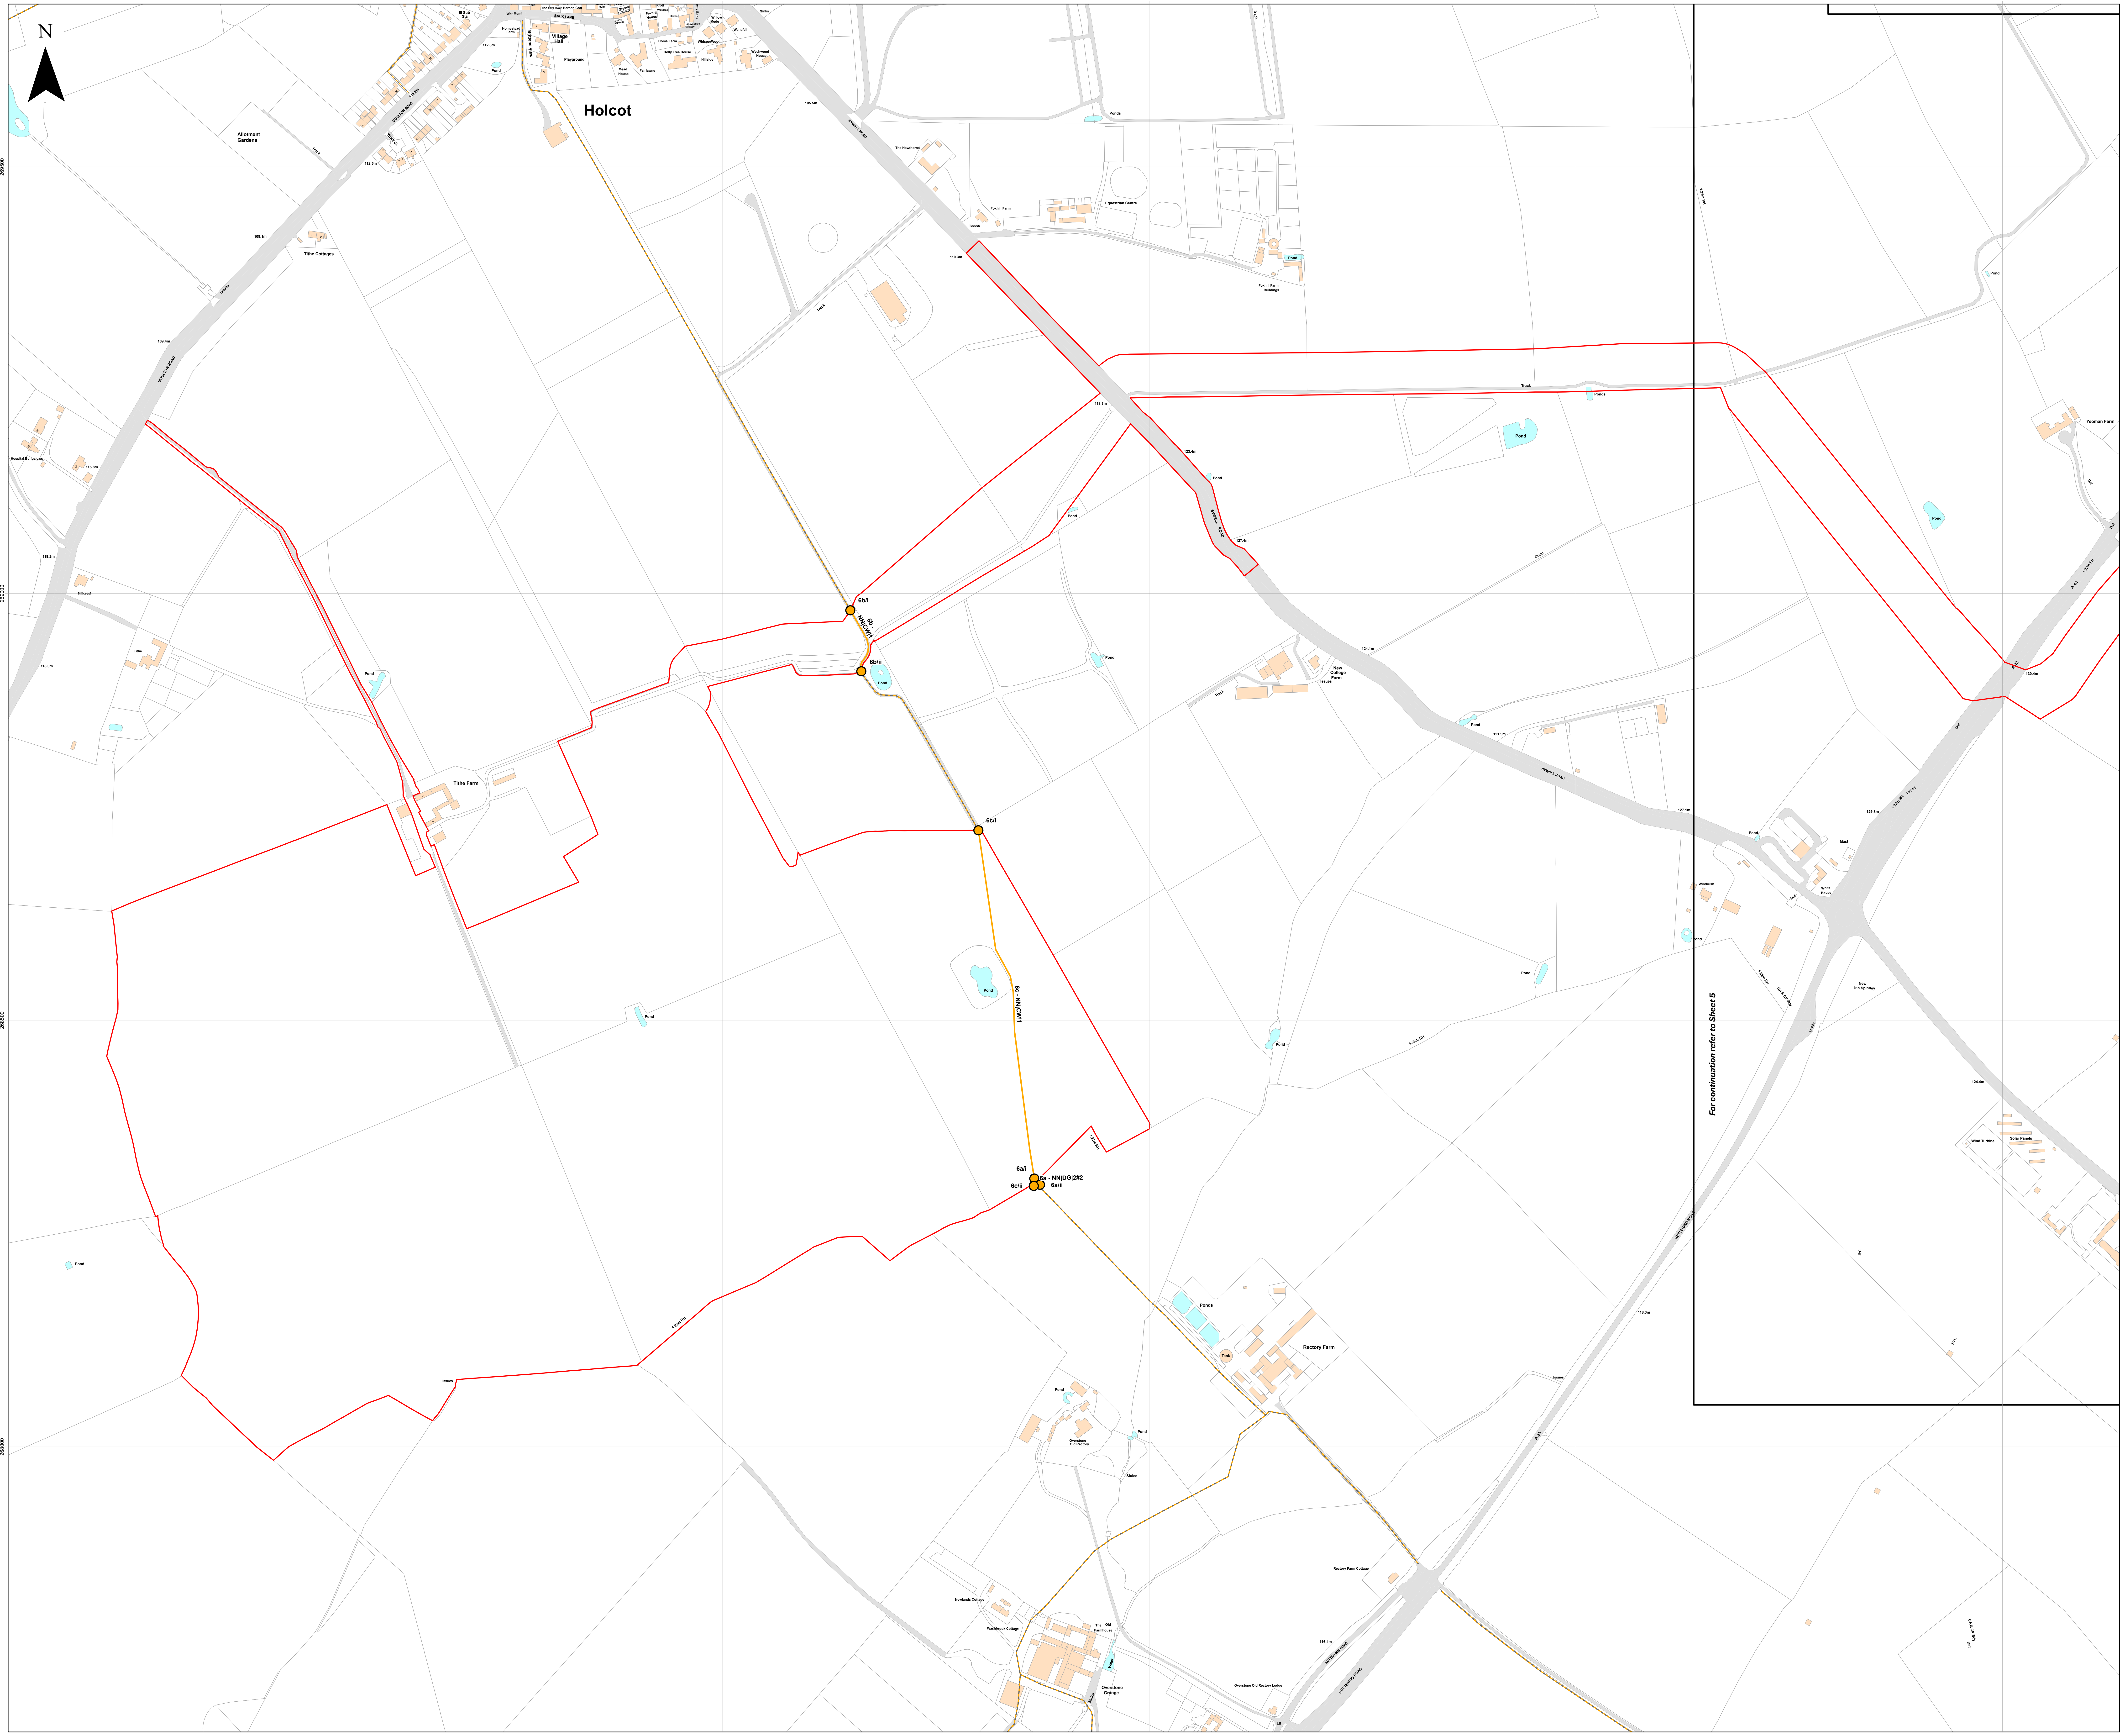
479000
479500
480000
480500
481000
269500
269000
268500
268000
N
Holcot
Village Hall
Allotment Gardens
Tithe Cottages
Tithe Farm
6b/i
6b - NN|CW|1
6b/ii
Pond
6c/i
6c - NN|CW|1
6a/i
6a - NN|DG|2#2
6c/ii
6a/ii
1.22m RH
Rectory Farm
Yeoman Farm
For continuation refer to Sheet 5

Island GREEN POWER

Lanpro

Key

🟥 Order Limits

☐ Sheet Index

Public Right of Way (PRoW)

Footpath

PRoW to be temporarily stopped up

Footpath

PRoW to be temporarily stopped up - start and end points

● Footpath

Layers: Lanpro, 2025; IGP, 2025

Base map: Reproduced from Ordnance Survey digital map data © Crown copyright 2025. All rights reserved. License number 0100031673

0 100 200 300 Meters

Scale: 1:2,500@ A0

APFP Regulation: 5(2)(j)	Application Doc No. CR1/GH2.6_B
Ref: P3535_LPR_ZZ_XX_DR_Z_0275	Date: 05/11/2025
Drawn by: BH	Checked by: JC

Public Rights of Way Plan (Change Application Version)

Sheet 6 of 18

Revision B

GREEN HILL SOLAR FARM

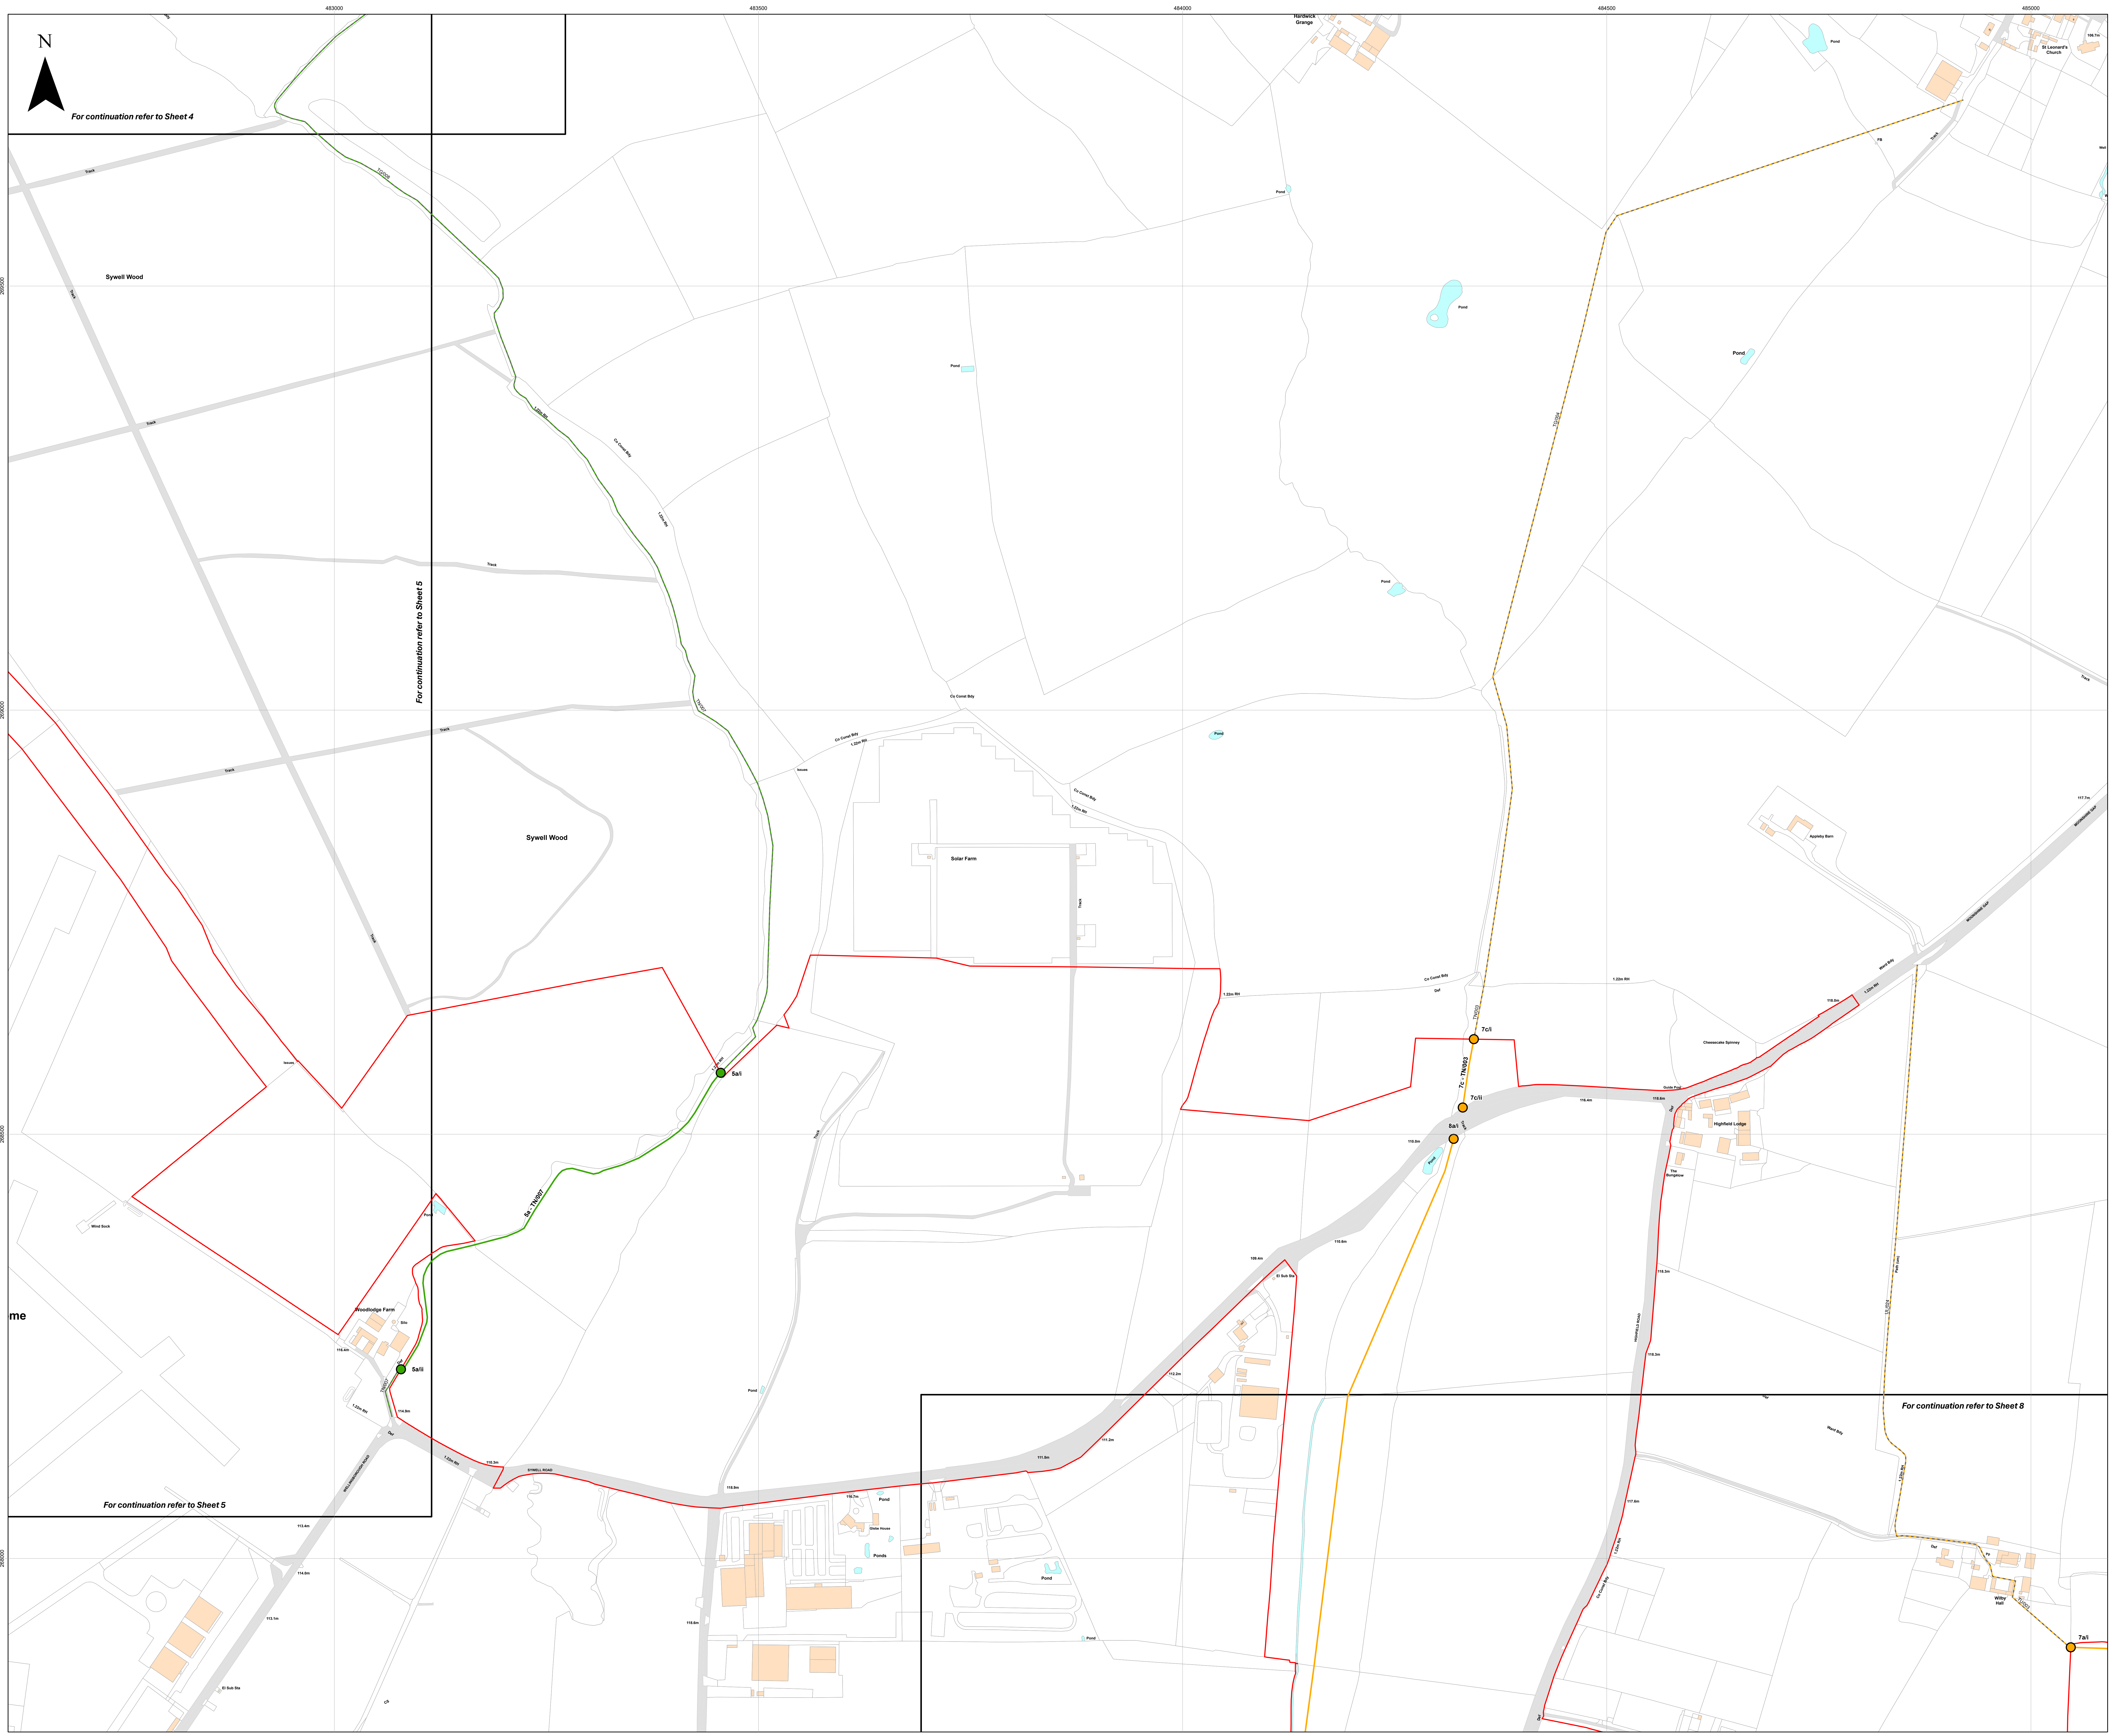
483000
483500
484000
484500
485000
N
For continuation refer to Sheet 4
For continuation refer to Sheet 5
For continuation refer to Sheet 5
For continuation refer to Sheet 8
Hardwick Grange
Sywell Wood
Sywell Wood
Solar Farm
Track
Pond
8a/i
8a/ii
8a - TN/007
7c/i
7c/ii
7c - TN/003
7a/i
Woodlodge Farm
Highfield Lodge
Cheesecake Spinney
Appleby Barn
SYWELL ROAD

Key

🟥 Order Limits

▭ Sheet Index

Public Right of Way (PRoW)

Bridleway

Footpath

PRoW to be temporarily stopped up

Bridleway

Footpath

PRoW to be temporarily stopped up - start and end points

● Bridleway

● Footpath

Layers: Lanpro, 2025; IGP, 2025

Base map: Reproduced from Ordnance Survey digital map data © Crown copyright 2025. All rights reserved. License number 0100031673

0 100 200 300 Meters

Scale: 1:2,500@ A0

APFP Regulation: 5(2)(j)	Application Doc No. CR1/GH2.6_B
Ref: P3535_LPR_ZZ_XX_DR_Z_0275	Date: 05/11/2025
Drawn by: BH	Checked by: JC

Public Rights of Way Plan (Change Application Version)

Sheet 7 of 18

Revision B

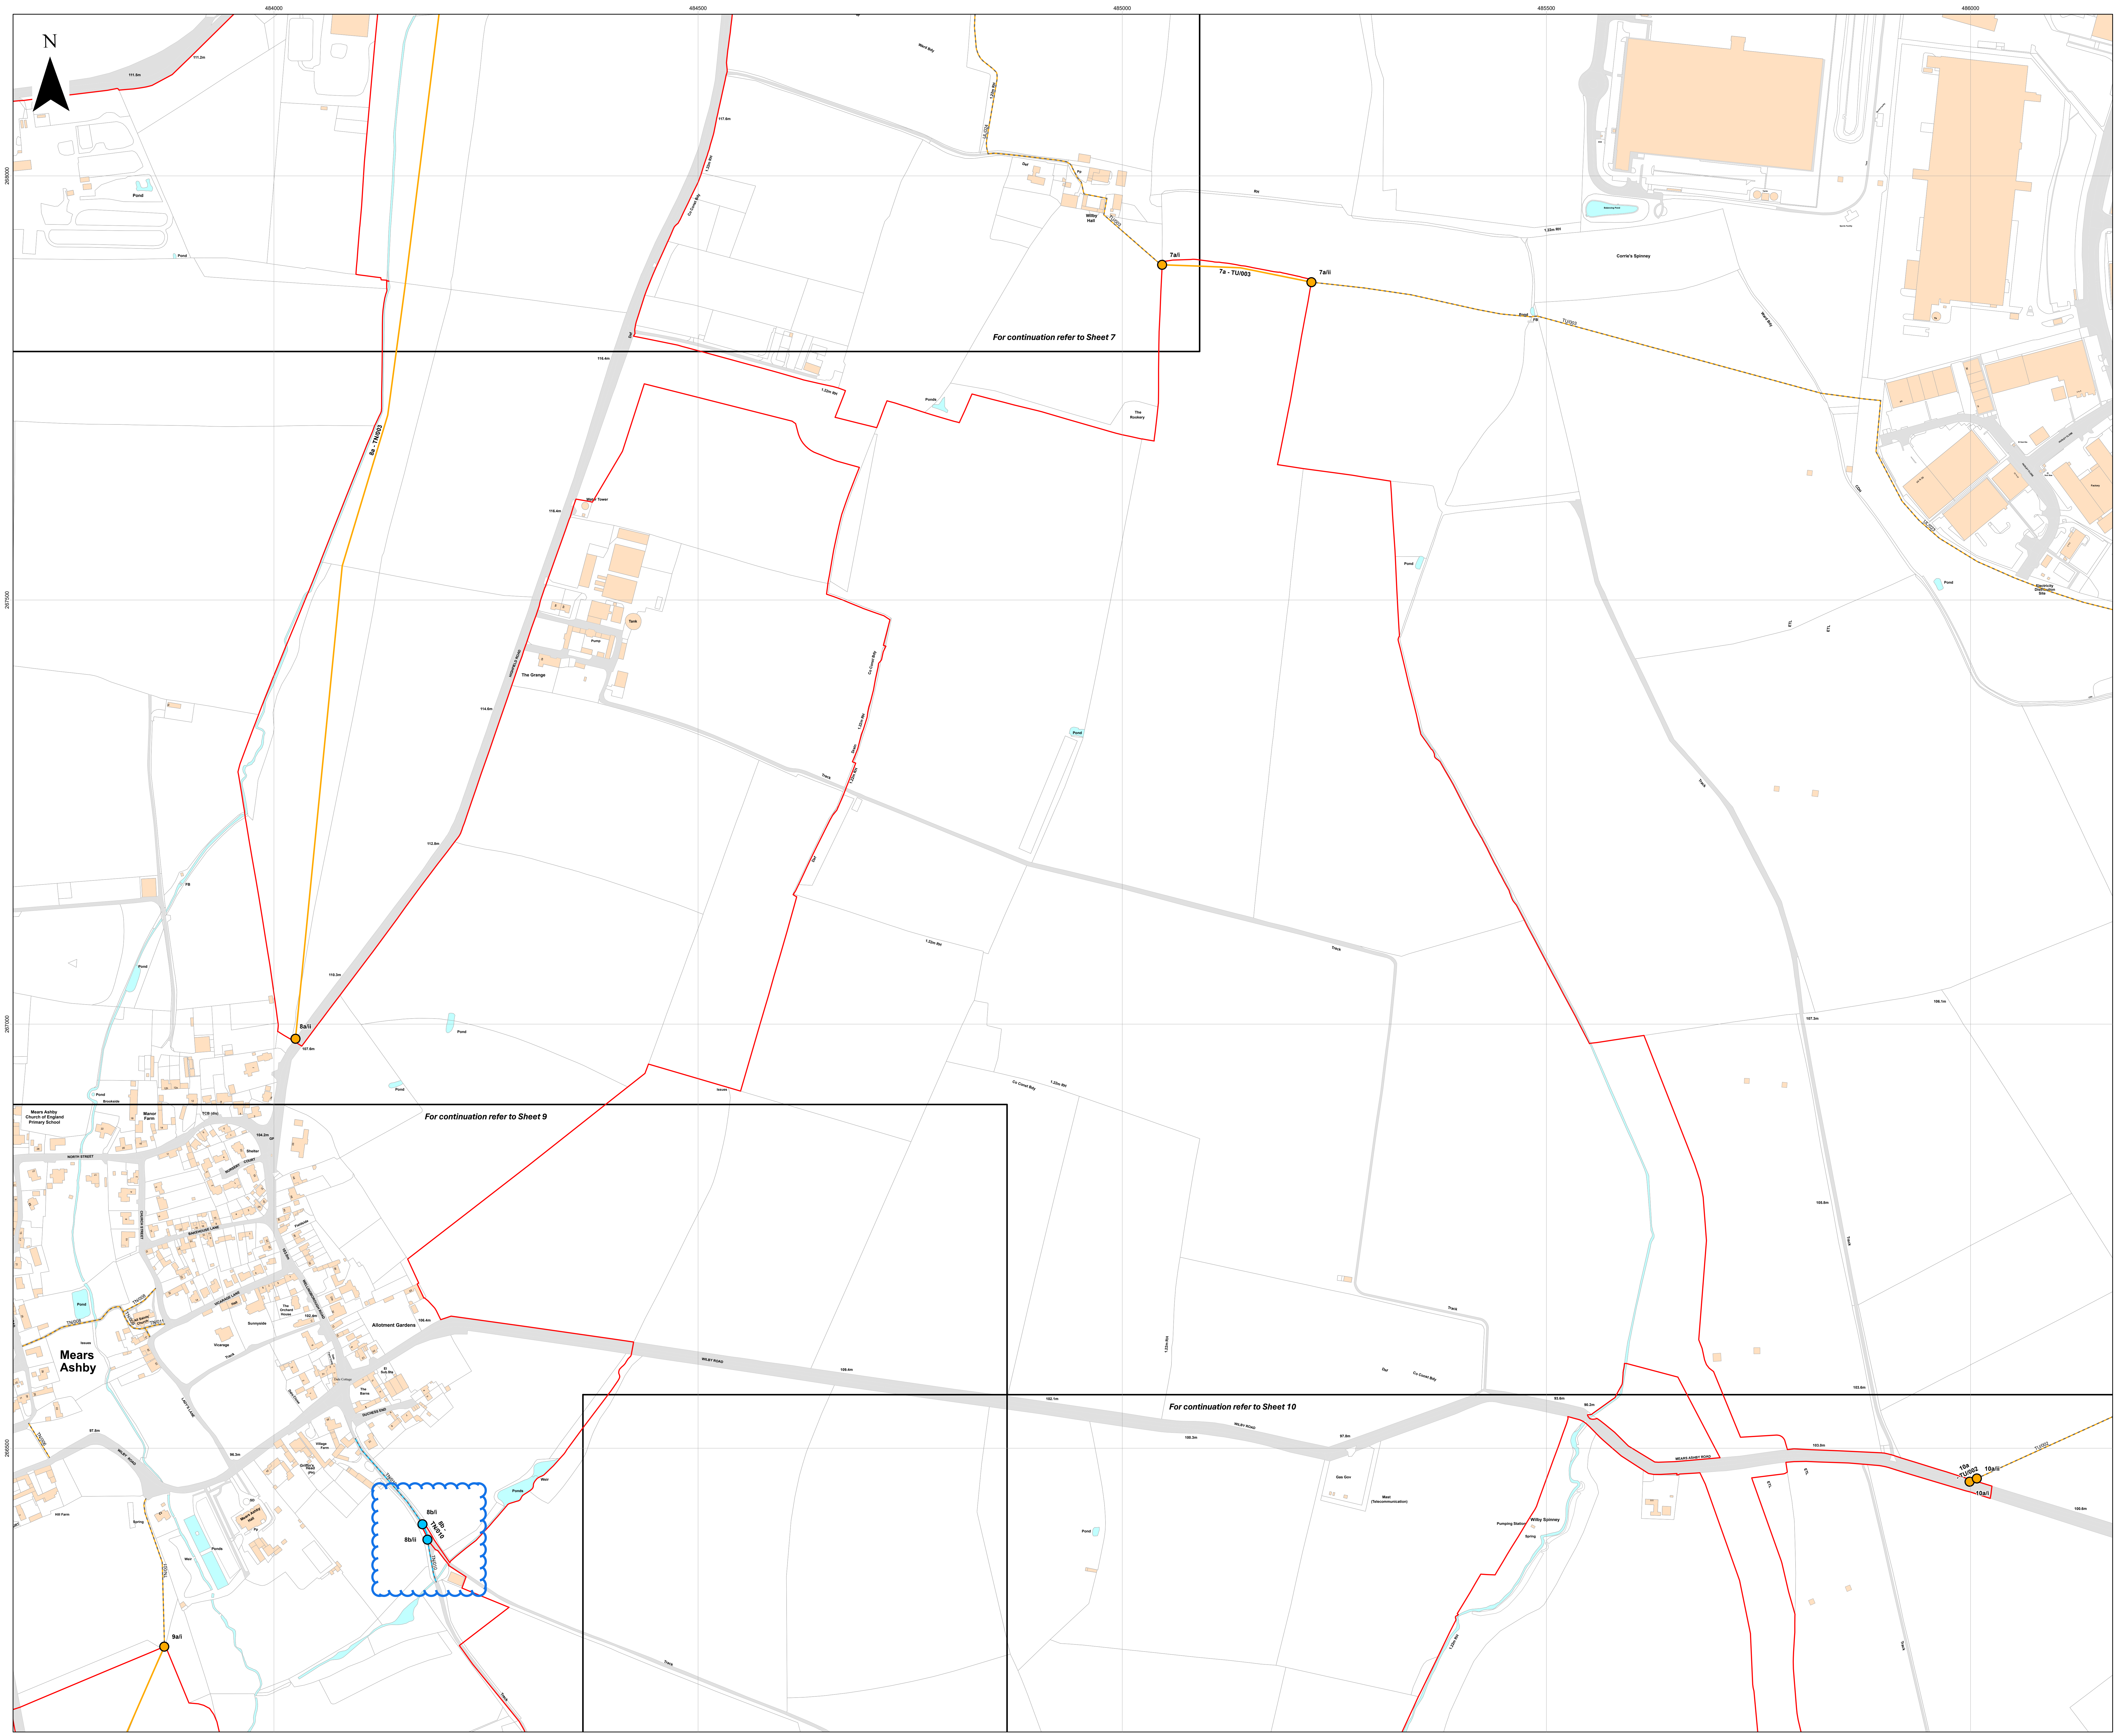
N
484000
484500
485000
485500
486000
7a/i
7a - TU/003
7a/ii
TU/003
8a - TN/003
8a/ii
8b/i
8b - TN/010
8b/ii
TN/010
9a/i
TN/001
10a - TU/002
10a/i
10a/ii
TU/002
For continuation refer to Sheet 7
For continuation refer to Sheet 9
For continuation refer to Sheet 10
Mears Ashby
Wilby Hall
The Grange
Allotment Gardens
DUCHESS END
Ponds
Weir
Wilby Spinney

Island GREEN POWER

Lanpro

Key

- 🟥 Order Limits
- ☐ Sheet Index

Public Right of Way (PRoW)

- Byway Open To All Traffic
- Footpath

PRoW to be temporarily stopped up

- Byway Open To All Traffic
- Footpath

PRoW to be temporarily stopped up - start and end points

- ● BOAT
- ● Footpath

Layers: Lanpro, 2025; IGP, 2025

0 100 200 300 Meters

Scale: 1:2,500@ A0

APFP Regulation: 5(2)(j)	Application Doc No. CR1/GH2.6_B
Ref: P3535_LPR_ZZ_XX_DR_Z_0275	Date: 05/11/2025
Drawn by: BH	Checked by: JC

Public Rights of Way Plan (Change Application Version)

Sheet 8 of 18
Revision B

GREEN HILL SOLAR FARM

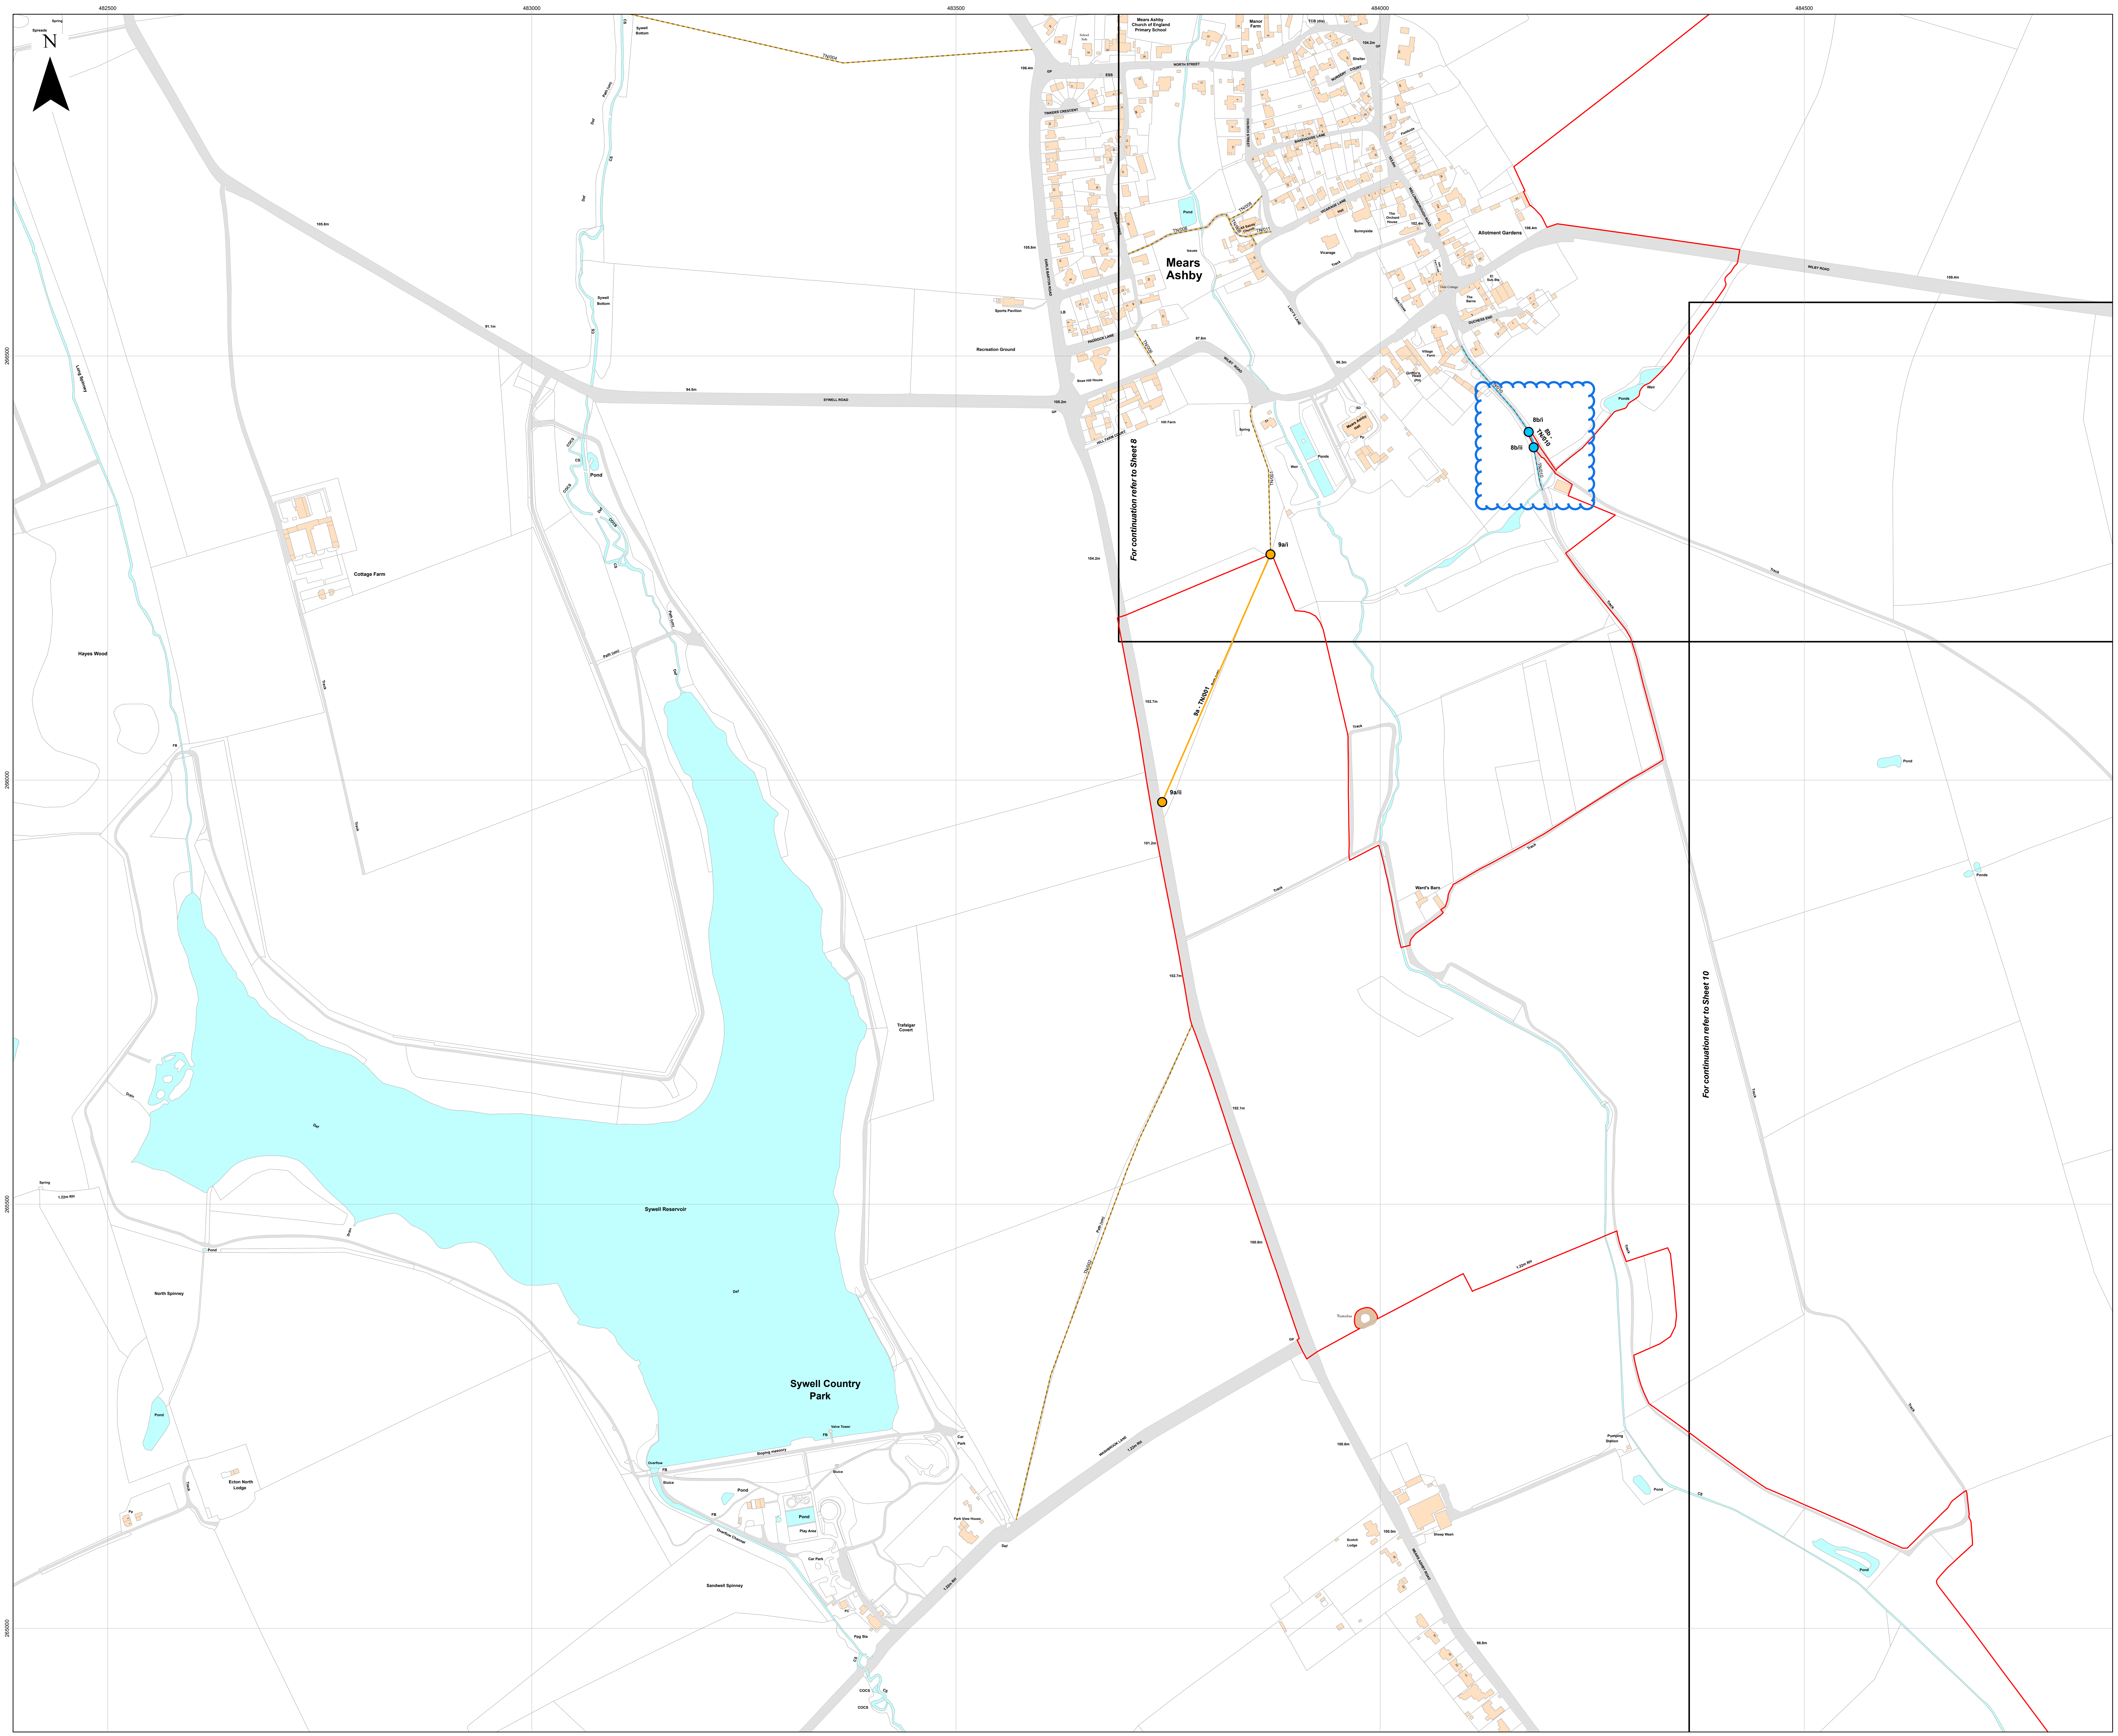
482500
483000
483500
484000
484500
265500
266000
265000
265000
N
Mears Ashby
Sywell Reservoir
Sywell Country Park
Hayes Wood
Cottage Farm
North Spinney
Sandwell Spinney
Ecton North Lodge
Trafalgar Covert
Ward's Barn
Recreation Ground
Allotment Gardens
Mears Ashby Church of England Primary School
Manor Farm
NORTH STREET
DUCHESS END
PADDOCK LANE
WILBY ROAD
SYWELL ROAD
LADY'S LANE
HILL FARM COURT
Rose Hill House
Hill Farm
Spring
Ponds
Weir
Village Farm
Griffin's Head (PH)
The Barns
Dale Cottage
For continuation refer to Sheet 8
For continuation refer to Sheet 10
TN/006
TN/001
TN/010
8b/i
8b/ii
8b - TN/010
9a/i
9a/ii
9a - TN/001
Track
Pond
Pumping Station
104.2m
102.7m
101.2m
97.8m
96.3m

Island GREEN POWER

Lanpro

Key

- ▭ Order Limits
- ▭ Sheet Index

Public Right of Way (PRoW)

- --- Byway Open To All Traffic
- --- Footpath

PRoW to be temporarily stopped up

- — Byway Open To All Traffic
- — Footpath

PRoW to be temporarily stopped up - start and end points

- ● BOAT
- ● Footpath

Layers: Lanpro, 2025; IGP, 2025
Base map: Reproduced from Ordnance Survey digital map data © Crown copyright 2025. All rights reserved. License number 0100031673

0 100 200 300 Meters

Scale: 1:2,500@ A0

APFP Regulation: 5(2)(j)	Application Doc No. CR1/GH2.6_B
Ref: P3535_LPR_ZZ_XX_DR_Z_0275	Date: 05/11/2025
Drawn by: BH	Checked by: JC

Public Rights of Way Plan (Change Application Version)

Sheet 9 of 18
Revision B

GREEN HILL SOLAR FARM

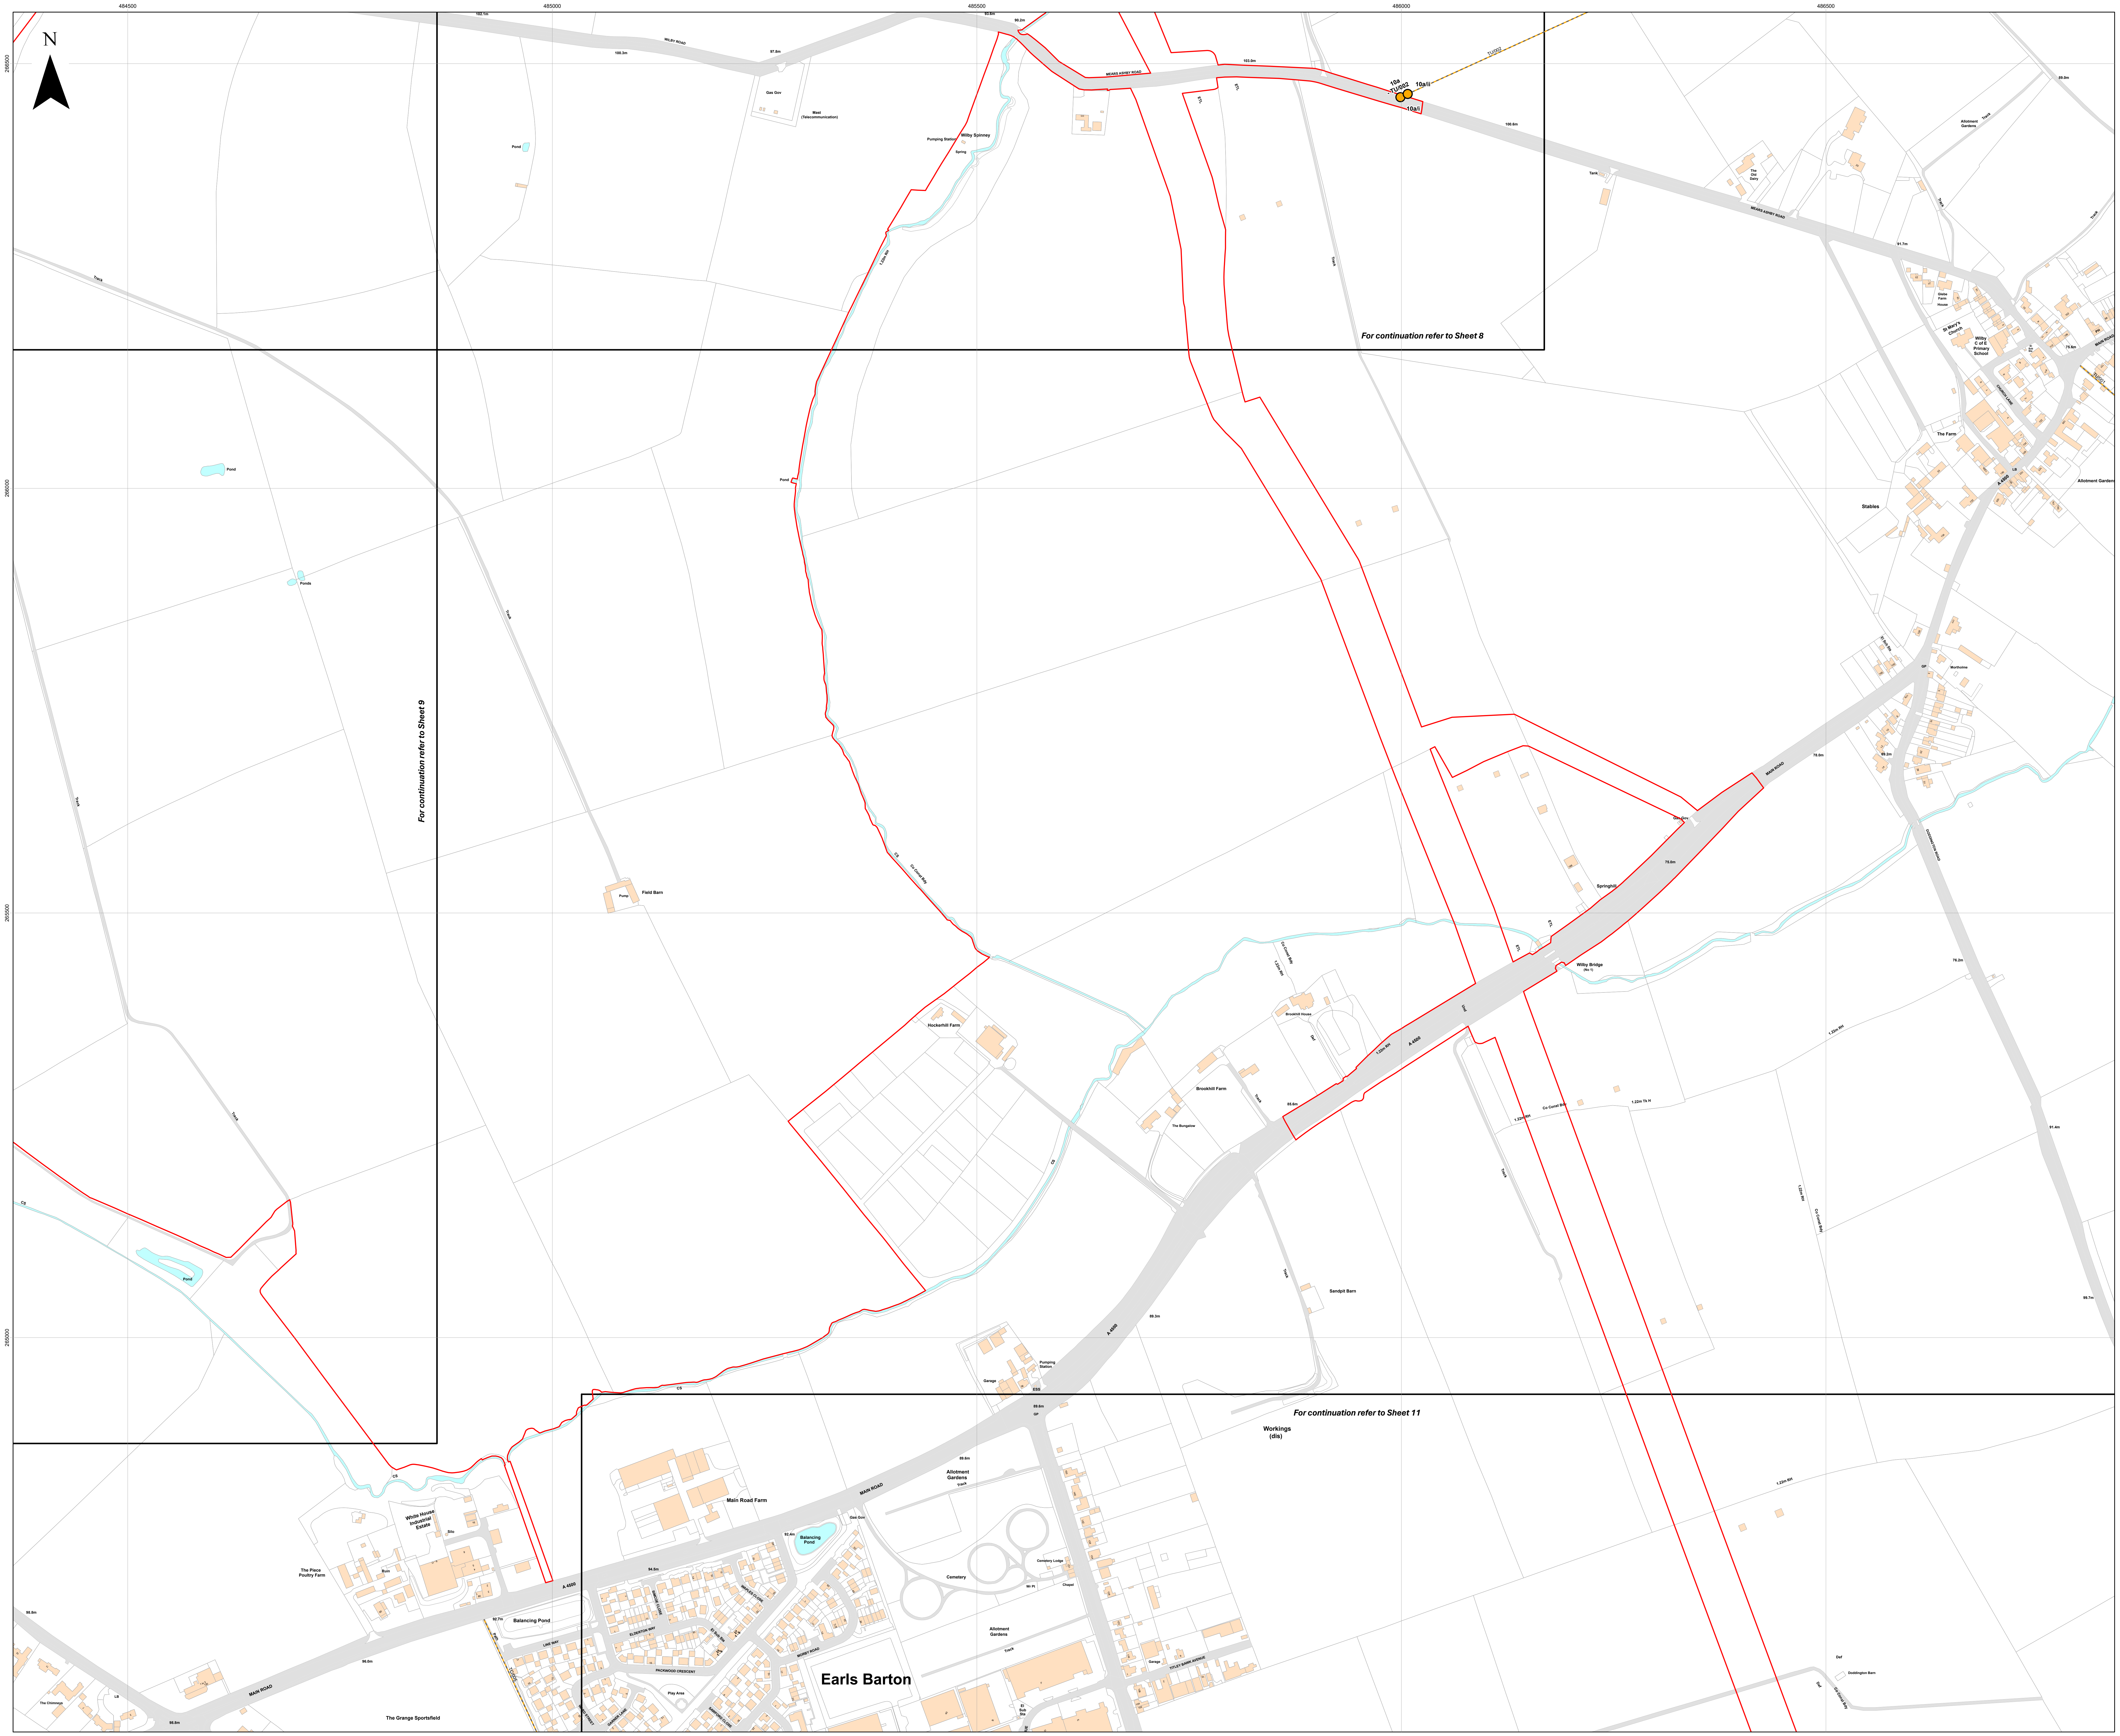
N
484500
485000
485500
486000
486500
For continuation refer to Sheet 8
For continuation refer to Sheet 9
For continuation refer to Sheet 11
10a
- TU/002
10a/ii
10a/i
TU/002
TU/001
100.6m
Tank
WILBY ROAD
MEARS ASHBY ROAD
Wilby Spinney
Pumping Station
Mast (Telecommunication)
Pond
Ponds
Field Barn
Hockerhill Farm
Brookhill Farm
Brookhill House
The Bungalow
Sandpit Barn
Springfield
Wilby Bridge
Stables
The Farm
Allotment Gardens
St Mary's Church
Wilby C of E Primary School
Workings (dis)
MAIN ROAD
A 4500
Main Road Farm
Balancing Pond
Cemetery
Earls Barton
The Grange Sportsfield
Track

Island GREEN POWER

Lanpro

Key

🟥	Order Limits
☐	Sheet Index

Public Right of Way (PRoW)

- - -	Footpath

PRoW to be temporarily stopped up

—	Footpath

PRoW to be temporarily stopped up - start and end points

●	Footpath

Layers: Lanpro, 2025; IGP, 2025

0 100 200 300 Meters

Scale: 1:2,500@ A0

APFP Regulation: 5(2)(j)	Application Doc No. CR1/GH2.6_B
Ref: P3535_LPR_ZZ_XX_DR_Z_0275	Date: 05/11/2025
Drawn by: BH	Checked by: JC

Public Rights of Way Plan (Change Application Version)

Sheet 10 of 18

Revision B

GREEN HILL SOLAR FARM

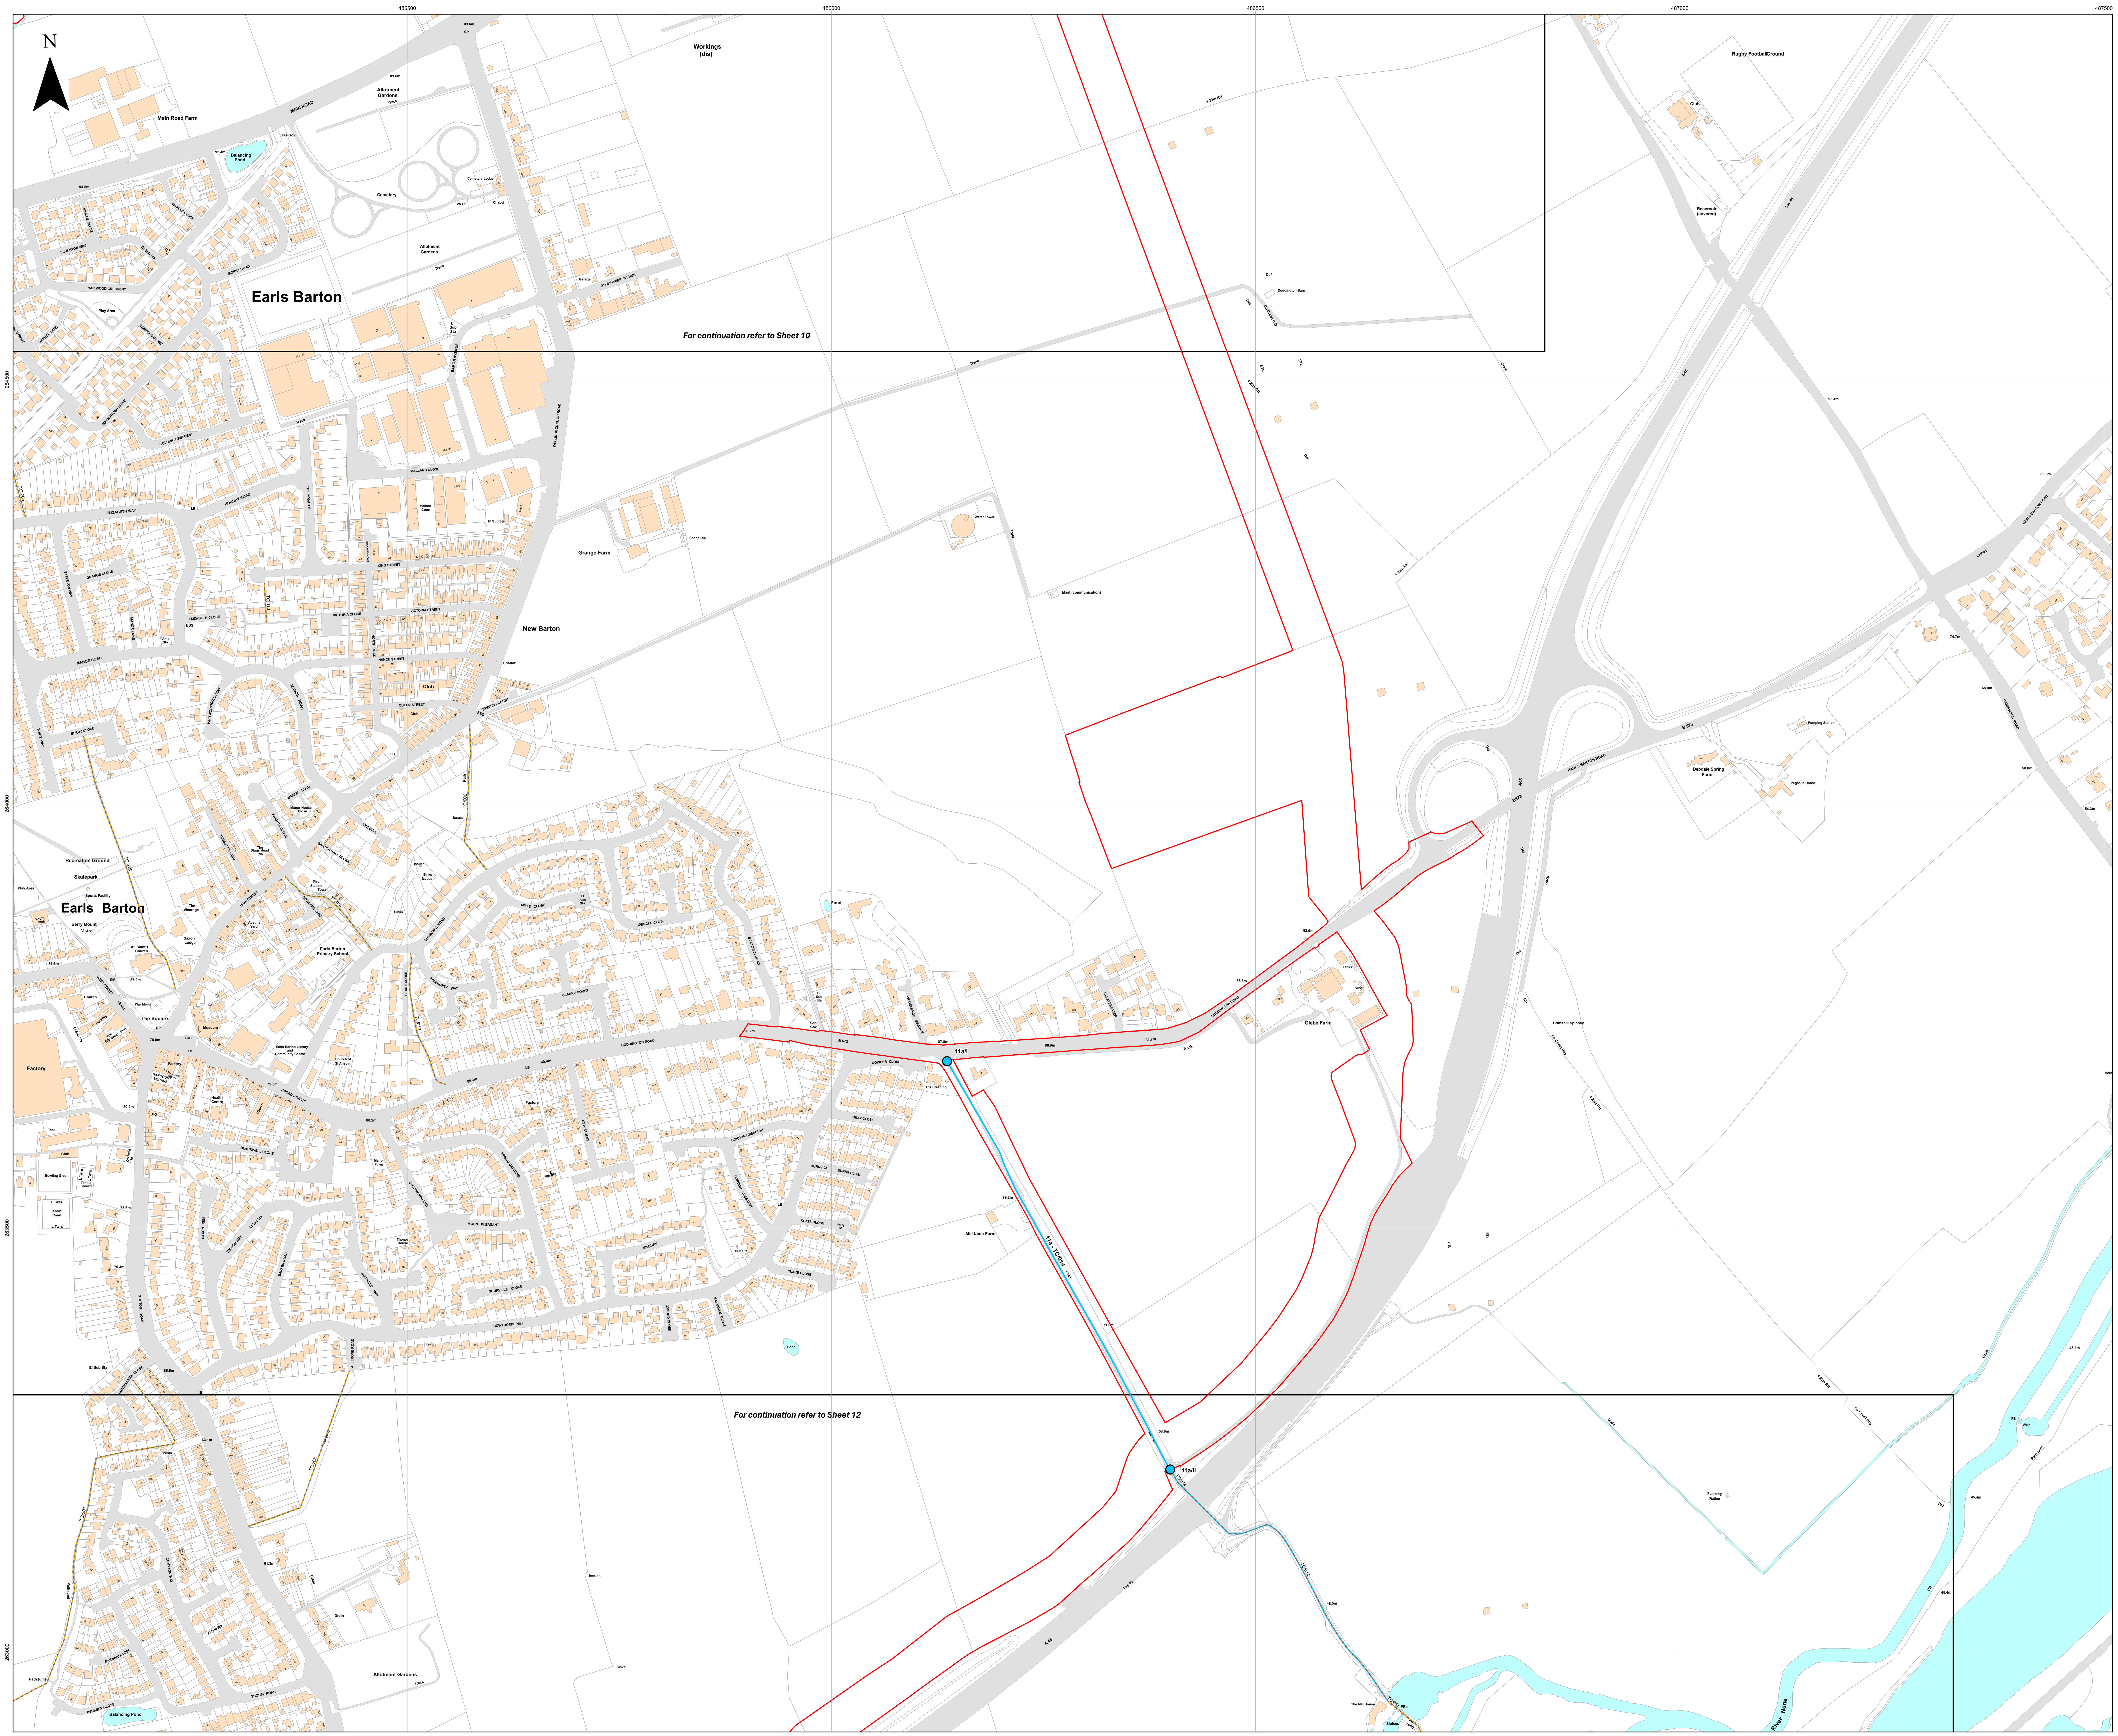
N
485500
486000
486500
487000
487500
264500
264000
263500
263000
Earls Barton
New Barton
Grange Farm
Main Road Farm
Workings (dis)
Rugby Football Ground
Allotment Gardens
Cemetery
Balancing Pond
Recreation Ground
Skatepark
Factory
Glebe Farm
Mill Lane Farm
Debdale Spring Farm
Pumping Station
Pond
Allotment Gardens
River Nene
A45
B573
DODDINGTON ROAD
EARLS BARTON ROAD
MAIN ROAD
For continuation refer to Sheet 10
For continuation refer to Sheet 12
11a/i
11a/ii
TC/014

Key

▭ Order Limits
▭ Sheet Index

Public Right of Way (PRoW)

- - - Byway Open To All Traffic
- - - Footpath

PRoW to be temporarily stopped up

— Byway Open To All Traffic

PRoW to be temporarily stopped up - start and end points

● BOAT

Layers: Lanpro, 2025; IGP, 2025

0 100 200 300 Meters

Scale: 1:2,500@ A0

APFP Regulation: 5(2)(j)	Application Doc No. CR1/GH2.6_B
Ref: P3535_LPR_ZZ_XX_DR_Z_0275	Date: 05/11/2025
Drawn by: BH	Checked by: JC

Public Rights of Way Plan (Change Application Version)

Sheet 11 of 18

Revision B

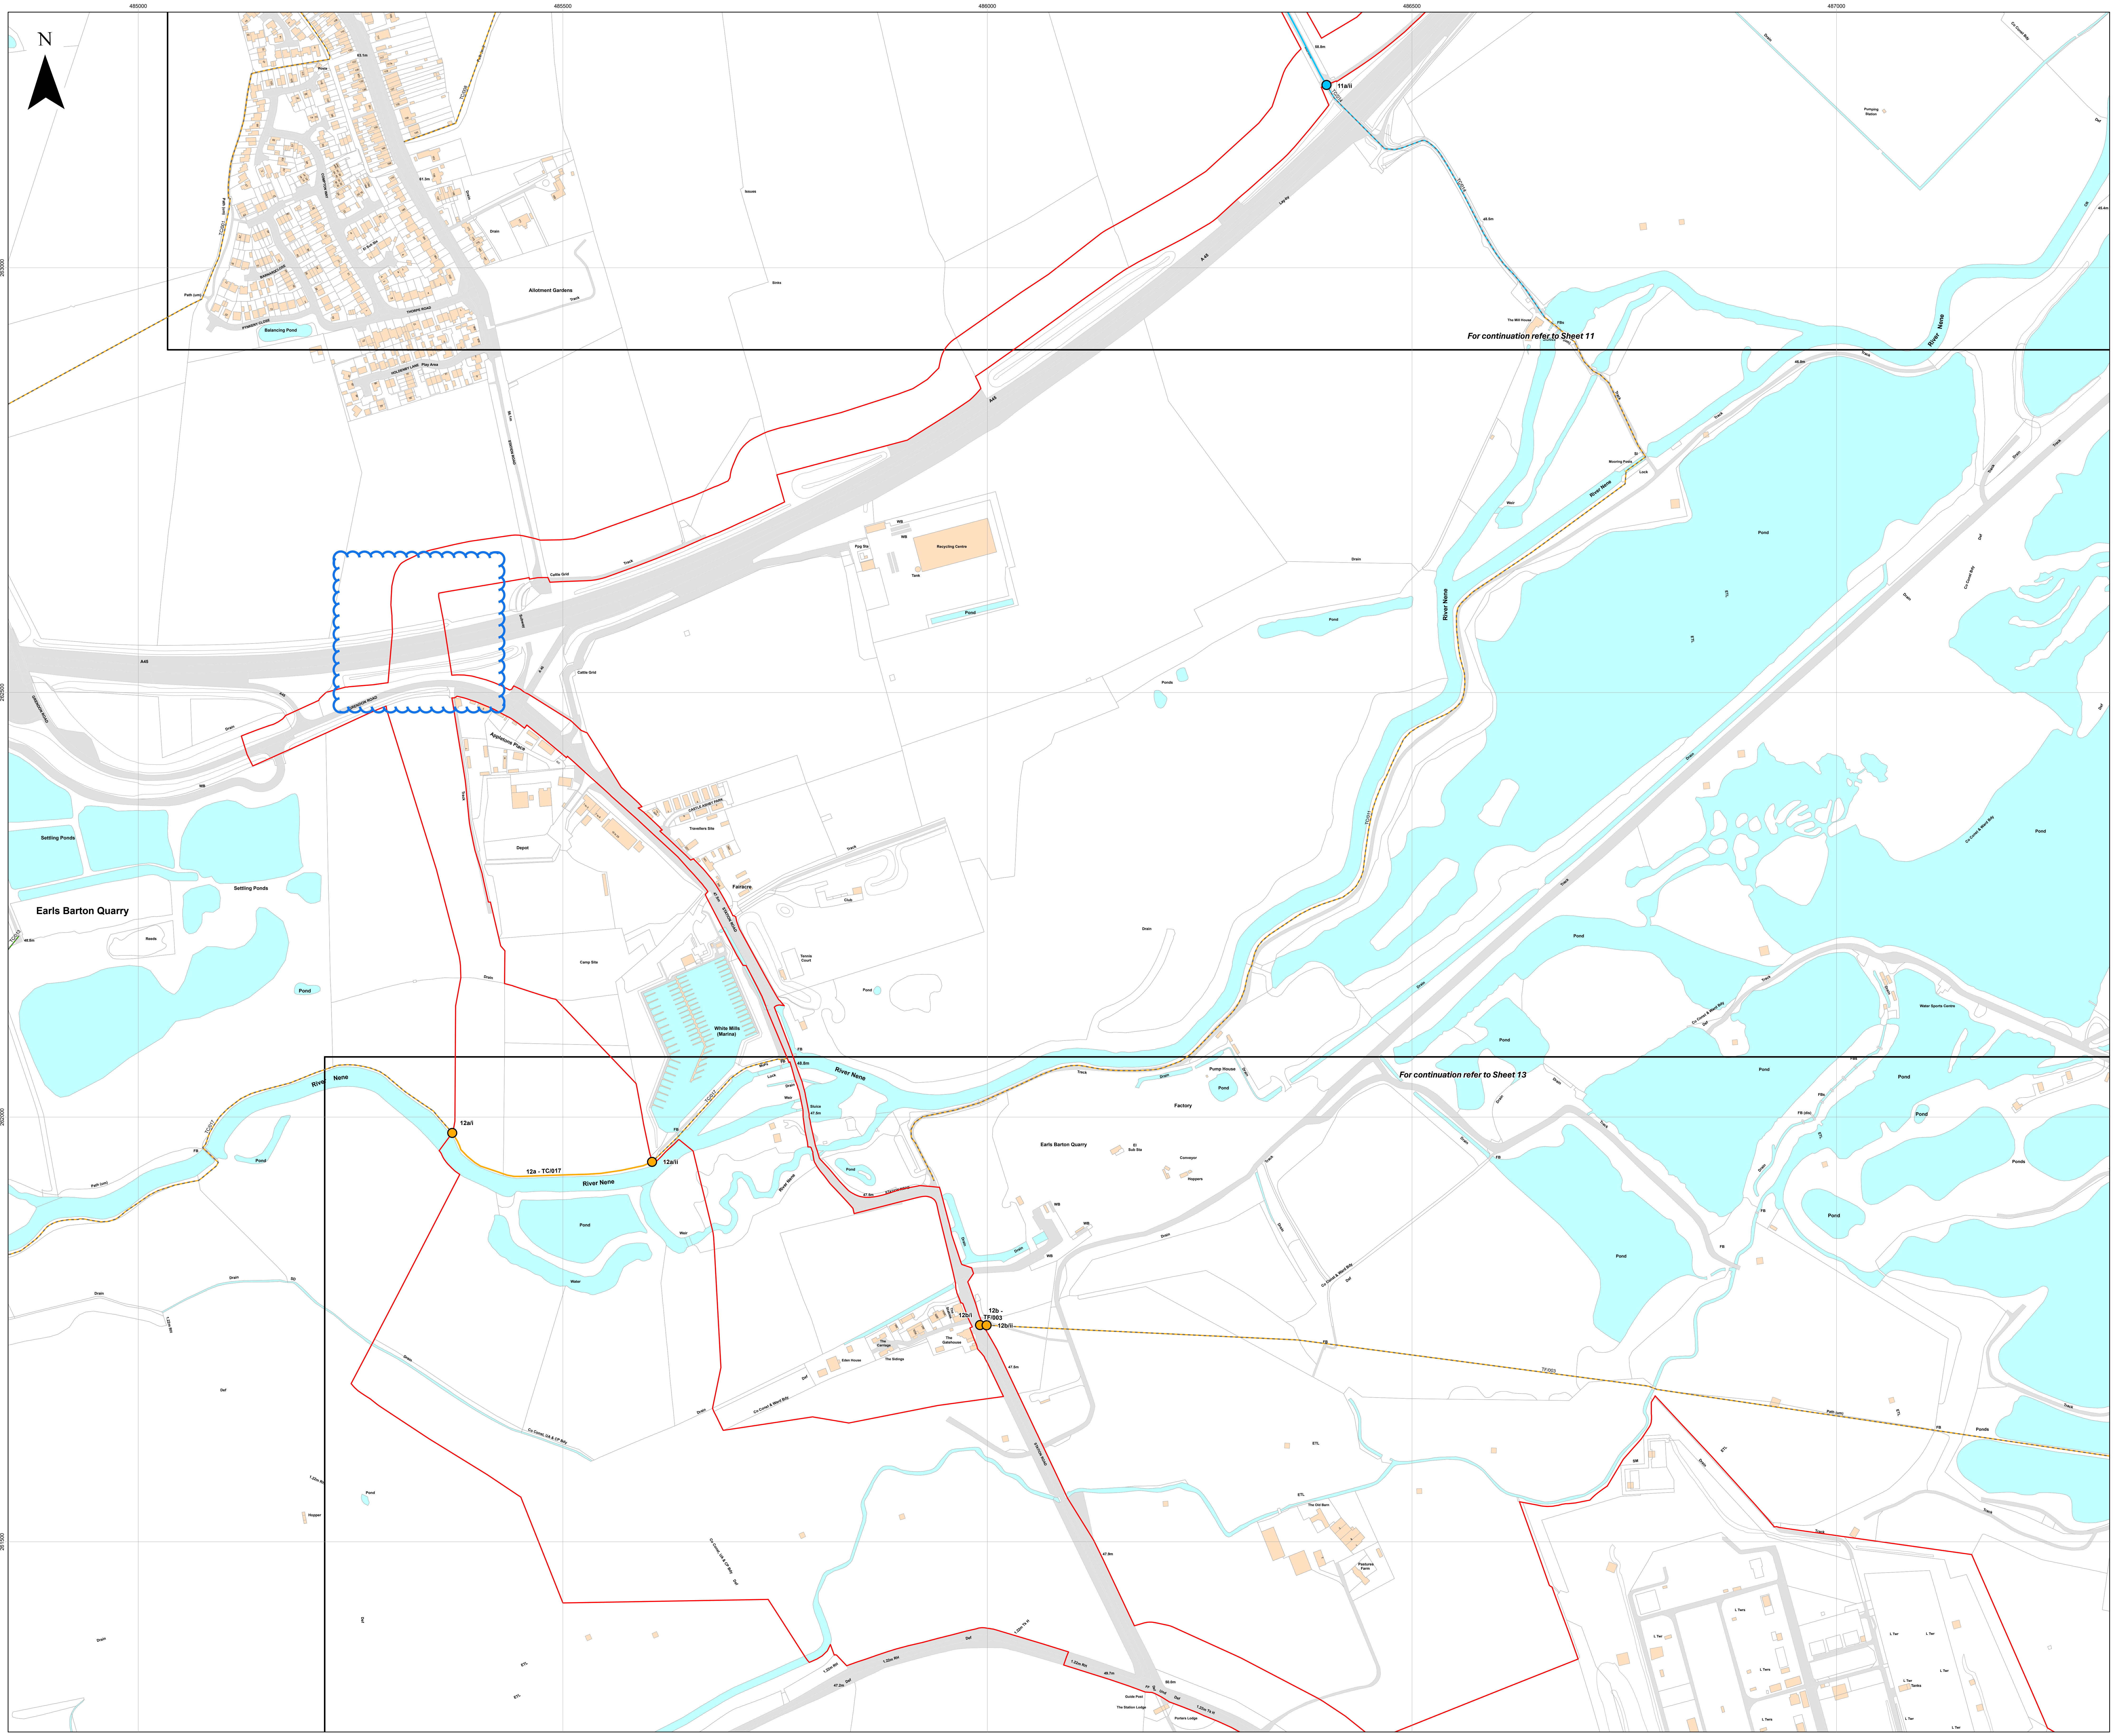
N
485000
485500
486000
486500
487000
11a/ii
For continuation refer to Sheet 11
A45
Earls Barton Quarry
Settling Ponds
Allotment Gardens
Balancing Pond
Recycling Centre
White Mills (Marina)
River Nene
12a/i
12a - TC/017
12a/ii
Earls Barton Quarry
Factory
Pump House
For continuation refer to Sheet 13
Water Sports Centre
12b/i
12b - TF/003
12b/ii
The Stables
The Gatehouse
The Sidings
Pond

Key

▭ Order Limits

▭ Sheet Index

Public Right of Way (PRoW)

- Byway Open To All Traffic
- Bridleway
- Footpath

PRoW to be temporarily stopped up

- Byway Open To All Traffic
- Footpath

PRoW to be temporarily stopped up - start and end points

● BOAT

● Footpath

Layers: Lanpro, 2025; IGP, 2025

Base map: Reproduced from Ordnance Survey digital map data © Crown copyright 2025. All rights reserved. License number 0100031673

0 100 200 300 Meters

Scale: 1:2,500@ A0

APFP Regulation: 5(2)(j)	Application Doc No. CR1/GH2.6_B
Ref: P3535_LPR_ZZ_XX_DR_Z_0275	Date: 05/11/2025
Drawn by: BH	Checked by: JC

Public Rights of Way Plan (Change Application Version)

Sheet 12 of 18

Revision B

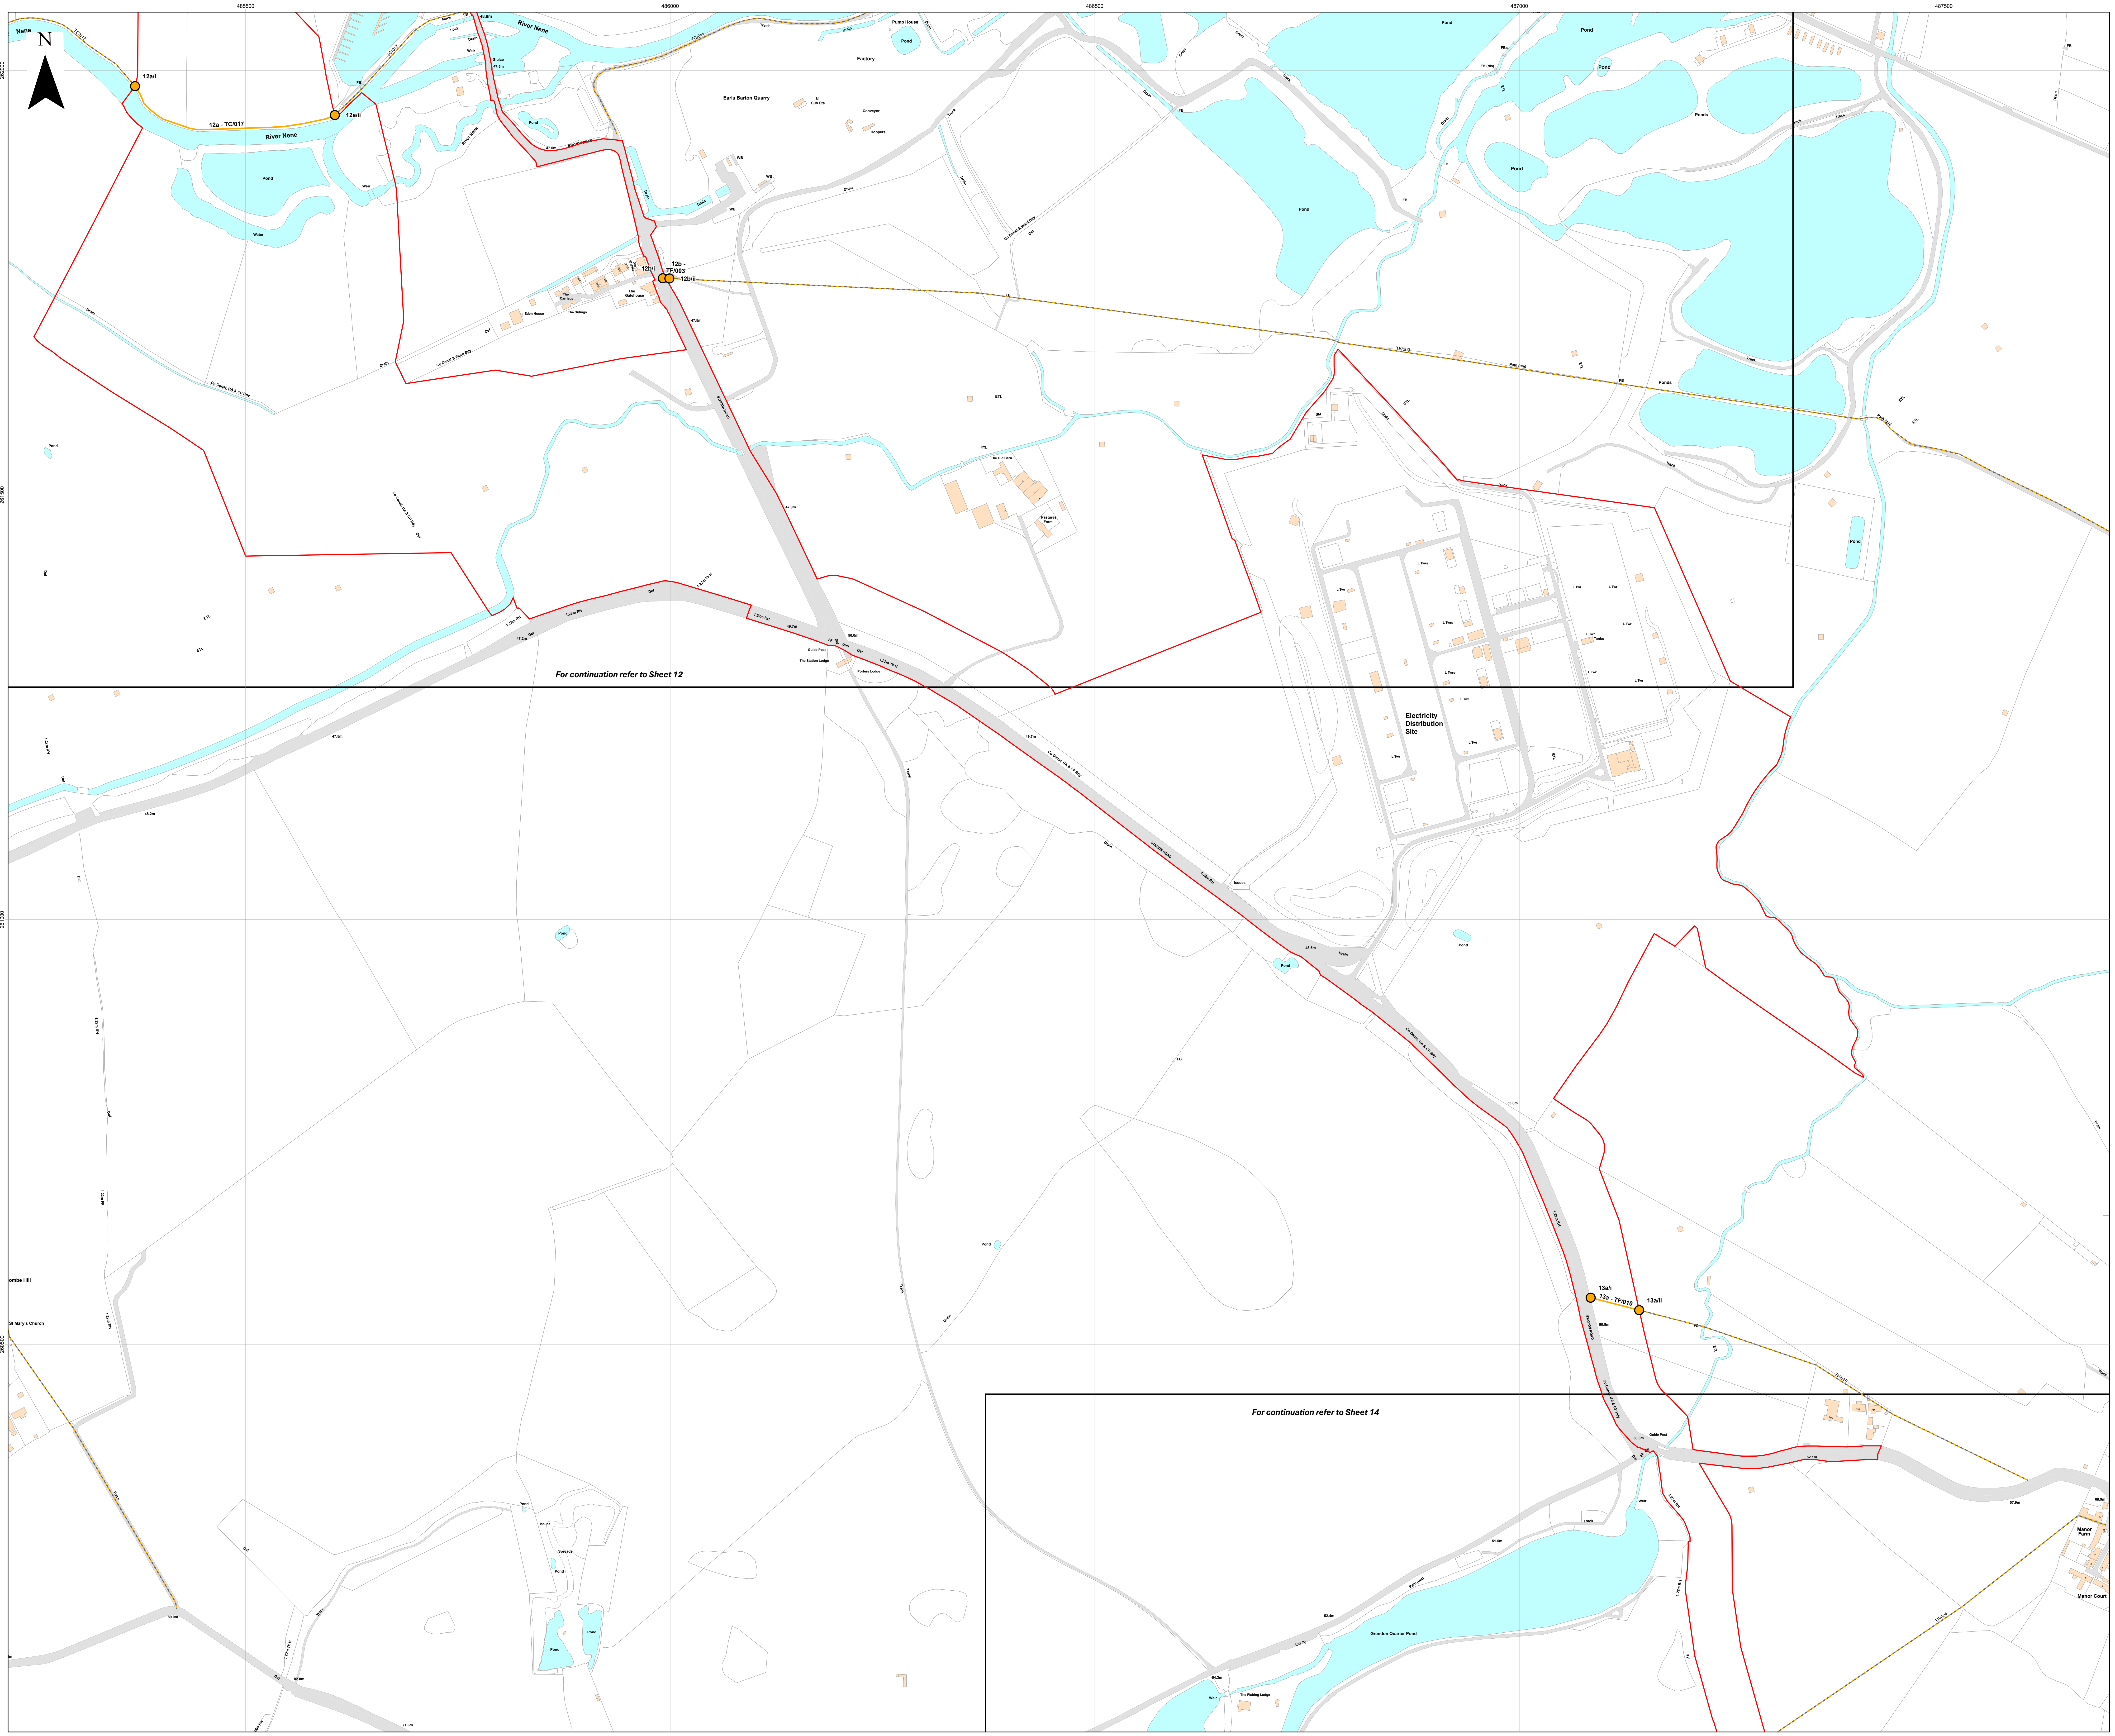
485500
486000
486500
487000
487500
N
12a/i
12a - TC/017
12a/ii
River Nene
Pond
Earls Barton Quarry
Factory
12b/i
12b - TF/003
12b/ii
Electricity Distribution Site
For continuation refer to Sheet 12
13a/i
13a - TF/010
13a/ii
For continuation refer to Sheet 14
Grendon Quarter Pond
Manor Farm
Manor Court
St Mary's Church

Island GREEN POWER

Lanpro

Key

🟥 Order Limits

⬜ Sheet Index

Public Right of Way (PRoW)

- - - Footpath

PRoW to be temporarily stopped up

— Footpath

PRoW to be temporarily stopped up - start and end points

● Footpath

Layers: Lanpro, 2025; IGP, 2025

0 100 200 300 Meters

Scale: 1:2,500@ A0

APFP Regulation: 5(2)(j)	Application Doc No. CR1/GH2.6_B
Ref: P3535_LPR_ZZ_XX_DR_Z_0275	Date: 05/11/2025
Drawn by: BH	Checked by: JC

Public Rights of Way Plan (Change Application Version)

Sheet 13 of 18

Revision B

GREEN HILL SOLAR FARM

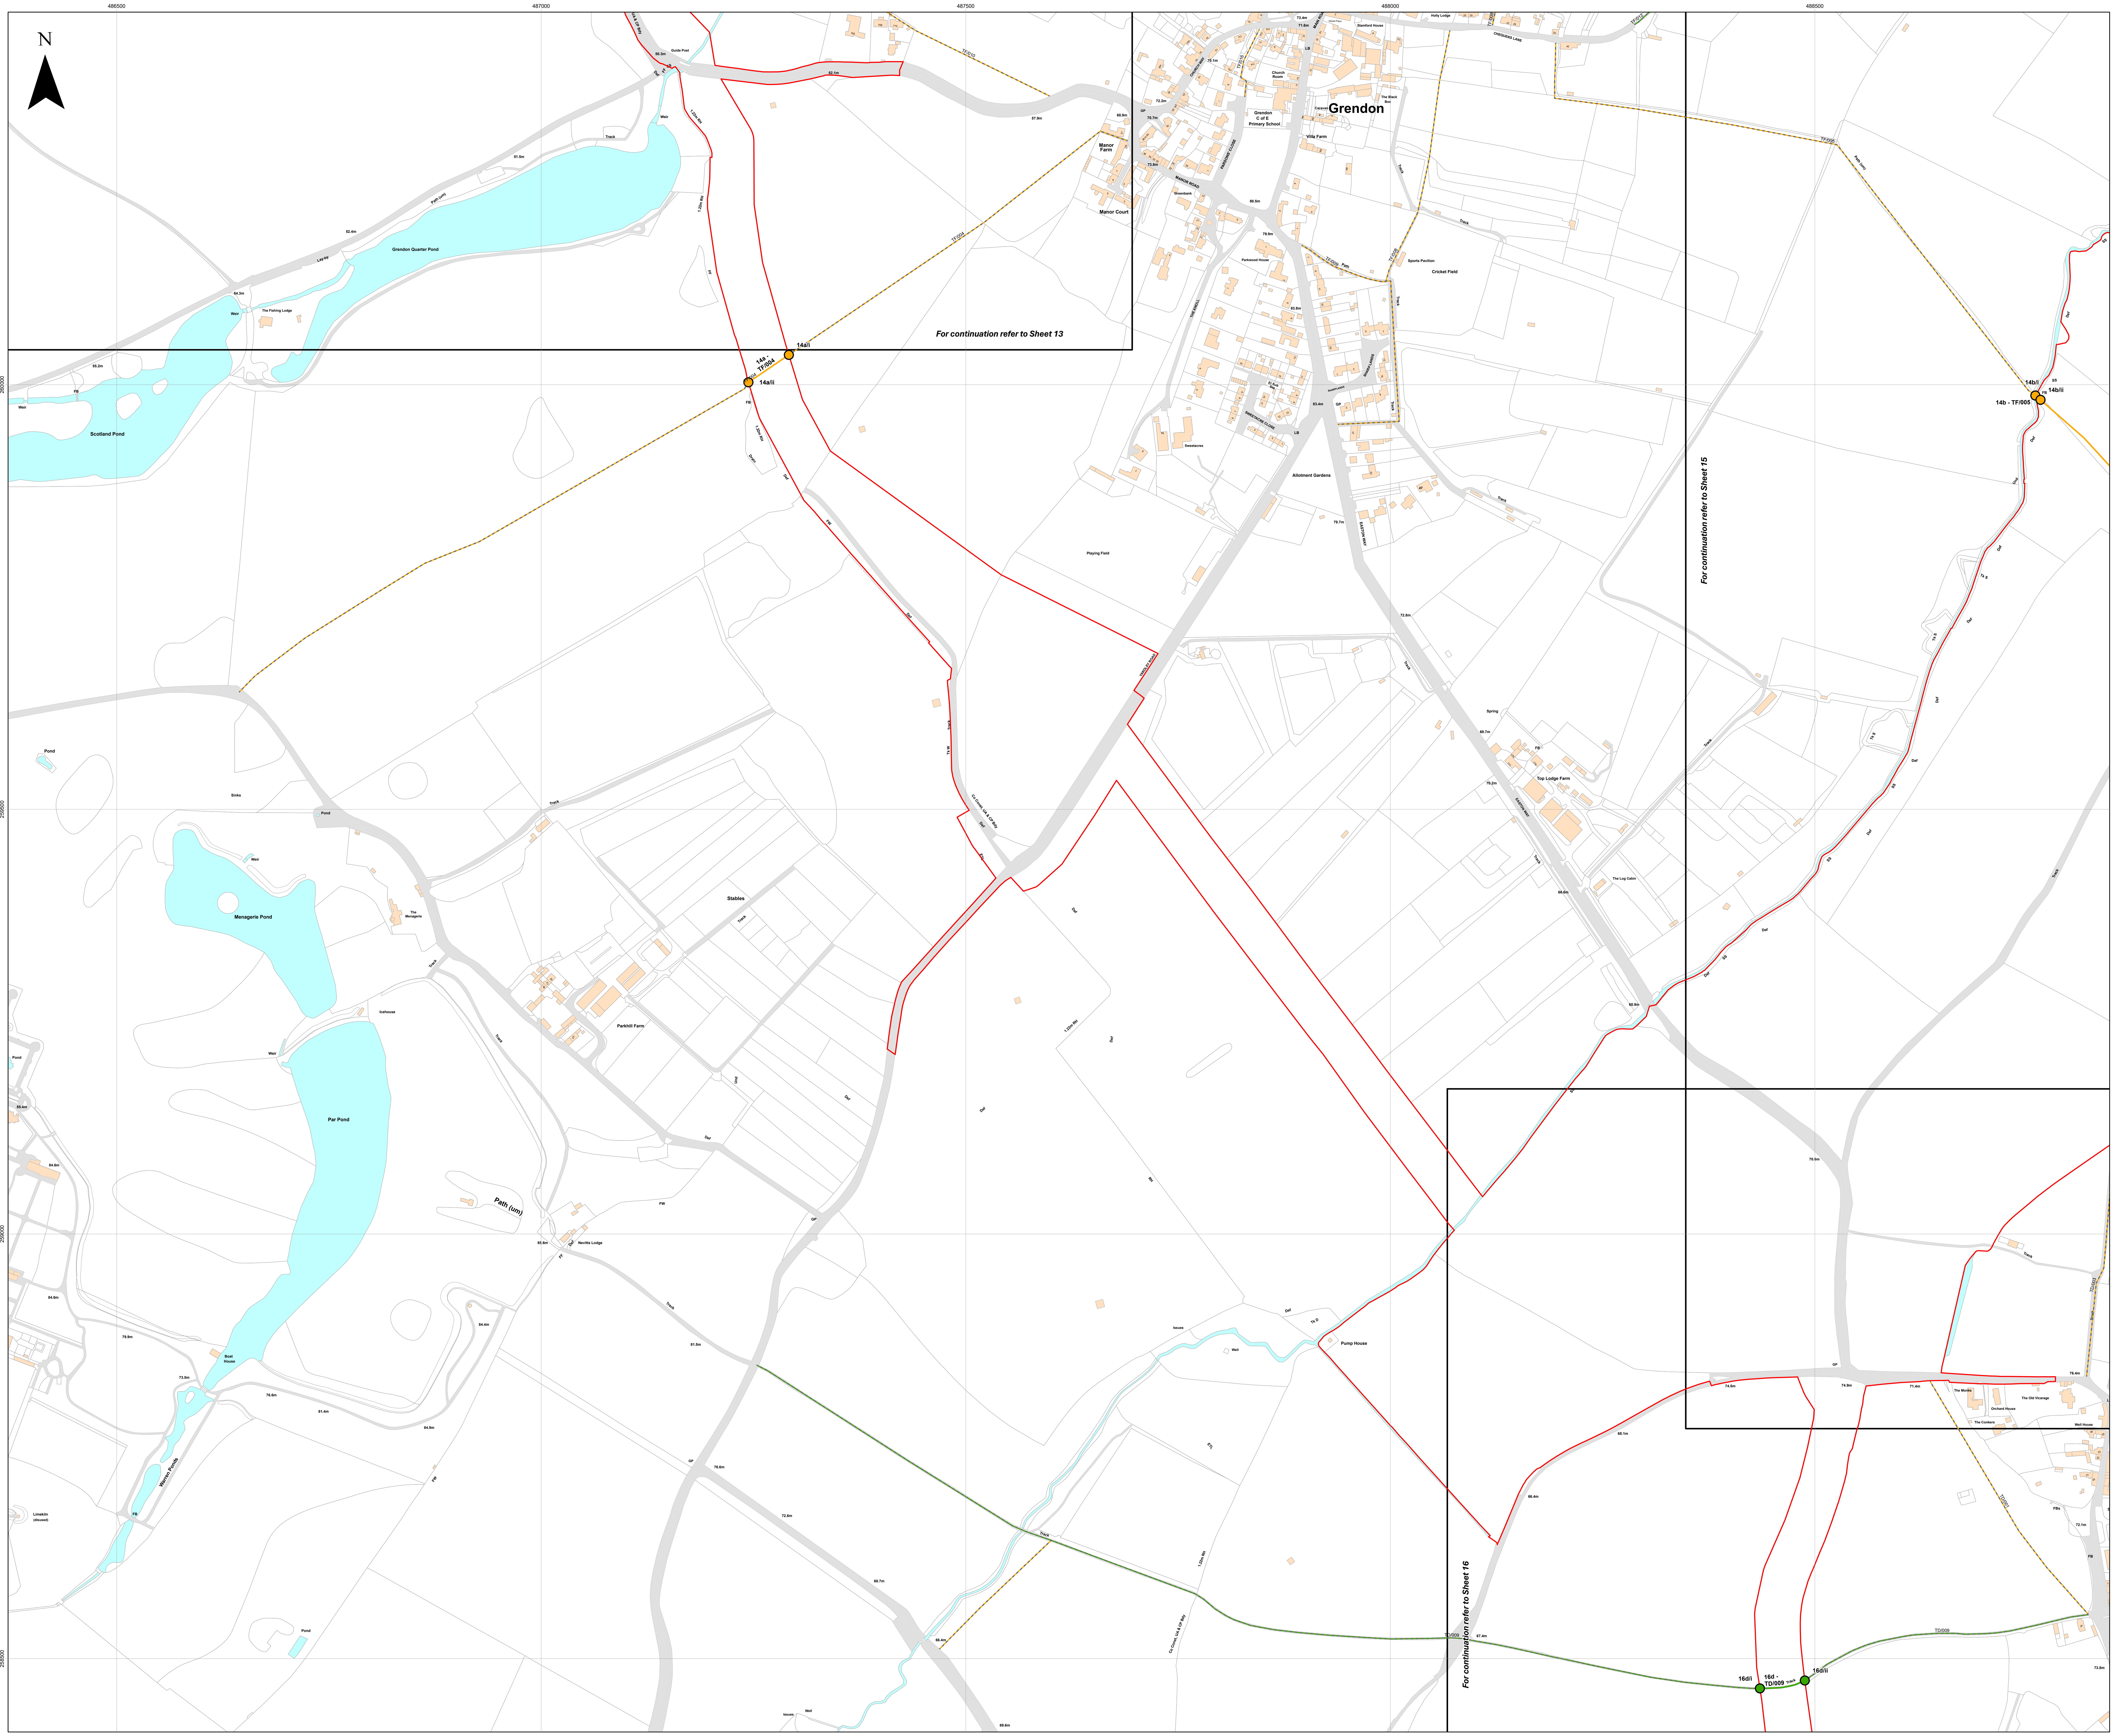
486500
487000
487500
488000
488500
N
Grendon
For continuation refer to Sheet 13
For continuation refer to Sheet 15
For continuation refer to Sheet 16
14a/i
14a - TF/004
14a/ii
TF/004
14b/i
14b/ii
14b - TF/005
16d/i
16d - TD/009
16d/ii
TD/009
TD/003
Grendon Quarter Pond
Scotland Pond
Menagerie Pond
Par Pond
Perkhill Farm
Stables
Top Lodge Farm
Playing Field
Allotment Gardens
Sports Pavilion
Cricket Field
Manor Farm
Manor Court
Grendon C of E Primary School
Villa Farm
Nevilla Lodge
Pump House
Path (um)
Track
Def
Drain
FB
1.22m RH

Key

- ▭ Order Limits
- ▭ Sheet Index

Public Right of Way (PRoW)

- Bridleway
- Footpath

PRoW to be temporarily stopped up

- Bridleway
- Footpath

PRoW to be temporarily stopped up - start and end points

- ● Bridleway
- ● Footpath

Layers: Lanpro, 2025; IGP, 2025
Base map: Reproduced from Ordnance Survey digital map data © Crown copyright 2025. All rights reserved. License number 0100031673

0 100 200 300 Meters

Scale: 1:2,500@ A0

APFP Regulation: 5(2)(j)	Application Doc No. CR1/GH2.6_B
Ref: P3535_LPR_ZZ_XX_DR_Z_0275	Date: 05/11/2025
Drawn by: BH	Checked by: JC

Public Rights of Way Plan (Change Application Version)

Sheet 14 of 18
Revision B

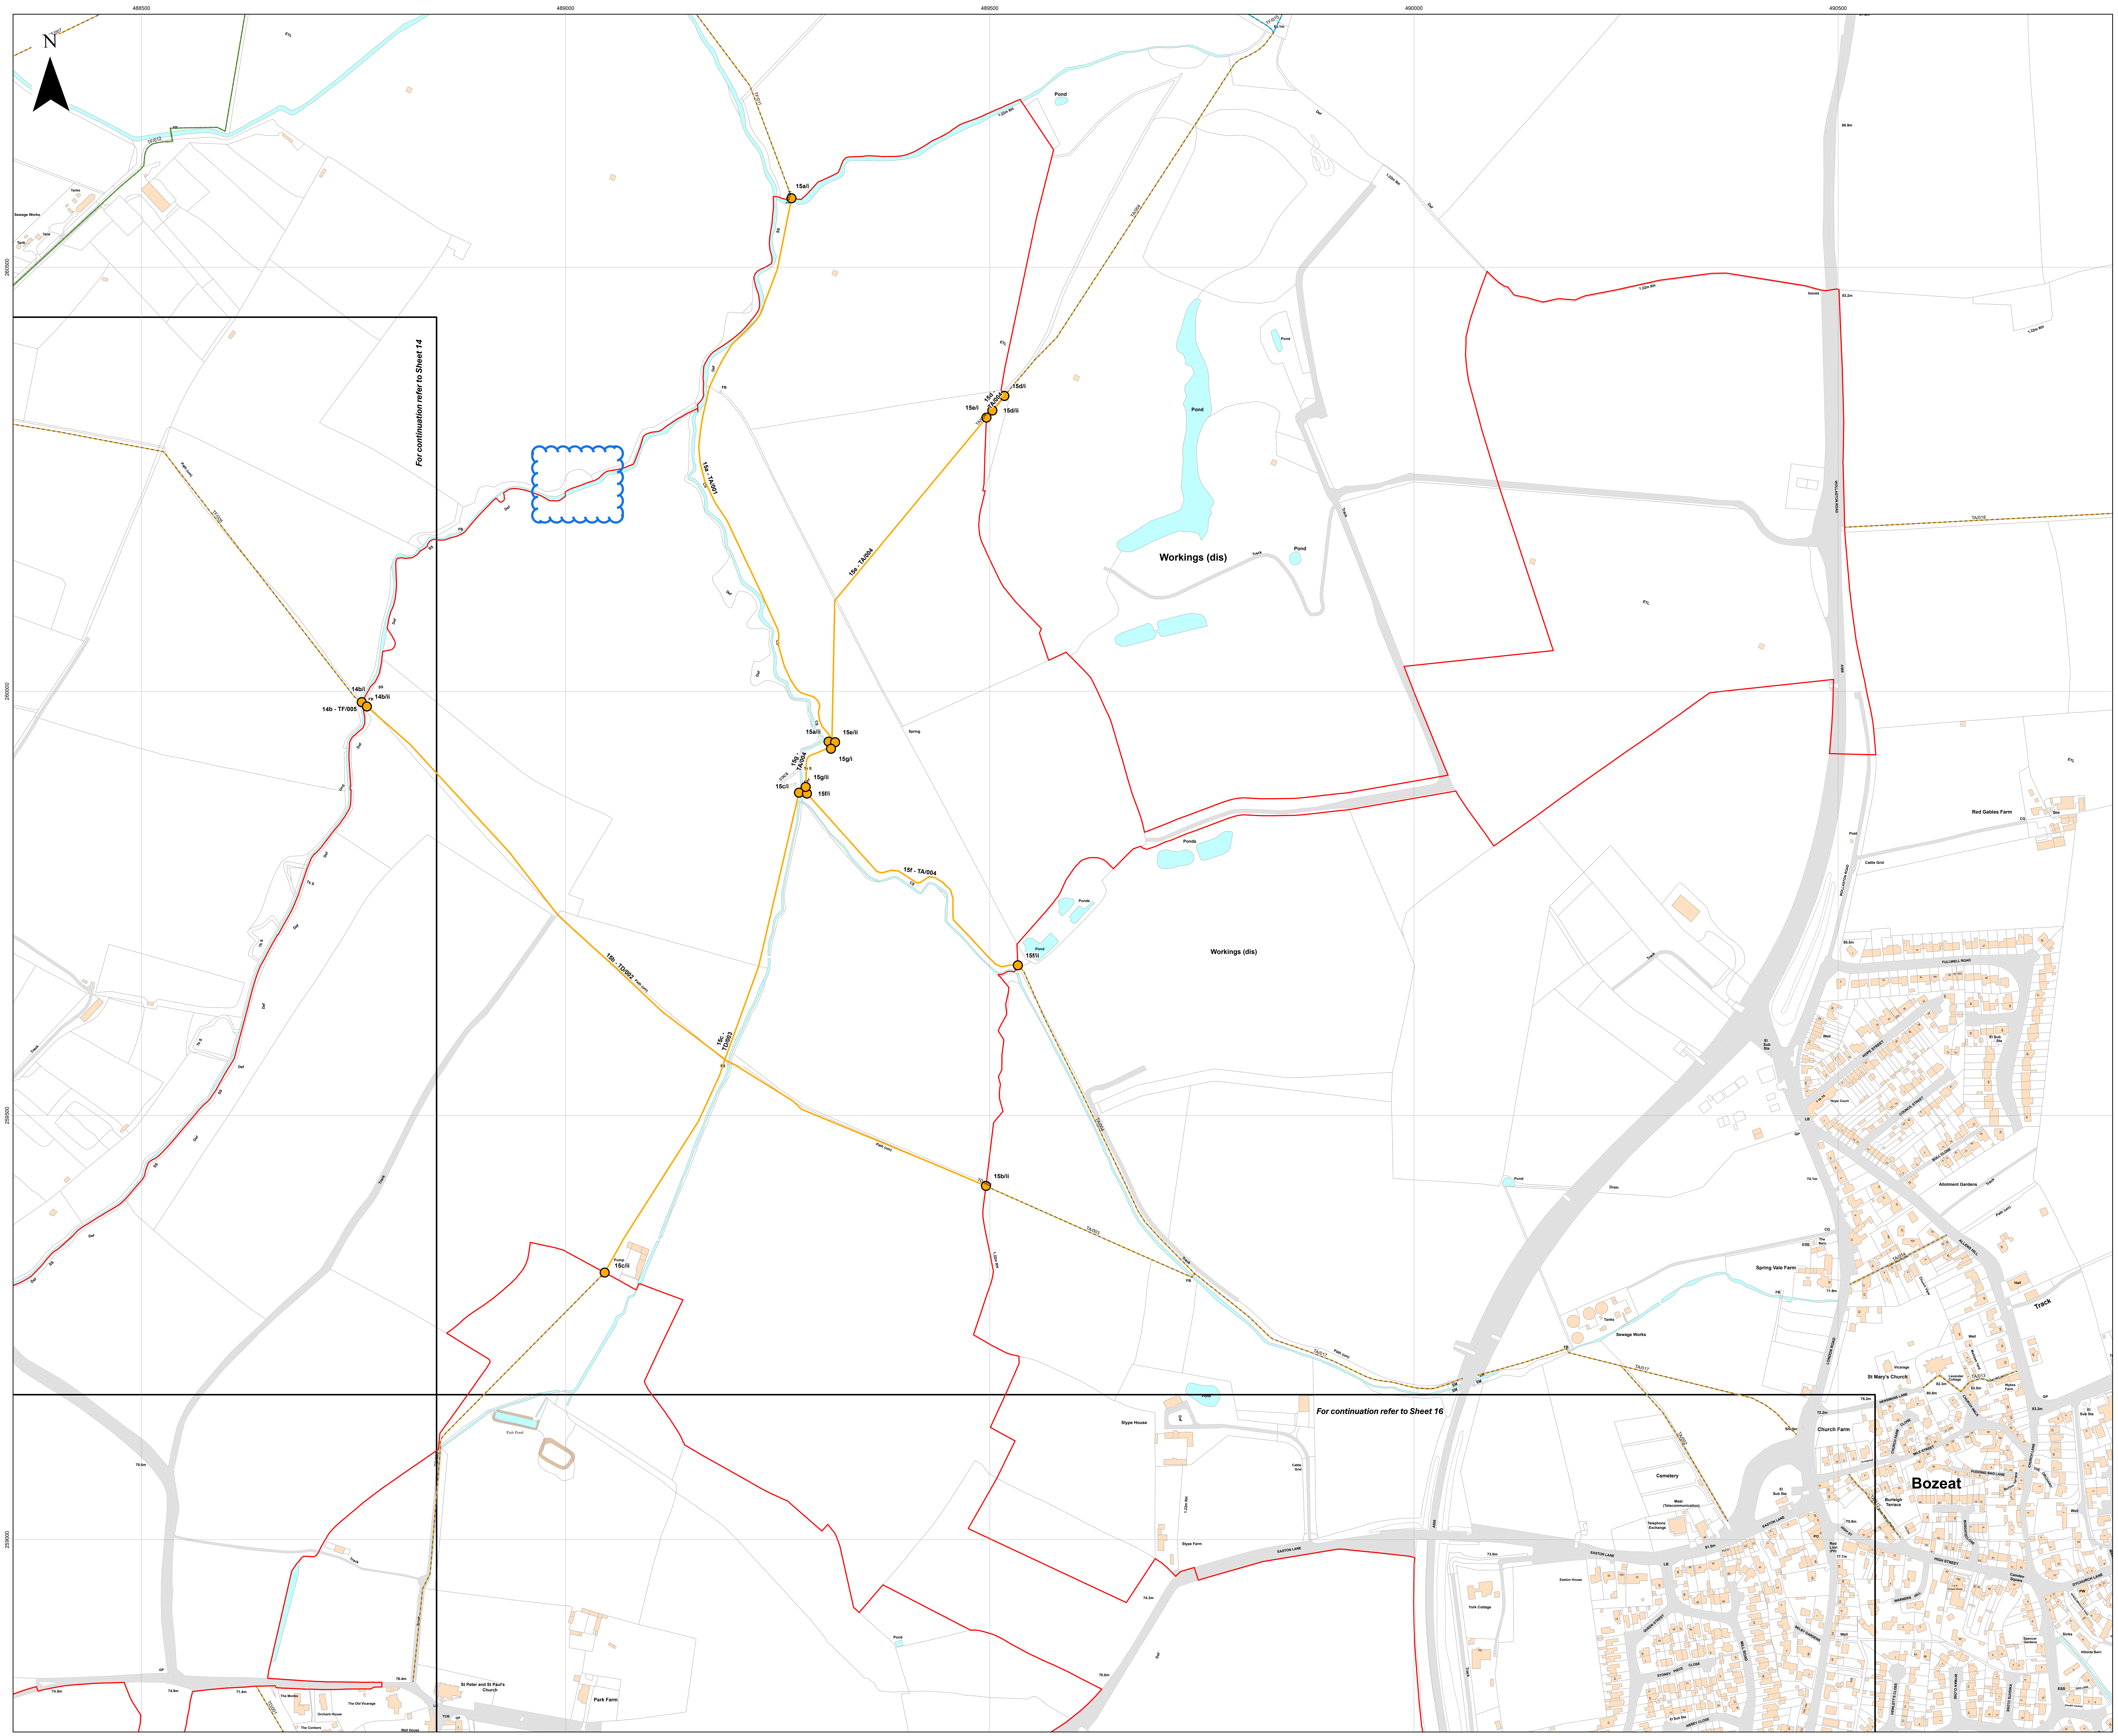
N
488500
489000
489500
490000
490500
15a/i
15a - TA/001
15a/ii
15e - TA/004
15e/i
15e/ii
15d - TA/004
15d/i
15d/ii
15g - TA/004
15g/i
15g/ii
15c/i
15f/i
15f - TA/004
15f/ii
15b - TD/002
15b/ii
15c - TD/003
15c/ii
14b/i
14b/ii
14b - TF/005
TF/011
TA/001
TD/003
Pond
Ponds
Workings (dis)
Spring
Pump
Sewage Works
Red Gables Farm
Spring Vale Farm
Allotment Gardens
St Mary's Church
Church Farm
Cemetery
Park Farm
Styps House
Styps Farm
Easton House
York Cottage
St Peter and St Paul's Church
Bozeat
EASTON LANE
Track
For continuation refer to Sheet 14
For continuation refer to Sheet 16

Island GREEN POWER

Lanpro

Key

- 🟥 Order Limits
- ▭ Sheet Index

Public Right of Way (PRoW)

- Byway Open To All Traffic
- Bridleway
- Footpath

PRoW to be temporarily stopped up

- Footpath

PRoW to be temporarily stopped up - start and end points

- ● Footpath

Layers: Lanpro, 2025; IGP, 2025
Base map: Reproduced from Ordnance Survey digital map data © Crown copyright 2025. All rights reserved. License number 0100031673

0 100 200 300 Meters

Scale: 1:2,500@ A0

APFP Regulation: 5(2)(j)	Application Doc No. CR1/GH2.6_B
Ref: P3535_LPR_ZZ_XX_DR_Z_0275	Date: 05/11/2025
Drawn by: BH	Checked by: JC

Public Rights of Way Plan (Change Application Version)

Sheet 15 of 18
Revision B

GREEN HILL
SOLAR FARM

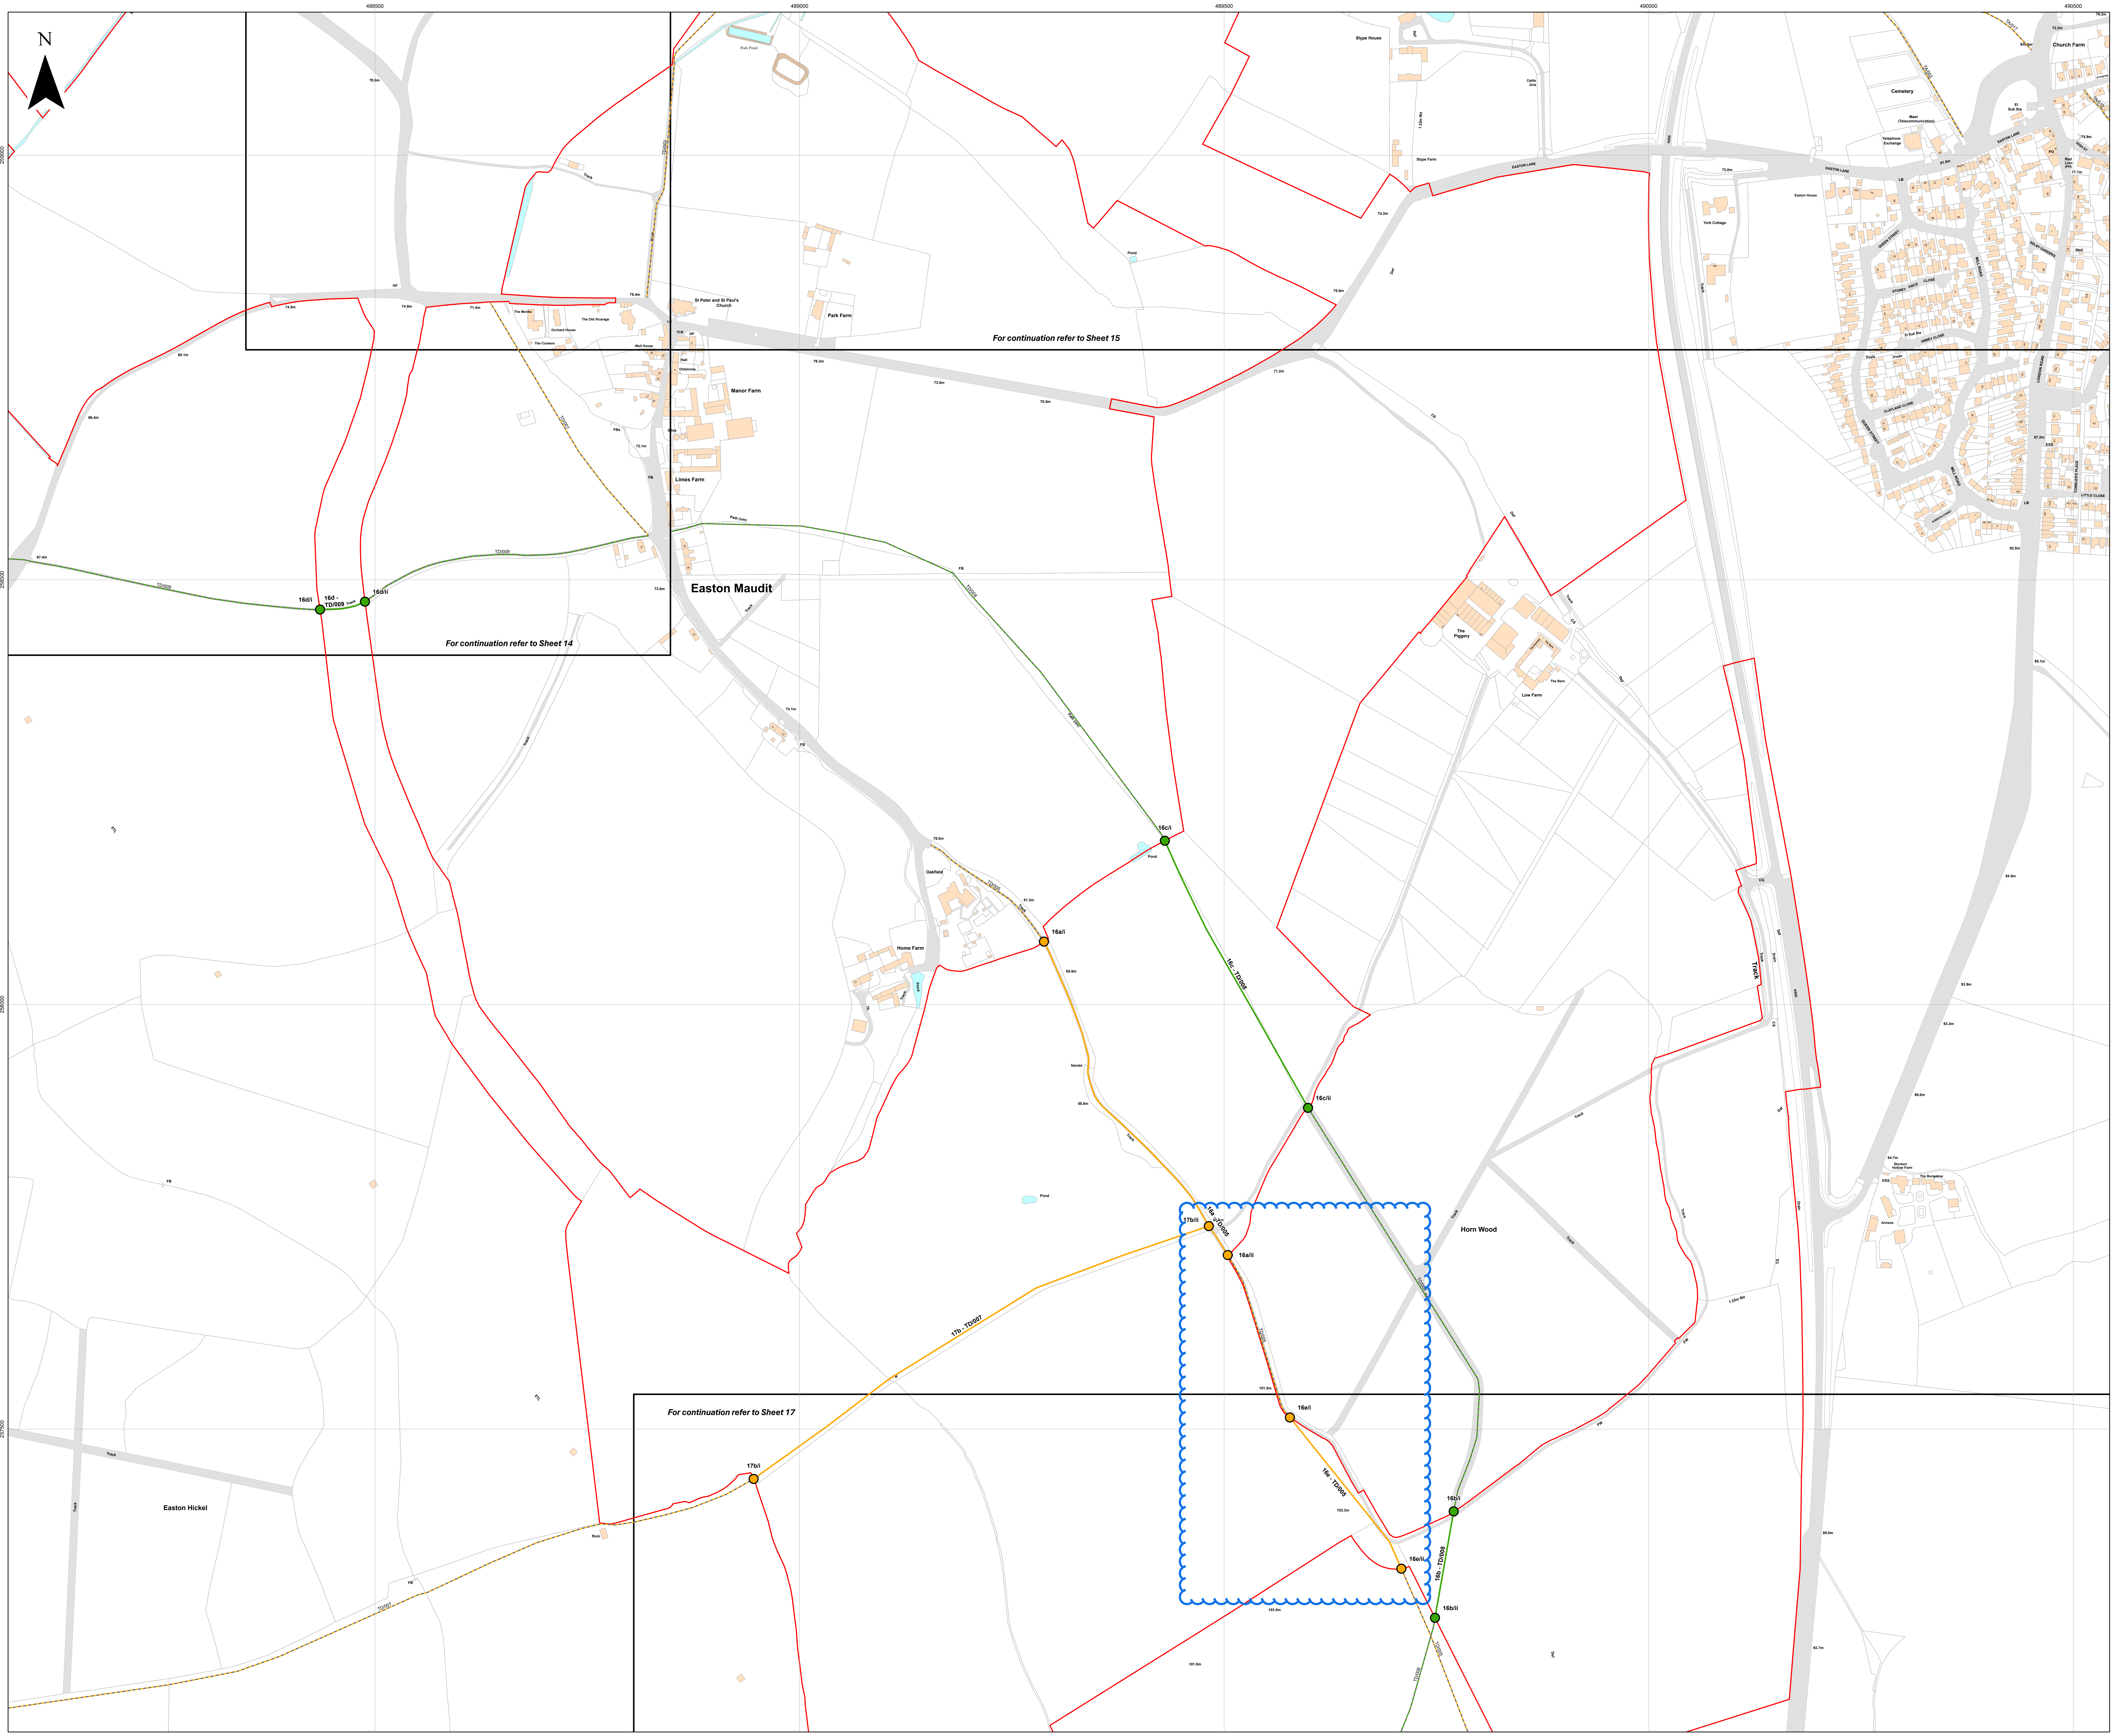
N
488500
489000
489500
490000
490500
For continuation refer to Sheet 15
For continuation refer to Sheet 14
For continuation refer to Sheet 17
Easton Maudit
Manor Farm
Limes Farm
Park Farm
St Peter and St Paul's Church
Oakfield
Home Farm
Horn Wood
Easton Hickel
The Piggery
Low Farm
The Barn
Stype House
Stype Farm
Easton Lane
York Cottage
Easton House
Cemetery
Church Farm
16d/i
16d - TD/009
16d/ii
16c/i
16c - TD/008
16c/ii
16a/i
16a - TD/008
16a/ii
17b/ii
17b - TD/007
17b/i
16e/i
16e - TD/008
16e/ii
16b/i
16b - TD/008
16b/ii

Key

- ▭ Order Limits
- ▭ Sheet Index

Public Right of Way (PRoW)

- Bridleway
- Footpath

PRoW to be temporarily stopped up

- Bridleway
- Footpath

PRoW to be temporarily stopped up - start and end points

- ● Bridleway
- ● Footpath

Layers: Lanpro, 2025; IGP, 2025

0 100 200 300 Meters

Scale: 1:2,500@ A0

APFP Regulation: 5(2)(j)	Application Doc No. CR1/GH2.6_B
Ref: P3535_LPR_ZZ_XX_DR_Z_0275	Date: 05/11/2025
Drawn by: BH	Checked by: JC

Public Rights of Way Plan
(Change Application Version)

Sheet 16 of 18

Revision B

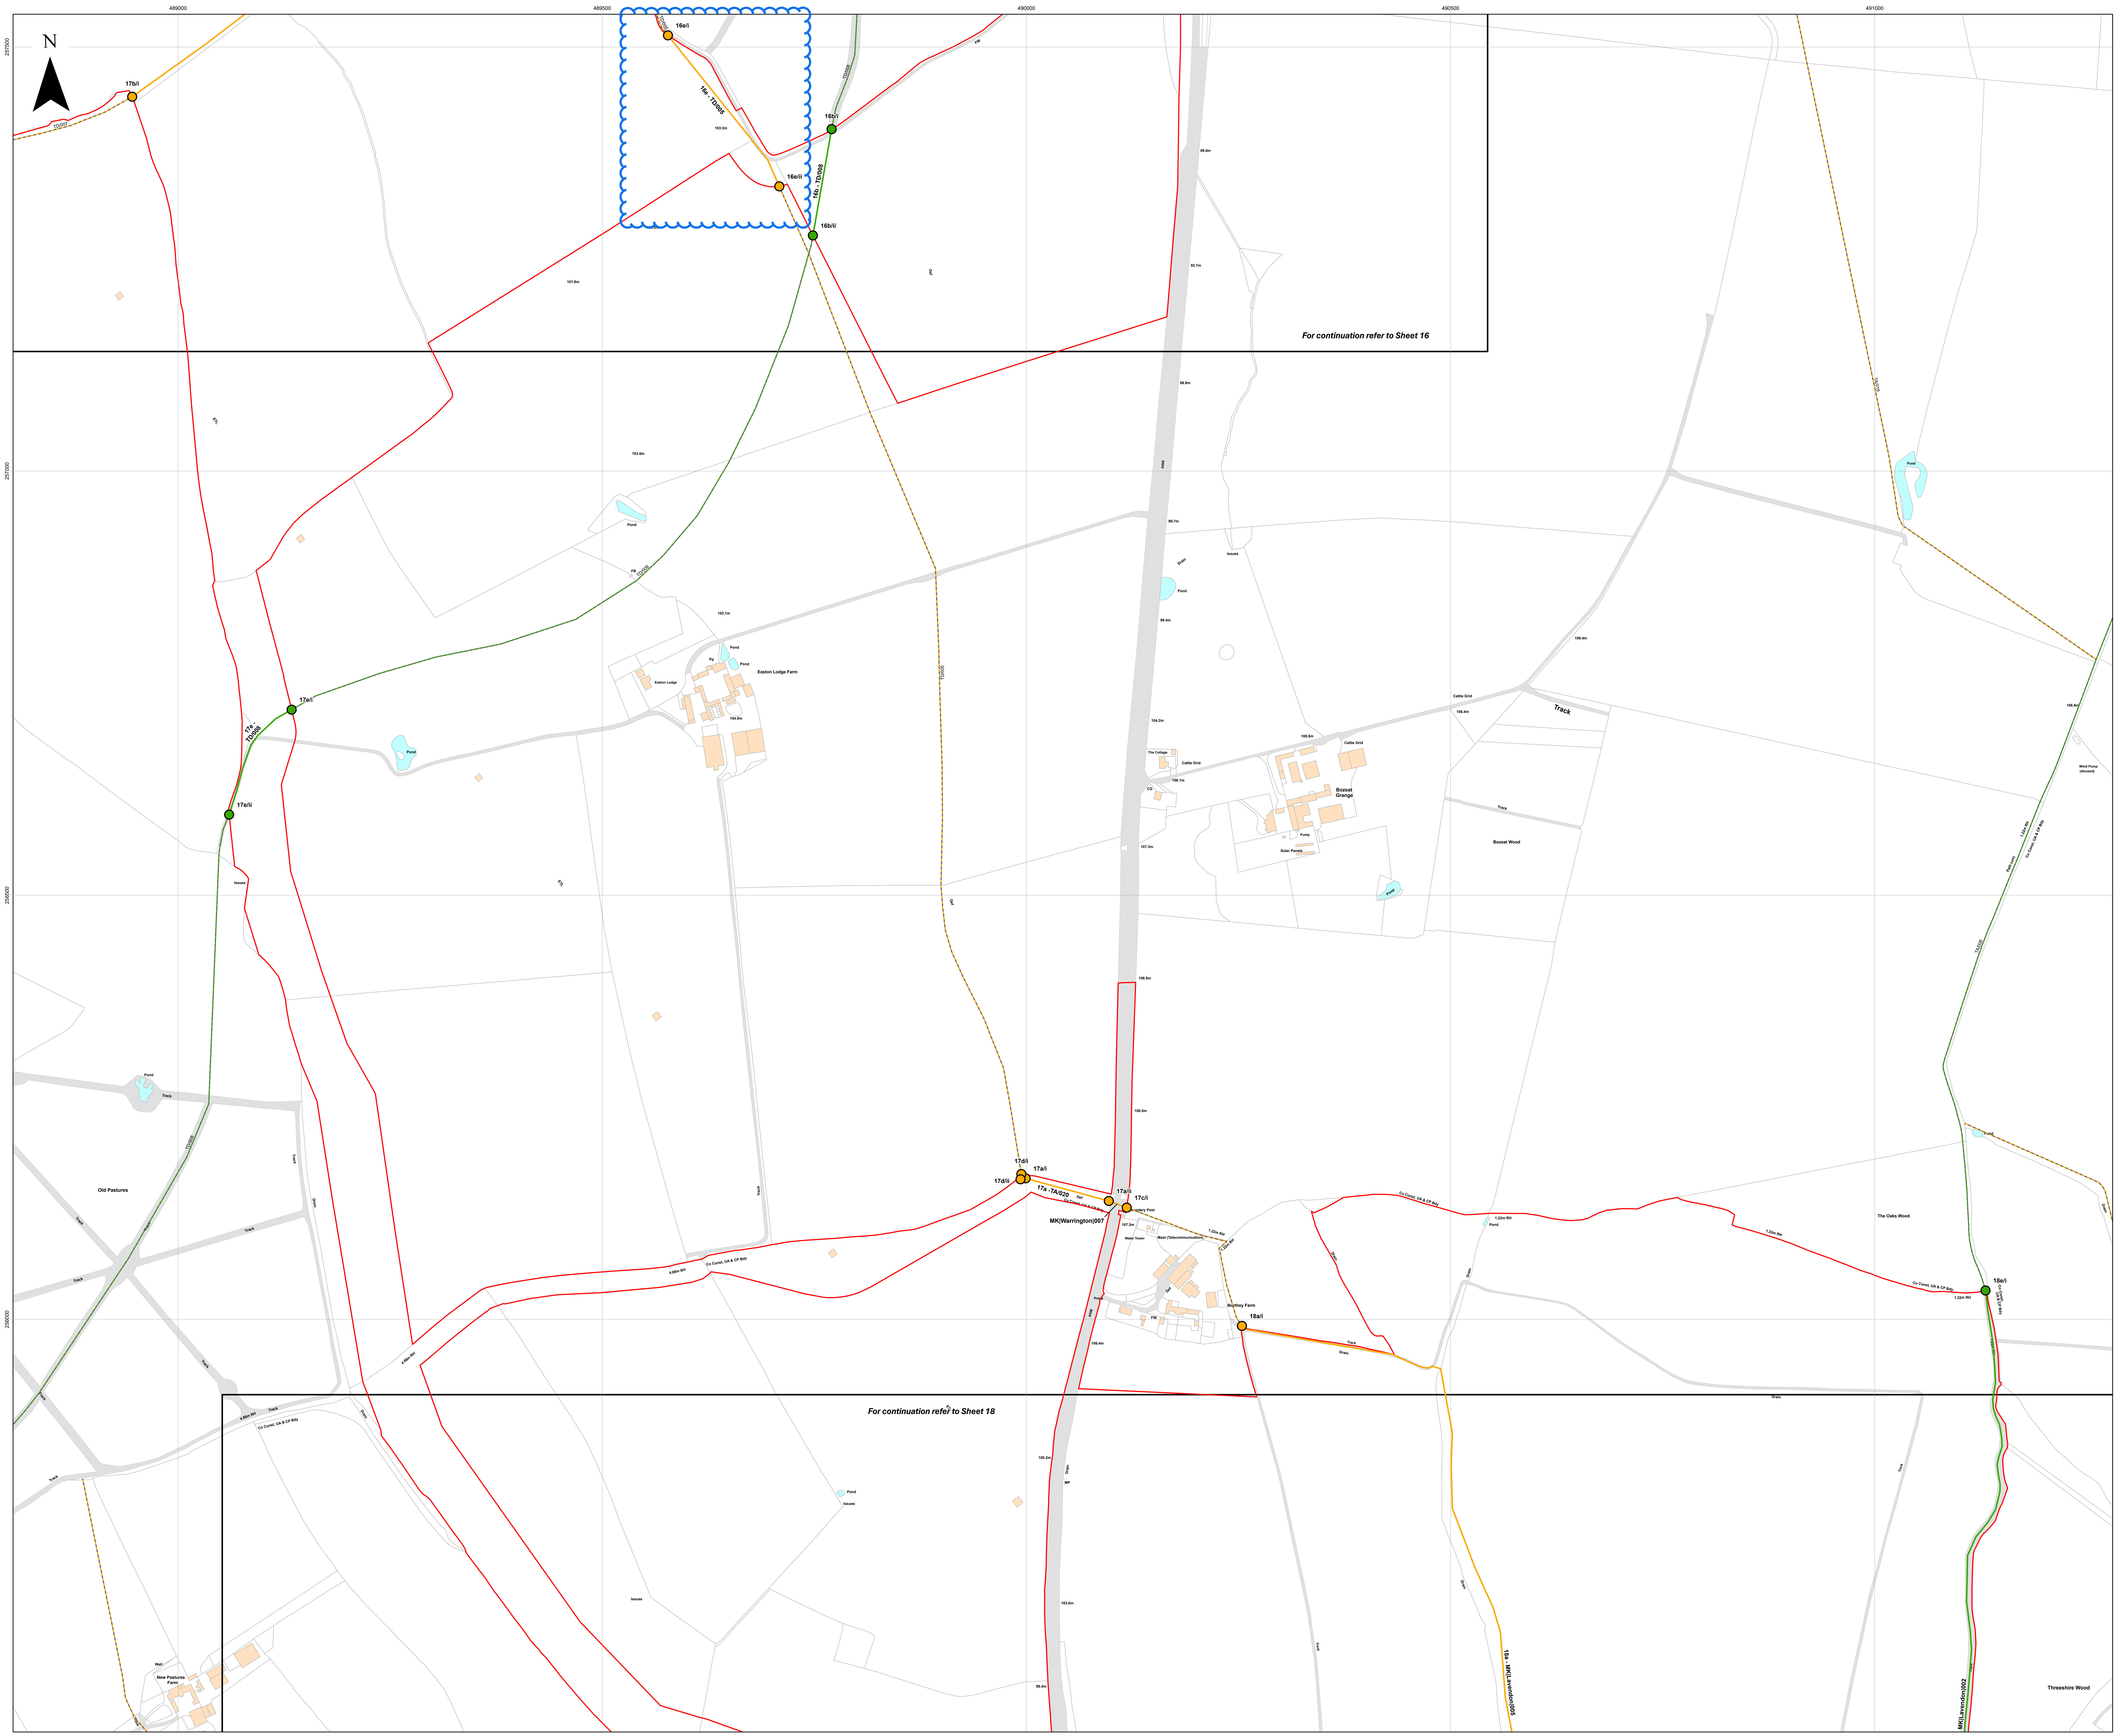
N
489000
489500
490000
490500
491000
17b/i
16e/i
16e - TD/005
16e/ii
16b/i
16b - TD/008
16b/ii
For continuation refer to Sheet 16
17e/i
17e - TD/008
17e/ii
Easton Lodge Farm
Old Pastures
New Pastures Farm
17d/i
17a/i
17d/ii
17a -TA/020
17a/ii
17c/i
MK|Warrington|007
Northey Farm
18a/i
18e/i
The Oaks Wood
Co Const, UA & CP Bdy
For continuation refer to Sheet 18
18a - MK|Lavendon|005
MK|Lavendon|002
Threeshire Wood

Island GREEN POWER

Lanpro

Key

- 🟥 Order Limits
- ▭ Sheet Index

Public Right of Way (PRoW)

- Bridleway
- Footpath

PRoW to be temporarily stopped up

- Bridleway
- Footpath

PRoW to be temporarily stopped up - start and end points

- ● Bridleway
- ● Footpath

Layers: Lanpro, 2025; IGP, 2025

0 100 200 300 Meters

Scale: 1:2,500@ A0

APFP Regulation: 5(2)(j)	Application Doc No. CR1/GH2.6_B
Ref: P3535_LPR_ZZ_XX_DR_Z_0275	Date: 05/11/2025
Drawn by: BH	Checked by: JC

Public Rights of Way Plan (Change Application Version)

Sheet 17 of 18

Revision B

GREEN HILL SOLAR FARM

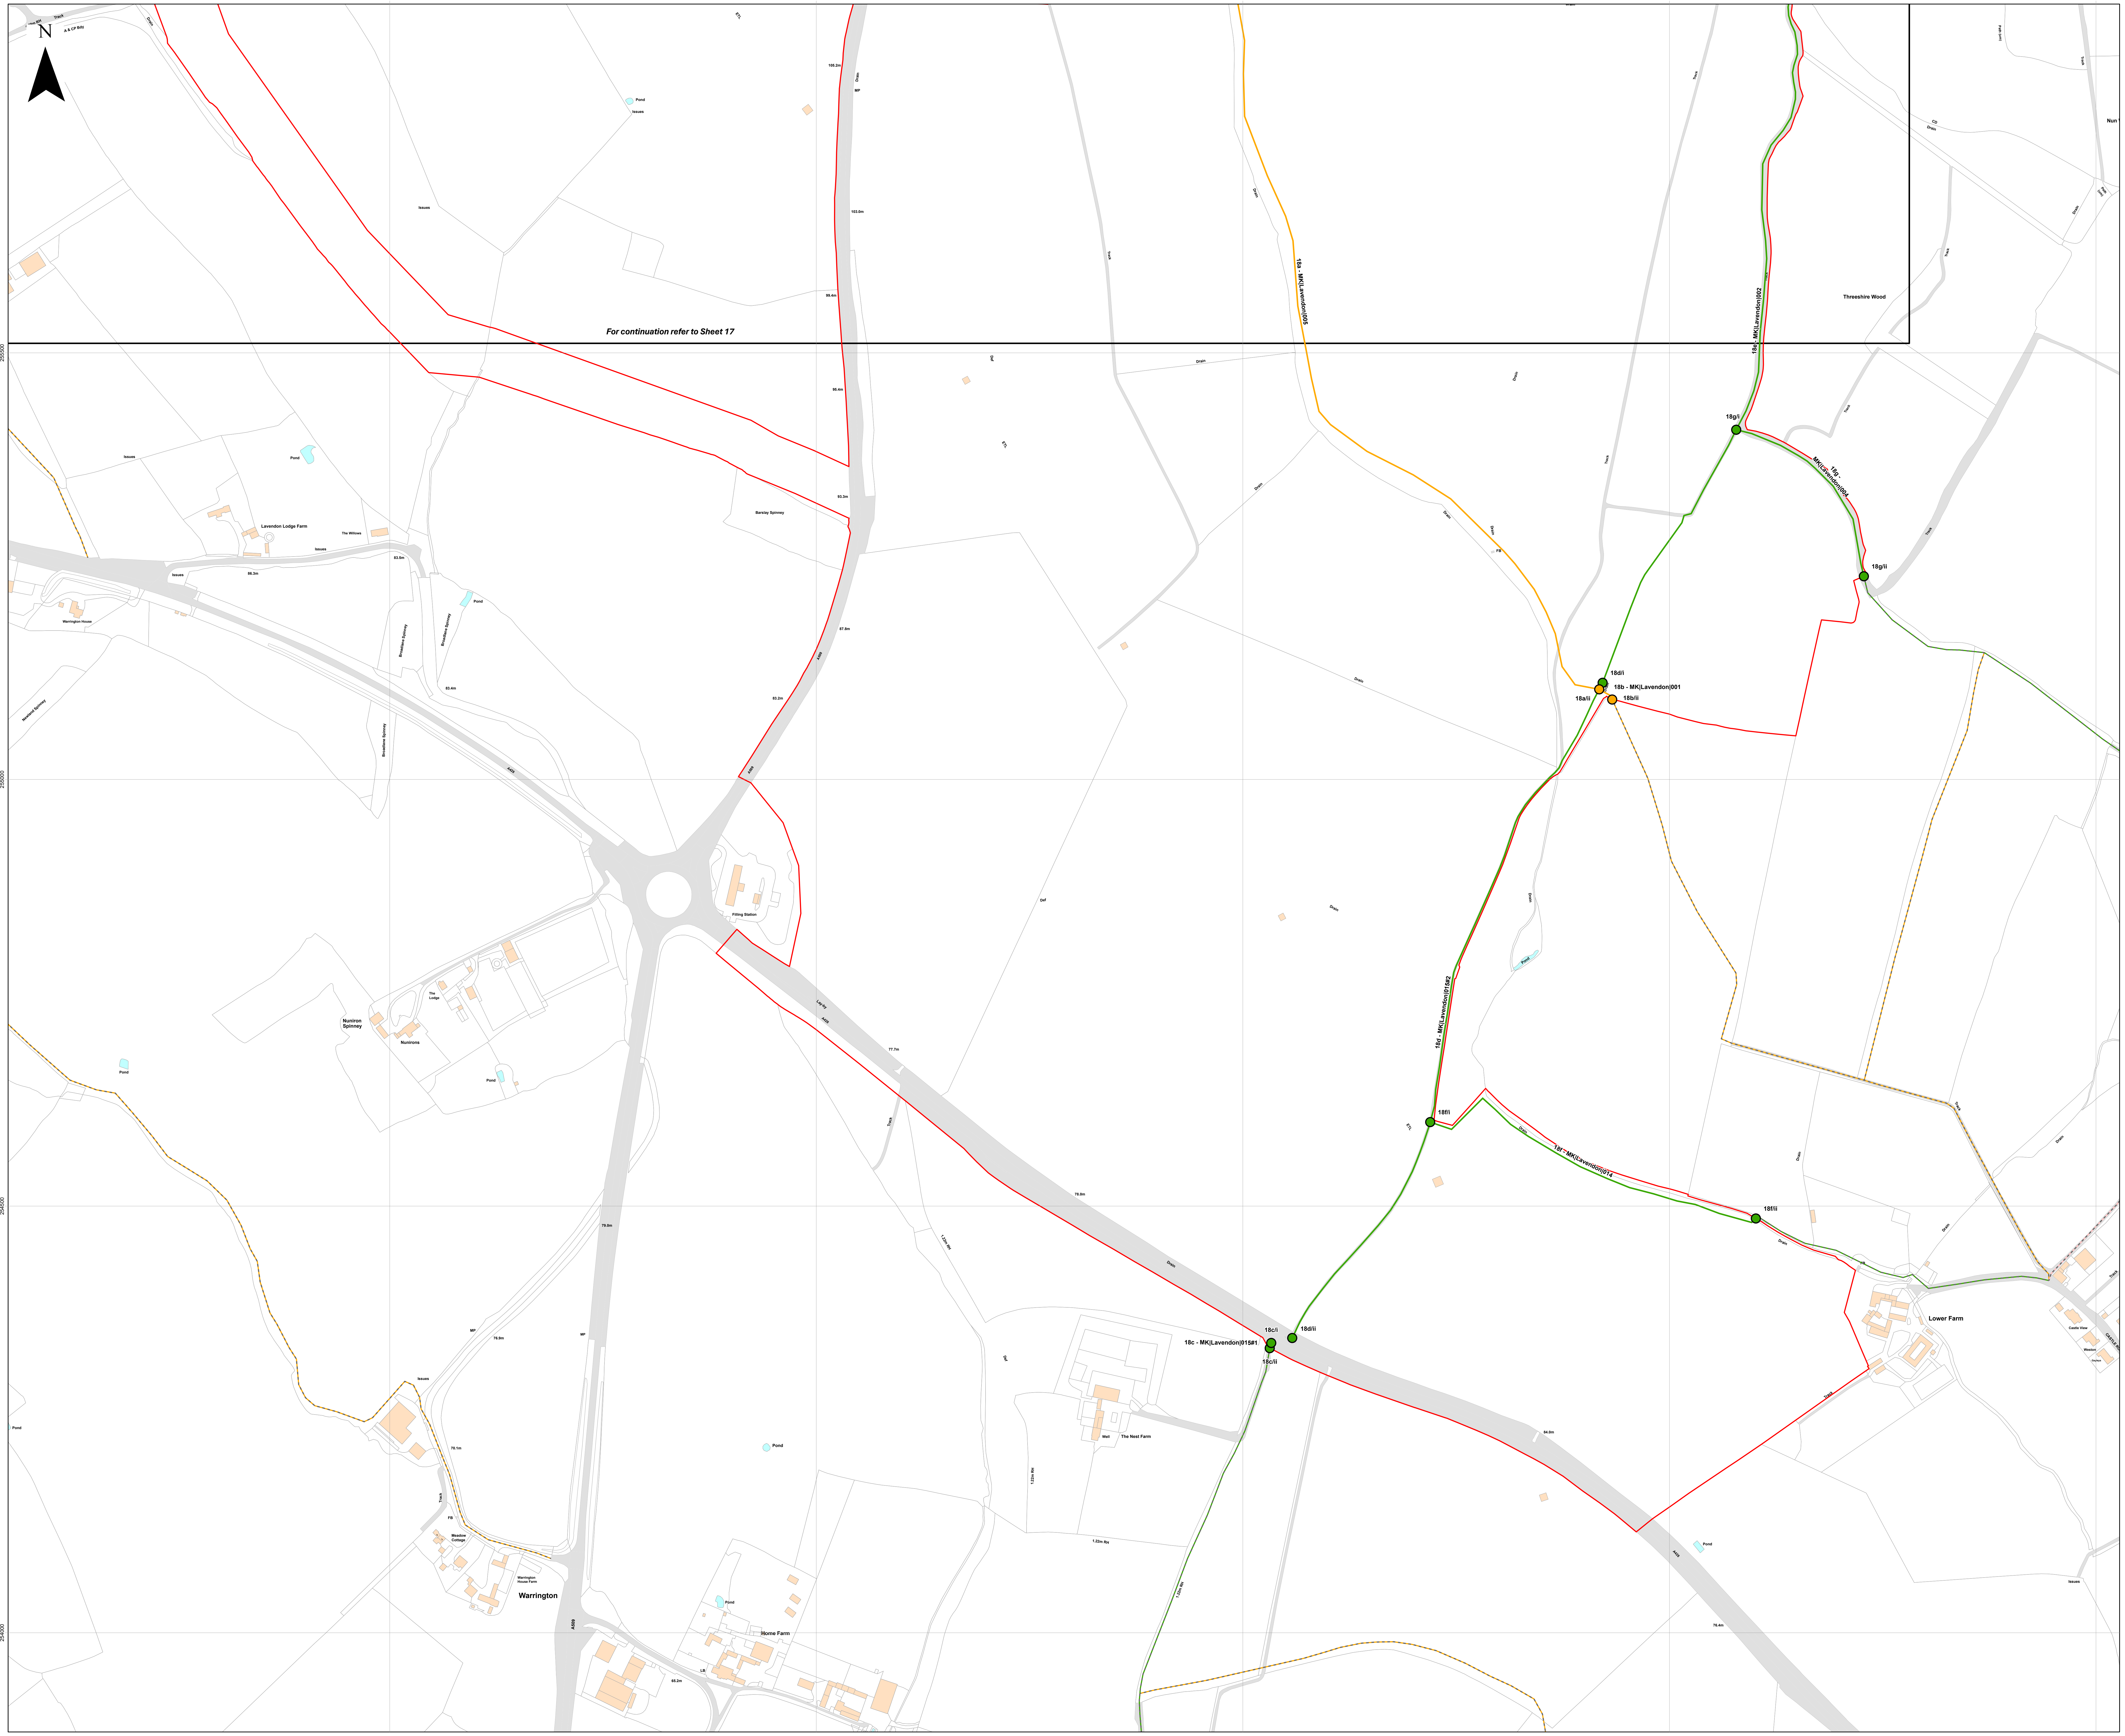
N
489500
490000
490500
491000
491500
255500
255000
254500
254000
For continuation refer to Sheet 17
18a - MK|Lavendon|005
18e - MK|Lavendon|002
18g - MK|Lavendon|004
18b - MK|Lavendon|001
18d - MK|Lavendon|015#2
18f - MK|Lavendon|014
18c - MK|Lavendon|015#1
18g/i
18g/ii
18d/i
18a/ii
18b/ii
18f/i
18f/ii
18c/i
18c/ii
18d/ii
Threeshire Wood
Lavendon Lodge Farm
Warrington House
Nunlorne Spinney
Filling Station
Lower Farm
The Nest Farm
Warrington
Home Farm
Barclay Spinney
Track
Drain
Pond
ETL

Island GREEN POWER

Lanpro

Key

🟥 Order Limits

▭ Sheet Index

Public Right of Way (PRoW)

- Bridleway
- Footpath
- Restricted Byway

PRoW to be temporarily stopped up

- Bridleway
- Footpath

PRoW to be temporarily stopped up - start and end points

● Bridleway

● Footpath

Layers: Lanpro, 2025; IGP, 2025

0 100 200 300 Meters

Scale: 1:2,500@ A0

APFP Regulation: 5(2)(j)	Application Doc No. CR1/GH2.6_B
Ref: P3535_LPR_ZZ_XX_DR_Z_0275	Date: 05/11/2025
Drawn by: BH	Checked by: JC

Public Rights of Way Plan (Change Application Version)

Sheet 18 of 18
Revision B

GREEN HILL
SOLAR FARM