Green Hill Solar Farm
EN010170

Streets Plan
Revision ~~A~~B (Tracked)

Prepared by: Lanpro
Date: ~~June~~ November 2025

Document Reference: ~~PEX~~CR1/GH2.5_B~~A~~
APFP Regulation 5(2)(k)

Schedule of Changes

Figure Reference	**Page**	**Description of Changes**	**Reason for Revision**
[cover]		Updated document reference to Revision B	As required for submission of Change Application.
All Sheets	3-21	Updated document references and annotations	As required for submission of Change Application.
Sheet 1	4	Order Limits extended Extension of street 1k-1l Addition of street 1n-1o	Presentation of Change 1 requested in Change Application **[EN010170/CR1/GH9.2]**
Sheet 3	6	Order Limits extended Addition of street 3j-3k	Presentation of Change 3 requested in Change Application **[EN010170/CR1/GH9.2]**
Sheet 8	11	Order Limits extended Extension of street 8k-10a	Presentation of Change 6 requested in Change Application **[EN010170/CR1/GH9.2]**
Sheet 9	12	Order Limits extended Extension of street 8k-10a	Presentation of Change 6 requested in Change Application **[EN010170/CR1/GH9.2]**
Sheet 12	15	Order Limits extended Extension of streets 12e-12f and 12g-12h	Presentation of Change 7 requested in Change Application **[EN010170/CR1/GH9.2]**
Sheet 15	18	Order Limits reduced	Presentation of Change 8 requested in Change Application **[EN010170/CR1/GH9.2]**
Sheet 16	19	Order Limits reduced Splitting of street 16f-16h into separate streets 16f-16h and 16n-16o	Presentation of Change 9 requested in Change Application **[EN010170/CR1/GH9.2]**
Sheet 17	20	Order Limits reduced Splitting of street 16f-16h into separate streets 16f-16h and 16n-16o	Presentation of Change 9 requested in Change Application **[EN010170/CR1/GH9.2]**

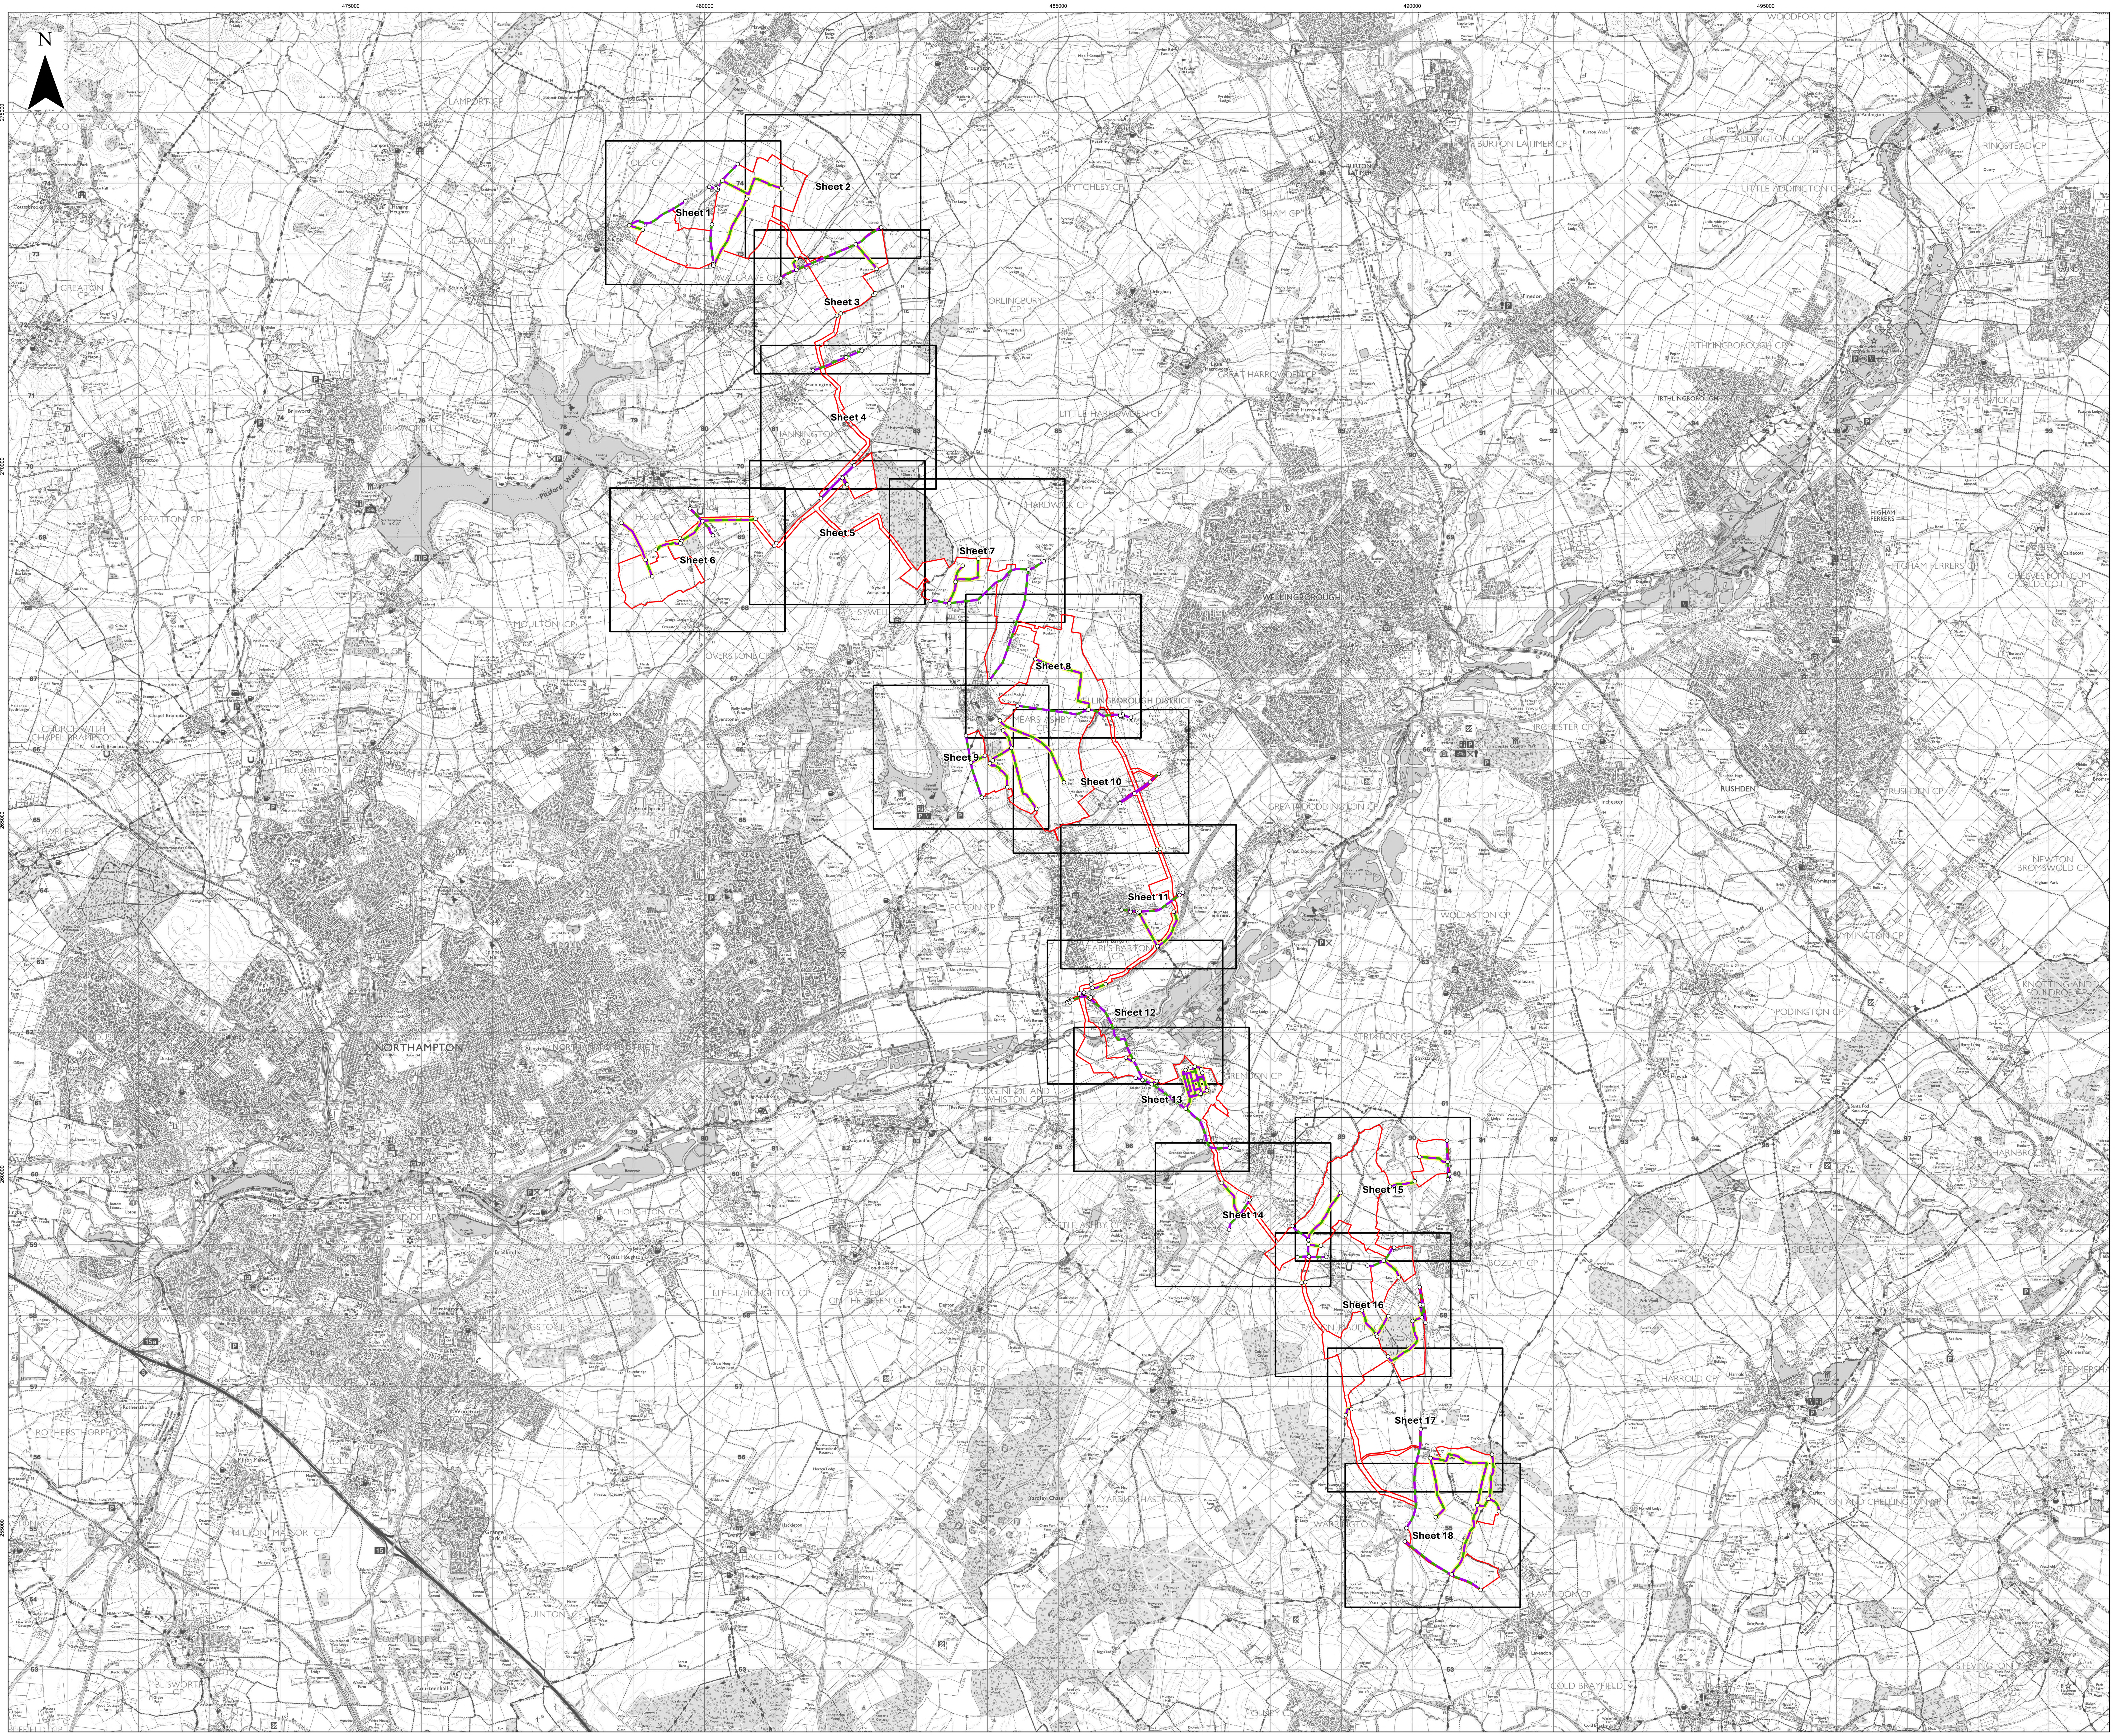
N
475000
480000
485000
490000
495000
Sheet 1
Sheet 2
Sheet 3
Sheet 4
Sheet 5
Sheet 6
Sheet 7
Sheet 8
Sheet 9
Sheet 10
Sheet 11
Sheet 12
Sheet 13
Sheet 14
Sheet 15
Sheet 16
Sheet 17
Sheet 18
WELLINGBOROUGH
NORTHAMPTON
RUSHDEN
HIGHAM FERRERS
SYWELL
EARLS BARTON
MEARS ASHBY
WOODFORD CP
BURTON LATIMER CP
GREAT ADDINGTON CP
RINGSTEAD CP
LITTLE ADDINGTON CP
ISHAM CP
PYTCHLEY CP
ORLINGBURY CP
GREAT HARROWDEN CP
LITTLE HARROWDEN CP
HARDWICK CP
IRTHLINGBOROUGH CP
STANWICK CP
HIGHAM FERRERS CP
CHELVESTON CUM CALDECOTT CP
IRCHESTER CP
RUSHDEN CP
NEWTON BROMSWOLD CP
GREAT DODDINGTON CP
WOLLASTON CP
STRIXTON CP
BOZEAT CP
PODINGTON CP
HINWICK
HARROLD CP
LAVENDON CP
COLD BRAYFIELD
WARRINGTON
GRENDON CP
COGENHOE AND WHISTON CP
ECTON CP
OVERSTONE CP
MOULTON CP
HOLCOT CP
WALGRAVE CP
OLD CP
HANNINGTON CP
LAMPORT CP
SCALDWELL CP
BRIXWORTH CP
SPRATTON CP
BOUGHTON CP
CHAPEL BRAMPTON CP
HARLESTONE CP
CREATON CP
COTTESBROOKE CP
LITTLE HOUGHTON CP
BRAFIELD ON THE GREEN CP
DENTON CP
YARDLEY HASTINGS CP
CASTLE ASHBY CP
HARDINGSTONE CP
MILTON MALSOR CP
QUINTON CP
BLISWORTH CP
ROTHERSTHORPE CP
Pitsford Water

Island GREEN POWER

Lanpro

Key

- 🟥 Order Limits
- ⬛ Sheet Index
- ○ Reference point within schedule
- 🟩 Private street with use temporarily suspended or restricted
- 🟪 Private access and street works / Private access subject to traffic regulation measures
- 🟩 Street with use temporarily suspended or restricted
- 🟪 Street works / Street subject to traffic regulation measures

Layers: Lanpro, 2024; IGP, 2025
Base map: Reproduced from Ordnance Survey digital map data © Crown copyright 2025. All rights reserved. License number 0100031673

0 1 2 3 4 Kilometers

Scale: 1:30,000@ A0

APFP Regulation: 5(2)(j)	Application Doc No. CR1/GH2.5_B
Ref: P3535_LPR_ZZ_XX_DR_Z_0281	Date: 05/11/2025
Drawn by: BH	Checked by: JC

Streets Plan (Change Application Version)

Index Sheet
Revision B

GREEN HILL
SOLAR FARM

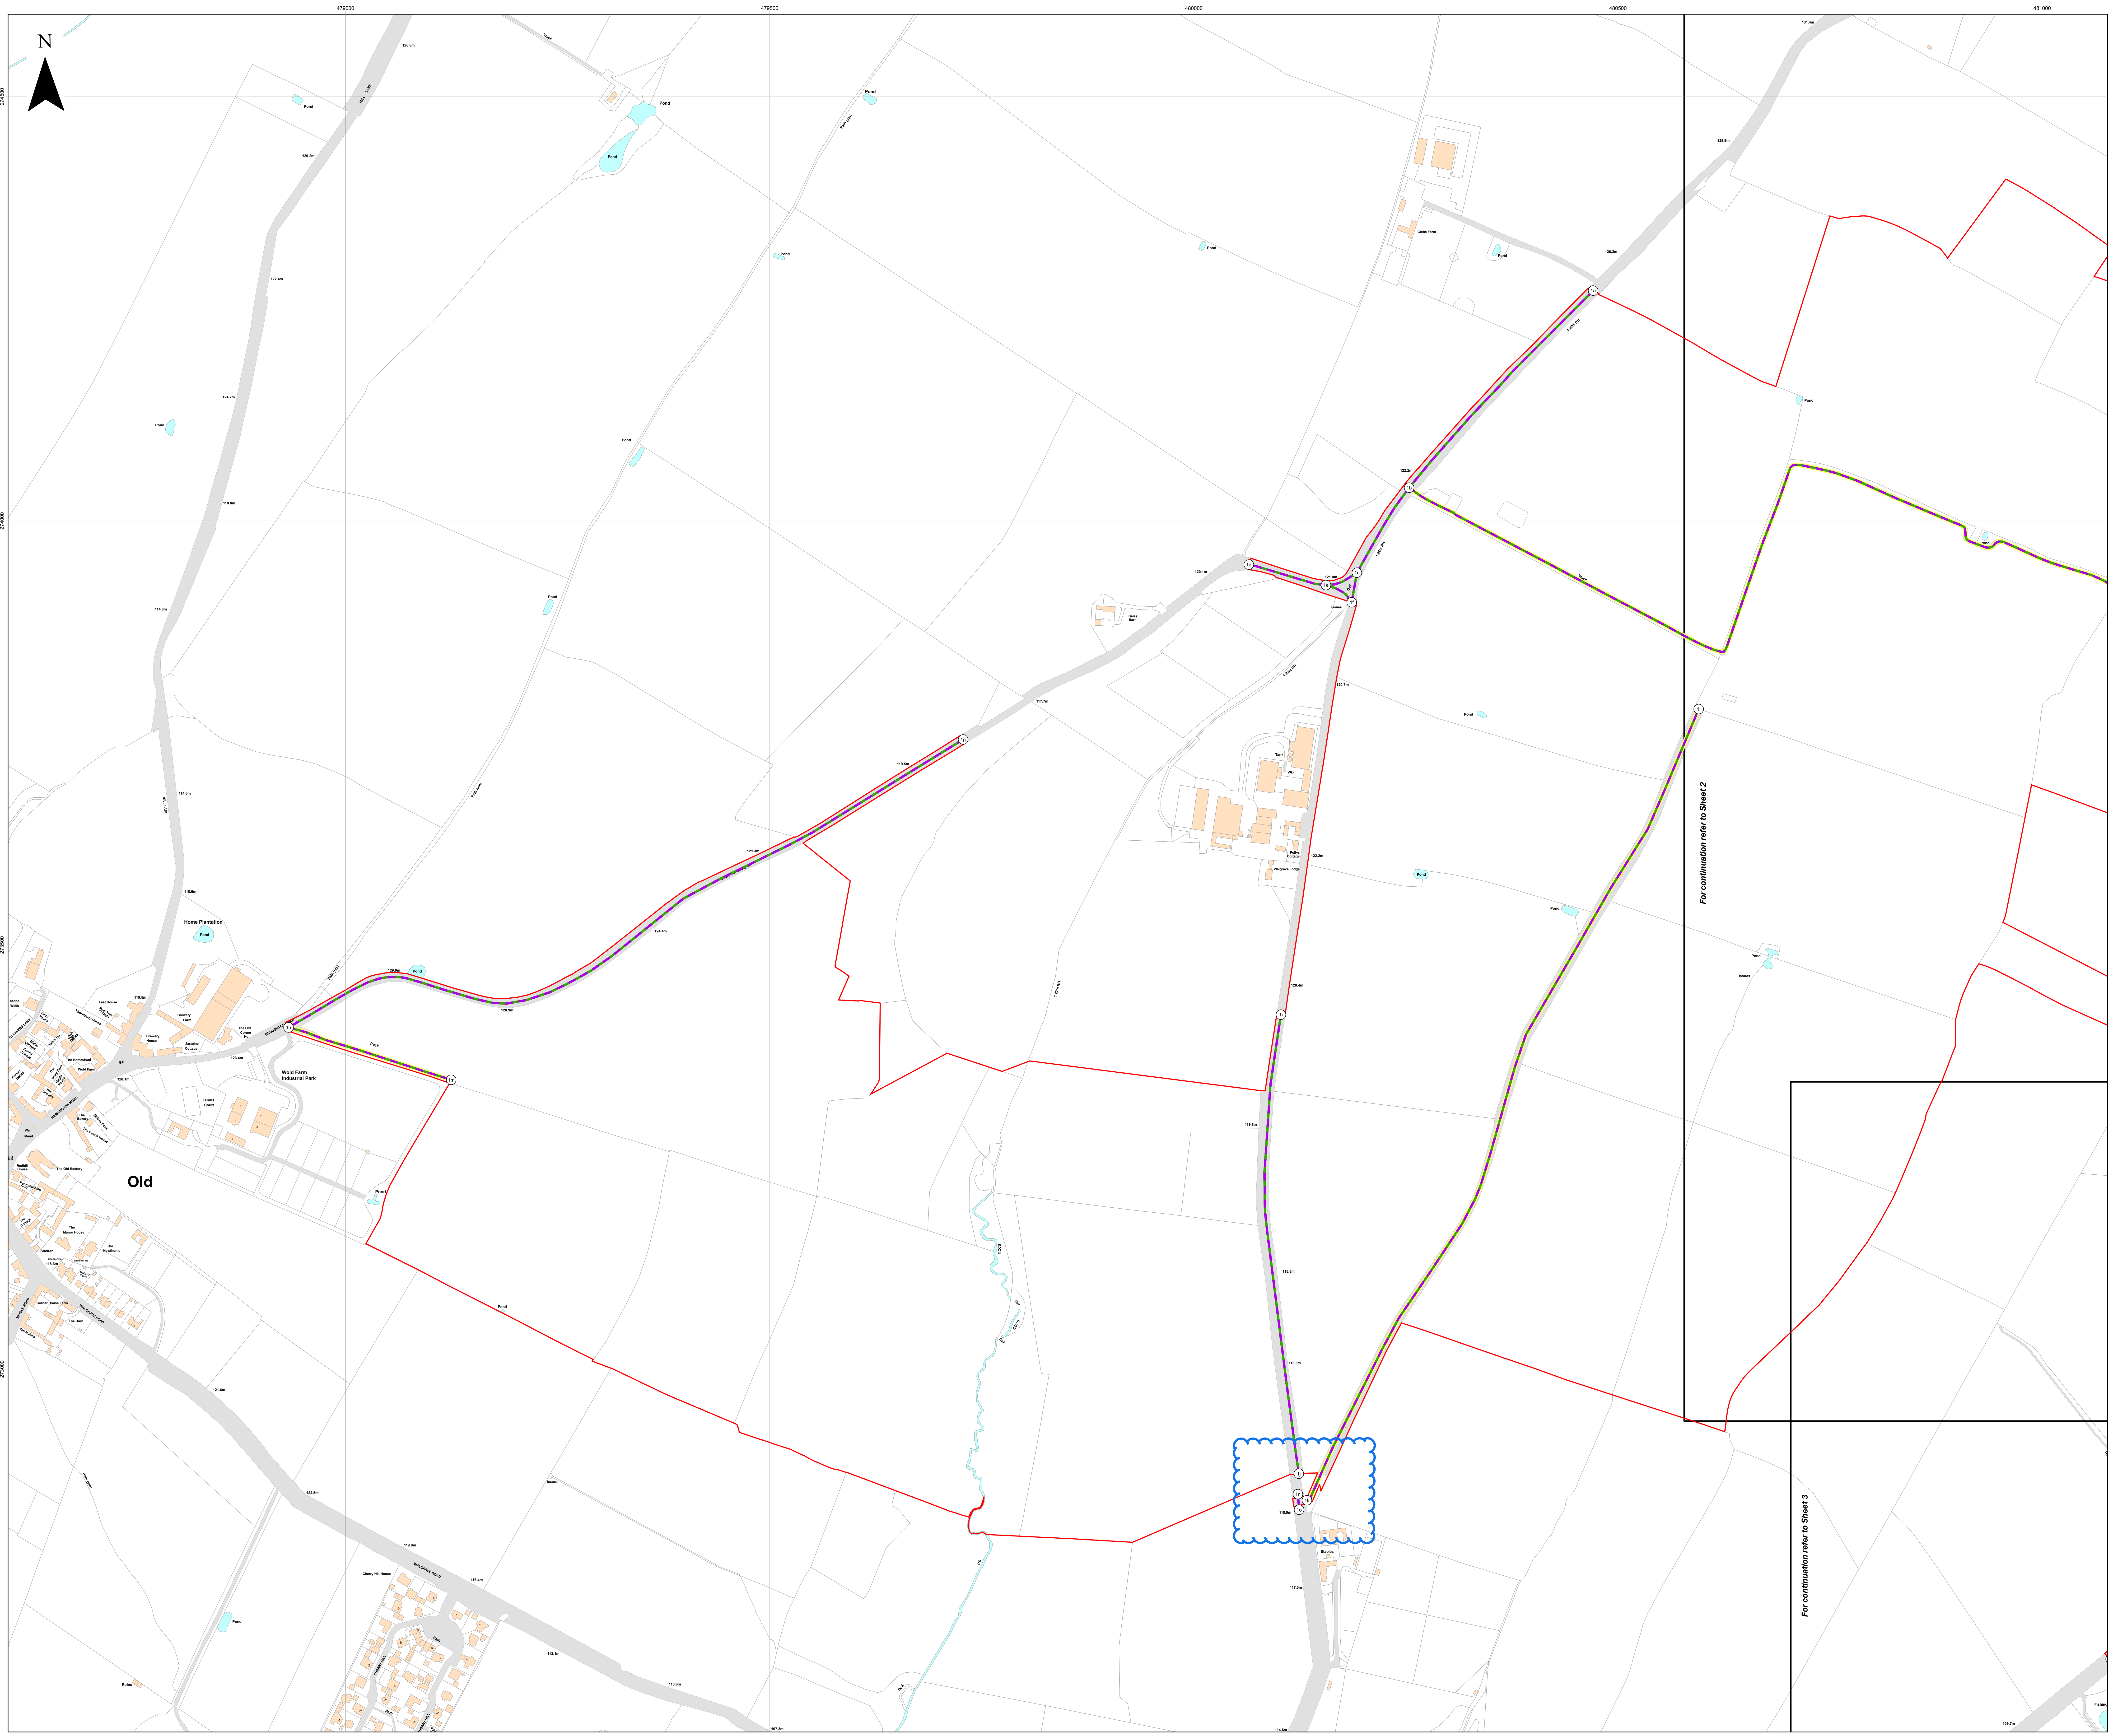
479000
479500
480000
480500
481000
274500
274000
273500
273000
N
Old
Home Plantation
Wold Farm Industrial Park
Pond
For continuation refer to Sheet 2
For continuation refer to Sheet 3

Key

- 🟥 Order Limits
- ☐ Sheet Index
- ○ Reference point within schedule
- ━ Private street with use temporarily suspended or restricted
- ━ Private access and street works / Private access subject to traffic regulation measures
- ━ Street with use temporarily suspended or restricted
- ━ Street works / Street subject to traffic regulation measures

Layers: Lanpro, 2025; IGP, 2025
Base map: Reproduced from Ordnance Survey digital map data © Crown copyright 2025. All rights reserved. License number 0100031673

0 100 200 300 Meters

Scale: 1:2,500@ A0

APFP Regulation: 5(2)(j)	Application Doc No. CR1/GH2.5_B
Ref: P3535_LPR_ZZ_XX_DR_Z_0281	Date: 05/11/2025
Drawn by: BH	Checked by: JC

Streets Plan (Change Application Version)

Sheet 1 of 18
Revision B

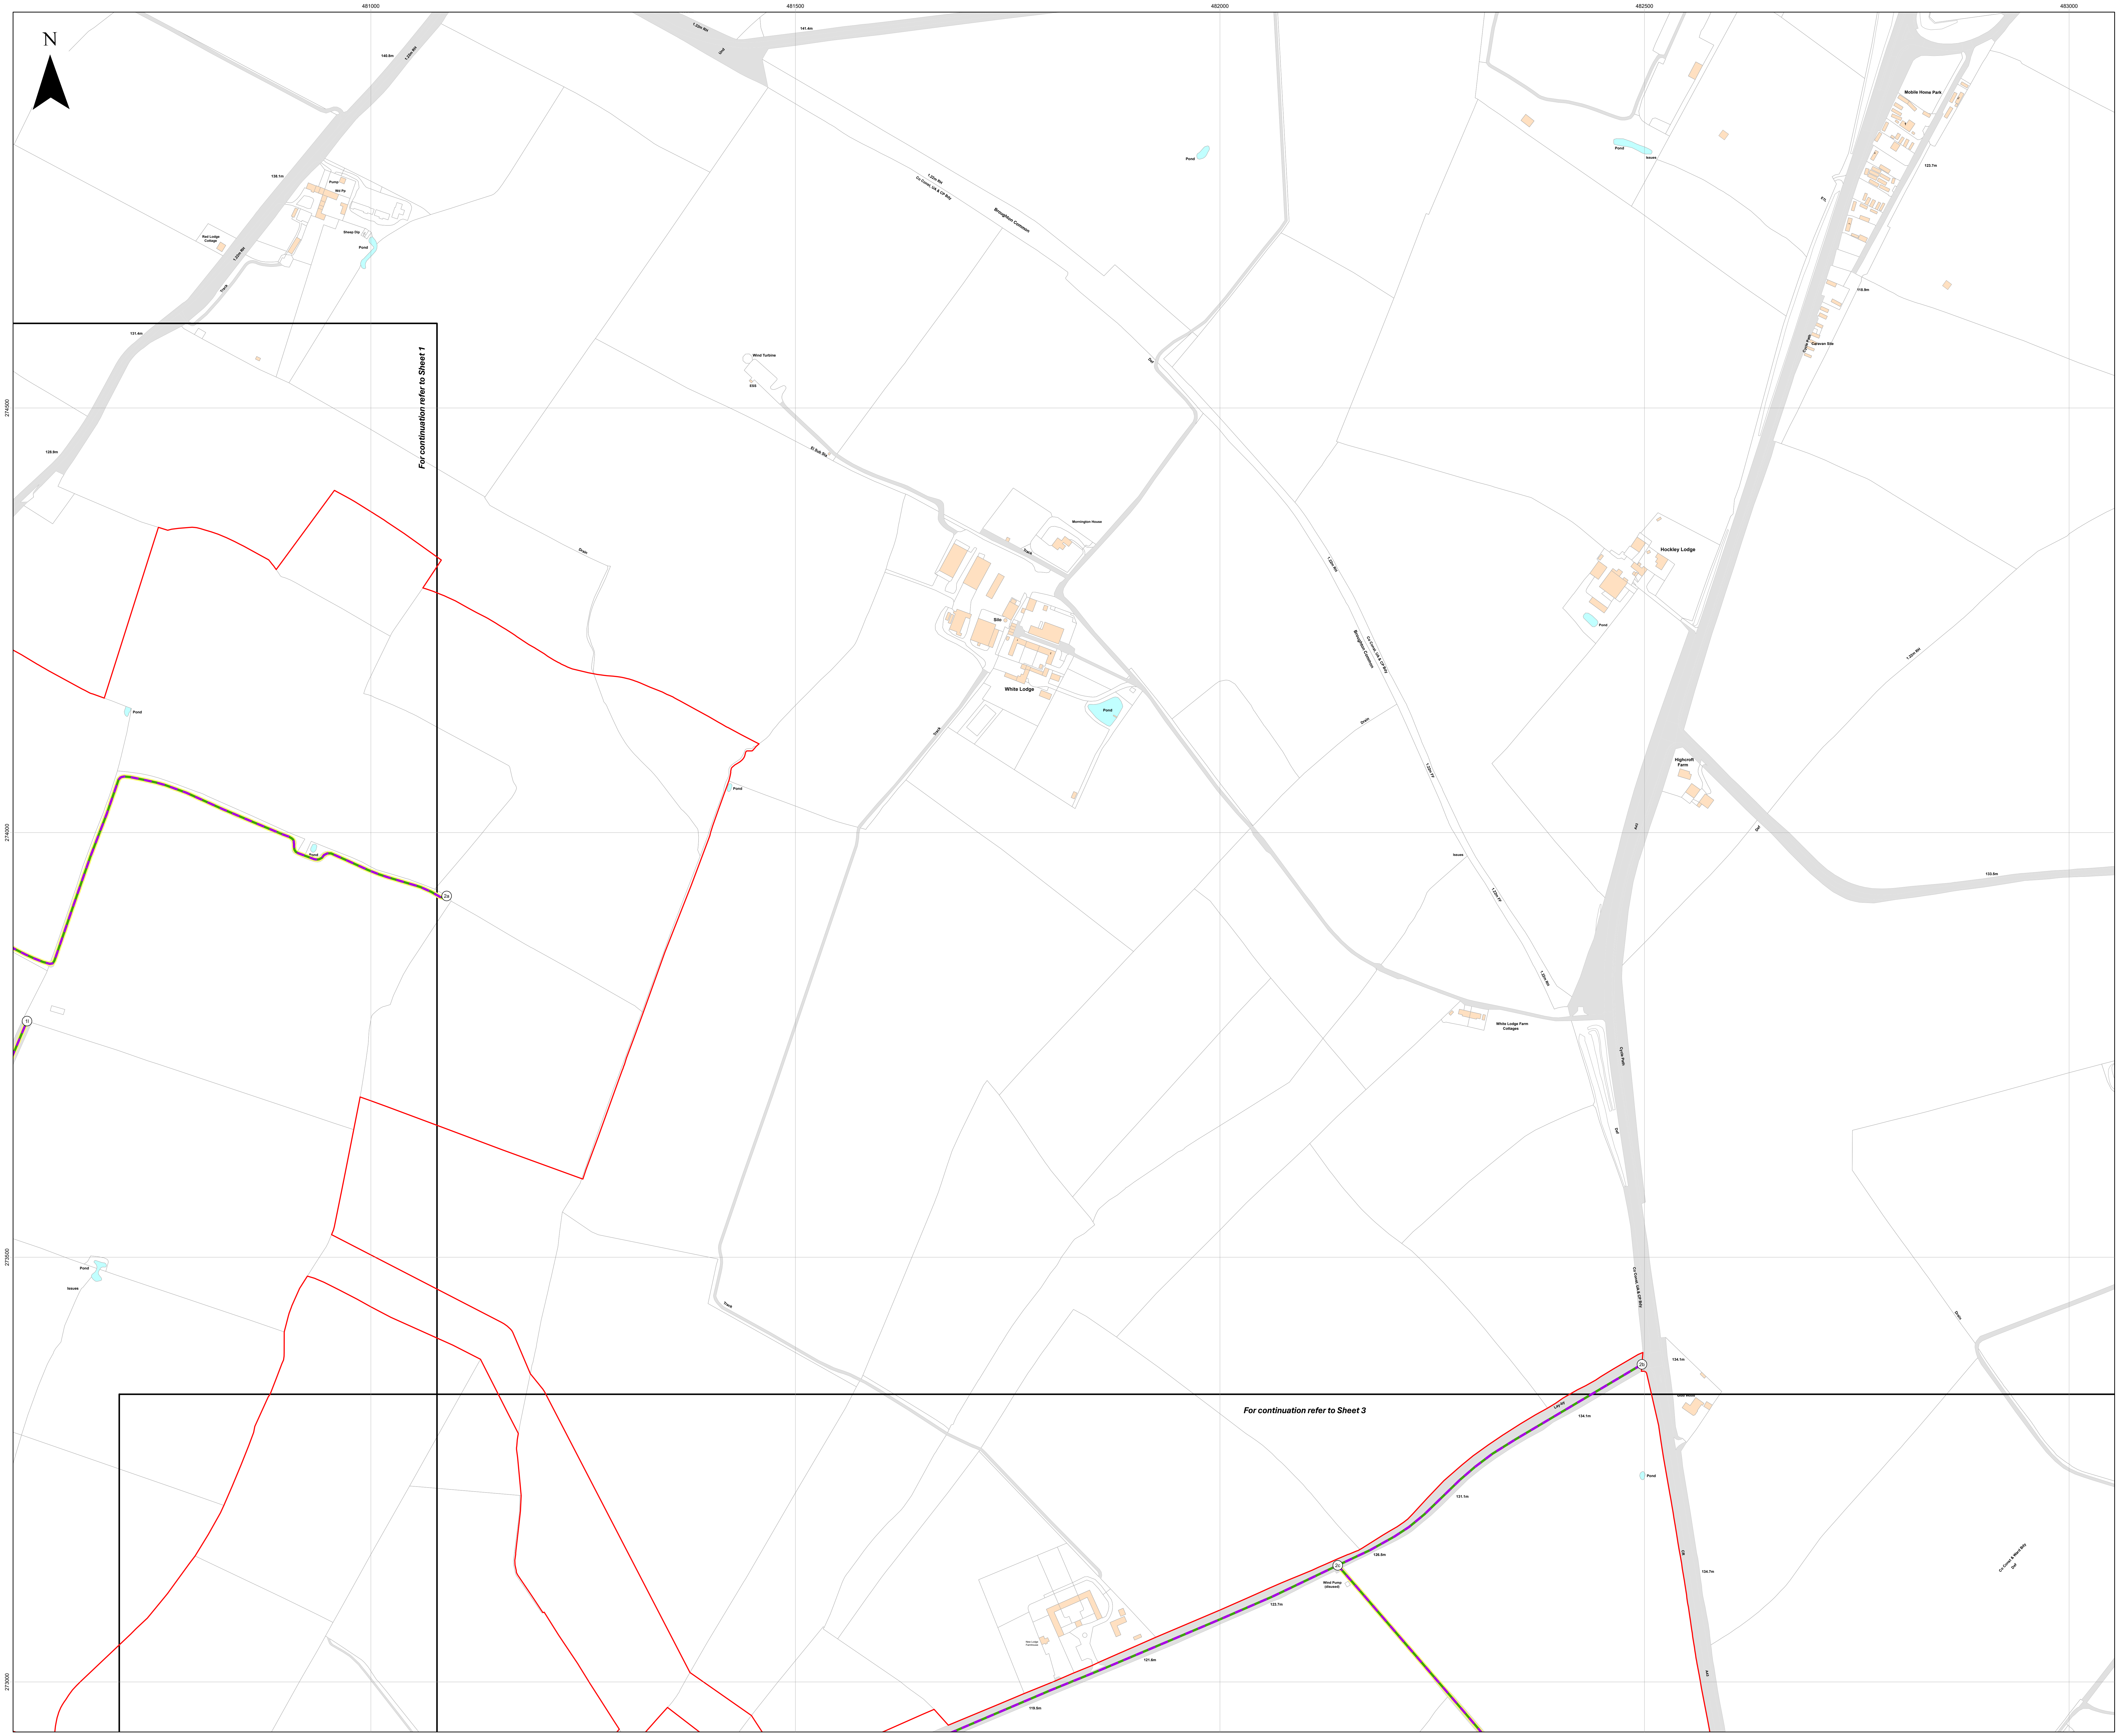
N
481000
481500
482000
482500
483000
274500
274000
273500
273000
For continuation refer to Sheet 1
For continuation refer to Sheet 3
1l
2a
2b
2c
Pond
Wind Turbine
Mornington House
Silo
White Lodge
Track
Drain
Hockley Lodge
Highcroft Farm
White Lodge Farm Cottages
Mobile Home Park
Caravan Site
Co Const, UA & CP Bdy
Lay-by
Wind Pump (disused)
Gibb Wood
CR
A43
134.1m
131.1m
126.5m
123.7m
134.7m

Island GREEN POWER

Lanpro

Key

- ▭ Order Limits
- ▭ Sheet Index
- ○ Reference point within schedule
- — Private street with use temporarily suspended or restricted
- — Private access and street works / Private access subject to traffic regulation measures
- — Street works / Street subject to traffic regulation measures

Layers: Lanpro, 2025; IGP, 2025

0 100 200 300 Meters

Scale: 1:2,500@ A0

APFP Regulation: 5(2)(j)	Application Doc No. CR1/GH2.5_B
Ref: P3535_LPR_ZZ_XX_DR_Z_0281	Date: 05/11/2025
Drawn by: BH	Checked by: JC

Streets Plan (Change Application Version)

Sheet 2 of 18

Revision B

GREEN HILL SOLAR FARM

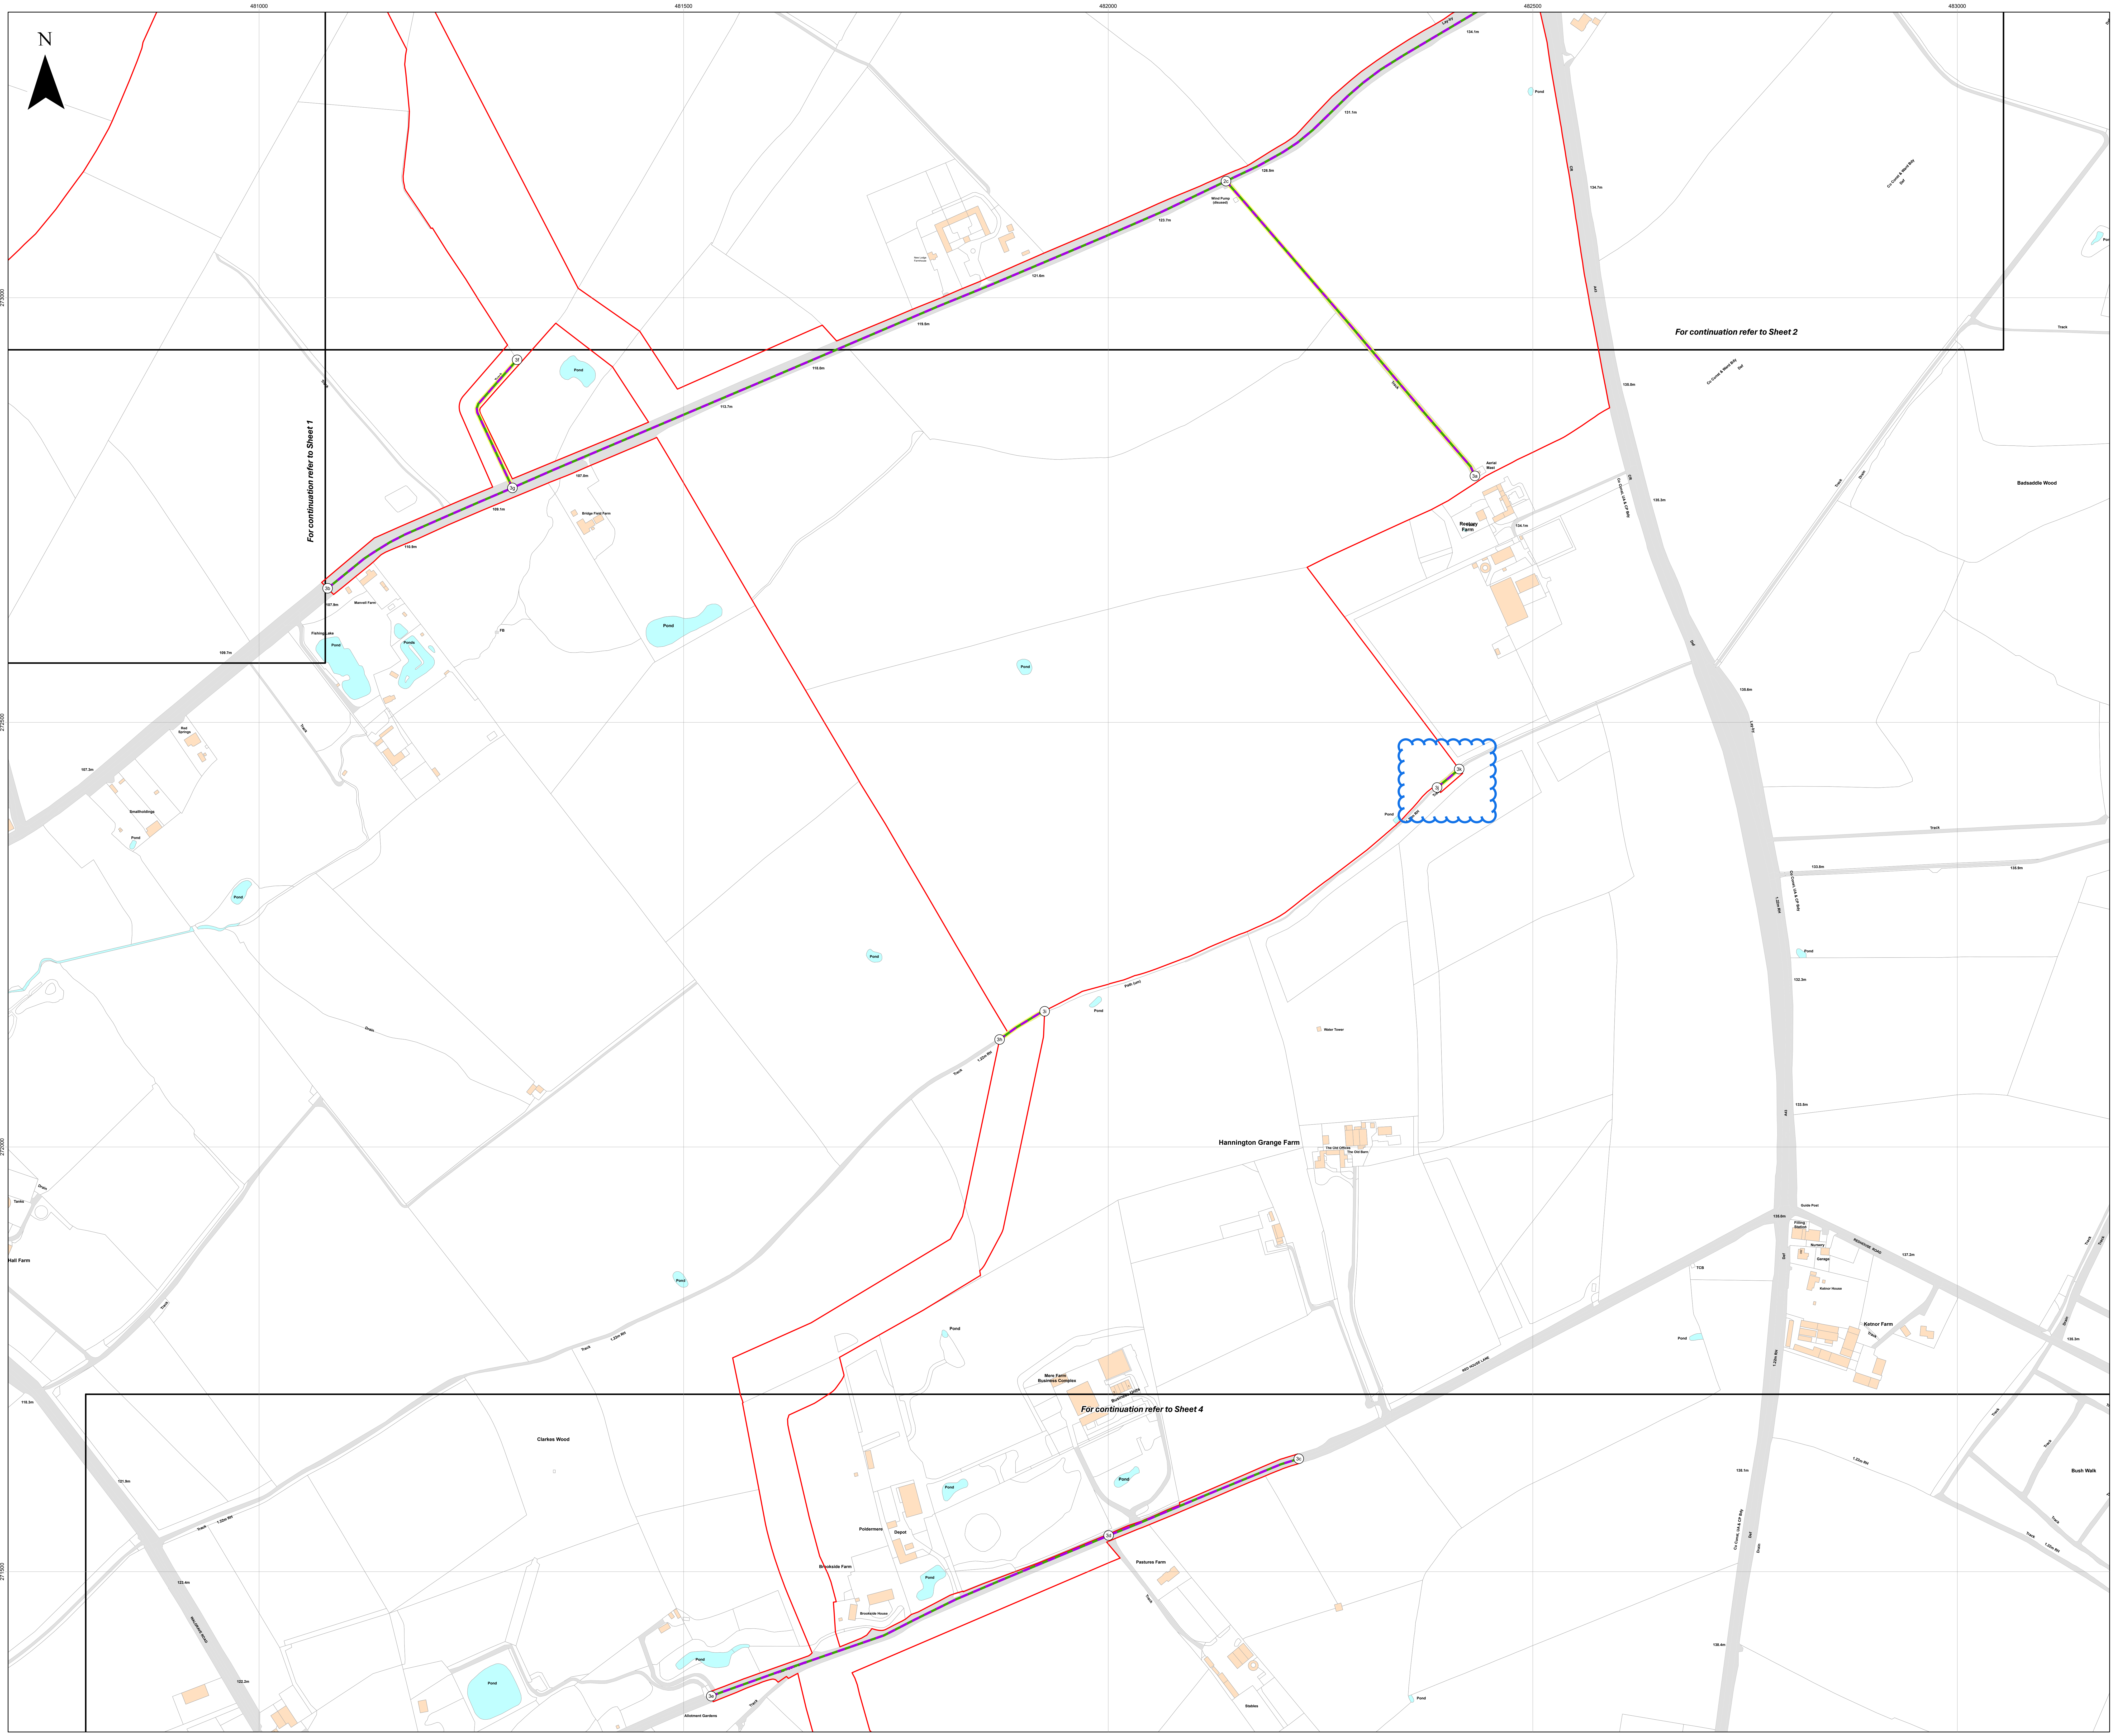
N
481000
481500
482000
482500
483000
273000
272500
272000
271500
For continuation refer to Sheet 1
For continuation refer to Sheet 2
For continuation refer to Sheet 4
Pond
Badsaddle Wood
Water Tower
Hannington Grange Farm
Hall Farm
Clarkes Wood
Kelmor Farm
Bush Walk
Track

Key

🟥 Order Limits
⬜ Sheet Index
○ Reference point within schedule
🟩 Private street with use temporarily suspended or restricted
🟪 Private access and street works / Private access subject to traffic regulation measures
🟪 Street works / Street subject to traffic regulation measures

Layers: Lanpro, 2025; IGP, 2025
Base map: Reproduced from Ordnance Survey digital map data © Crown copyright 2025. All rights reserved. License number 0100031673

0 100 200 300 Meters

Scale: 1:2,500@ A0

APFP Regulation: 5(2)(j)	Application Doc No. CR1/GH2.5_B
Ref: P3535_LPR_ZZ_XX_DR_Z_0281	Date: 05/11/2025
Drawn by: BH	Checked by: JC

Streets Plan (Change Application Version)

Sheet 3 of 18
Revision B

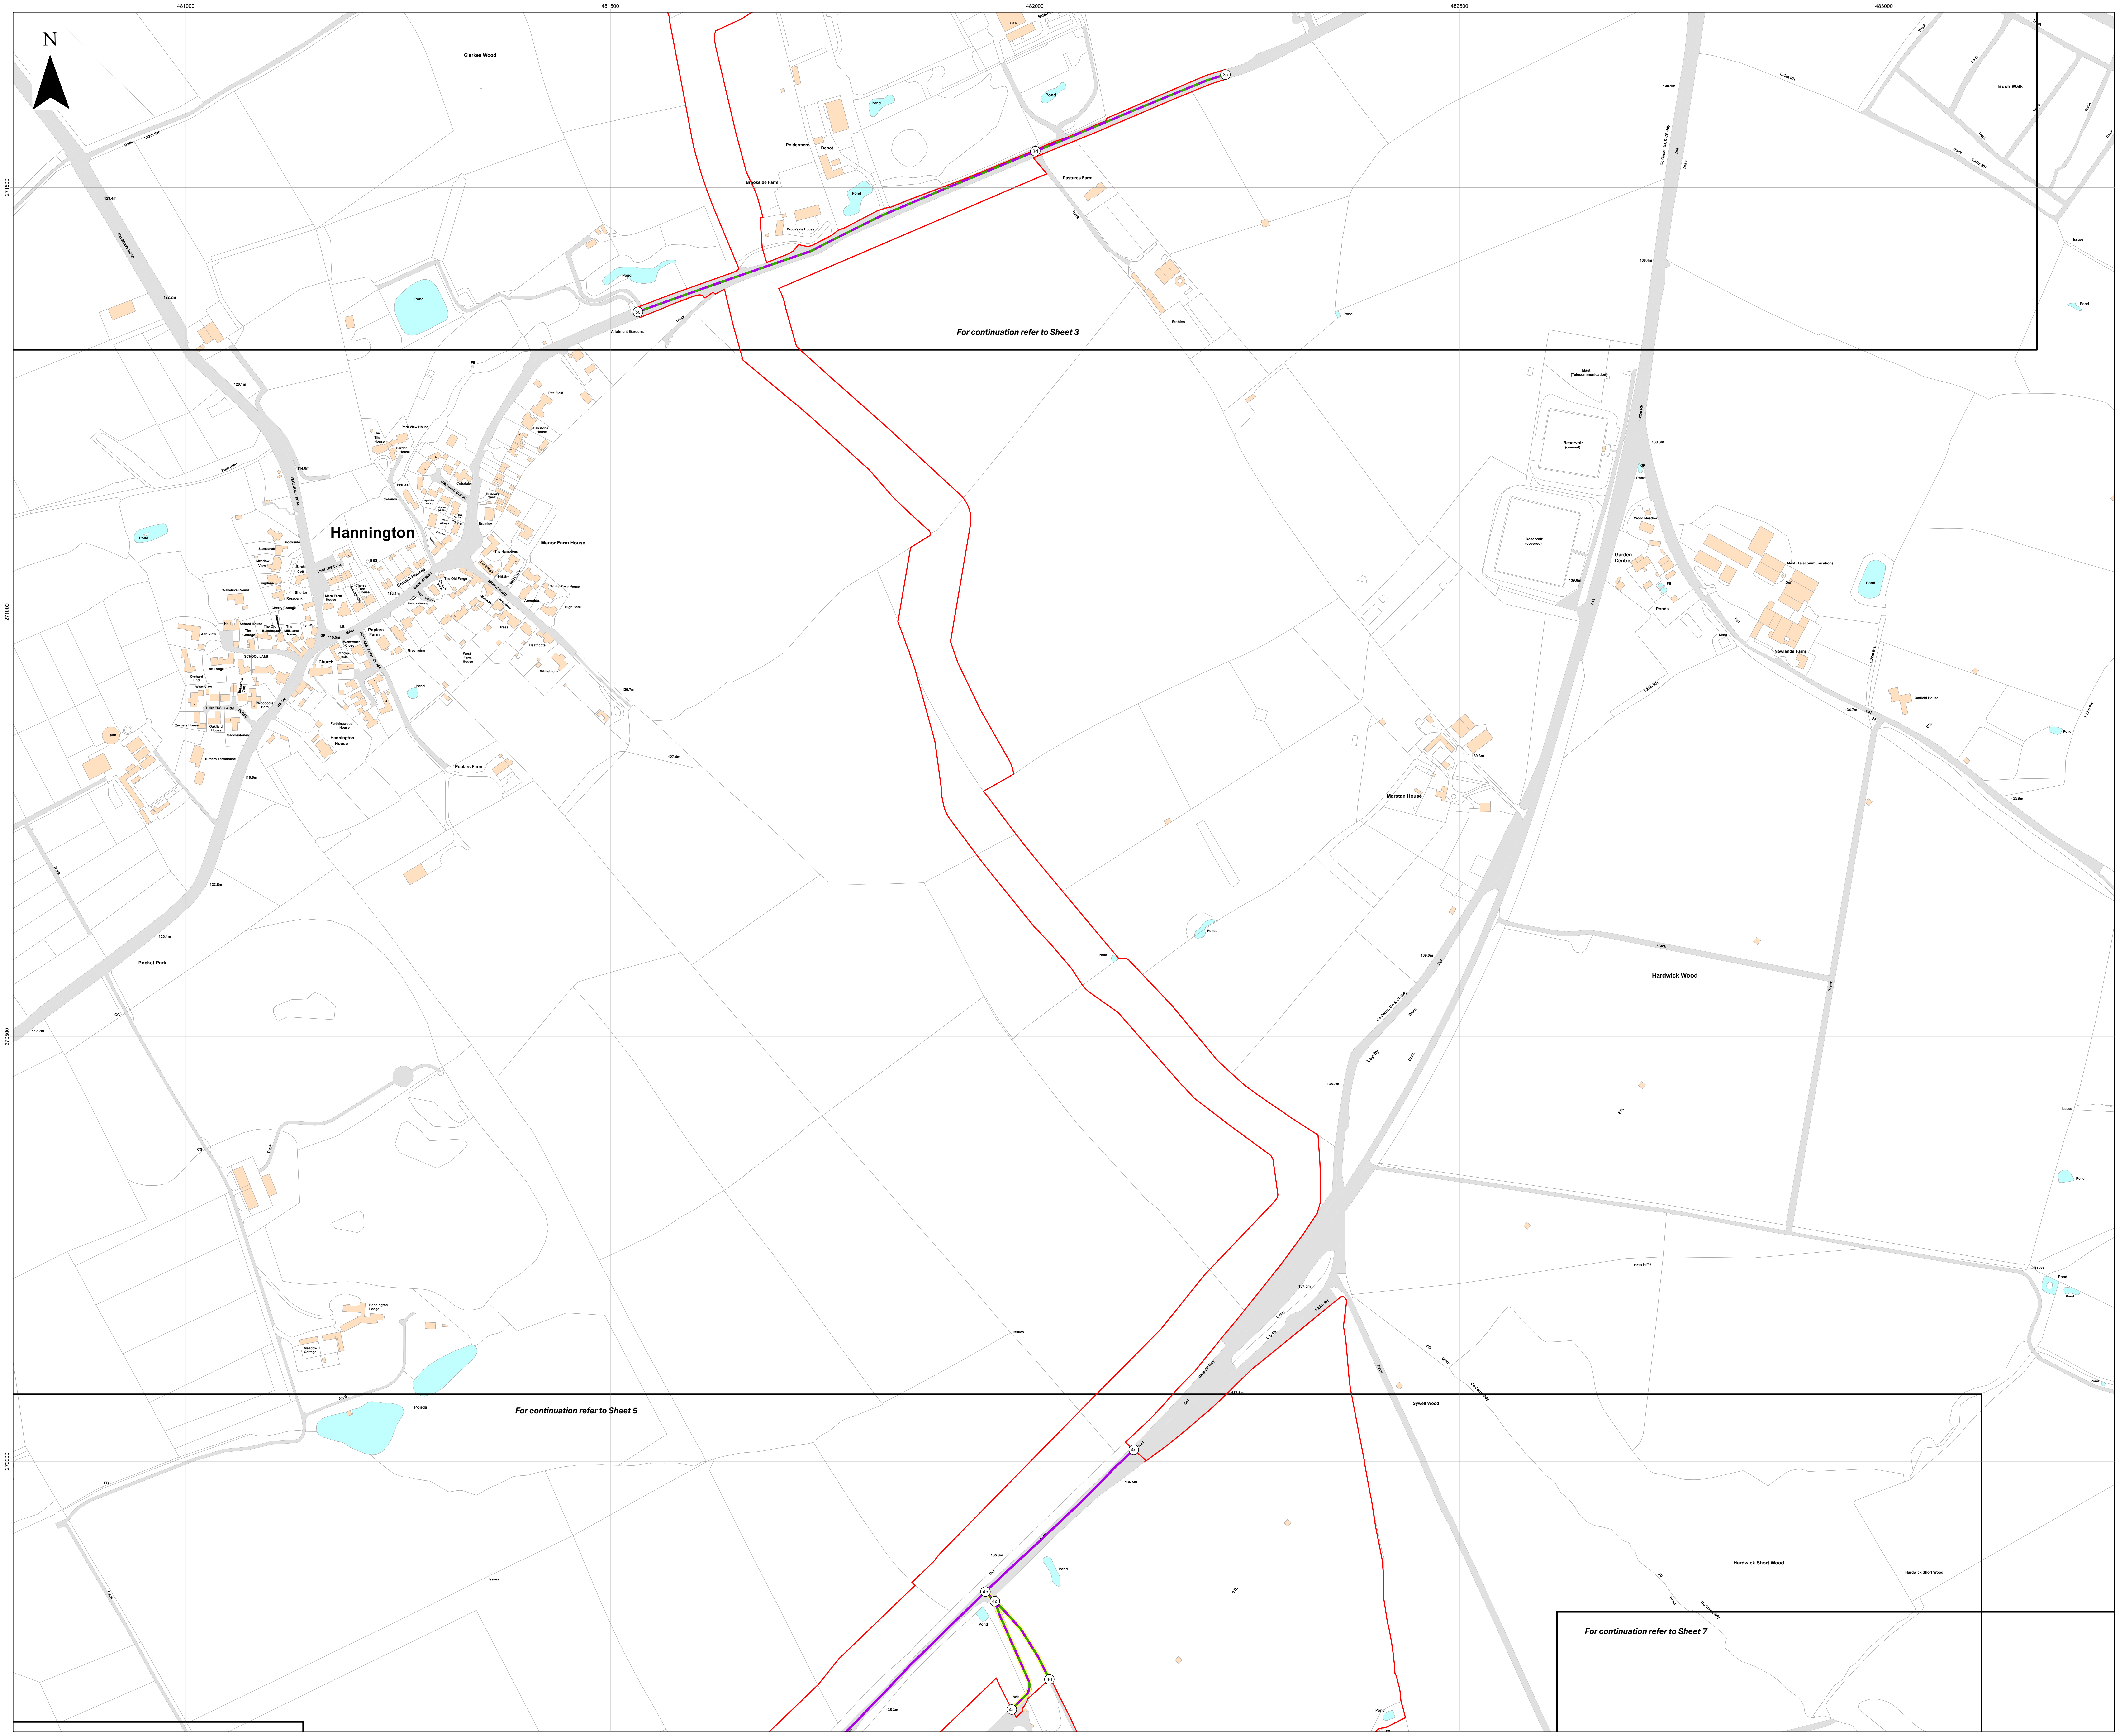
481000
481500
482000
482500
483000
271500
271000
270500
270000
N
Clarkes Wood
Poldermere
Depot
Brookside Farm
Brookside House
Pond
Pastures Farm
Stables
Allotment Gardens
Track
3c
3d
3e
For continuation refer to Sheet 3
Hannington
Manor Farm House
Poplars Farm
Church
Hannington House
Pocket Park
Reservoir (covered)
Garden Centre
Newlands Farm
Marston House
Hardwick Wood
Bush Walk
Sywell Wood
Hardwick Short Wood
For continuation refer to Sheet 5
For continuation refer to Sheet 7
A 43
UA & CP Bdy
Def
136.5m
135.9m
135.3m
WB
4a
4b
4c
4d
4e

Island GREEN POWER

Lanpro

Key

- 🟥 Order Limits
- ⬛ Sheet Index
- ○ Reference point within schedule
- 🟩 Private street with use temporarily suspended or restricted
- 🟪 Private access and street works / Private access subject to traffic regulation measures
- 🟪 Street works / Street subject to traffic regulation measures

Layers: Lanpro, 2025; IGP, 2025
Base map: Reproduced from Ordnance Survey digital map data © Crown copyright 2025. All rights reserved. License number 0100031673

0 100 200 300 Meters

Scale: 1:2,500@ A0

APFP Regulation: 5(2)(j)	Application Doc No. CR1/GH2.5_B
Ref: P3535_LPR_ZZ_XX_DR_Z_0281	Date: 05/11/2025
Drawn by: BH	Checked by: JC

Streets Plan (Change Application Version)

Sheet 4 of 18
Revision B

GREEN HILL
SOLAR FARM

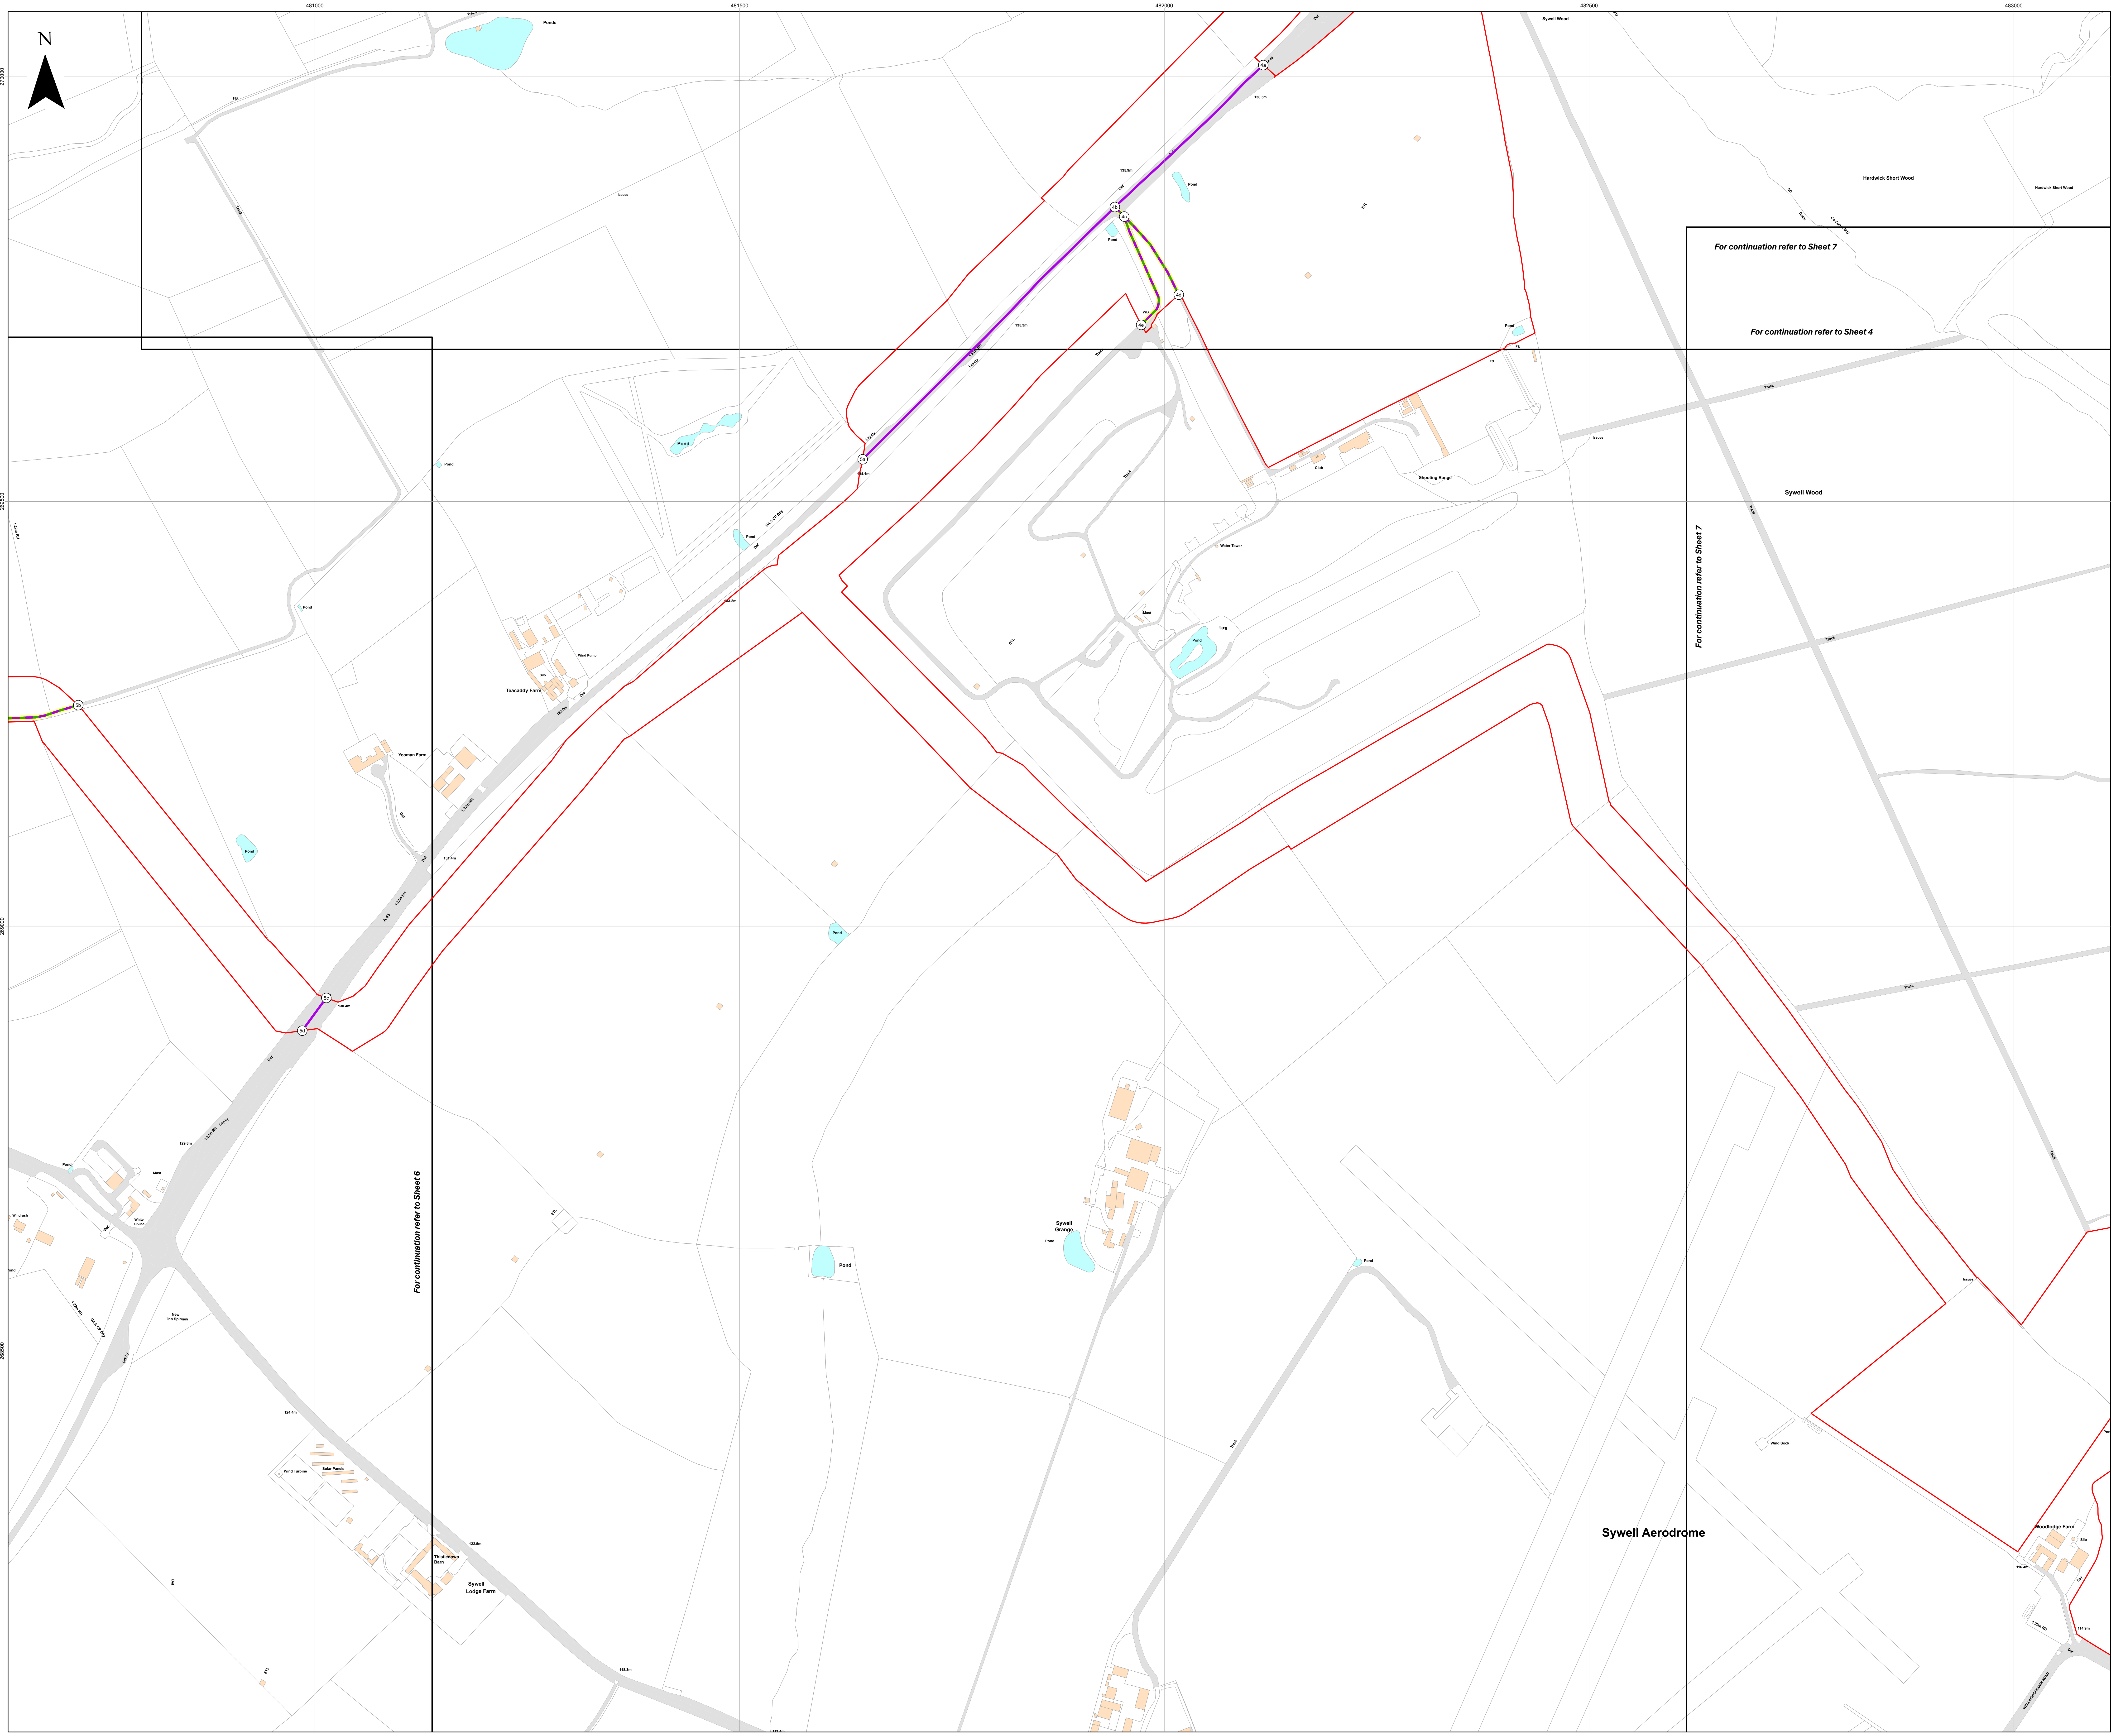
N
481000
481500
482000
482500
483000
270000
269500
269000
268500
For continuation refer to Sheet 7
For continuation refer to Sheet 4
For continuation refer to Sheet 6
4a
4b
4c
4d
4e
5a
5b
5c
5d
A 43
Def
Lay-by
1.22m RH
WB
Track
Pond
Ponds
136.5m
135.9m
135.3m
134.1m
131.4m
130.4m
Club
Shooting Range
Water Tower
Sywell Wood
Hardwick Short Wood
Teacaddy Farm
Wind Pump
Yeoman Farm
Sywell Grange
Thistledown Barn
Sywell Lodge Farm
Wind Turbine
Solar Panels
Wind Sock
Woodlodge Farm
Silo
114.9m
Sywell Aerodrome

Key

- 🟥 Order Limits
- ▭ Sheet Index
- ○ Reference point within schedule
- Private street with use temporarily suspended or restricted
- Private access and street works / Private access subject to traffic regulation measures
- Street works / Street subject to traffic regulation measures

Layers: Lanpro, 2025; IGP, 2025

0 100 200 300 Meters

Scale: 1:2,500@ A0

APFP Regulation: 5(2)(j)	Application Doc No. CR1/GH2.5_B
Ref: P3535_LPR_ZZ_XX_DR_Z_0281	Date: 05/11/2025
Drawn by: BH	Checked by: JC

Streets Plan (Change Application Version)

Sheet 5 of 18

Revision B

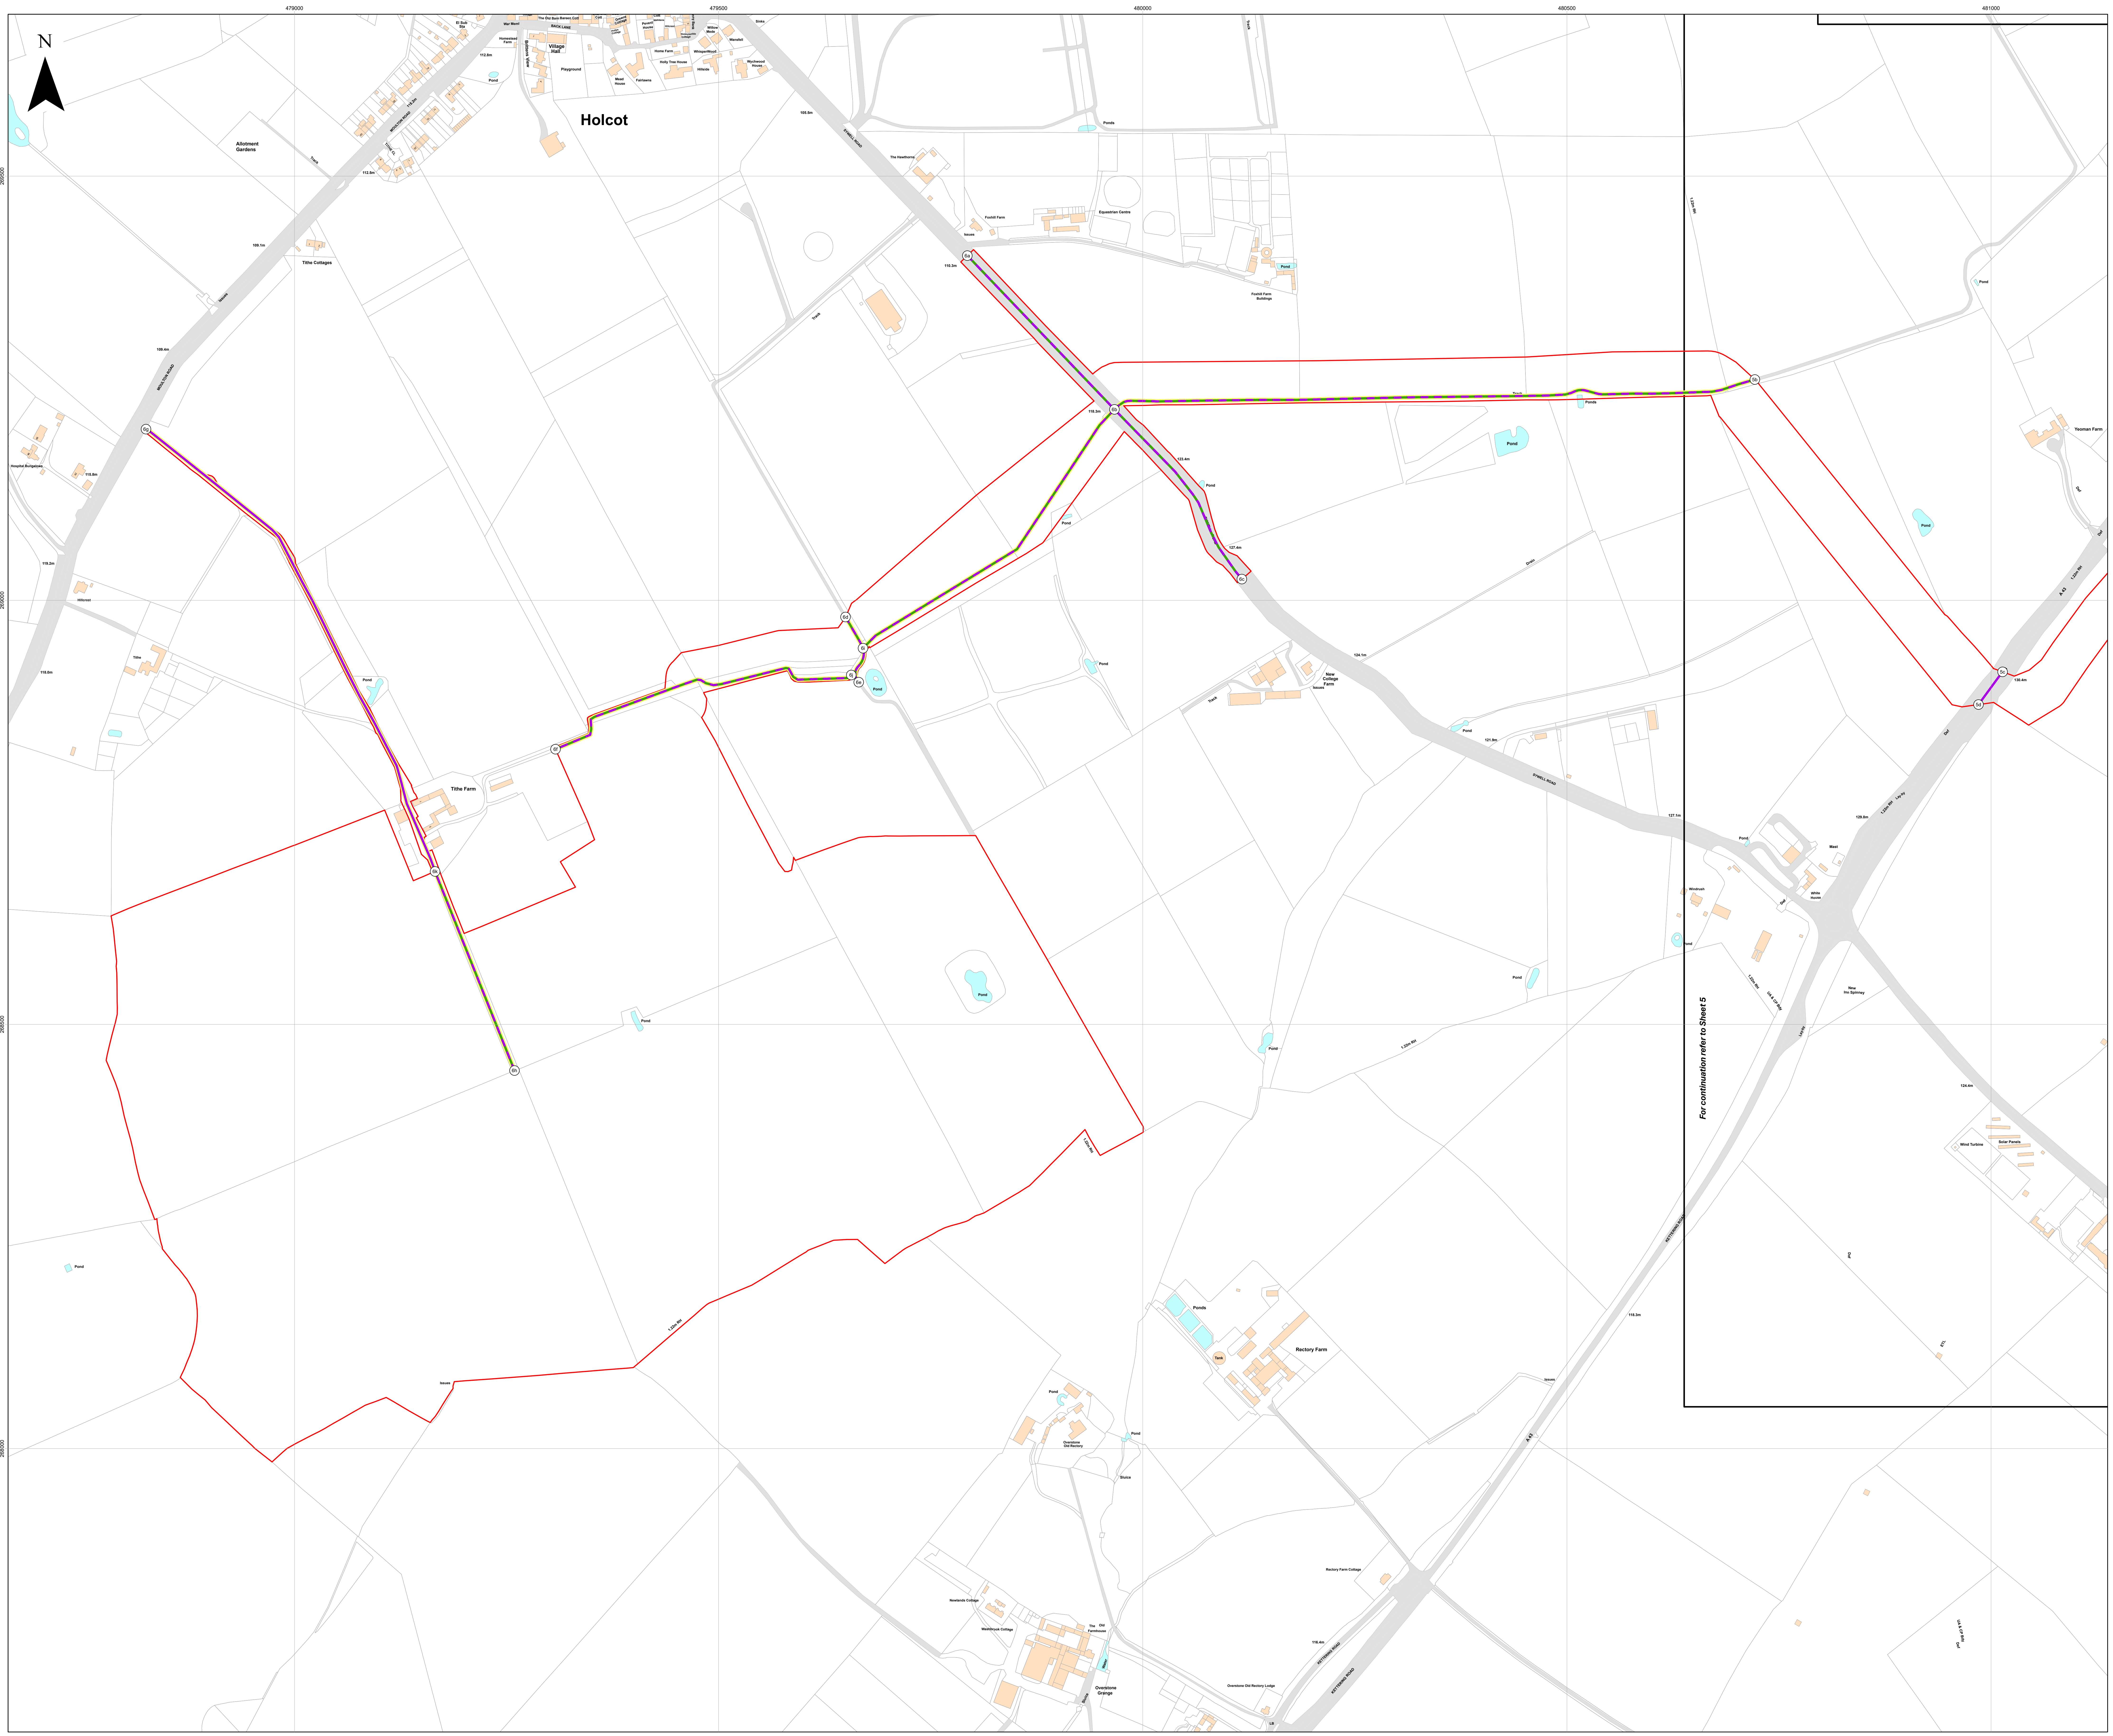
N
Holcot
Allotment Gardens
Tithe Cottages
MOULTON ROAD
109.4m
115.8m
119.2m
Hillcrest
Tithe
Tithe Farm
Pond
Track
Foxhill Farm Buildings
Equestrian Centre
118.3m
123.4m
127.4m
New College Farm
Issues
Yeoman Farm
Rectory Farm
Ponds
Tank
6b
6c
6d
6e
6f
6g
6h
6i
6j
6k
For continuation refer to Sheet 5
479000
479500
480000
480500
481000
269500
269000
268500
268000

Island GREEN POWER

Lanpro

Key

- 🟥 Order Limits
- ▭ Sheet Index
- ○ Reference point within schedule
- Private street with use temporarily suspended or restricted
- Private access and street works / Private access subject to traffic regulation measures
- Street with use temporarily suspended or restricted
- Street works / Street subject to traffic regulation measures

Layers: Lanpro, 2025; IGP, 2025
Base map: Reproduced from Ordnance Survey digital map data © Crown copyright 2025. All rights reserved. License number 0100031673

0 100 200 300 Meters

Scale: 1:2,500@ A0

APFP Regulation: 5(2)(j)	Application Doc No. CR1/GH2.5_B
Ref: P3535_LPR_ZZ_XX_DR_Z_0281	Date: 05/11/2025
Drawn by: BH	Checked by: JC

Streets Plan (Change Application Version)

Sheet 6 of 18
Revision B

GREEN HILL SOLAR FARM

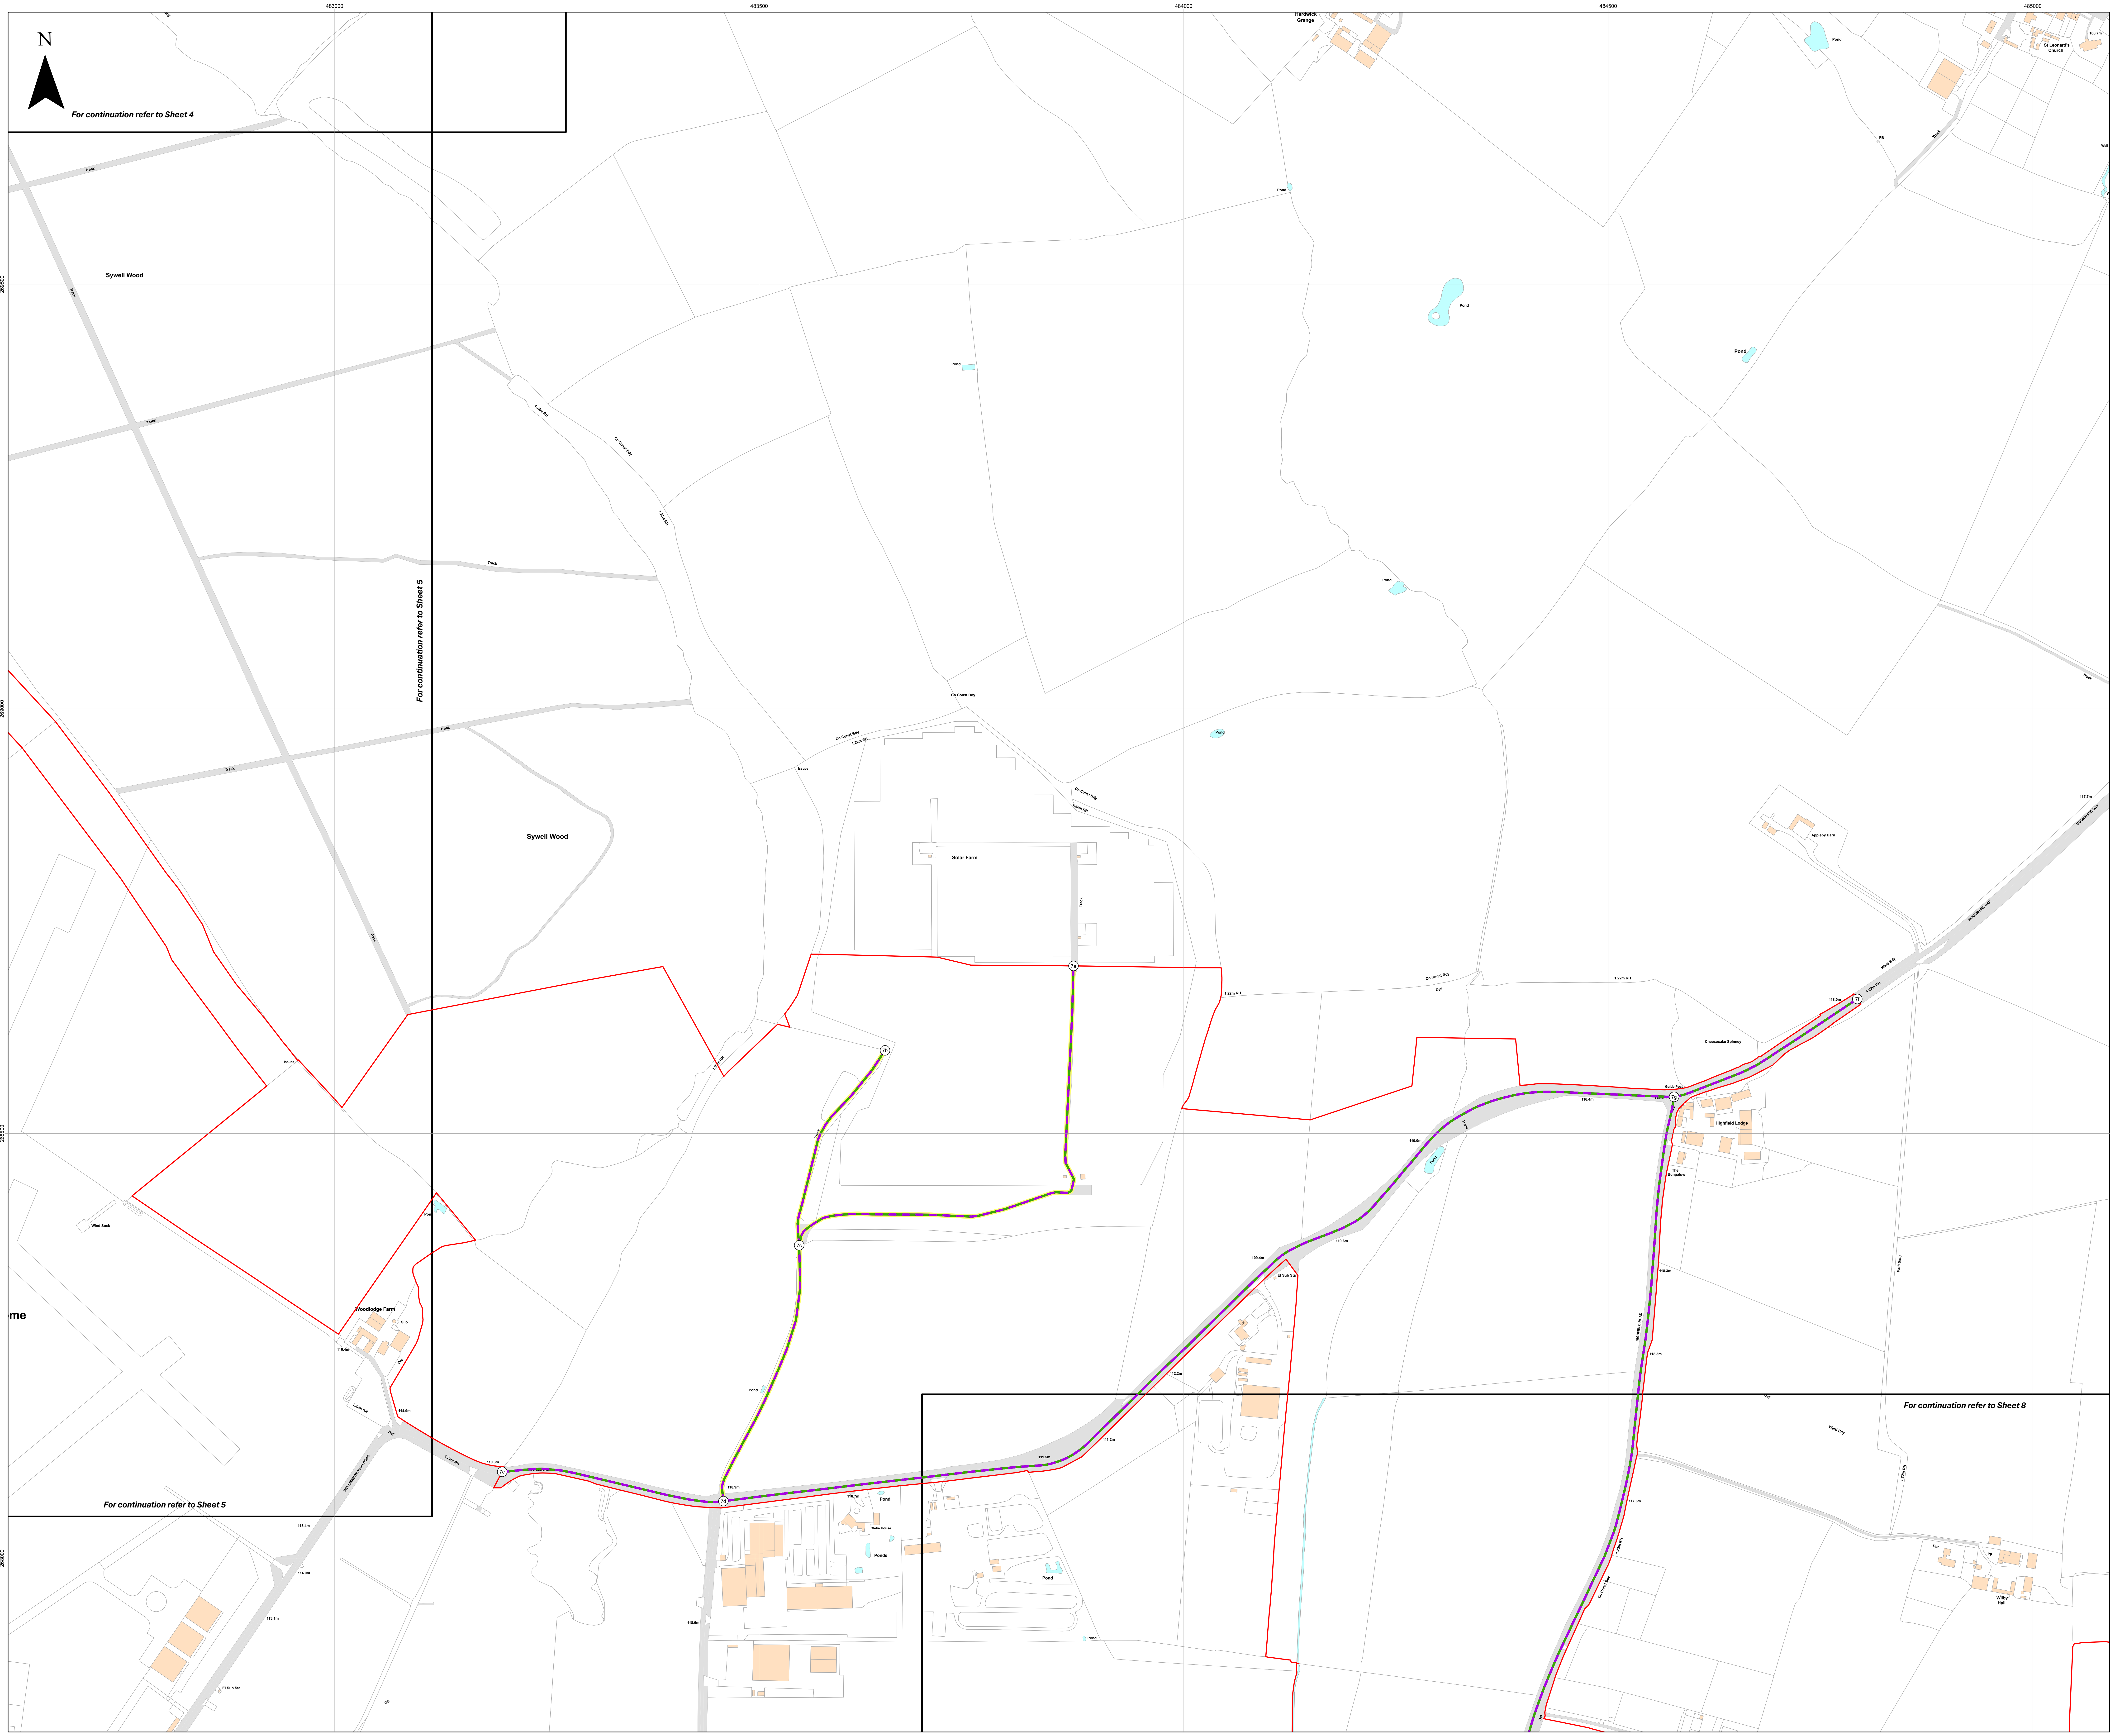
N
For continuation refer to Sheet 4
For continuation refer to Sheet 5
For continuation refer to Sheet 5
For continuation refer to Sheet 8
483000
483500
484000
484500
485000
Sywell Wood
Sywell Wood
Track
Solar Farm
Hardwick Grange
St Leonard's Church
Pond
Appleby Barn
Cheesecake Spinney
Guide Post
Highfield Lodge
The Bungalow
Woodlodge Farm
Silo
Wind Sock
WELLINGBOROUGH ROAD
Ward Bdy
1.22m RH
Def
Path (um)
Ponds
Wilby Hall
7a
7b
7c
7d
7e
7f
7g
116.4m
118.0m
118.3m
118.9m
118.6m
114.9m
110.3m
113.4m
114.0m
113.1m
112.2m
Pond

Island GREEN POWER

Lanpro

Key

- ▭ Order Limits
- ▭ Sheet Index
- ○ Reference point within schedule
- 🟩 Private street with use temporarily suspended or restricted
- 🟪 Private access and street works / Private access subject to traffic regulation measures
- 🟩 Street with use temporarily suspended or restricted
- 🟪 Street works / Street subject to traffic regulation measures

Layers: Lanpro, 2025; IGP, 2025
Base map: Reproduced from Ordnance Survey digital map data © Crown copyright 2025. All rights reserved. License number 0100031673

0 100 200 300 Meters

Scale: 1:2,500@ A0

APFP Regulation: 5(2)(j)	Application Doc No. CR1/GH2.5_B
Ref: P3535_LPR_ZZ_XX_DR_Z_0281	Date: 05/11/2025
Drawn by: BH	Checked by: JC

Streets Plan (Change Application Version)

Sheet 7 of 18
Revision B

GREEN HILL SOLAR FARM

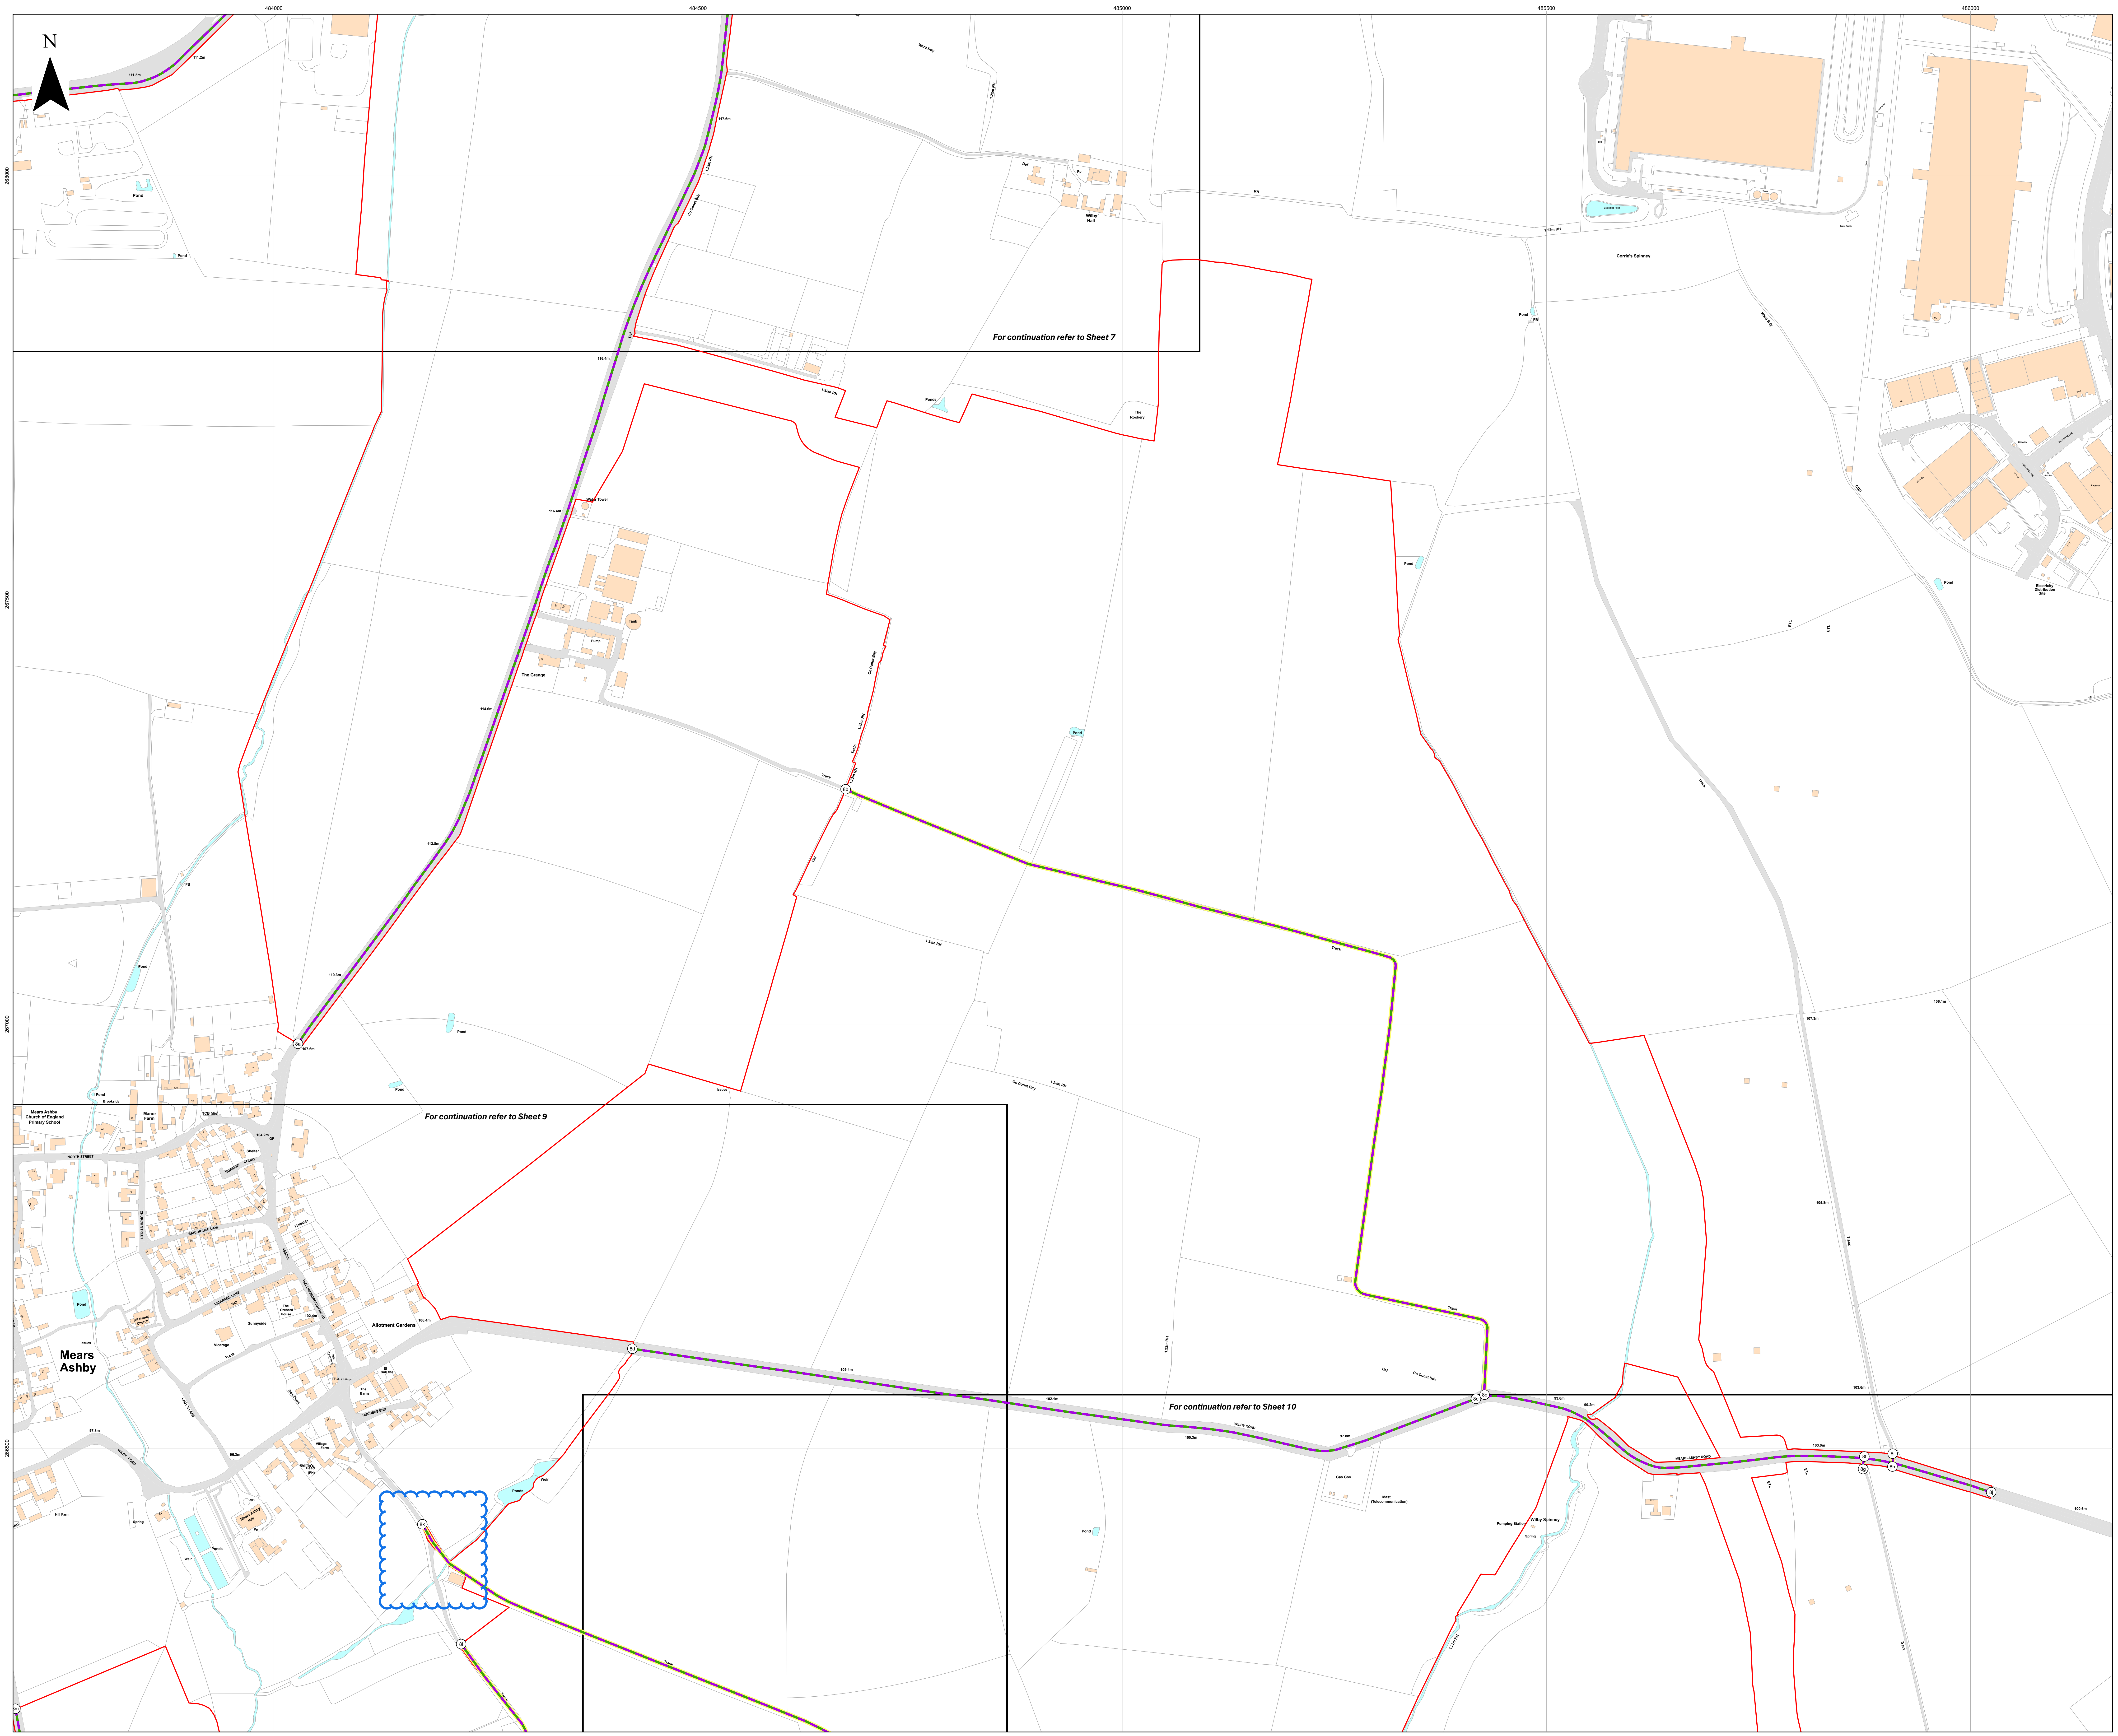
N
484000
484500
485000
485500
486000
268000
267500
267000
266500
For continuation refer to Sheet 7
For continuation refer to Sheet 9
For continuation refer to Sheet 10
Mears Ashby
The Grange
Allotment Gardens
Wilby Spinney
Corrie's Spinney
Pond

Island GREEN POWER

Lanpro

Key

- 🟥 Order Limits
- ▭ Sheet Index
- ○ Reference point within schedule
- Private street with use temporarily suspended or restricted
- Private access and street works / Private access subject to traffic regulation measures
- Street with use temporarily suspended or restricted
- Street works / Street subject to traffic regulation measures

Layers: Lanpro, 2025; IGP, 2025
Base map: Reproduced from Ordnance Survey digital map data © Crown copyright 2025. All rights reserved. License number 0100031673

0 100 200 300 Meters

Scale: 1:2,500@ A0

APFP Regulation: 5(2)(j)	Application Doc No. CR1/GH2.5_B
Ref: P3535_LPR_ZZ_XX_DR_Z_0281	Date: 05/11/2025
Drawn by: BH	Checked by: JC

Streets Plan (Change Application Version)

Sheet 8 of 18
Revision B

GREEN HILL SOLAR FARM

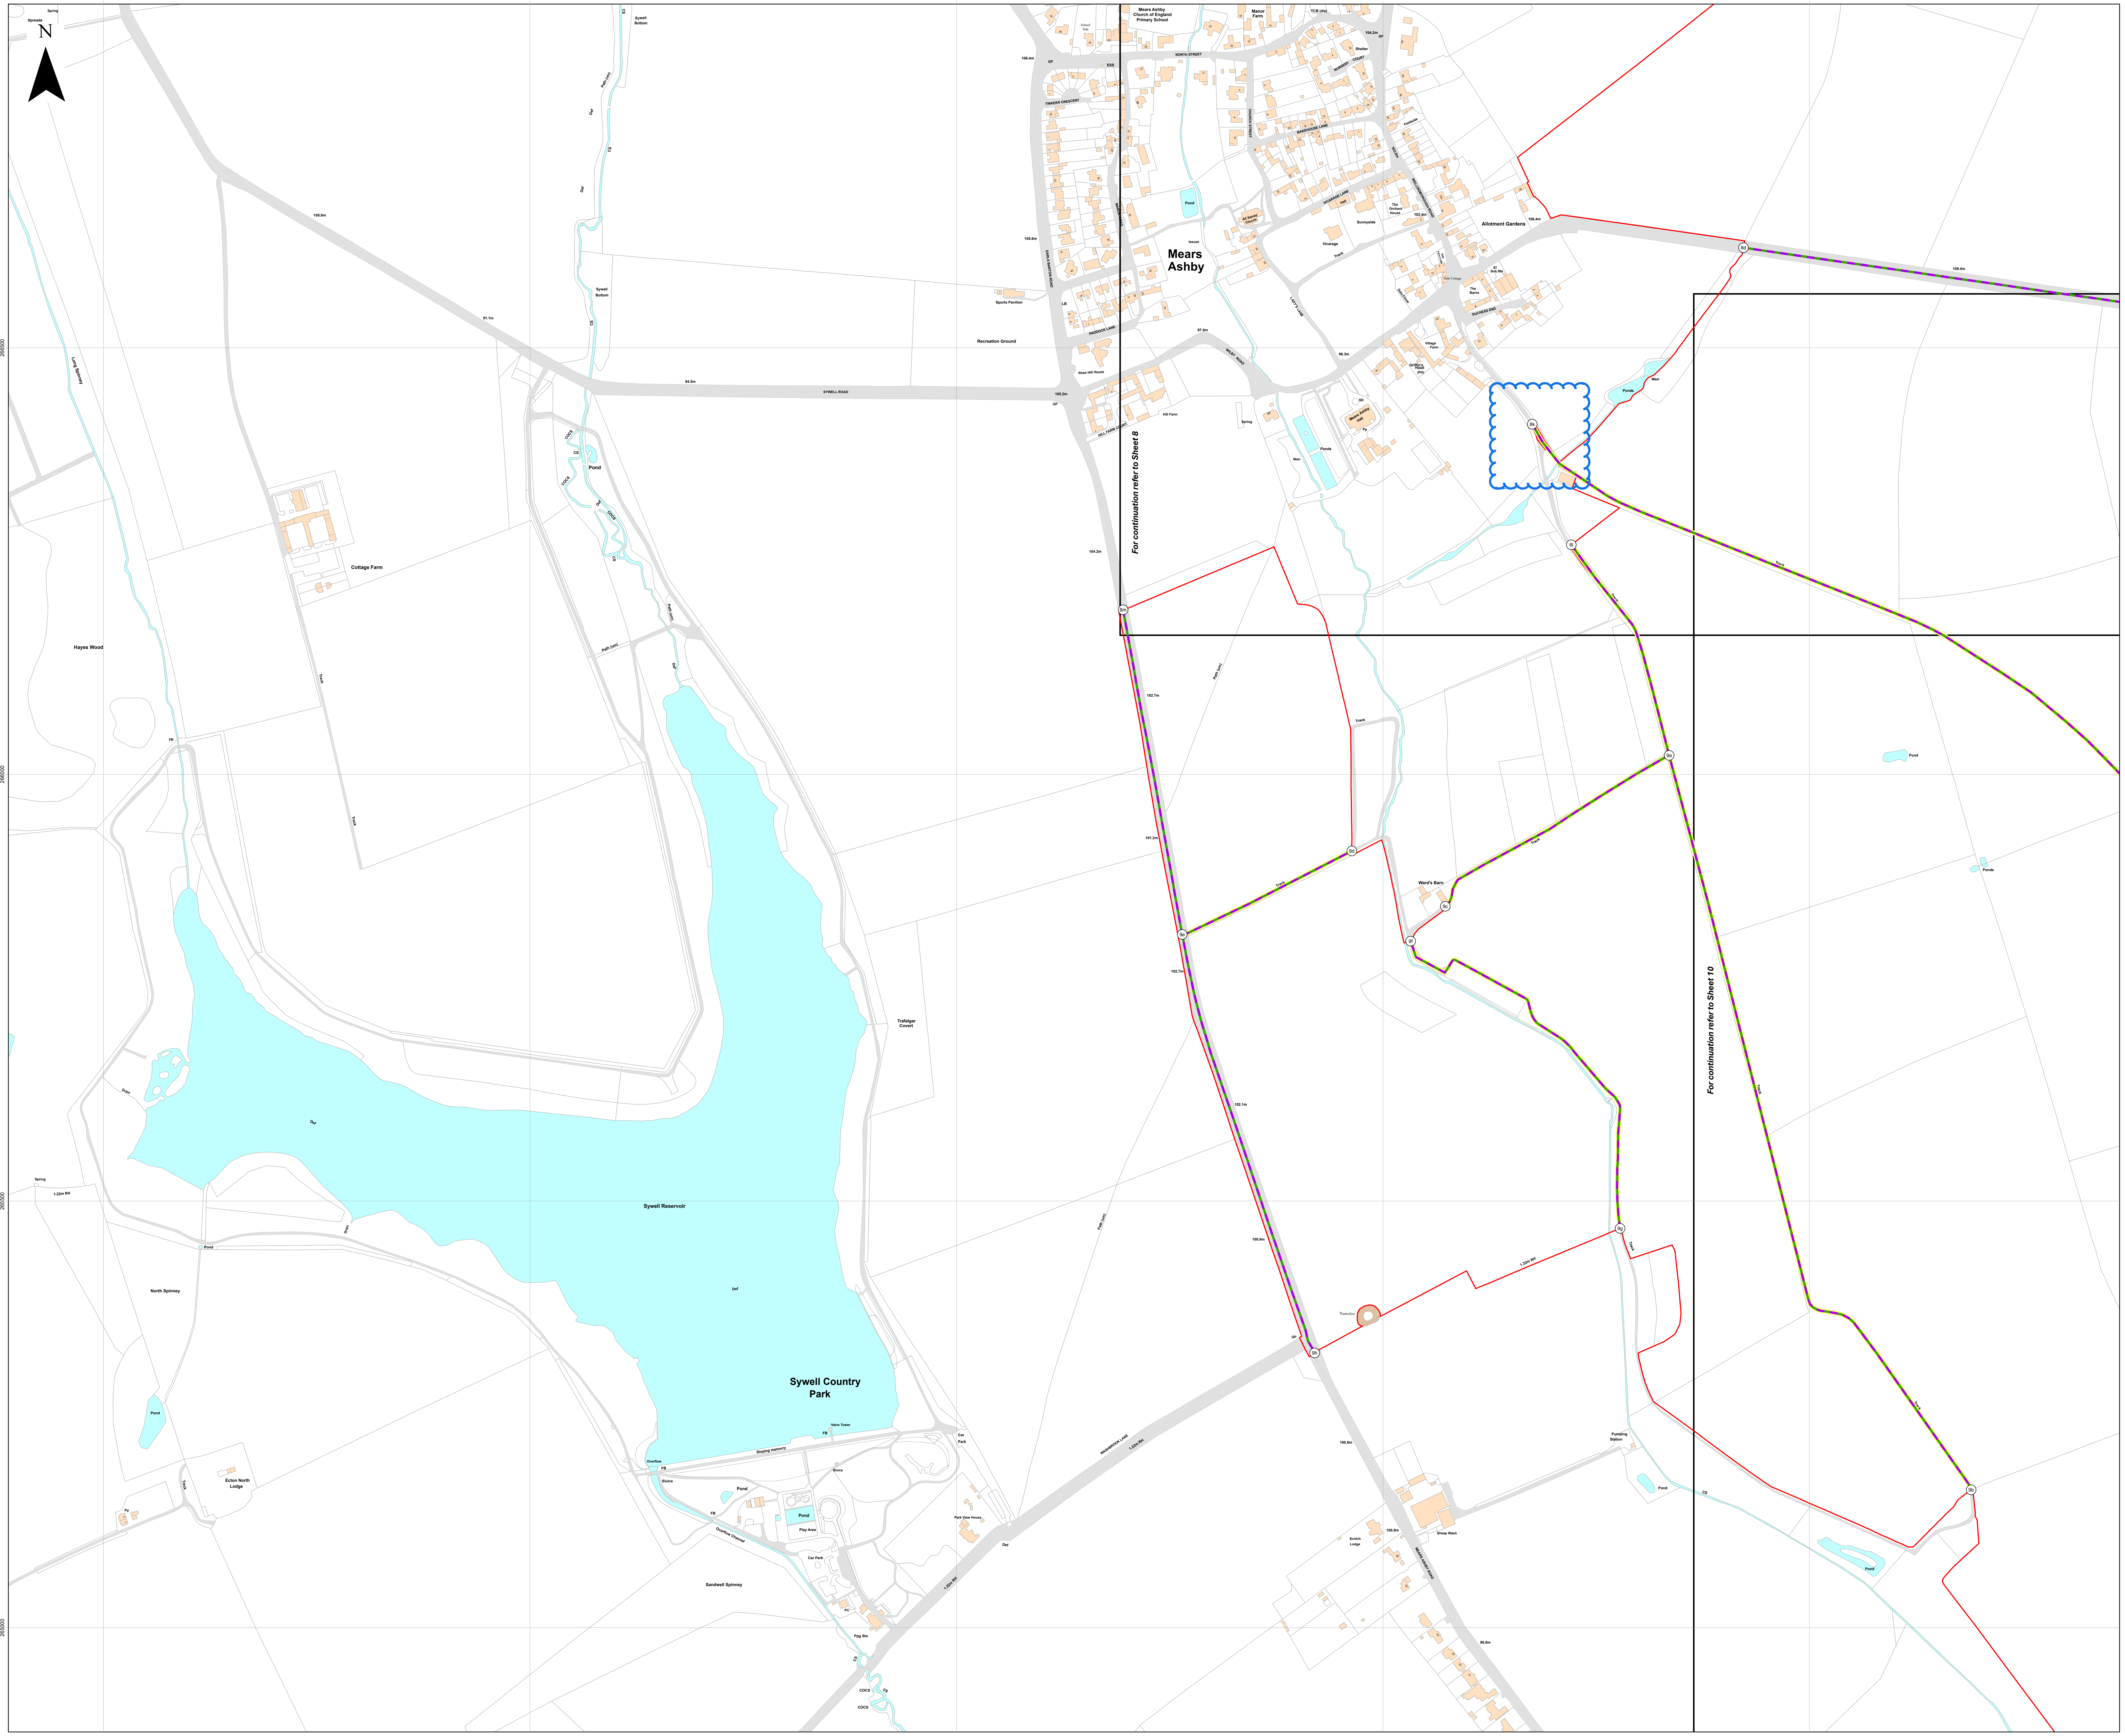
482500
483000
483500
484000
484500
N
Mears Ashby
Allotment Gardens
Duchess End
The Barns
Dale Cottage
El Sub Sta
Ponds
Weir
Recreation Ground
Cottage Farm
Hayes Wood
Pond
Sywell Reservoir
Sywell Country Park
Trafalgar Covert
North Spinney
Ecton North Lodge
Sandwell Spinney
Ward's Barn
Track
Path (um)
Tumulus
1.22m RH
Pumping Station
Pond
Sheep Wash
Scotch Lodge
MEARS ASHBY ROAD
For continuation refer to Sheet 8
For continuation refer to Sheet 10
8d
8k
8l
8m
9a
9b
9c
9d
9e
9f
9g
9h

Key

- 🟥 Order Limits
- ⬛ Sheet Index
- ○ Reference point within schedule
- Private street with use temporarily suspended or restricted
- Private access and street works / Private access subject to traffic regulation measures
- Street with use temporarily suspended or restricted
- Street works / Street subject to traffic regulation measures

Layers: Lanpro, 2025; IGP, 2025

Base map: Reproduced from Ordnance Survey digital map data © Crown copyright 2025. All rights reserved. License number 0100031673

0 100 200 300 Meters

Scale: 1:2,500@ A0

APFP Regulation: 5(2)(j)	Application Doc No. CR1/GH2.5_B
Ref: P3535_LPR_ZZ_XX_DR_Z_0281	Date: 05/11/2025
Drawn by: BH	Checked by: JC

Streets Plan (Change Application Version)

Sheet 9 of 18

Revision B

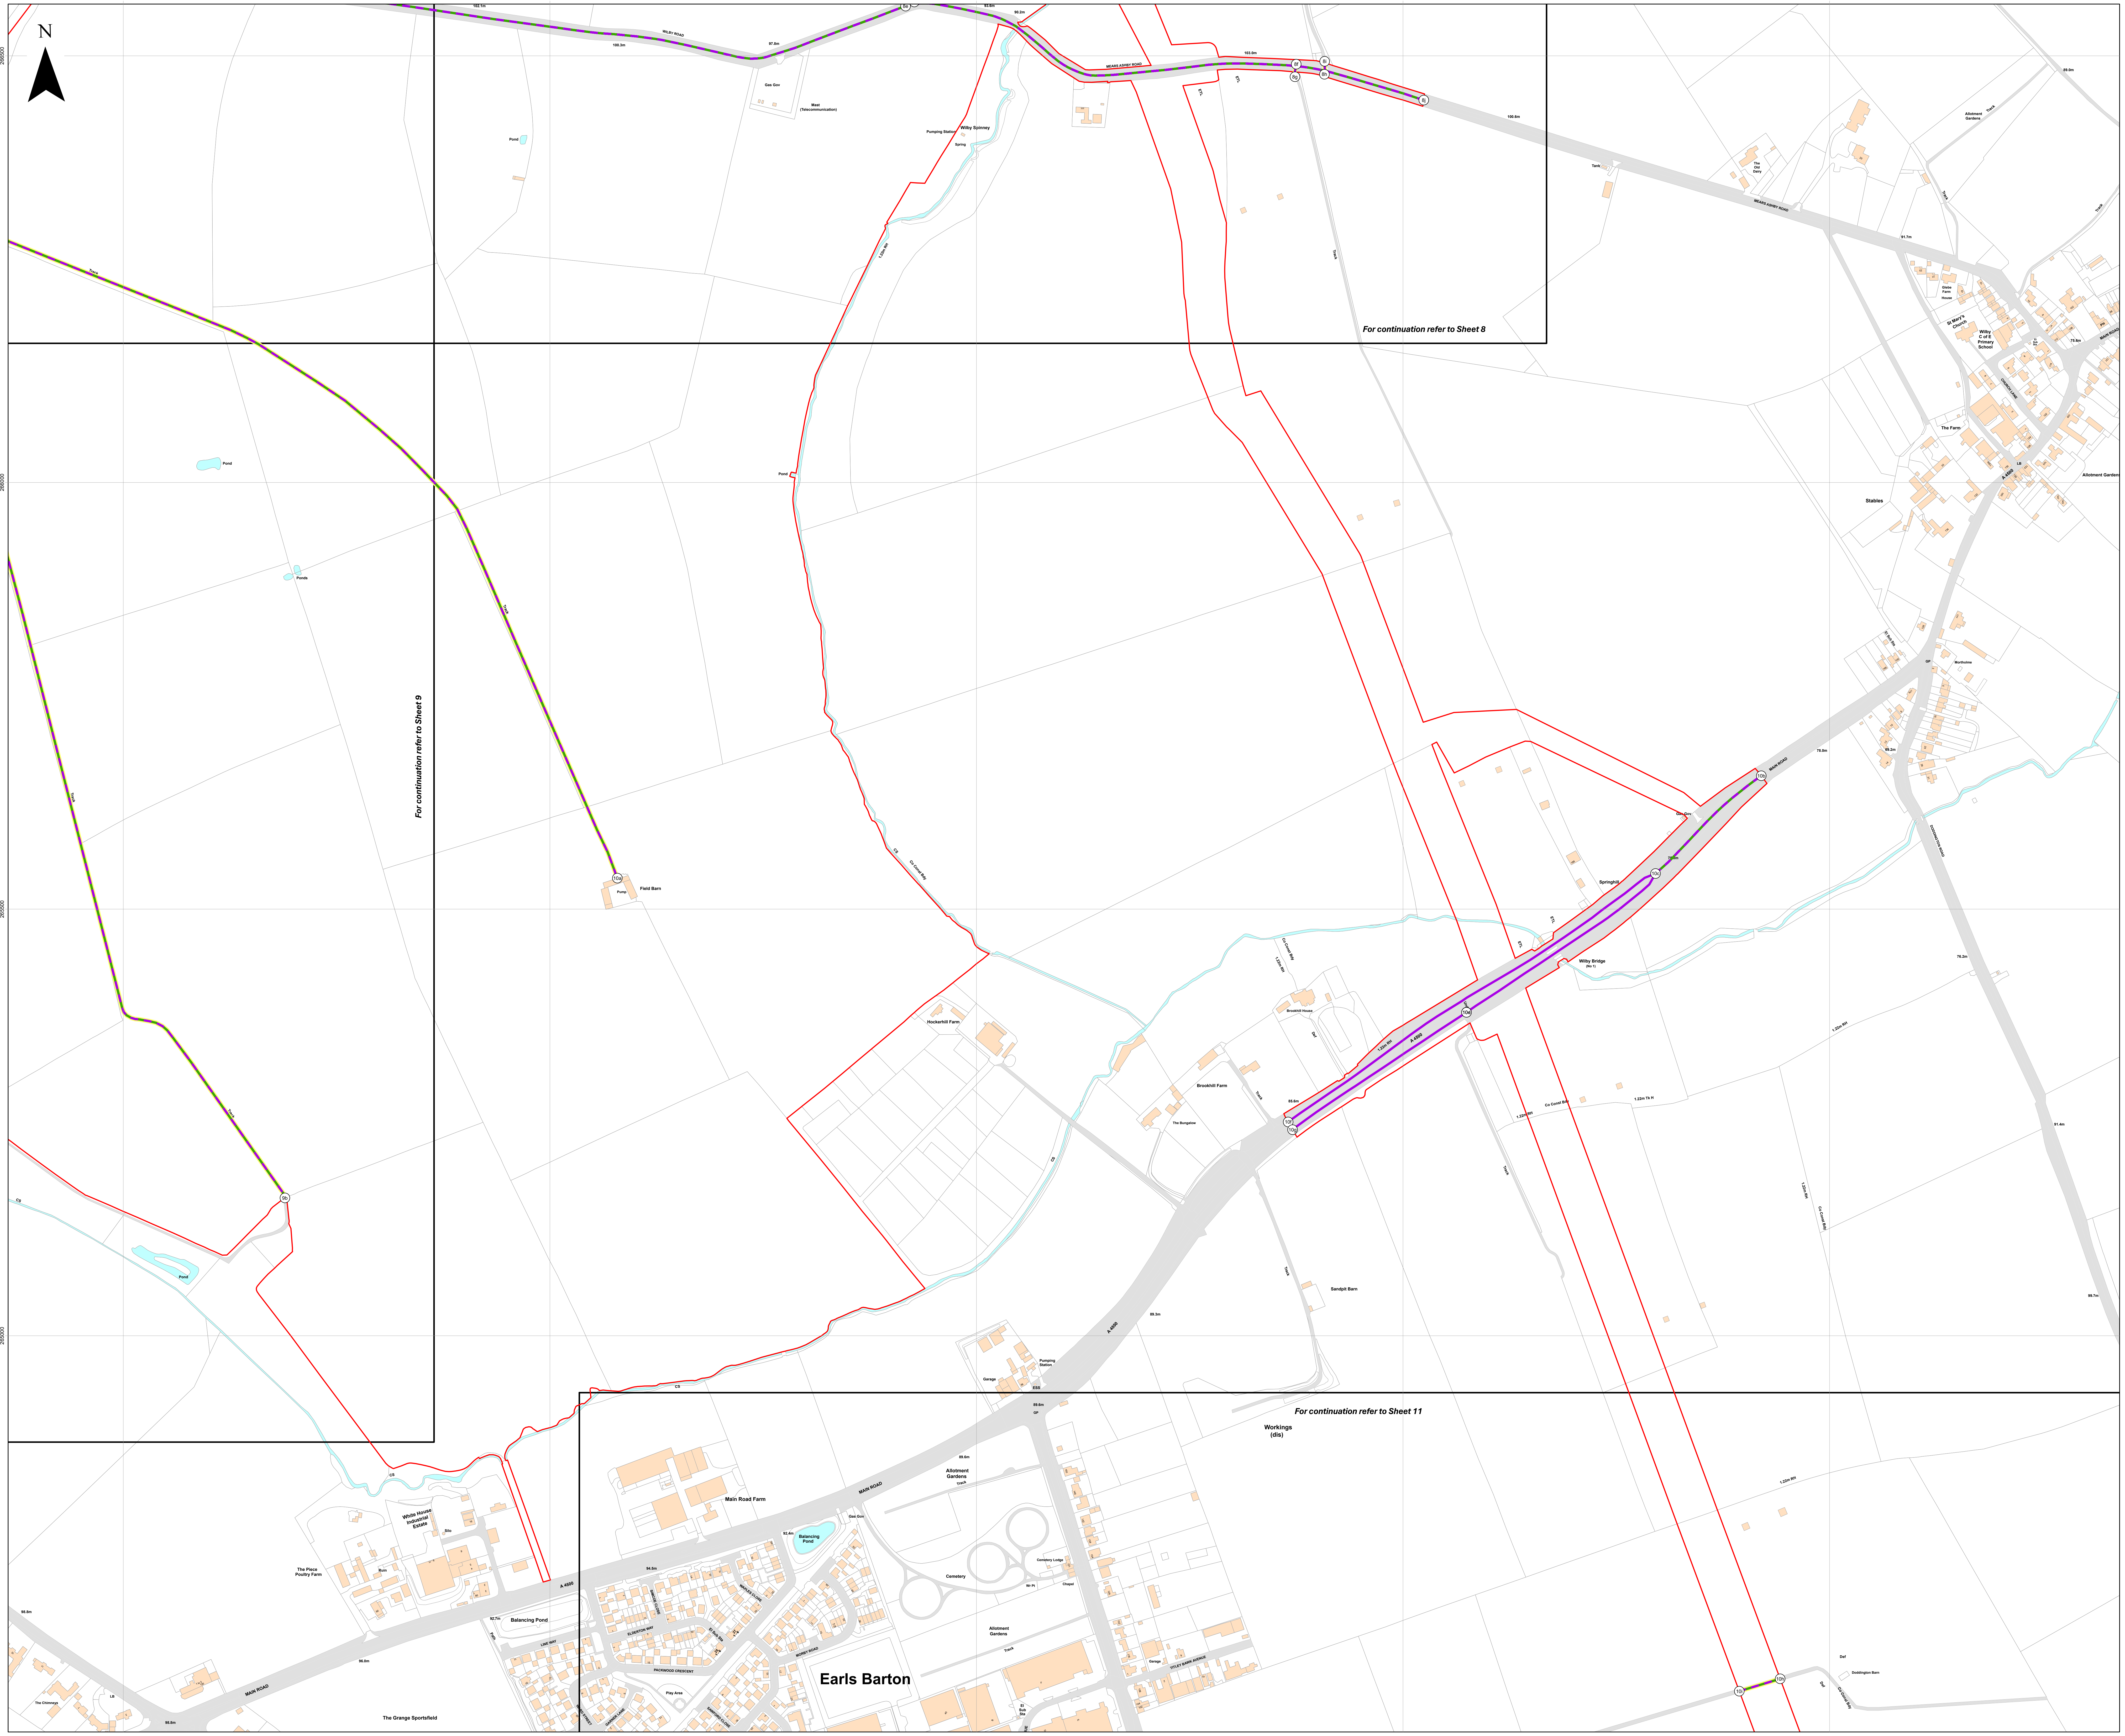
N
484500
485000
485500
486000
486500
For continuation refer to Sheet 8
For continuation refer to Sheet 9
For continuation refer to Sheet 11
Fold Barn
Hockerhill Farm
Brookhill Farm
Springfield
Wilby Bridge
Sandpit Barn
Workings (dis)
Stables
The Farm
Main Road Farm
Allotment Gardens
Cemetery
Balancing Pond
Earls Barton
MAIN ROAD
A 4500
The Grange Sportsfield

Key

- ▭ Order Limits
- ▭ Sheet Index
- ○ Reference point within schedule
- Private street with use temporarily suspended or restricted
- Private access and street works / Private access subject to traffic regulation measures
- Street with use temporarily suspended or restricted
- Street works / Street subject to traffic regulation measures

Layers: Lanpro, 2025; IGP, 2025

0 100 200 300 Meters

Scale: 1:2,500@ A0

APFP Regulation: 5(2)(j)	Application Doc No. CR1/GH2.5_B
Ref: P3535_LPR_ZZ_XX_DR_Z_0281	Date: 05/11/2025
Drawn by: BH	Checked by: JC

Streets Plan (Change Application Version)

Sheet 10 of 18

Revision B

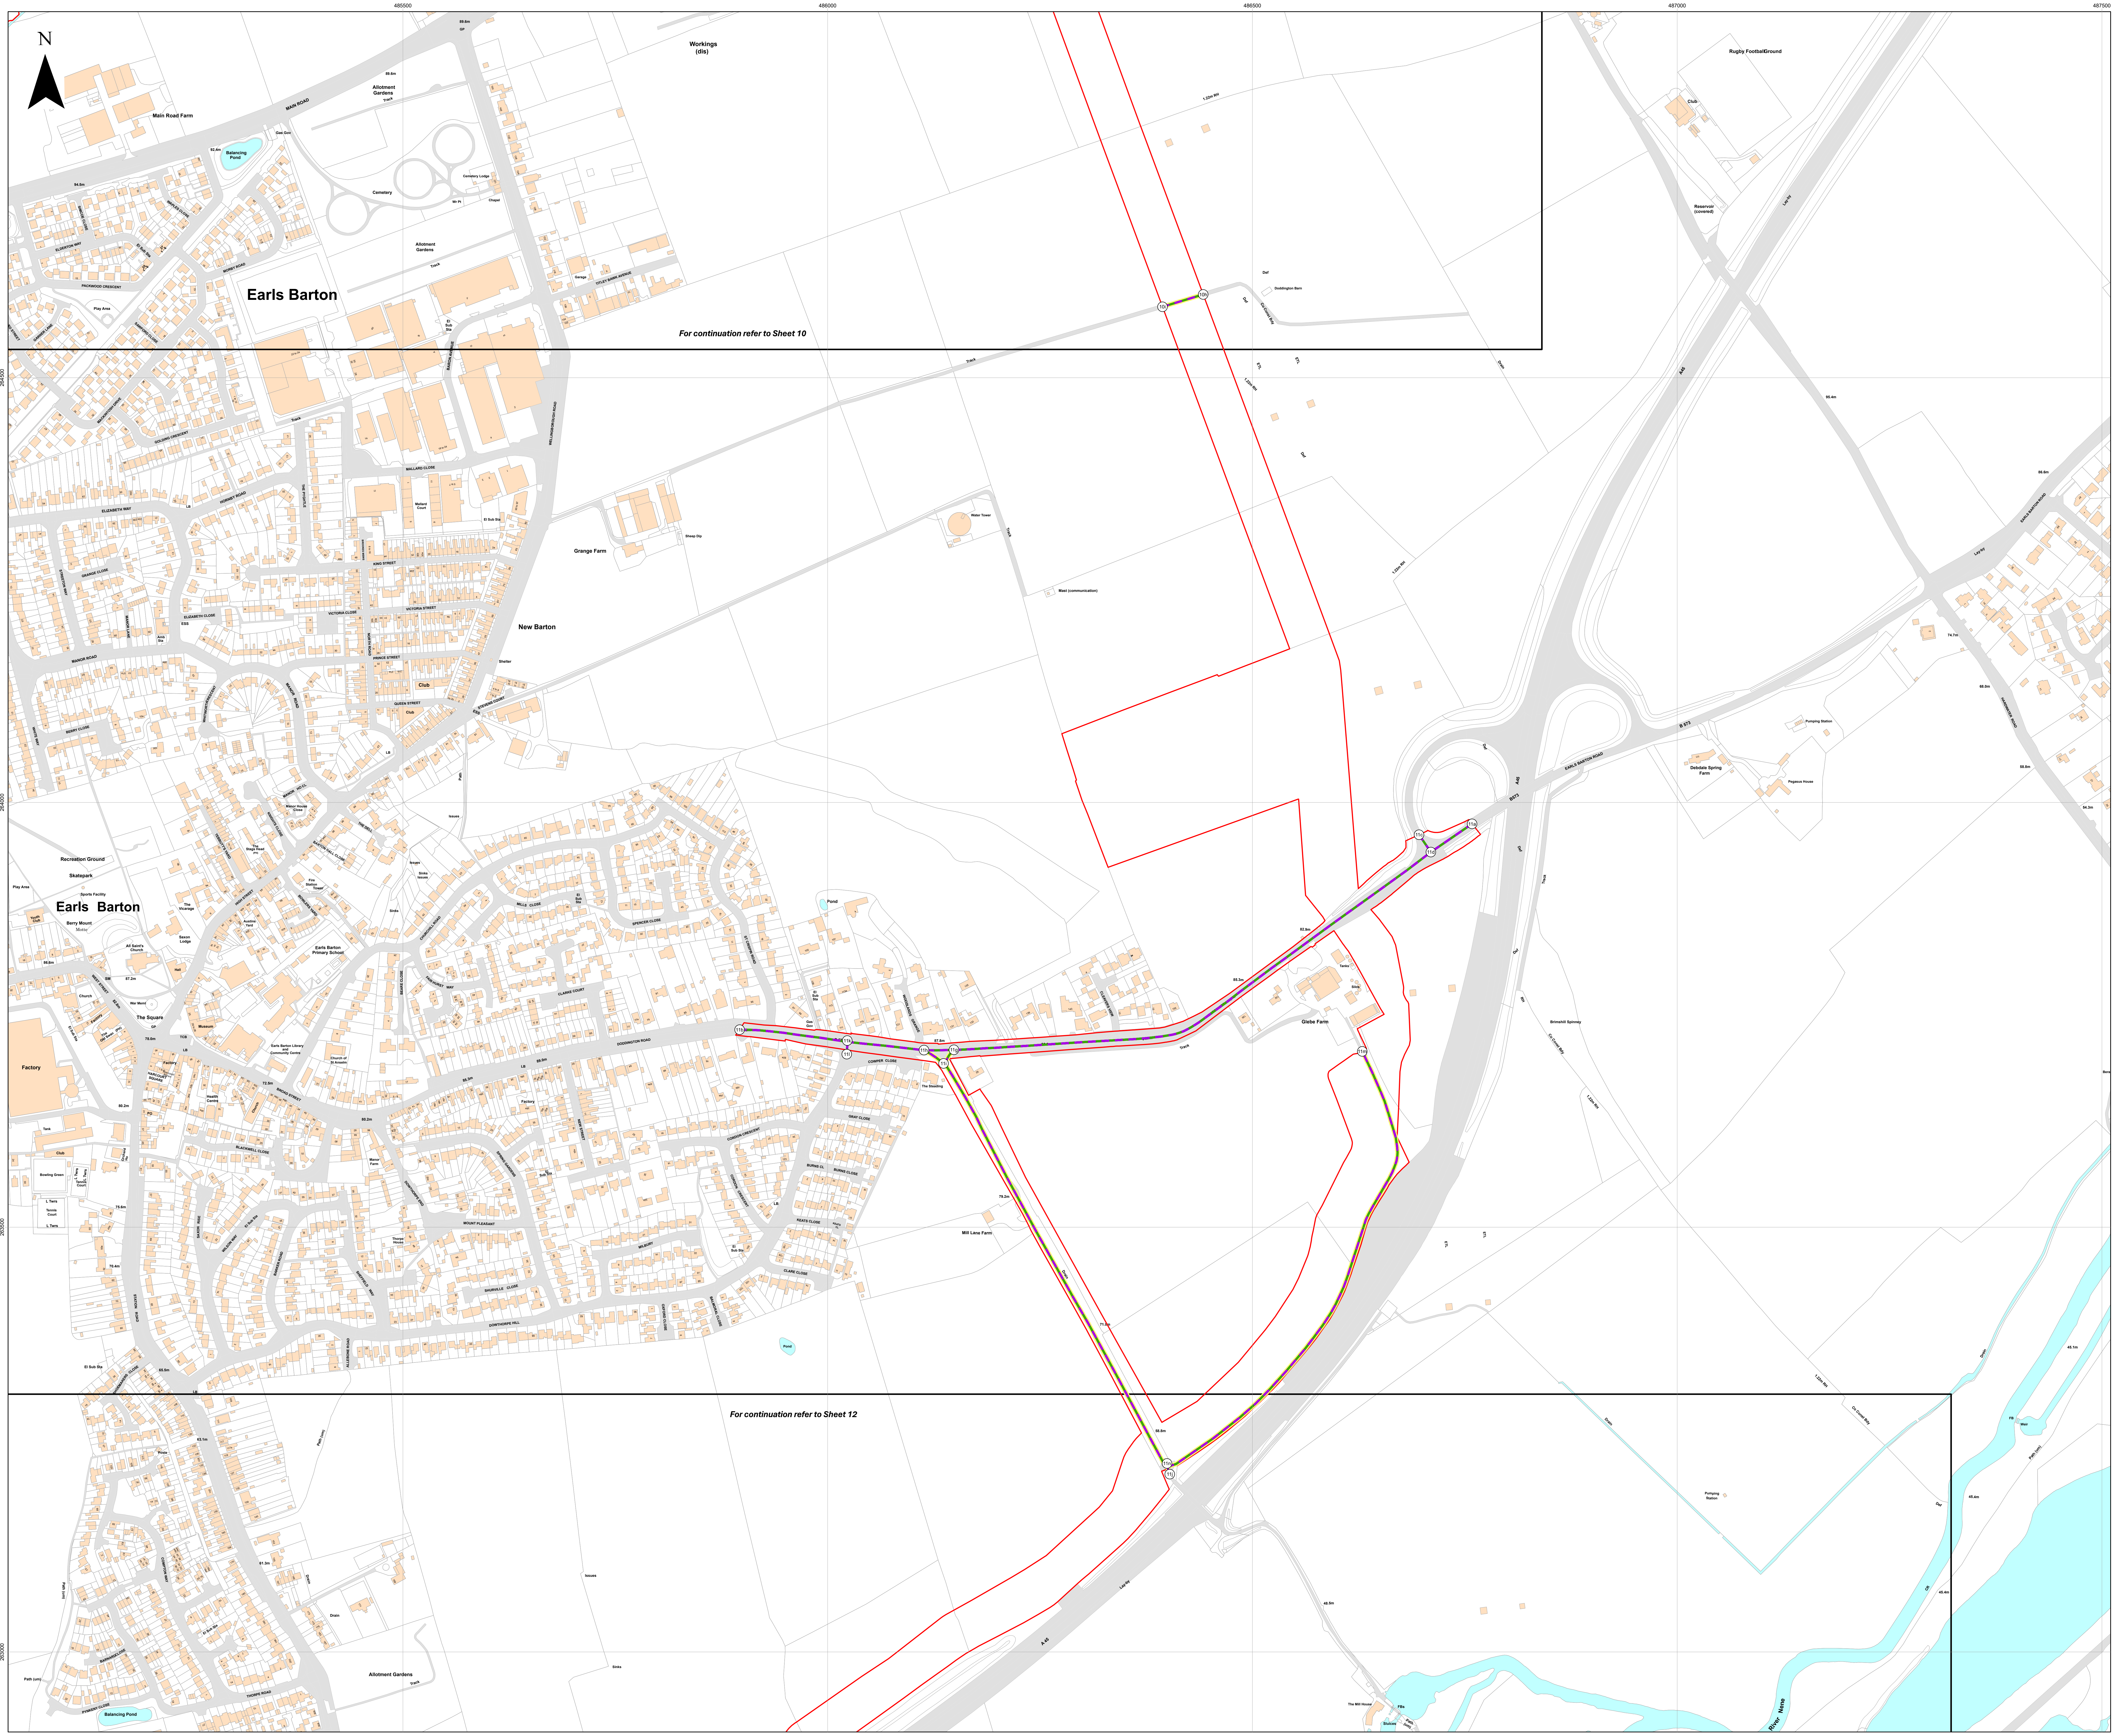
485500
486000
486500
487000
487500
264500
264000
263500
263000
N
Earls Barton
Earls Barton
New Barton
Grange Farm
Glebe Farm
Mill Lane Farm
Main Road Farm
Debdale Spring Farm
Rugby Football Ground
MAIN ROAD
DODDINGTON ROAD
ST CRISPIN ROAD
WOODLANDS GRANGE
COWPER CLOSE
GRAY CLOSE
CORDON CRESCENT
The Steading
Tanks
Silos
A45
B573
EARLS BARTON ROAD
River Nene
87.8m
58.8m
1.22m RH
Def
ETL
10h
10i
11a
11b
11c
11d
11g
11h
11i
11j
11k
11l
11m
11n
For continuation refer to Sheet 10
For continuation refer to Sheet 12

Island GREEN POWER

Lanpro

Key

- 🟥 Order Limits
- ▭ Sheet Index
- ○ Reference point within schedule
- ▬ Private street with use temporarily suspended or restricted
- ▬ Private access and street works / Private access subject to traffic regulation measures
- ▬ Street with use temporarily suspended or restricted
- ▬ Street works / Street subject to traffic regulation measures

Layers: Lanpro, 2025; IGP, 2025

Base map: Reproduced from Ordnance Survey digital map data License number 0100031673

0 100 200 300 Meters

Scale: 1:2,500@ A0

APFP Regulation: 5(2)(j)	Application Doc No. CR1/GH2.5_B
Ref: P3535_LPR_ZZ_XX_DR_Z_0281	Date: 05/11/2025
Drawn by: BH	Checked by: JC

Streets Plan (Change Application Version)

Sheet 11 of 18

Revision B

GREEN HILL SOLAR FARM

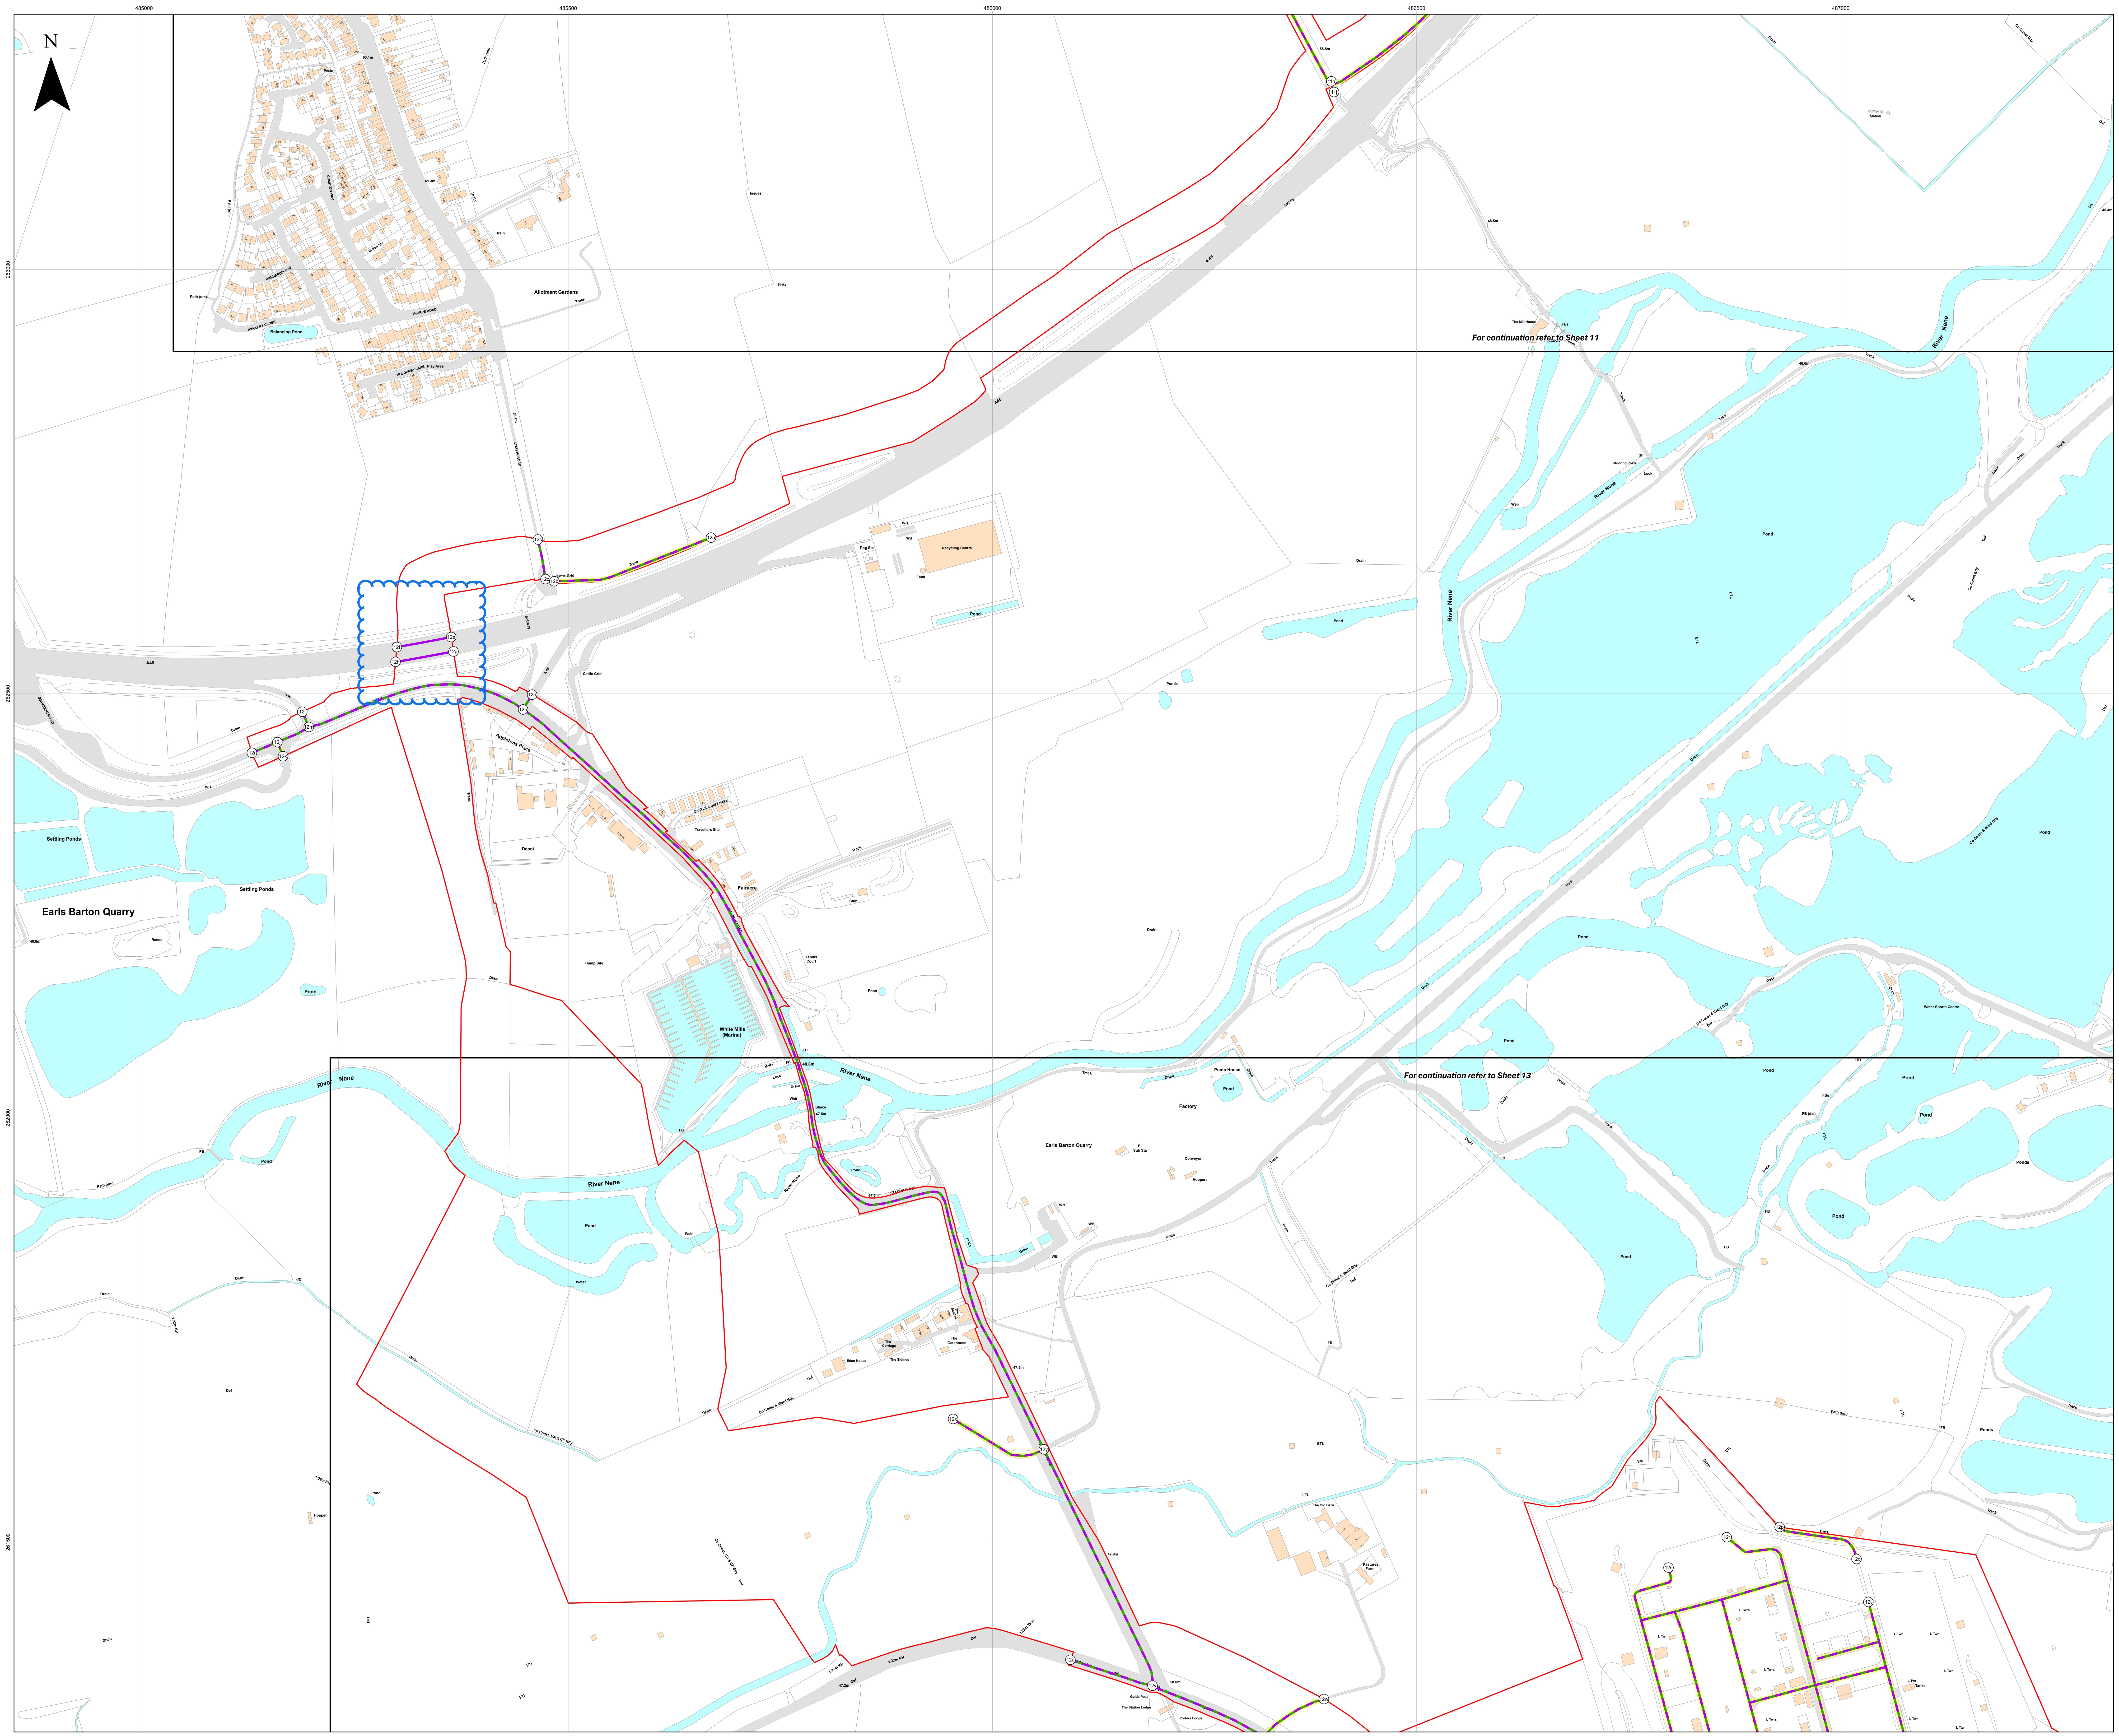
N
485000
485500
486000
486500
487000
263000
262500
262000
261500
A45
Earls Barton Quarry
Settling Ponds
Allotment Gardens
Balancing Pond
Recycling Centre
Depot
Fairacre
Travellers Site
Camp Site
White Mills (Marina)
River Nene
Pond
Factory
Earls Barton Quarry
Pumping Station
Water Sports Centre
For continuation refer to Sheet 11
For continuation refer to Sheet 13

Island GREEN POWER

Lanpro

Key

- 🟥 Order Limits
- ⬛ Sheet Index
- ○ Reference point within schedule
- Private street with use temporarily suspended or restricted
- Private access and street works / Private access subject to traffic regulation measures
- Street with use temporarily suspended or restricted
- Street works / Street subject to traffic regulation measures

Layers: Lanpro, 2025; IGP, 2025

0 100 200 300 Meters

Scale: 1:2,500@ A0

APFP Regulation: 5(2)(j)	Application Doc No. CR1/GH2.5_B
Ref: P3535_LPR_ZZ_XX_DR_Z_0281	Date: 05/11/2025
Drawn by: BH	Checked by: JC

Streets Plan (Change Application Version)

Sheet 12 of 18

Revision B

GREEN HILL SOLAR FARM

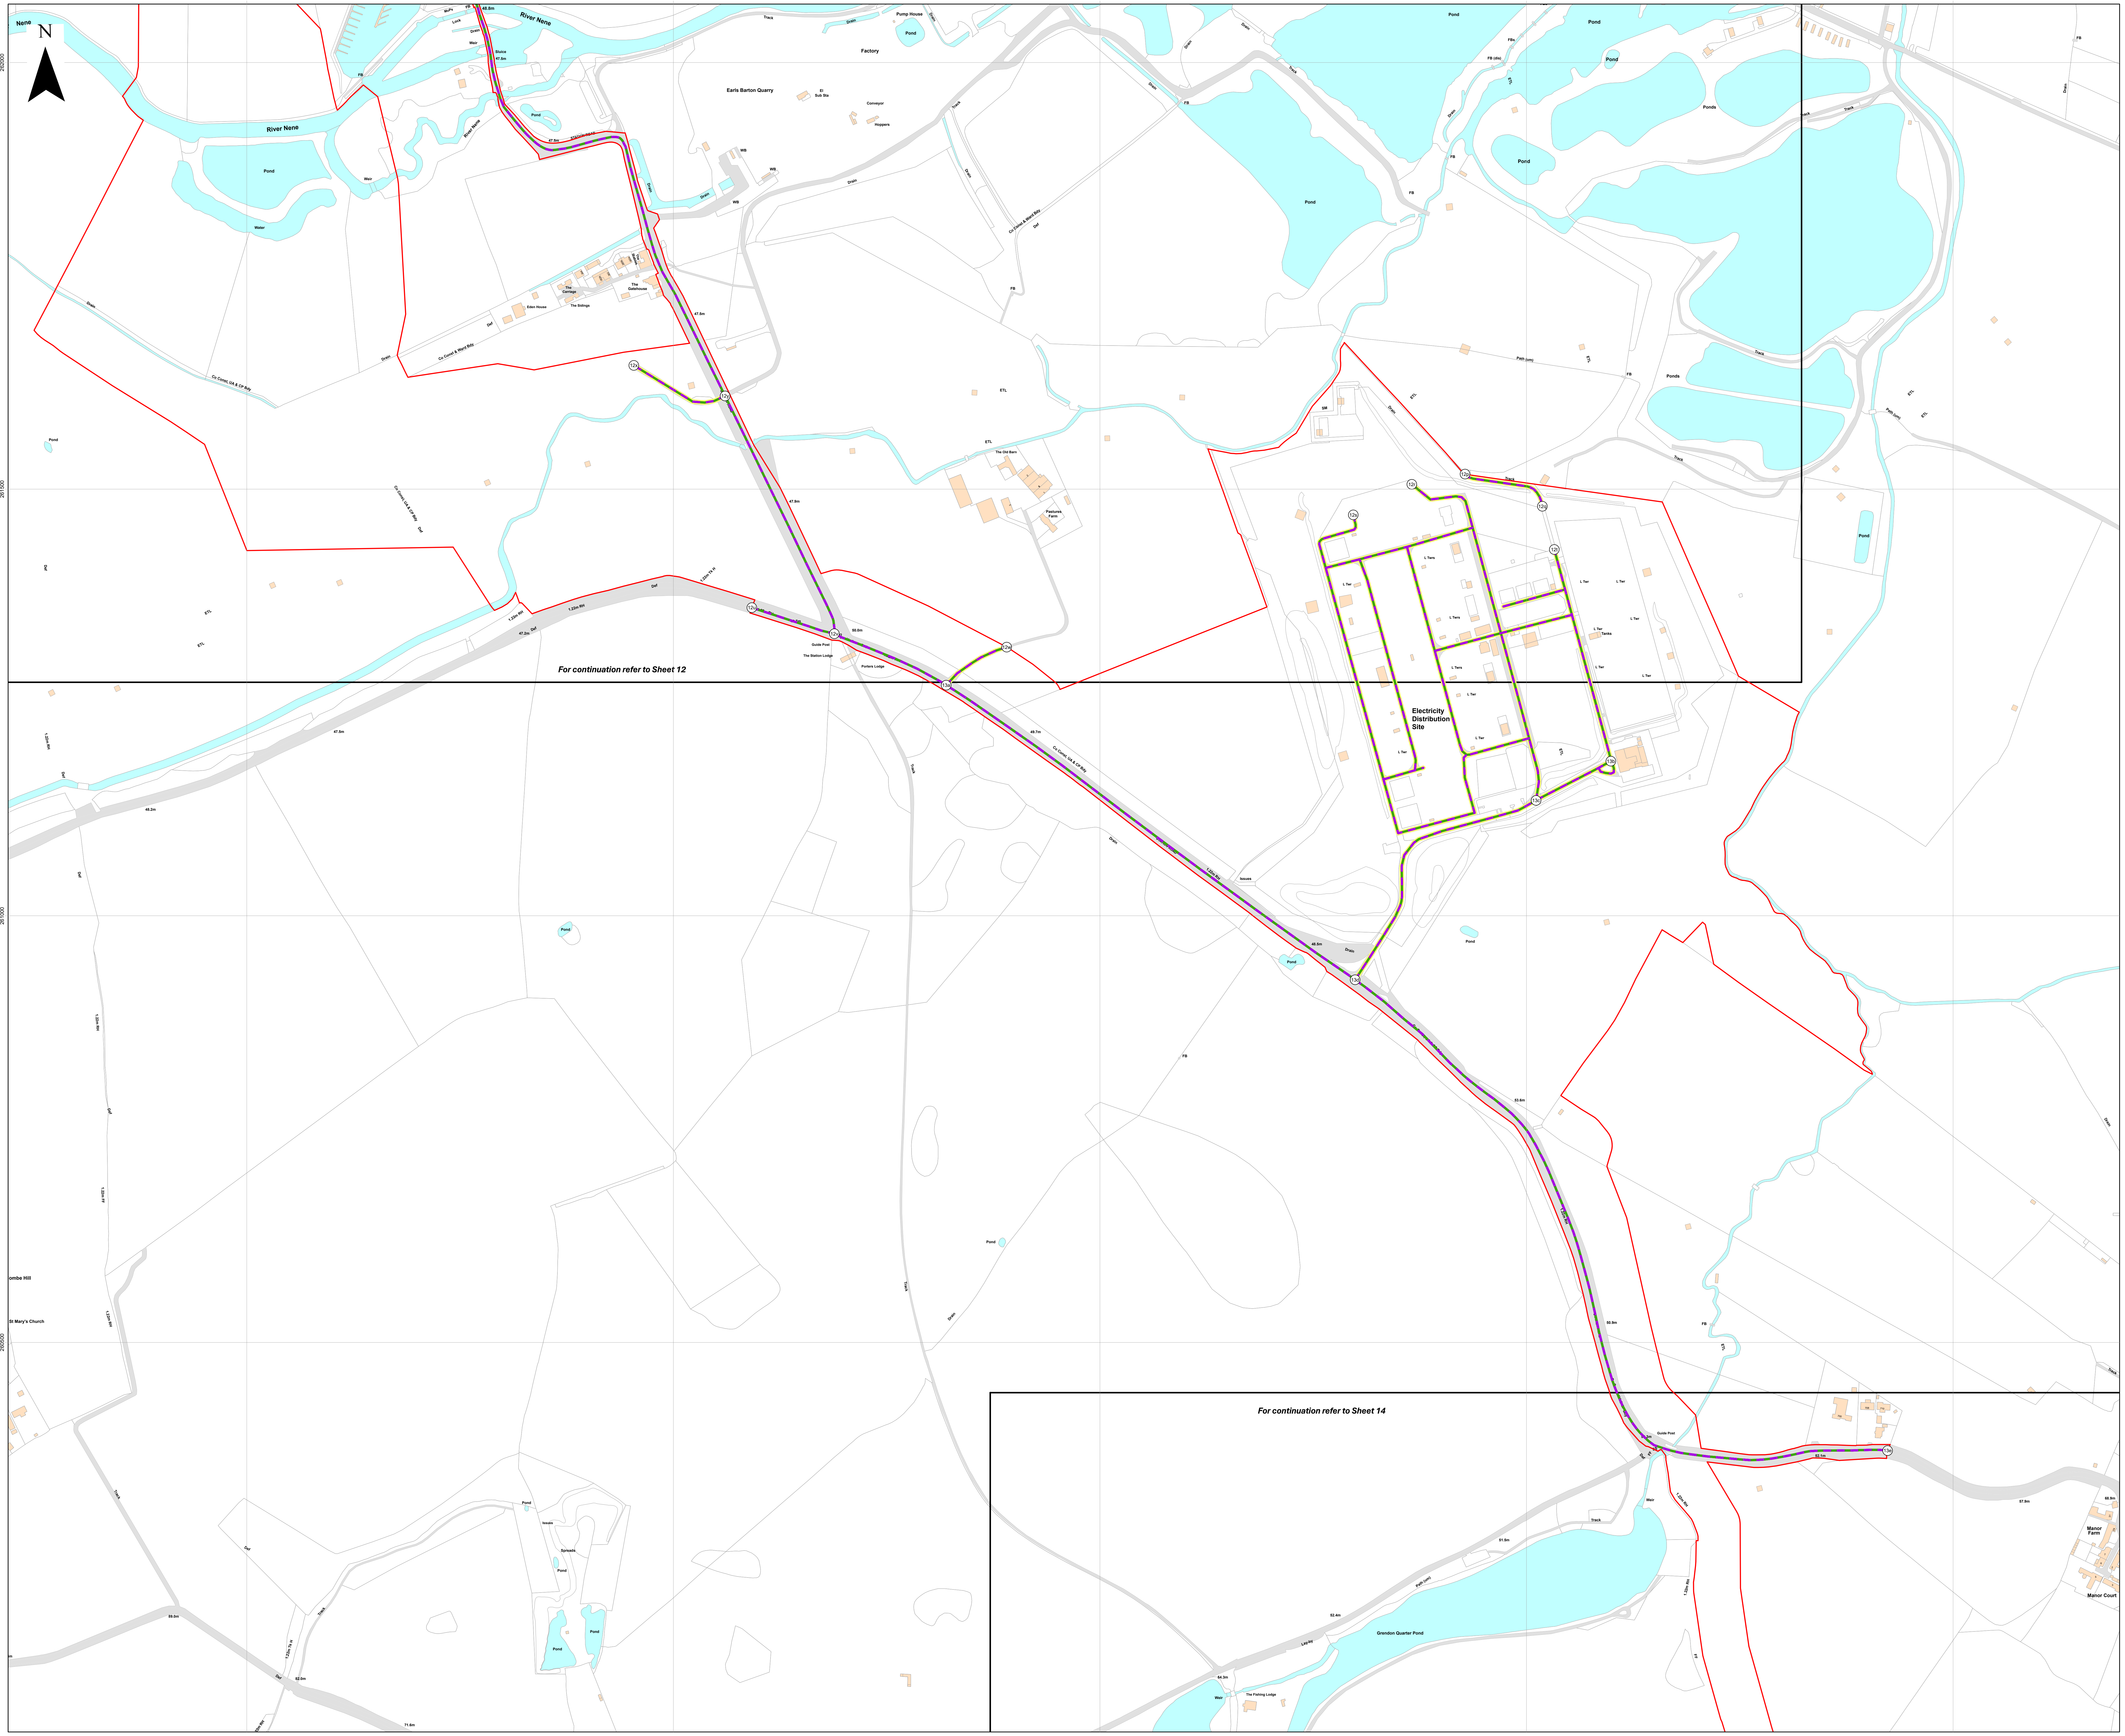
N
485500
486000
486500
487000
487500
261000
261500
261000
260500
River Nene
Earls Barton Quarry
Factory
Pump House
Pond
Ponds
The Gatehouse
The Carriage
The Sidings
The Stables
12x
12y
12u
12v
12w
13a
12p
12q
12r
12s
12t
13b
13c
13d
13e
47.5m
47.9m
50.0m
49.7m
48.5m
50.9m
52.1m
Co Const, UA & CP Bdy
Guide Post
The Station Lodge
Porters Lodge
The Old Barn
Pastures Farm
ETL
FB
Track
Drain
Def
1.22m RH
1.22m Tk H
SM
L Twr
L Twrs
Tanks
Electricity Distribution Site
Issues
Weir
Manor Farm
Manor Court
Grendon Quarter Pond
The Fishing Lodge
St Mary's Church
For continuation refer to Sheet 12
For continuation refer to Sheet 14

Island GREEN POWER

Lanpro

Key

▭	Order Limits
▭	Sheet Index
○	Reference point within schedule
🟩	Private street with use temporarily suspended or restricted
🟪	Private access and street works / Private access subject to traffic regulation measures
🟩	Street with use temporarily suspended or restricted
🟪	Street works / Street subject to traffic regulation measures

Layers: Lanpro, 2025; IGP, 2025
Base map: Reproduced from Ordnance Survey digital map data © Crown copyright 2025. All rights reserved. License number 0100031673

0 100 200 300 Meters

Scale: 1:2,500@ A0

APFP Regulation: 5(2)(j)	Application Doc No. CR1/GH2.5_B
Ref: P3535_LPR_ZZ_XX_DR_Z_0281	Date: 05/11/2025
Drawn by: BH	Checked by: JC

Streets Plan (Change Application Version)

Sheet 13 of 18
Revision B

GREEN HILL SOLAR FARM

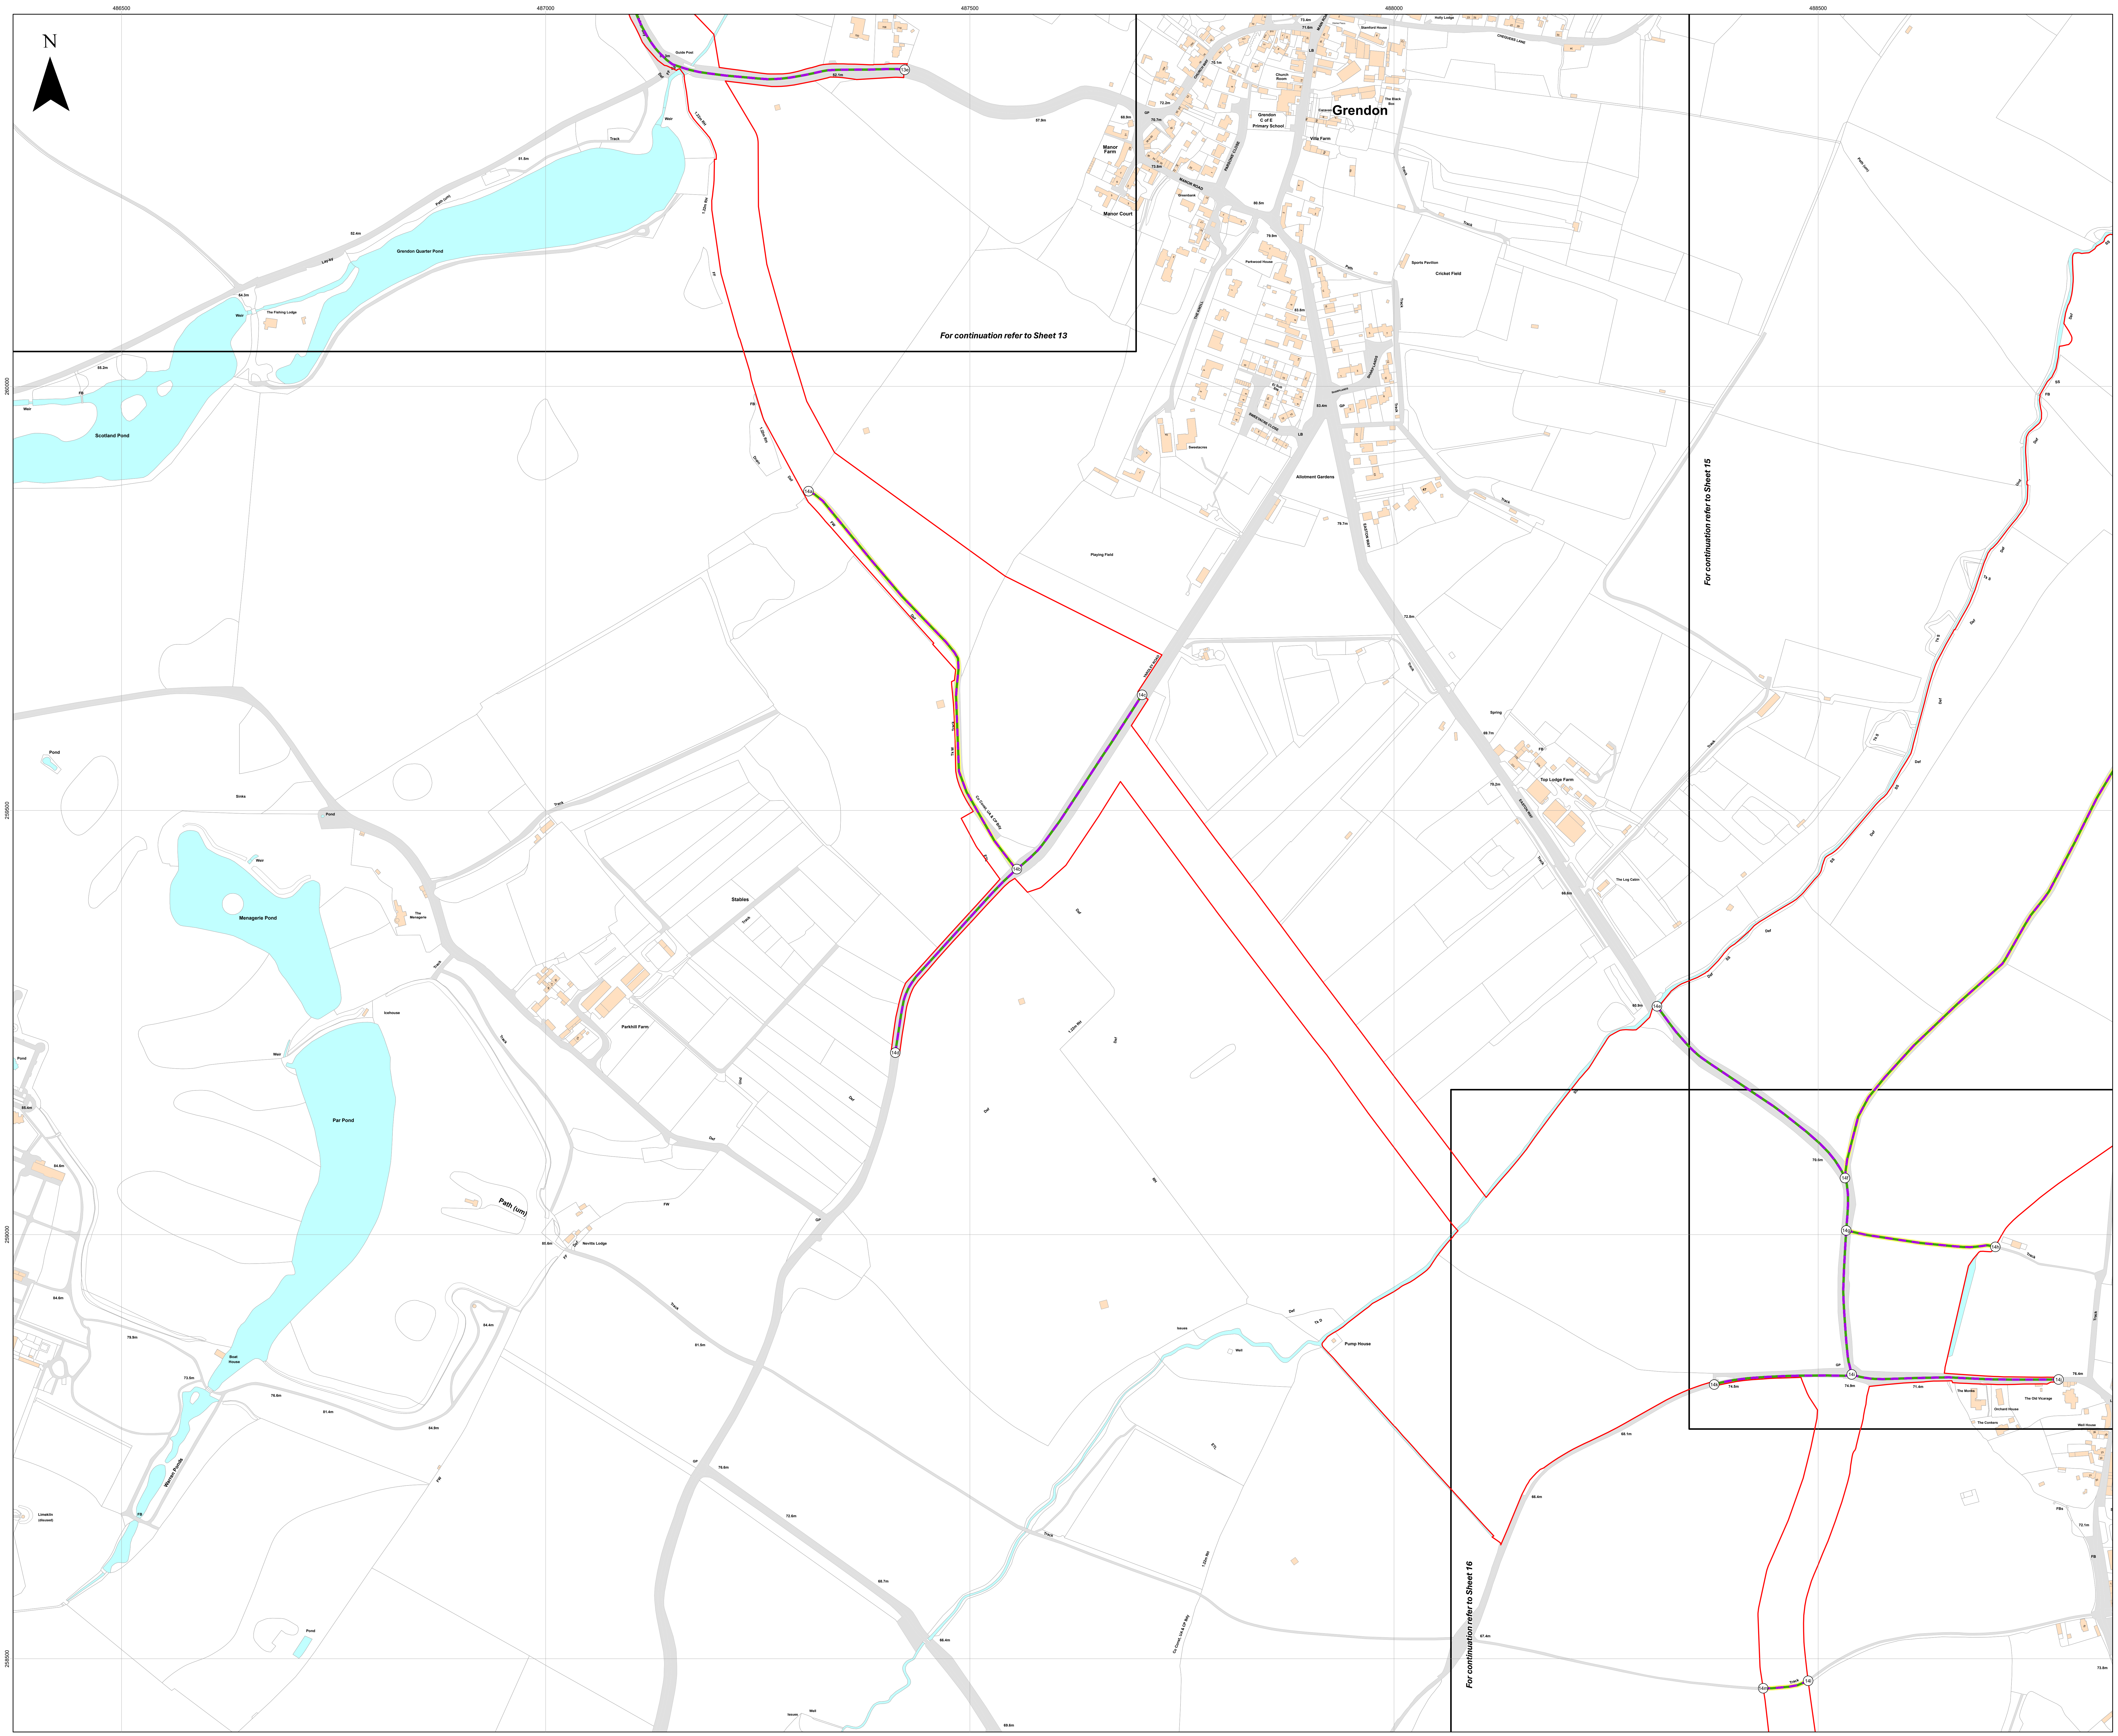
N
486500
487000
487500
488000
488500
260000
259500
259000
258500
Grendon
Grendon Quarter Pond
The Fishing Lodge
Weir
Scotland Pond
Pond
Sinks
Menagerie Pond
The Menagerie
Icehouse
Par Pond
Stables
Parkhill Farm
Path (um)
Nevills Lodge
Guide Post
Track
Def
1.22m RH
Co Const, UA & CP Bdy
Manor Farm
Manor Court
Grendon C of E Primary School
Villa Farm
Playing Field
Allotment Gardens
Sports Pavilion
Cricket Field
Spring
Top Lodge Farm
The Log Cabin
Pump House
The Monks
The Old Vicarage
Orchard House
The Conkers
Well House
FBs
13e
14b
14c
14d
14e
14f
14g
14h
14i
14j
14k
14l
14m
70.6m
74.5m
74.9m
71.4m
76.4m
68.1m
52.1m
For continuation refer to Sheet 13
For continuation refer to Sheet 15
For continuation refer to Sheet 16

Island GREEN POWER

Lanpro

Key

- 🟥 Order Limits
- ▭ Sheet Index
- ○ Reference point within schedule
- Private street with use temporarily suspended or restricted
- Private access and street works / Private access subject to traffic regulation measures
- Street with use temporarily suspended or restricted
- Street works / Street subject to traffic regulation measures

Layers: Lanpro, 2025; IGP, 2025
Base map: Reproduced from Ordnance Survey digital map data © Crown copyright 2025. All rights reserved. License number 0100031673

0 100 200 300 Meters

Scale: 1:2,500@ A0

APFP Regulation: 5(2)(j)	Application Doc No. CR1/GH2.5_B
Ref: P3535_LPR_ZZ_XX_DR_Z_0281	Date: 05/11/2025
Drawn by: BH	Checked by: JC

Streets Plan (Change Application Version)

Sheet 14 of 18
Revision B

GREEN HILL SOLAR FARM

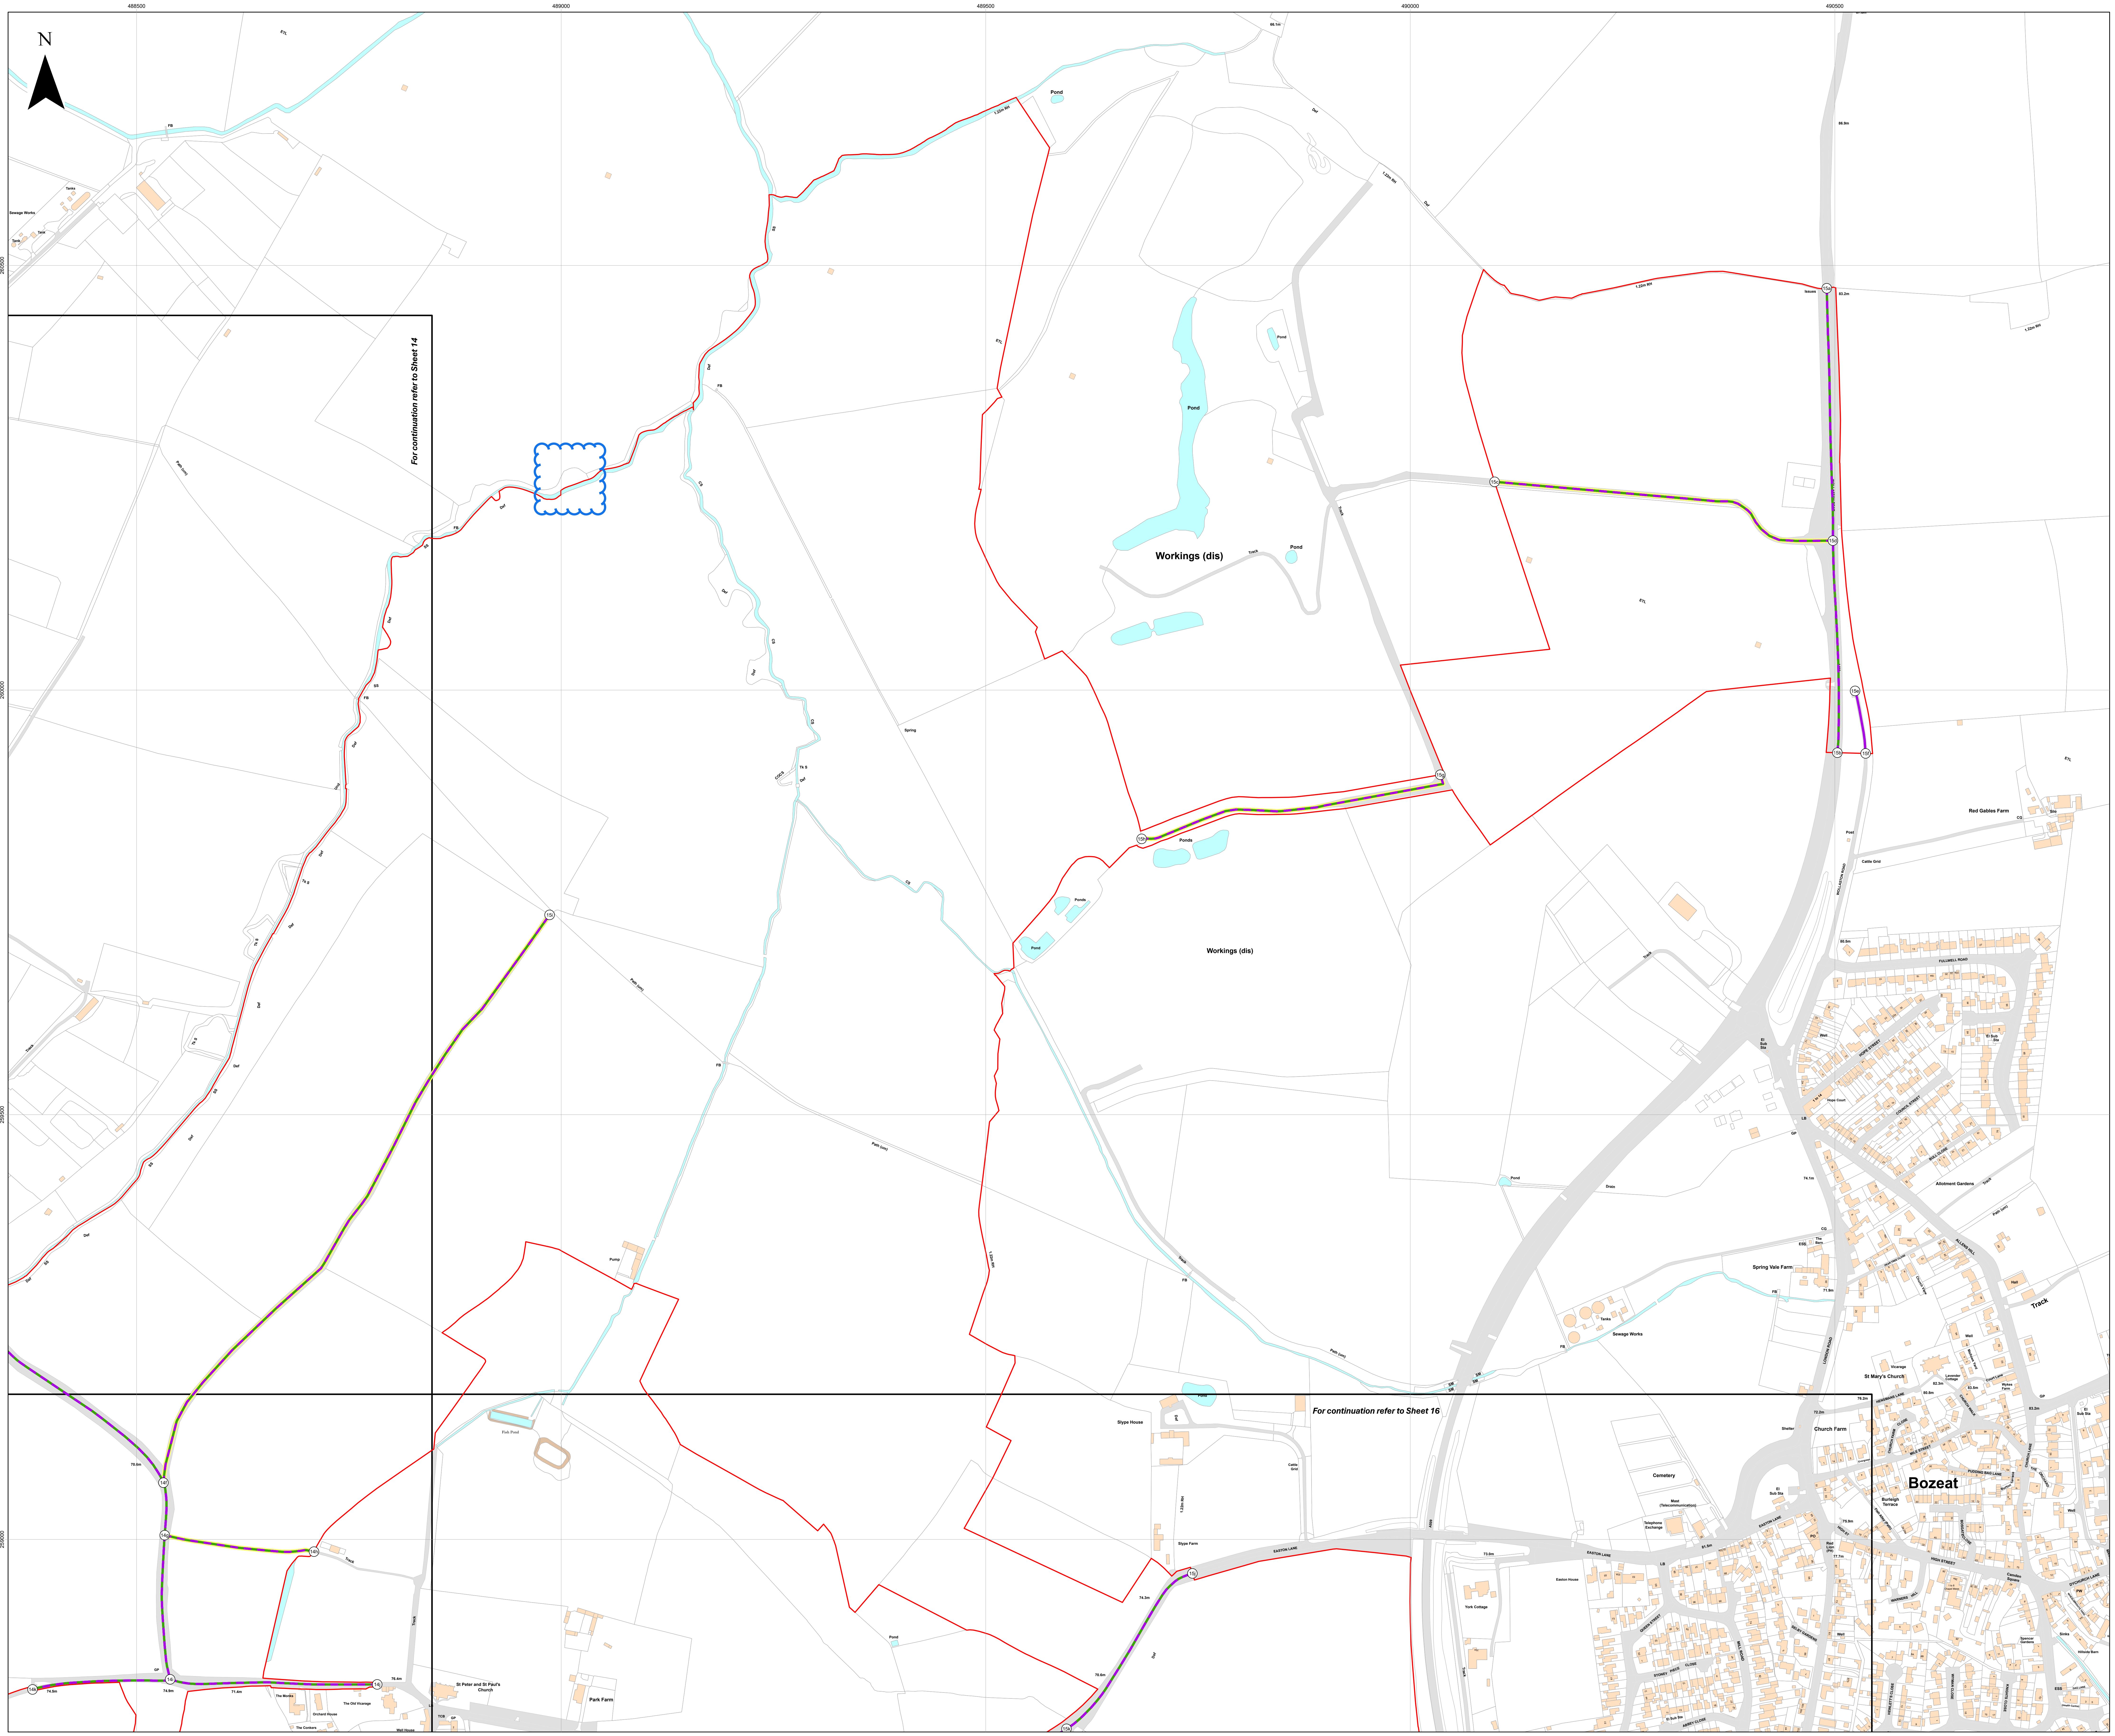
N
488500
489000
489500
490000
490500
260500
260000
259500
259000
For continuation refer to Sheet 14
For continuation refer to Sheet 16
Workings (dis)
Pond
Ponds
Track
Issues
83.2m
15a
15b
15c
15d
15e
15f
15g
15h
15i
15j
15k
14e
14f
14g
14h
14i
14j
14k
70.6m
74.5m
74.9m
71.4m
76.4m
74.3m
1.22m RH
Def
GP
Post
Red Gables Farm
Slype Farm
Slype House
Spring Vale Farm
Sewage Works
Allotment Gardens
Church Farm
Cemetery
St Mary's Church
Park Farm
Park Pond
The Monks
Orchard House
The Old Vicarage
The Conkers
Well House
St Peter and St Paul's Church
TCB
LB
EASTON LANE
Bozeat

Key

- 🟥 Order Limits
- ▭ Sheet Index
- ○ Reference point within schedule
- 🟩 Private street with use temporarily suspended or restricted
- 🟪 Private access and street works / Private access subject to traffic regulation measures
- 🟩 Street with use temporarily suspended or restricted
- 🟪 Street works / Street subject to traffic regulation measures

Layers: Lanpro, 2025; IGP, 2025

Base map: Reproduced from Ordnance Survey digital map data

0 100 200 300 Meters

Scale: 1:2,500@ A0

APFP Regulation: 5(2)(j)	Application Doc No. CR1/GH2.5_B
Ref: P3535_LPR_ZZ_XX_DR_Z_0281	Date: 05/11/2025
Drawn by: BH	Checked by: JC

Streets Plan (Change Application Version)

Sheet 15 of 18

Revision B

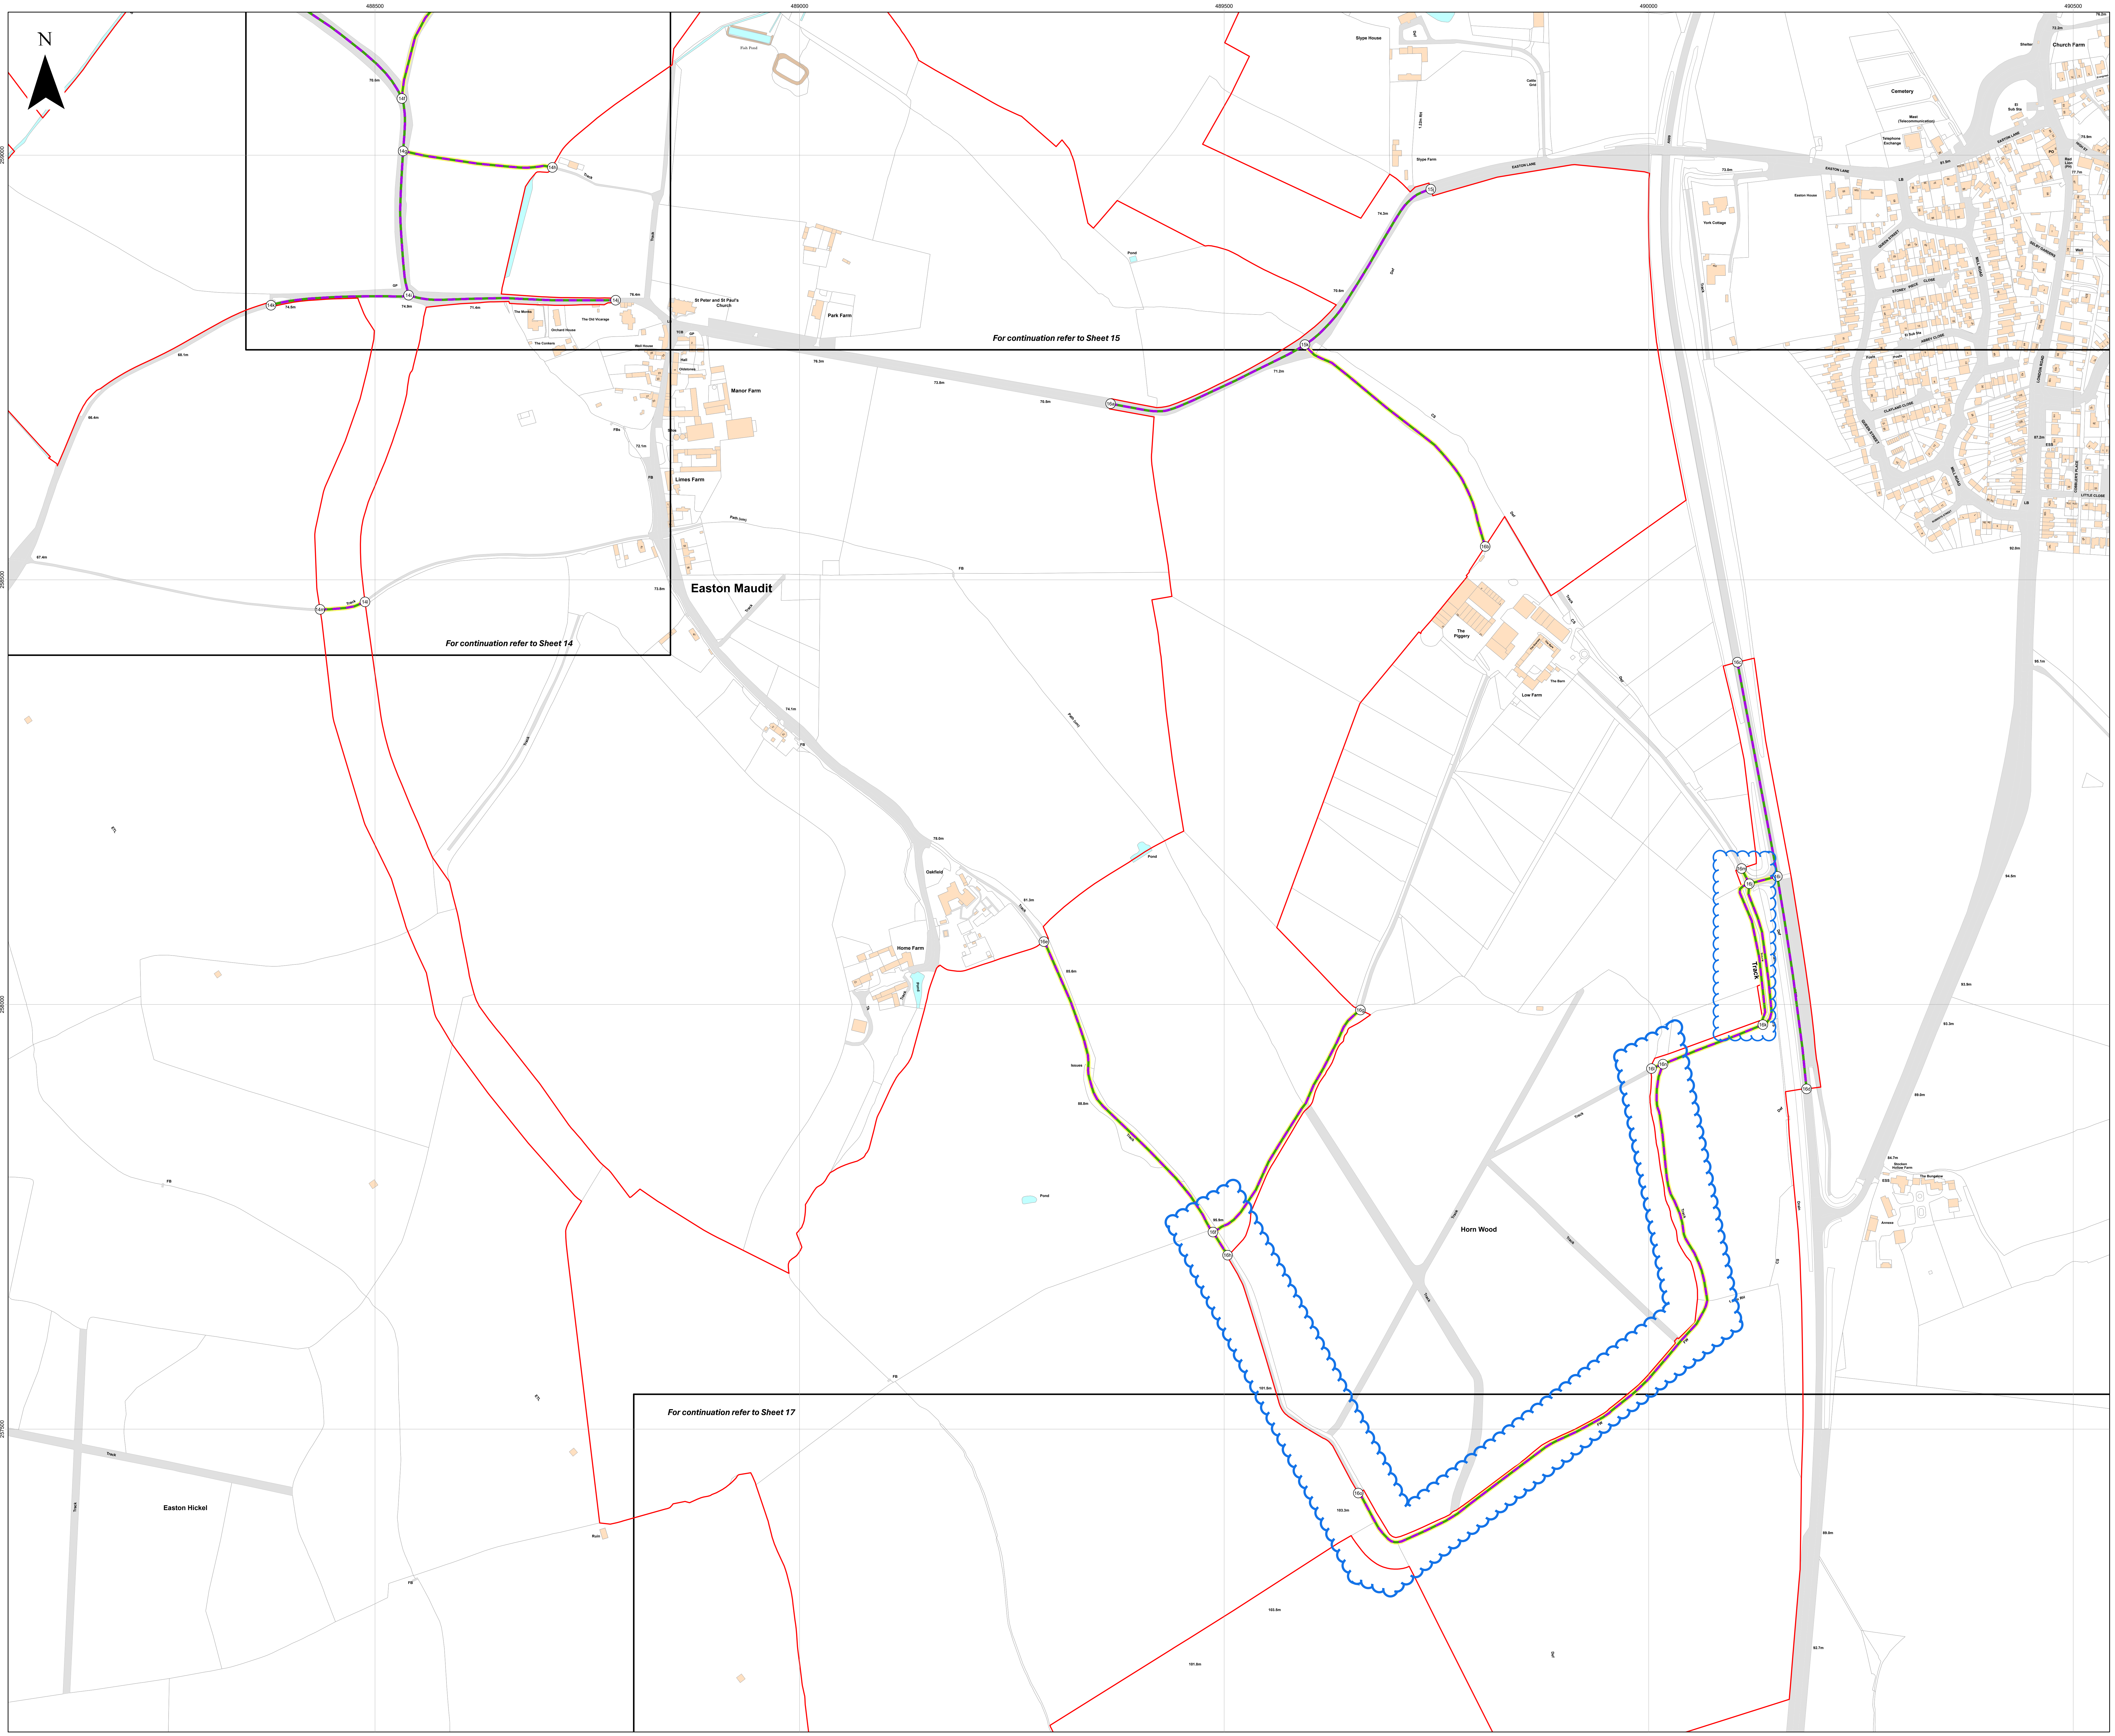
N
488500
489000
489500
490000
490500
For continuation refer to Sheet 14
For continuation refer to Sheet 15
For continuation refer to Sheet 17
Easton Maudit
St Peter and St Paul's Church
Park Farm
Manor Farm
Limes Farm
Oakfield
Home Farm
The Piggery
Low Farm
The Barn
Horn Wood
Easton Hickel
Stype House
Stype Farm
Cemetery
Church Farm
Pond
Track

Island GREEN POWER

Lanpro

Key

🟥	Order Limits
▭	Sheet Index
○	Reference point within schedule
🟩	Private street with use temporarily suspended or restricted
🟪	Private access and street works / Private access subject to traffic regulation measures
🟩	Street with use temporarily suspended or restricted
🟪	Street works / Street subject to traffic regulation measures

Layers: Lanpro, 2025; IGP, 2025

0 100 200 300 Meters

Scale: 1:2,500@ A0

APFP Regulation: 5(2)(j)	Application Doc No. CR1/GH2.5_B
Ref: P3535_LPR_ZZ_XX_DR_Z_0281	Date: 05/11/2025
Drawn by: BH	Checked by: JC

Streets Plan (Change Application Version)

Sheet 16 of 18

Revision B

GREEN HILL SOLAR FARM

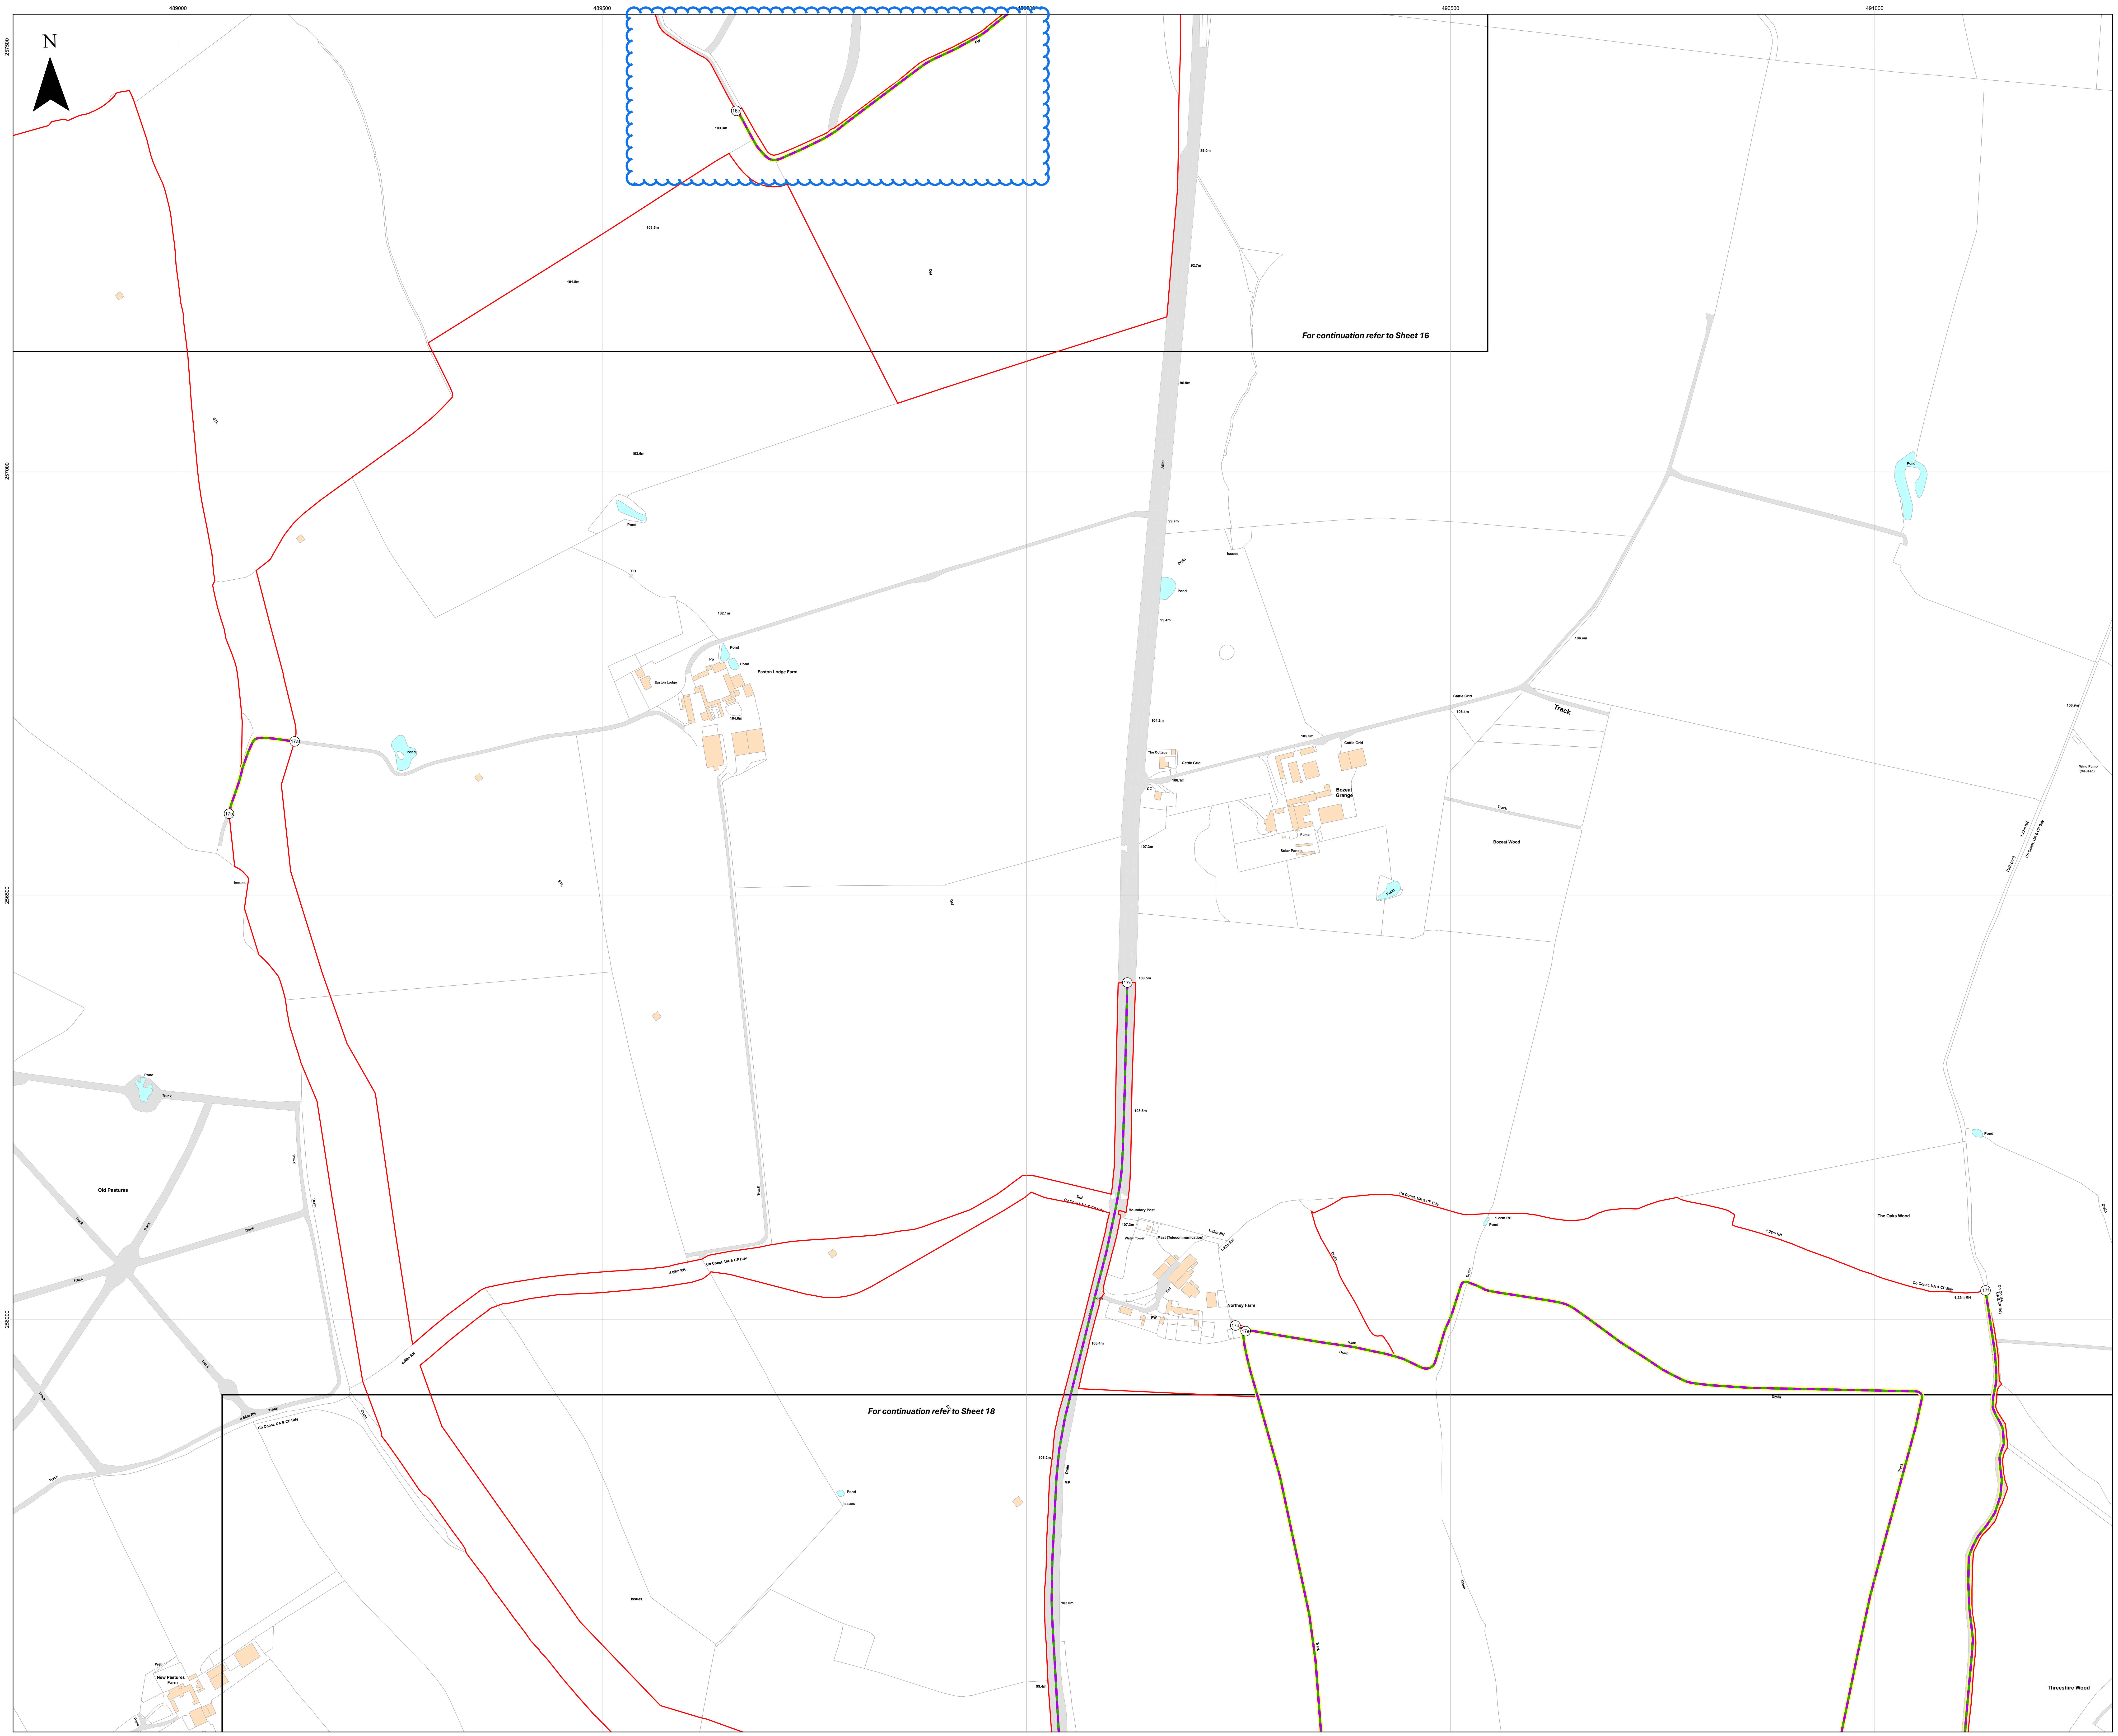
N
489000
489500
490000
490500
491000
257500
257000
256500
256000
16o
17a
17b
17c
17d
17e
17f
103.3m
103.5m
FW
Def
Easton Lodge Farm
Easton Lodge
Pond
Pp
FB
102.1m
104.0m
ETL
Issues
The Cottage
Cattle Grid
CG
106.1m
105.5m
104.2m
99.4m
107.3m
106.4m
Bozeat Grange
Pump
Solar Panels
Track
Bozeat Wood
Boundary Post
Water Tower
Mast (Telecommunication)
1.22m RH
Co Const, UA & CP Bdy
Northey Farm
Drain
108.5m
The Oaks Wood
Old Pastures
New Pastures Farm
Threeshire Wood

For continuation refer to Sheet 16

For continuation refer to Sheet 18

Key

- 🟥 Order Limits
- ▭ Sheet Index
- ○ Reference point within schedule
- 🟩 Private street with use temporarily suspended or restricted
- 🟪 Private access and street works / Private access subject to traffic regulation measures
- 🟪 Street works / Street subject to traffic regulation measures

Layers: Lanpro, 2025; IGP, 2025
Base map: Reproduced from Ordnance Survey digital map data © Crown copyright 2025. All rights reserved. License number 0100031673

0 100 200 300 Meters

Scale: 1:2,500@ A0

APFP Regulation: 5(2)(j)	Application Doc No. CR1/GH2.5_B
Ref: P3535_LPR_ZZ_XX_DR_Z_0281	Date: 05/11/2025
Drawn by: BH	Checked by: JC

Streets Plan (Change Application Version)

Sheet 17 of 18
Revision B

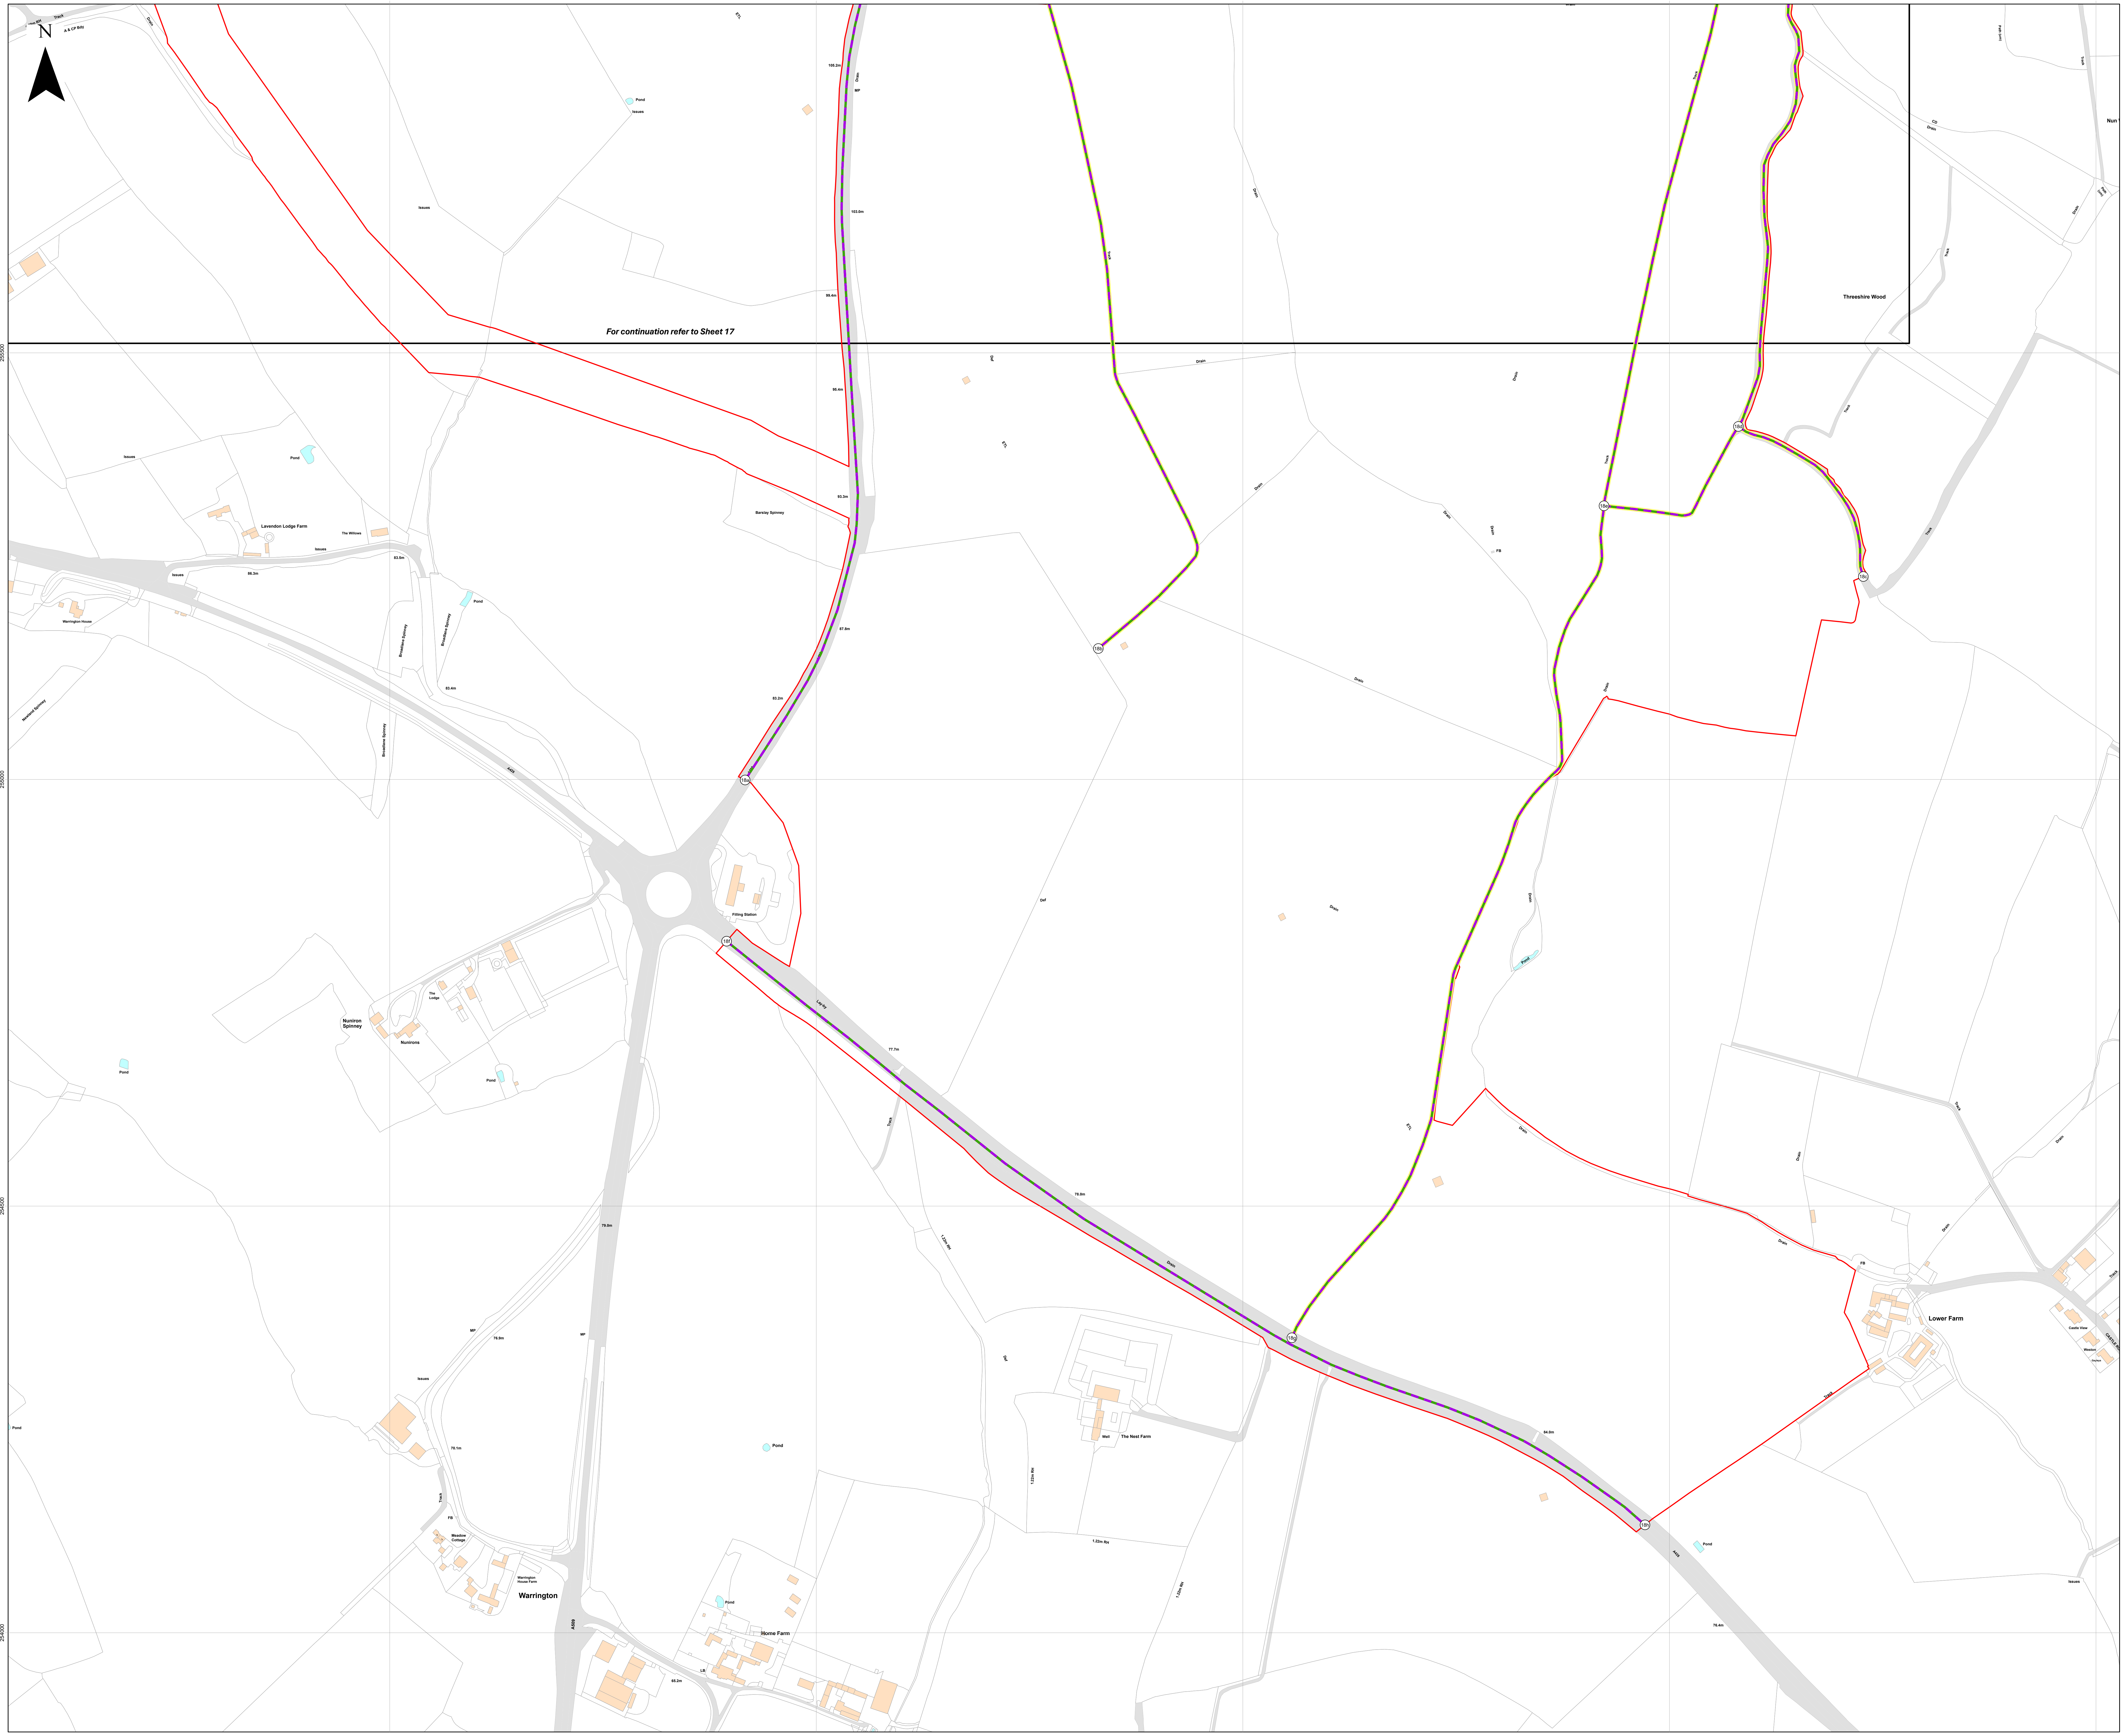
489500
490000
490500
491000
491500
255000
254500
254000
N
For continuation refer to Sheet 17
18a
18b
18c
18d
18e
18f
18g
18h
Track
Filling Station
Def
Lay-by
87.8m
83.2m
77.7m
84.0m
76.4m
A428
Pond
Lavendon Lodge Farm
Threeshire Wood
Lower Farm
The Nest Farm
Home Farm
Warrington
A509
Castle View
Weston
Gayleys
CASTLE RO

Island GREEN POWER

Lanpro

Key

- 🟥 Order Limits
- ▭ Sheet Index
- ○ Reference point within schedule
- Private street with use temporarily suspended or restricted
- Private access and street works / Private access subject to traffic regulation measures
- Street with use temporarily suspended or restricted
- Street works / Street subject to traffic regulation measures

Layers: Lanpro, 2025; IGP, 2025

0 100 200 300 Meters

Scale: 1:2,500@ A0

APFP Regulation: 5(2)(j)	Application Doc No. CR1/GH2.5_B
Ref: P3535_LPR_ZZ_XX_DR_Z_0281	Date: 05/11/2025
Drawn by: BH	Checked by: JC

Streets Plan (Change Application Version)

Sheet 18 of 18

Revision B

GREEN HILL SOLAR FARM