

Green Hill Solar Farm

EN010170

Land Plan

Revision ~~BC~~ (Tracked) – Change Application version

Prepared by: Bruton Knowles

Date: November 2025


Document Reference: ~~EX1~~CR1/GH2.2_~~BC~~

APFP Regulation 5(2)(i)



Schedule of Changes

Figure Reference	Page	Description of Changes	Reason for Revision
[cover]		Updated document reference to Revision C	As required for submission of Change Application EN010170/CR1/GH9.2.
All Sheets	3-21	Updated document references and annotations	As required for submission of Change Application EN010170/CR1/GH9.2.
Sheet 1	4	Order Limits extended Creation of plots 01-011a, 01-011-b, and 01-011-c	Presentation of Change 1 requested in Change Application EN010170/CR1/GH9.2.
Sheet 3	6	Change of rights sought to plot 03-030	Presentation of Change 2 requested in Change Application EN010170/CR1/GH9.2.
Sheet 3	6	Order Limits extended Creation of plots 02-029a, 02-029b, 03-031a, and 03-031-b	Presentation of Change 3 requested in Change Application EN010170/CR1/GH9.2.
Sheet 7	10	Creation of plots 07-069-a, 07-069-b, 07-069-c, 07-070a, 07-070-b, 07-070c, 07-072-a, 07-072-b, 07-072c, and 07-072d	Presentation of Change 4 requested in Change Application EN010170/CR1/GH9.2.
Sheet 8 Sheet 10	11 13	Change of rights sought to plot 08-088	Presentation of Change 5 requested in Change Application EN010170/CR1/GH9.2.
Sheet 8 Sheet 9	11 12	Order Limits extended Creation of plots 08-089-a, and 08-089-b	Presentation of Change 6 requested in Change Application EN010170/CR1/GH9.2.
Sheet 12	15	Order Limits extended Creation of plots 12-128-a, 12-128-b, 12-129-a, 12-129-b, 12-130-a, 12-130-b, and 12-131-d Change of rights sought to plot 12-131-c, 12-136-a, and 12-136-b	Presentation of Change 7 requested in Change Application EN010170/CR1/GH9.2.
Sheet 15	18	Order Limits reduced	Presentation of Change 8 requested in Change Application EN010170/CR1/GH9.2.
Sheet 16 Sheet 17	19 20	Order Limits reduced Creation of plot 16-210-c	Presentation of Change 9 requested in Change Application EN010170/CR1/GH9.2.

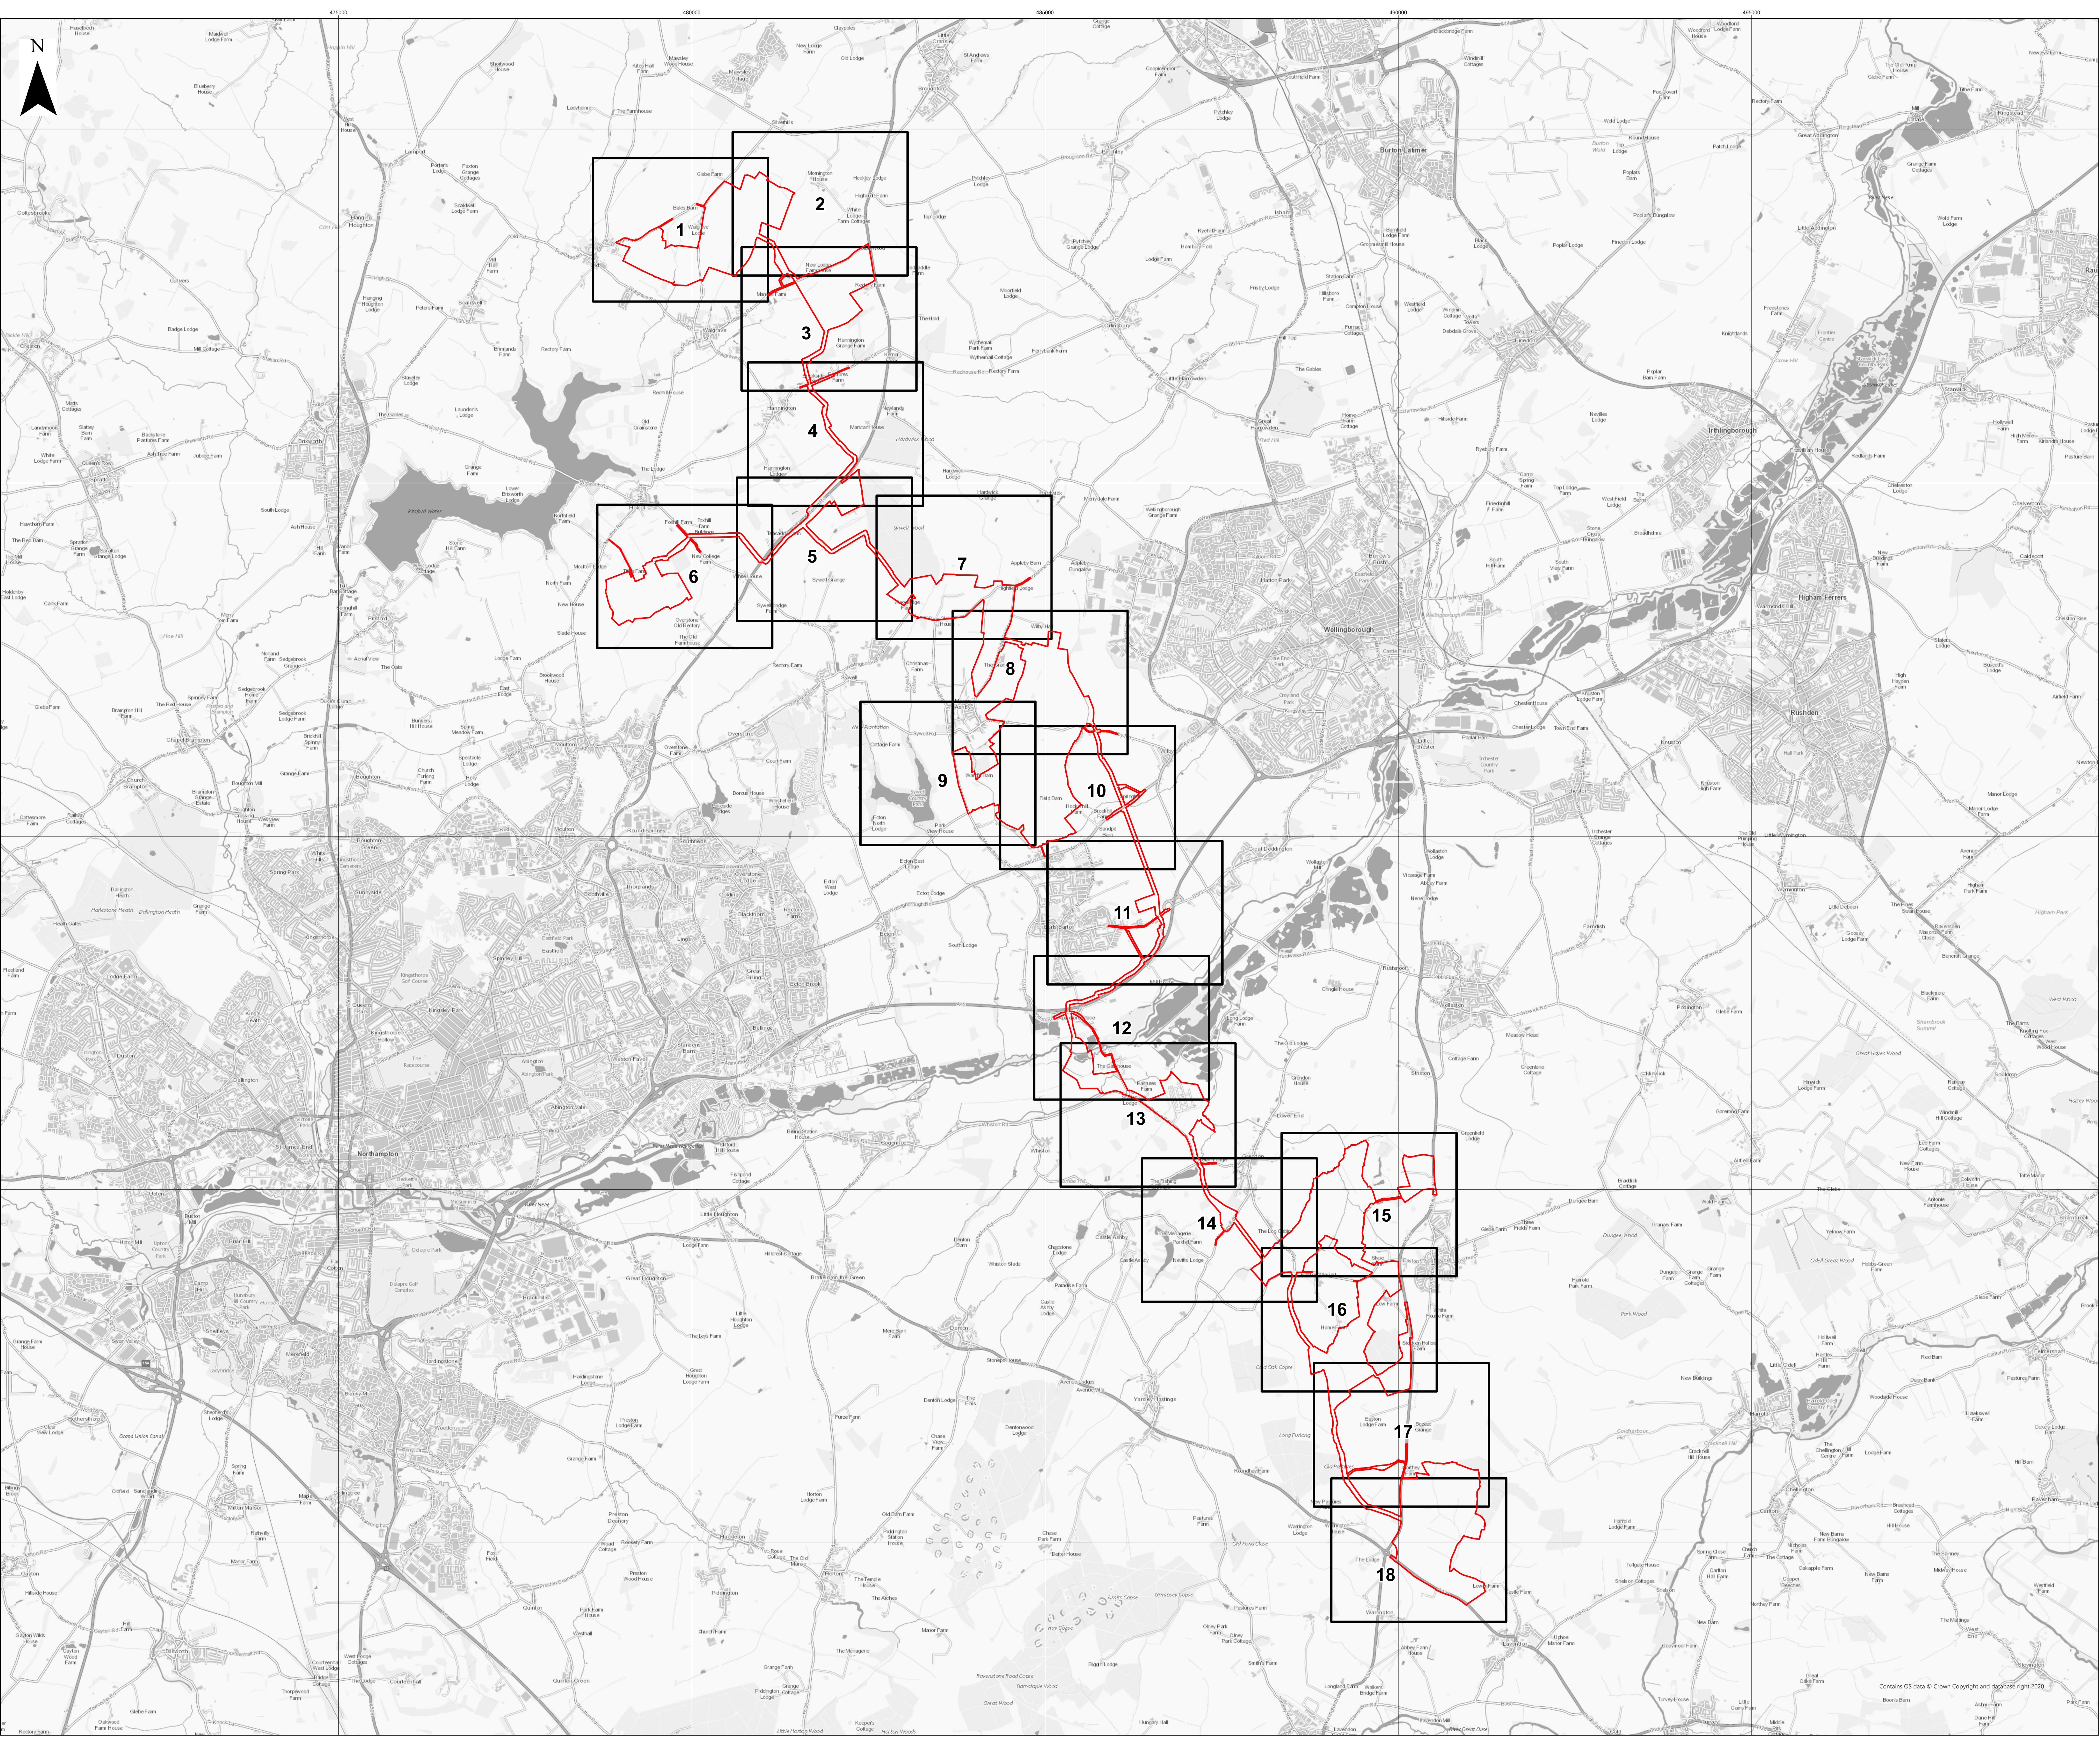



Key

 Sheet

 Order Limits

Base map: © Crown Copyright and database rights 2025 OS Licence no. AC000849896. All rights reserved.

0 1,000 2,000 3,000 4,000

Metres

Scale: 1:30,000@A0





APFP Regulation: 5(2)(i)	Application Doc No. CR1/GH2.2_C
Ref: IGP_GH_DCO_Land_Plan	Date: 10/11/2025
Drawn by: DLG	Checked by: AT

**Overview Land Plan
(Change Application Version)**

Revision C
Sheet 0



Contains OS data © Crown Copyright and database right 2020.

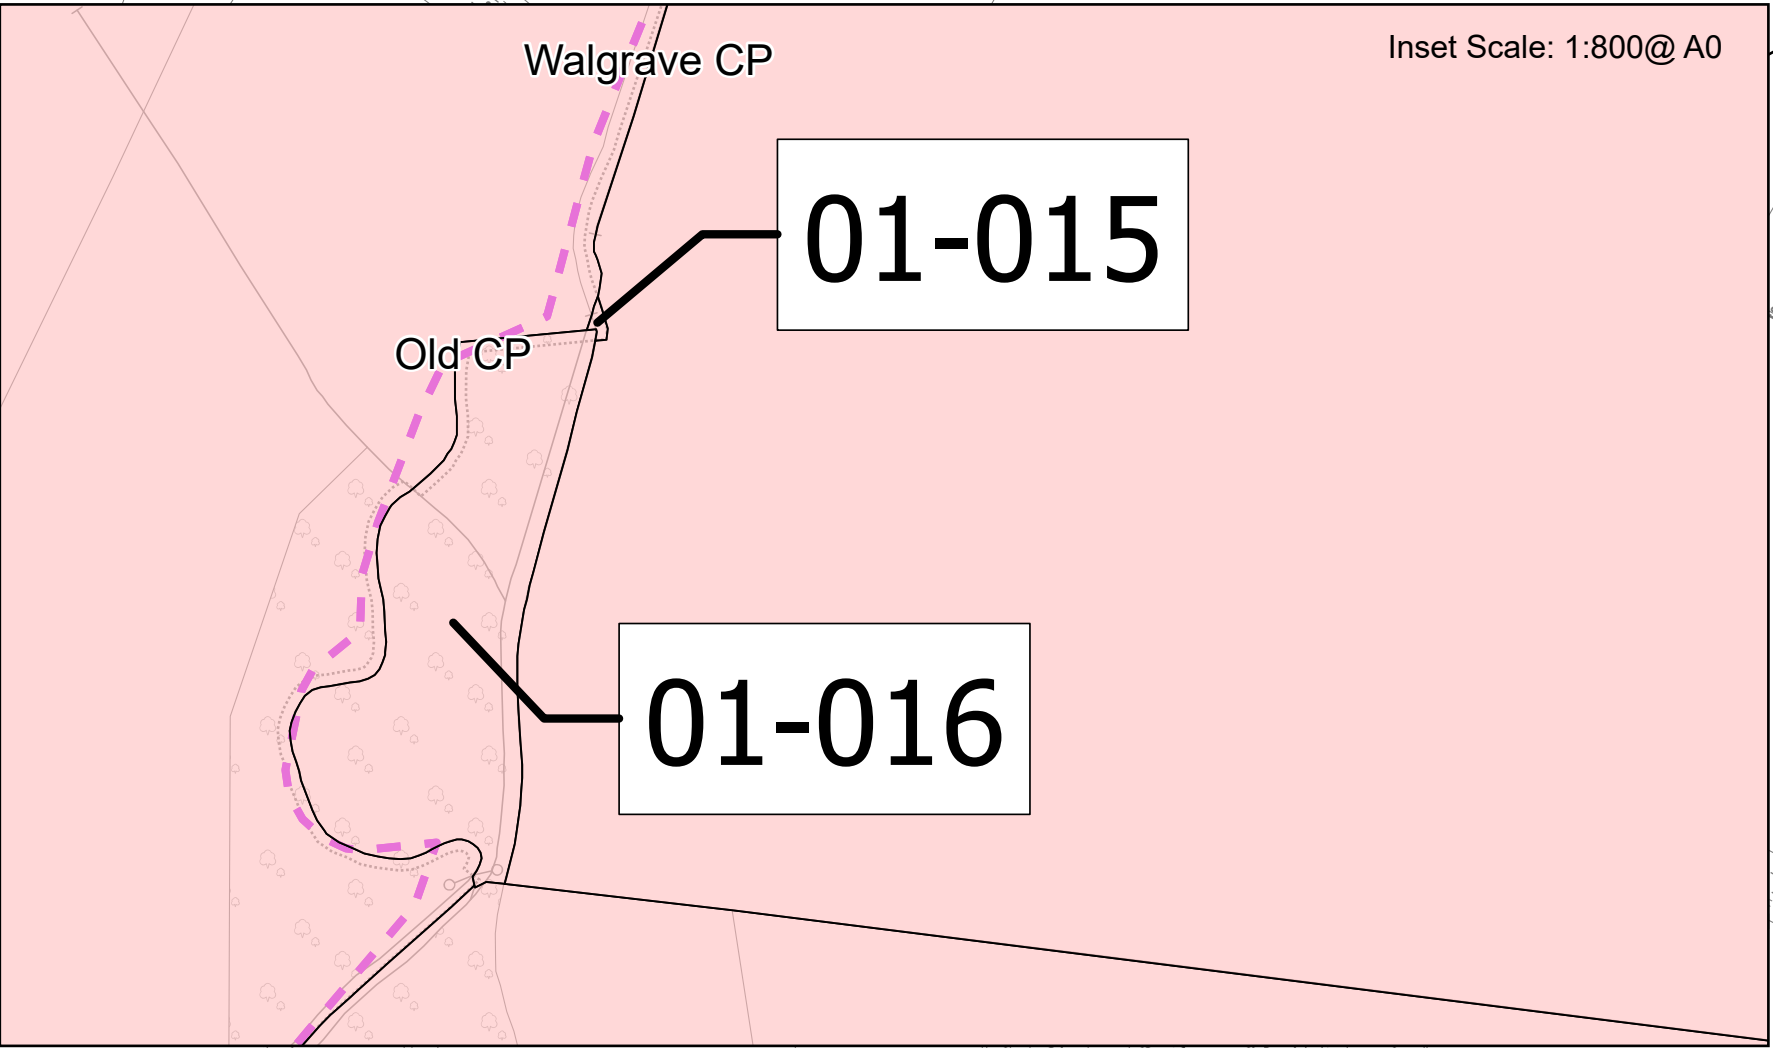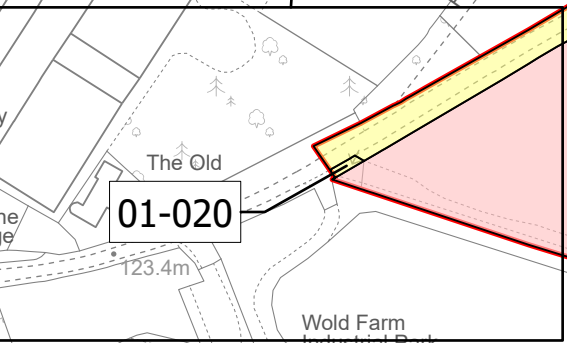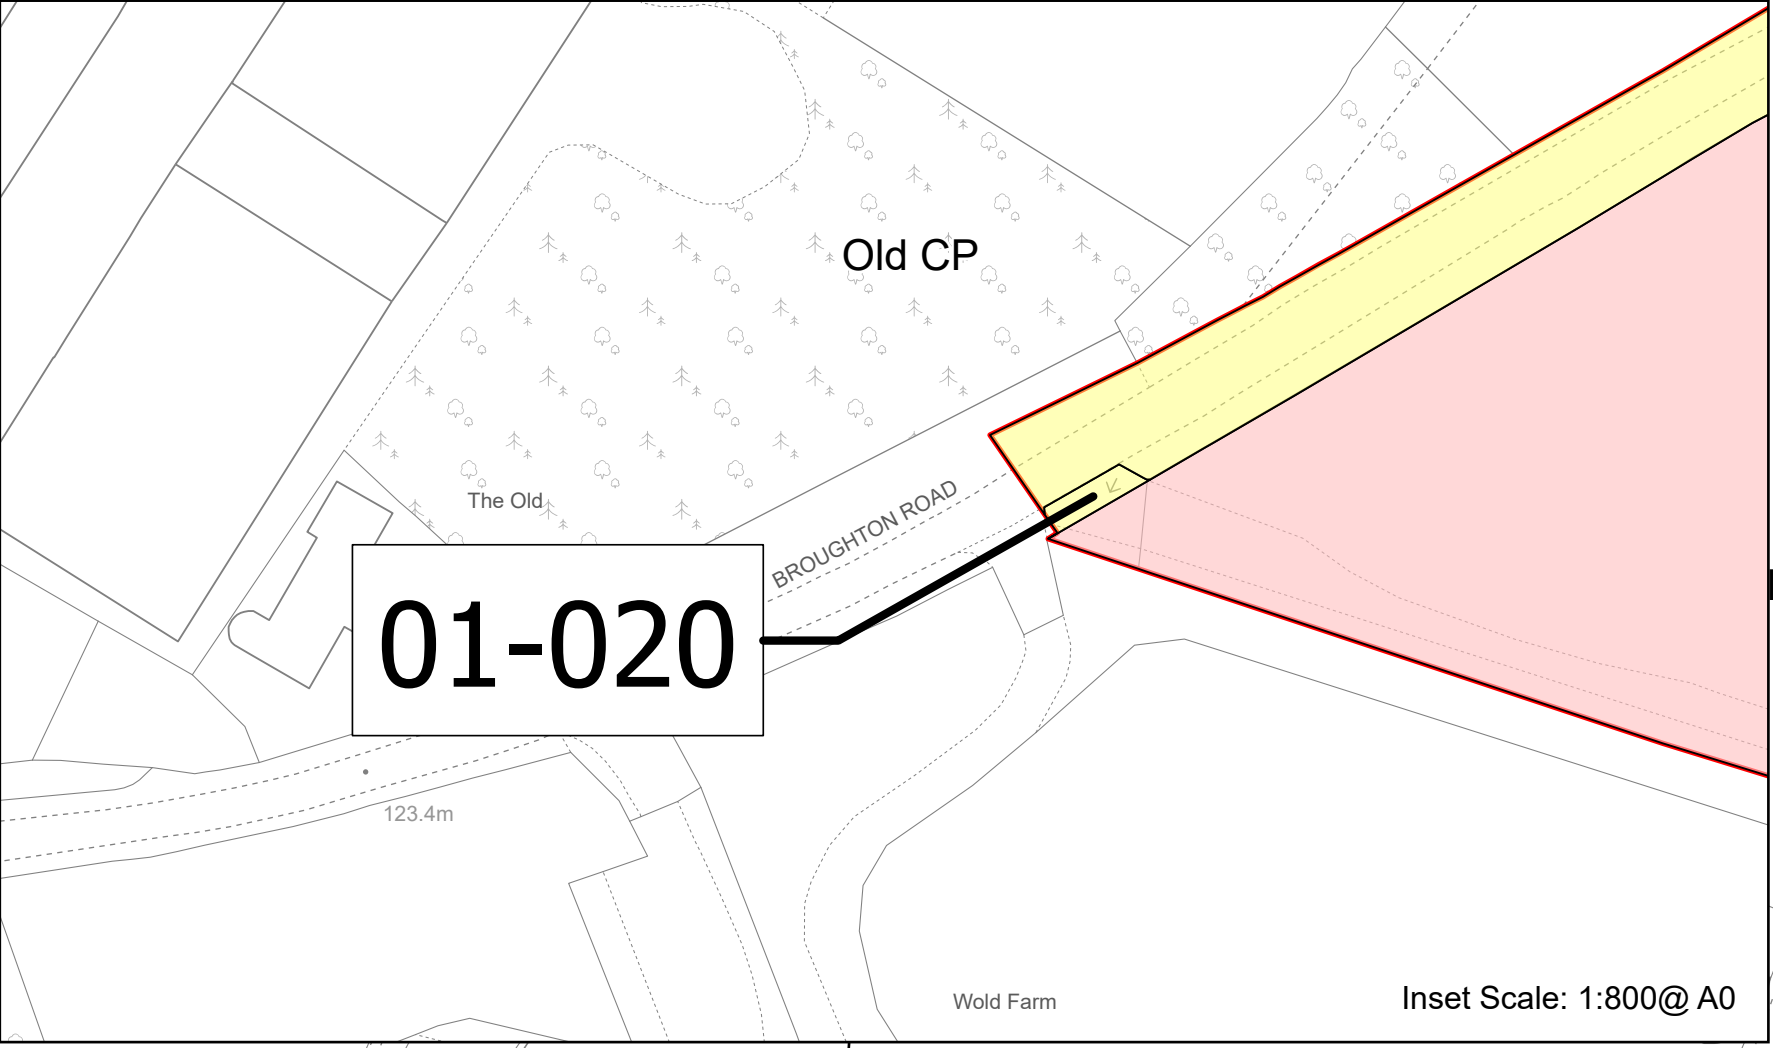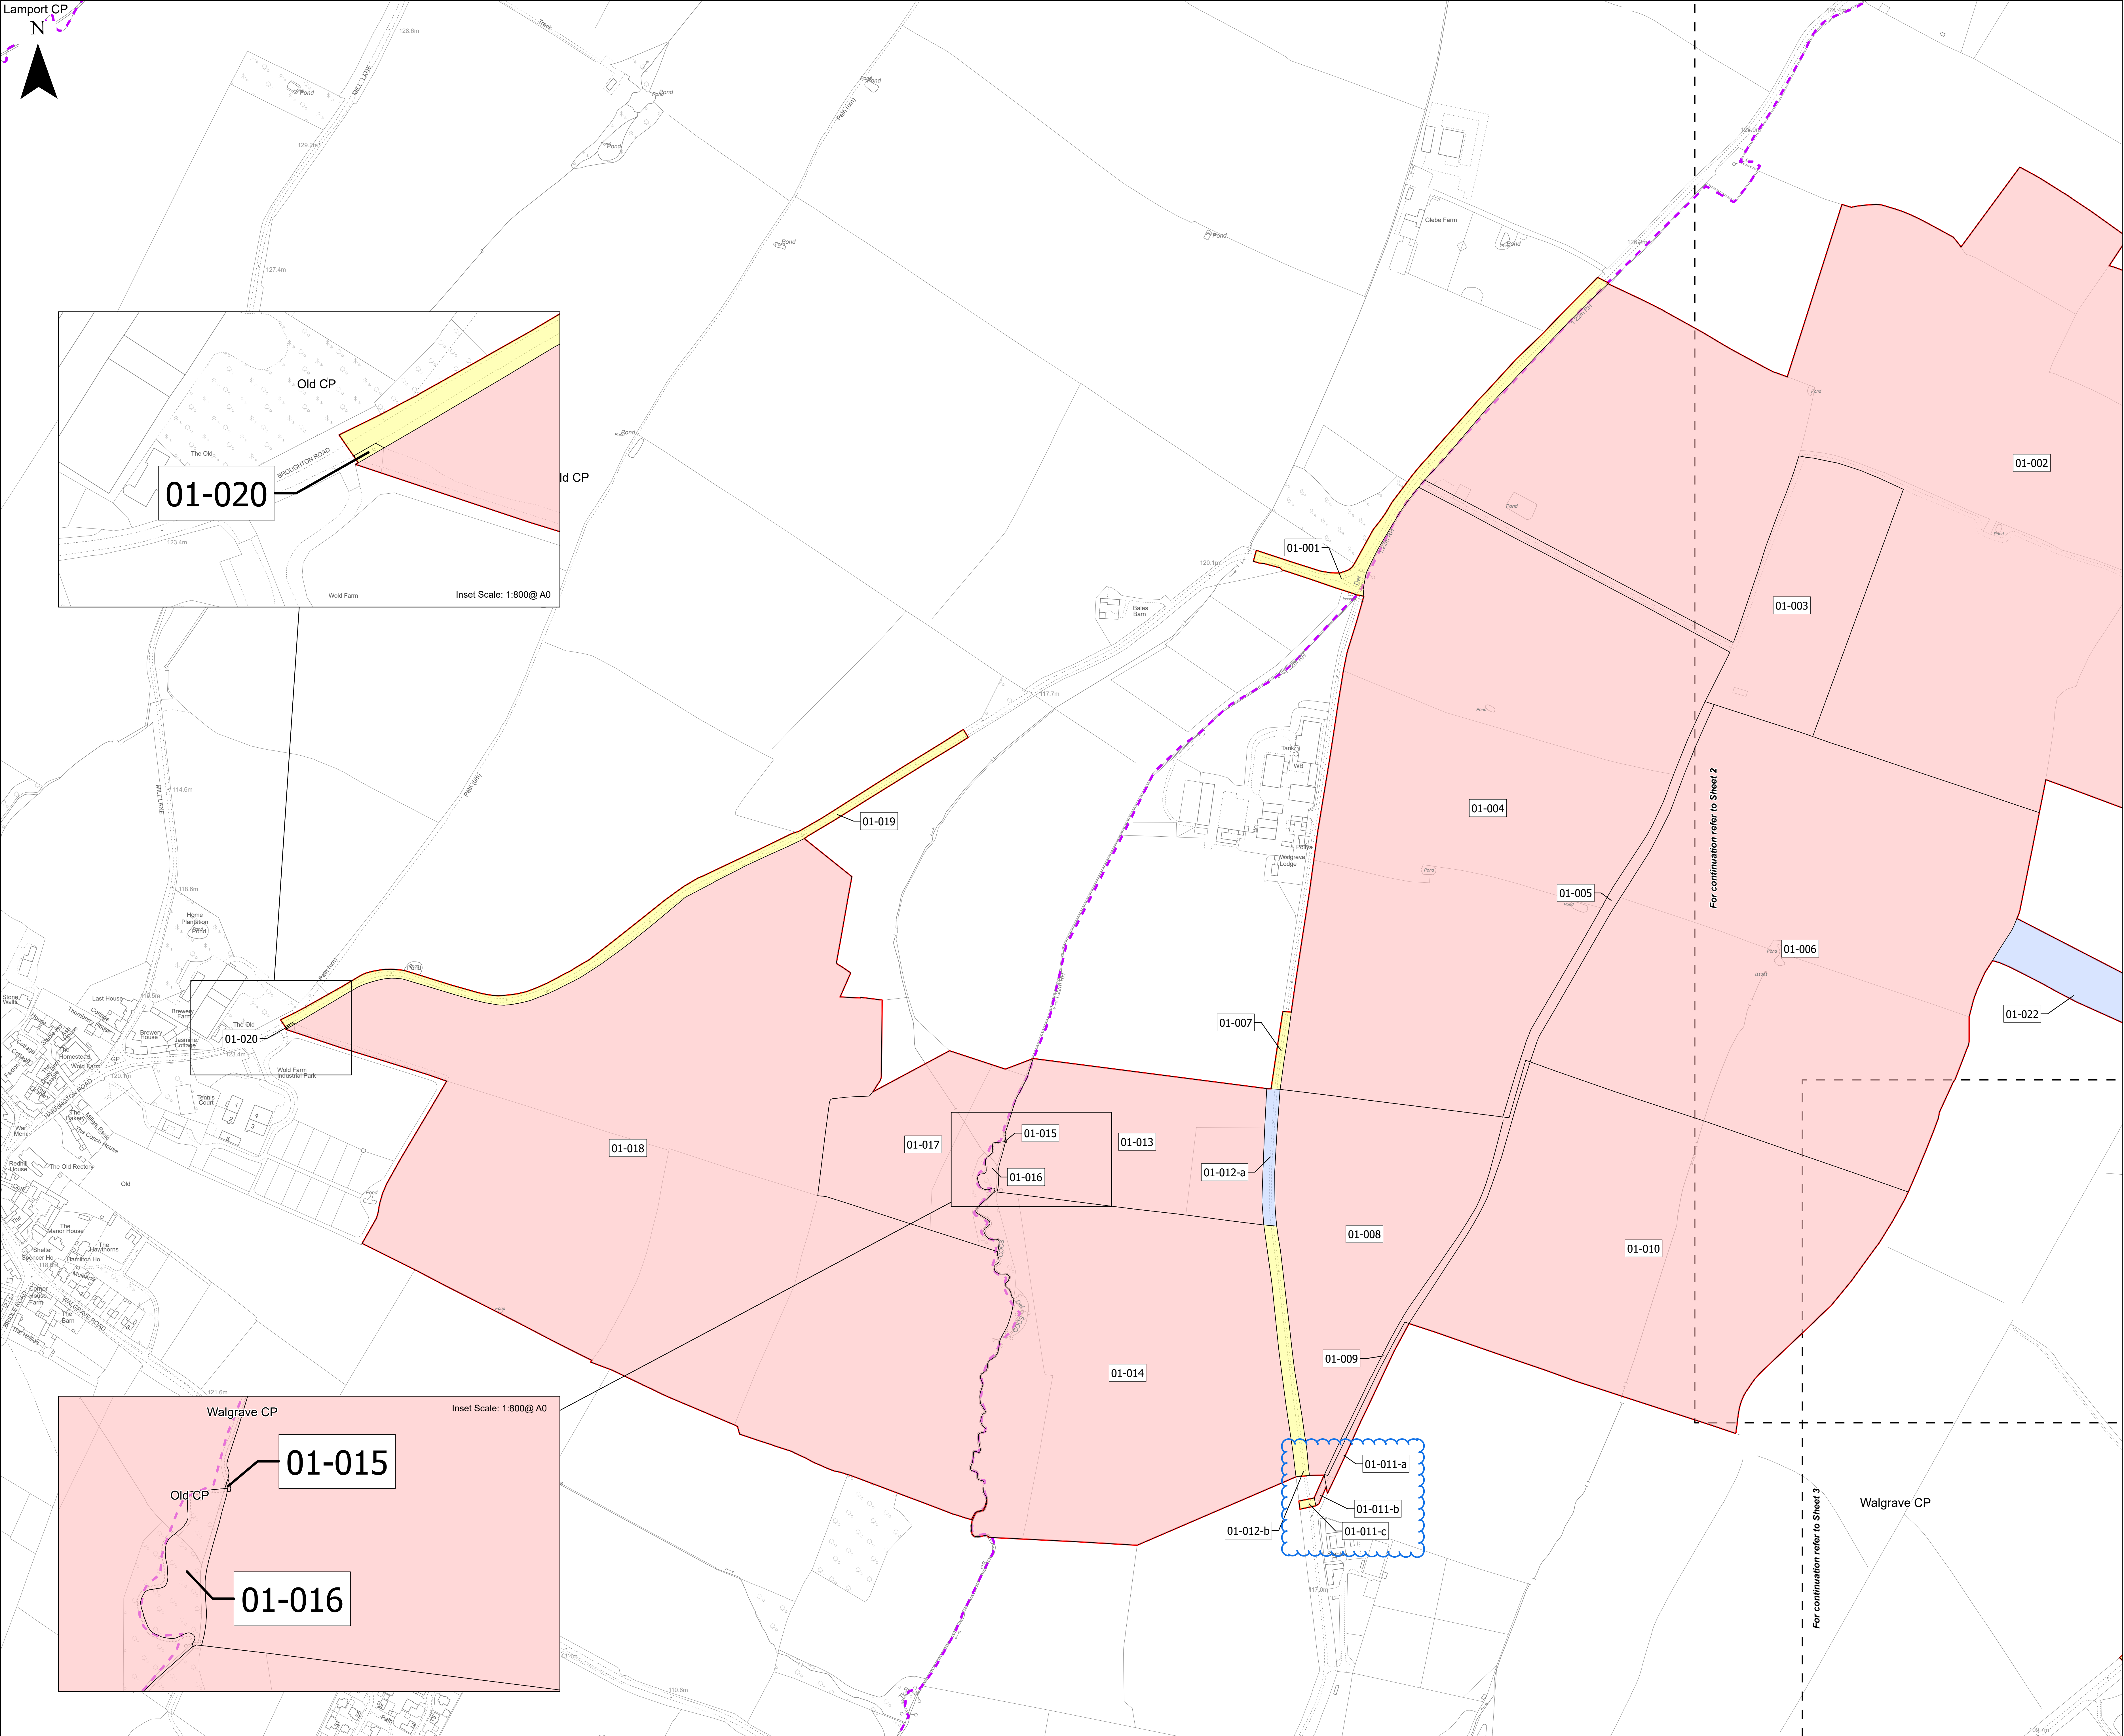

Key

- Order Limits
- Freehold to be compulsorily acquired and temporary use of land and in relation to which it is proposed that easements, servitudes and other private rights will cease to have effect
- Temporary use of land and in relation to which it is proposed to temporarily suspend easements, servitudes and other private rights
- New rights (including restrictions) to be compulsorily acquired and temporary use of land and in relation to which it is proposed that easements, servitudes and other private rights will be suspended or cease to have effect
- No Land Take
- Local Authority / Parish Boundary
- Cut Line

Base map: © Crown Copyright and database rights 2025 OS Licence no. AC0000849896. All rights reserved.


0 100 200 300 400 Metres

Scale: 1:2,500@ A0

APFP Regulation: 5(2)(i)	Application Doc No. CR1/GH2.2_C
Ref: IGP_GH_DCO_Land_Plan	Date: 10/11/2025
Drawn by: DLG	Checked by: AT


Land Plan
(Change Application Version)

Revision C
Sheet 1 of 18

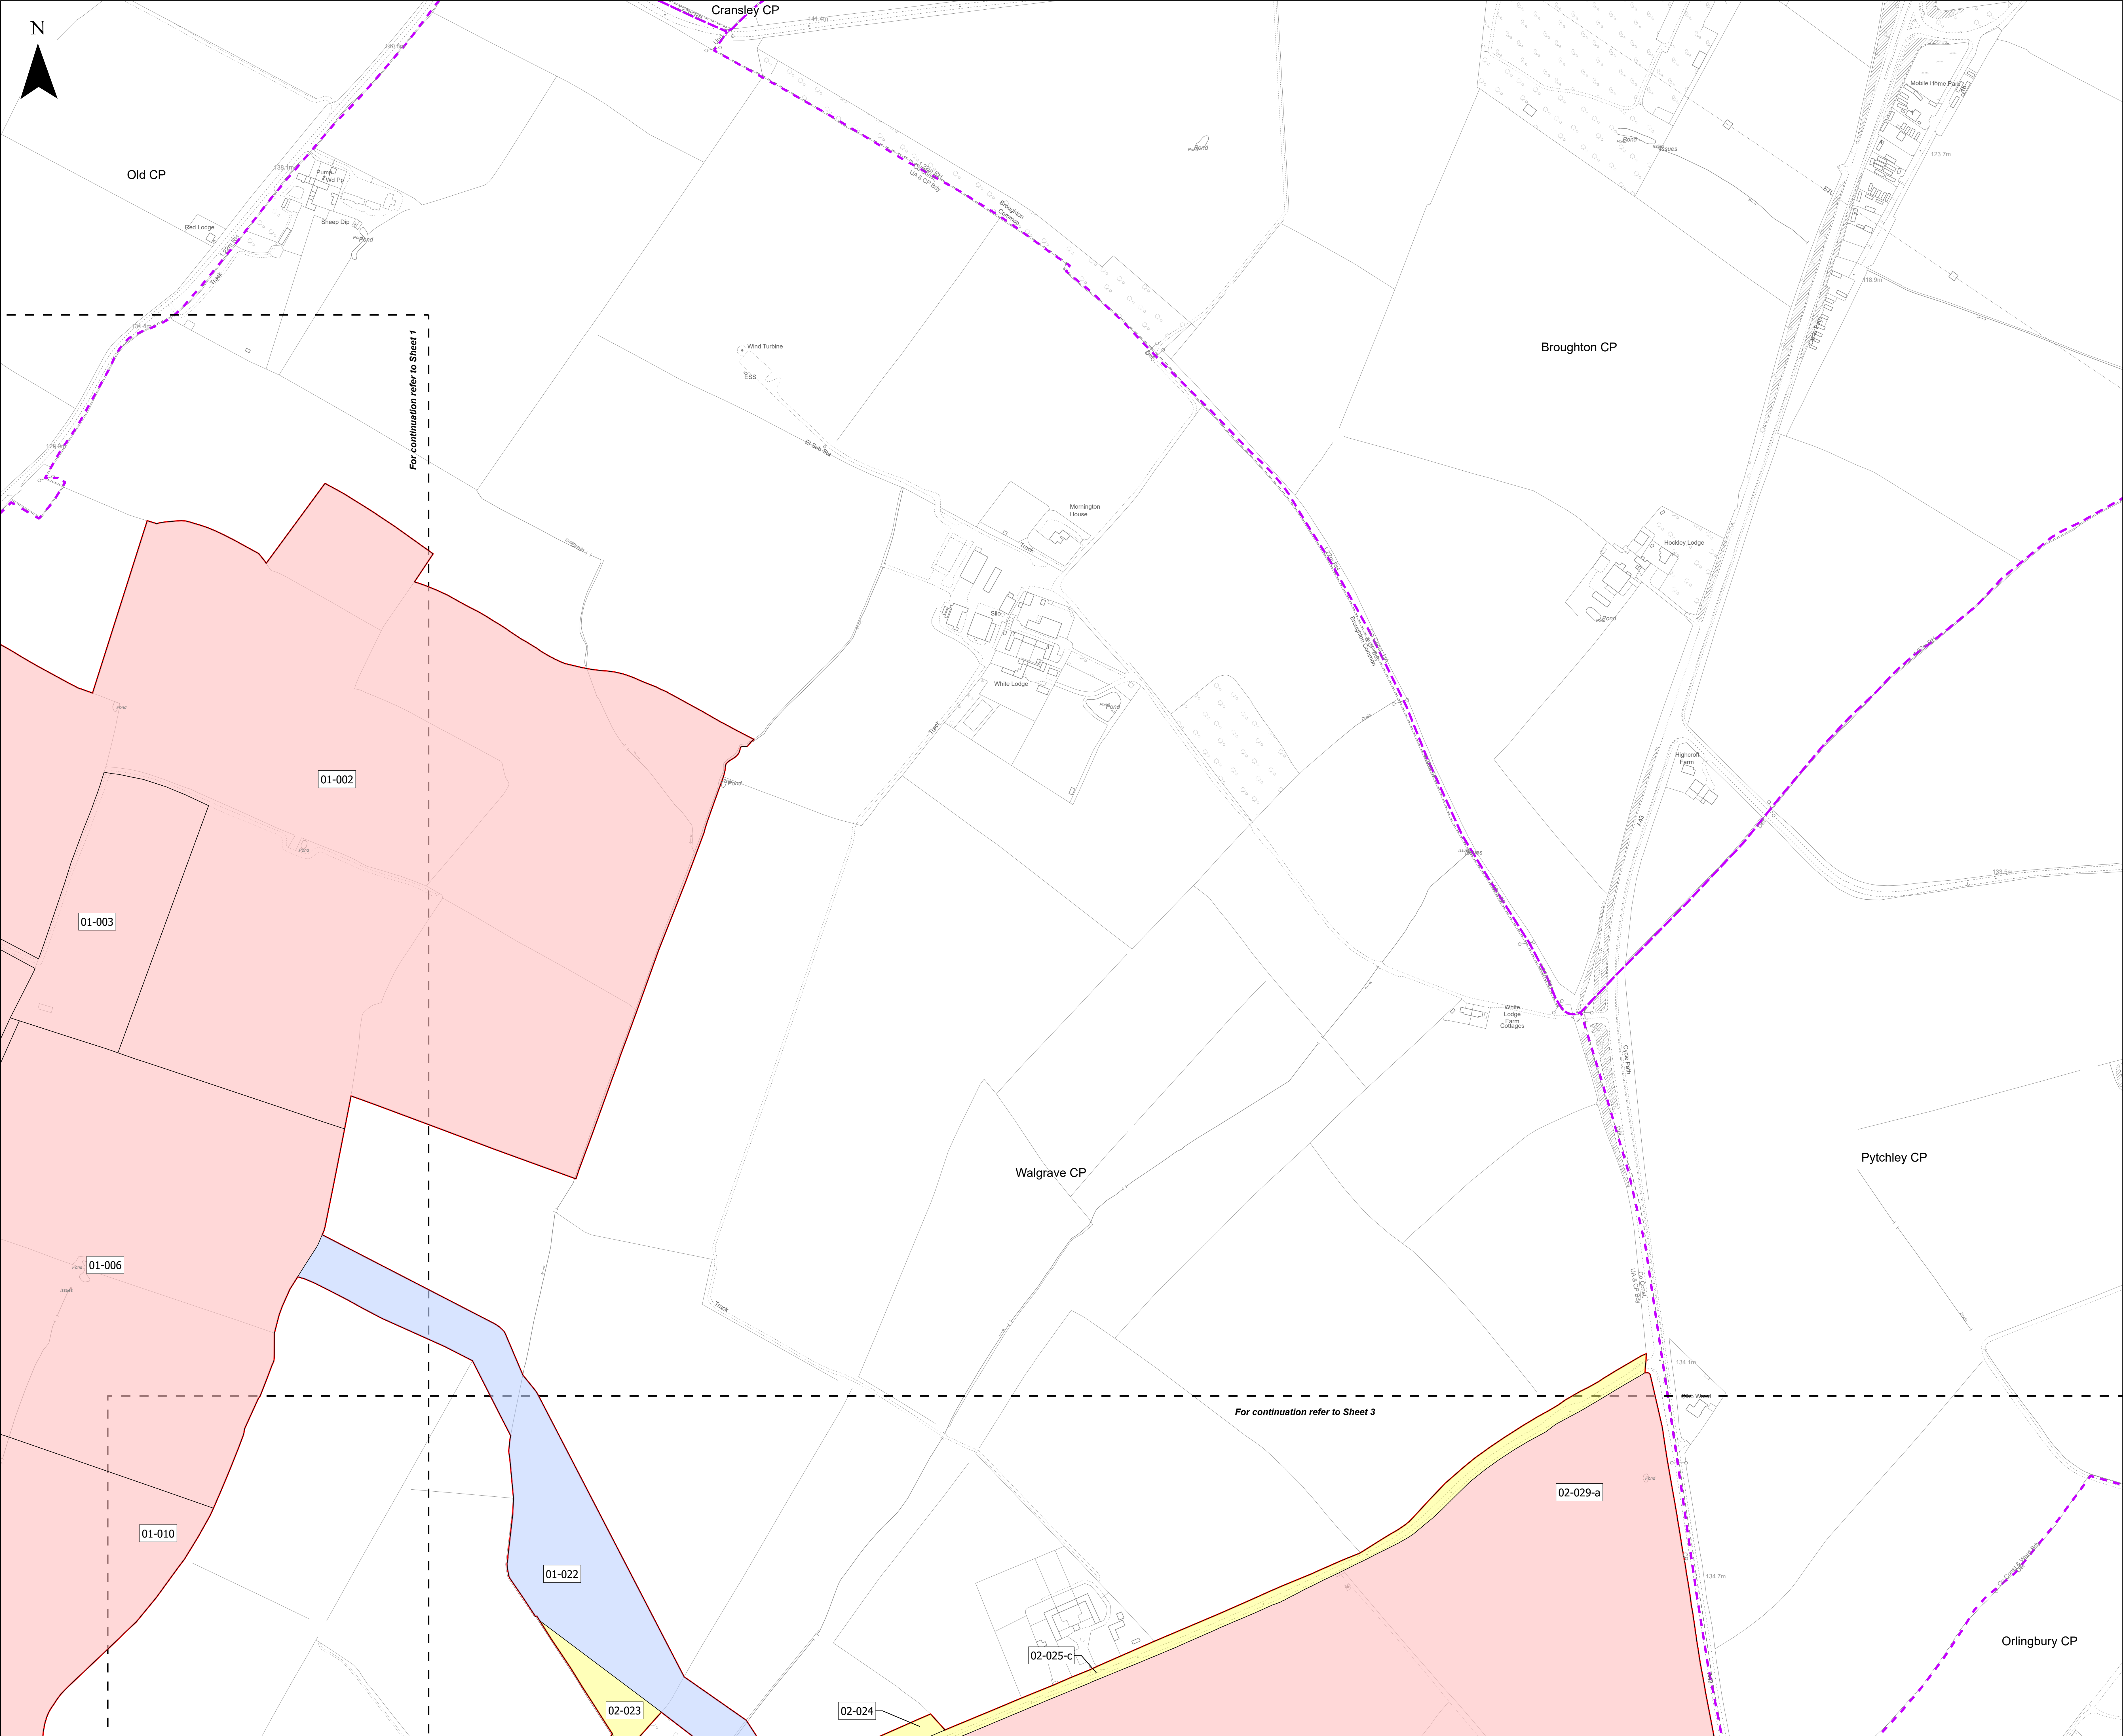

- Key**
- Order Limits
 - Freehold to be compulsorily acquired and temporary use of land and in relation to which it is proposed that easements, servitudes and other private rights will cease to have effect
 - Temporary use of land and in relation to which it is proposed to temporarily suspend easements, servitudes and other private rights
 - New rights (including restrictions) to be compulsorily acquired and temporary use of land and in relation to which it is proposed that easements, servitudes and other private rights will be suspended or cease to have effect
 - No Land Take
 - Local Authority / Parish Boundary
 - Cut Line

Base map: © Crown Copyright and database rights 2025 OS Licence no. AC0000849896. All rights reserved.

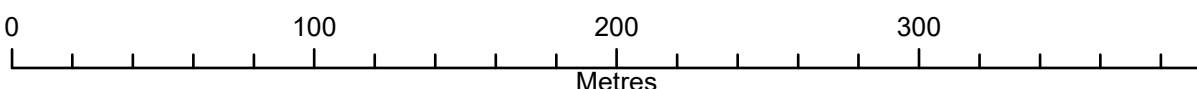


Scale: 1:2,500@ A0

APFP Regulation: 5(2)(i)	Application Doc No. CR1/GH2.2_C
Ref: IGP_GH_DCO_Land_Plan	Date: 10/11/2025
Drawn by: DLG	Checked by: AT


Land Plan
(Change Application Version)
Revision C
Sheet 2 of 18



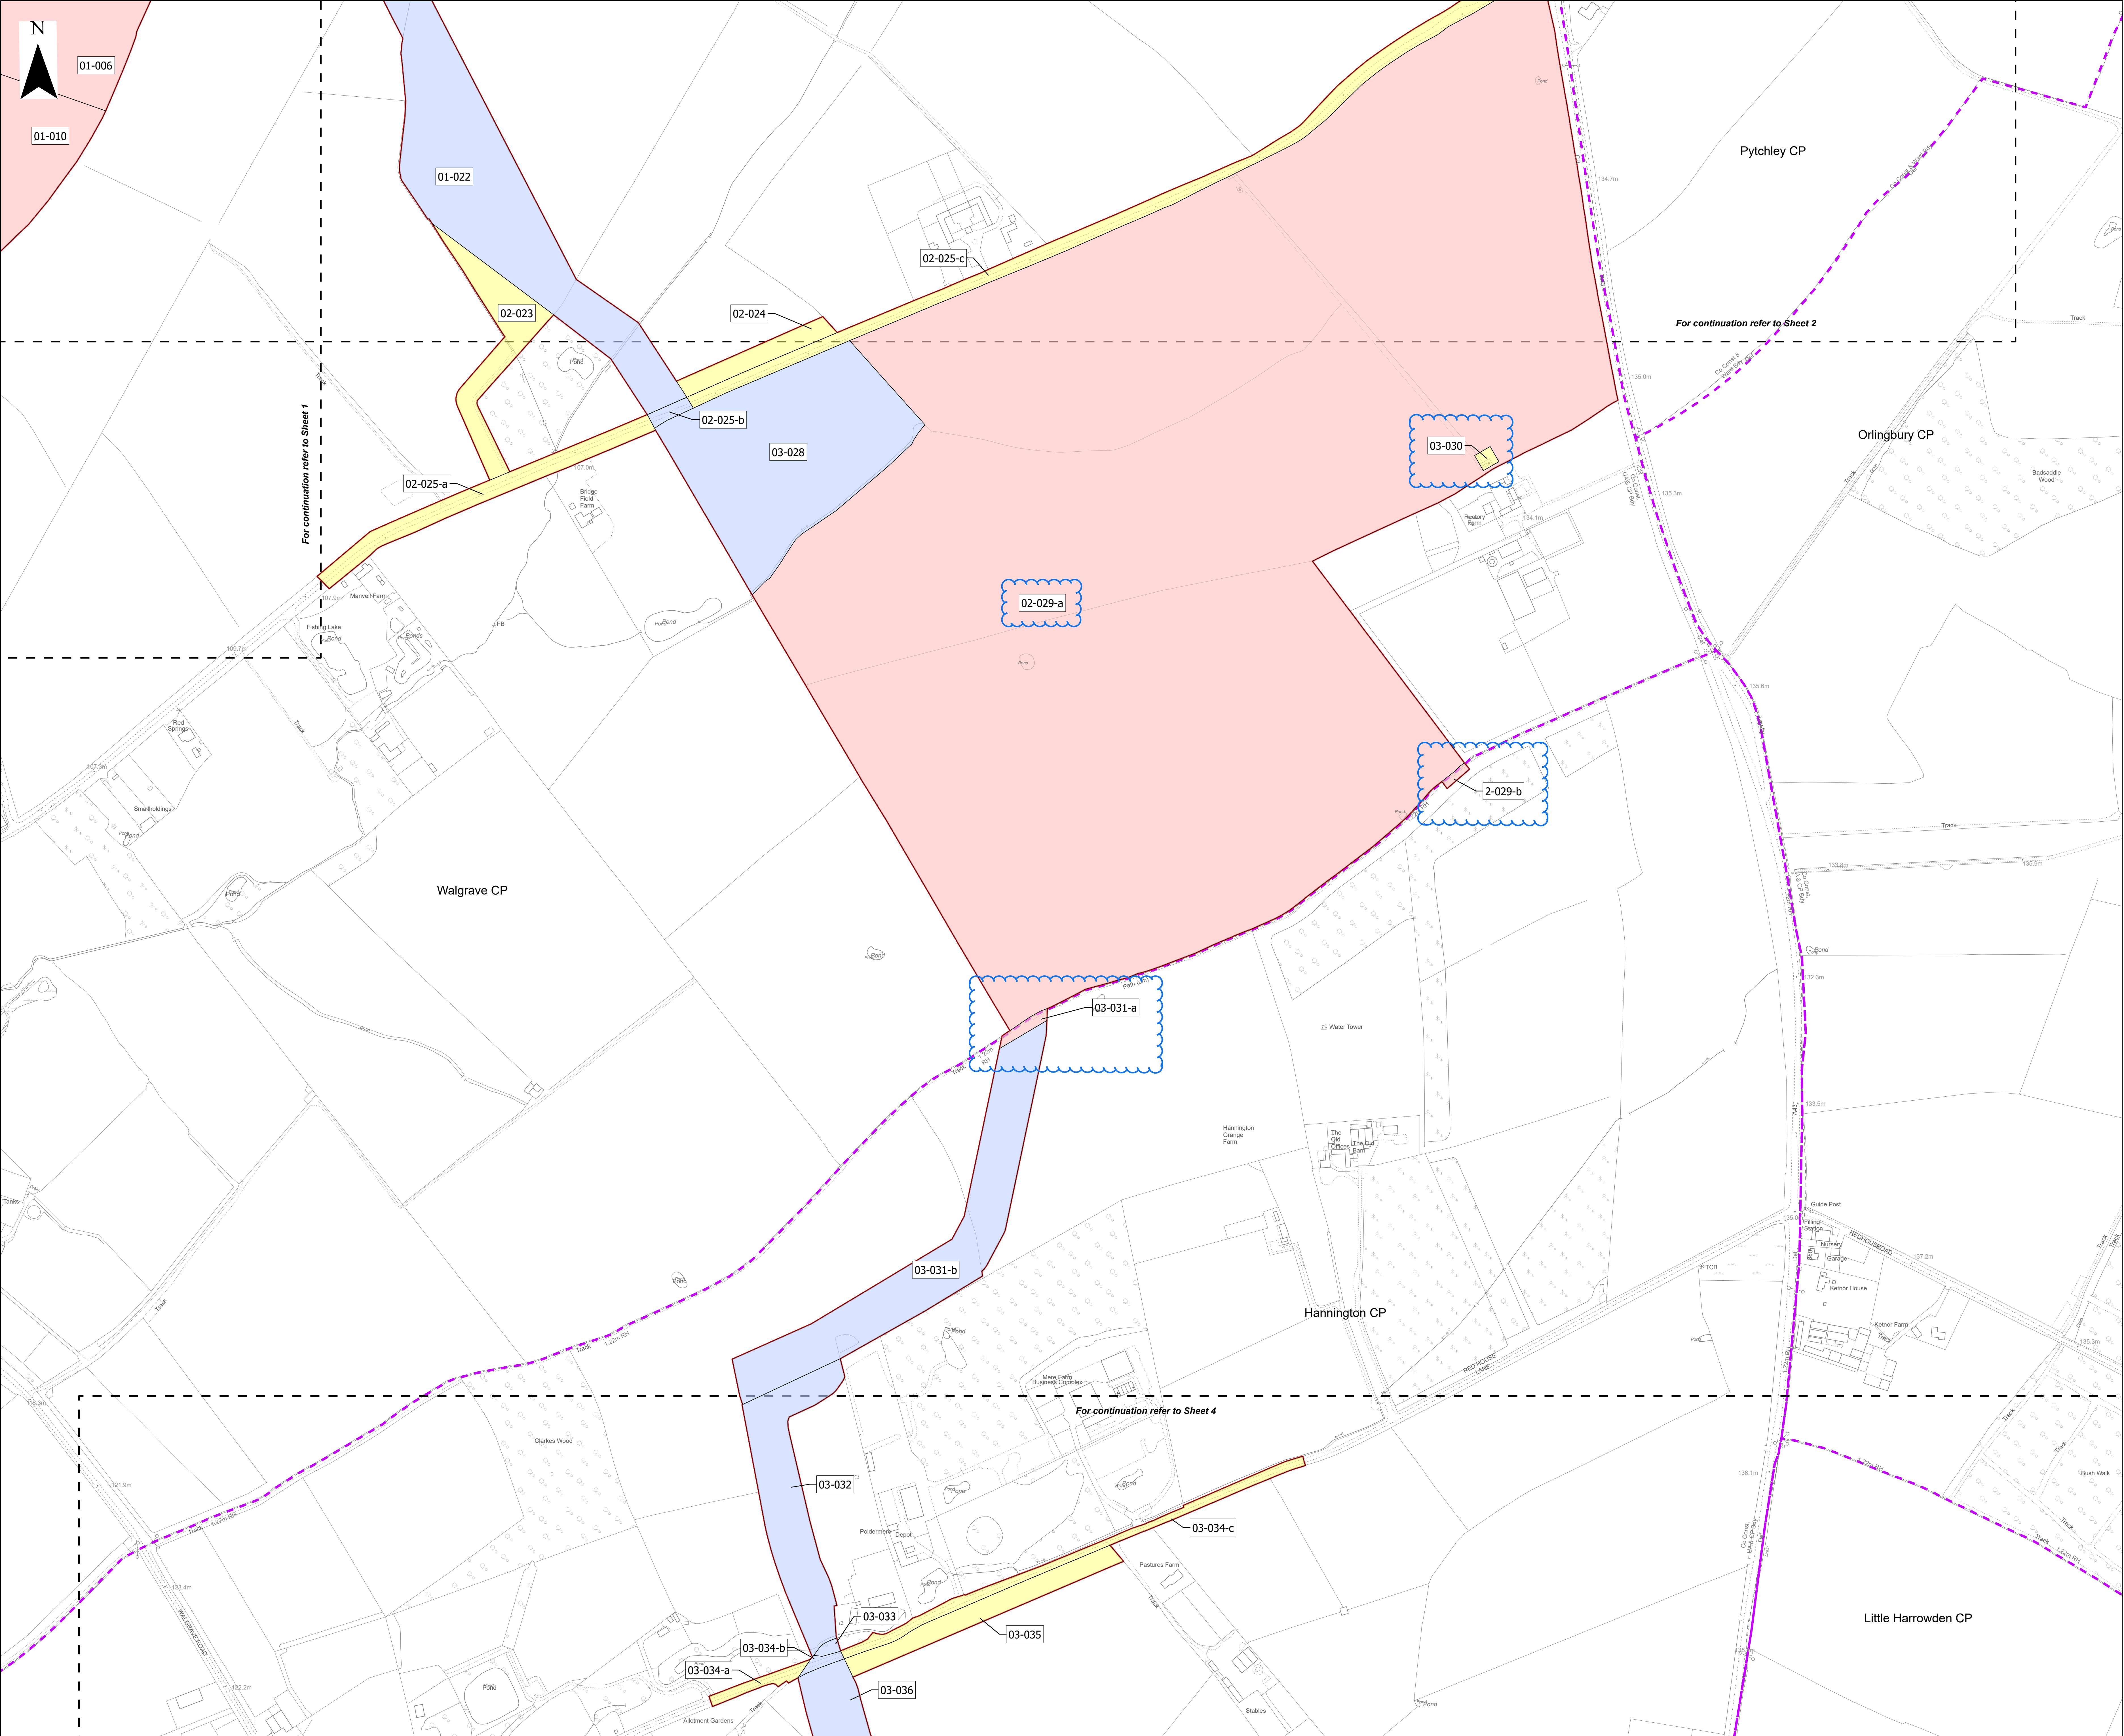

- Key**
- Order Limits
 - Freehold to be compulsorily acquired and temporary use of land and in relation to which it is proposed that easements, servitudes and other private rights will cease to have effect
 - Temporary use of land and in relation to which it is proposed to temporarily suspend easements, servitudes and other private rights
 - New rights (including restrictions) to be compulsorily acquired and temporary use of land and in relation to which it is proposed that easements, servitudes and other private rights will be suspended or cease to have effect
 - No Land Take
 - Local Authority / Parish Boundary
 - Cut Line

Base map: © Crown Copyright and database rights 2025 OS Licence no. AC000849896. All rights reserved.

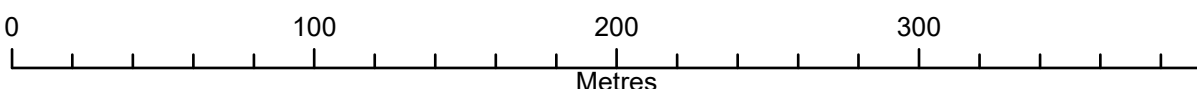


Scale: 1:2,500@ A0


APFP Regulation: 5(2)(i)	Application Doc No. CR1/GH2_2_C
Ref: IGP_GH_DCO_Land_Plan	Date: 10/11/2025
Drawn by: DLG	Checked by: AT

Land Plan
(Change Application Version)
Revision C
Sheet 3 of 18



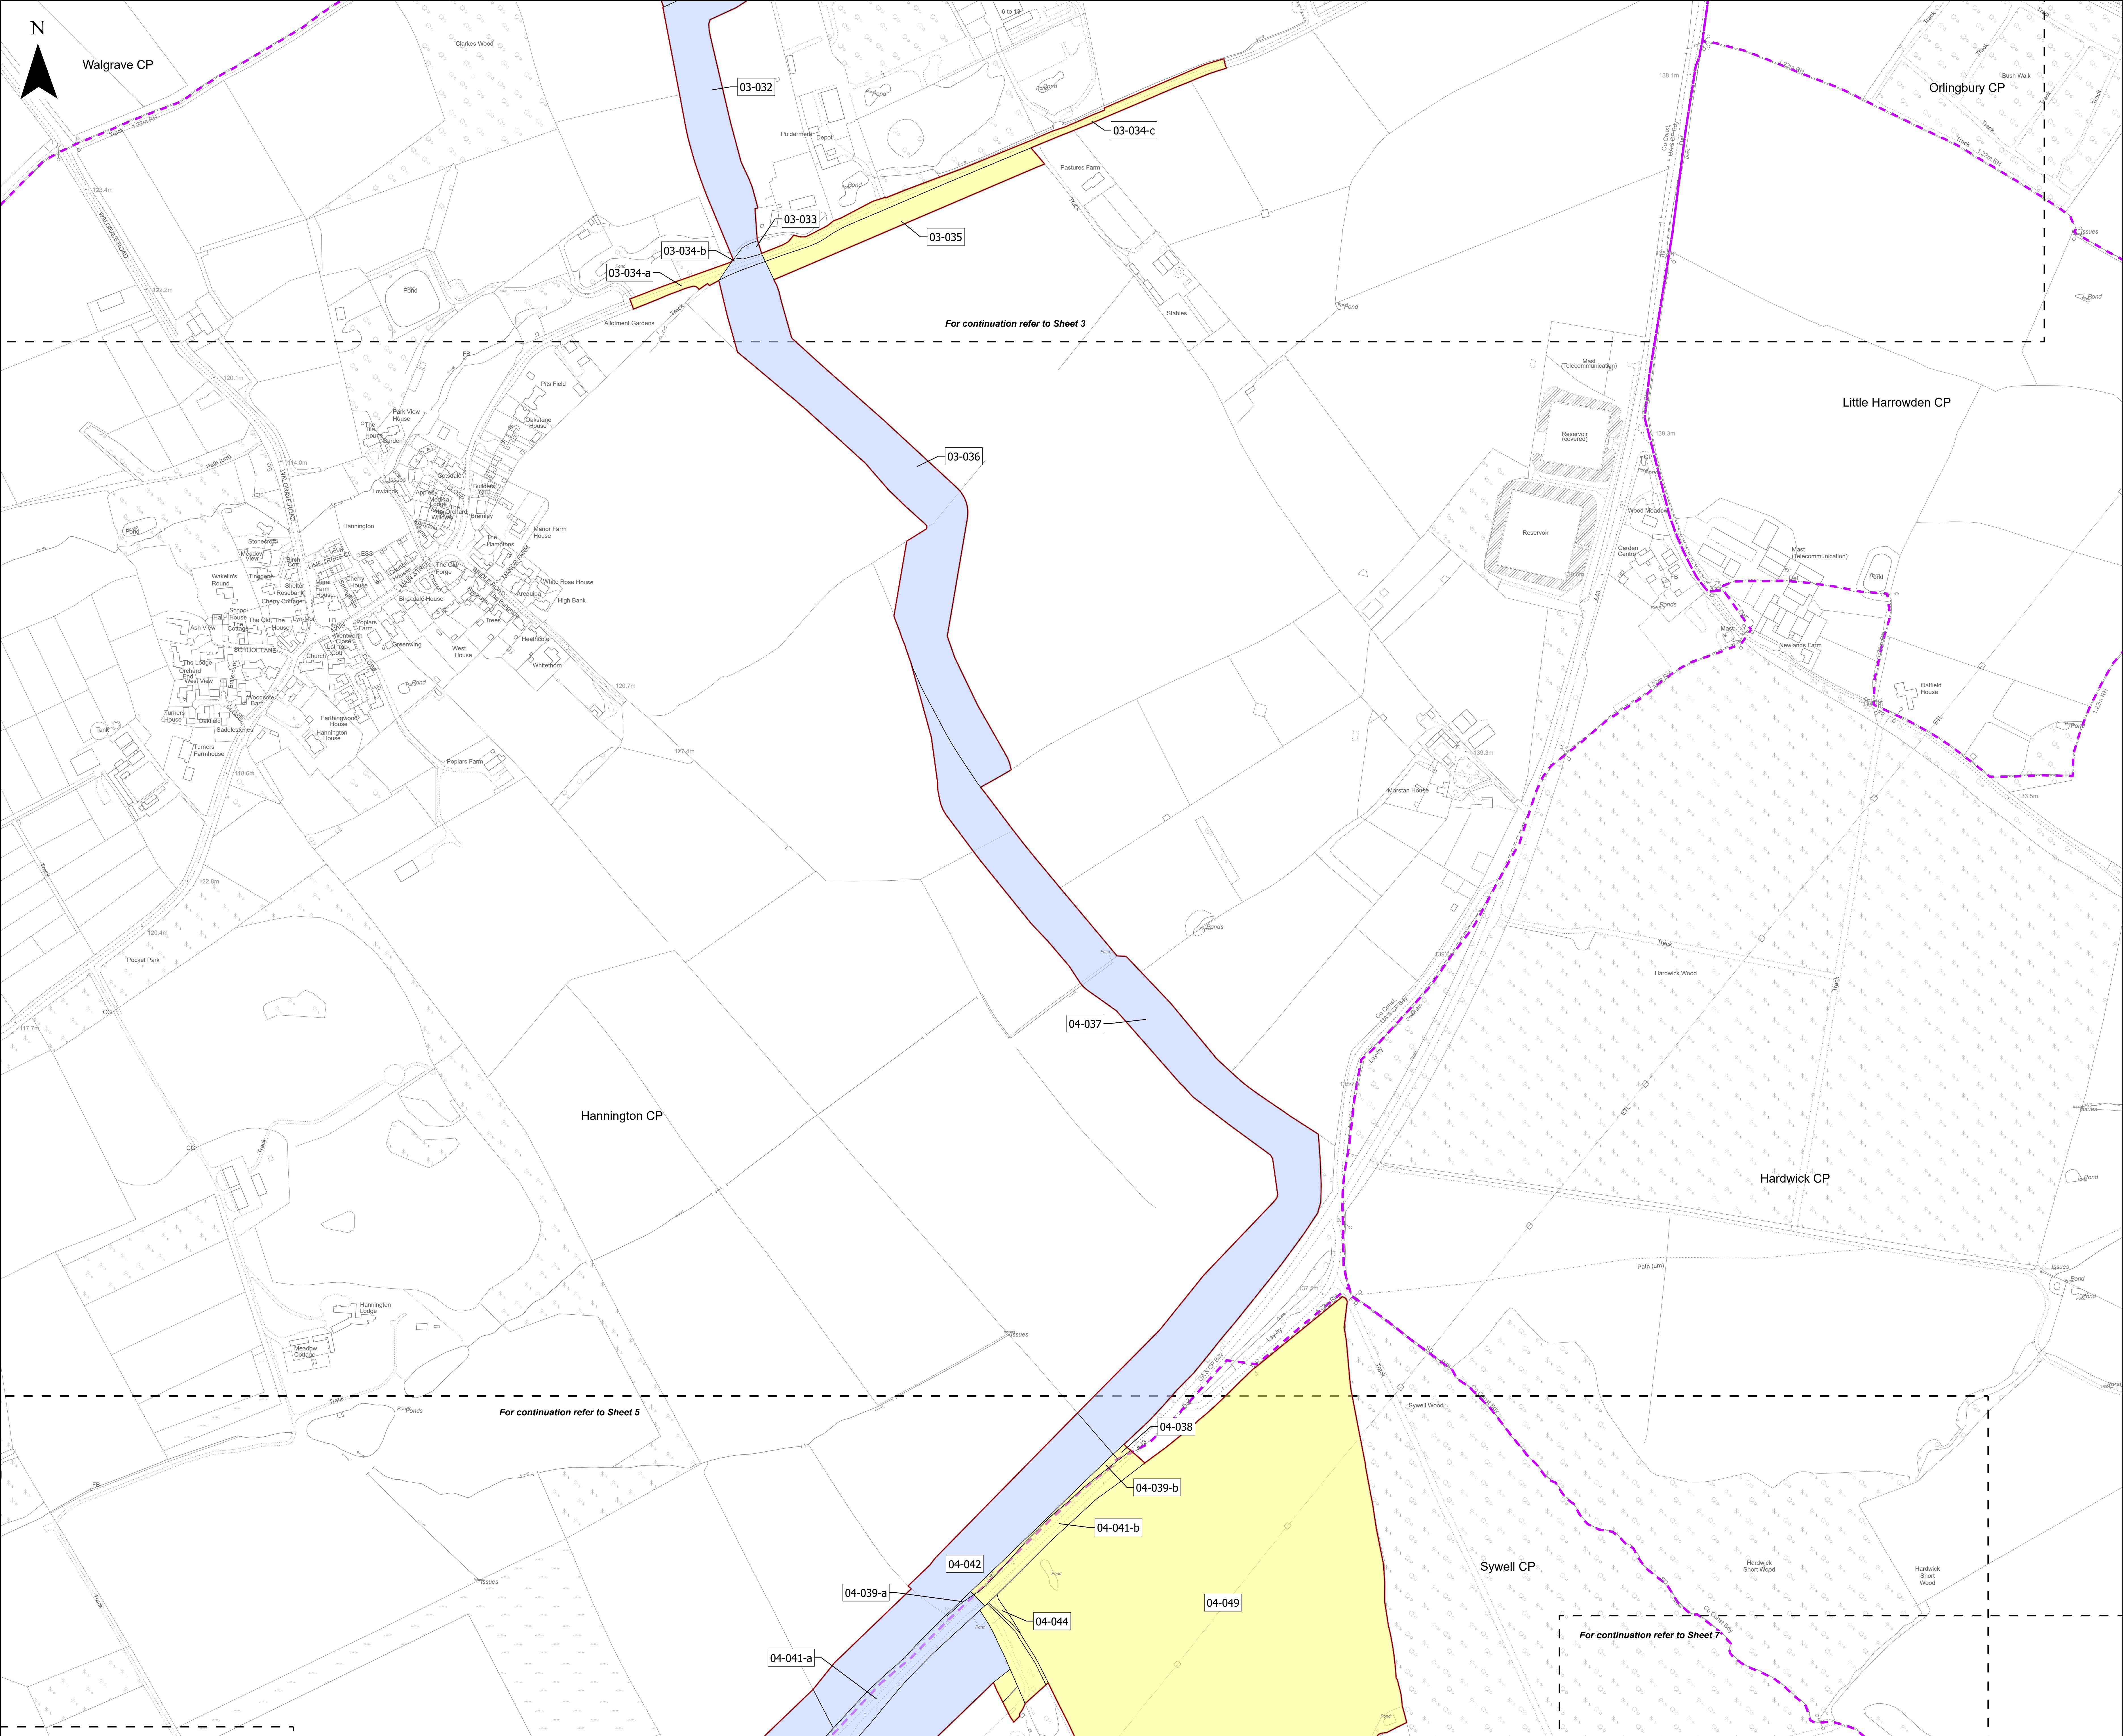


- Key**
- Order Limits
 - Freehold to be compulsorily acquired and temporary use of land and in relation to which it is proposed that easements, servitudes and other private rights will cease to have effect
 - Temporary use of land and in relation to which it is proposed to temporarily suspend easements, servitudes and other private rights
 - New rights (including restrictions) to be compulsorily acquired and temporary use of land and in relation to which it is proposed that easements, servitudes and other private rights will be suspended or cease to have effect
 - No Land Take
 - Local Authority / Parish Boundary
 - Cut Line

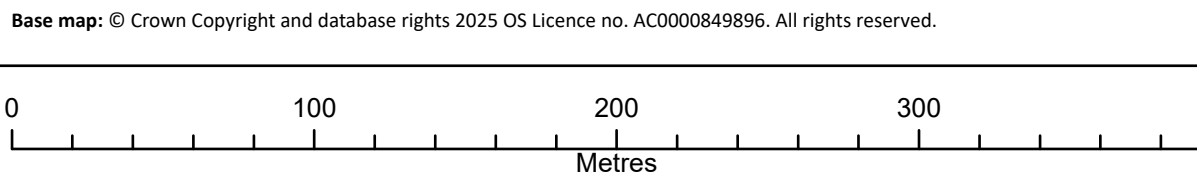

APFP Regulation: 5(2)(i)	Application Doc No. CR1/GH2.2_C
Ref: IGP_GH_DCO_Land_Plan	Date: 10/11/2025
Drawn by: DLG	Checked by: AT


Land Plan
(Change Application Version)
Revision C
Sheet 4 of 18

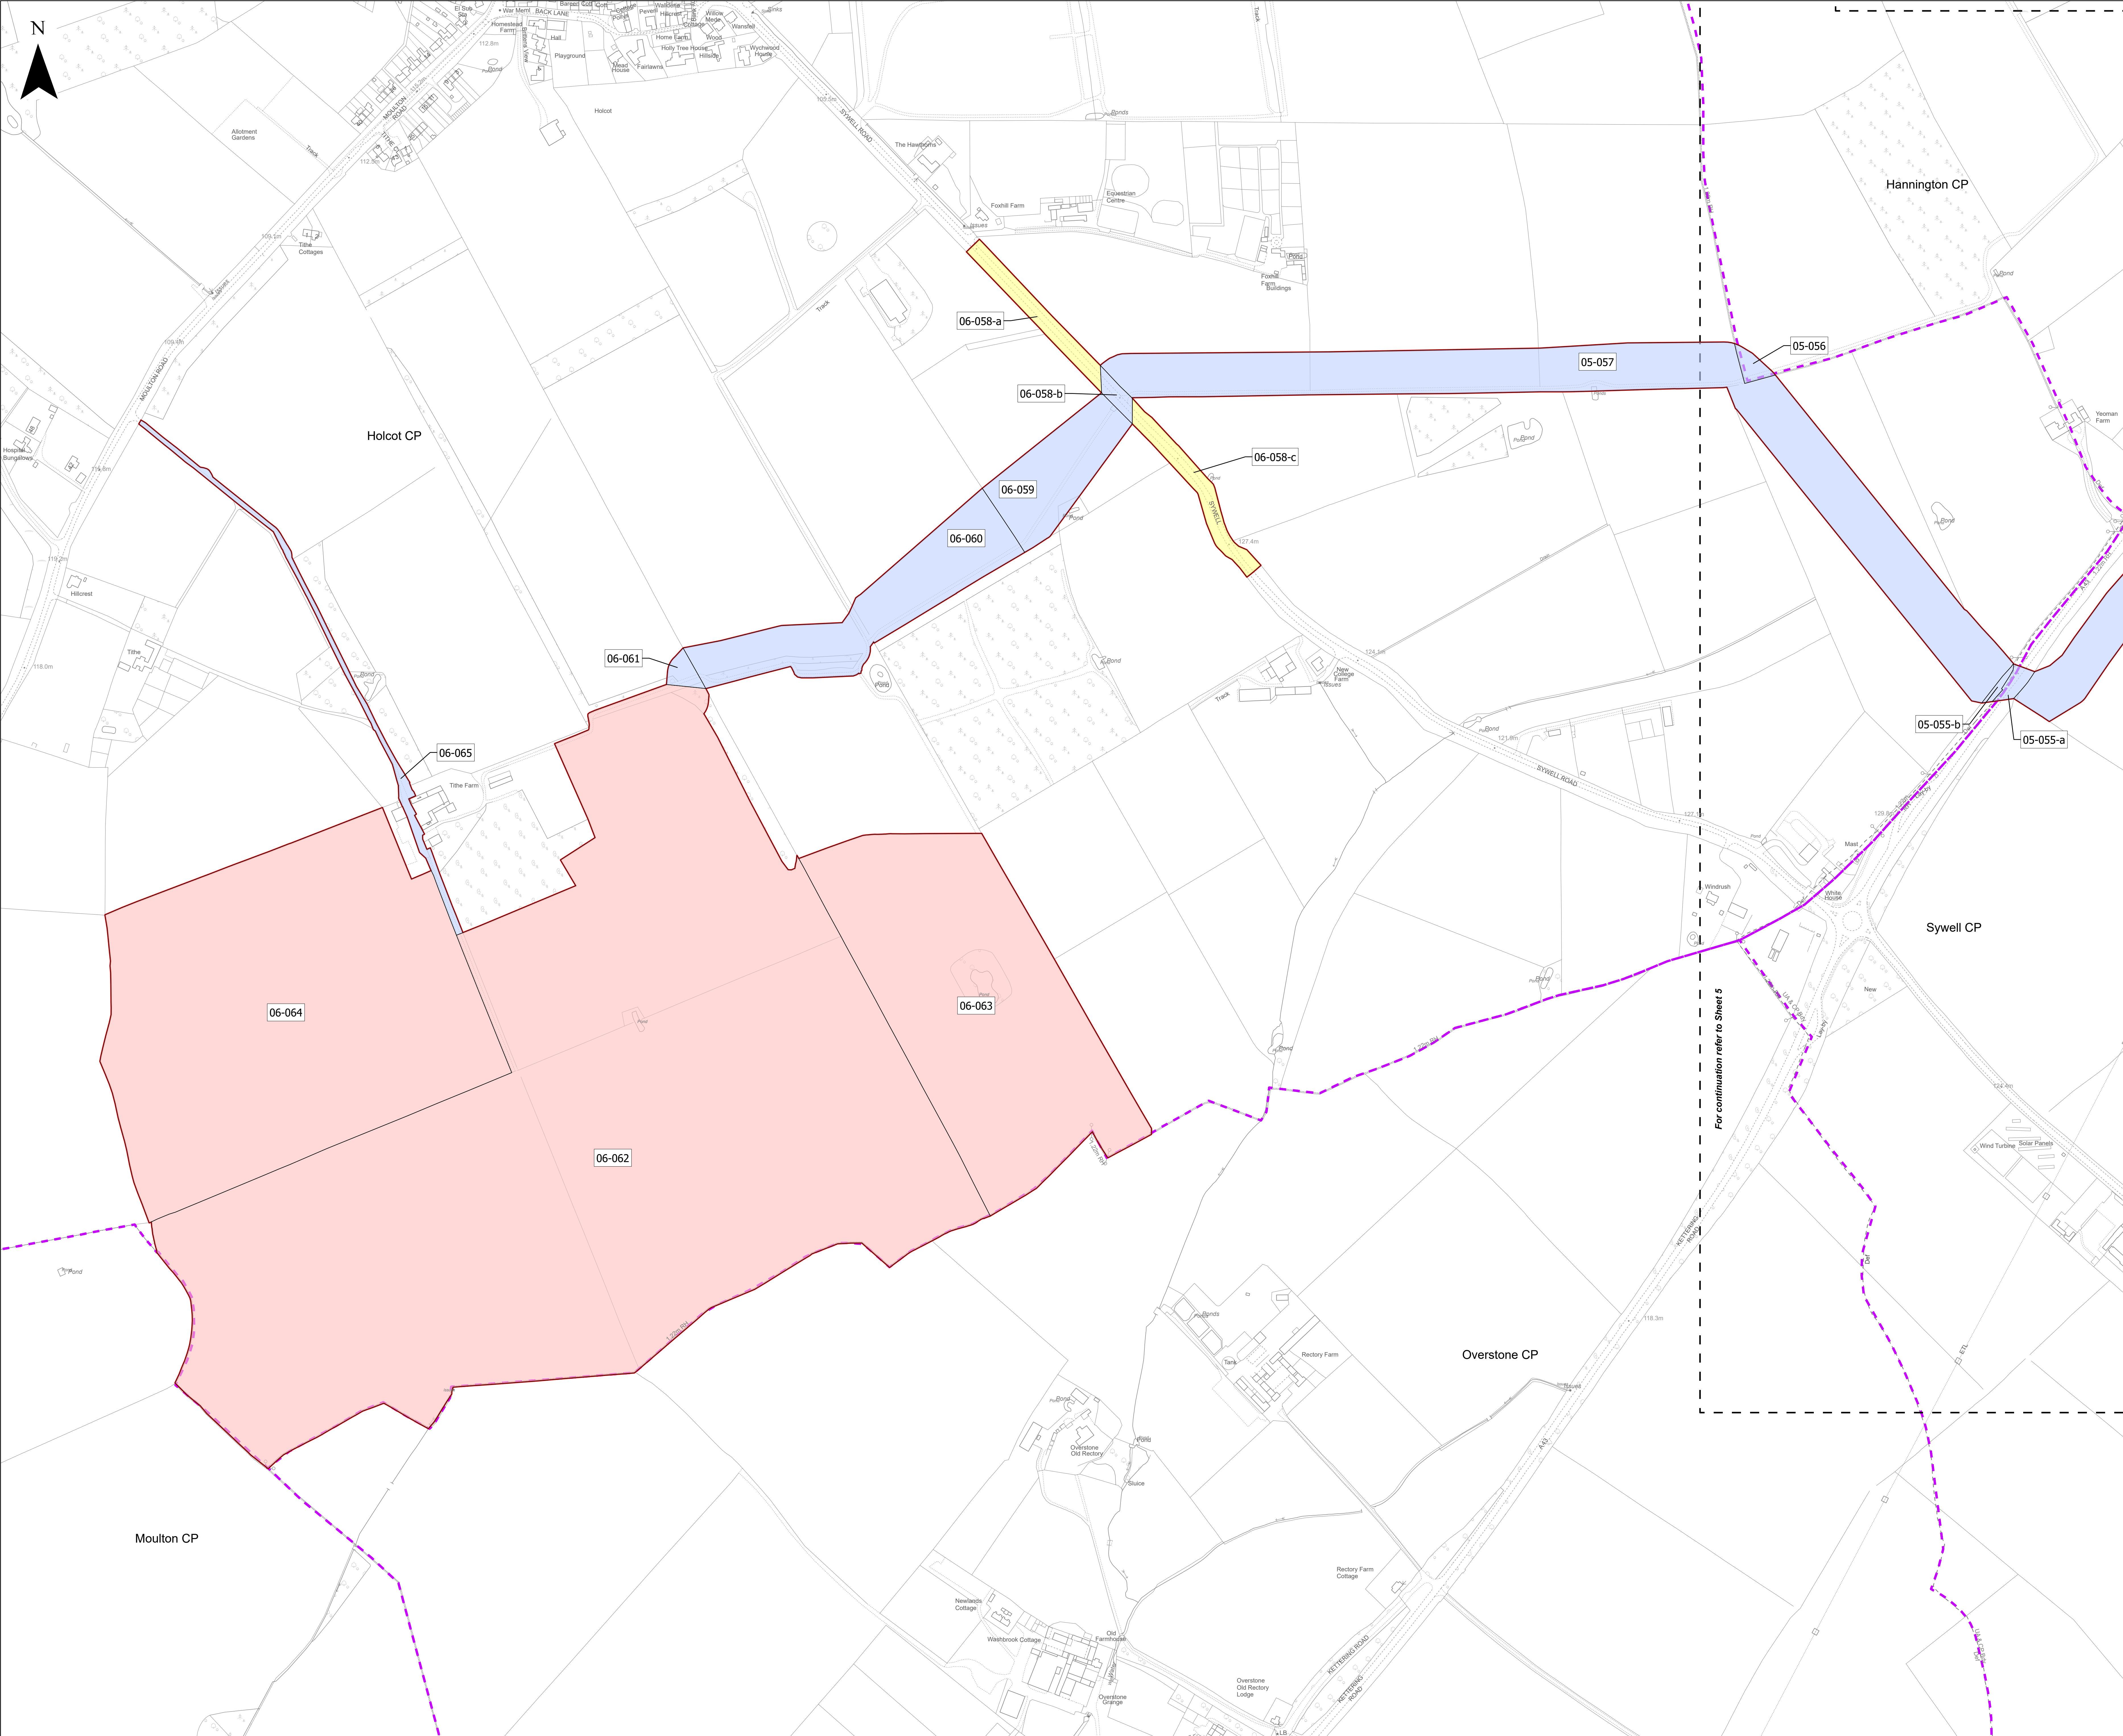

Key

-  **Order Limits**
-  Freehold to be compulsorily acquired and temporary use of land and in relation to which it is proposed that easements, servitudes and other private rights will cease to have effect
-  Temporary use of land and in relation to which it is proposed to temporarily suspend easements, servitudes and other private rights
-  New rights (including restrictions) to be compulsorily acquired and temporary use of land and in relation to which it is proposed that easements, servitudes and other private rights will be suspended or cease to have effect
-  No Land Take
-  Local Authority / Parish Boundary
-  Cut Line

Base map: © Crown Copyright and database rights 2025 OS Licence no. AC0000849896. All rights reserved.

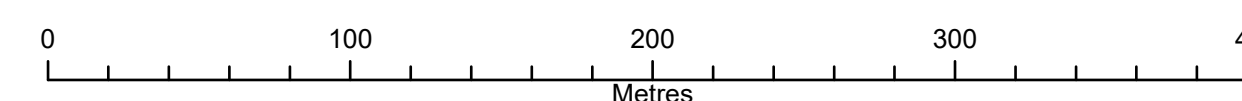


Scale: 1:2,500@ A0

APFP Regulation: 5(2)(i)	Application Doc No. CR1/GH2.2_C
Ref: IGP_GH_DCO_Land_Plan	Date: 10/11/2025
Drawn by: DLG	Checked by: AT

**Land Plan
(Change Application Version)**

Revision C
Sheet 6 of 18

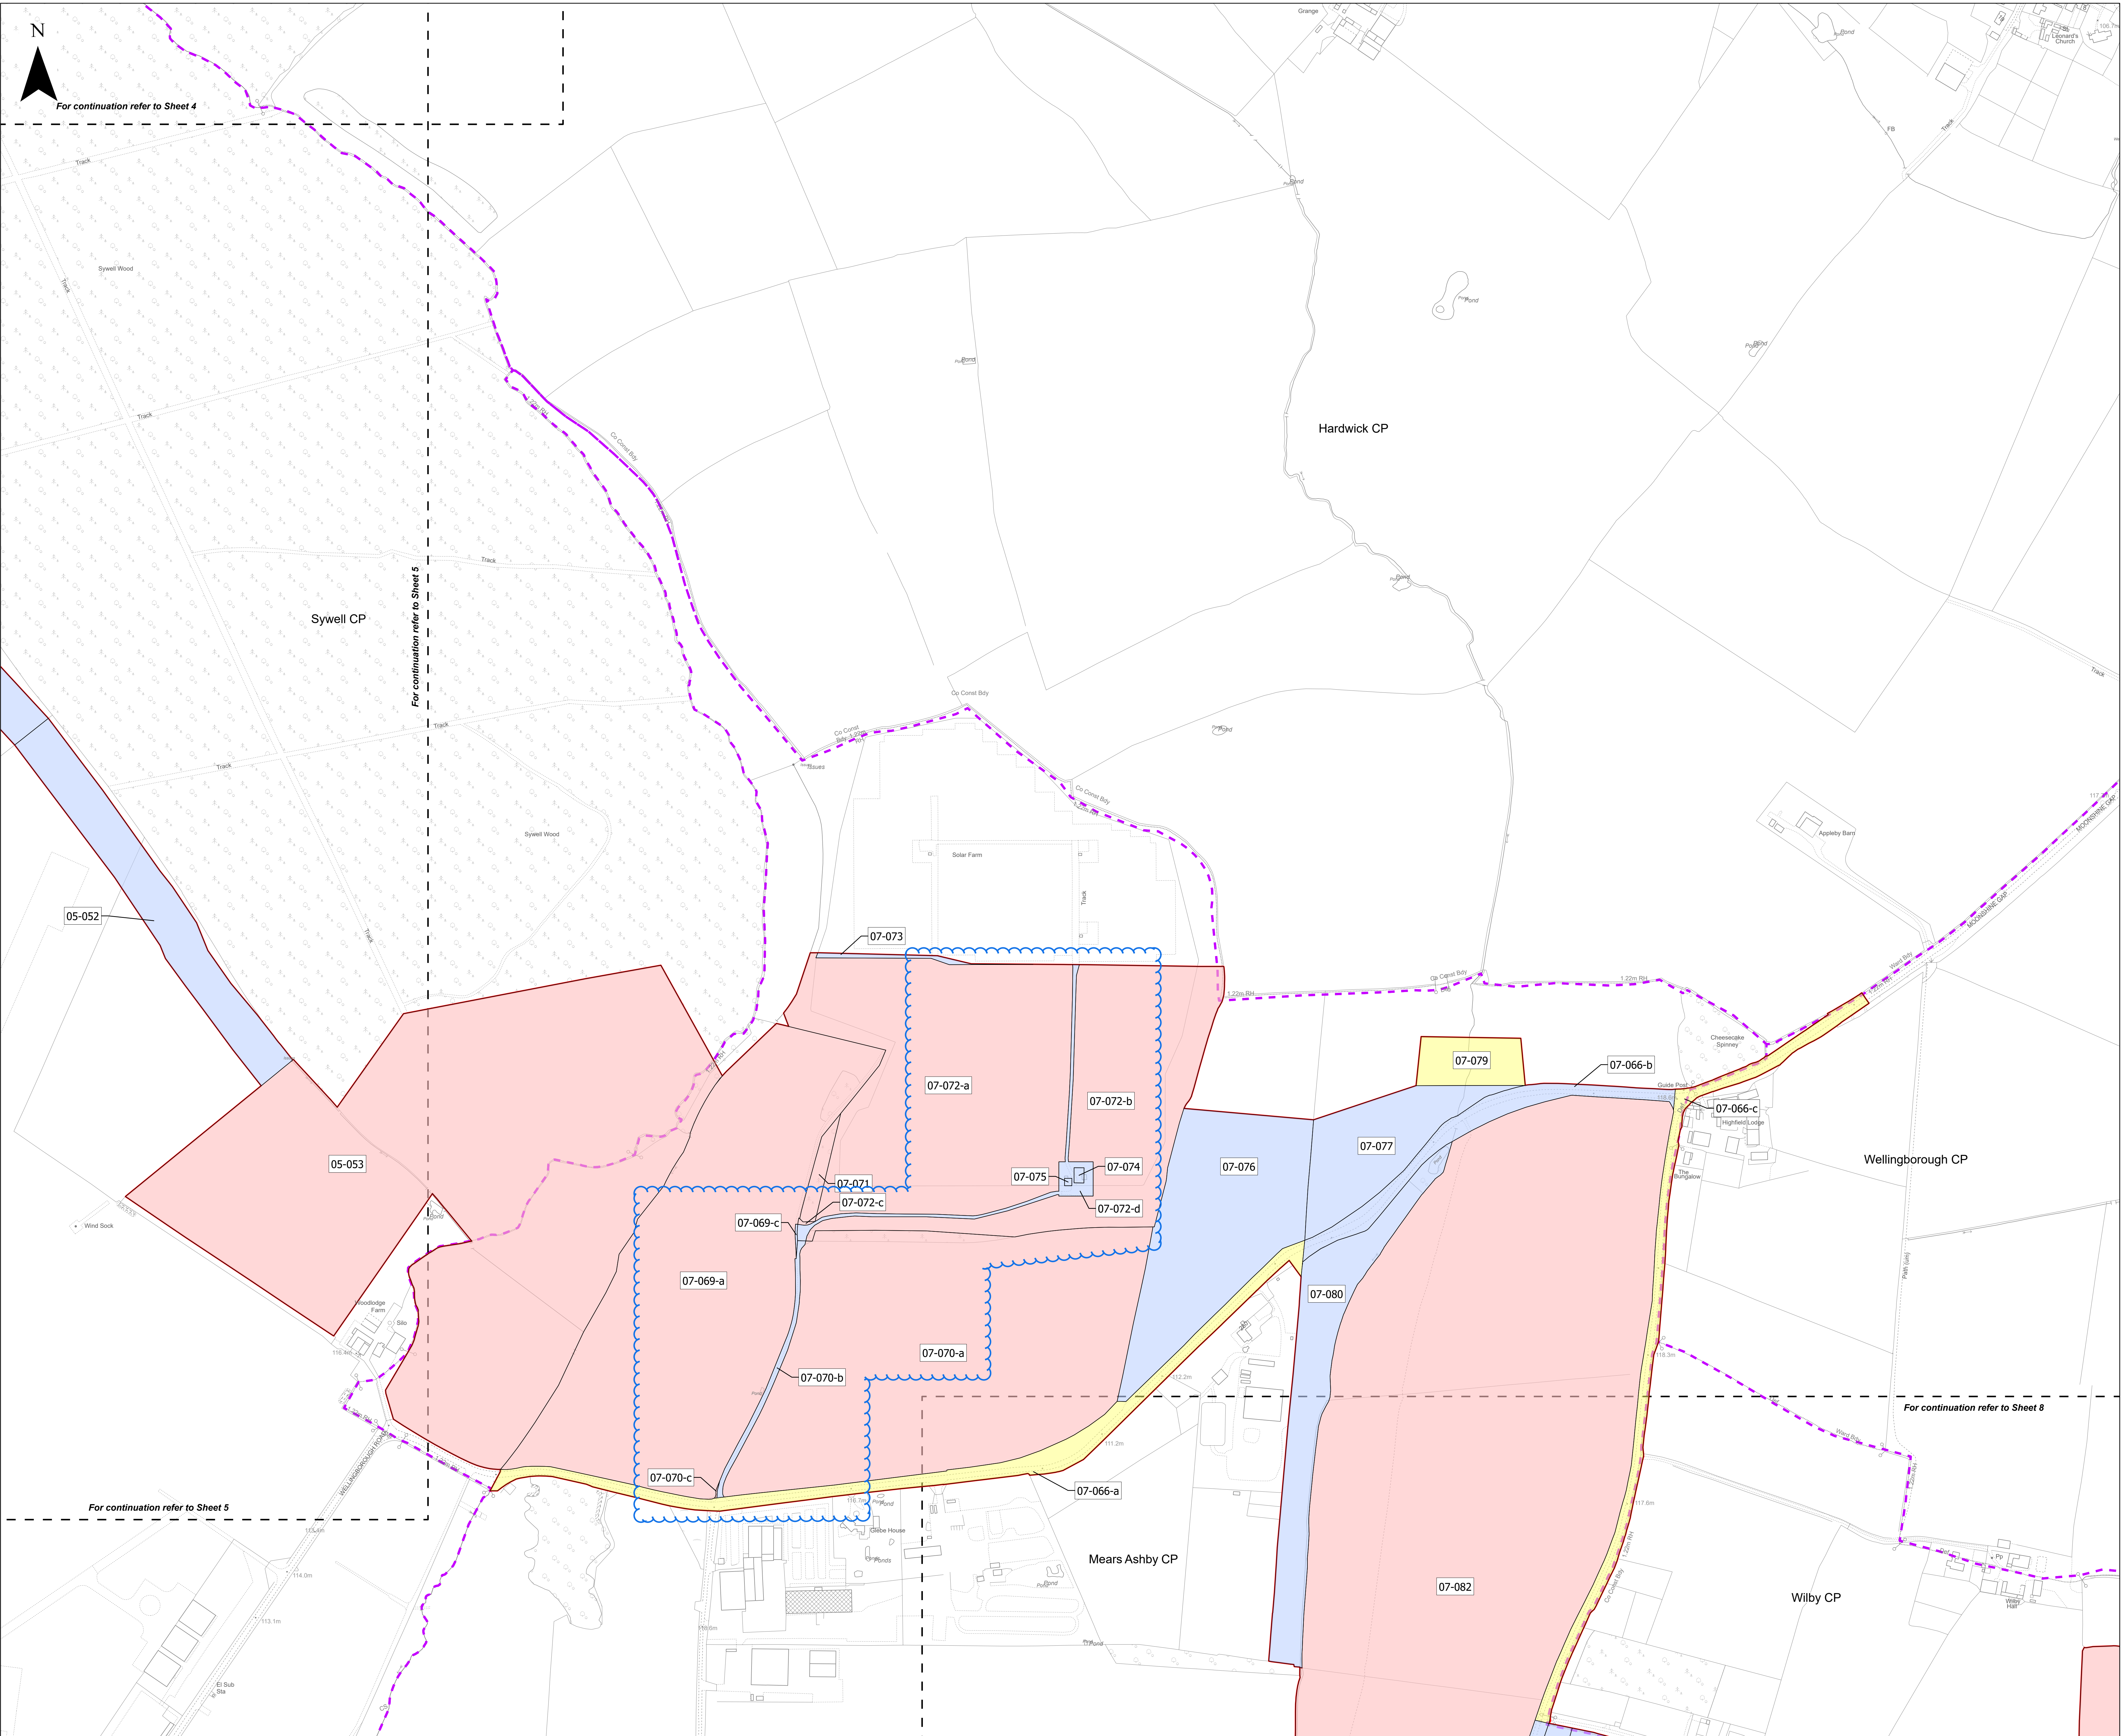




Key

- Order Limits
- Freehold to be compulsorily acquired and temporary use of land and in relation to which it is proposed that easements, servitudes and other private rights will cease to have effect
- Temporary use of land and in relation to which it is proposed to temporarily suspend easements, servitudes and other private rights
- New rights (including restrictions) to be compulsorily acquired and temporary use of land and in relation to which it is proposed that easements, servitudes and other private rights will be suspended or cease to have effect
- No Land Take
- Local Authority / Parish Boundary
- Cut Line

Base map: © Crown Copyright and database rights 2025 OS Licence no. AC000849896. All rights reserved.


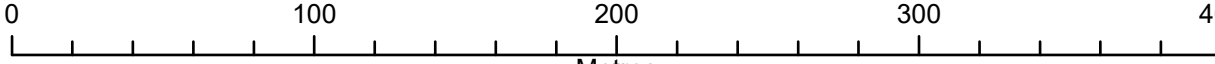


Scale: 1:2,500@ A0

APFP Regulation: 5(2)(i)	Application Doc No. CR1/GH2.2_C
Ref: IGP_GH_DCO_Land_Plan	Date: 10/11/2025
Drawn by: DLG	Checked by: AT


Land Plan
(Change Application Version)
Revision C
Sheet 7 of 18



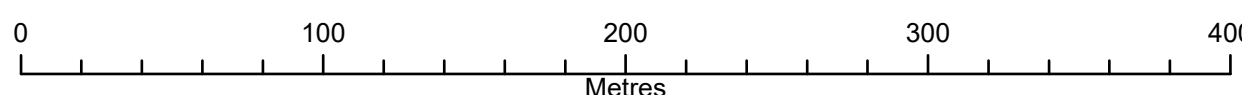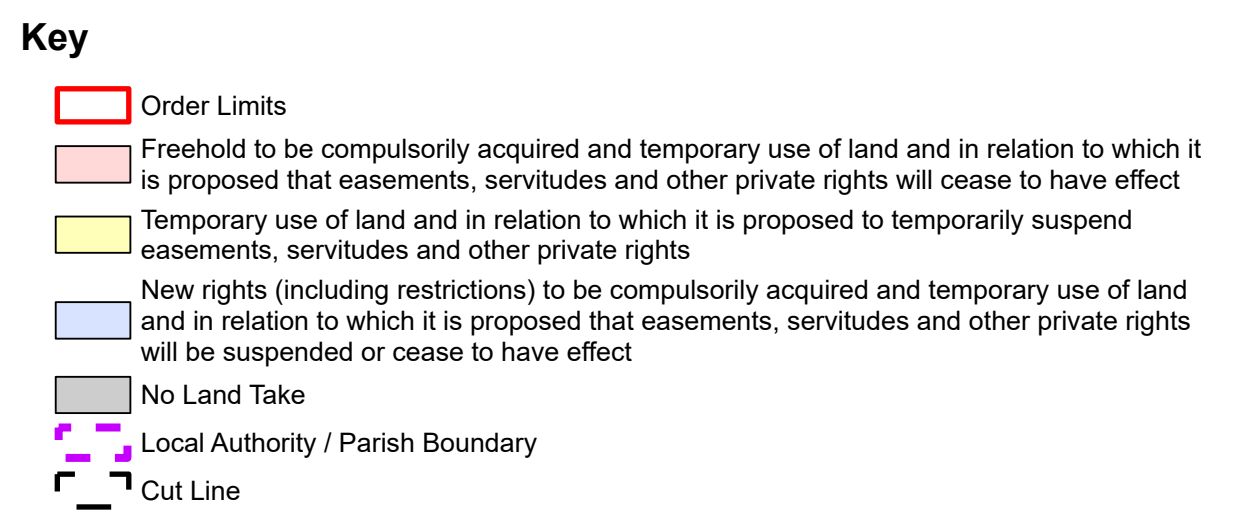


Drawn by: DLG	Checked by: AT
---------------	----------------



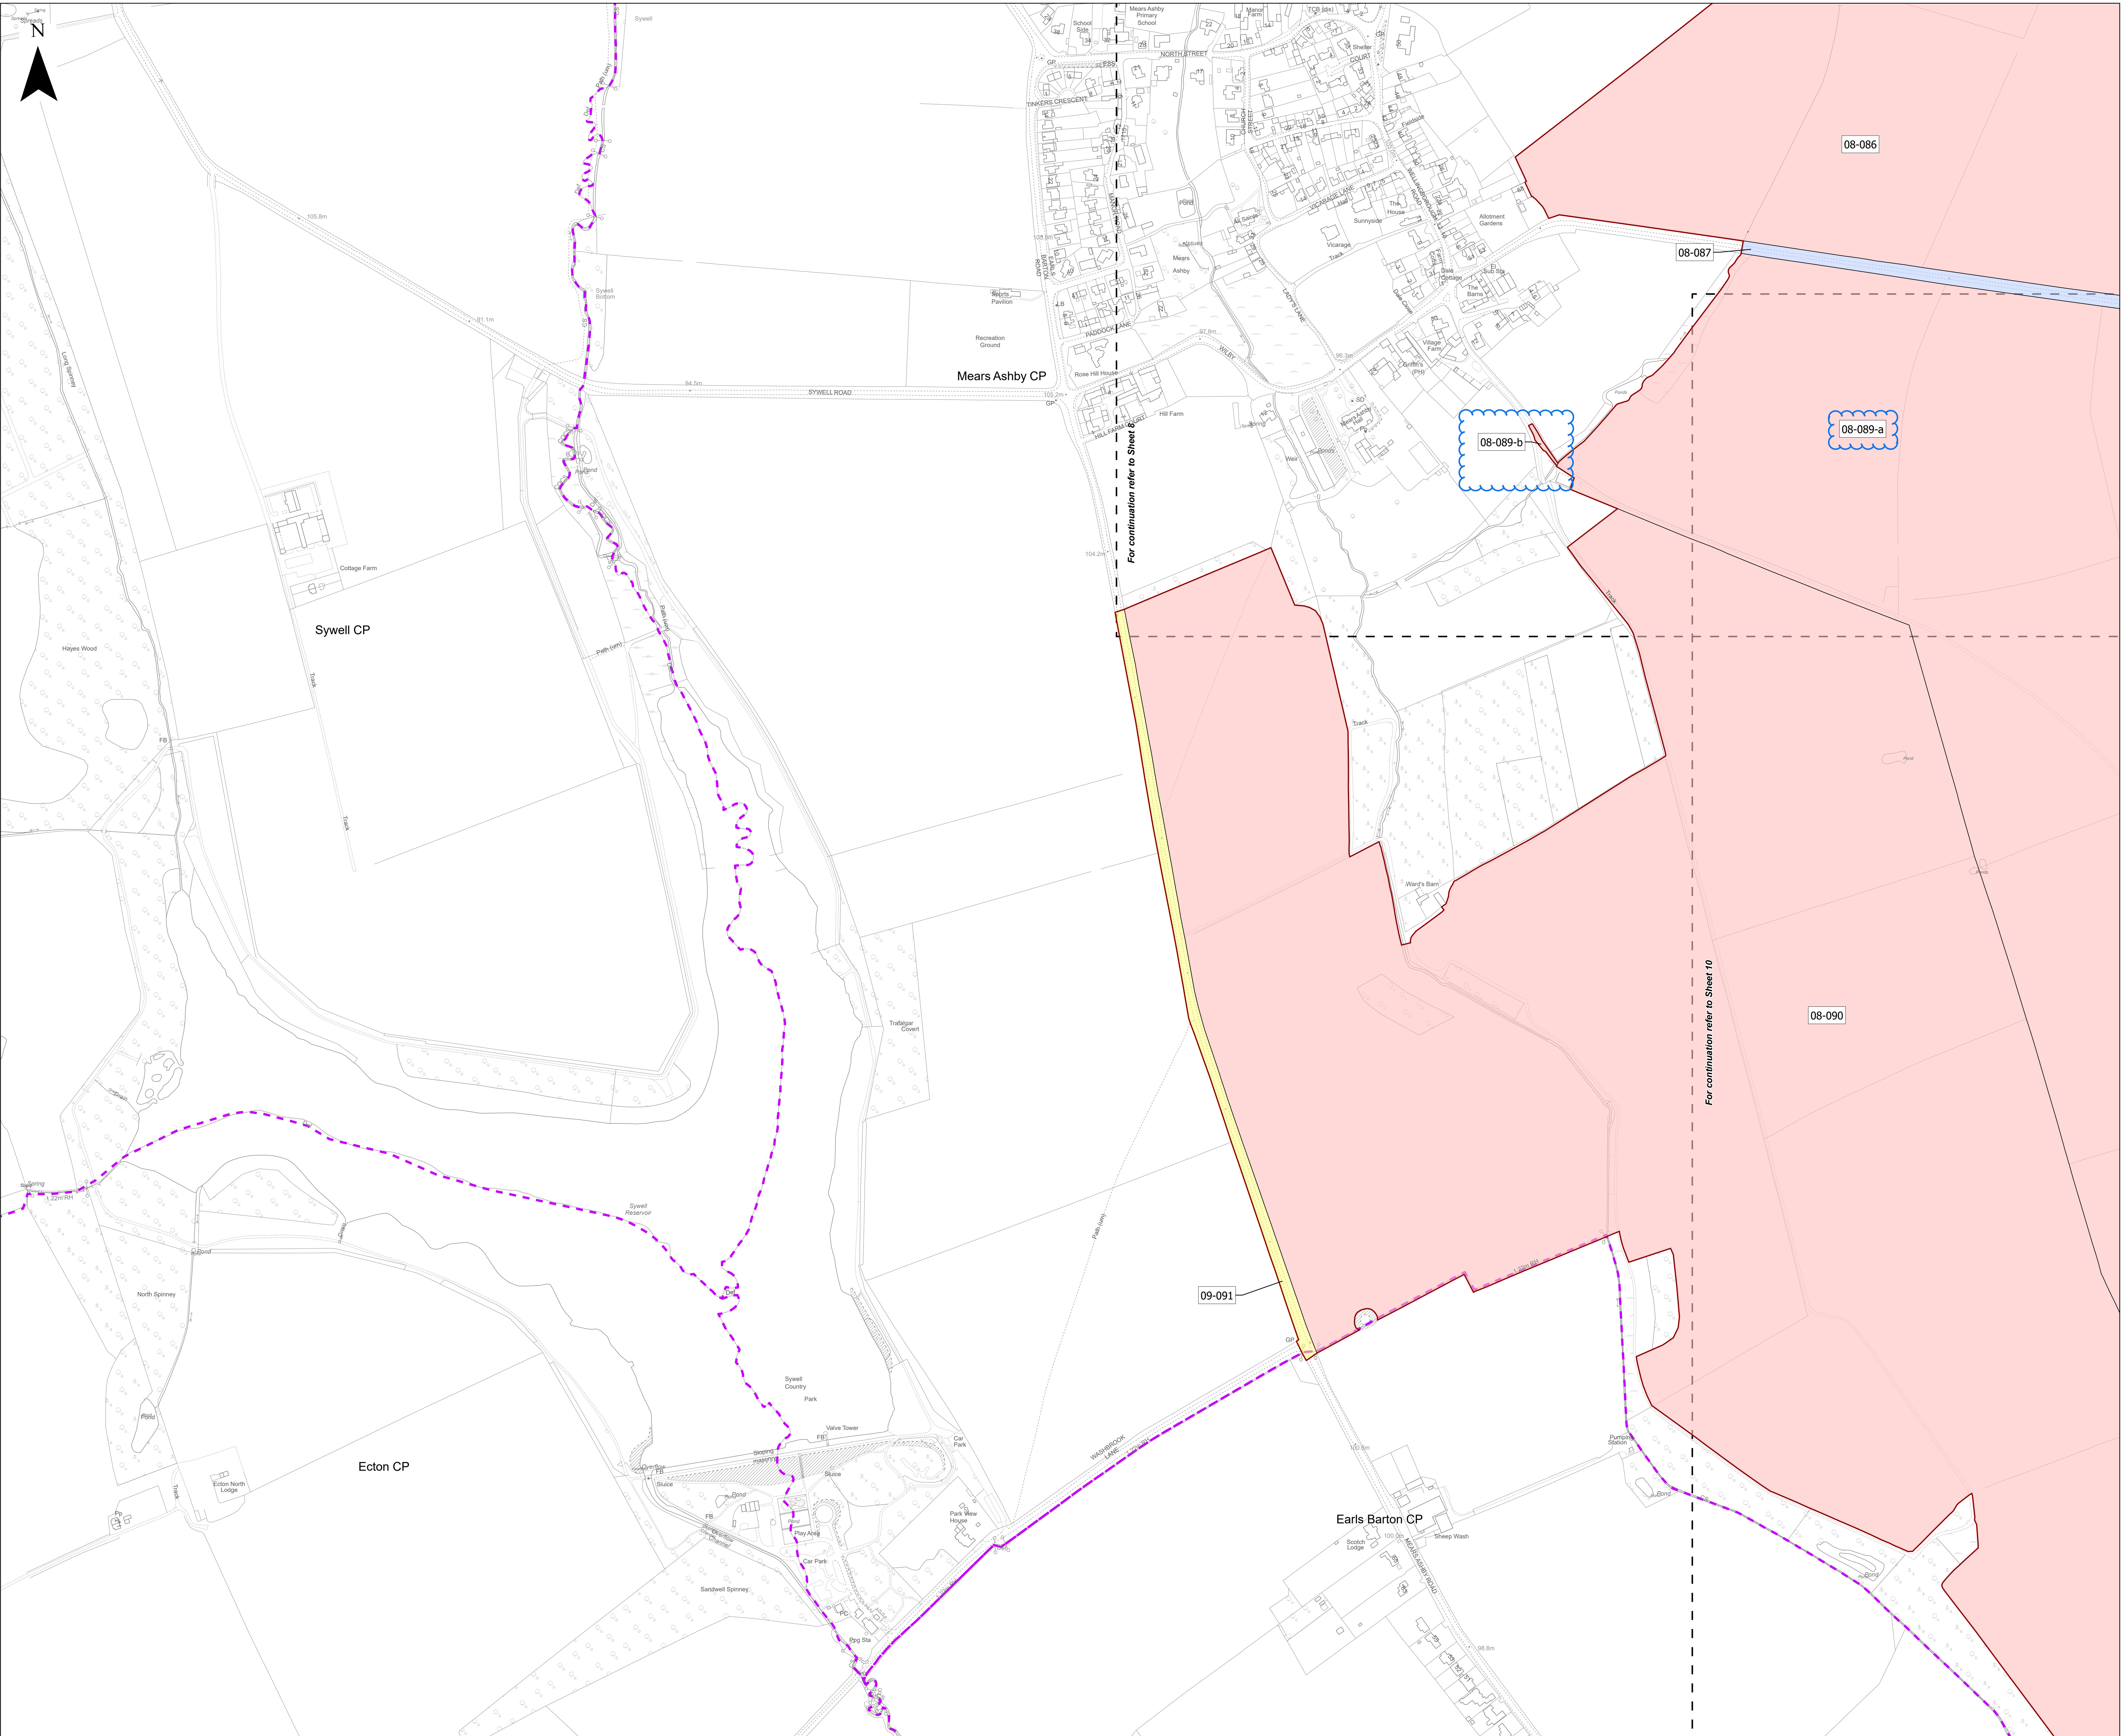


- Key**
- Order Limits
 - Freehold to be compulsorily acquired and temporary use of land and in relation to which it is proposed that easements, servitudes and other private rights will cease to have effect
 - Temporary use of land and in relation to which it is proposed to temporarily suspend easements, servitudes and other private rights
 - New rights (including restrictions) to be compulsorily acquired and temporary use of land and in relation to which it is proposed that easements, servitudes and other private rights will be suspended or cease to have effect
 - No Land Take
 - Local Authority / Parish Boundary
 - Cut Line

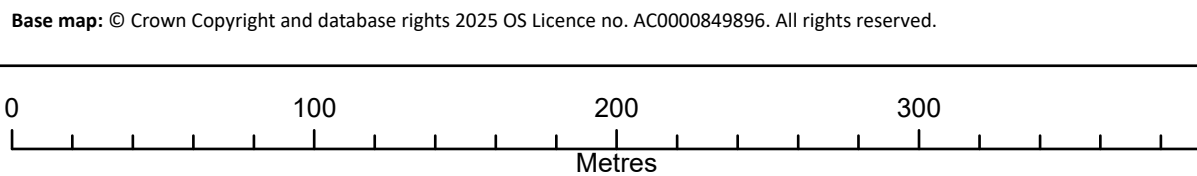

Scale: 1:2,500@ A0

APFP Regulation: 5(2)(i)	Application Doc No. CR1/GH2.2_C
Ref: IGP_GH_DCO_Land_Plan	Date: 10/11/2025
Drawn by: DLG	Checked by: AT

Land Plan
(Change Application Version)
Revision C
Sheet 9 of 18

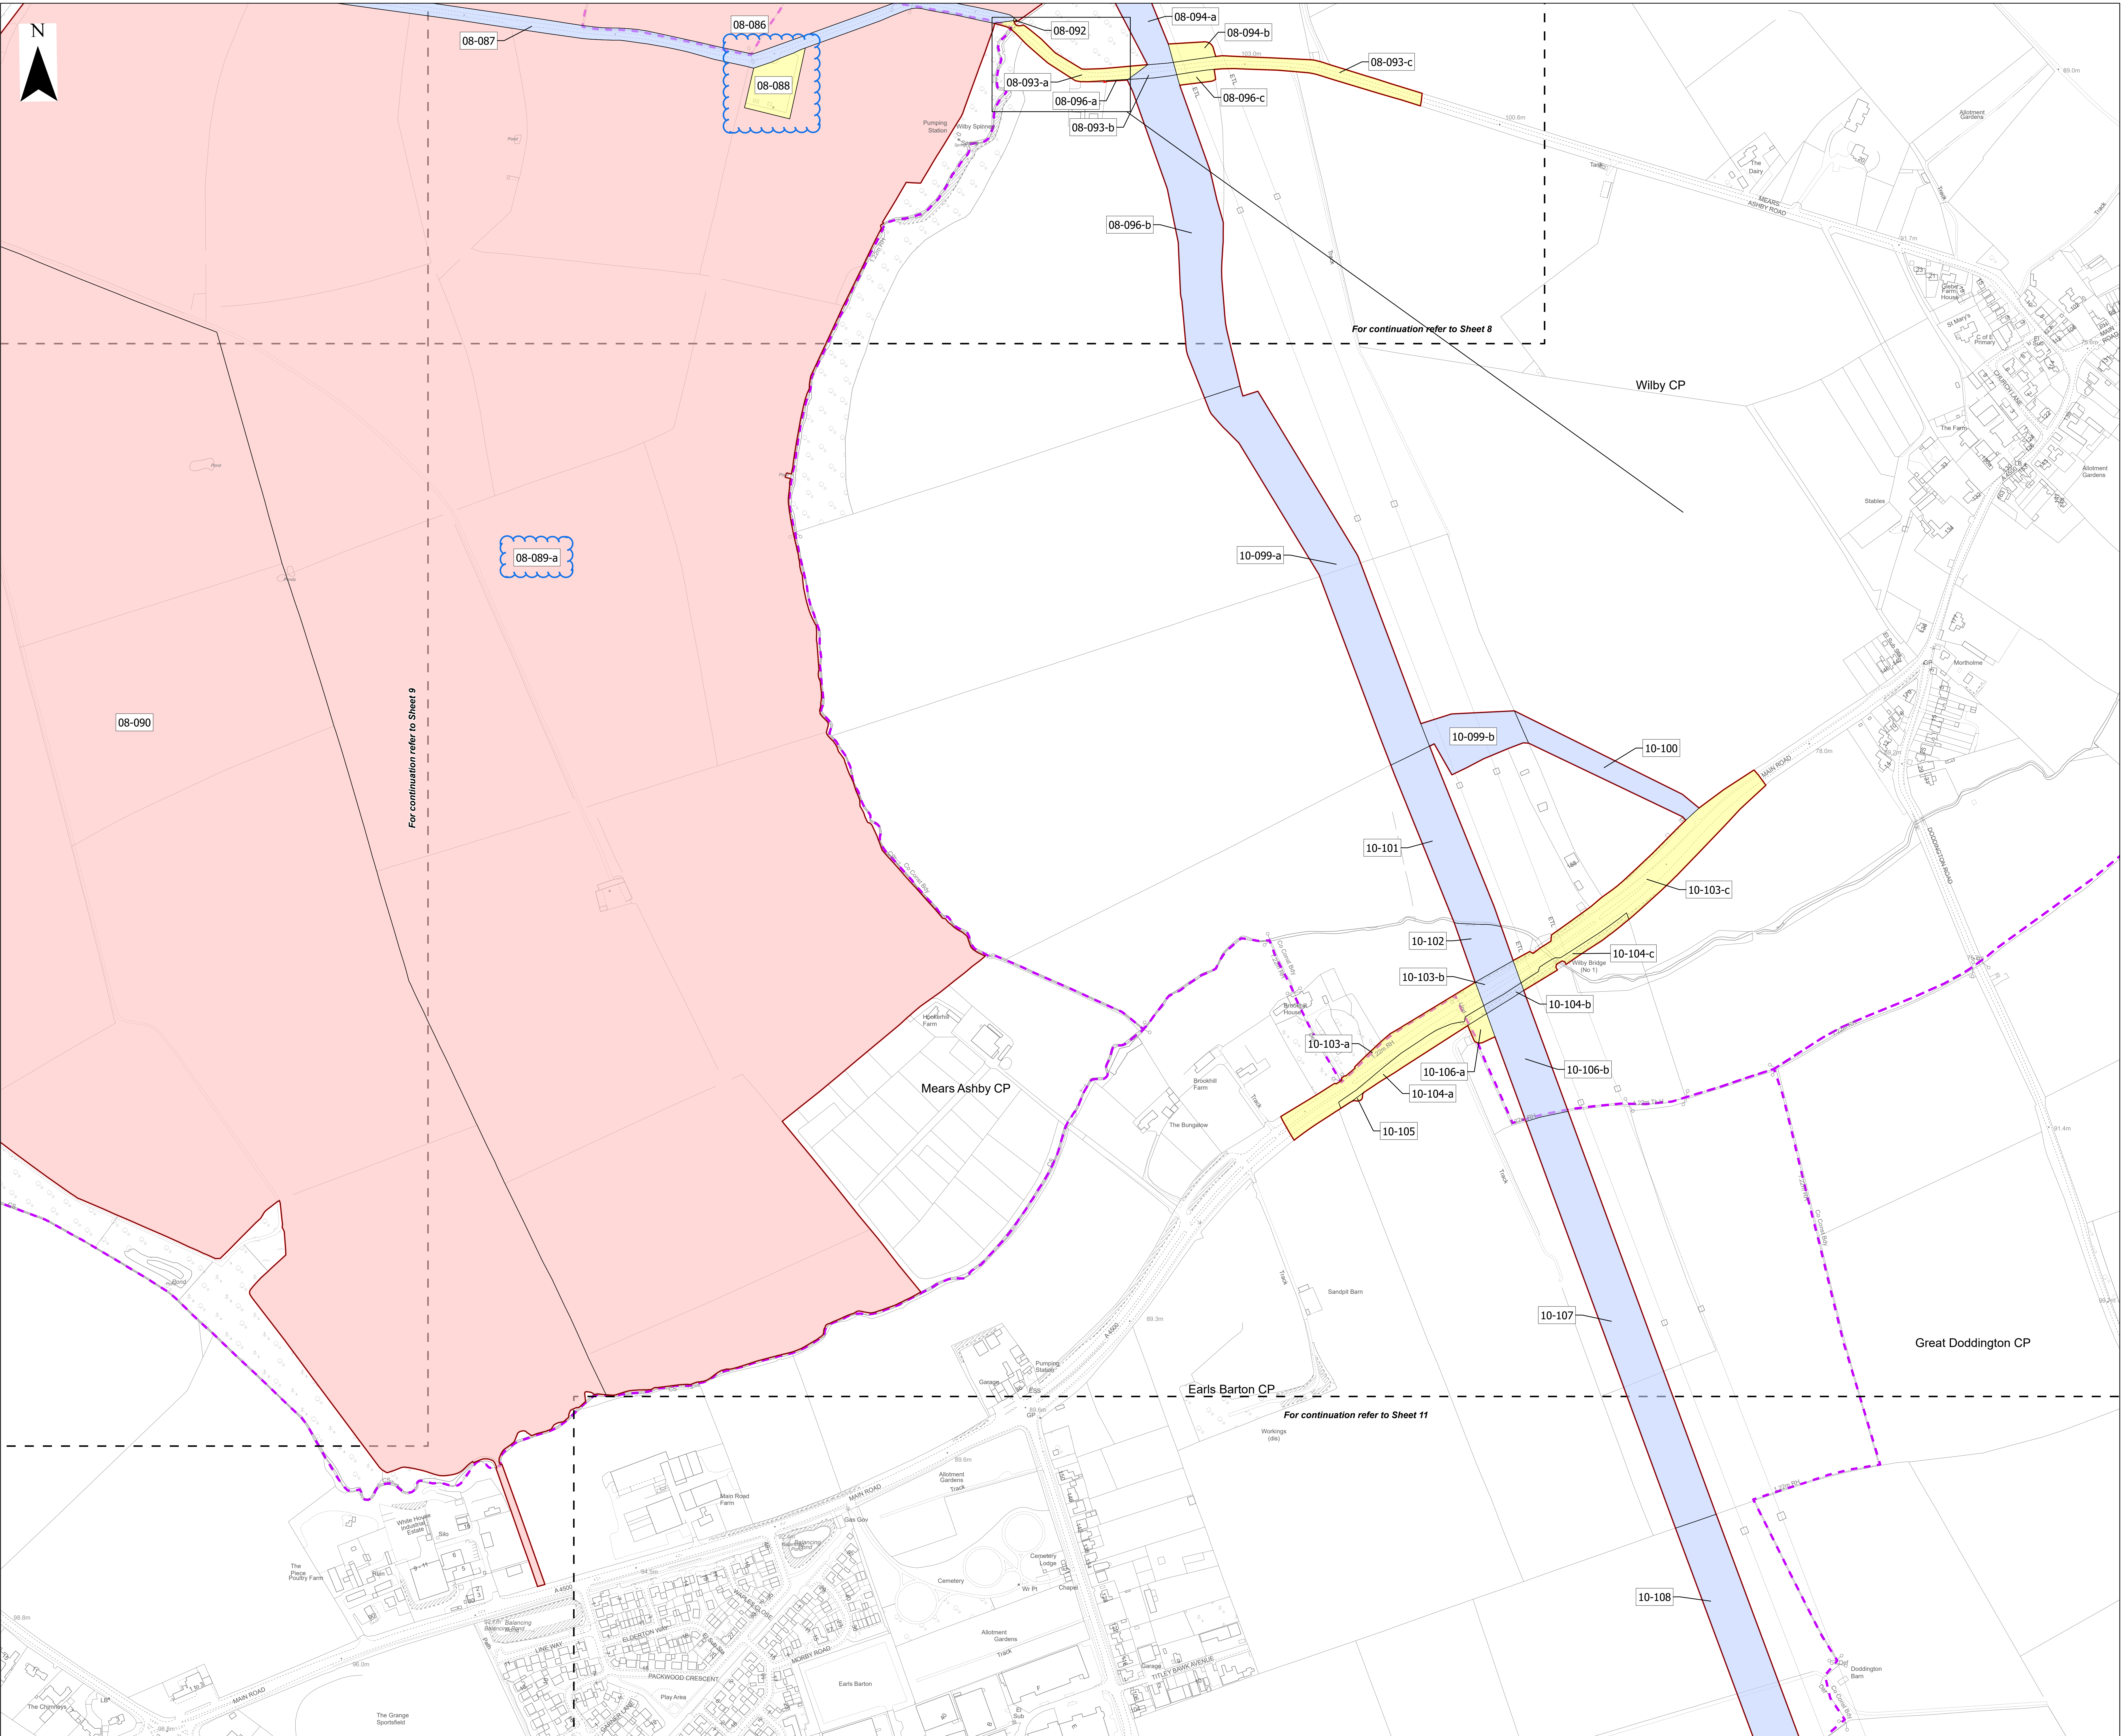


- Key**
- Order Limits
 - Freehold to be compulsorily acquired and temporary use of land and in relation to which it is proposed that easements, servitudes and other private rights will cease to have effect
 - Temporary use of land and in relation to which it is proposed to temporarily suspend easements, servitudes and other private rights
 - New rights (including restrictions) to be compulsorily acquired and temporary use of land and in relation to which it is proposed that easements, servitudes and other private rights will be suspended or cease to have effect
 - No Land Take
 - Local Authority / Parish Boundary
 - Cut Line

Base map: © Crown Copyright and database rights 2025 OS Licence no. AC000849896. All rights reserved.

0 100 200 300 400
Metres


Scale: 1:2,500@ A0

APFP Regulation: 5(2)(i)	Application Doc No. CR1/GH2.2_C
Ref: IGP_GH_DCO_Land_Plan	Date: 10/11/2025
Drawn by: DLG	Checked by: AT

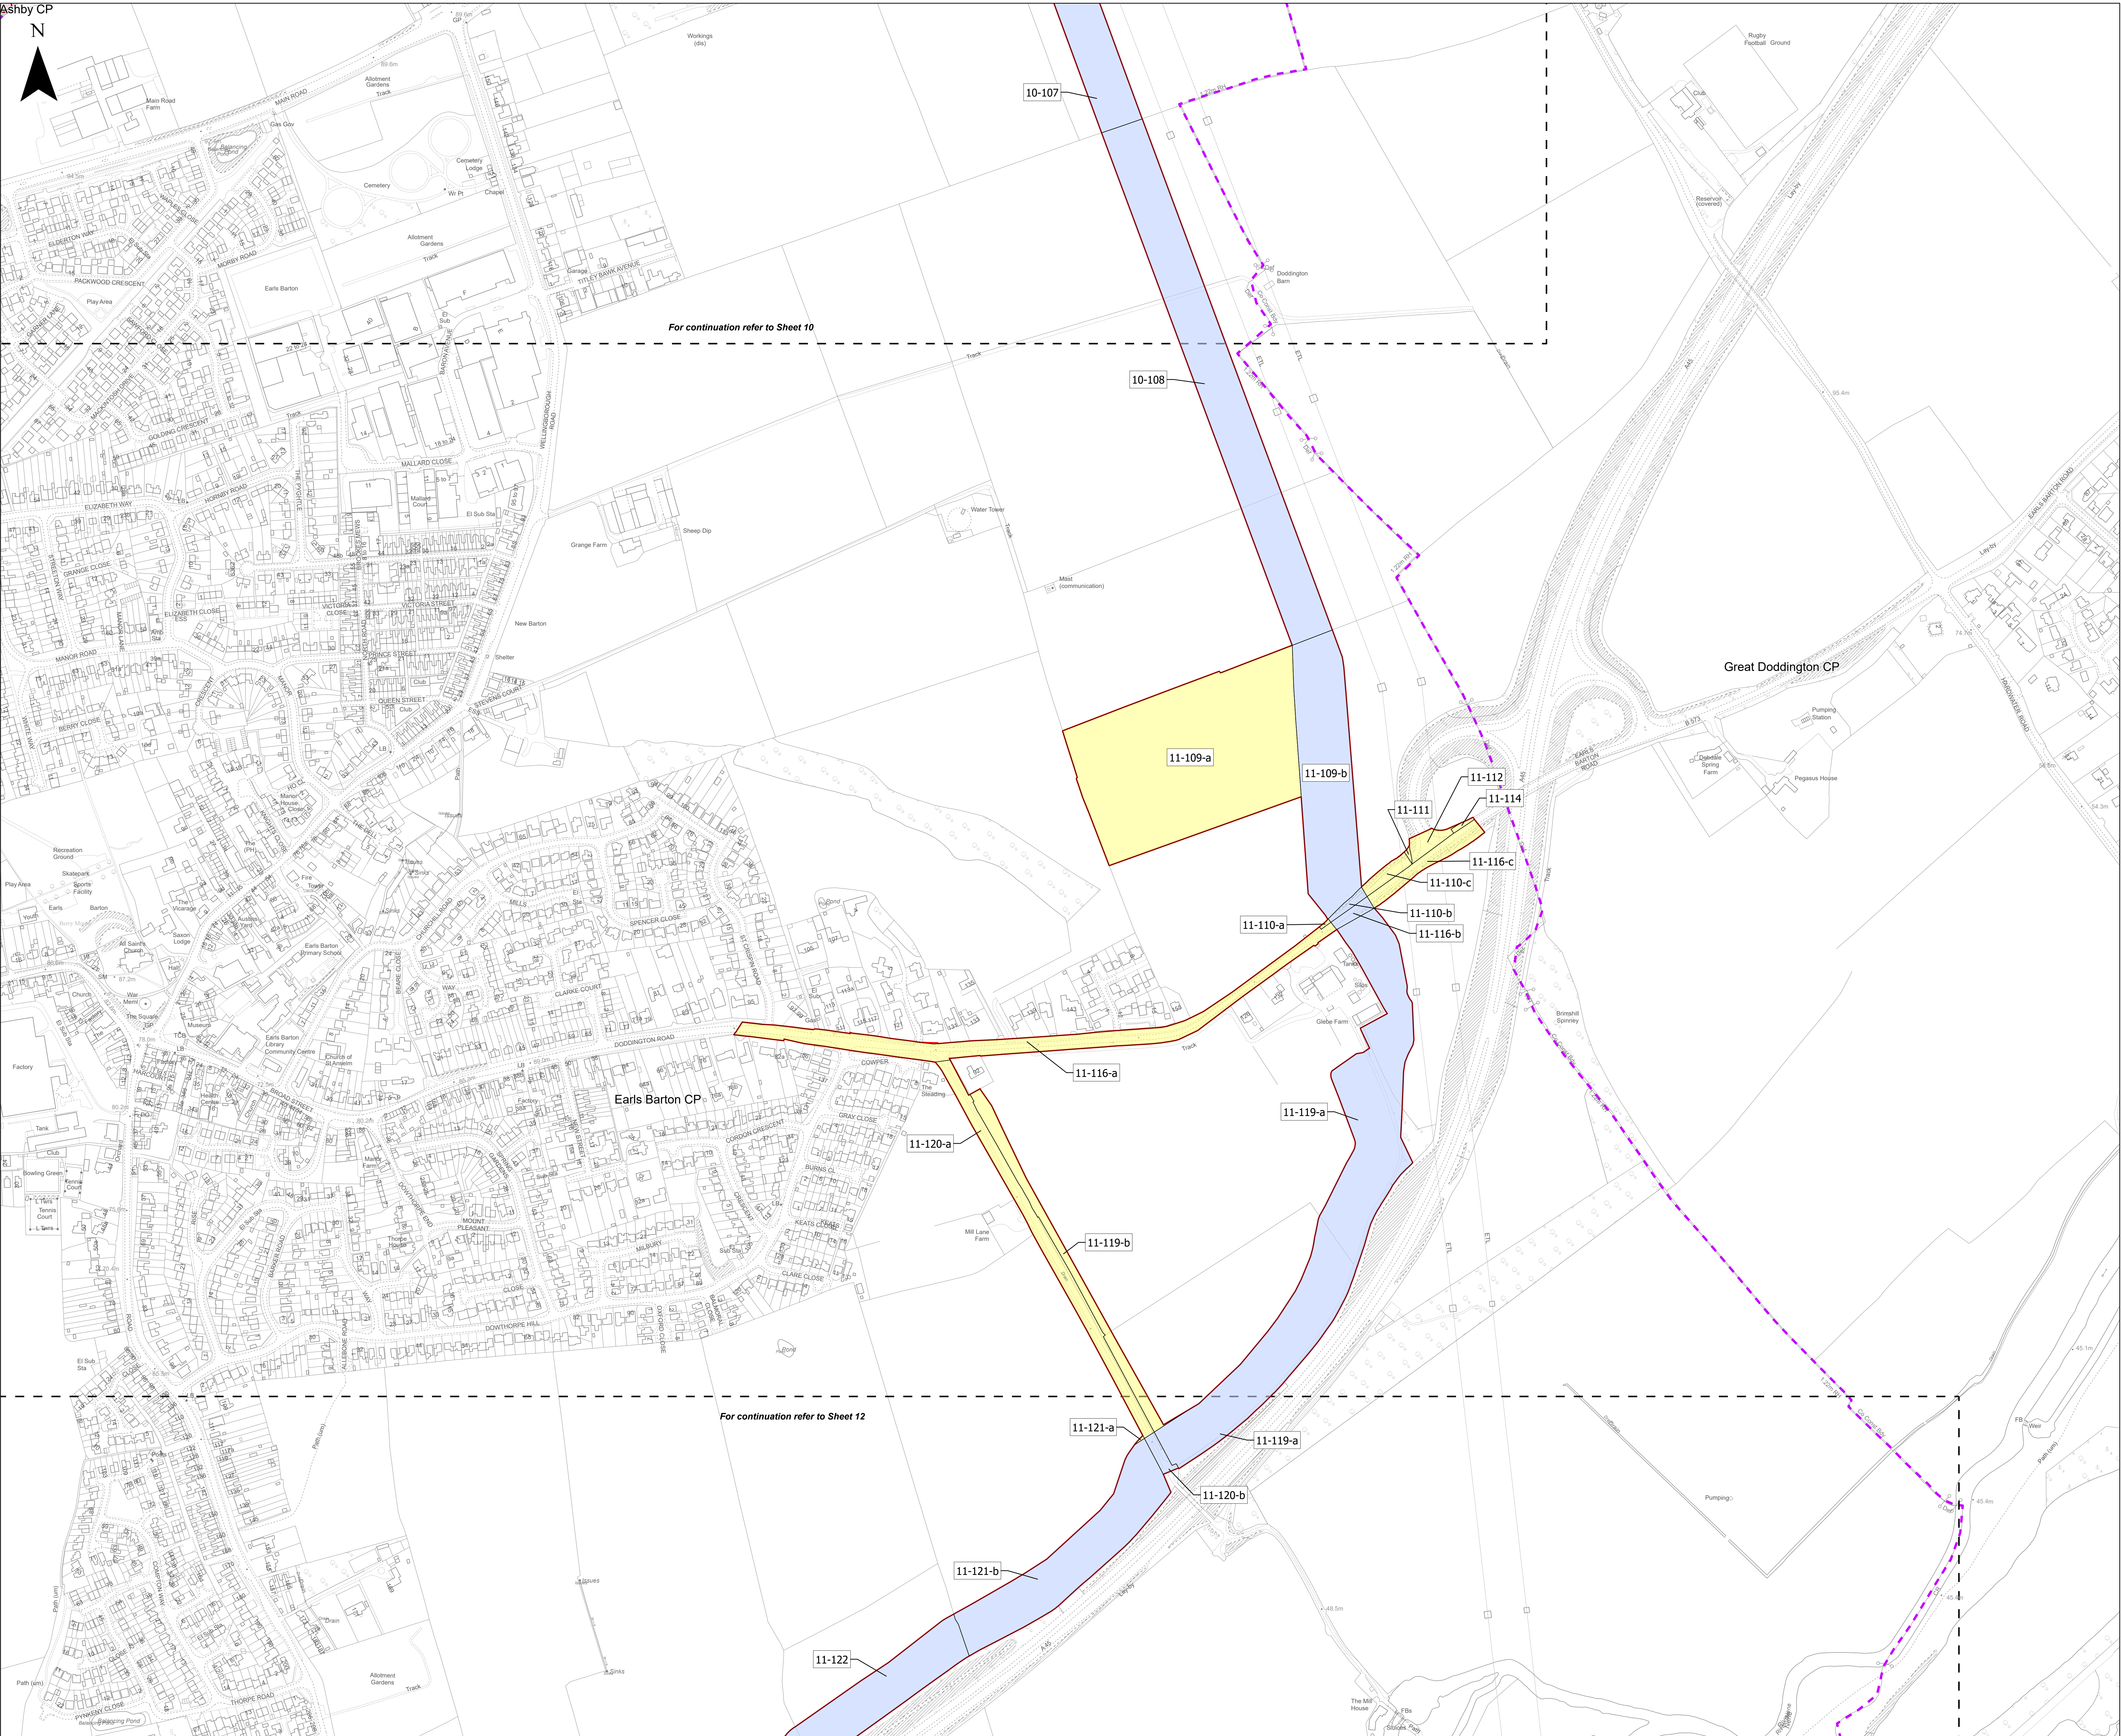

- Key**
- Order Limits
 - Freehold to be compulsorily acquired and temporary use of land and in relation to which it is proposed that easements, servitudes and other private rights will cease to have effect
 - Temporary use of land and in relation to which it is proposed to temporarily suspend easements, servitudes and other private rights
 - New rights (including restrictions) to be compulsorily acquired and temporary use of land and in relation to which it is proposed that easements, servitudes and other private rights will be suspended or cease to have effect
 - No Land Take
 - Local Authority / Parish Boundary
 - Cut Line

Base map: © Crown Copyright and database rights 2025 OS Licence no. AC000849896. All rights reserved.

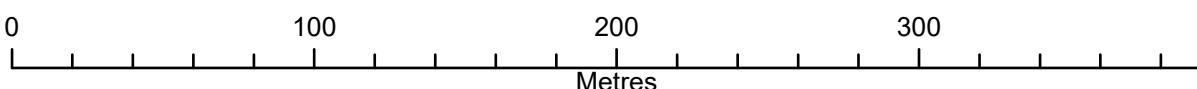


Scale: 1:2,500 @ A0

APFP Regulation: 5(2)(i)	Application Doc No. CR1/GH2.2_C
Ref: IGP_GH_DCO_Land_Plan	Date: 10/11/2025
Drawn by: DLG	Checked by: AT

Land Plan
(Change Application Version)
Revision C
Sheet 11 of 18



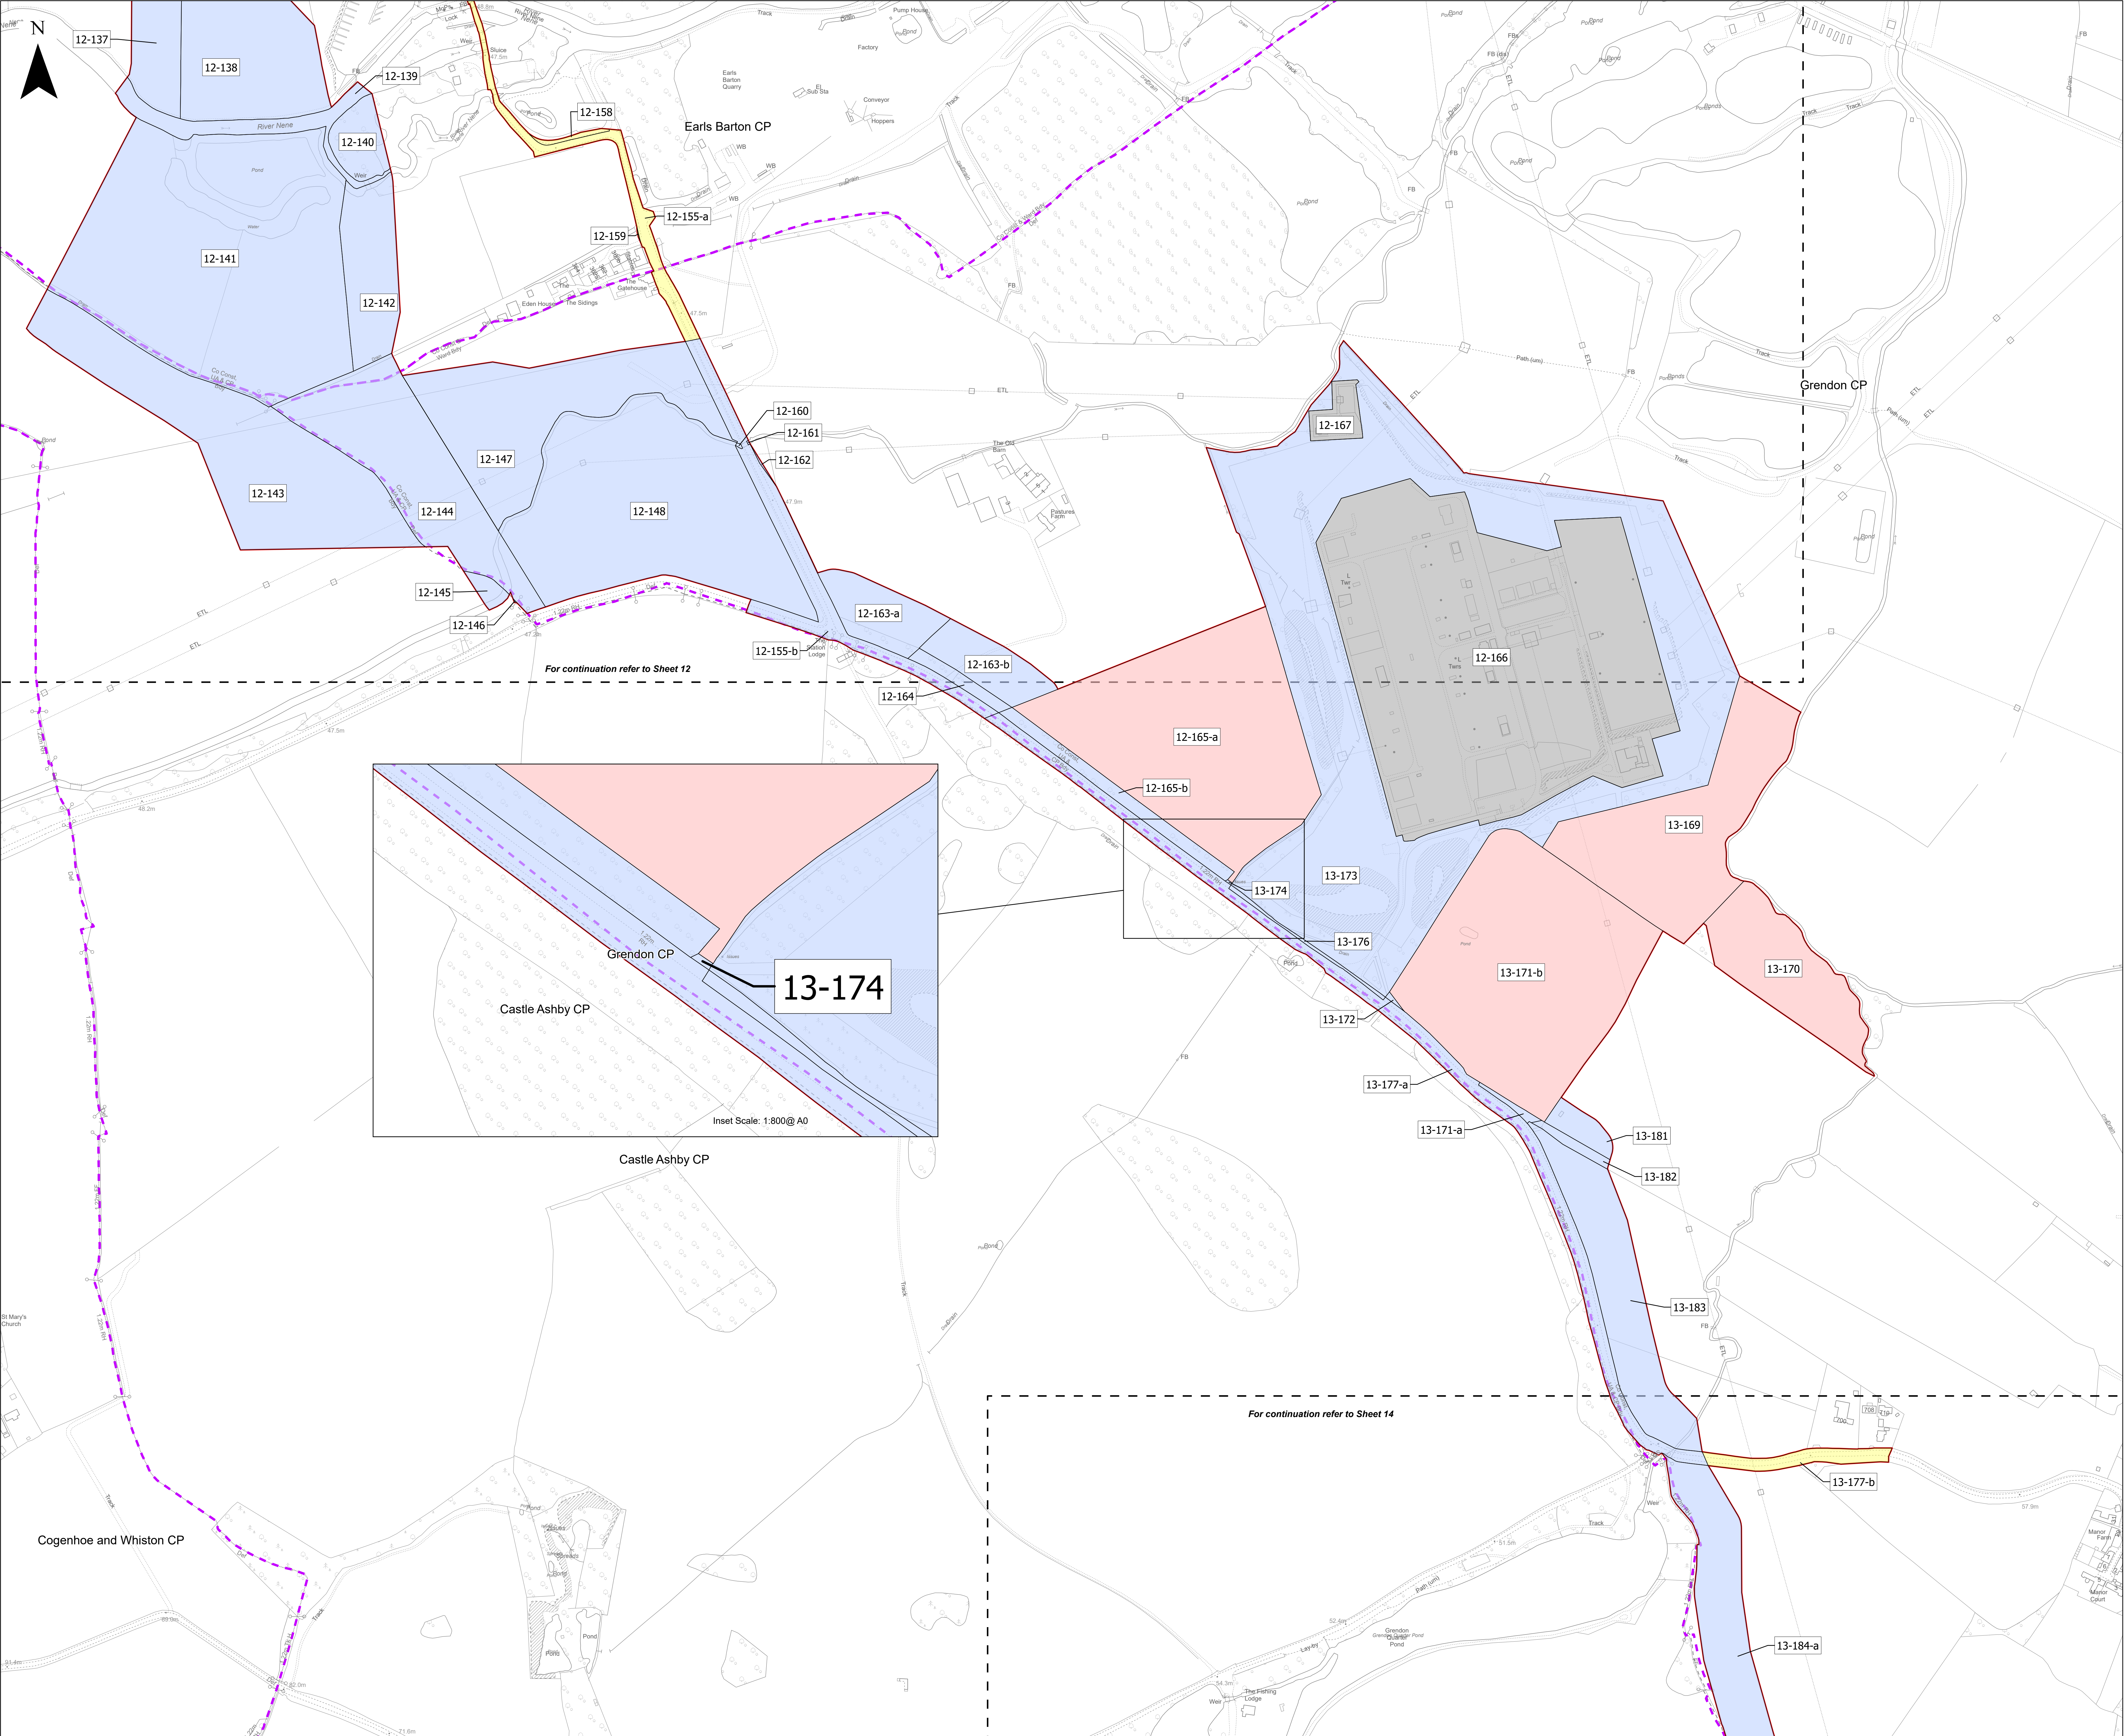




Key

- Order Limits
- Freehold to be compulsorily acquired and temporary use of land and in relation to which it is proposed that easements, servitudes and other private rights will cease to have effect
- Temporary use of land and in relation to which it is proposed to temporarily suspend easements, servitudes and other private rights
- New rights (including restrictions) to be compulsorily acquired and temporary use of land and in relation to which it is proposed that easements, servitudes and other private rights will be suspended or cease to have effect
- No Land Take
- Local Authority / Parish Boundary
- Cut Line

Base map: © Crown Copyright and database rights 2025 OS Licence no. AC000849896. All rights reserved.


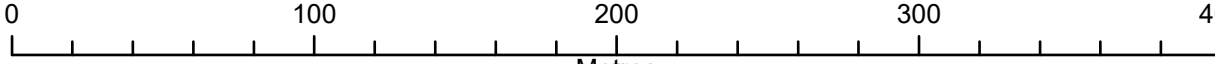


Scale: 1:2,500@ A0


APFP Regulation: 5(2)(i)	Application Doc No. CR1/GH2.2_C
Ref: IGP_GH_DCO_Land_Plan	Date: 10/11/2025
Drawn by: DLG	Checked by: AT

Land Plan
(Change Application Version)
Revision C
Sheet 13 of 18



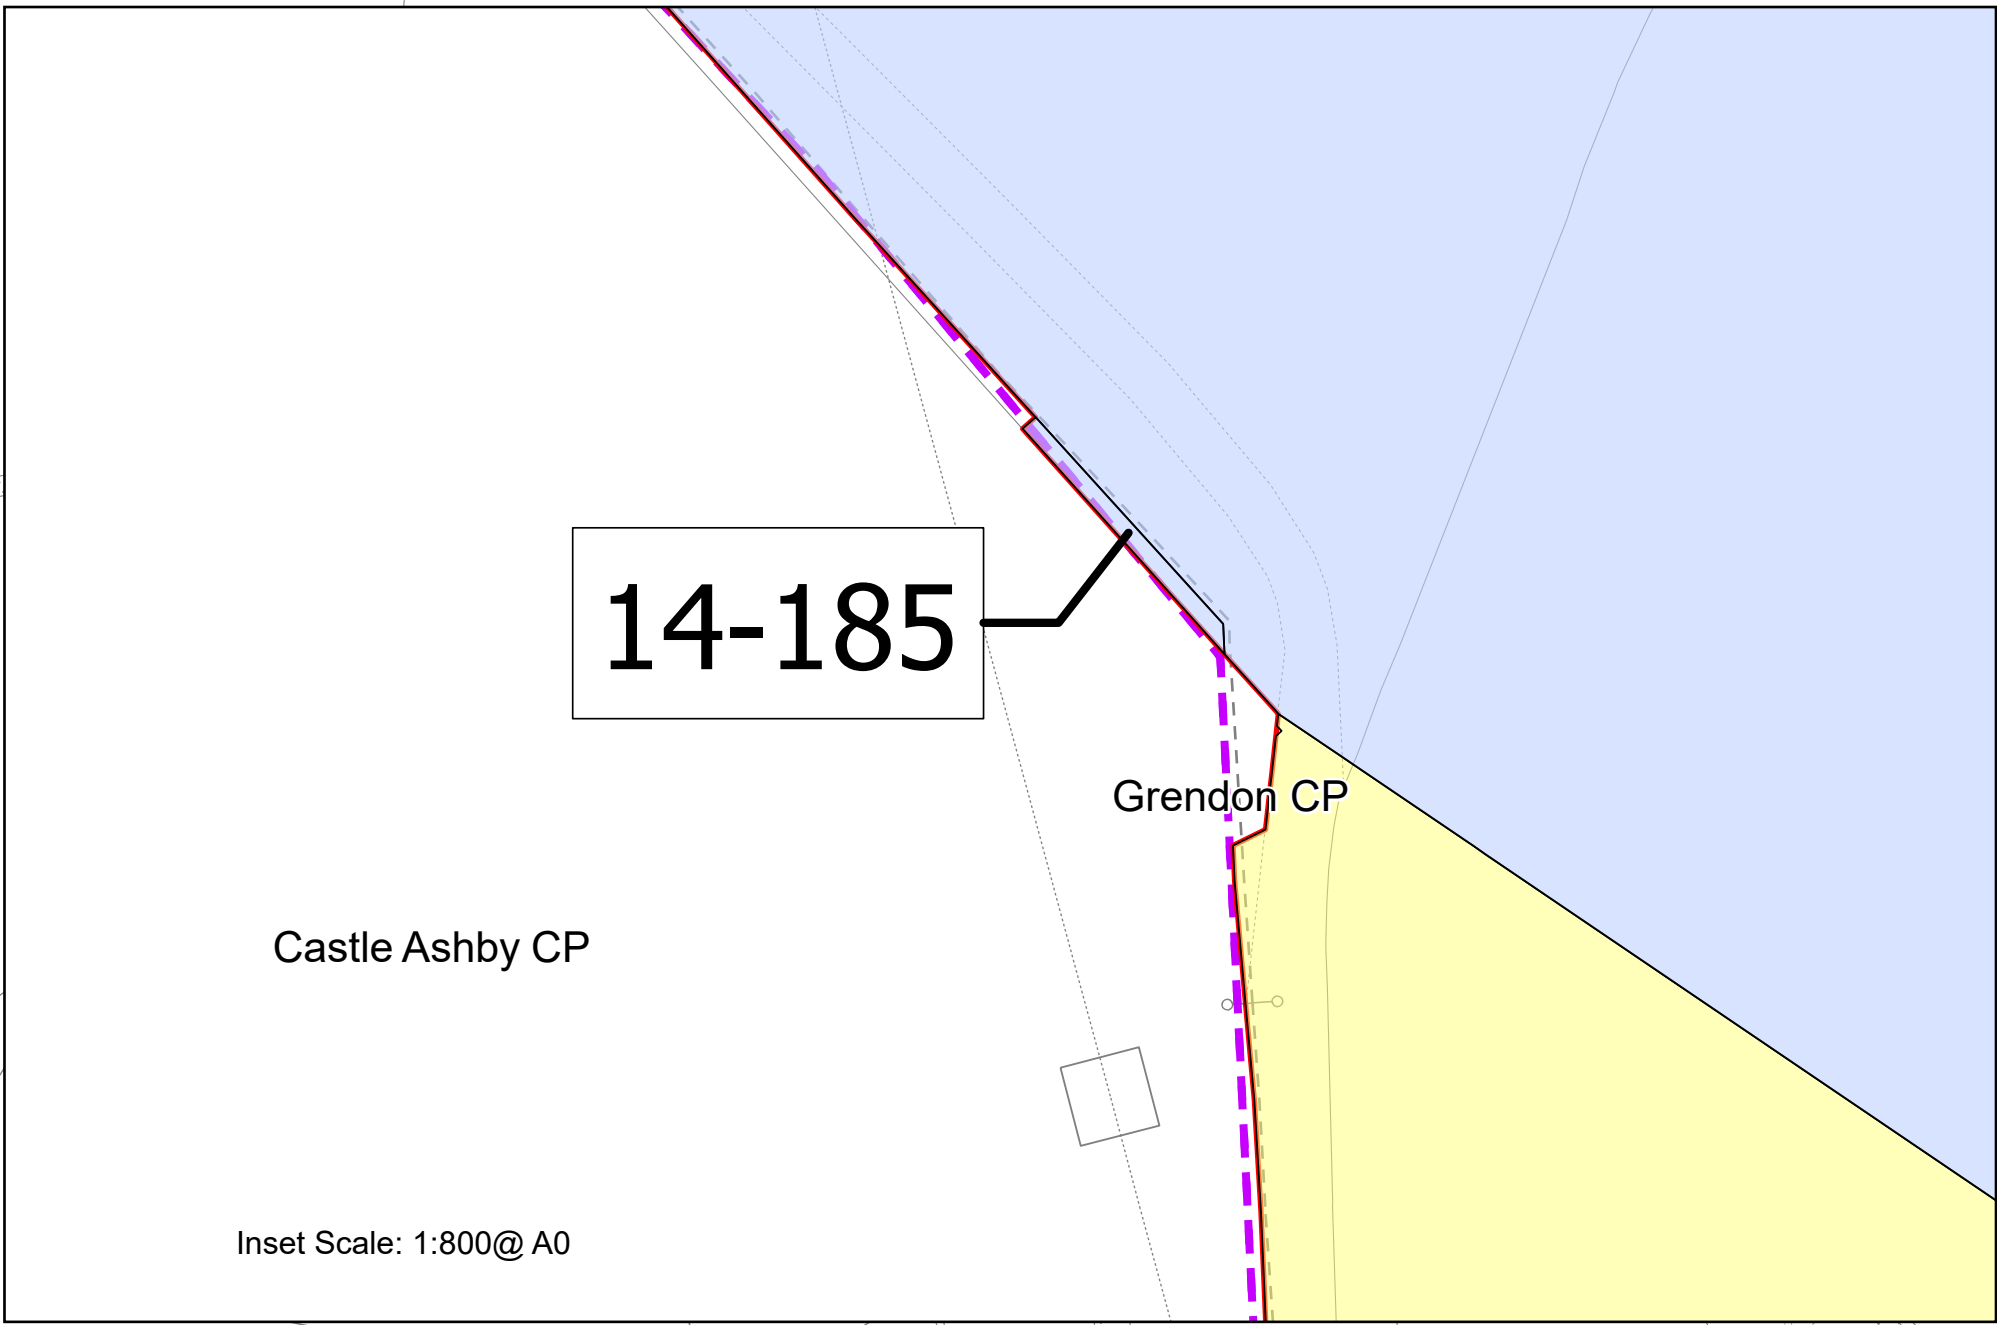
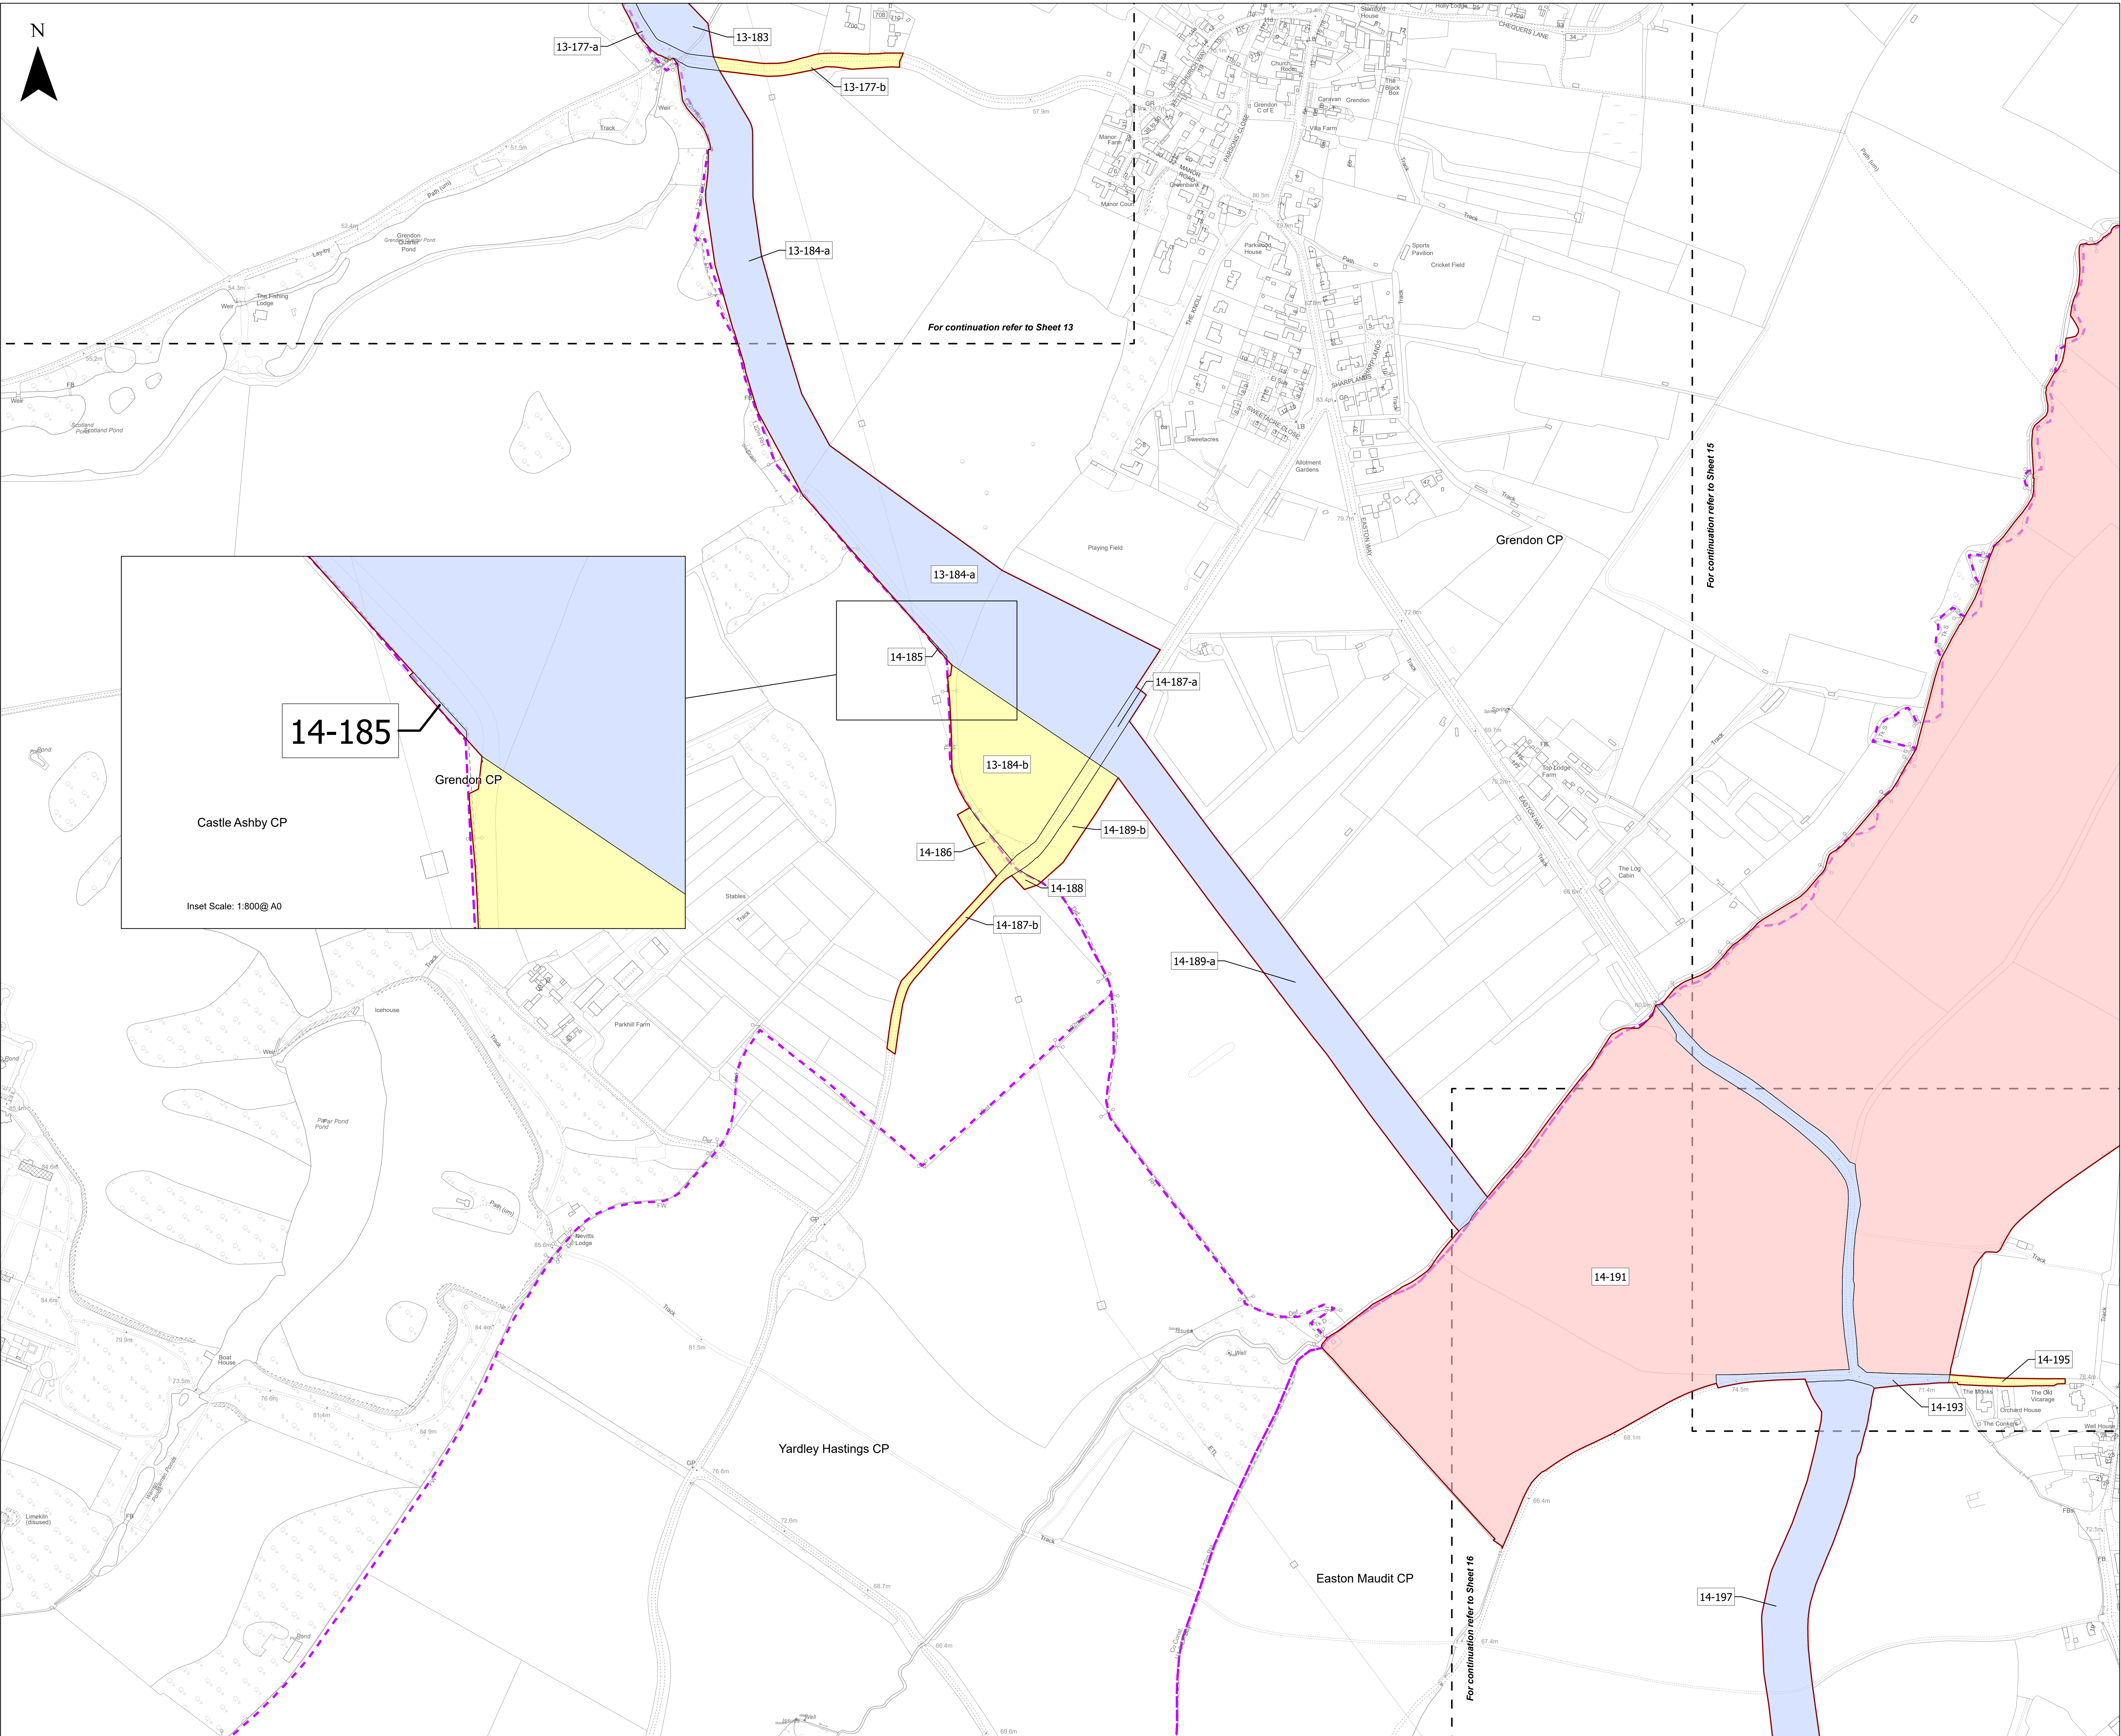


- Key**
- Order Limits
 - Freehold to be compulsorily acquired and temporary use of land and in relation to which it is proposed that easements, servitudes and other private rights will cease to have effect
 - Temporary use of land and in relation to which it is proposed to temporarily suspend easements, servitudes and other private rights
 - New rights (including restrictions) to be compulsorily acquired and temporary use of land and in relation to which it is proposed that easements, servitudes and other private rights will be suspended or cease to have effect
 - No Land Take
 - Local Authority / Parish Boundary
 - Cut Line

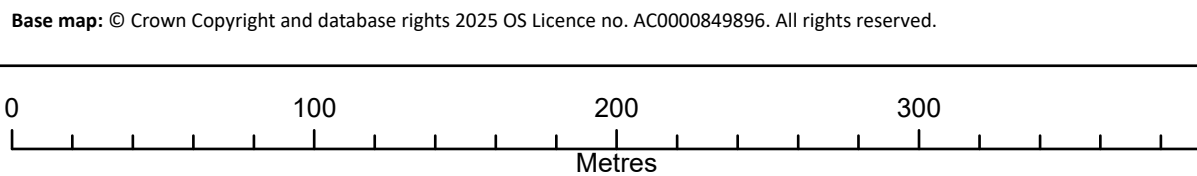


APFP Regulation: 5(2)(i)	Application Doc No. CR1/GH2.2_C
Ref: IGP_GH_DCO_Land_Plan	Date: 10/11/2025
Drawn by: DLG	Checked by: AT

Land Plan
(Change Application Version)
Revision C
Sheet 14 of 18

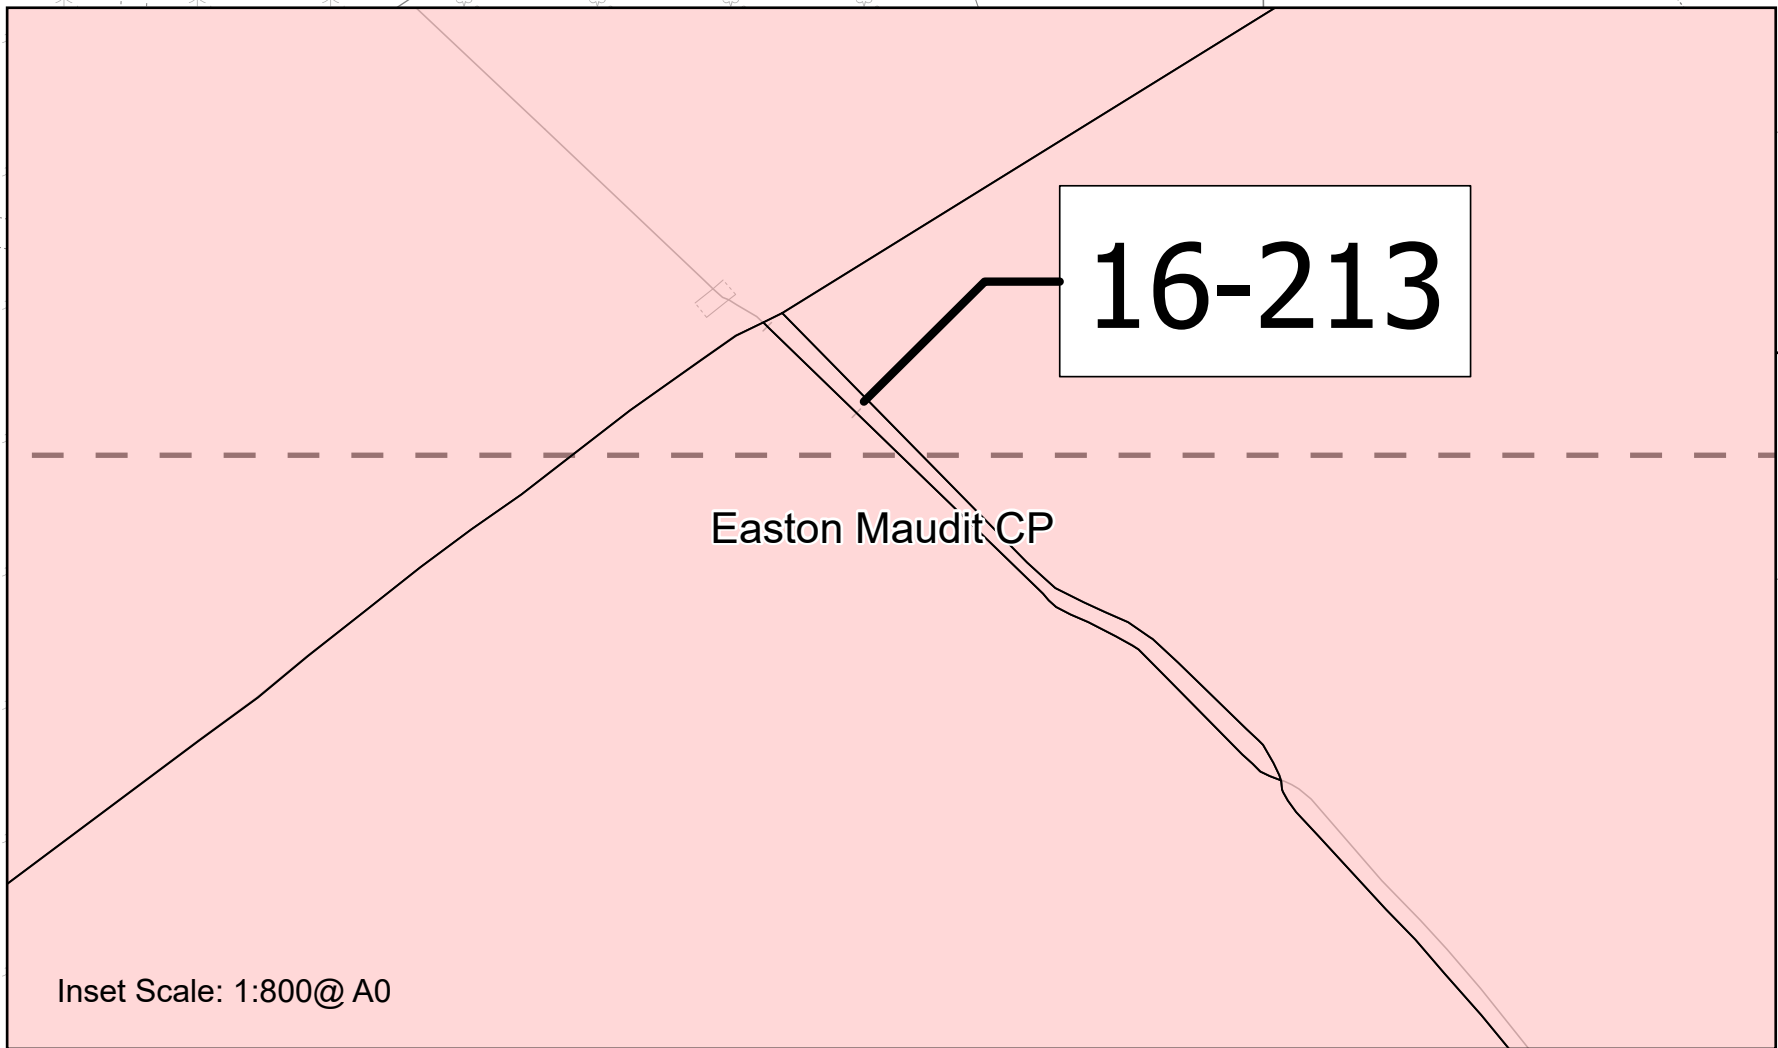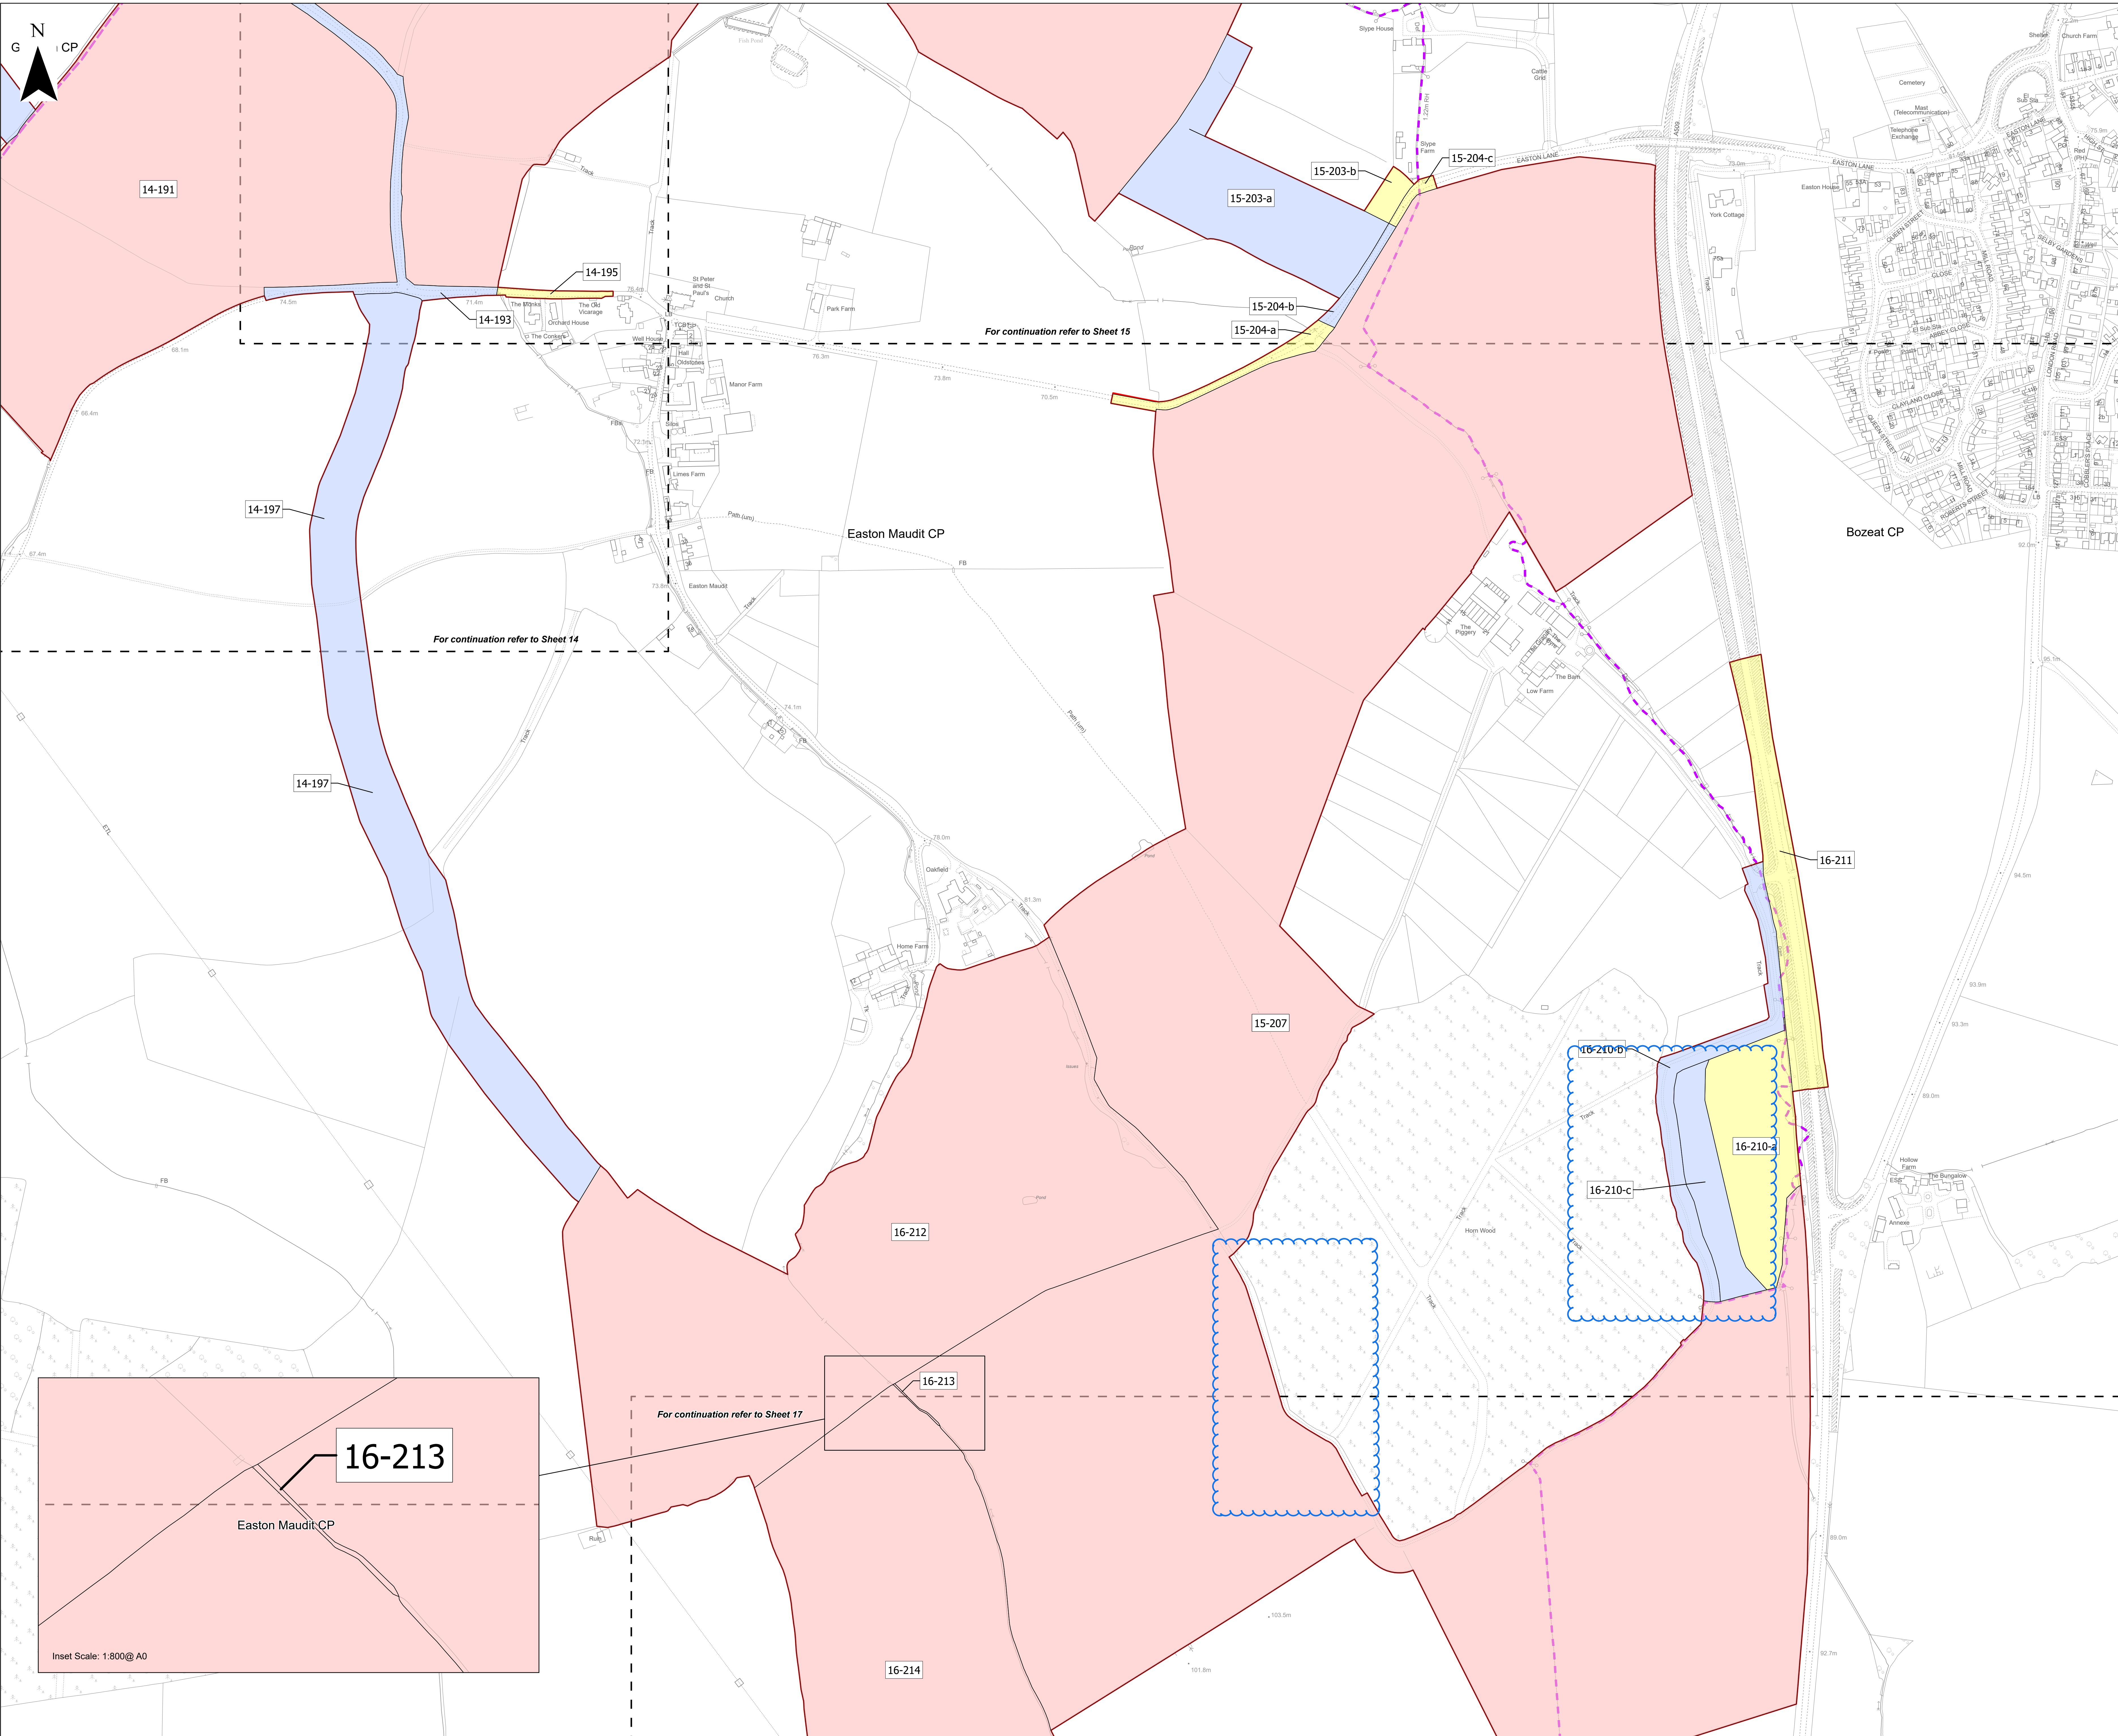


- Key**
- Order Limits
 - Freehold to be compulsorily acquired and temporary use of land and in relation to which it is proposed that easements, servitudes and other private rights will cease to have effect
 - Temporary use of land and in relation to which it is proposed to temporarily suspend easements, servitudes and other private rights
 - New rights (including restrictions) to be compulsorily acquired and temporary use of land will be suspended or cease to have effect
 - No Land Take
 - Local Authority / Parish Boundary
 - Cut Line

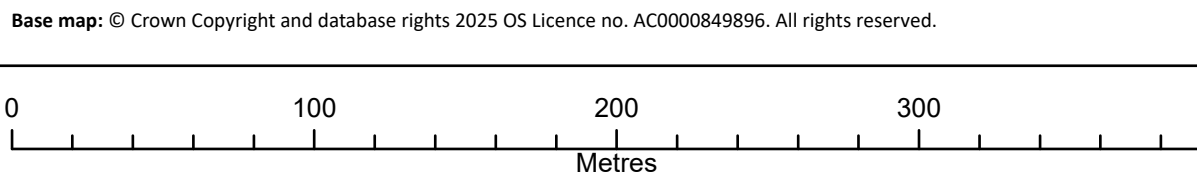

Scale: 1:2,500@A0

APFP Regulation: 5(2)(i)	Application Doc No. CR1/GH2.2_C
Ref: IGP_GH_DCO_Land_Plan	Date: 10/11/2025
Drawn by: DLG	Checked by: AT


Land Plan
(Change Application Version)
Revision C
Sheet 16 of 18

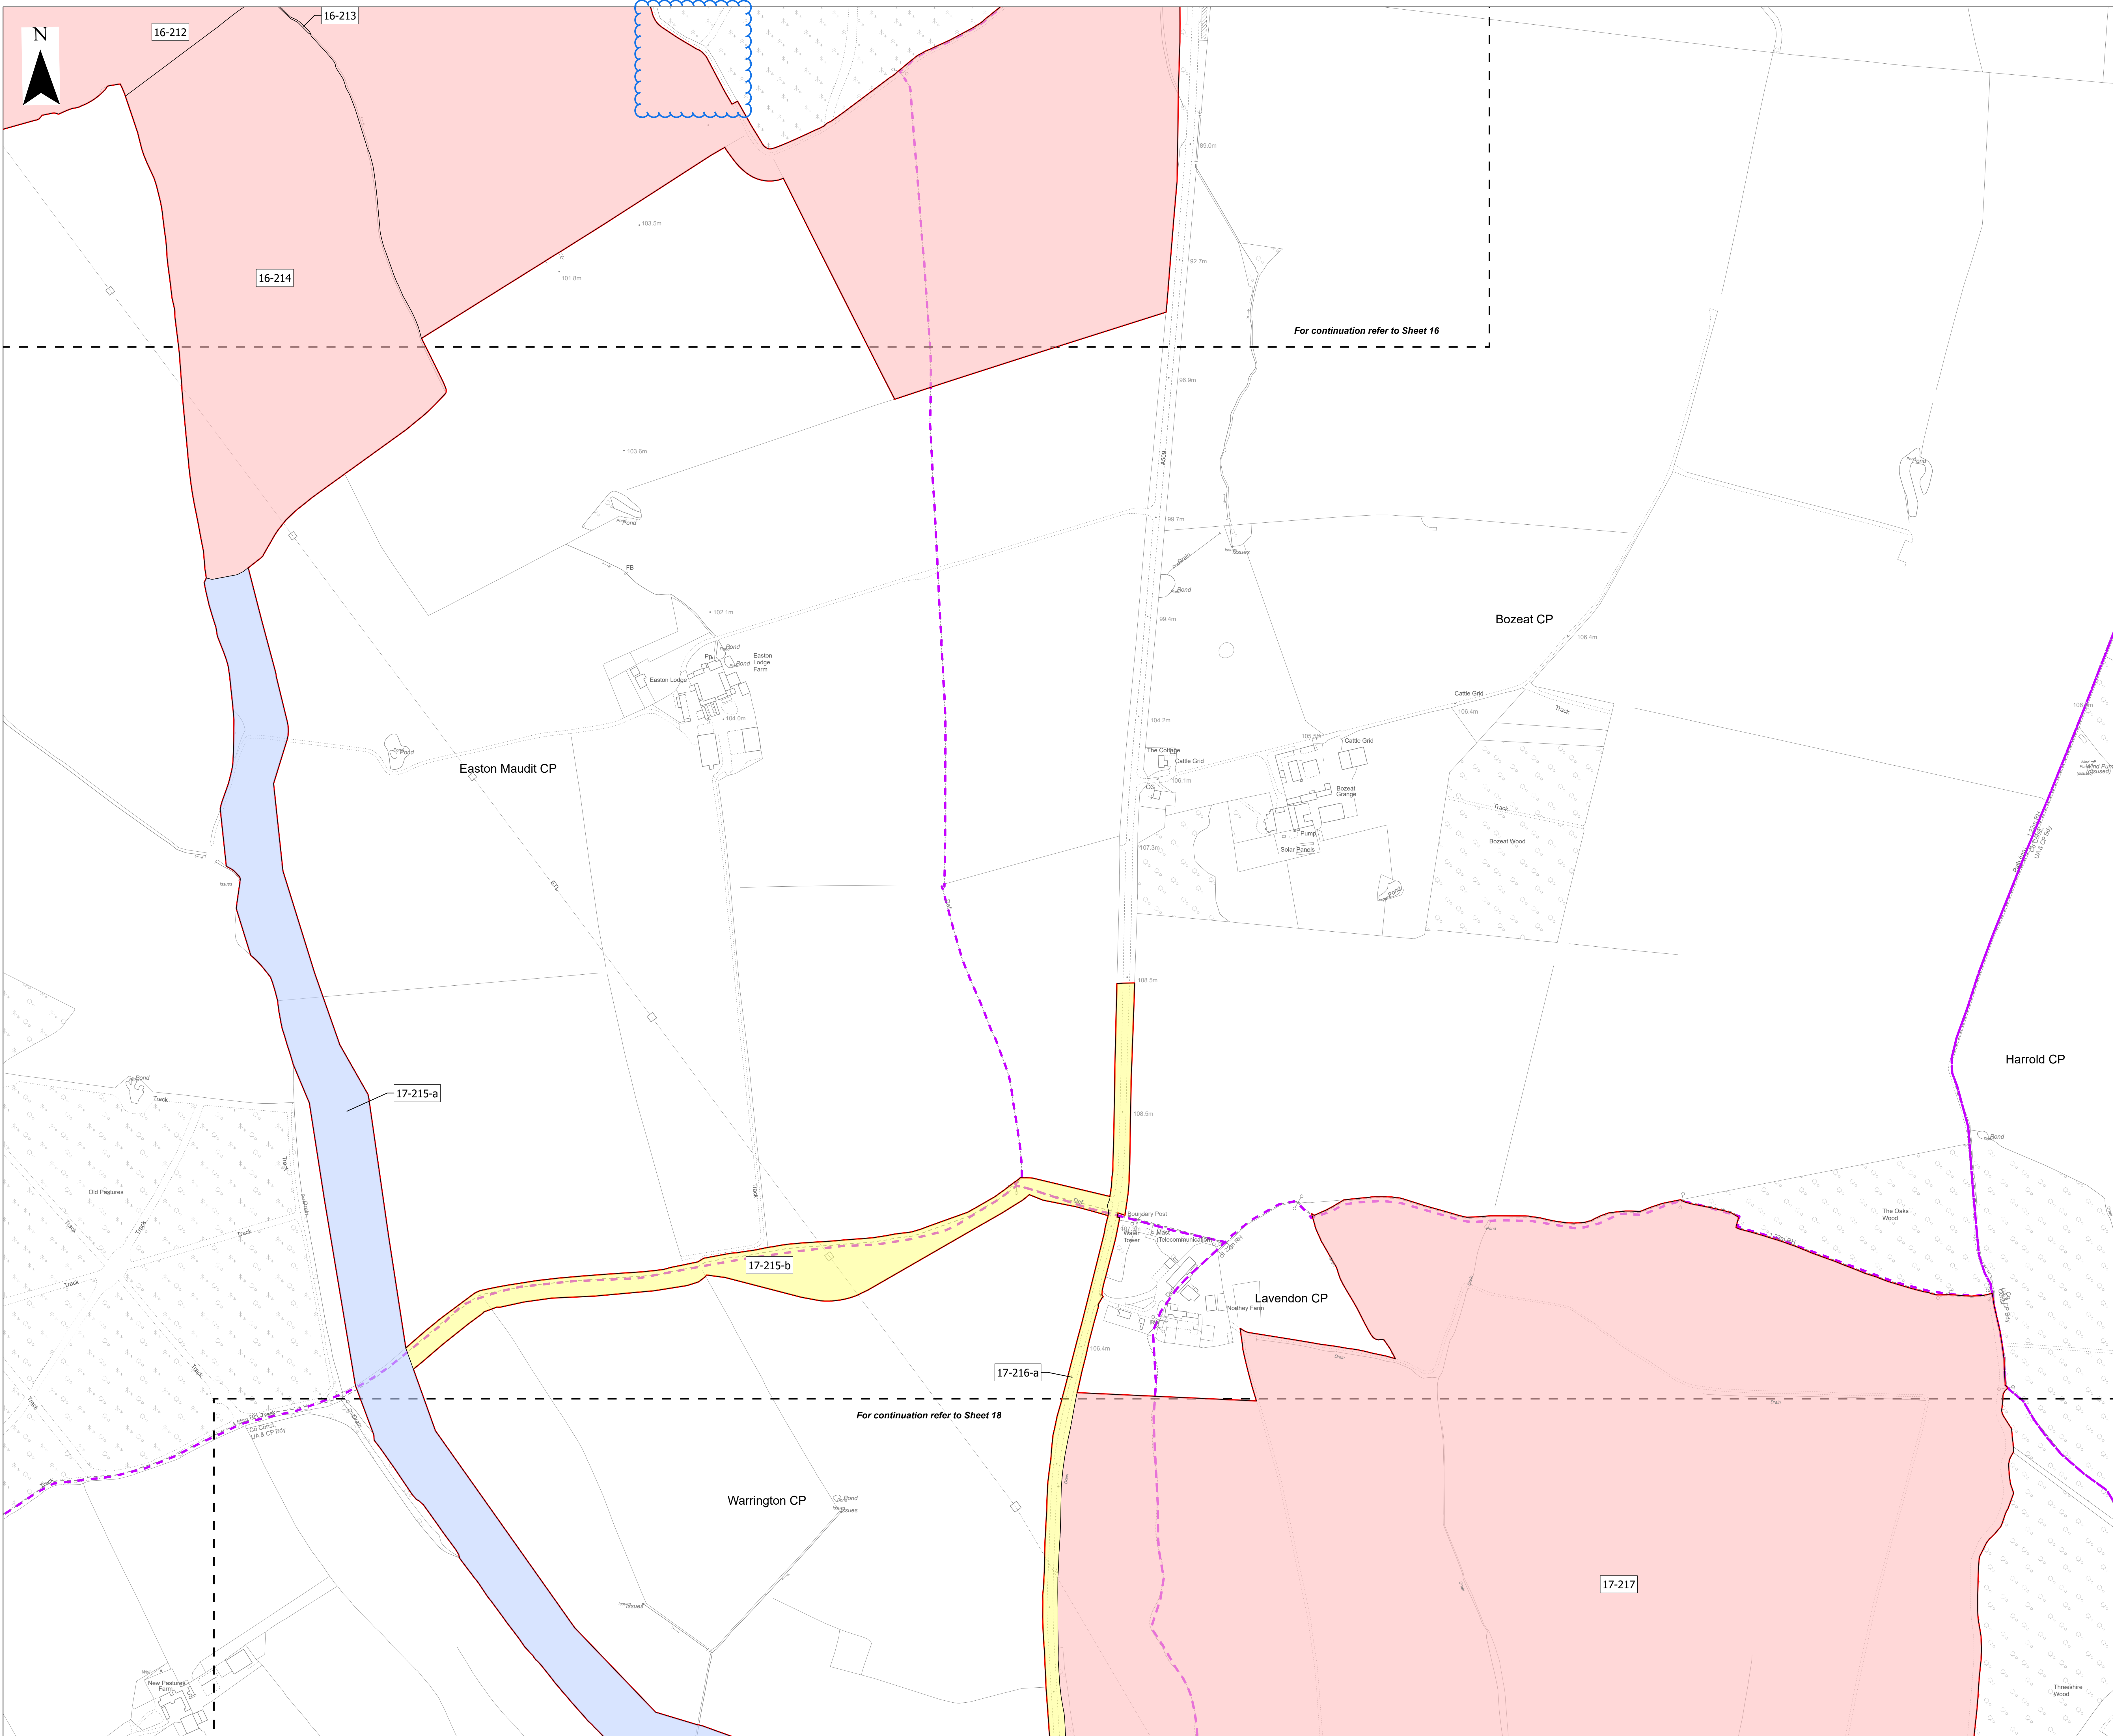

Key

-  Order Limit
-  Freehold to be compulsorily acquired and temporary use of land and in relation to which it is proposed that easements, servitudes and other private rights will cease to have effect
-  Temporary use of land and in relation to which it is proposed to temporarily suspend easements, servitudes and other private rights
-  New rights (including restrictions) to be compulsorily acquired and temporary use of land and in relation to which it is proposed that easements, servitudes and other private rights will be suspended or cease to have effect
-  No Land Take
-  Local Authority / Parish Boundary
-  Cut Line

Base map: © Crown Copyright and database rights 2025 OS Licence no. AC0000849896. All rights reserved.

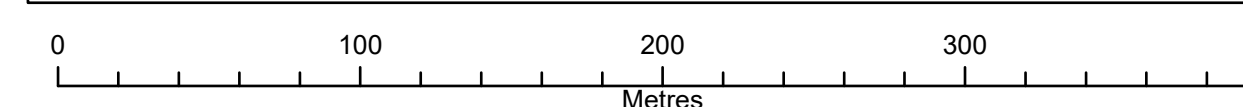


Scale: 1:2,500@ A0

APFP Regulation: 5(2)(i)	Application Doc No. CR1/GH2.2_C
Ref: IGP_GH_DCO_Land_Plan	Date: 10/11/2025
Drawn by: DLG	Checked by: AT

Land Plan
(Change Application Version)
Revision C
Sheet 17 of 18



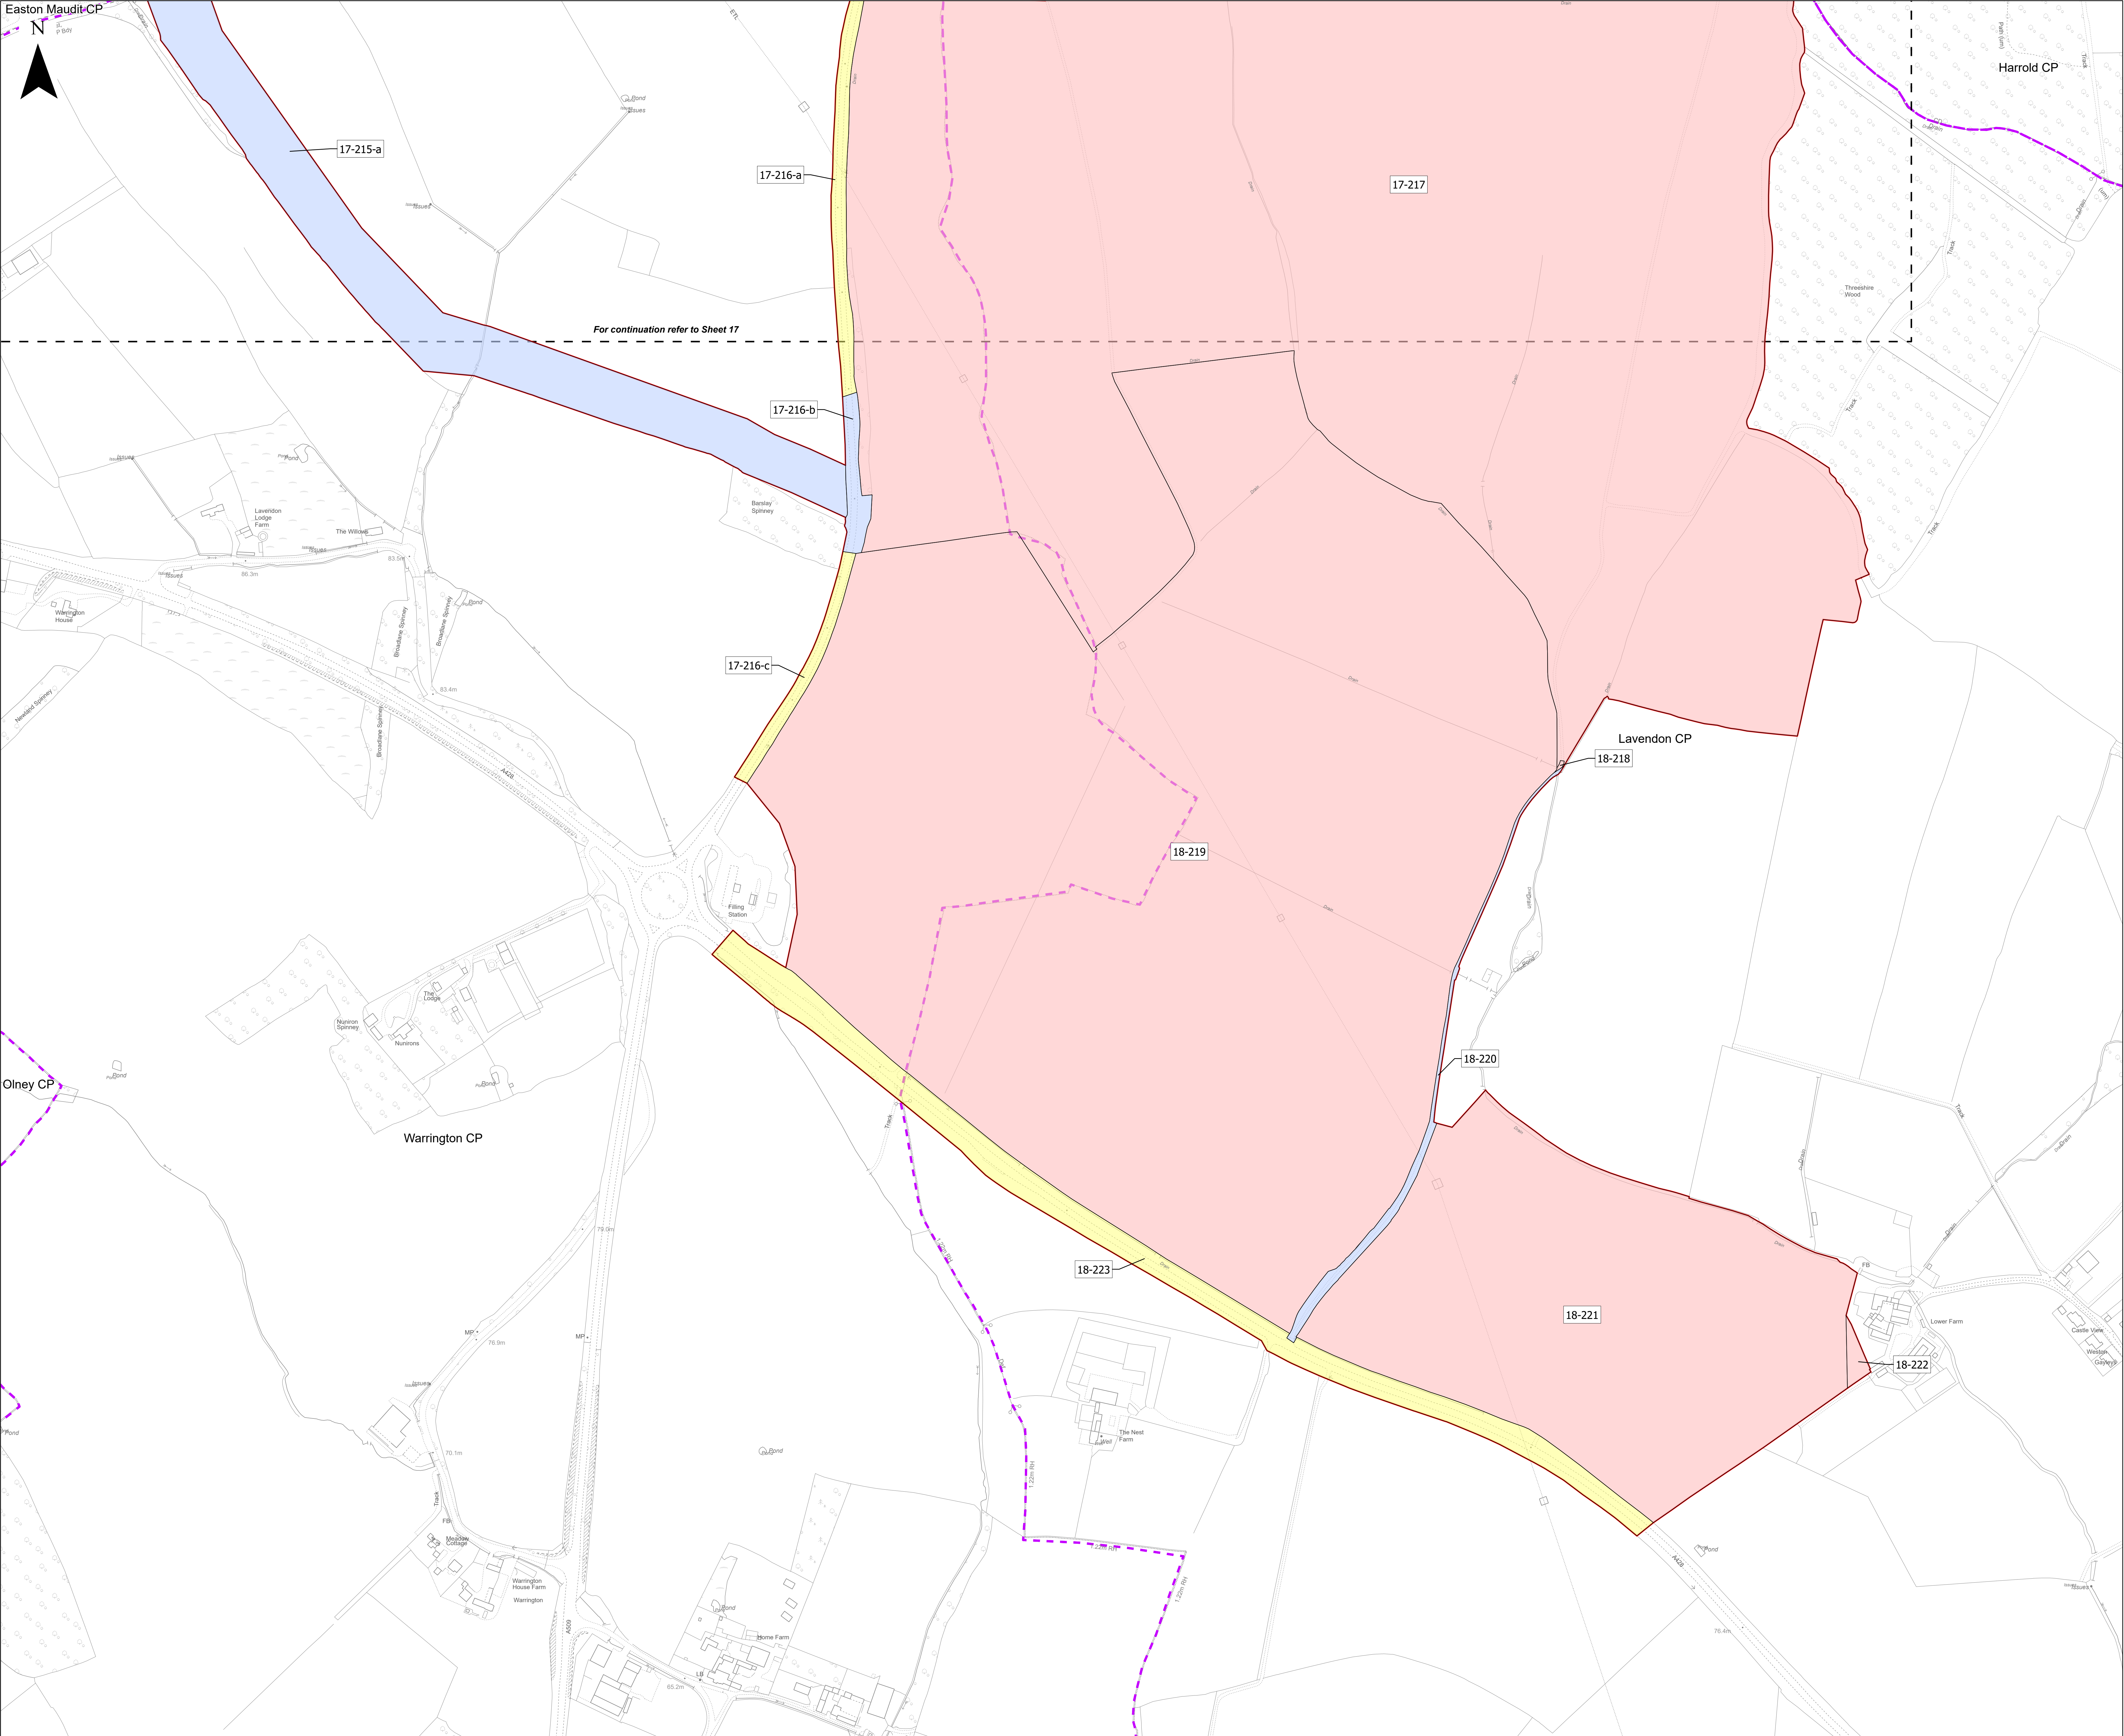



Key

- Order Limits
- Freehold to be compulsorily acquired and temporary use of land and in relation to which it is proposed that easements, servitudes and other private rights will cease to have effect
- Temporary use of land and in relation to which it is proposed to temporarily suspend easements, servitudes and other private rights
- New rights (including restrictions) to be compulsorily acquired and temporary use of land and in relation to which it is proposed that easements, servitudes and other private rights will be suspended or cease to have effect
- No Land Take
- Local Authority / Parish Boundary
- Cut Line

Base map: © Crown Copyright and database rights 2025 OS Licence no. AC000849896. All rights reserved.

0 100 200 300 400 Metres

Scale: 1:2,500@ A0

APFP Regulation: 5(2)(i)	Application Doc No. CR1/GH2.2_C
Ref: IGP_GH_DCO_Land_Plan	Date: 10/11/2025
Drawn by: DLG	Checked by: AT

Land Plan
(Change Application Version)
Revision C
Sheet 18 of 18

