Green Hill Solar Farm

EN010170

Streets Plan

Revision ~~A~~C (Tracked)

Prepared by: Lanpro

Date: ~~June~~ December 2025

Document Reference: ~~PEX~~EX3/GH2.5_~~A~~C

APFP Regulation 5(2)(k)

Schedule of Changes

Figure Reference	Page	Description of Changes	Reason for Revision
[cover]		Updated document reference to Revision C	As required for submission of Change Application.
All Sheets	3-21	Updated document references and annotations	As required for submission of Change Application.
Sheet 1	4	Order Limits extended Extension of street 1k-1l Addition of street 1n-1o	Presentation of Change 1 requested in Change Application and Consultation Report **[CR1-039]**.
Sheet 3	6	Order Limits extended Addition of street 3j-3k	Presentation of Change 3 requested in Change Application and Consultation Report **[CR1-039]**.
Sheet 8	11	Order Limits extended Extension of street 8k-10a	Presentation of Change 6 requested in Change Application and Consultation Report **[CR1-039]**.
Sheet 9	12	Order Limits extended Extension of street 8k-10a	Presentation of Change 6 requested in Change Application and Consultation Report **[CR1-039]**.
Sheet 12	15	Order Limits extended Extension of streets 12e-12f and 12g-12h	Presentation of Change 7 requested in Change Application and Consultation Report **[CR1-039]**.
Sheet 15	18	Order Limits reduced	Presentation of Change 8 requested in Change Application and Consultation Report **[CR1-039]**.
Sheet 16	19	Order Limits reduced Splitting of street 16f-16h into separate streets 16f-16h and 16n-16o	Presentation of Change 9 requested in Change Application and Consultation Report **[CR1-039]**.
Sheet 17	20	Order Limits reduced Splitting of street 16f-16h into separate streets 16f-16h and 16n-16o	Presentation of Change 9 requested in Change Application and Consultation Report **[CR1-039]**.

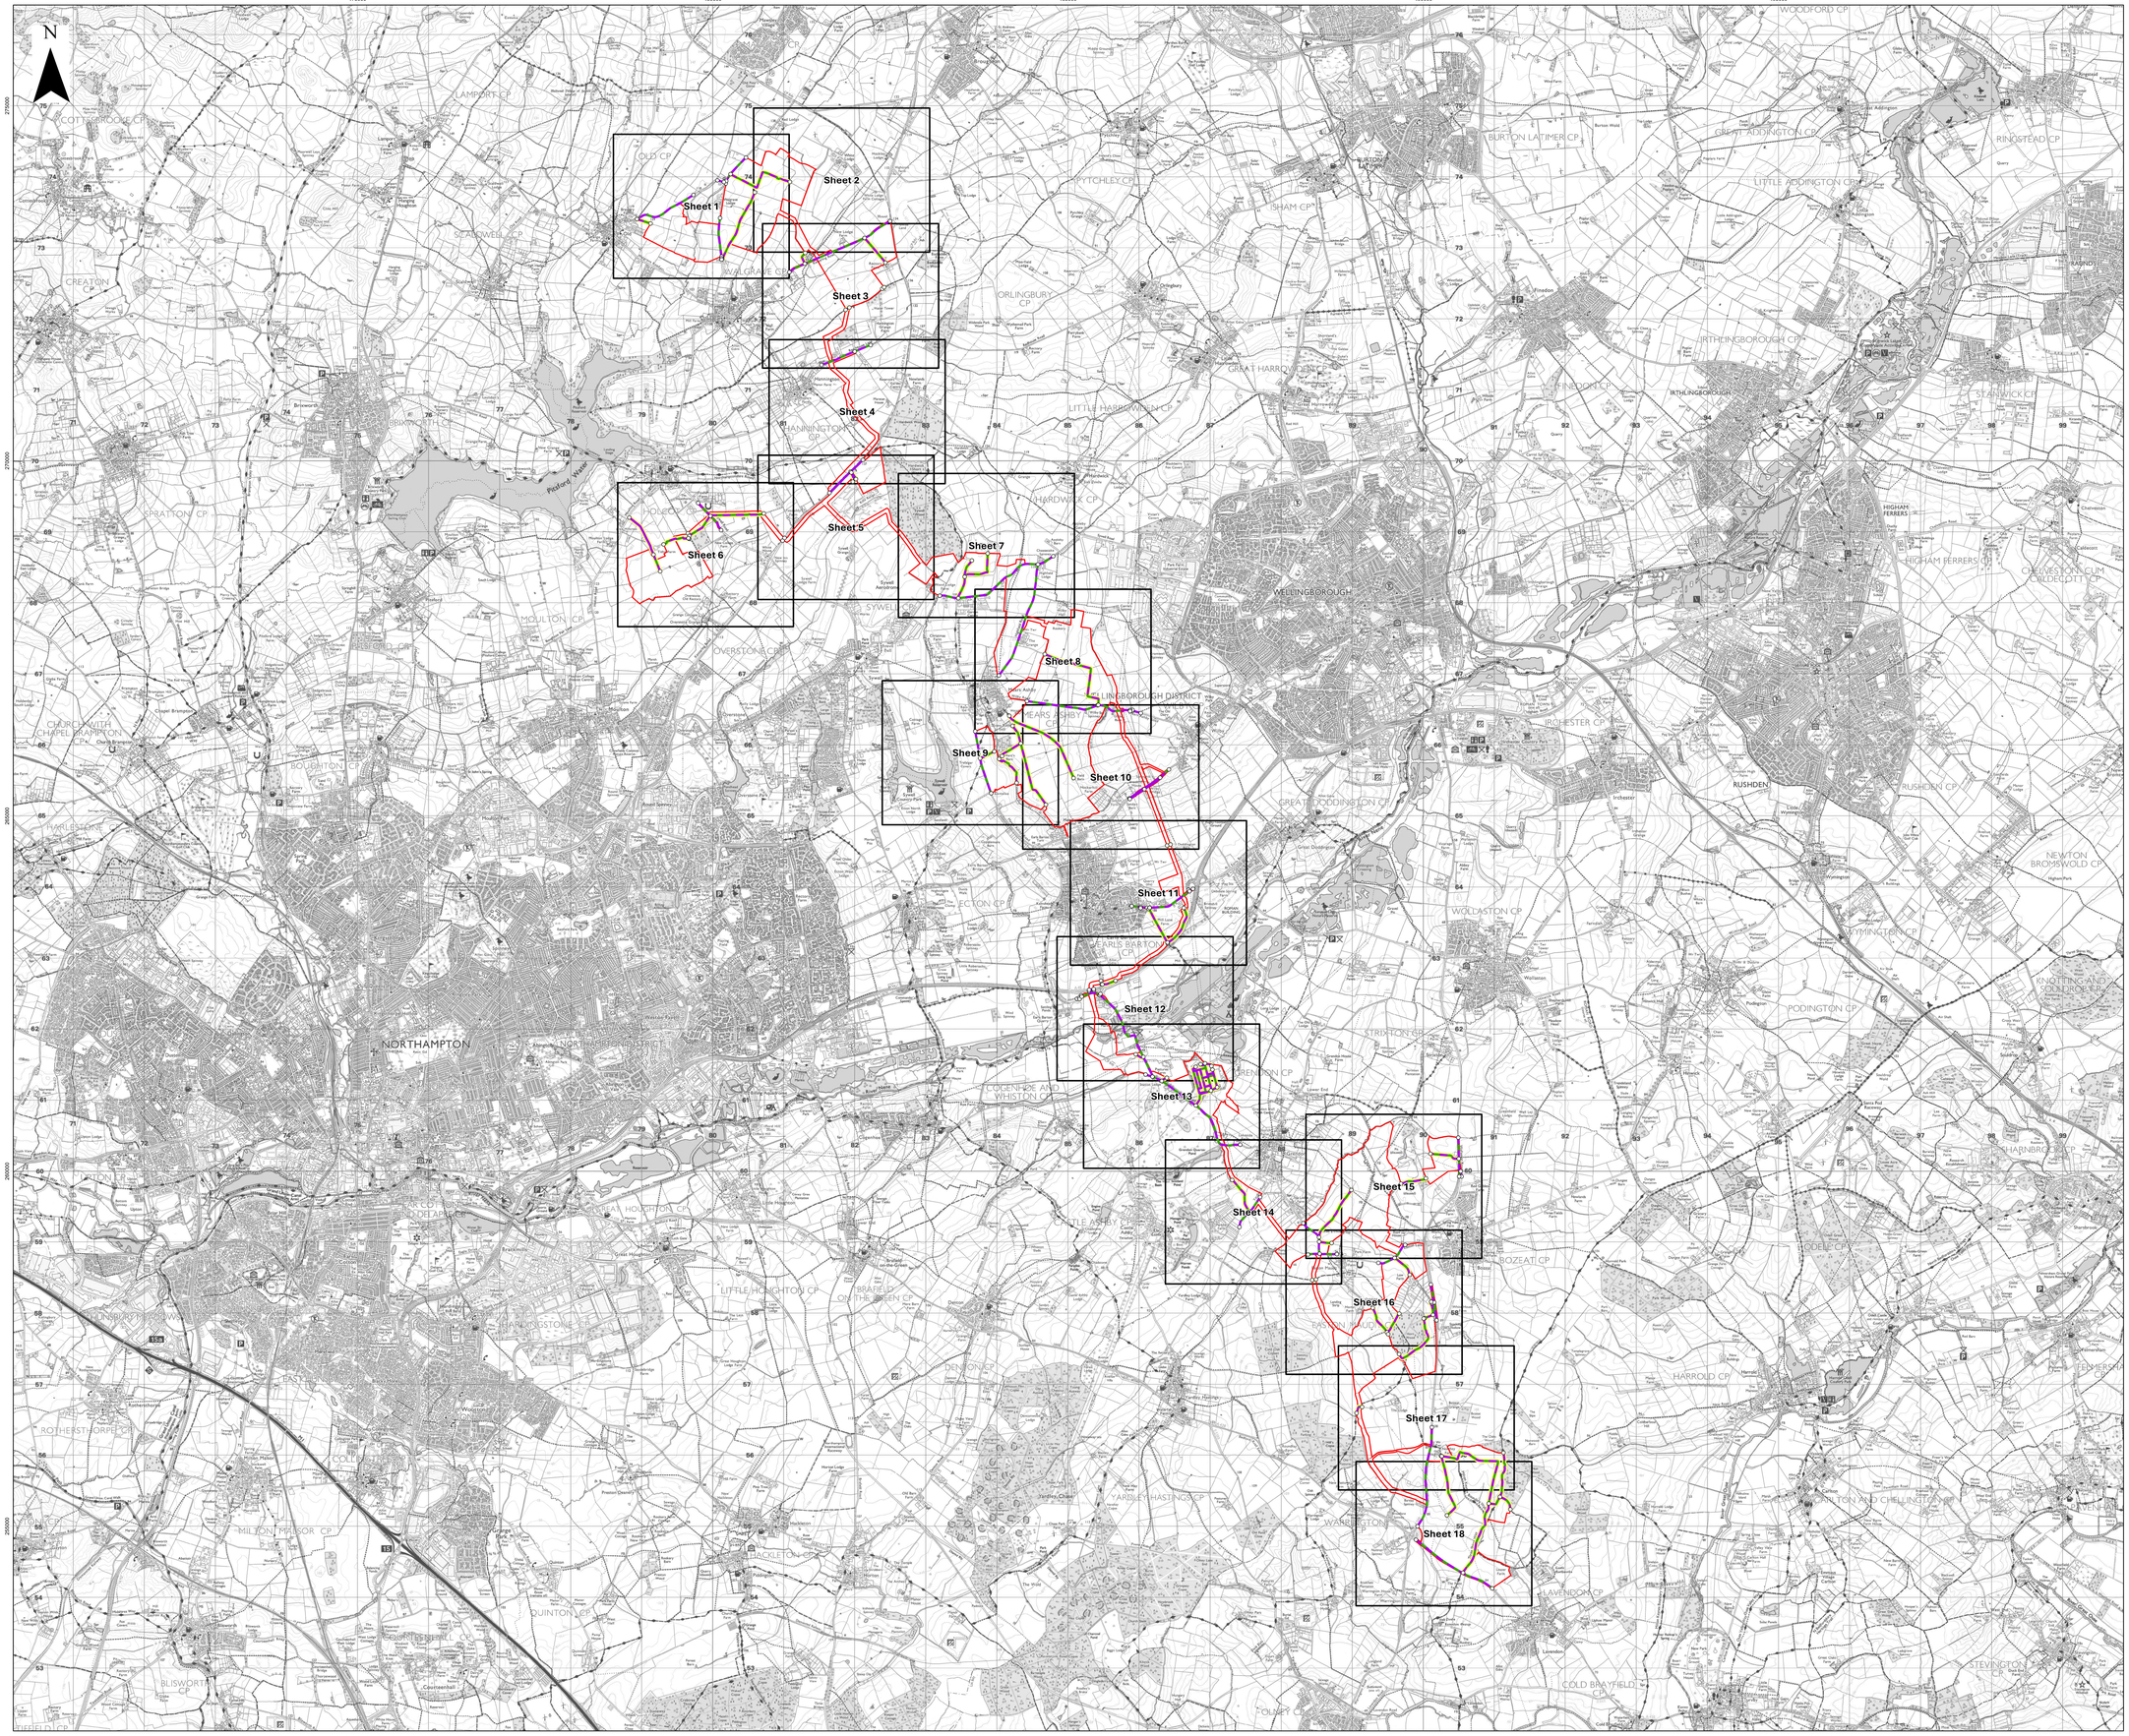

Island GREEN POWER

Lanpro

Key

- Order Limits
- Sheet Index
- Reference point within schedule
- Private street with use temporarily suspended or restricted
- Private access and street works / Private access subject to traffic regulation measures
- Street with use temporarily suspended or restricted
- Street works / Street subject to traffic regulation measures

Layers: Lanpro, 2024; IGP, 2025

Base map: Reproduced from Ordnance Survey digital map data © Crown copyright 2025. All rights reserved. License number 0100031673

0 1 2 3 4 Kilometers

Scale: 1:30,000@ A0

APFP Regulation: 5(2)(j)	Application Doc No. EX3/GH2.5_C
Ref: P3535_LPR_ZZ_XX_DR_Z_0281	Date: 15/12/2025
Drawn by: BH	Checked by: JC

Streets Plan

Index Sheet

Revision C

GREEN HILL SOLAR FARM

479000 479500 480000 480500 481000

271500 271000 270500

N

Old

Wold Farm Industrial Park

Home Plantation

Pond

Ponds

Trees

Tank

WB

Stables

Sales Barn

Police Cottage

Walgrove Lodge

Glebe Farm

Jasmine Cottage

Brewery House

Brewery Farm

The Old Corner Shop

Last House

The Homestead

Wold Farm

Tennis Court

The Old Rectory

The Manor House

The Hawthorns

Corner House Farm

The Barn

Cherry Hill House

Ruins

Public Rights of Way

Lane NW

Lane SW

Track

Ditch

Stream

Order Limits

Sheet Index

Reference point within schedule

Private street with use temporarily suspended or restricted

Private access and street works / Private access subject to traffic regulation measures

Street with use temporarily suspended or restricted

Street works / Street subject to traffic regulation measures

For continuation refer to Sheet 2

For continuation refer to Sheet 3

Layers: Lanpro, 2025; IGP, 2025

Base map: Reproduced from Ordnance Survey digital map data © Crown copyright 2025. All rights reserved. License number 0100031673

0 100 200 300 Meters

Scale: 1:2,500@ A0

APFP Regulation: 5(2)(j)	Application Doc No. EX3/GH2.5_C
Ref: P3535_LPR_ZZ_XX_DR_Z_0281	Date: 15/12/2025
Drawn by: BH	Checked by: JC

Streets Plan

Sheet 1 of 18

Revision C

GREEN HILL SOLAR FARM

481000
481500
482000
482500
483000
271500
271000
270500

N

For continuation refer to Sheet 1

For continuation refer to Sheet 3

Island GREEN POWER

Lanpro

Key

- Order Limits
- Sheet Index
- Reference point within schedule
- Private street with use temporarily suspended or restricted
- Private access and street works / Private access subject to traffic regulation measures
- Street works / Street subject to traffic regulation measures

Layers: Lanpro, 2025; IGP, 2025
Base map: Reproduced from Ordnance Survey digital map data © Crown copyright 2025. All rights reserved. License number 0100031673

0 100 200 300 Meters

Scale: 1:2,500@ A0

APFP Regulation: 5(2)(j)	Application Doc No. EX3/GH2.5_C
Ref: P3535_LPR_ZZ_XX_DR_Z_0281	Date: 15/12/2025
Drawn by: BH	Checked by: JC

Streets Plan
Sheet 2 of 18
Revision C

GREEN HILL SOLAR FARM

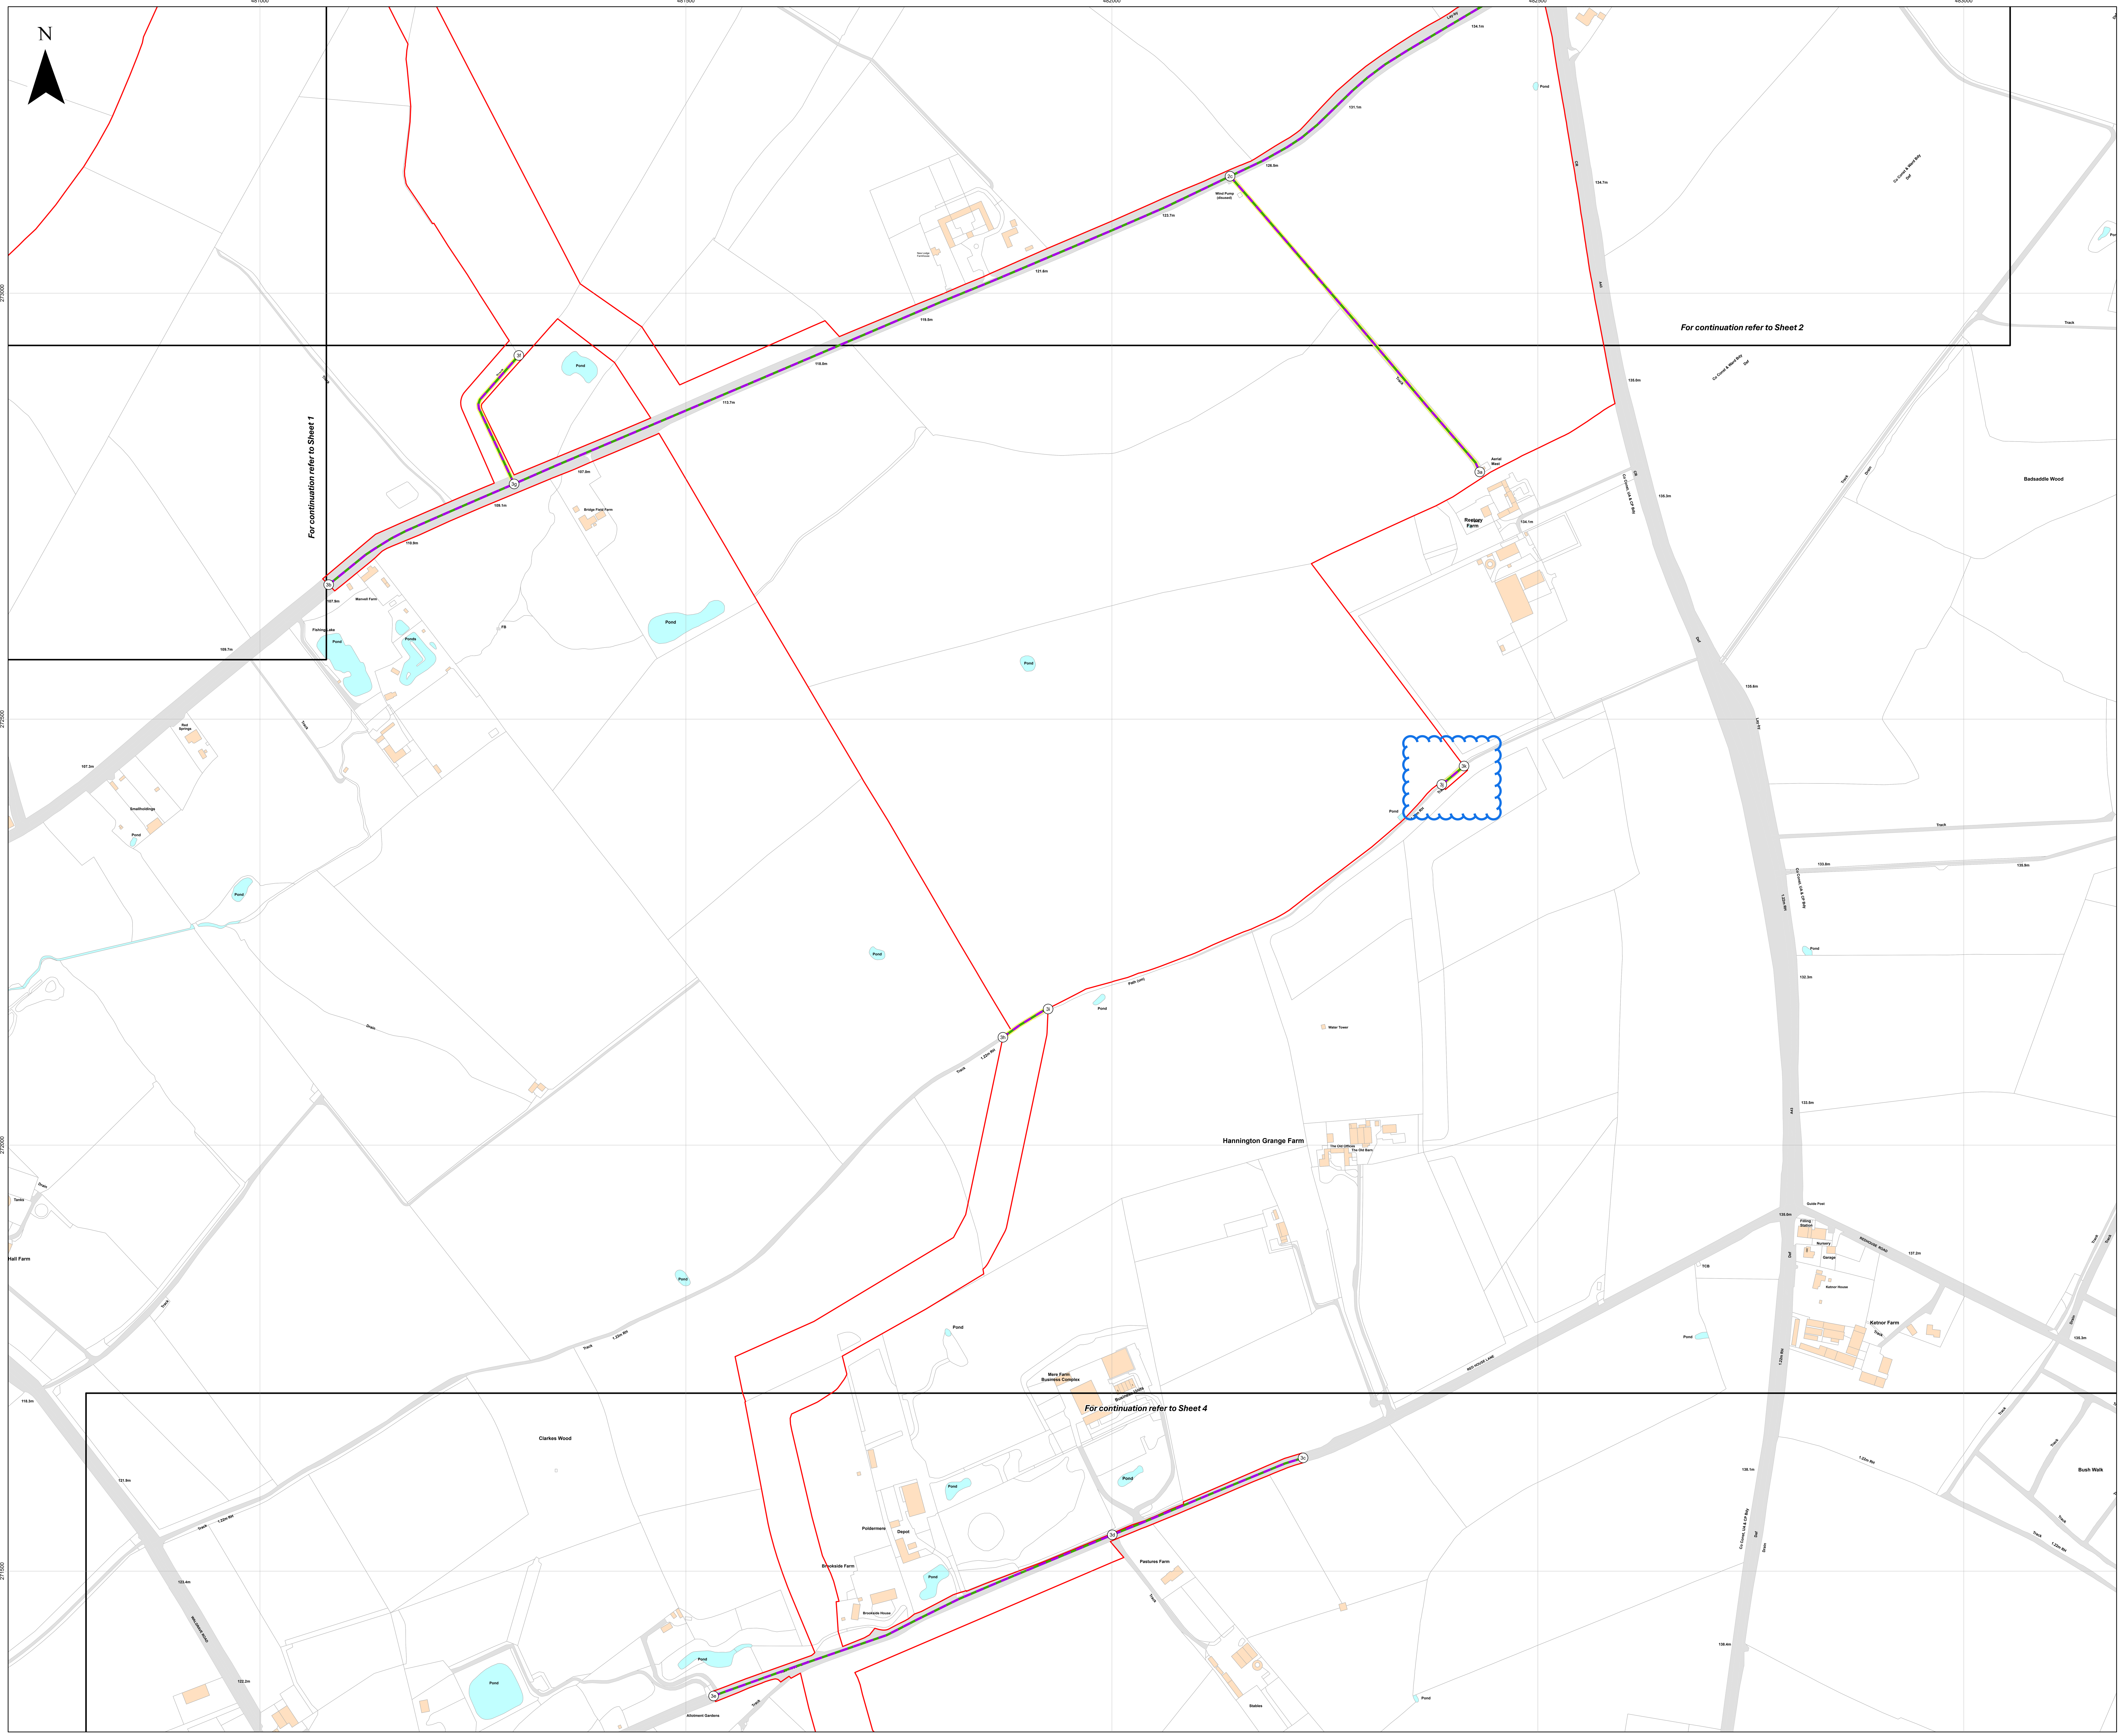

Island GREEN POWER

Lanpro

Key

- Order Limits
- Sheet Index
- Reference point within schedule
- Private street with use temporarily suspended or restricted
- Private access and street works / Private access subject to traffic regulation measures
- Street works / Street subject to traffic regulation measures

Layers: Lanpro, 2025; IGP, 2025
Base map: Reproduced from Ordnance Survey digital map data © Crown copyright 2025. All rights reserved. License number 0100031673

0 100 200 300 Meters

Scale: 1:2,500@ A0

APFP Regulation: 5(2)(j)	Application Doc No. EX3/GH2.5_C
Ref: P3535_LPR_ZZ_XX_DR_Z_0281	Date: 15/12/2025
Drawn by: BH	Checked by: JC

Streets Plan
Sheet 3 of 18
Revision C

GREEN HILL SOLAR FARM

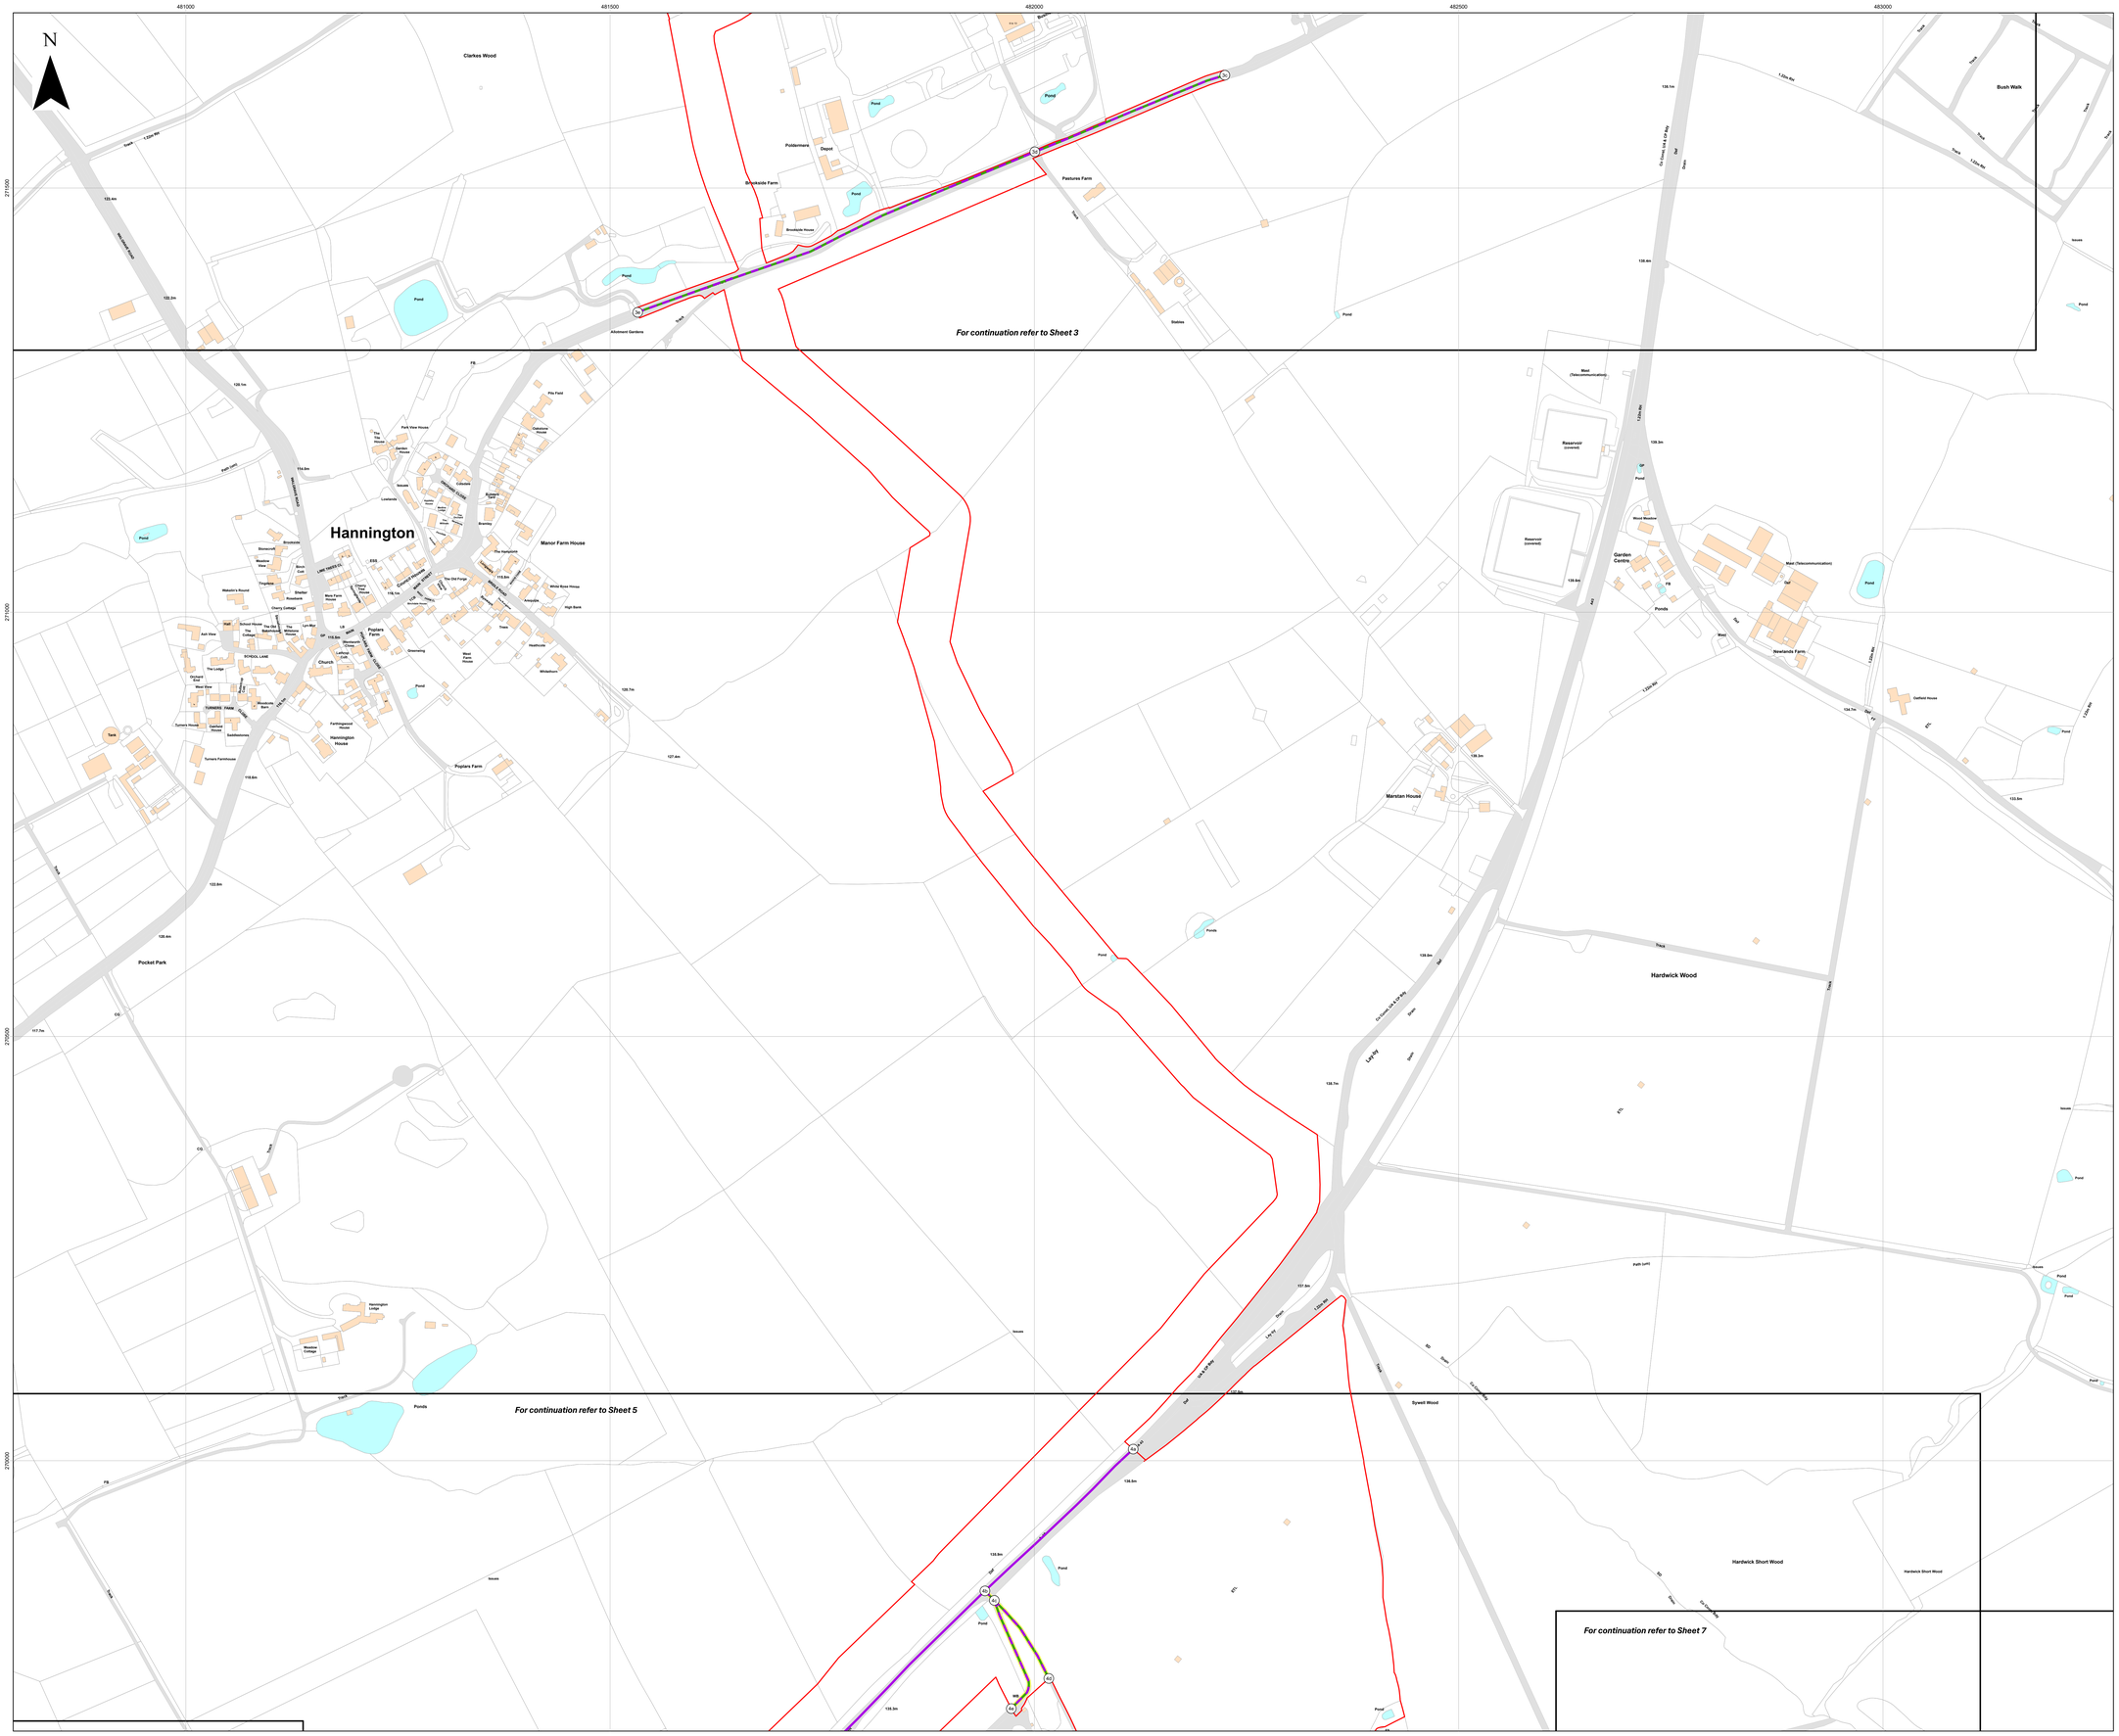

Key

- Order Limits
- Sheet Index
- Reference point within schedule
- Private street with use temporarily suspended or restricted
- Private access and street works / Private access subject to traffic regulation measures
- Street works / Street subject to traffic regulation measures

Layers: Lanpro, 2025; IGP, 2025
Base map: Reproduced from Ordnance Survey digital map data © Crown copyright 2025. All rights reserved. License number 0100031673

0 100 200 300 Meters

Scale: 1:2,500@ A0

APFP Regulation: 5(2)(j)	Application Doc No. EX3/GH2.5_C
Ref: P3535_LPR_ZZ_XX_DR_Z_0281	Date: 15/12/2025
Drawn by: BH	Checked by: JC

Streets Plan

Sheet 4 of 18
Revision C

GREEN HILL SOLAR FARM

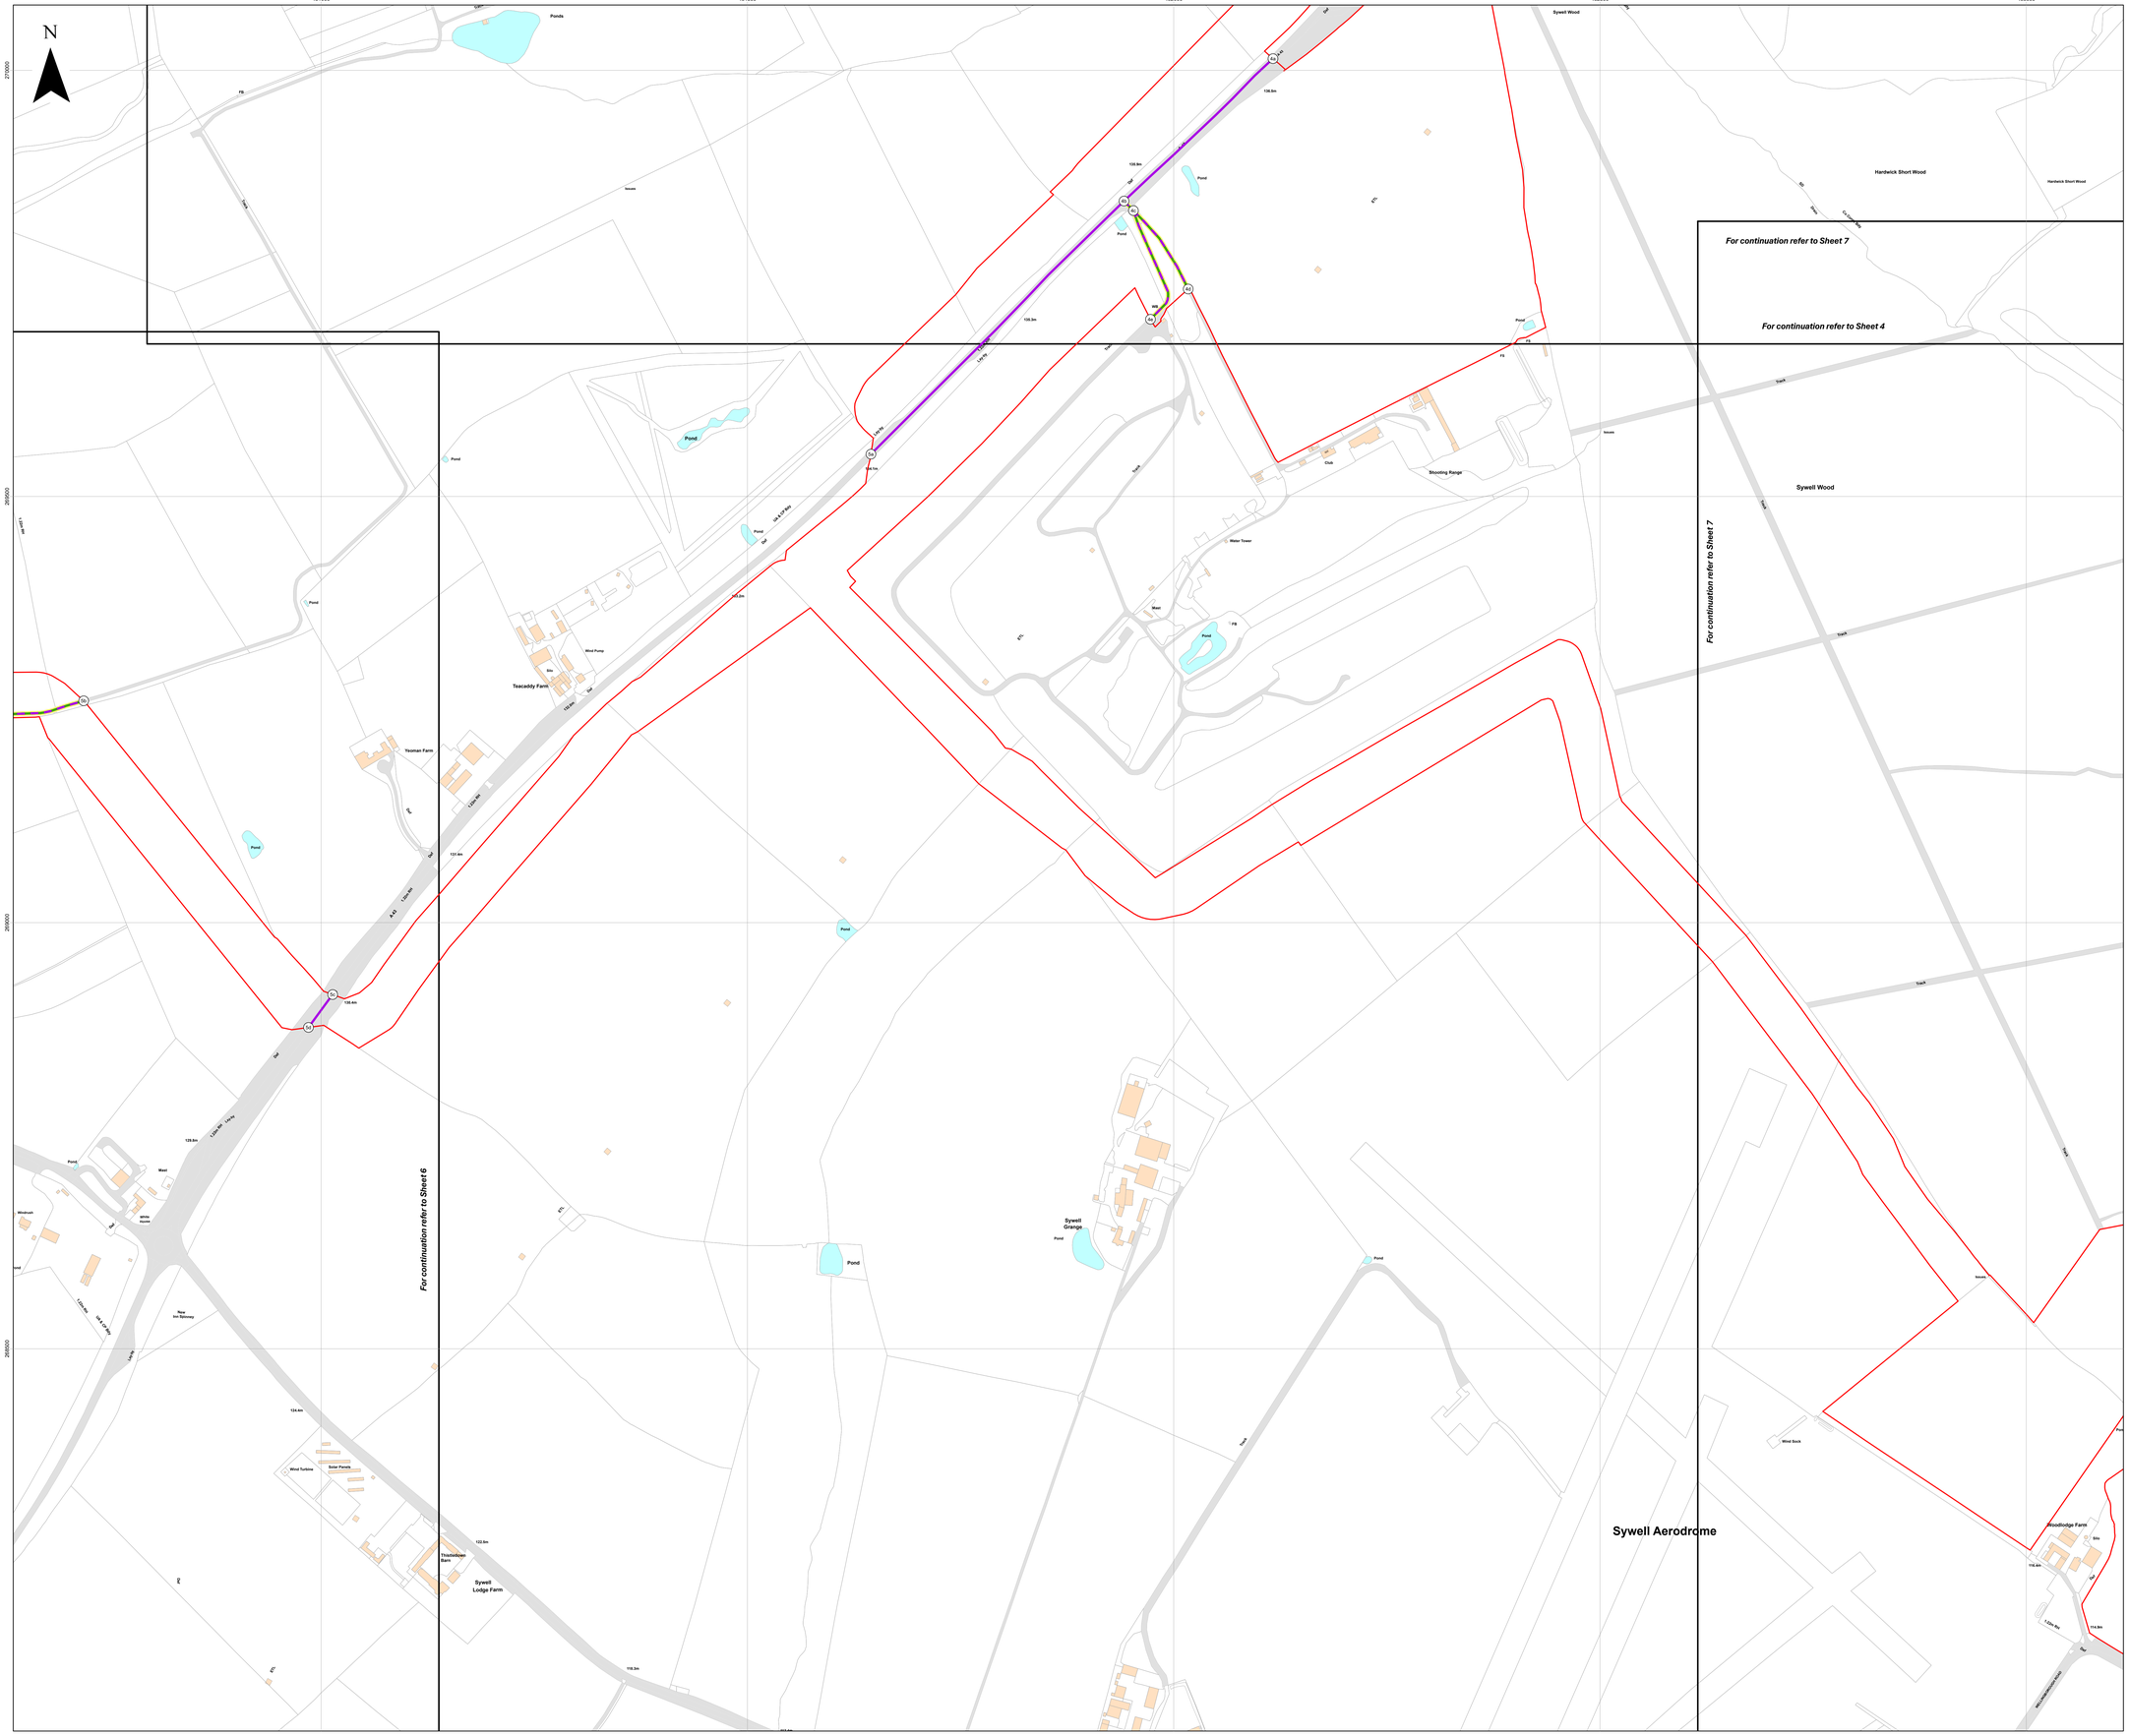

Key

- Order Limits
- Sheet Index
- Reference point within schedule
- Private street with use temporarily suspended or restricted
- Private access and street works / Private access subject to traffic regulation measures
- Street works / Street subject to traffic regulation measures

Layers: Lanpro, 2025; IGR, 2025
Base map: Reproduced from Ordnance Survey digital map data © Crown copyright 2025. All rights reserved. License number 0100031673

0 100 200 300 Meters

Scale: 1:2,500@ A0

APFP Regulation: 5(2)(j)	Application Doc No. EX3/GH2.5_C
Ref: P3535_LPR_ZZ_XX_DR_Z_0281	Date: 15/12/2025
Drawn by: BH	Checked by: JC

Streets Plan

Sheet 5 of 18
Revision C

GREEN HILL SOLAR FARM

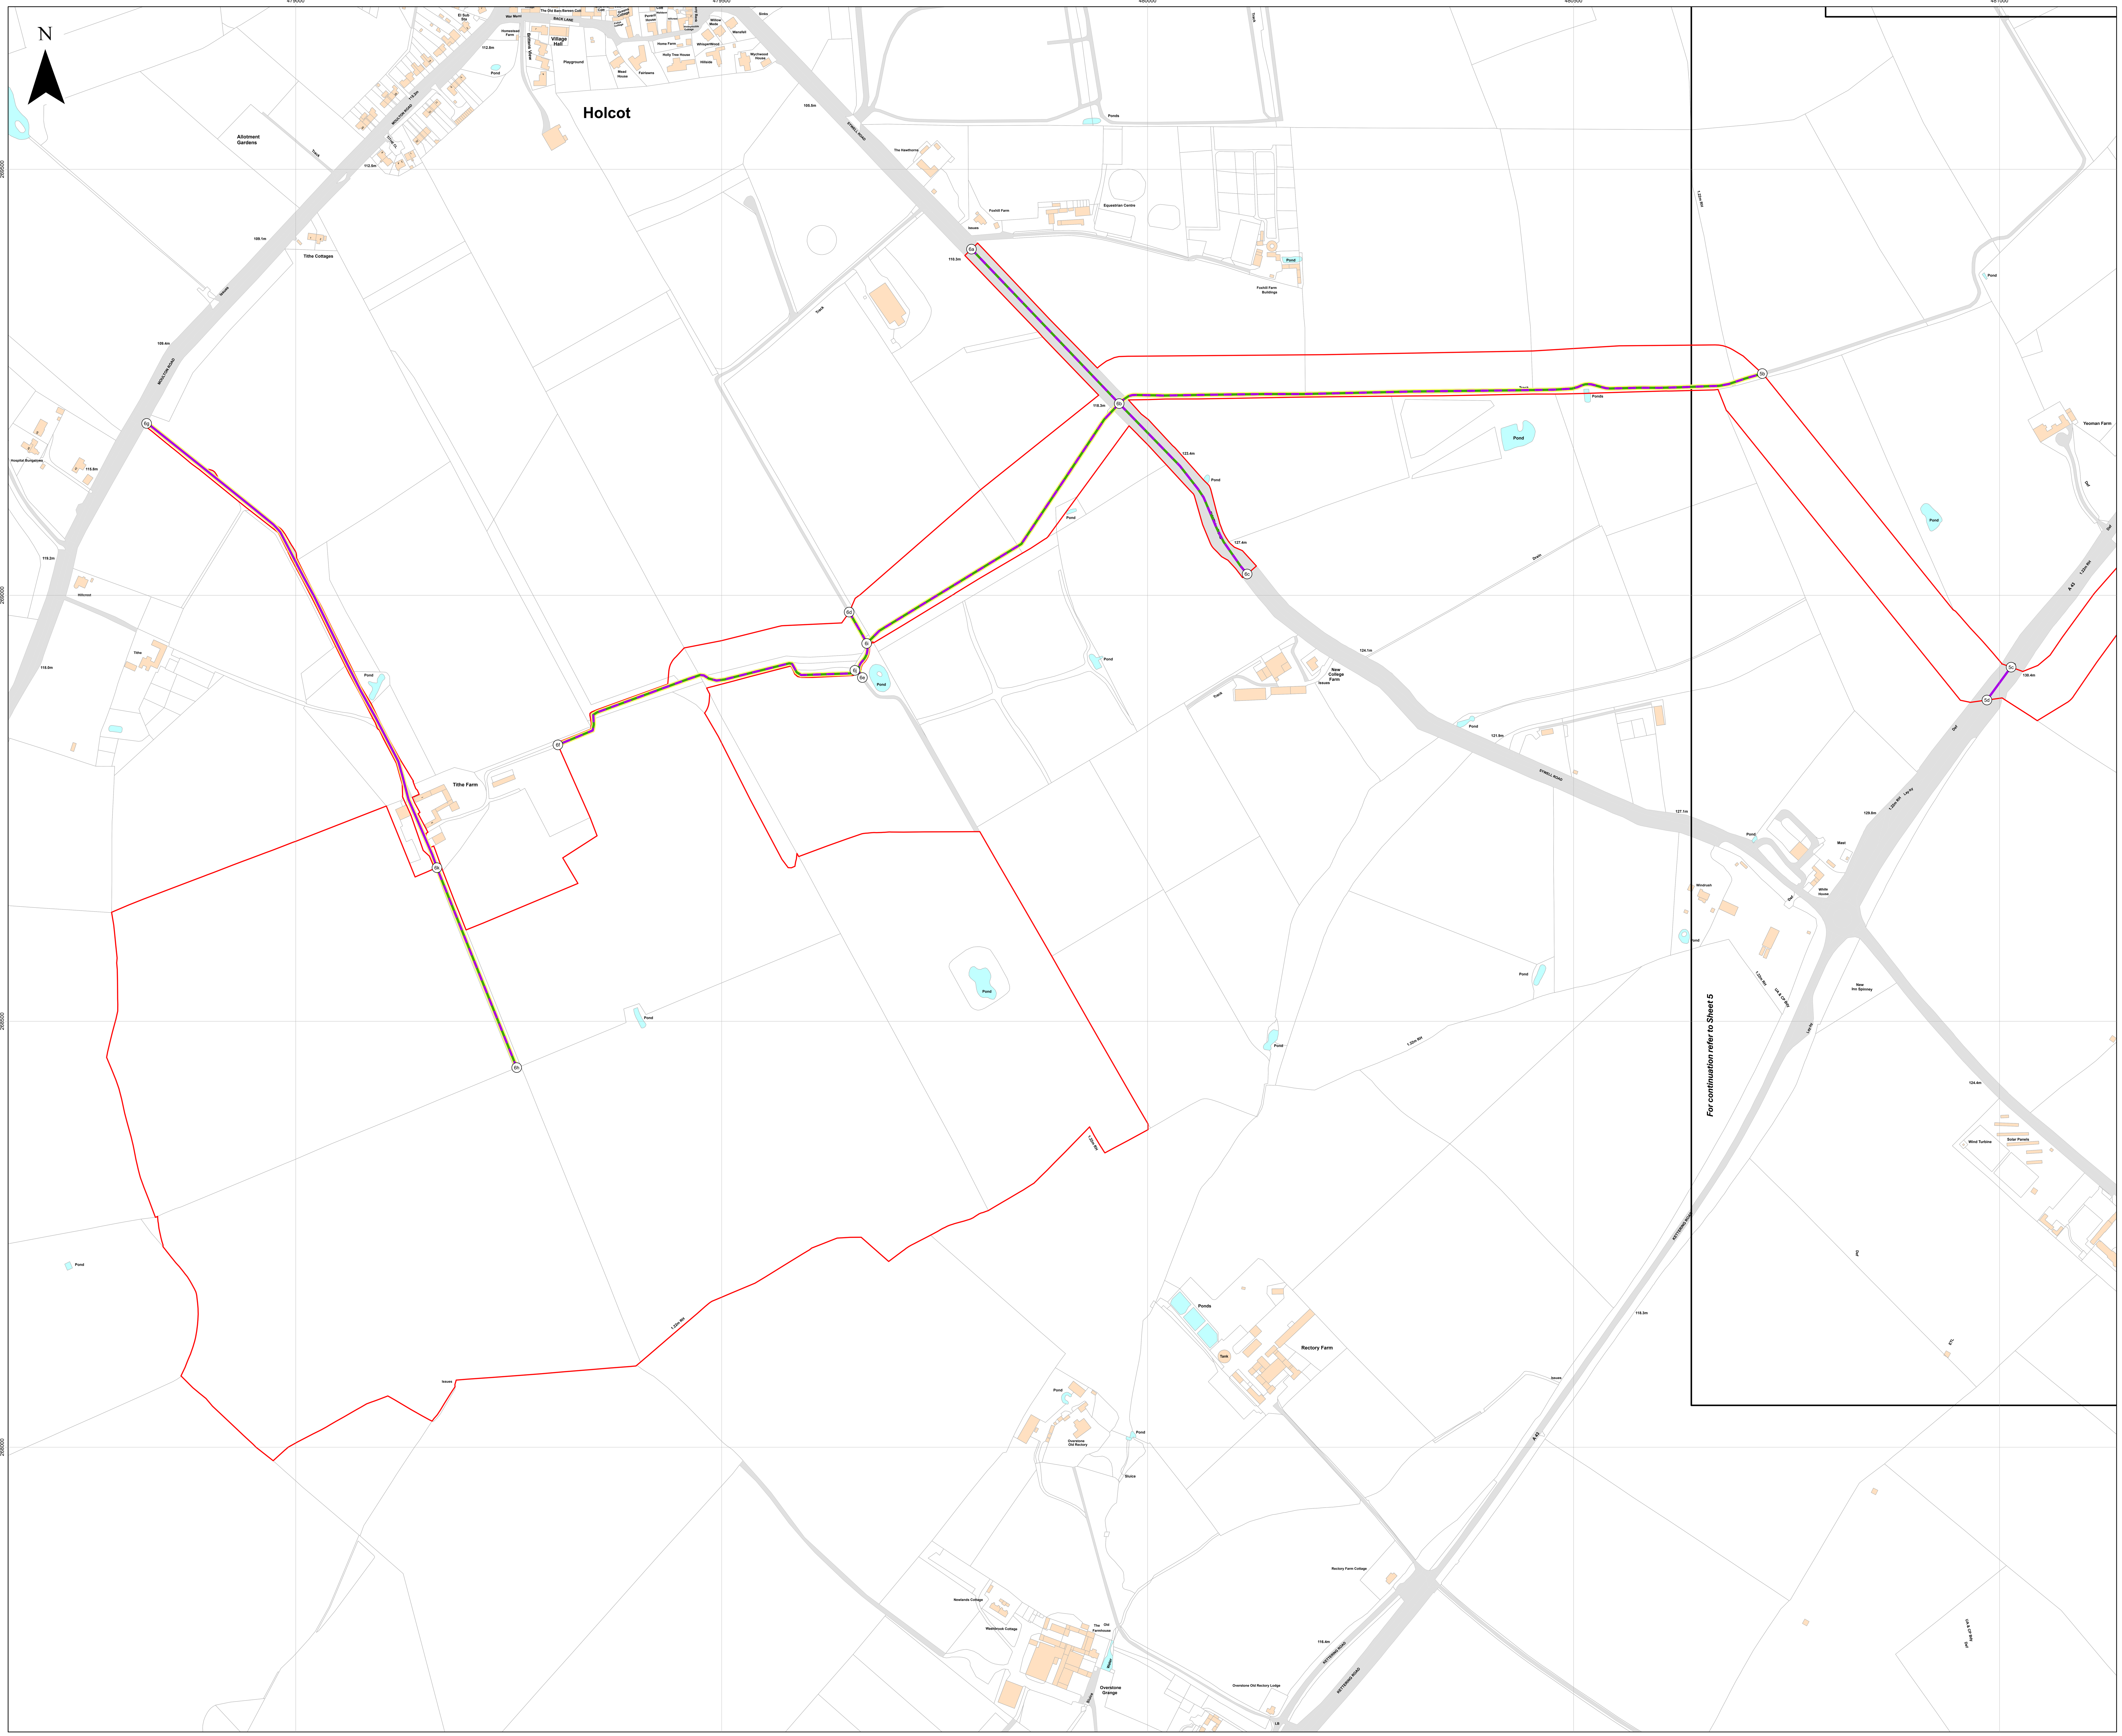

Key

- Order Limits
- Sheet Index
- Reference point within schedule
- Private street with use temporarily suspended or restricted
- Private access and street works / Private access subject to traffic regulation measures
- Street with use temporarily suspended or restricted
- Street works / Street subject to traffic regulation measures

Layers: Lanpro, 2025; IGP, 2025
Base map: Reproduced from Ordnance Survey digital map data © Crown copyright 2025. All rights reserved. License number 0100031673

0 100 200 300 Meters

Scale: 1:2,500@ A0

APFP Regulation: 5(2)(j)	Application Doc No. EX3/GH2.5_C
Ref: P3535_LPR_ZZ_XX_DR_Z_0281	Date: 15/12/2025
Drawn by: BH	Checked by: JC

Streets Plan
Sheet 6 of 18
Revision C

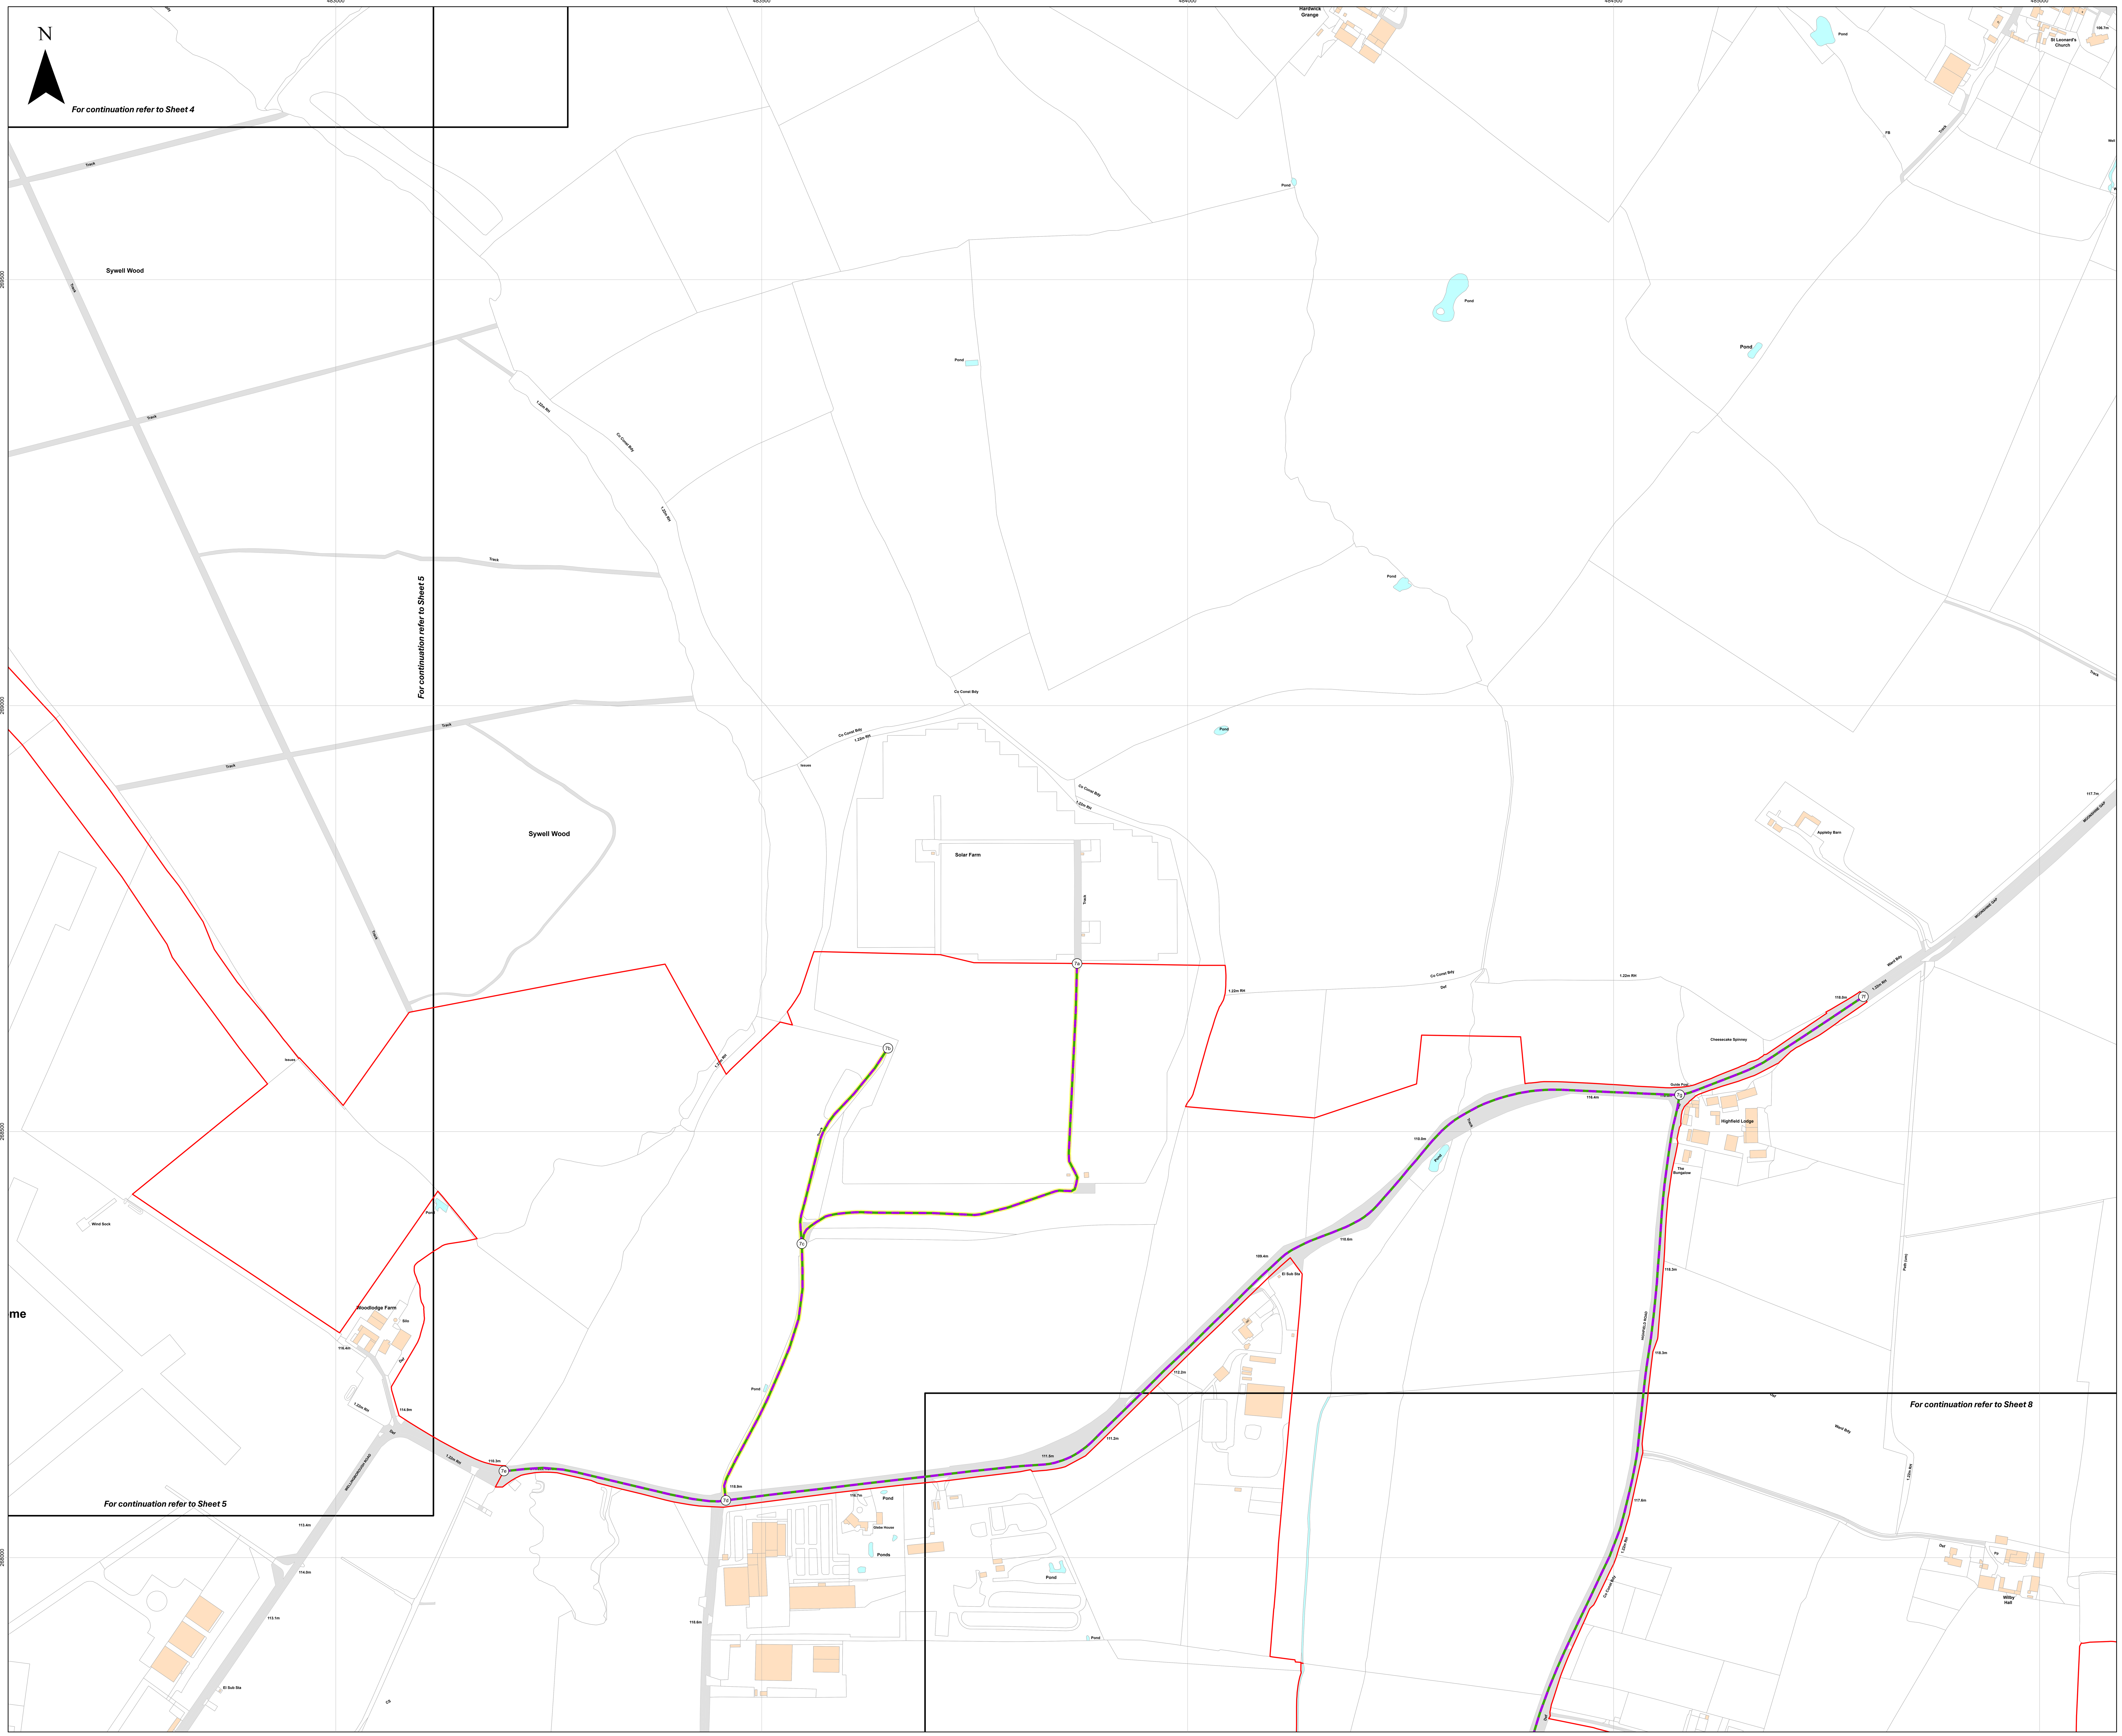

Island GREEN POWER

Lanpro

Key

- Order Limits
- Sheet Index
- Reference point within schedule
- Private street with use temporarily suspended or restricted
- Private access and street works / Private access subject to traffic regulation measures
- Street with use temporarily suspended or restricted
- Street works / Street subject to traffic regulation measures

Layers: Lanpro, 2025; IGP, 2025

Base map: Reproduced from Ordnance Survey digital map data © Crown copyright 2025. All rights reserved. License number 0100031673

0 100 200 300 Meters

Scale: 1:2,500@ A0

APFP Regulation: 5(2)(j)	Application Doc No. EX3/GH2.5_C
Ref: P3535_LPR_ZZ_XX_DR_Z_0281	Date: 15/12/2025
Drawn by: BH	Checked by: JC

Streets Plan

Sheet 7 of 18

Revision C

GREEN HILL SOLAR FARM

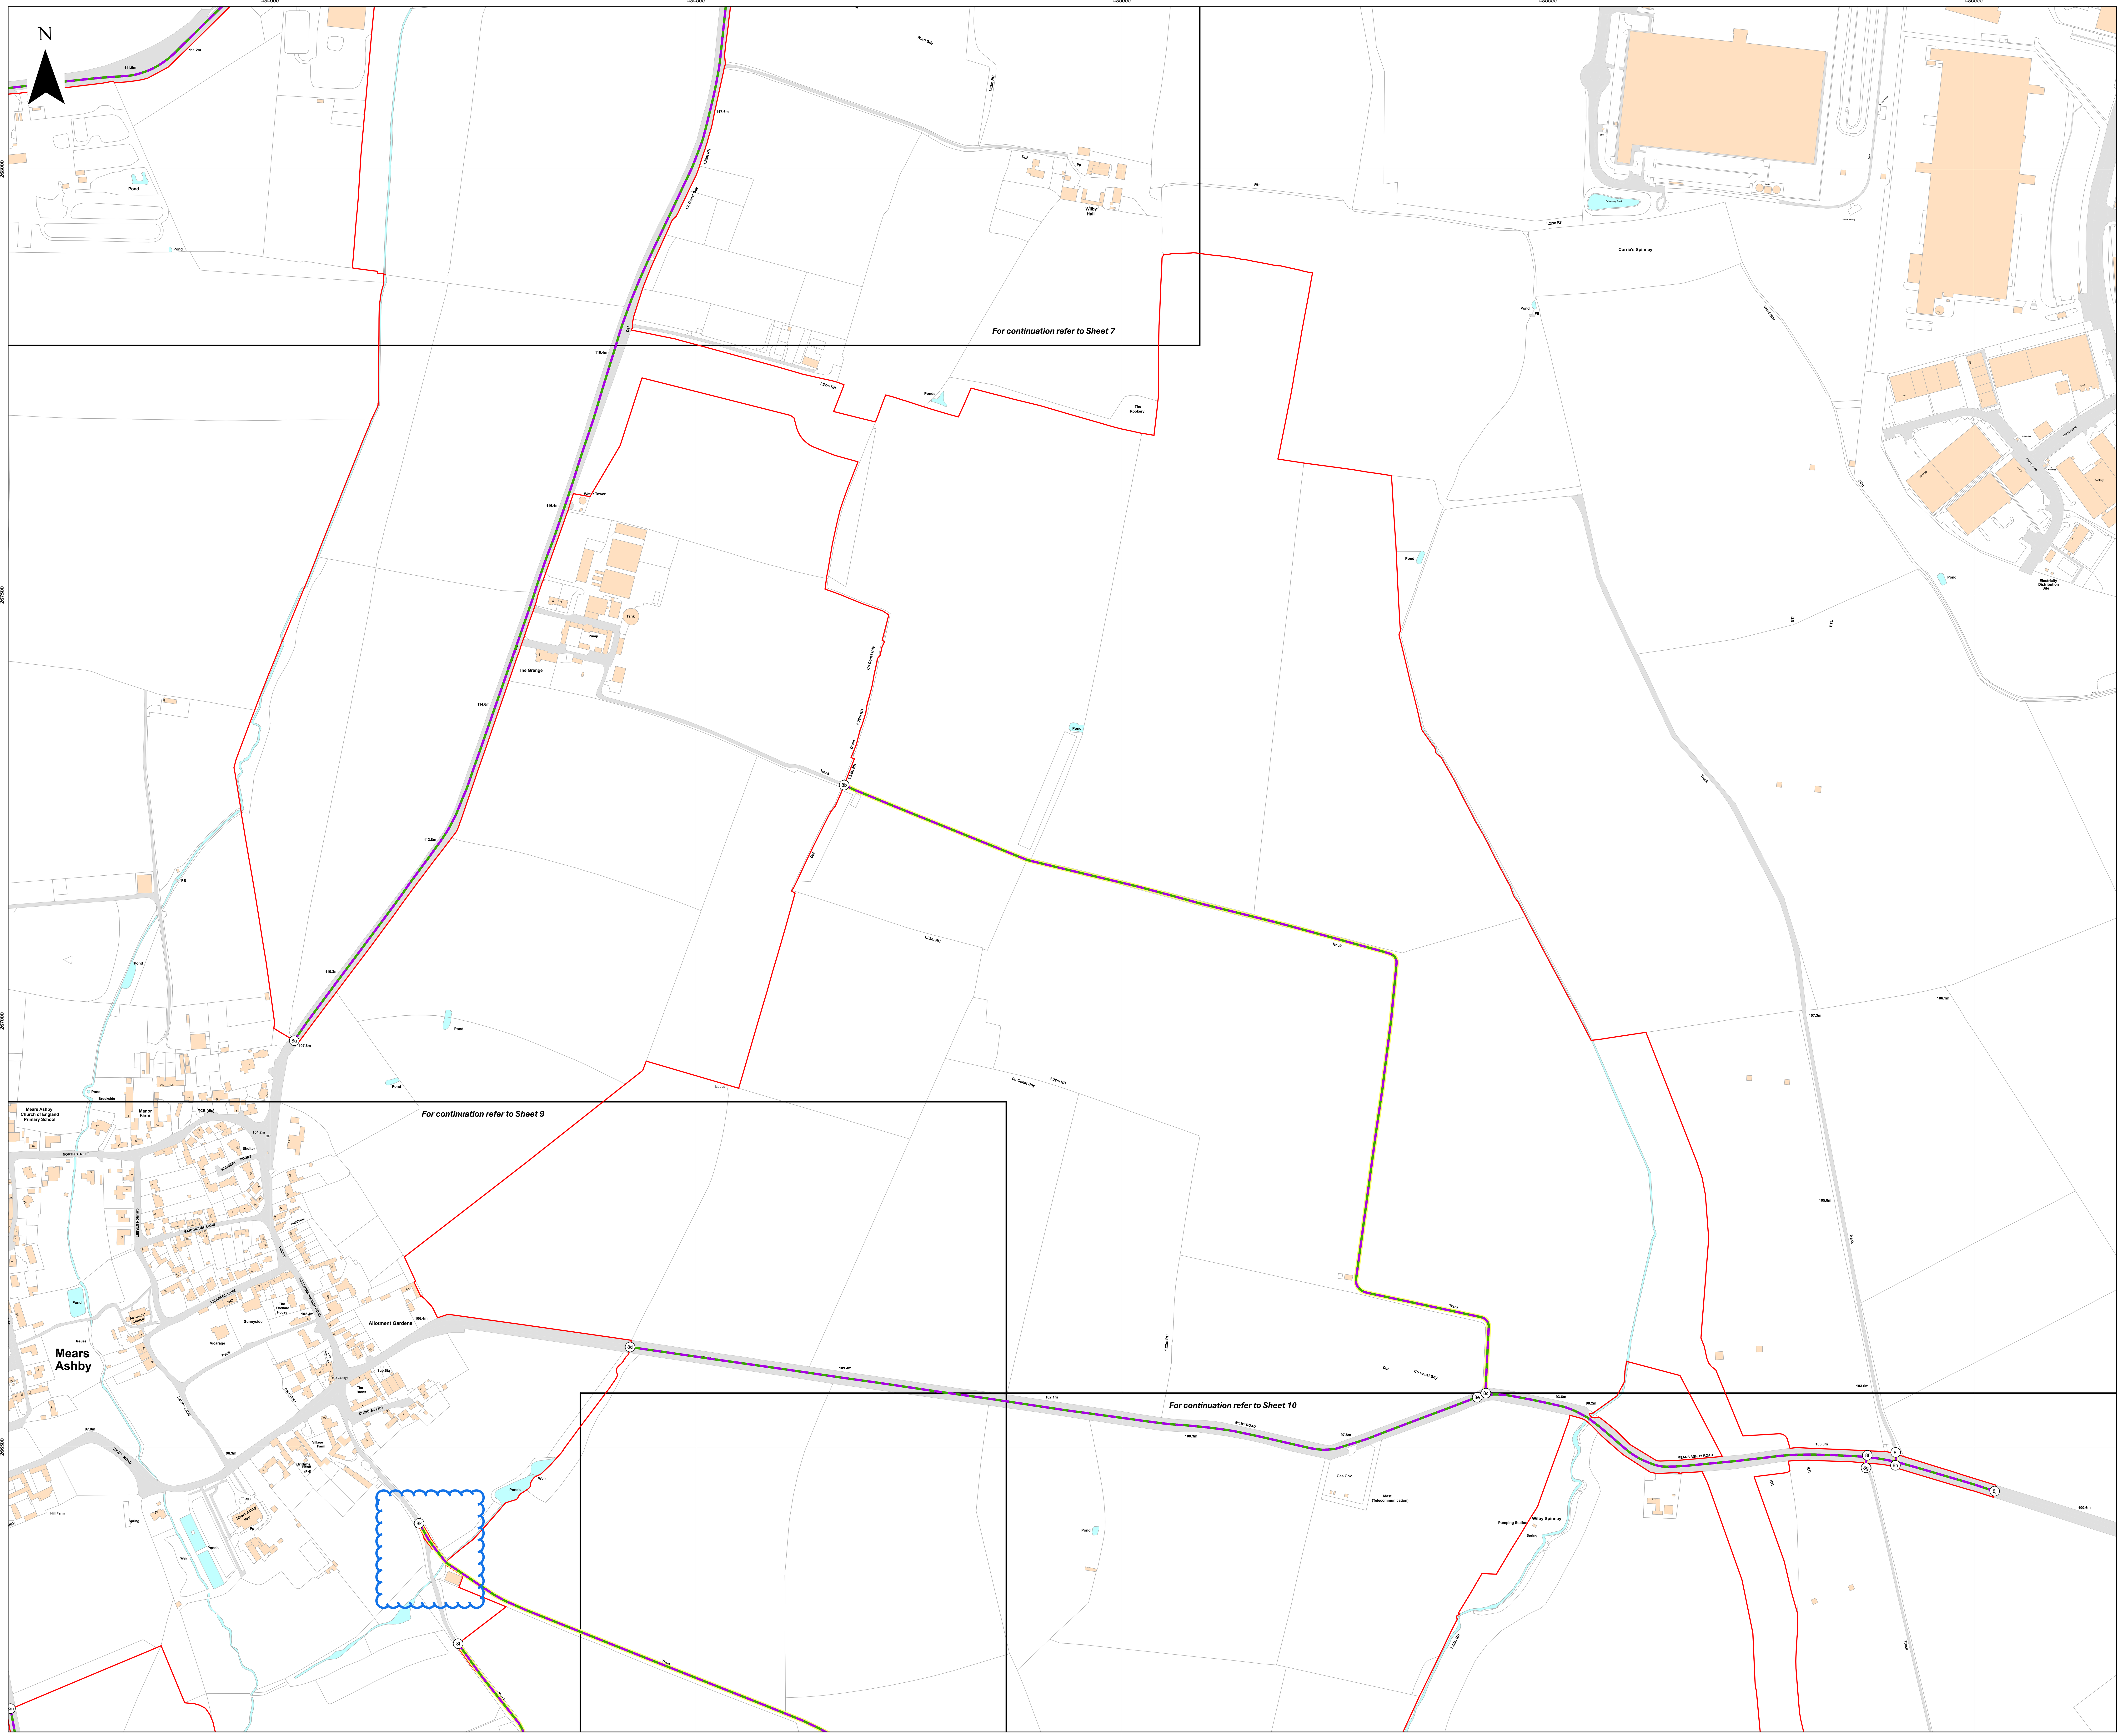

Key

- Order Limits
- Sheet Index
- Reference point within schedule
- Private street with use temporarily suspended or restricted
- Private access and street works / Private access subject to traffic regulation measures
- Street with use temporarily suspended or restricted
- Street works / Street subject to traffic regulation measures

Layers: Lanpro, 2025; IGP, 2025
Base map: Reproduced from Ordnance Survey digital map data © Crown copyright 2025. All rights reserved. License number 0100031673

Scale: 1:2,500@ A0

APFP Regulation: 5(2)(j)	Application Doc No. EX3/GH2.5_C
Ref: P3535_LPR_ZZ_XX_DR_Z_0281	Date: 15/12/2025
Drawn by: BH	Checked by: JC

Streets Plan
Sheet 8 of 18
Revision C

GREEN HILL SOLAR FARM

482500
483000
483500
484000
484500
265000
260000
255000
250000

Island GREEN POWER

Lanpro

Key

- Order Limits
- Sheet Index
- Reference point within schedule
- Private street with use temporarily suspended or restricted
- Private access and street works / Private access subject to traffic regulation measures
- Street with use temporarily suspended or restricted
- Street works / Street subject to traffic regulation measures

Layers: Lanpro, 2025; IGP, 2025
Base map: Reproduced from Ordnance Survey digital map data © Crown copyright 2025. All rights reserved. License number 0100031673

0 100 200 300 Meters

Scale: 1:2,500@ A0

APFP Regulation: 5(2)(j)	Application Doc No. EX3/GH2.5_C
Ref: P3535_LPR_ZZ_XX_DR_Z_0281	Date: 15/12/2025
Drawn by: BH	Checked by: JC

Streets Plan

Sheet 9 of 18
Revision C

GREEN HILL SOLAR FARM

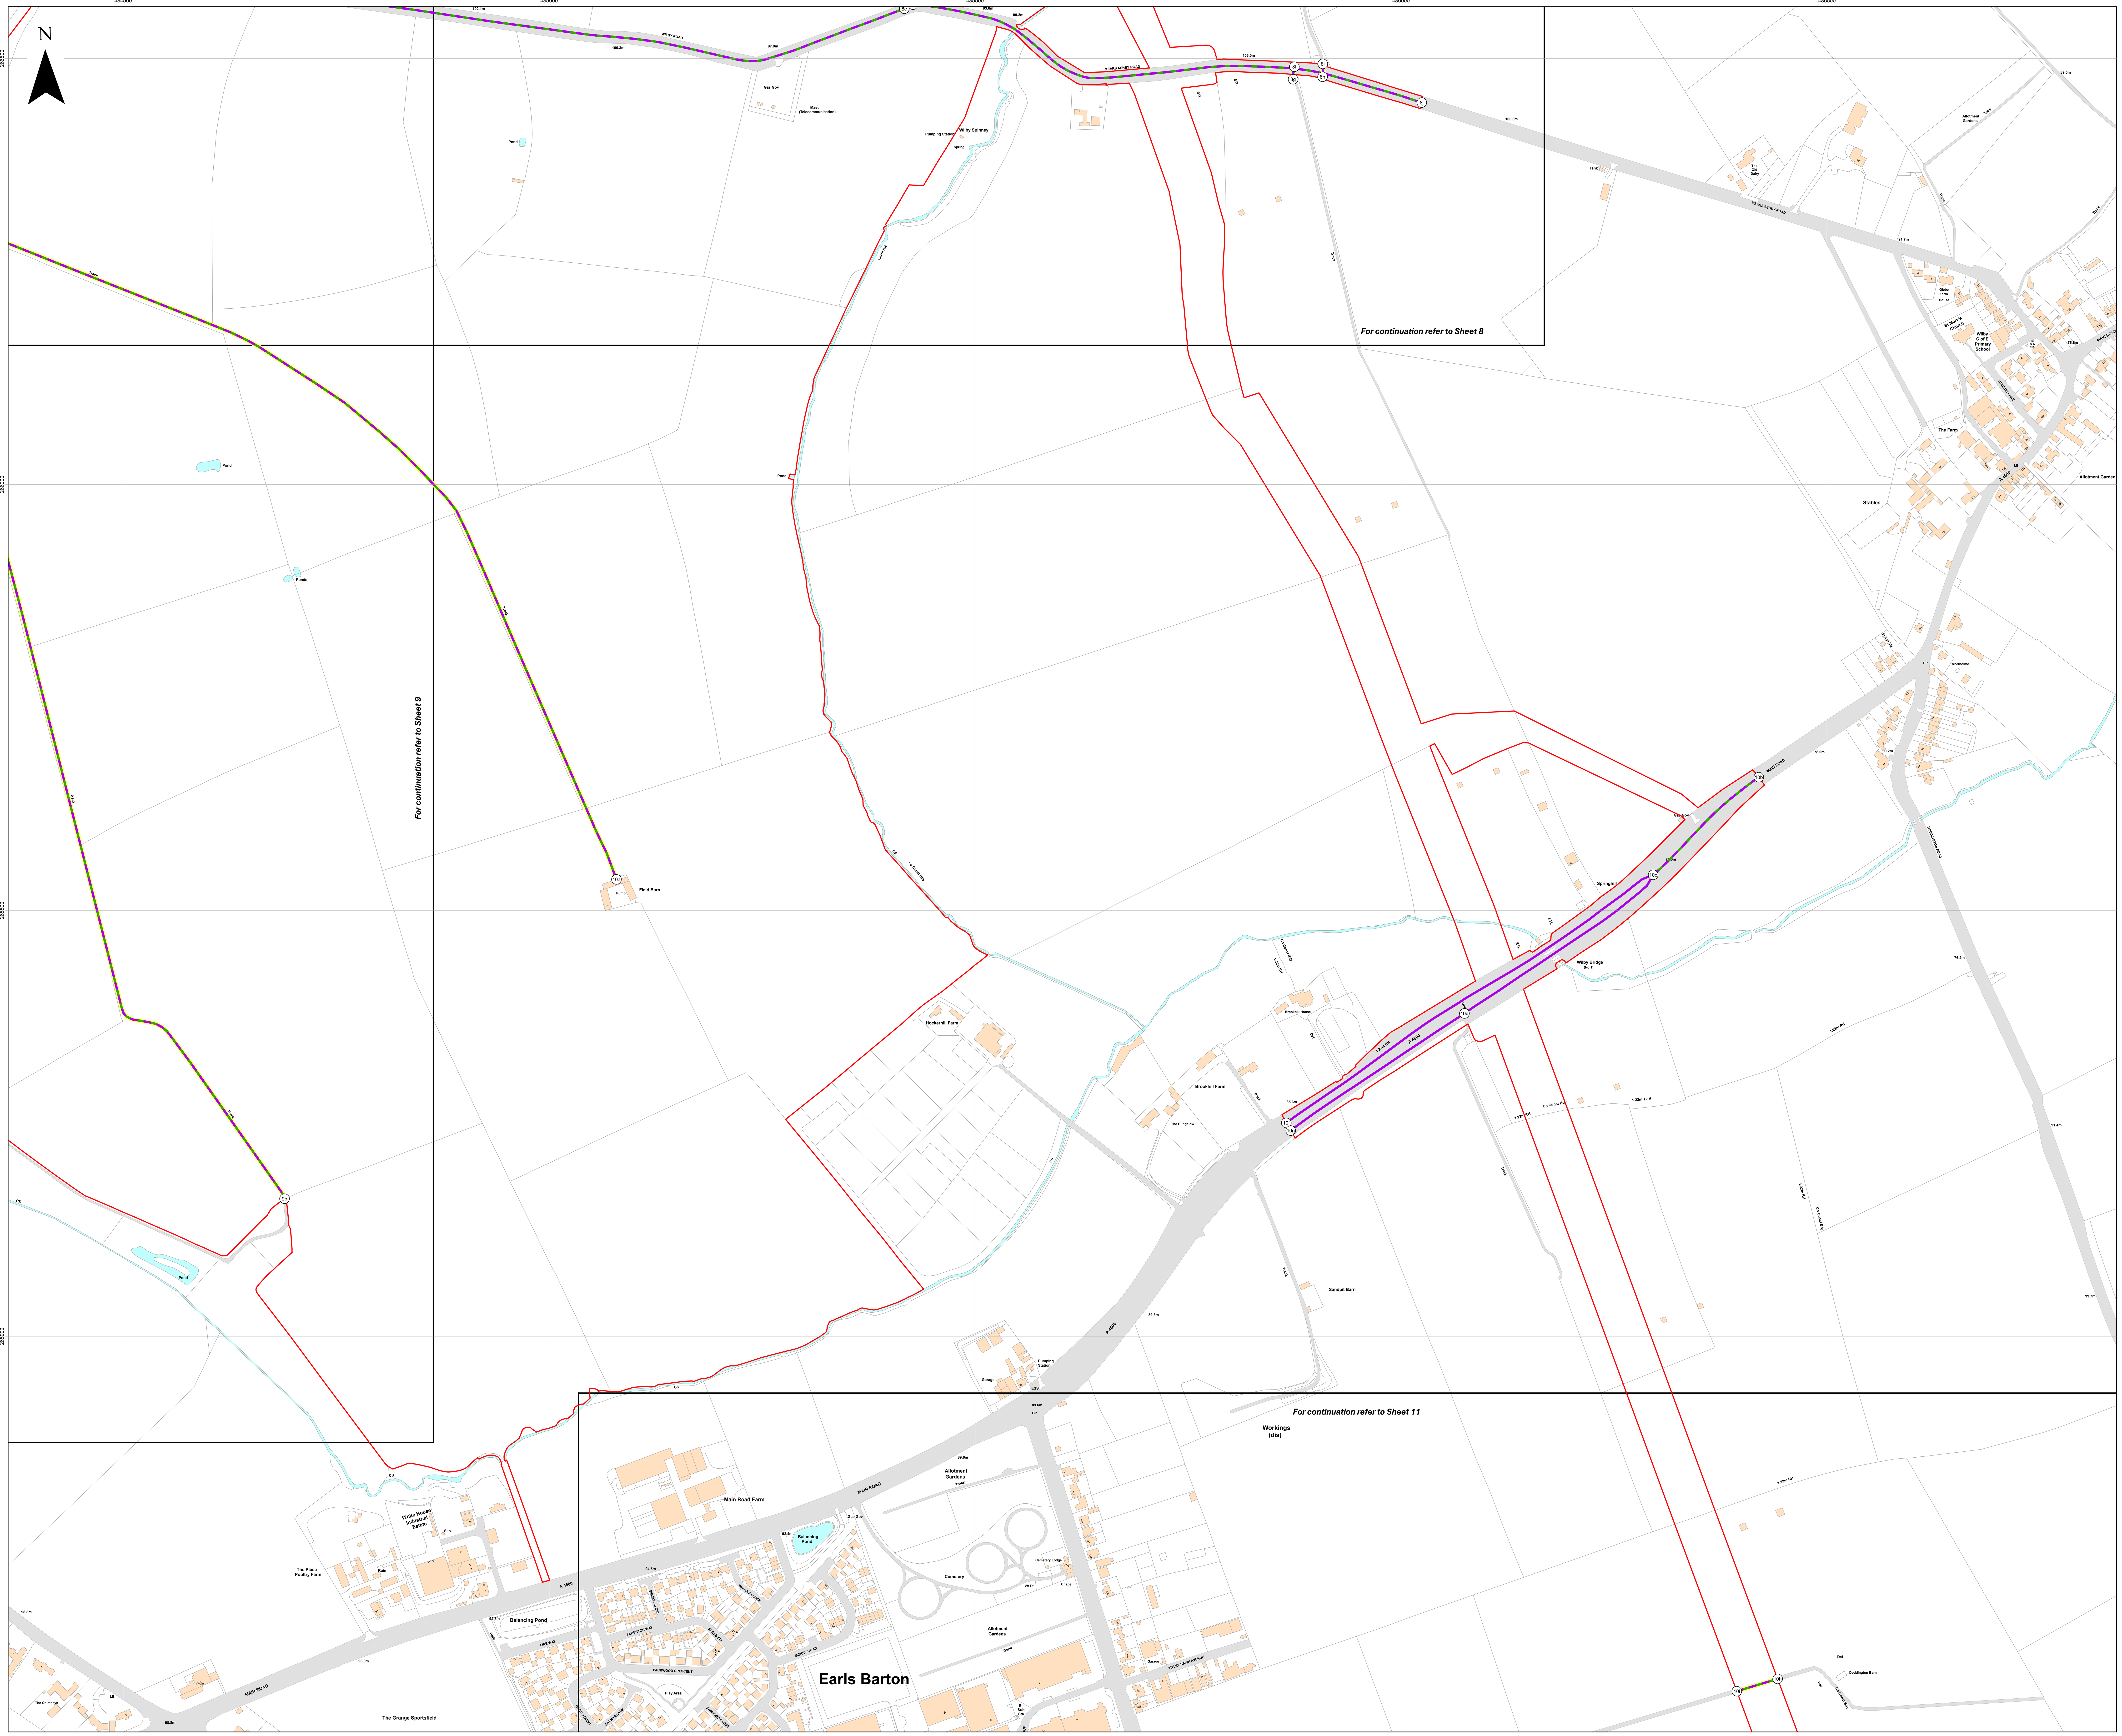

Key

- Order Limits
- Sheet Index
- Reference point within schedule
- Private street with use temporarily suspended or restricted
- Private access and street works / Private access subject to traffic regulation measures
- Street with use temporarily suspended or restricted
- Street works / Street subject to traffic regulation measures

Layers: Lanpro, 2025; IGP, 2025

Base map: Reproduced from Ordnance Survey digital map data © Crown copyright 2025. All rights reserved. License number 0100031673

0 100 200 300 Meters

Scale: 1:2,500@ A0

APFP Regulation: 5(2)(j)	Application Doc No. EX3/GH2.5_C
Ref: P3535_LPR_ZZ_XX_DR_Z_0281	Date: 15/12/2025
Drawn by: BH	Checked by: JC

Streets Plan

Sheet 10 of 18

Revision C

GREEN HILL SOLAR FARM

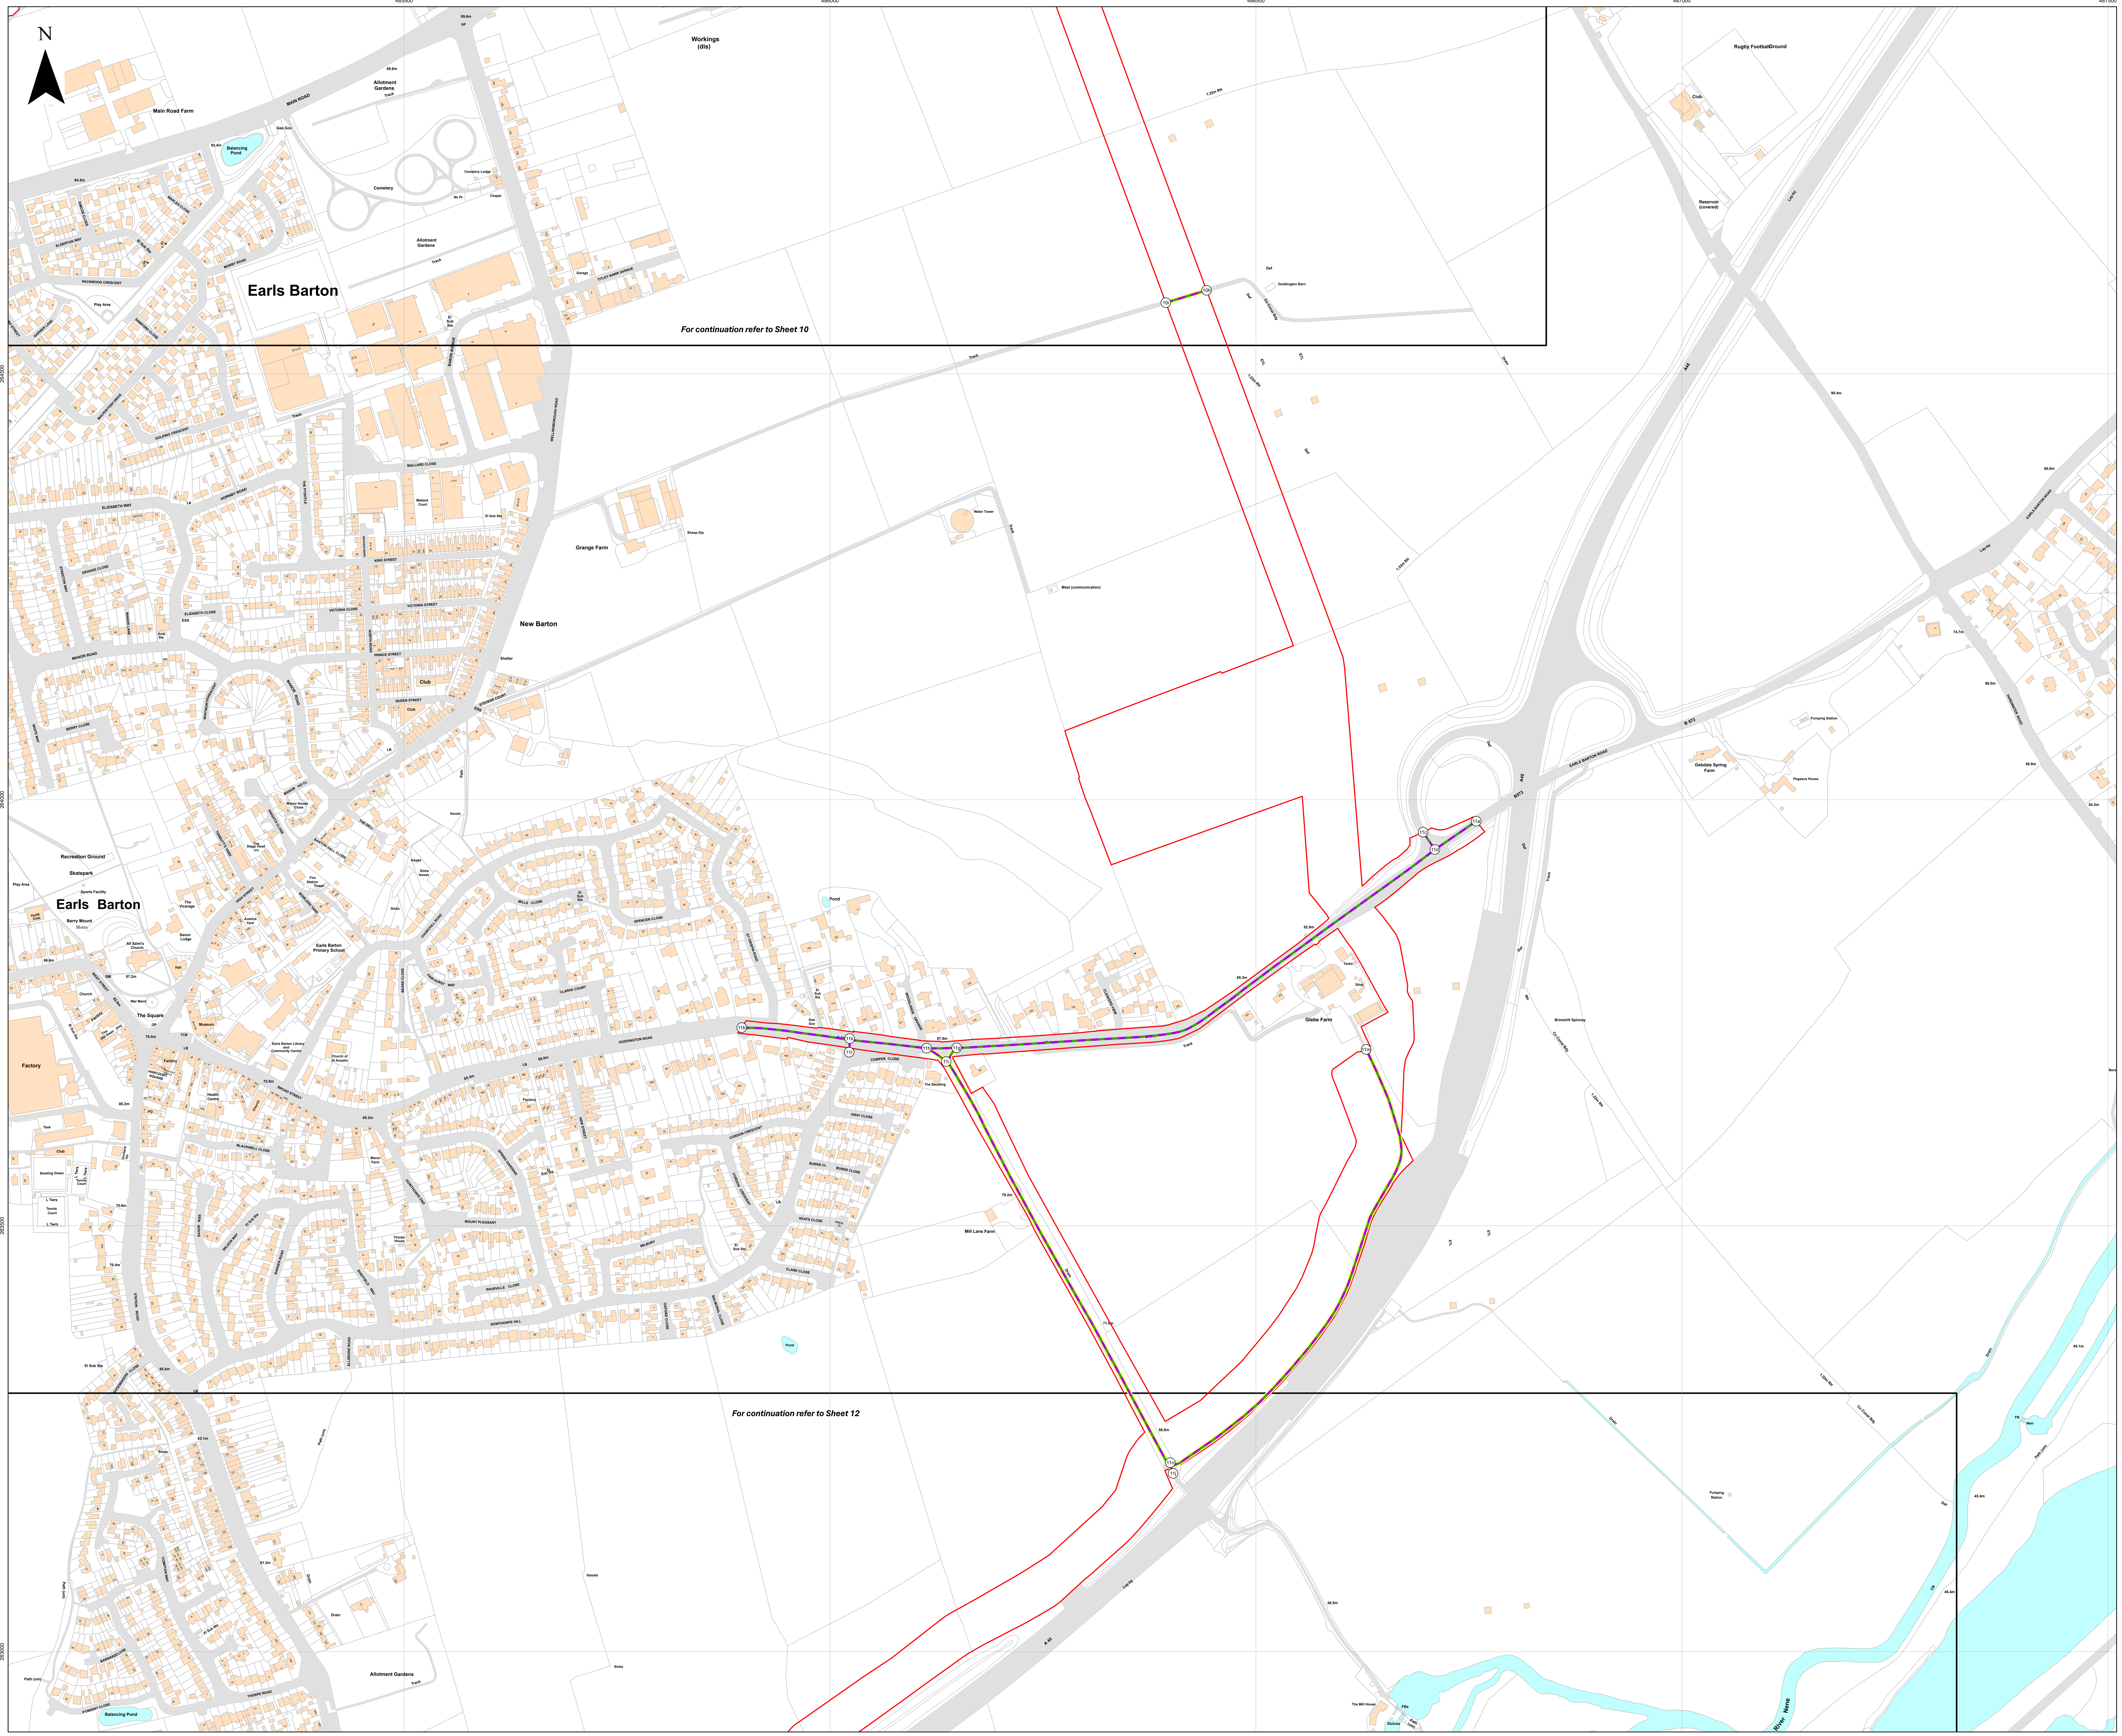

Key

- Order Limits
- Sheet Index
- Reference point within schedule
- Private street with use temporarily suspended or restricted
- Private access and street works / Private access subject to traffic regulation measures
- Street with use temporarily suspended or restricted
- Street works / Street subject to traffic regulation measures

Layers: Lanpro, 2025; IGP, 2025
Base map: Reproduced from Ordnance Survey digital map data © Crown copyright 2025. All rights reserved. License number 0100031673

0 100 200 300 Meters

Scale: 1:2,500@ A0

APFP Regulation: 5(2)(j)	Application Doc No. EX3/GH2.5_C
Ref: P3535_LPR_ZZ_XX_DR_Z_0281	Date: 15/12/2025
Drawn by: BH	Checked by: JC

Streets Plan

Sheet 11 of 18
Revision C

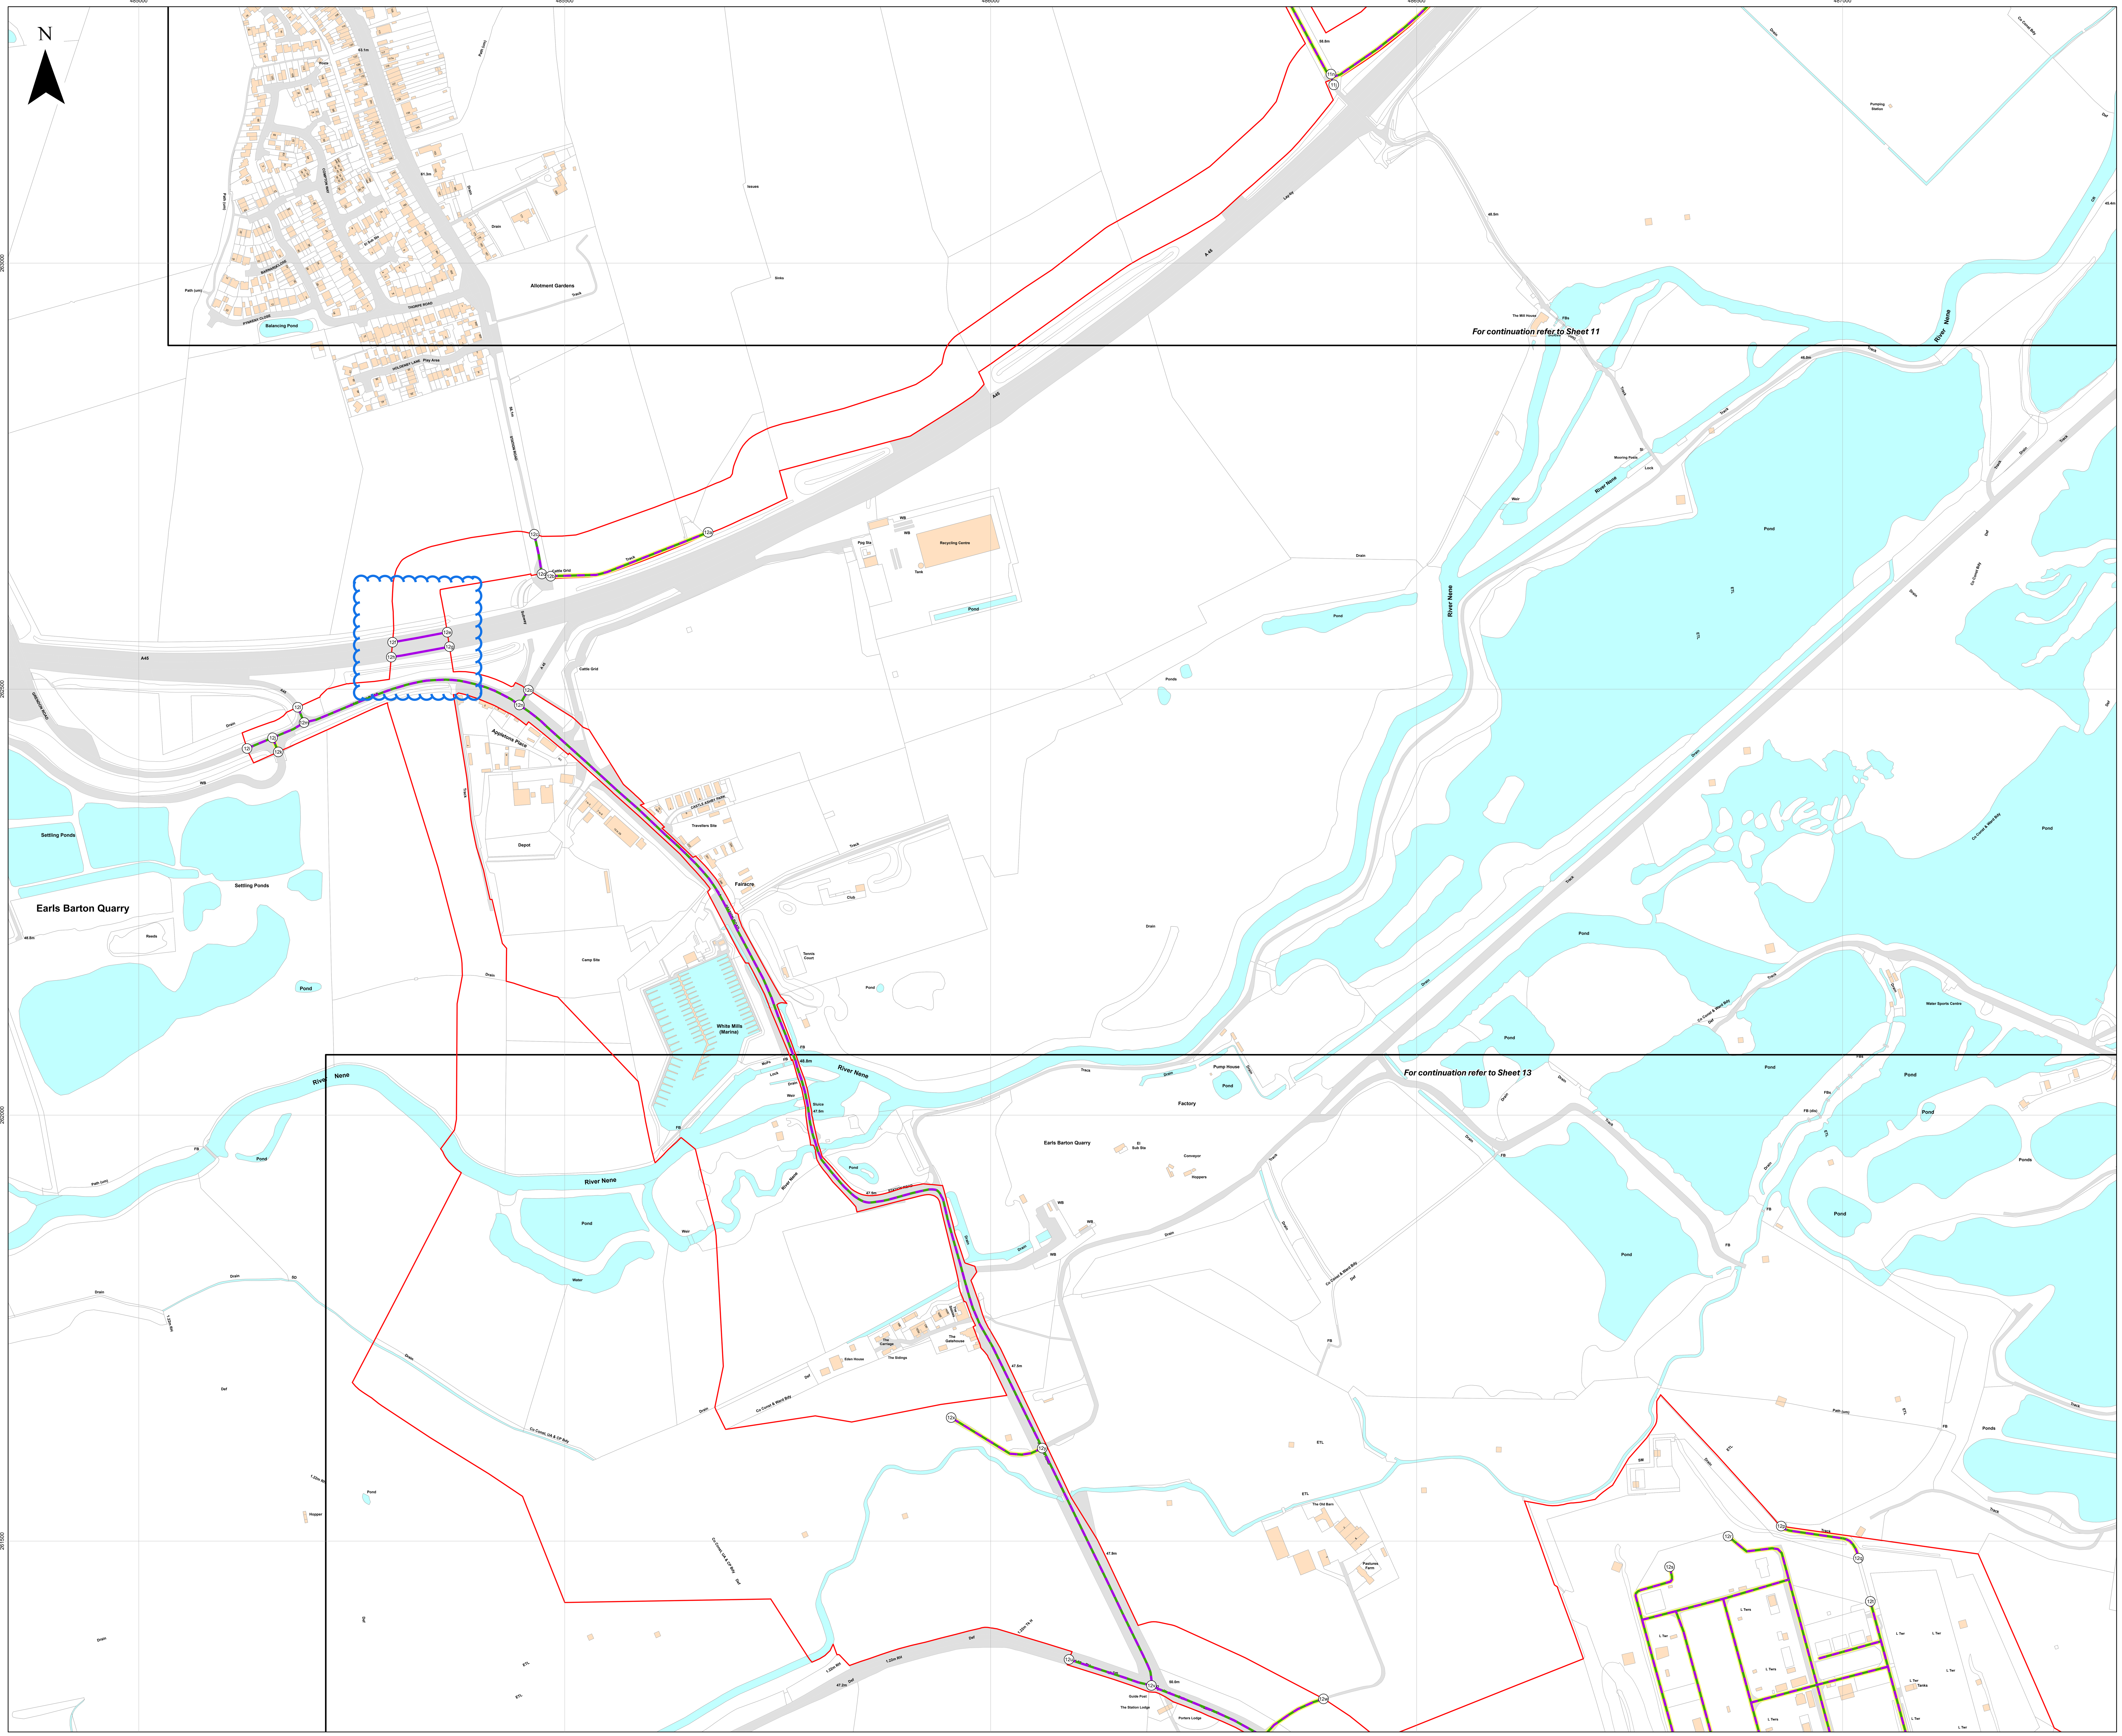

Key

- Order Limits
- Sheet Index
- Reference point within schedule
- Private street with use temporarily suspended or restricted
- Private access and street works / Private access subject to traffic regulation measures
- Street with use temporarily suspended or restricted
- Street works / Street subject to traffic regulation measures

Layers: Lanpro, 2025; IGP, 2025
Base map: Reproduced from Ordnance Survey digital map data © Crown copyright 2025. All rights reserved. License number 0100031673

0 100 200 300 Meters

Scale: 1:2,500@ A0

APFP Regulation: 5(2)(j)	Application Doc No. EX3/GH2.5_C
Ref: P3535_LPR_ZZ_XX_DR_Z_0281	Date: 15/12/2025
Drawn by: BH	Checked by: JC

Streets Plan

Sheet 12 of 18
Revision C

GREEN HILL SOLAR FARM

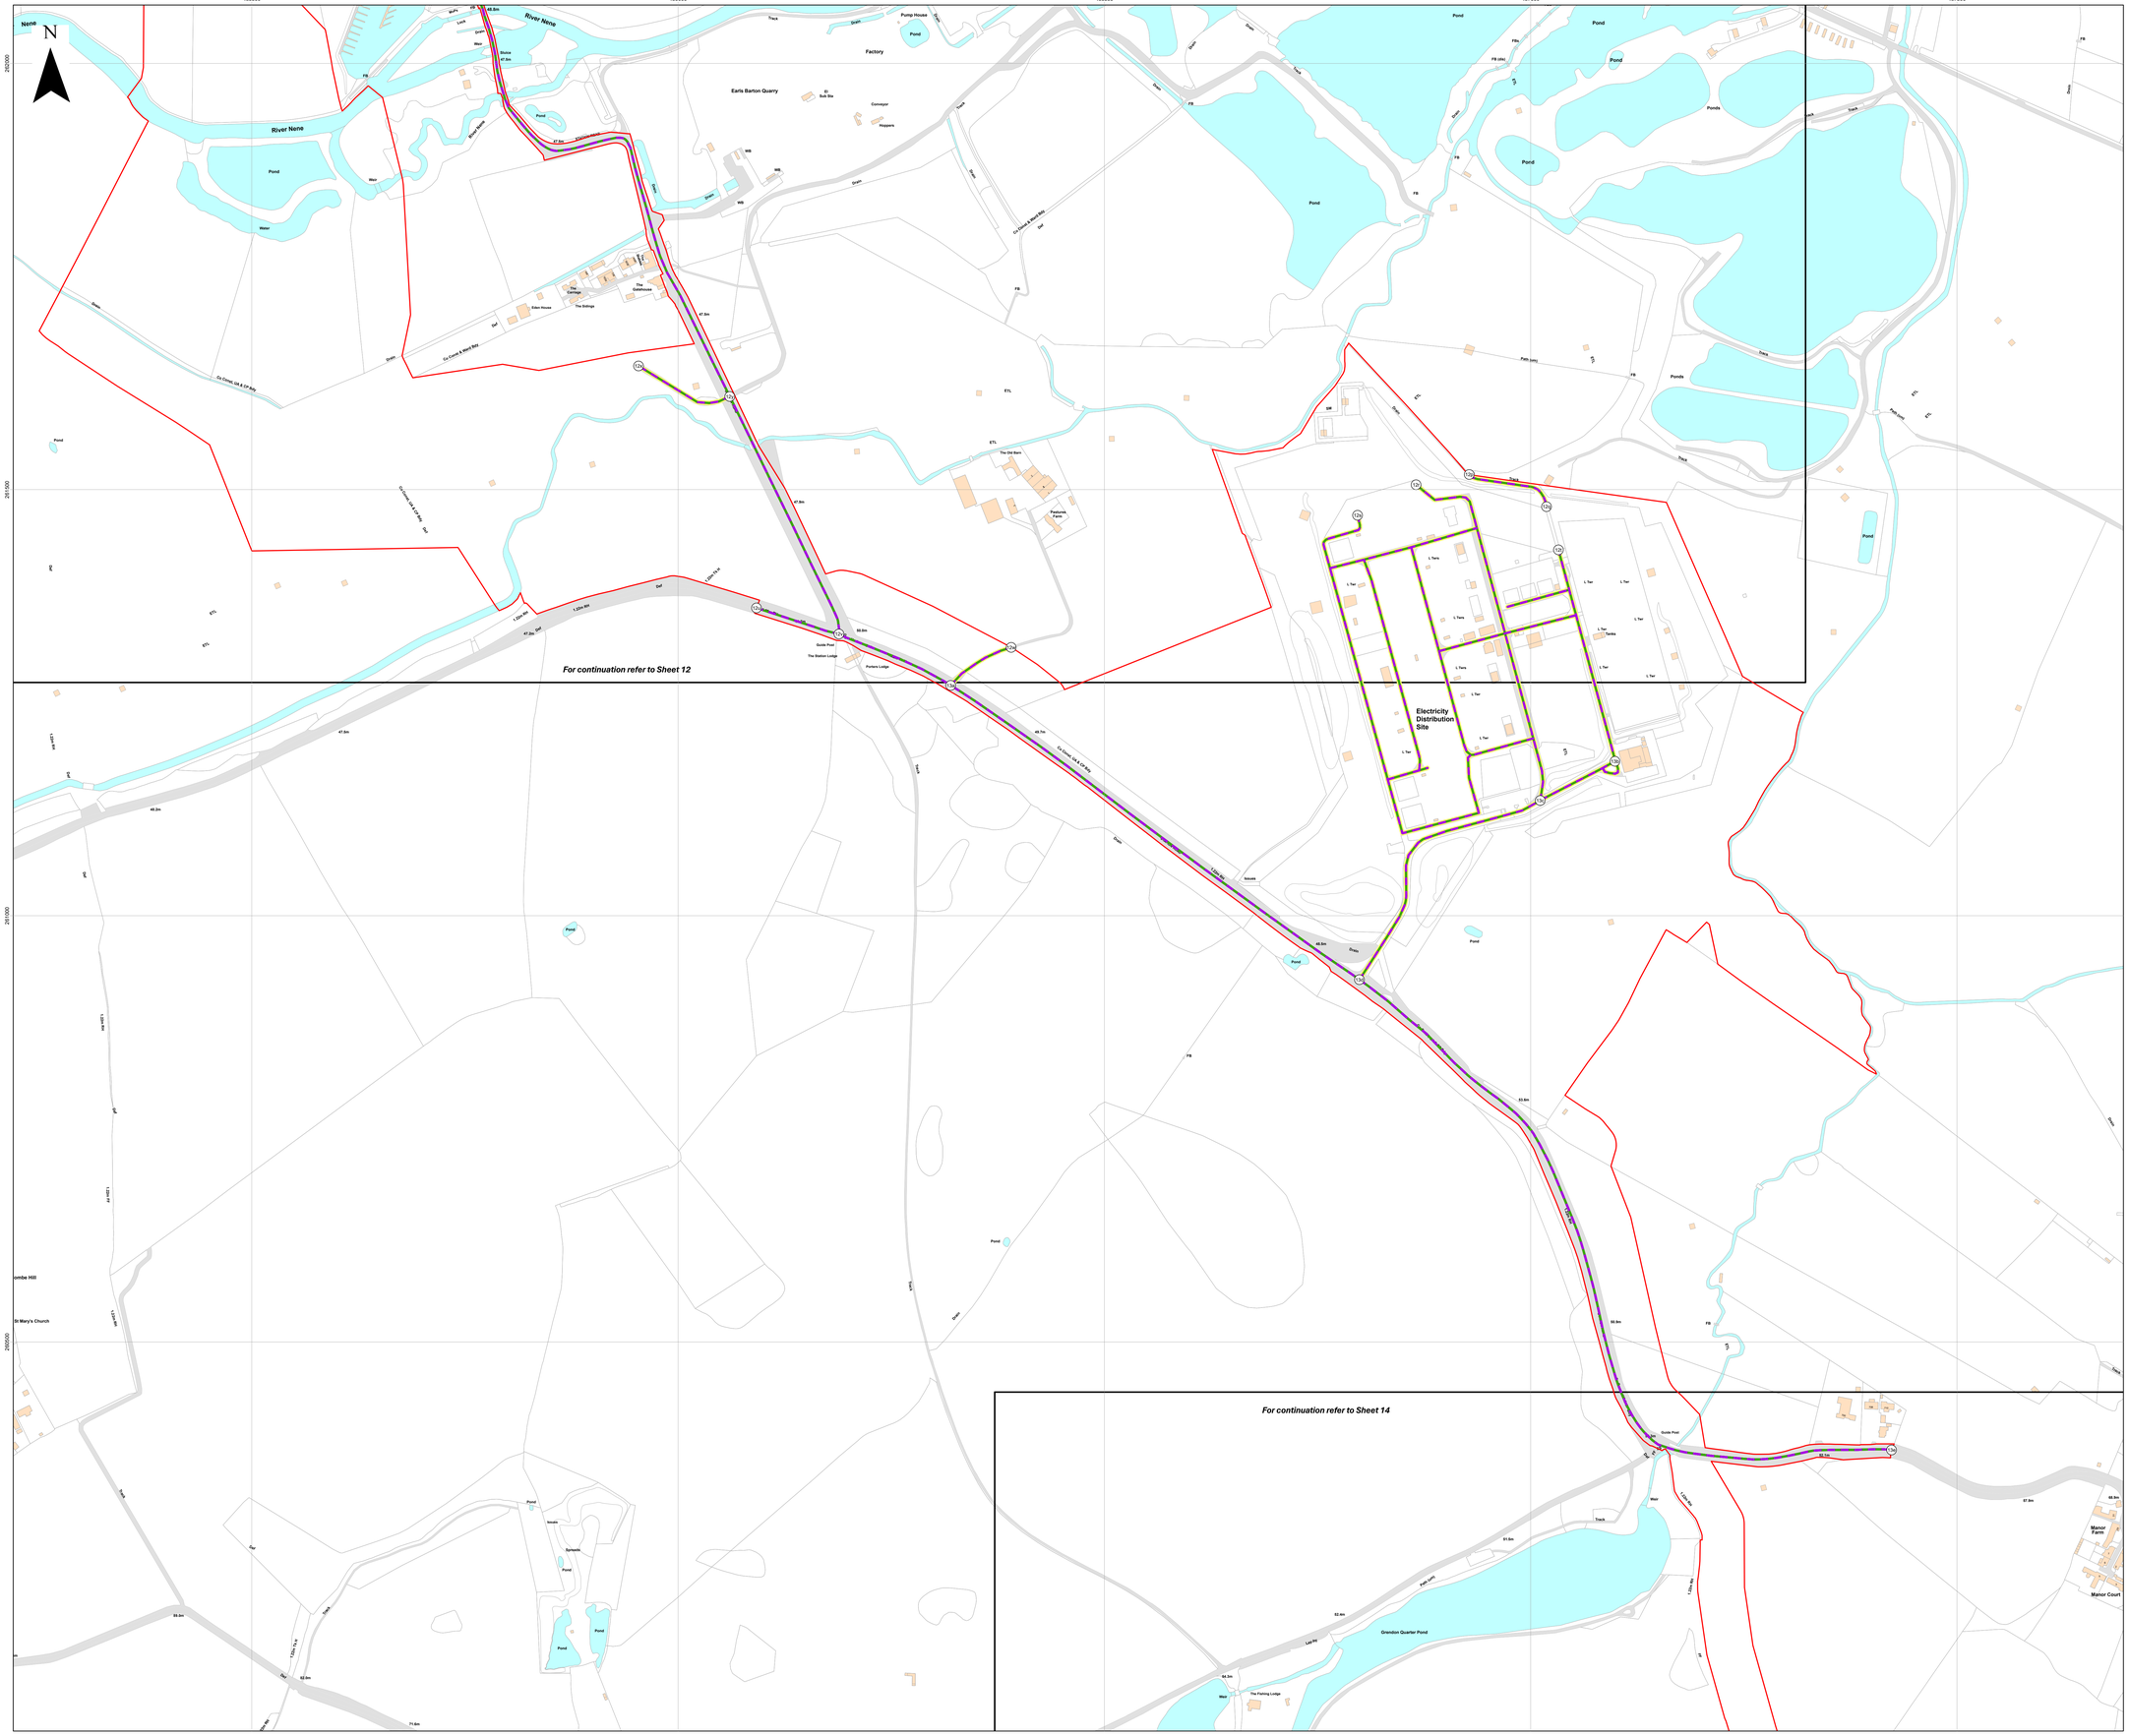

Island GREEN POWER

Lanpro

Key

- Order Limits
- Sheet Index
- Reference point within schedule
- Private street with use temporarily suspended or restricted
- Private access and street works / Private access subject to traffic regulation measures
- Street with use temporarily suspended or restricted
- Street works / Street subject to traffic regulation measures

Layers: Lanpro, 2025; IGP, 2025

Base map: Reproduced from Ordnance Survey digital map data © Crown copyright 2025. All rights reserved. License number 0100031673

0 100 200 300 Meters

Scale: 1:2,500@ A0

APFP Regulation: 5(2)(j)	Application Doc No. EX3/GH2.5_C
Ref: P3535_LPR_ZZ_XX_DR_Z_0281	Date: 15/12/2025
Drawn by: BH	Checked by: JC

Streets Plan

Sheet 13 of 18

Revision C

GREEN HILL SOLAR FARM

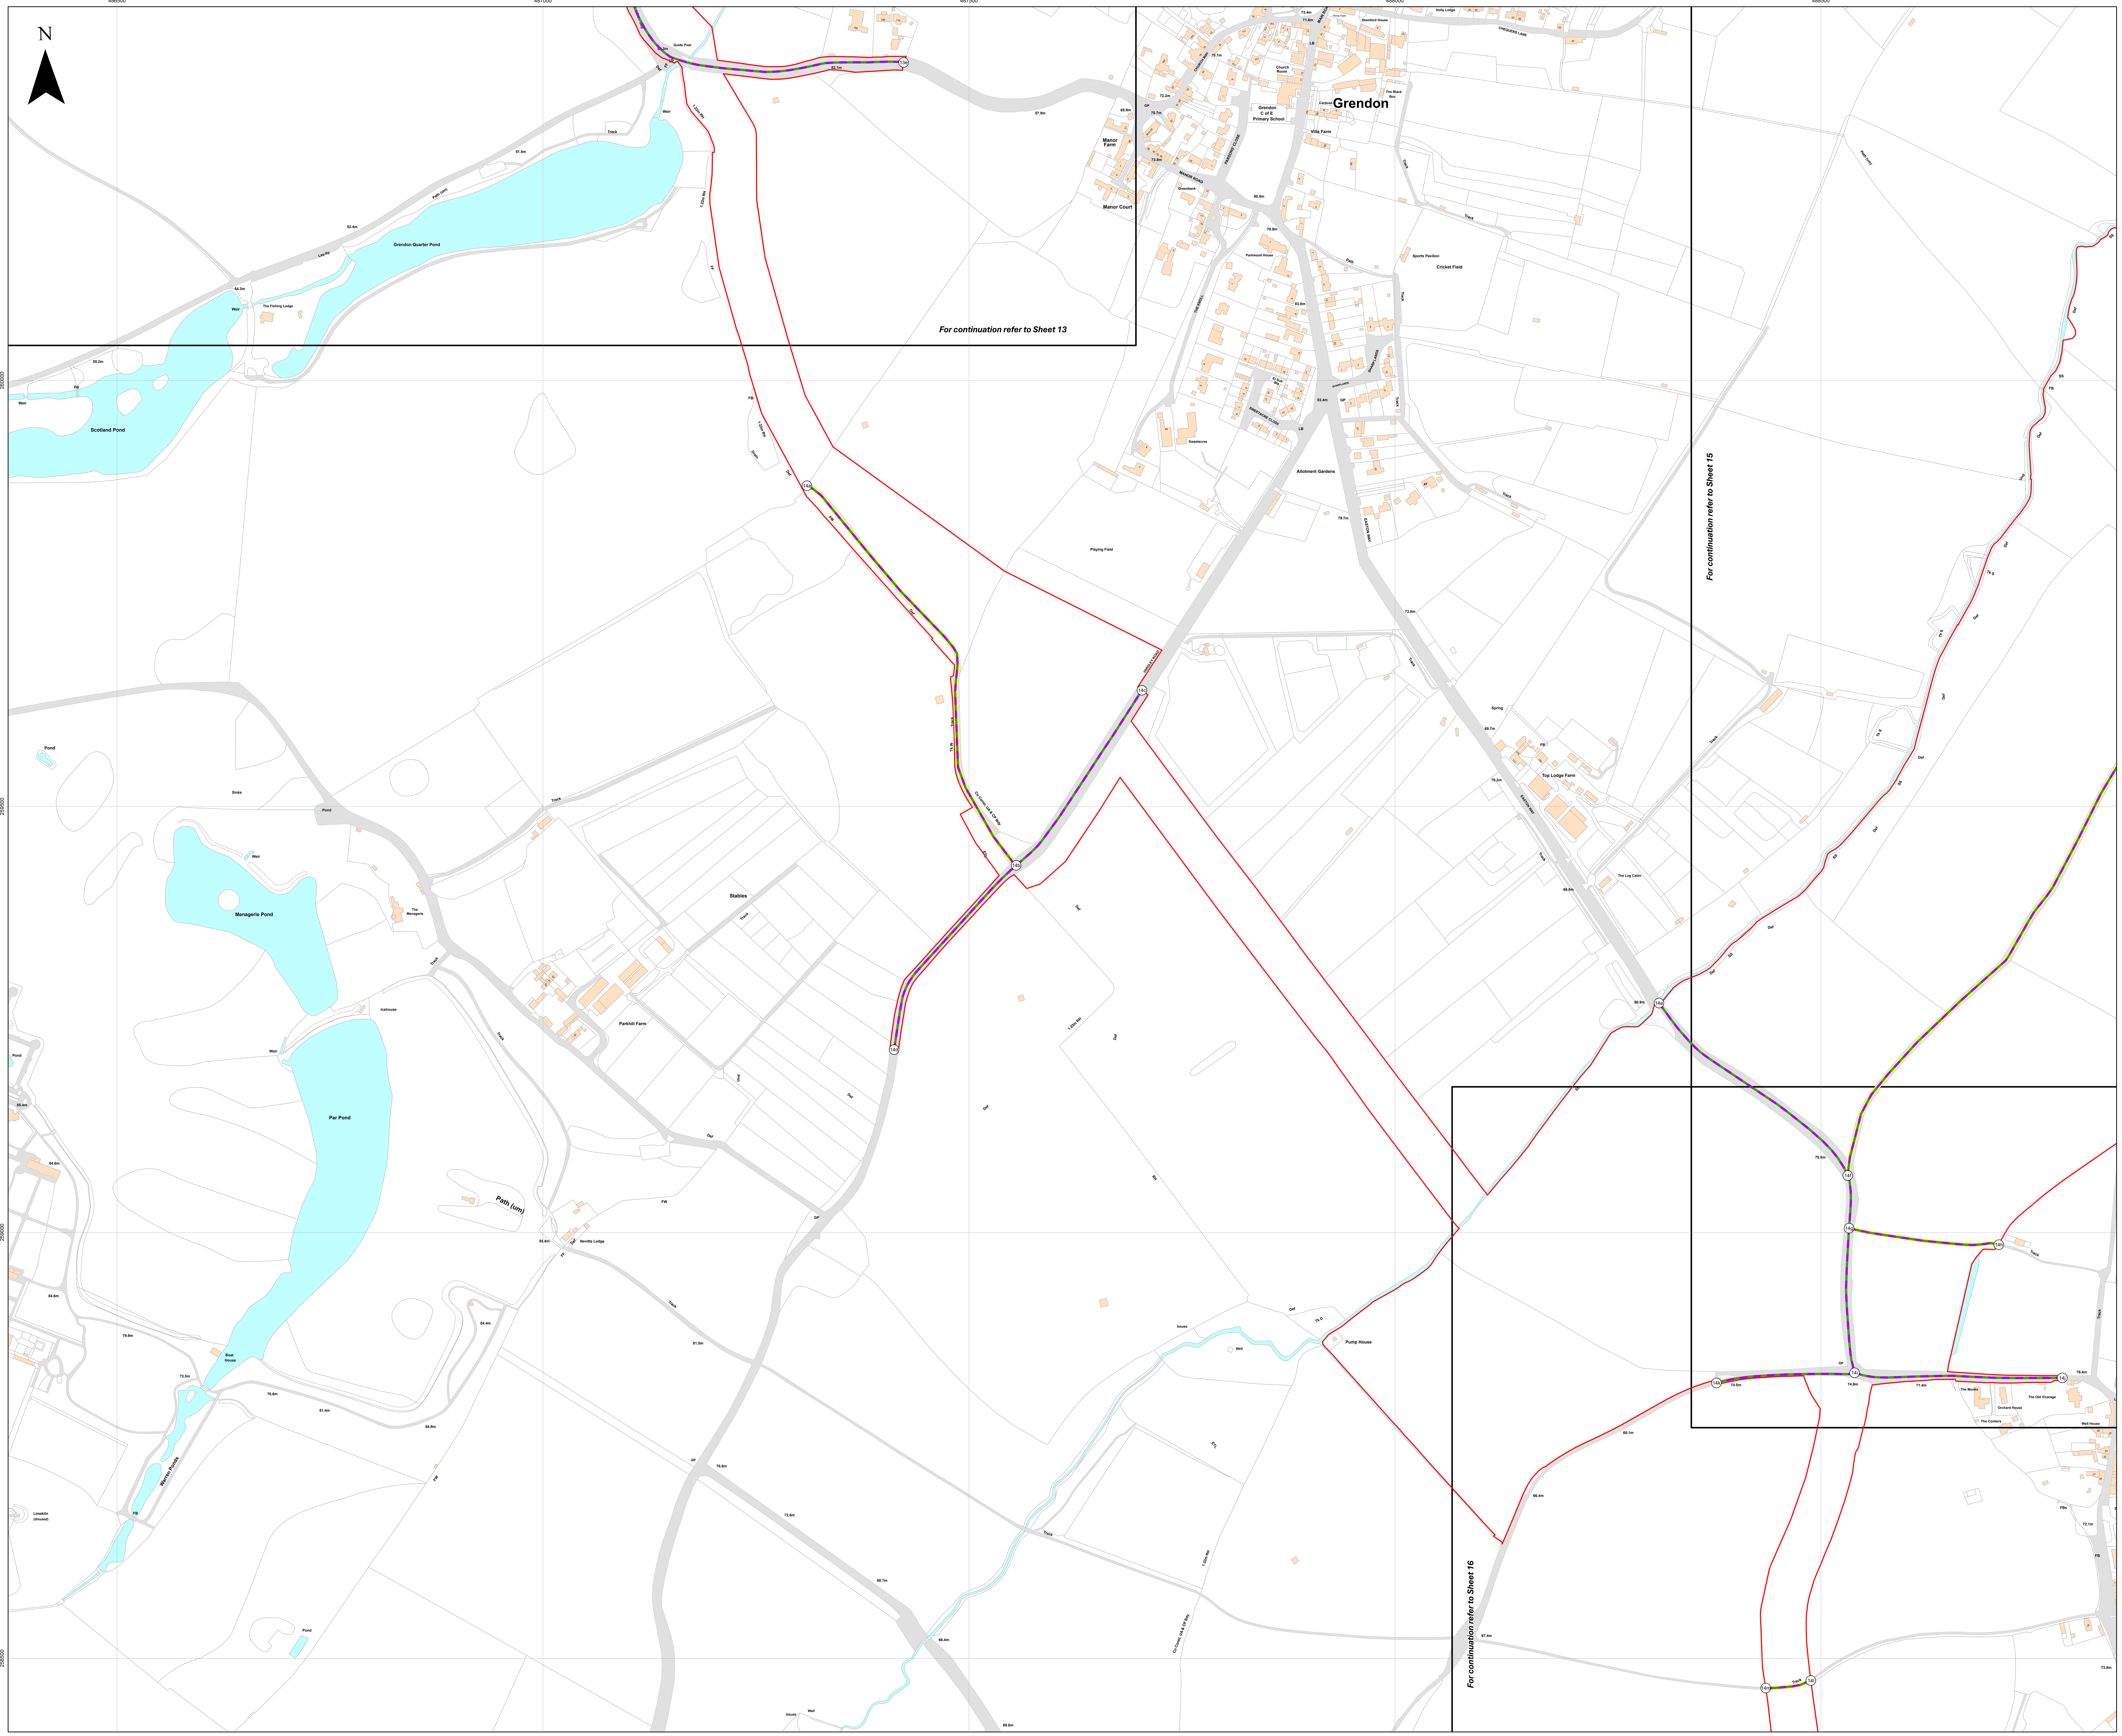

Key

- Order Limits
- Sheet Index
- Reference point within schedule
- Private street with use temporarily suspended or restricted
- Private access and street works / Private access subject to traffic regulation measures
- Street with use temporarily suspended or restricted
- Street works / Street subject to traffic regulation measures

Layers: Lanpro, 2025; IGP, 2025
Base map: Reproduced from Ordnance Survey digital map data © Crown copyright 2025. All rights reserved. License number 0100031673

0 100 200 300 Meters

Scale: 1:2,500@ A0

APFP Regulation: 5(2)(j)	Application Doc No. EX3/GH2.5_C
Ref: P3535_LPR_ZZ_XX_DR_Z_0281	Date: 15/12/2025
Drawn by: BH	Checked by: JC

Streets Plan
Sheet 14 of 18
Revision C

GREEN HILL SOLAR FARM

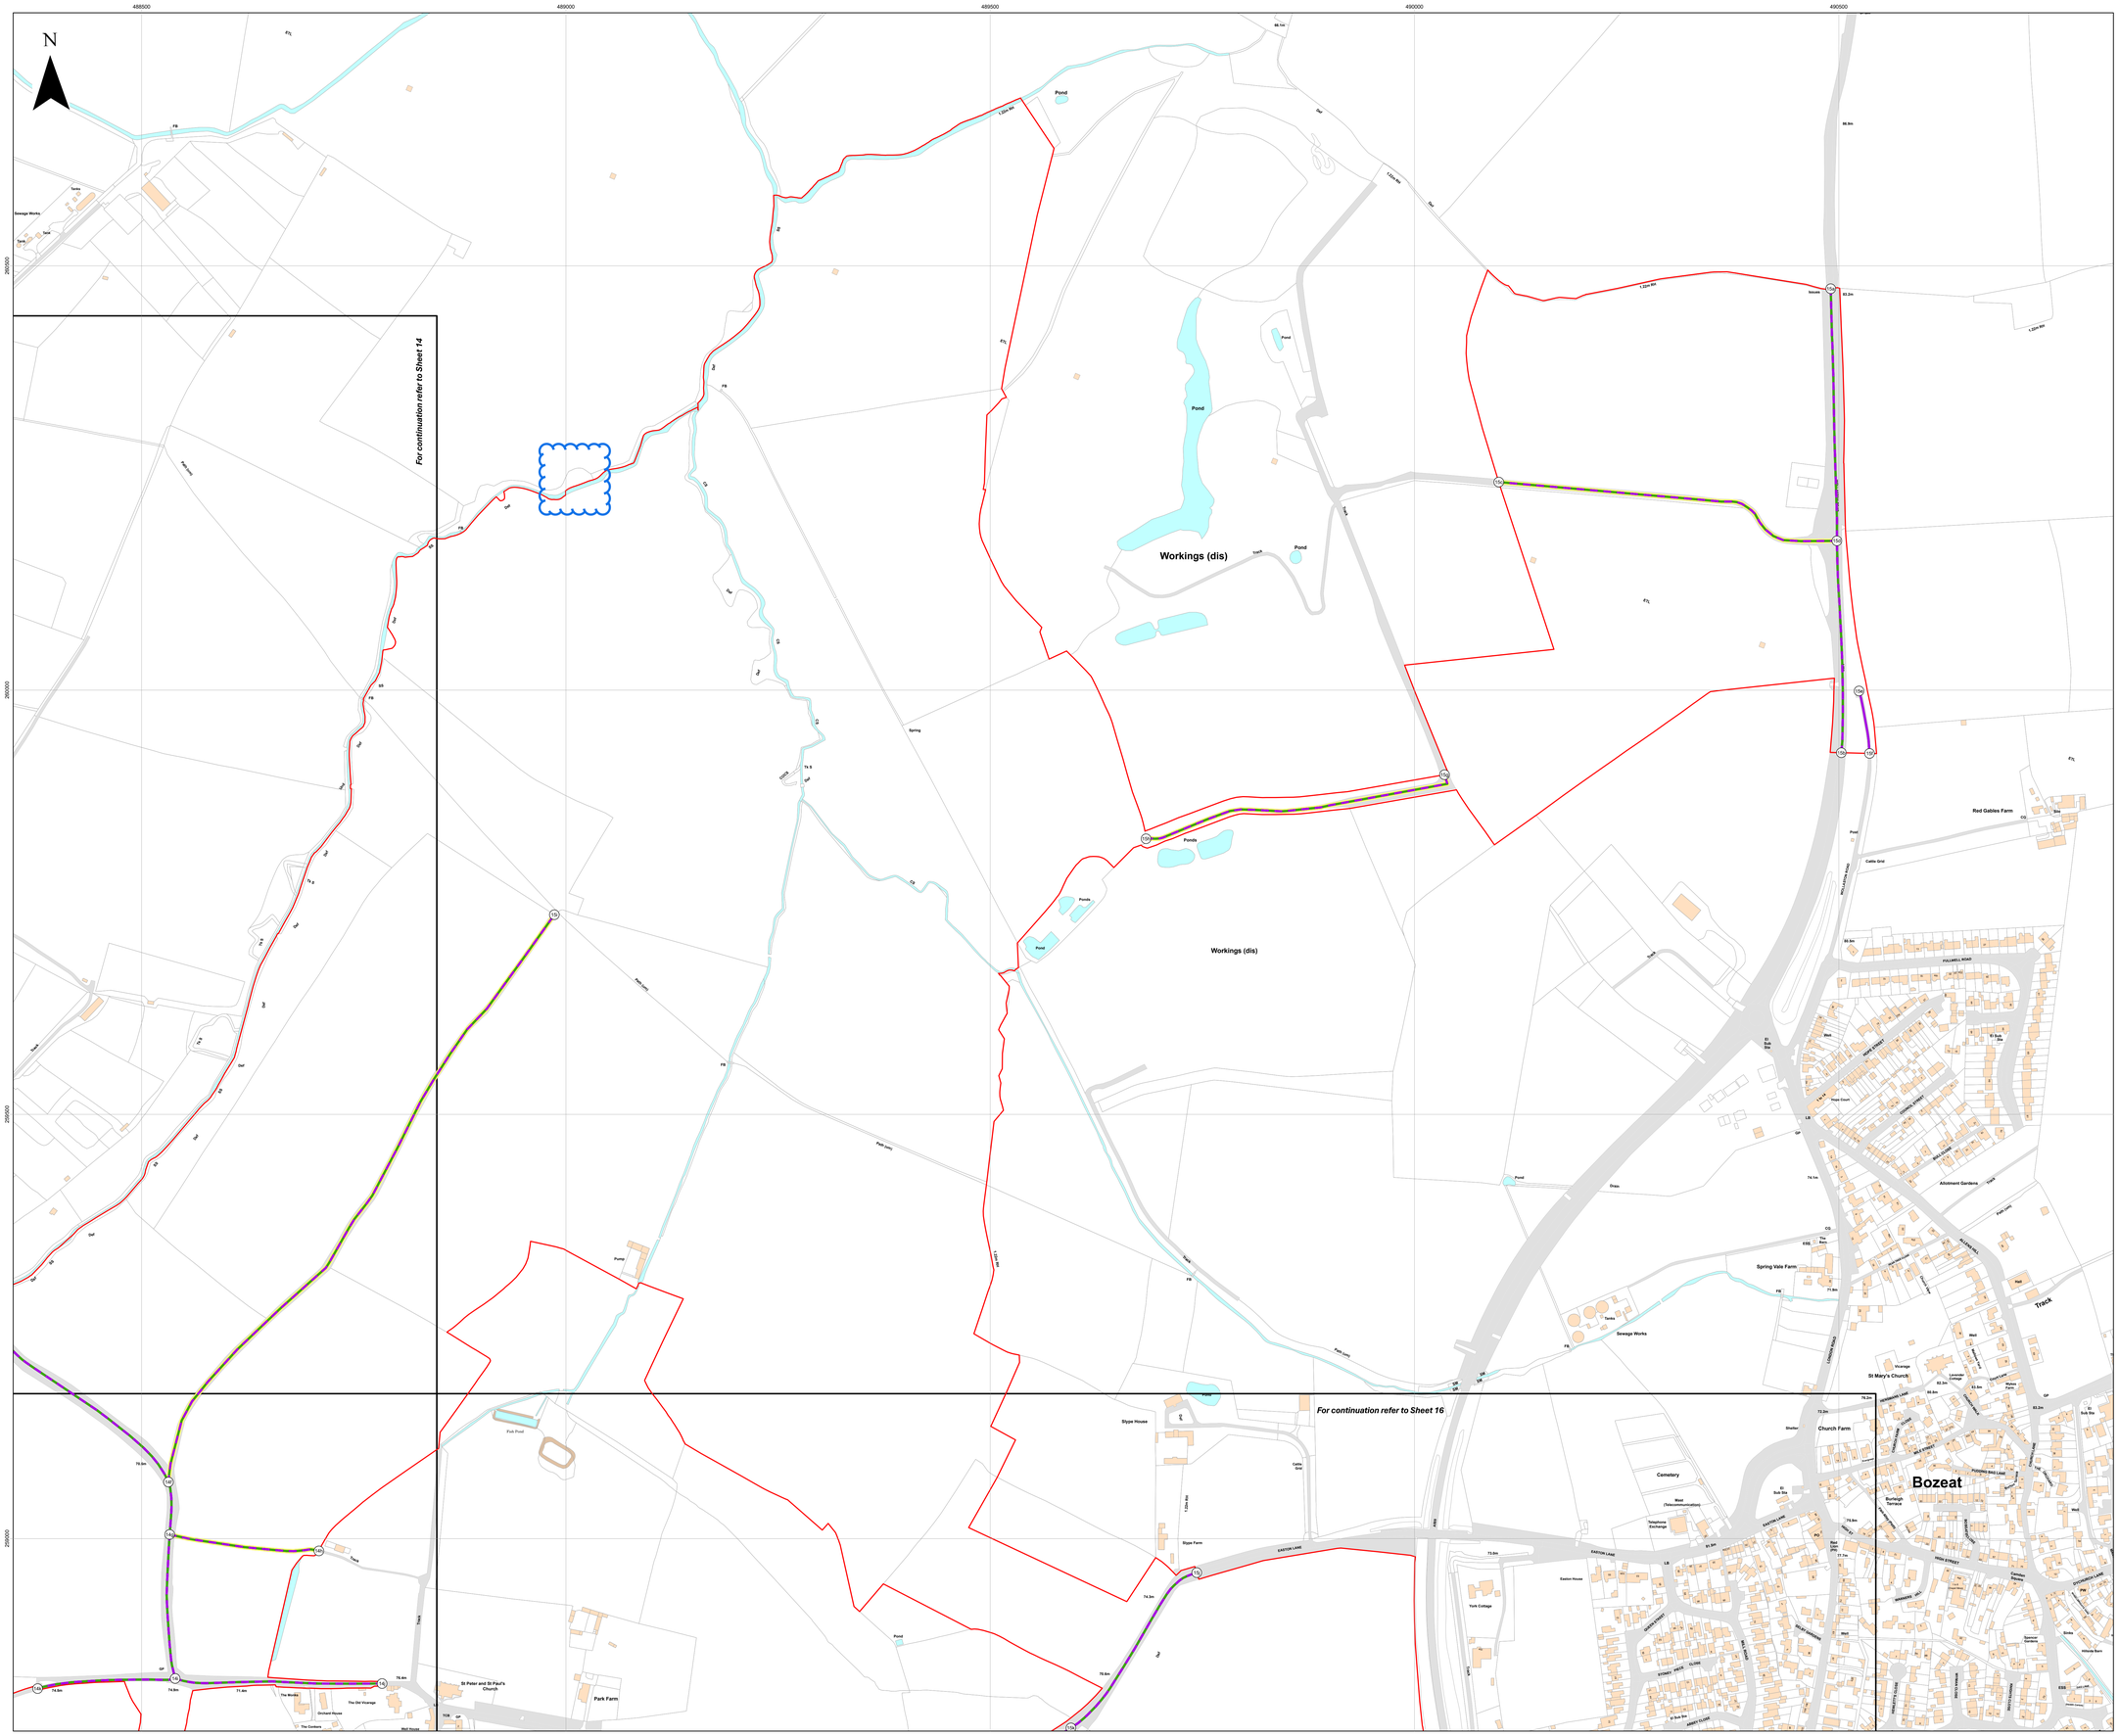
488500
489000
489500
490000
490500
N
Key
Order Limits
Sheet Index
Reference point within schedule
Private street with use temporarily suspended or restricted
Private access and street works / Private access subject to traffic regulation measures
Street with use temporarily suspended or restricted
Street works / Street subject to traffic regulation measures
For continuation refer to Sheet 14
For continuation refer to Sheet 16
Workings (dis)
Pond
Ponds
Spring
Track
Bozeat
Church Farm
Spring Vale Farm
Red Gables Farm
Slype House
Slype Farm
Park Farm
St Peter and St Paul's Church
St Mary's Church
Cemetery
Sewage Works
Cattle Grid
Pump
Park Pond
EASTON LANE
HIGH STREET
PULLABELL ROAD
Layers: Langros, 2025; IGP, 2025
Base map: Reproduced from Ordnance Survey digital map data © Crown copyright 2025. All rights reserved. License number 0100031673
0
100
200
300 Meters
Scale: 1:2,500@ A0
APFP Regulation: 5(2)(j)
Application Doc No. EX3/GH2.5_C
Ref: P3535_LPR_ZZ_XX_DR_Z_0281
Date: 15/12/2025
Drawn by: BH
Checked by: JC
Streets Plan
Sheet 15 of 18
Revision C
GREEN HILL SOLAR FARM

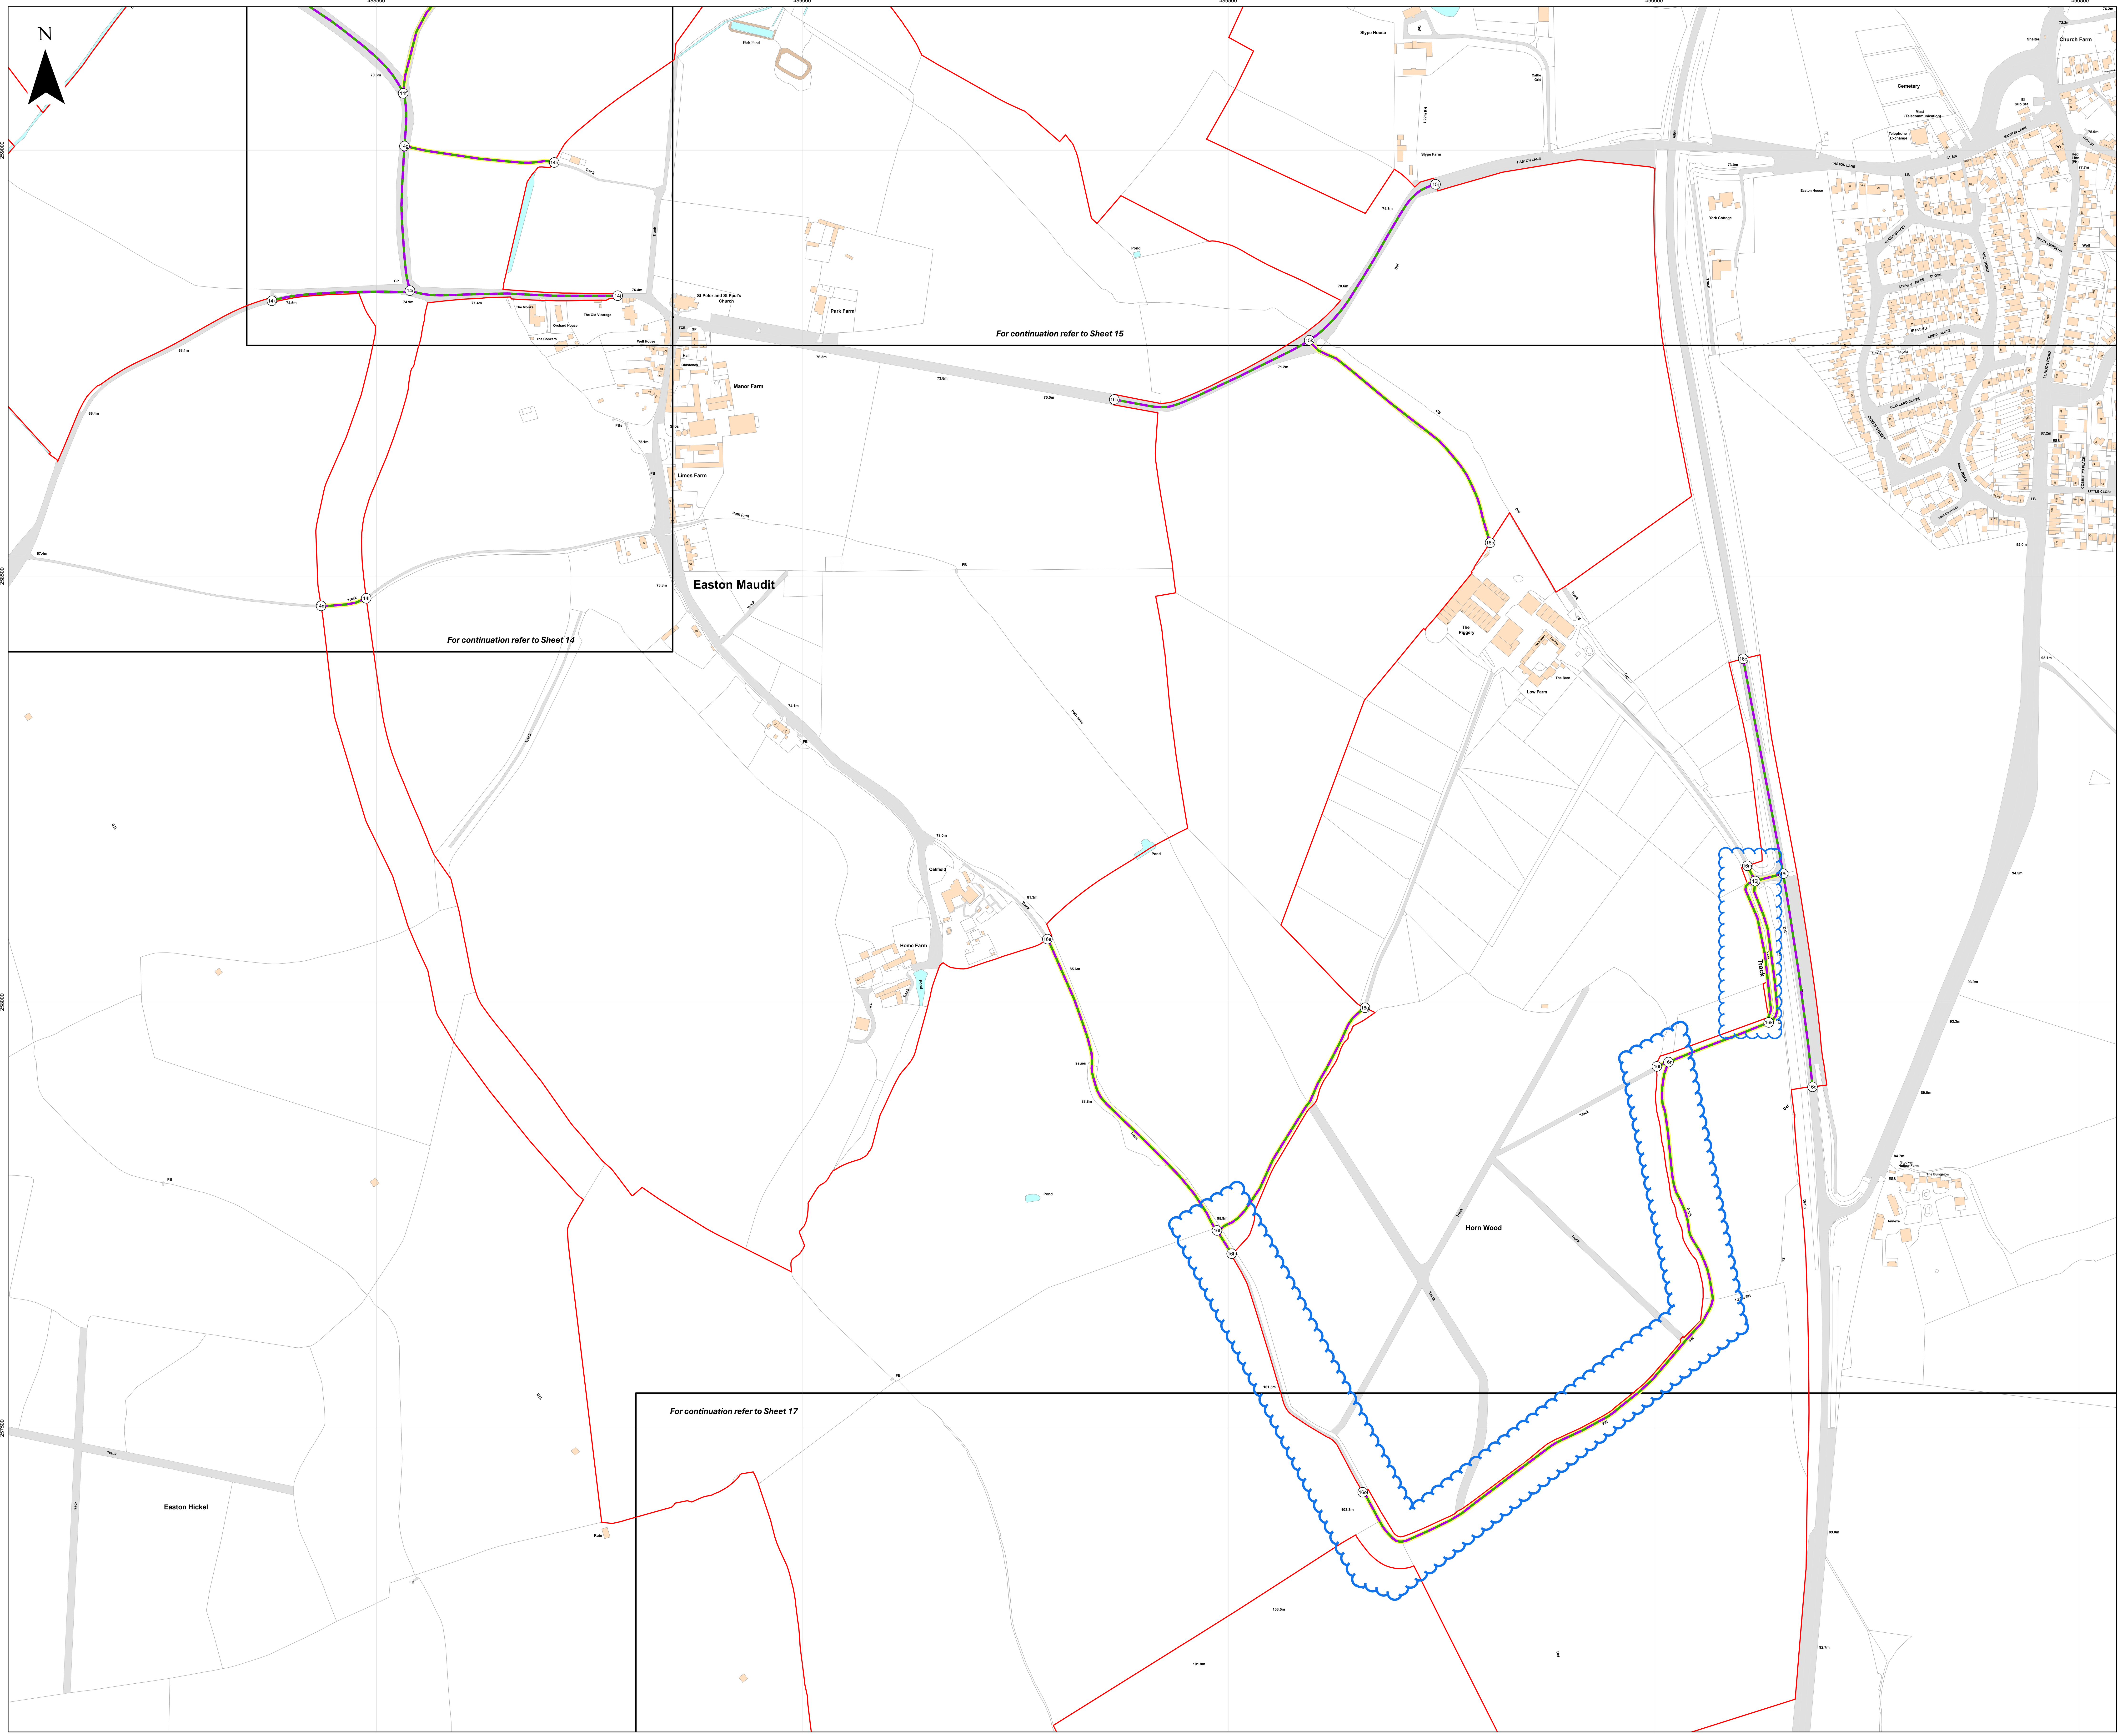

Island GREEN POWER

Lanpro

Key

- Order Limits
- Sheet Index
- Reference point within schedule
- Private street with use temporarily suspended or restricted
- Private access and street works / Private access subject to traffic regulation measures
- Street with use temporarily suspended or restricted
- Street works / Street subject to traffic regulation measures

Layers: Lanpro, 2025; IGP, 2025
Base map: Reproduced from Ordnance Survey digital map data © Crown copyright 2025. All rights reserved. License number 0100031673

0 100 200 300 Meters

Scale: 1:2,500@ A0

APFP Regulation: 5(2)(j)	Application Doc No. EX3/GH2.5_C
Ref: P3535_LPR_ZZ_XX_DR_Z_0281	Date: 15/12/2025
Drawn by: BH	Checked by: JC

Streets Plan
Sheet 16 of 18
Revision C

GREEN HILL SOLAR FARM

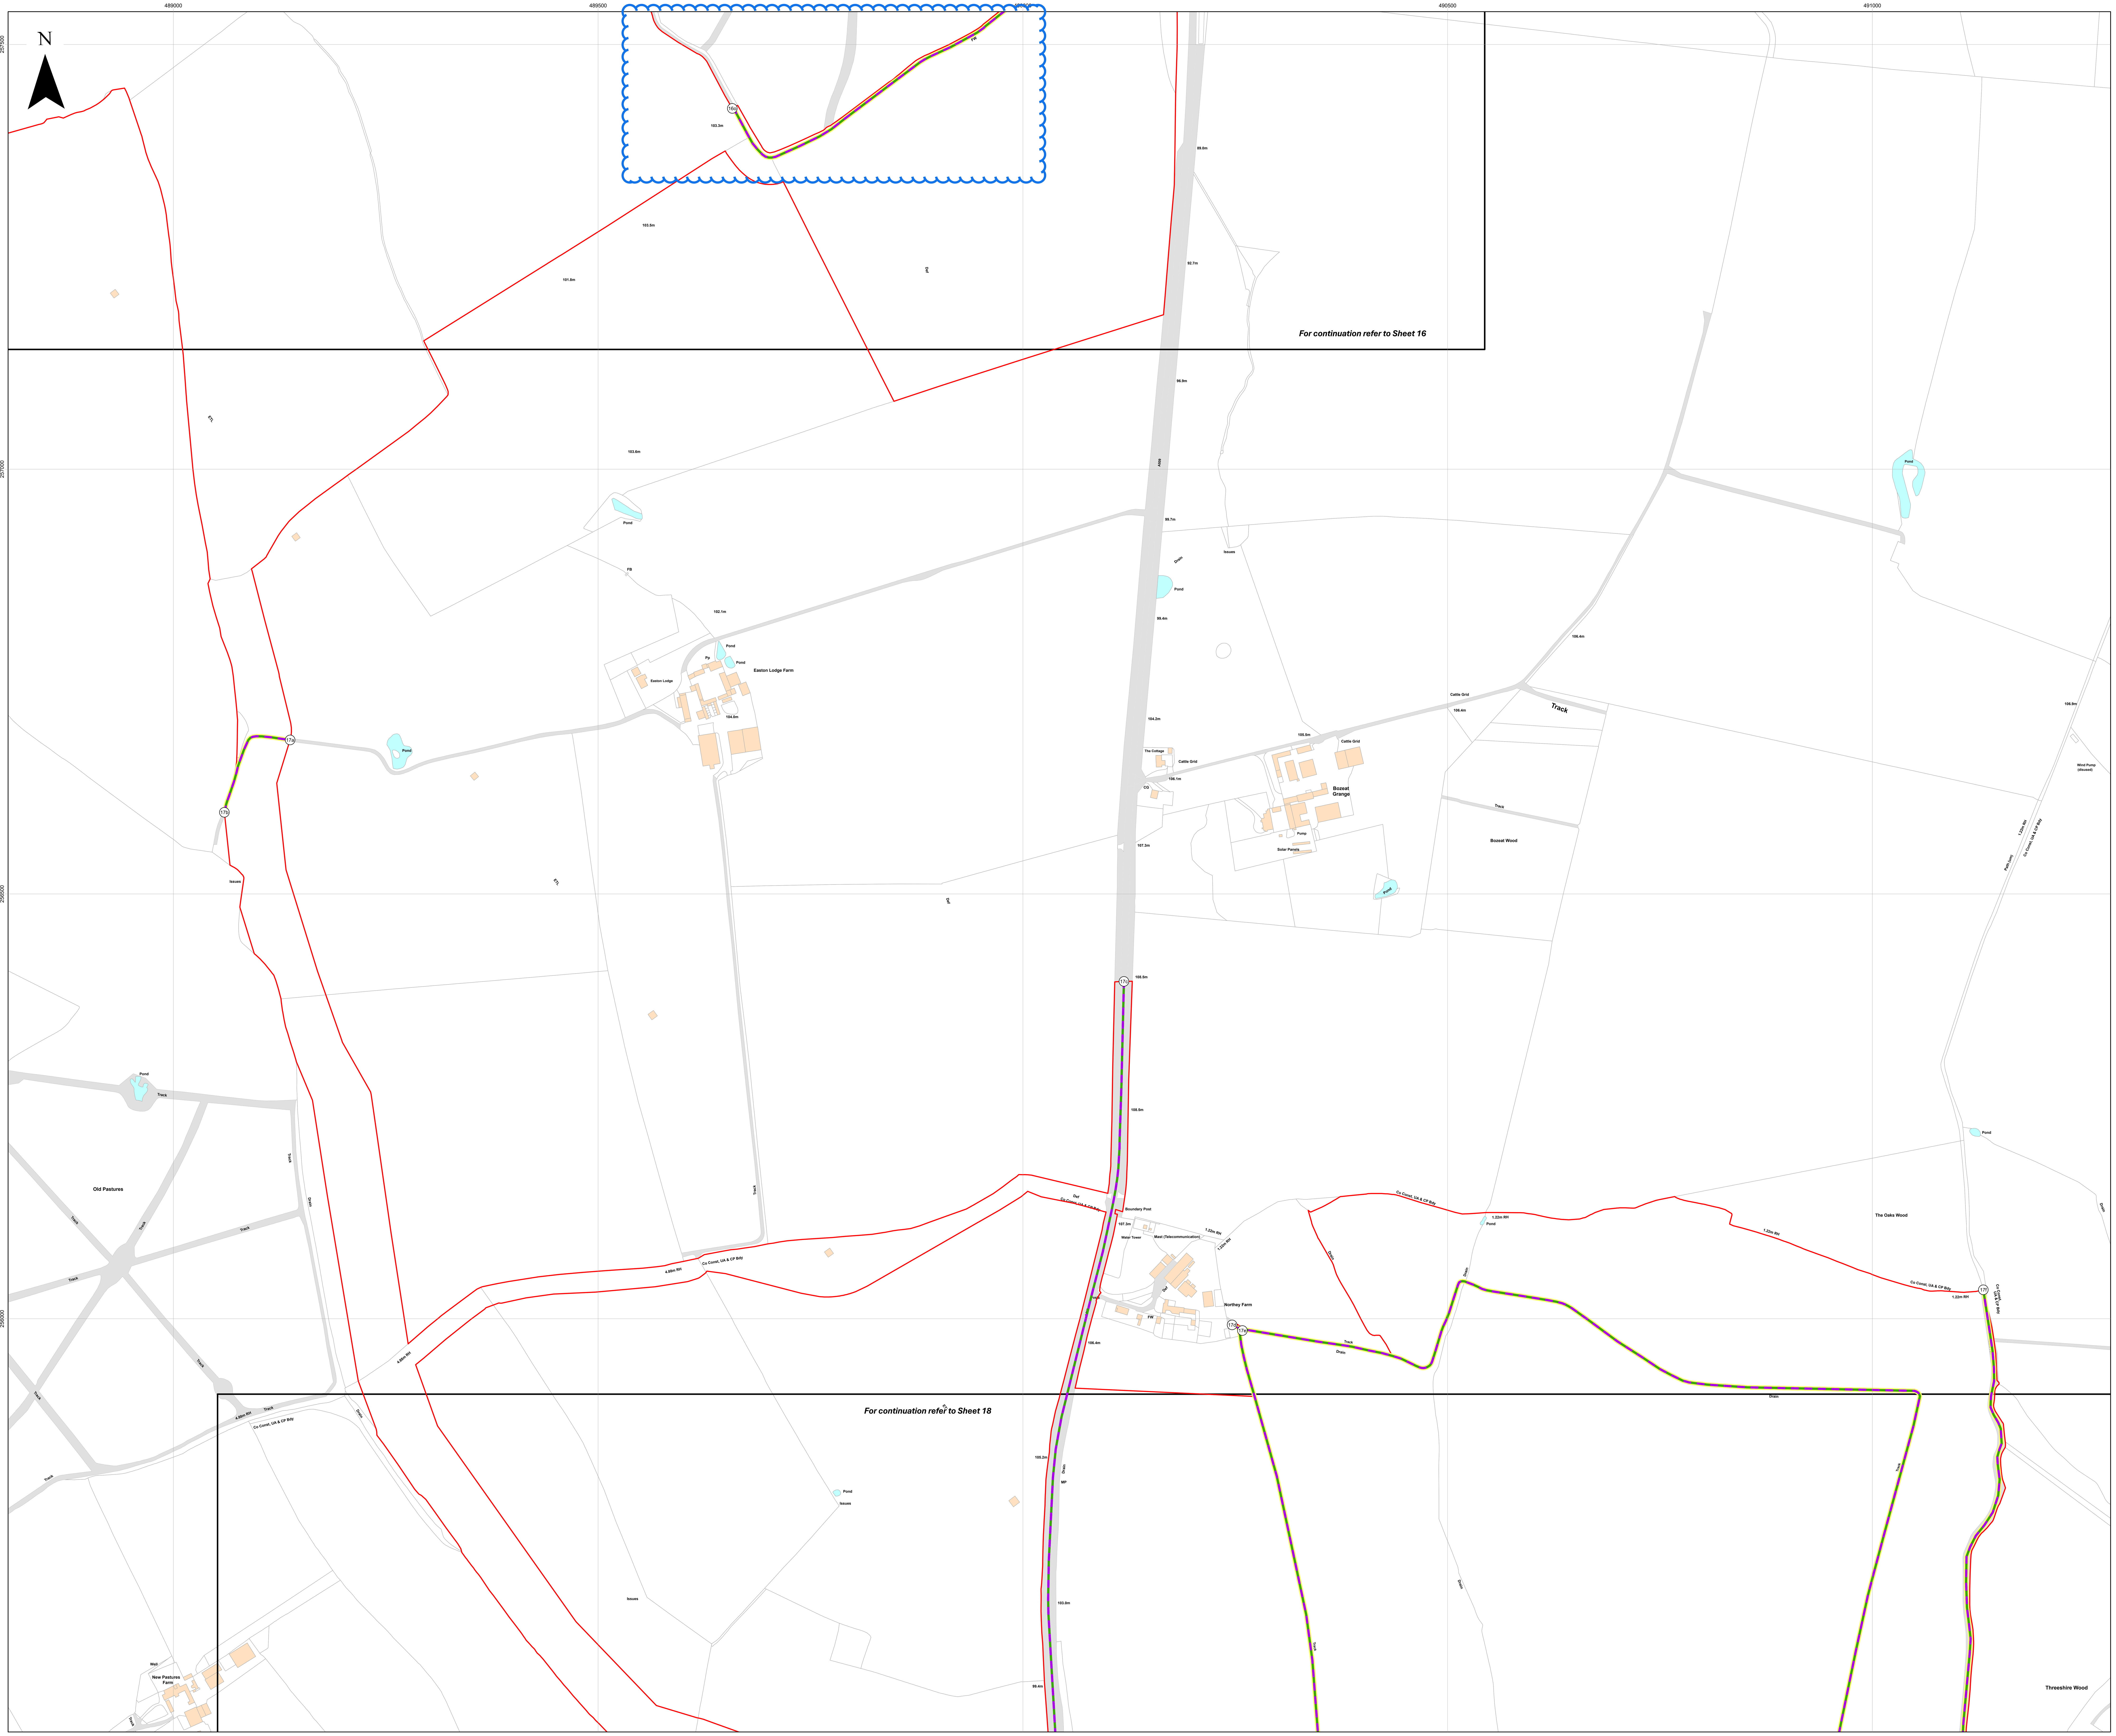

Island GREEN POWER

Lanpro

Key

- Order Limits
- Sheet Index
- Reference point within schedule
- Private street with use temporarily suspended or restricted
- Private access and street works / Private access subject to traffic regulation measures
- Street works / Street subject to traffic regulation measures

Layers: Lanpro, 2025; IGP, 2025
Base map: Reproduced from Ordnance Survey digital map data © Crown copyright 2025. All rights reserved. License number 0100031673

0 100 200 300 Meters

Scale: 1:2,500@ A0

APFP Regulation: 5(2)(j)	Application Doc No. EX3/GH2.5_C
Ref: P3535_LPR_ZZ_XX_DR_Z_0281	Date: 15/12/2025
Drawn by: BH	Checked by: JC

Streets Plan
Sheet 17 of 18
Revision C

GREEN HILL SOLAR FARM

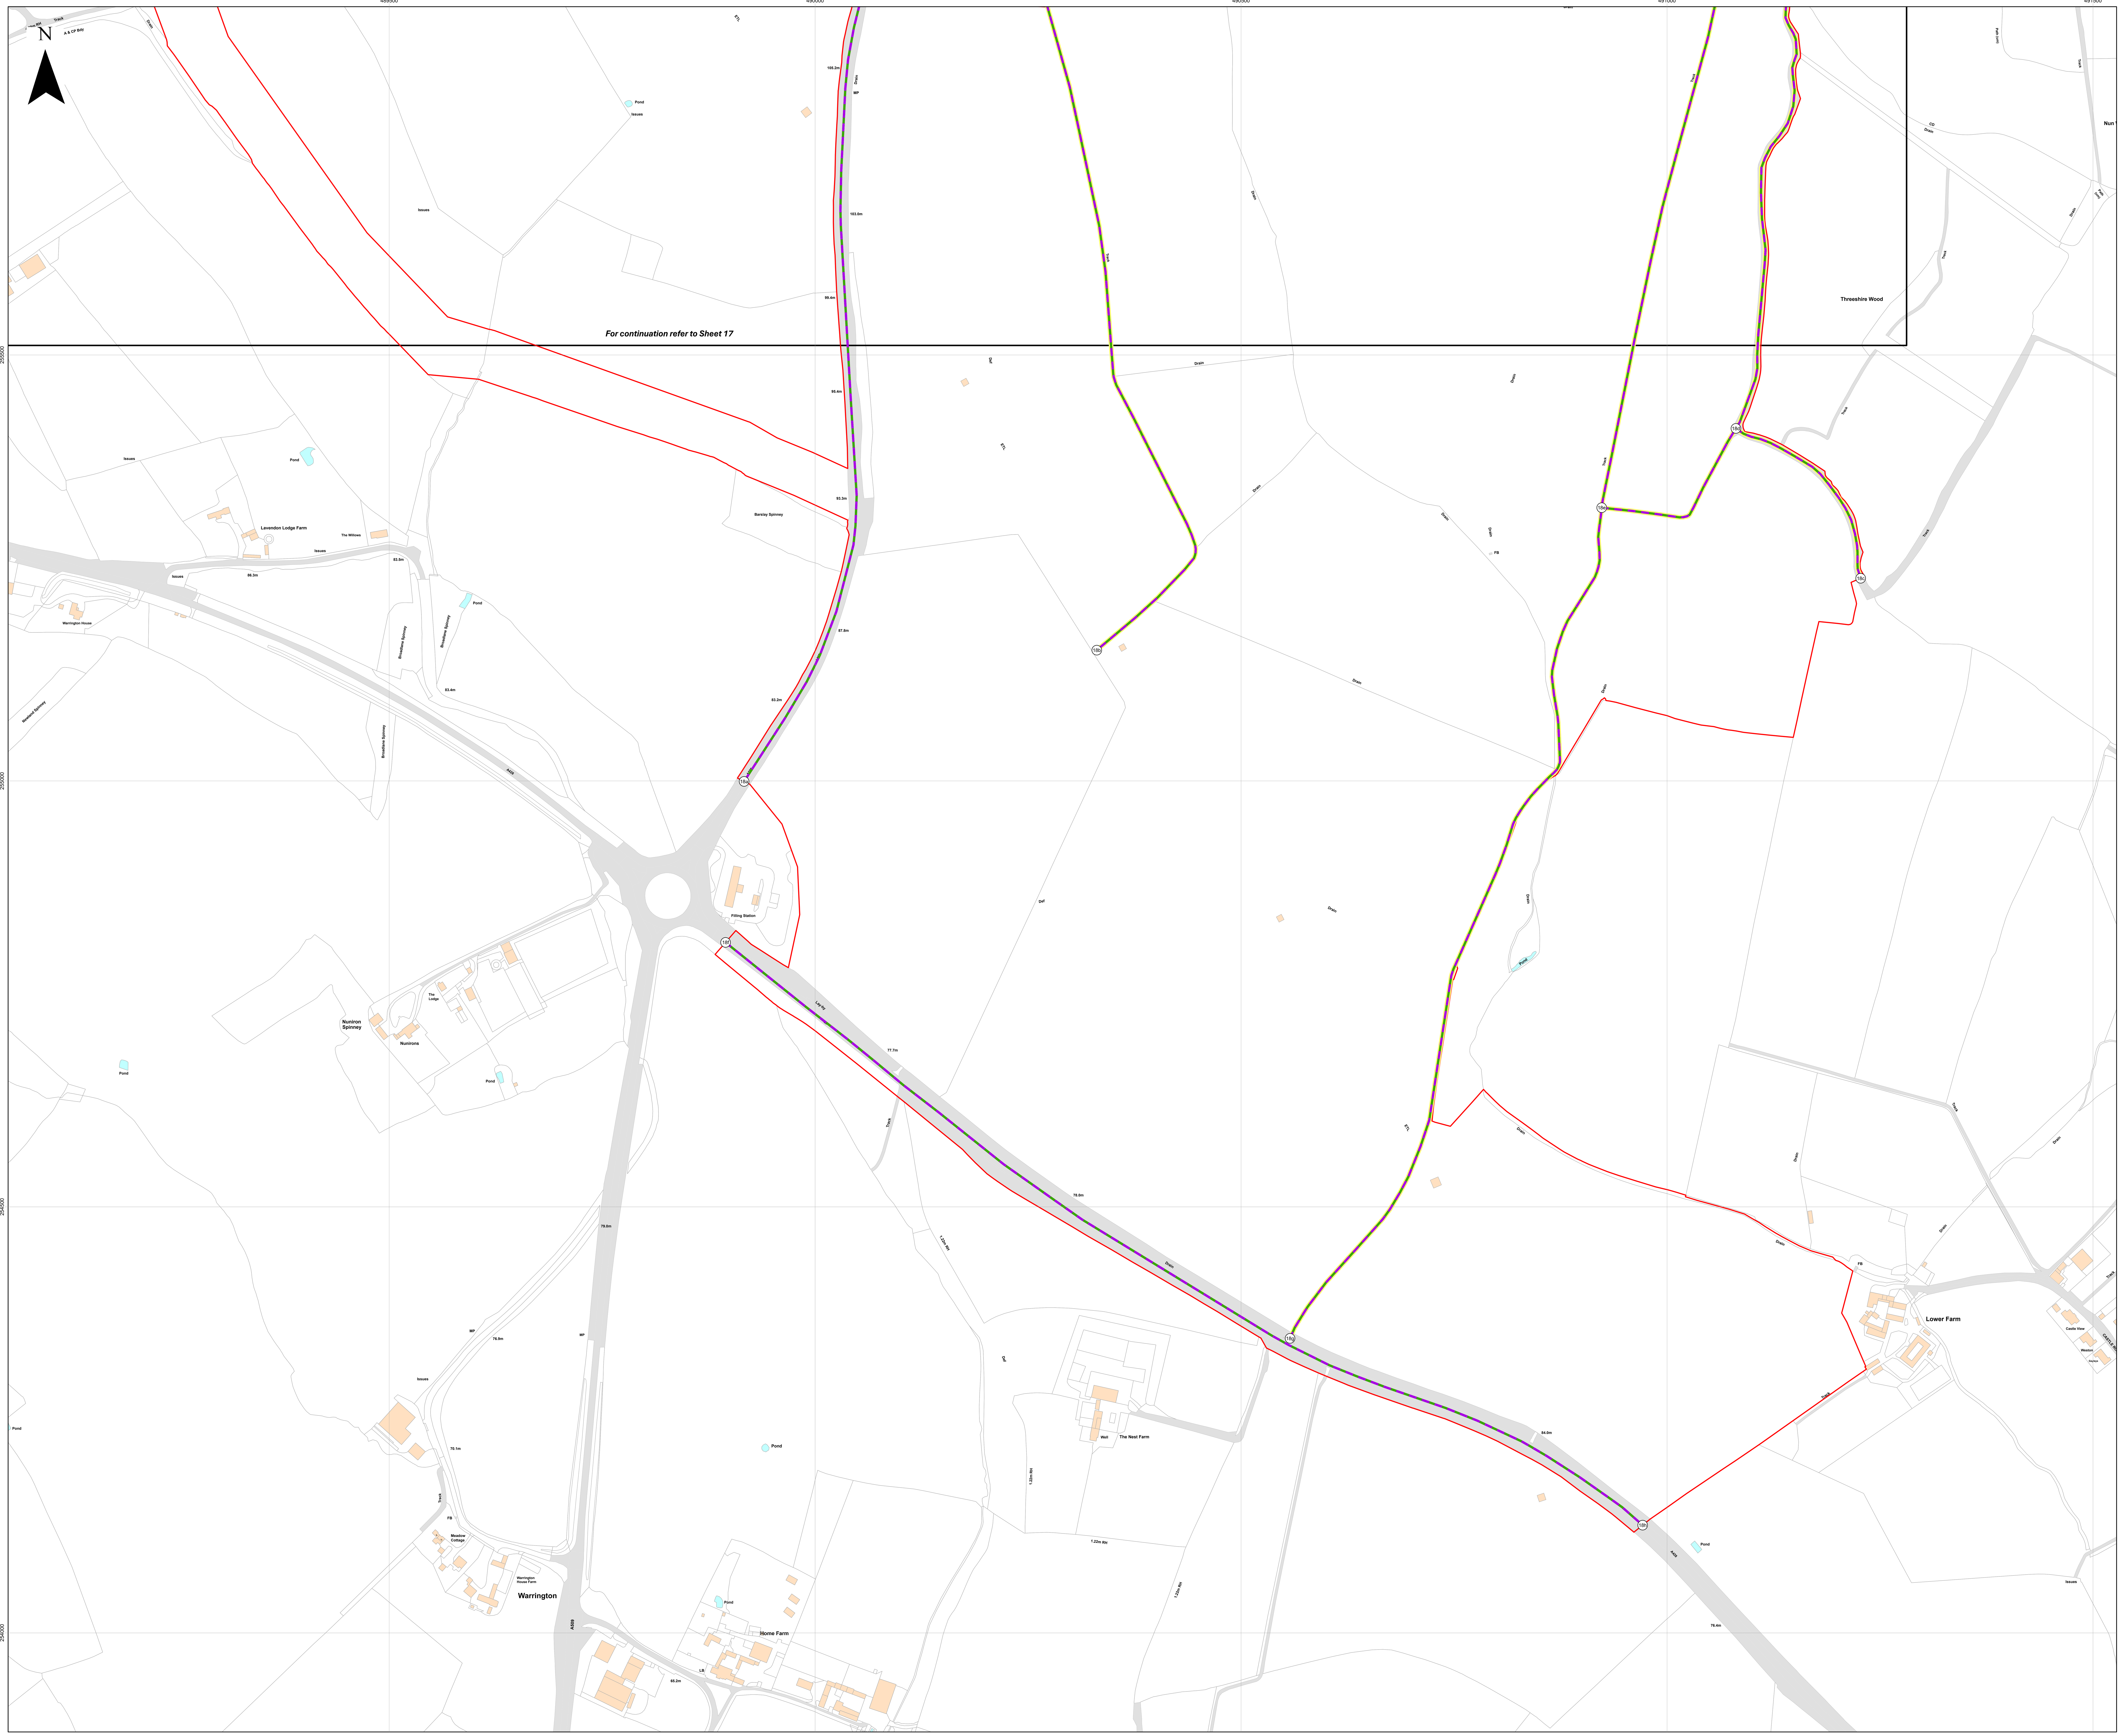

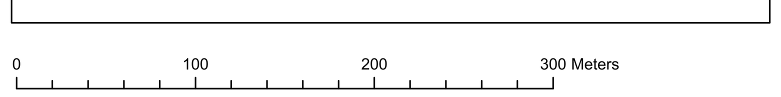

Key

- Order Limits
- Sheet Index
- Reference point within schedule
- Private street with use temporarily suspended or restricted
- Private access and street works / Private access subject to traffic regulation measures
- Street with use temporarily suspended or restricted
- Street works / Street subject to traffic regulation measures

Layers: Lanpro, 2025; IGP, 2025
Base map: Reproduced from Ordnance Survey digital map data © Crown copyright 2025. All rights reserved. License number 0100031673

0 100 200 300 Meters

Scale: 1:2,500@ A0

APFP Regulation: 5(2)(j)	Application Doc No. EX3/GH2.5_C
Ref: P3535_LPR_ZZ_XX_DR_Z_0281	Date: 15/12/2025
Drawn by: BH	Checked by: JC

Streets Plan
Sheet 18 of 18
Revision C