

Green Hill Solar Farm

EN010170

Ecology and Nature Conservation Features Plan

Revision A (Tracked)

Prepared by: Lanpro

Date: ~~May~~ December 2025


Document Reference: ~~APPEX3~~/GH2.9 A

APFP Regulation 5(2)(I)



Schedule of Changes


<u>Figure Reference</u>	<u>Page</u>	<u>Description of Changes</u>	<u>Reason for Revision</u>
[cover]		Updated document reference to Revision A	As required for submission of Change Application [CR1-039].
Sheet 1	3	Updated document references and annotations	As required for submission of Change Application [CR1-039].
Sheet 1	3	Extensions and reductions to Order Limits	Presentation of Changes 1, 3, 6, 7, 8 and 9 requested in Change Application and Consultation Report [CR1-039]

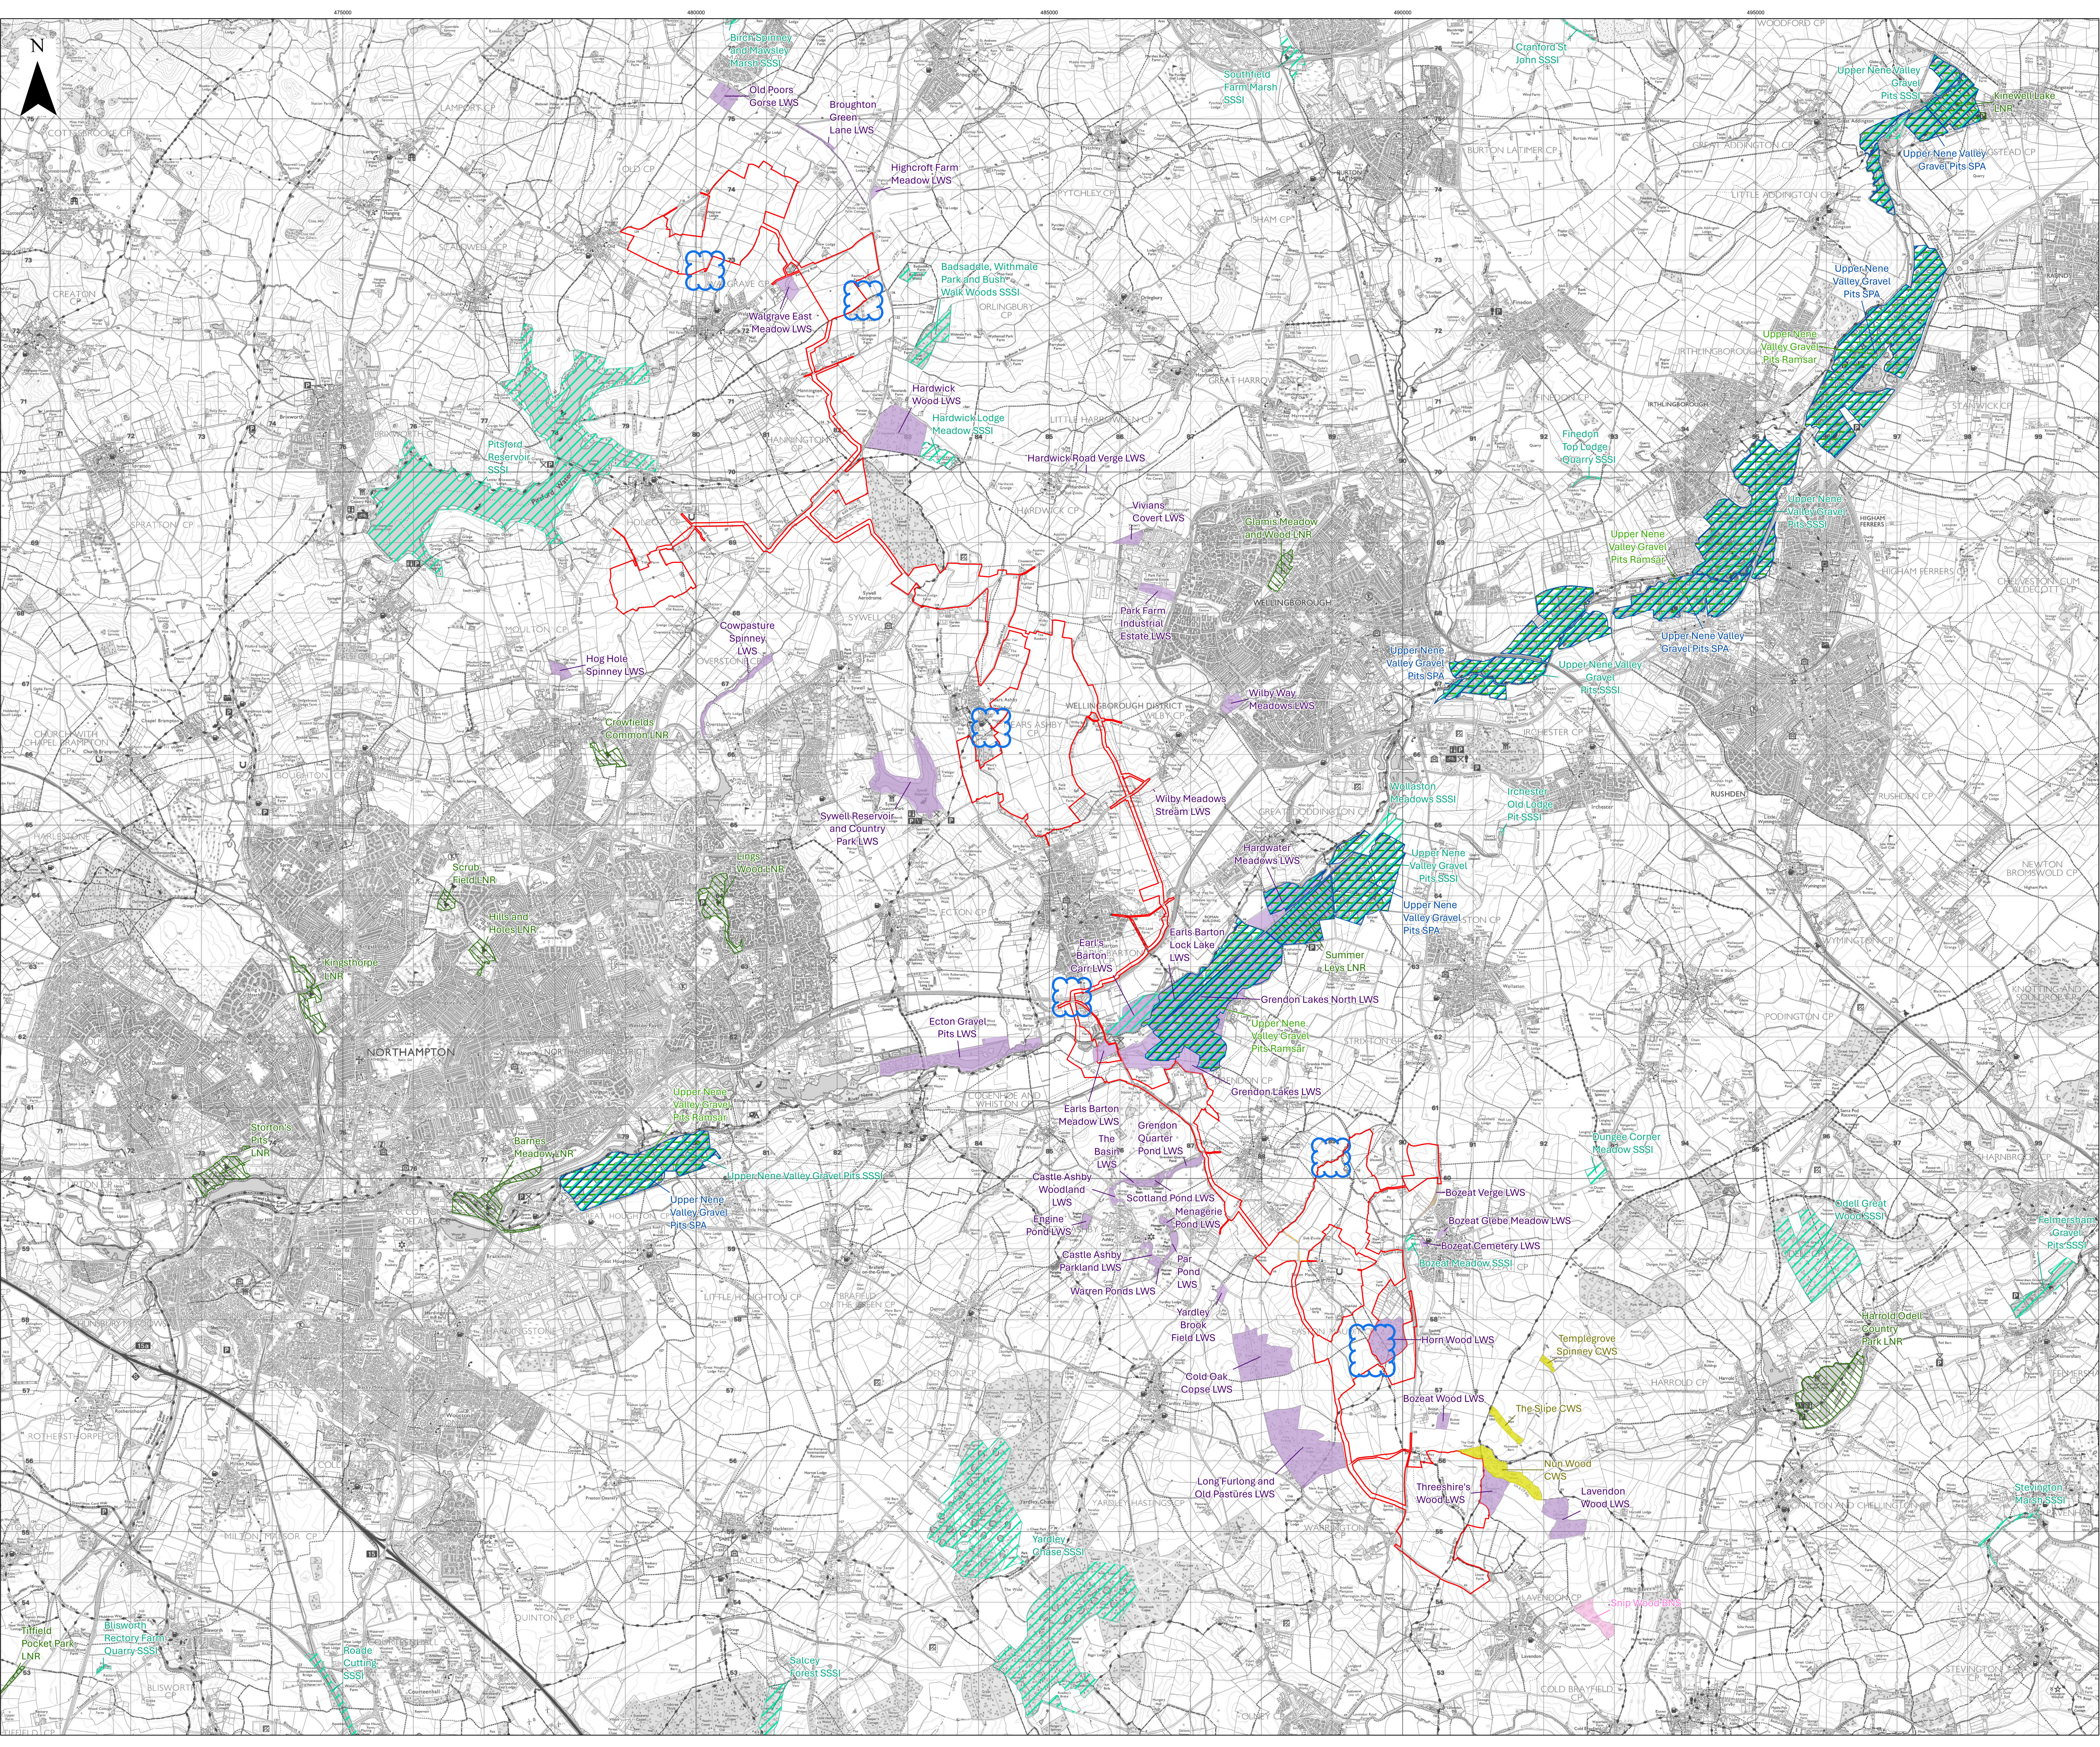

Key

- Order Limits
- Local Nature Reserve (LNR)
- Site of Special Scientific Interest (SSSI)
- Special Protection Area (SPA)
- Ramsar site
- Non-Statutory Sites within 2km of Order Limits
- County Wildlife Site
- Local Wildlife Site
- Biological Notification Site
- Protected Wildflower Verges

Layers: Natural England, 2025; Lanpro, 2025; IGF, 2025
Base map: Reproduced from Ordnance Survey digital map data © Crown copyright 2025. All rights reserved. License number 0100031673

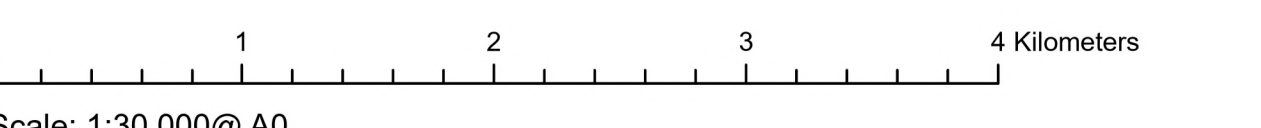

APFP Regulation: 5(2)(i)	Application Doc No. EX3/GH2.9_A
Ref: P3535_LPR_ZZ_XX_DR_Z_0278	Date: 15/12/2025
Drawn by: BH	Checked by: JC

Plan of Statutory / Non-statutory Sites or Features of Nature Conservation

Revision A

