Green Hill Solar Farm
EN010170

Hedgerow and Tree Protection Order Plan
Revision B (Tracked)

Prepared by: Lanpro
Date: ~~May~~ December 2025

Document Reference: ~~APP~~EX3/GH2.11_B
APFP Regulation 5(2)(q)

Schedule of Changes

Figure Reference	**Page**	**Description of Changes**	**Reason for Revision**
[cover]		Updated document reference to Revision B	As required for submission of Change Application.
All Sheets	3-21	Updated document references and annotations	As required for submission of Change Application.
Sheet 1	4	Order Limits extended	Presentation of Change 1 requested in Change Application and Consultation Report **[CR1-039]**.
Sheet 3	6	Order Limits extended	Presentation of Change 3 requested in Change Application and Consultation Report **[CR1-039]**.
Sheet 8	11	Order Limits extended	Presentation of Change 6 requested in Change Application and Consultation Report **[CR1-039]**.
Sheet 9	12	Order Limits extended	Presentation of Change 6 requested in Change Application and Consultation Report **[CR1-039]**.
Sheet 12	15	Order Limits extended Length of hedgerow CR5aB47 extended Length of hedgerow CR5aB48 extended	Presentation of Change 7 requested in Change Application and Consultation Report **[CR1-039]**.
Sheet 15	18	Order Limits reduced	Presentation of Change 8 requested in Change Application and Consultation Report **[CR1-039]**.
Sheet 16	19	Order Limits reduced	Presentation of Change 9 requested in Change Application and Consultation Report **[CR1-039]**.
Sheet 17	20	Order Limits reduced	Presentation of Change 9 requested in Change Application and Consultation Report **[CR1-039]**.

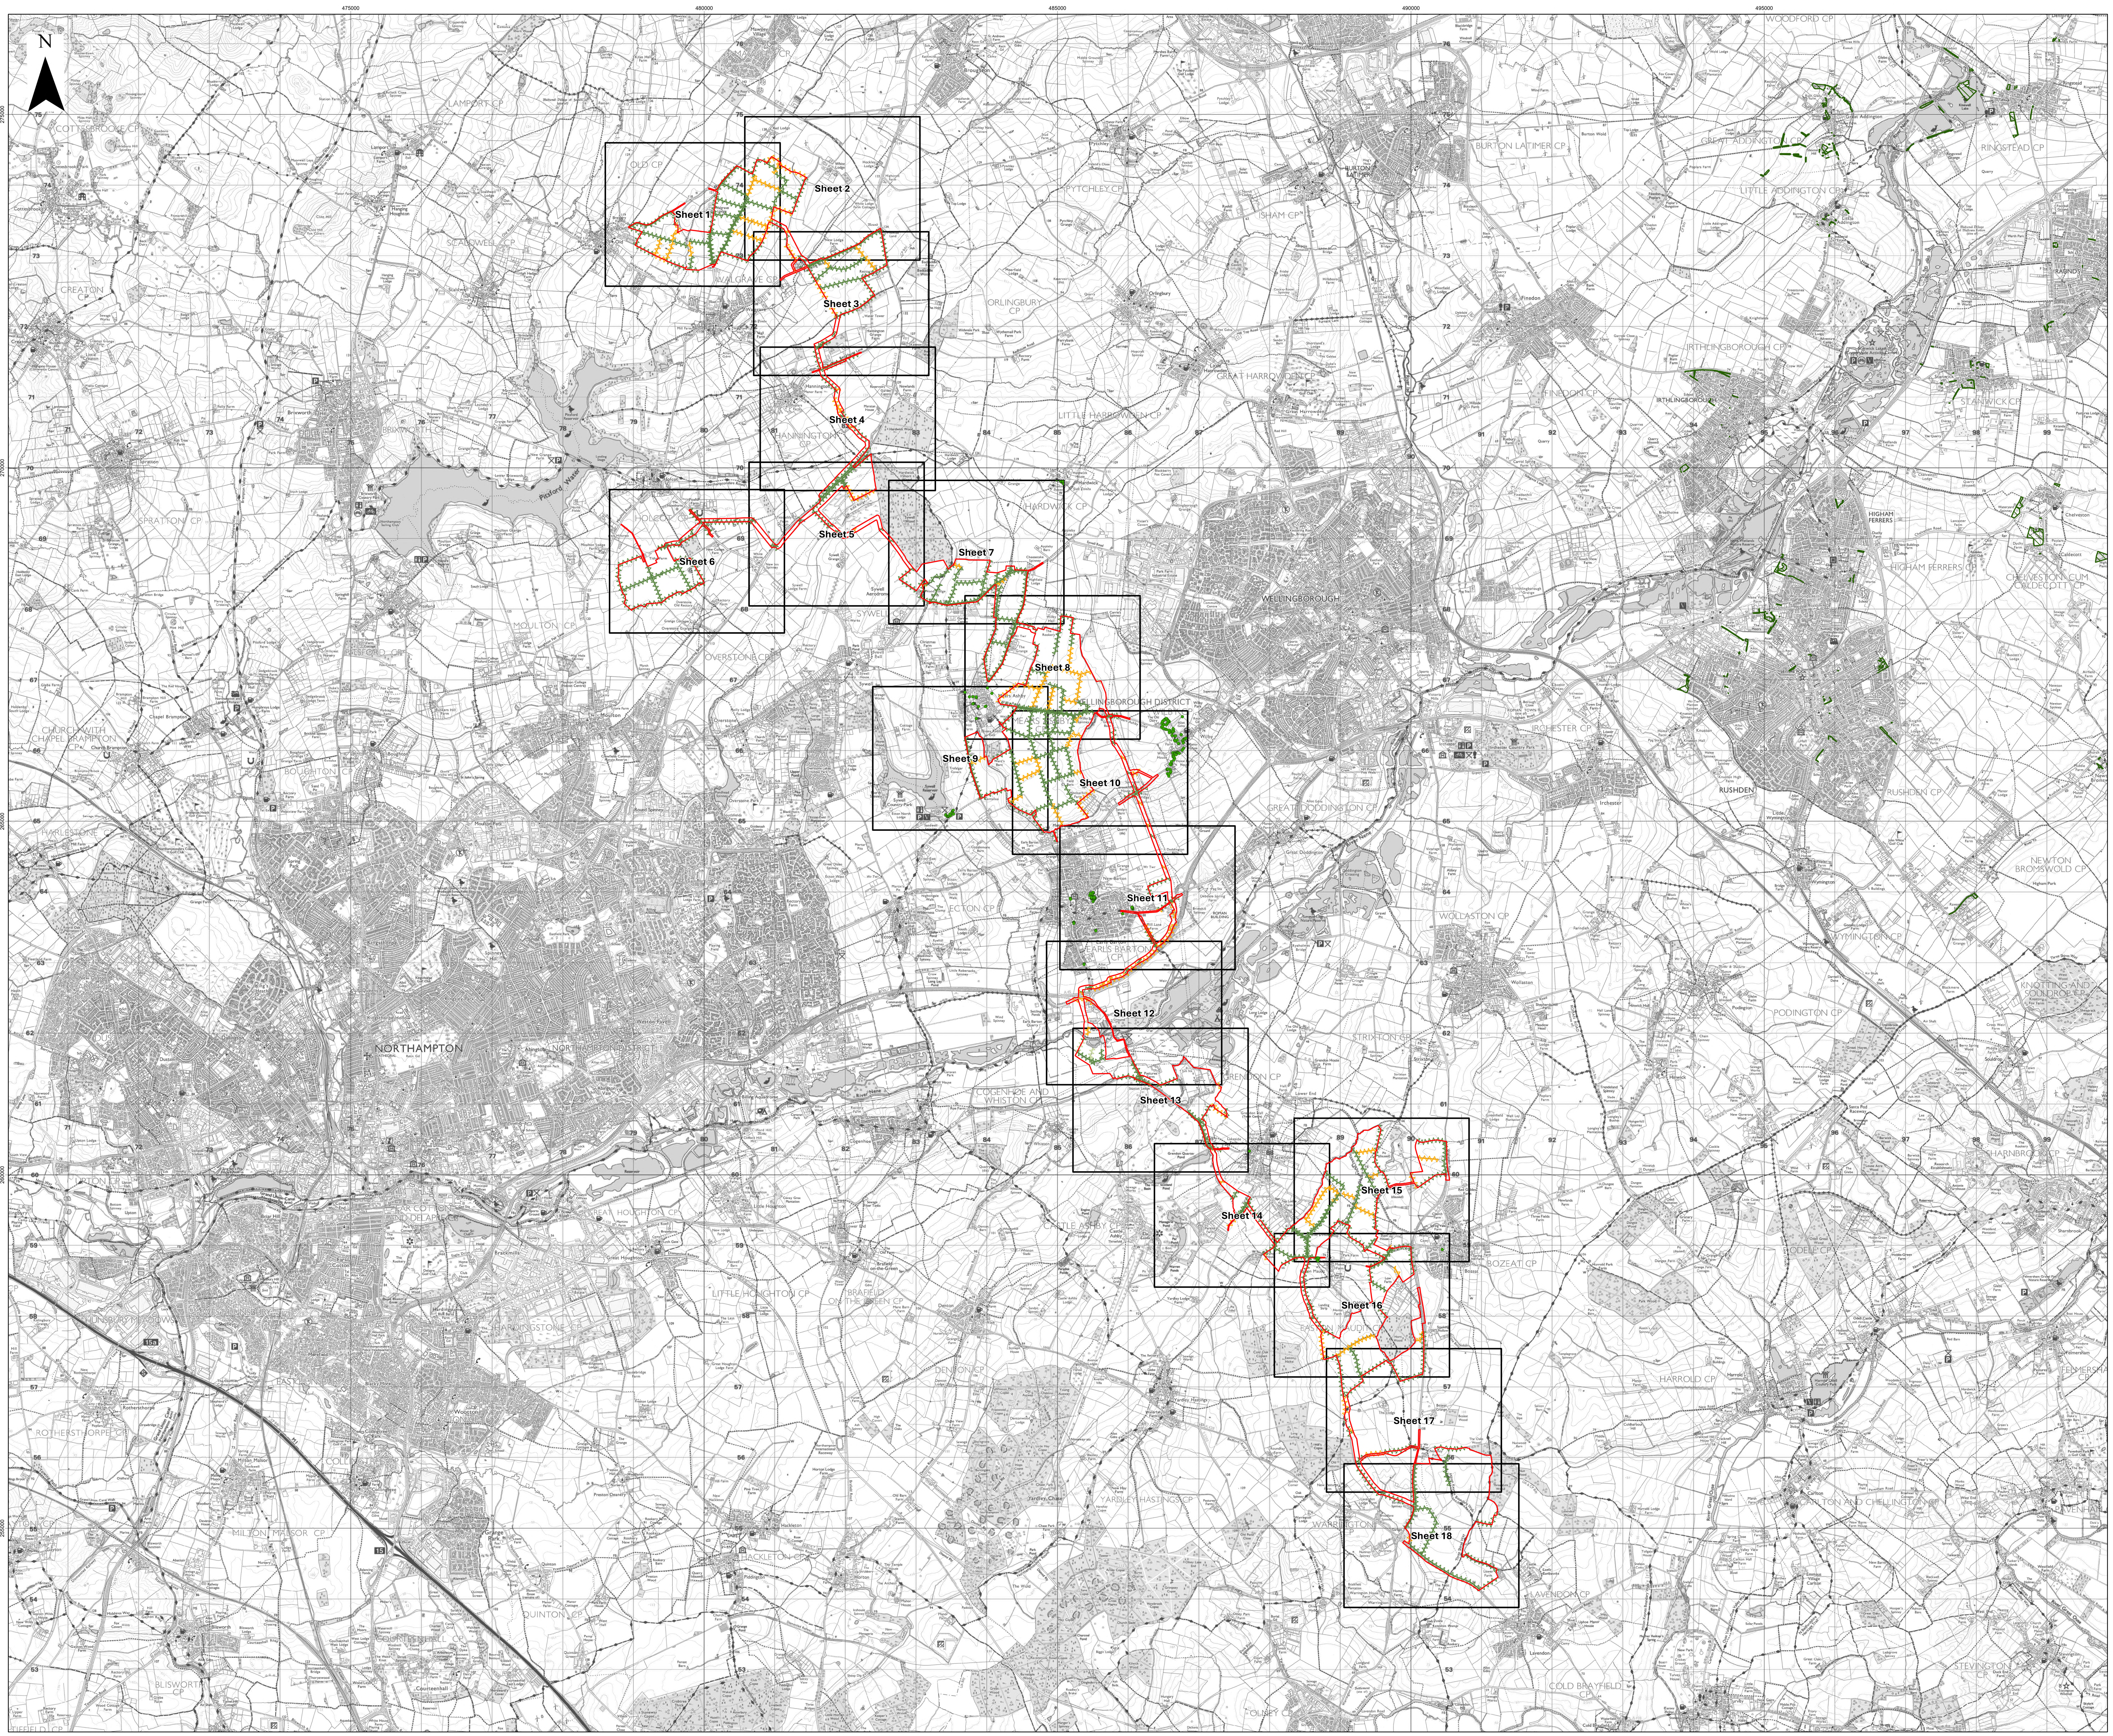
N
475000
480000
485000
490000
495000
Sheet 1
Sheet 2
Sheet 3
Sheet 4
Sheet 5
Sheet 6
Sheet 7
Sheet 8
Sheet 9
Sheet 10
Sheet 11
Sheet 12
Sheet 13
Sheet 14
Sheet 15
Sheet 16
Sheet 17
Sheet 18
NORTHAMPTON
WELLINGBOROUGH
WELLINGBOROUGH DISTRICT
RUSHDEN
HIGHAM FERRERS
IRTHLINGBOROUGH
BURTON LATIMER
Pitsford Water
SYWELL
EARLS BARTON
WOLLASTON CP
GRENDON CP
BOZEAT CP
LAVENDON CP
COLD BRAYFIELD
WOODFORD CP
RINGSTEAD CP
STANWICK CP

Island GREEN POWER

Lanpro

Key

- 🟥 Order Limits
- ▭ Sheet Index
- Important Hedgerow
- Potentially Important Hedgerow
- Hedgerow

Tree Protection Order (TPO)

- ● Points
- ▨ Group

Layers: Lanpro, 2025; IGP, 2025
Base map: Reproduced from Ordnance Survey digital map data © Crown copyright 2025. All rights reserved. License number 0100031673

0 1 2 3 4 Kilometers

Scale: 1:30,000@ A0

APFP Regulation: 5(2)(q)	Application Doc No. EX3/GH2.11_B
Ref: P3535_LPR_ZZ_XX_DR_Z_0280	Date: 15/12/2025
Drawn by: BH	Checked by: JC

Hedgerow and Tree Protection Order Plan
Index Sheet
Revision B

GREEN HILL SOLAR FARM

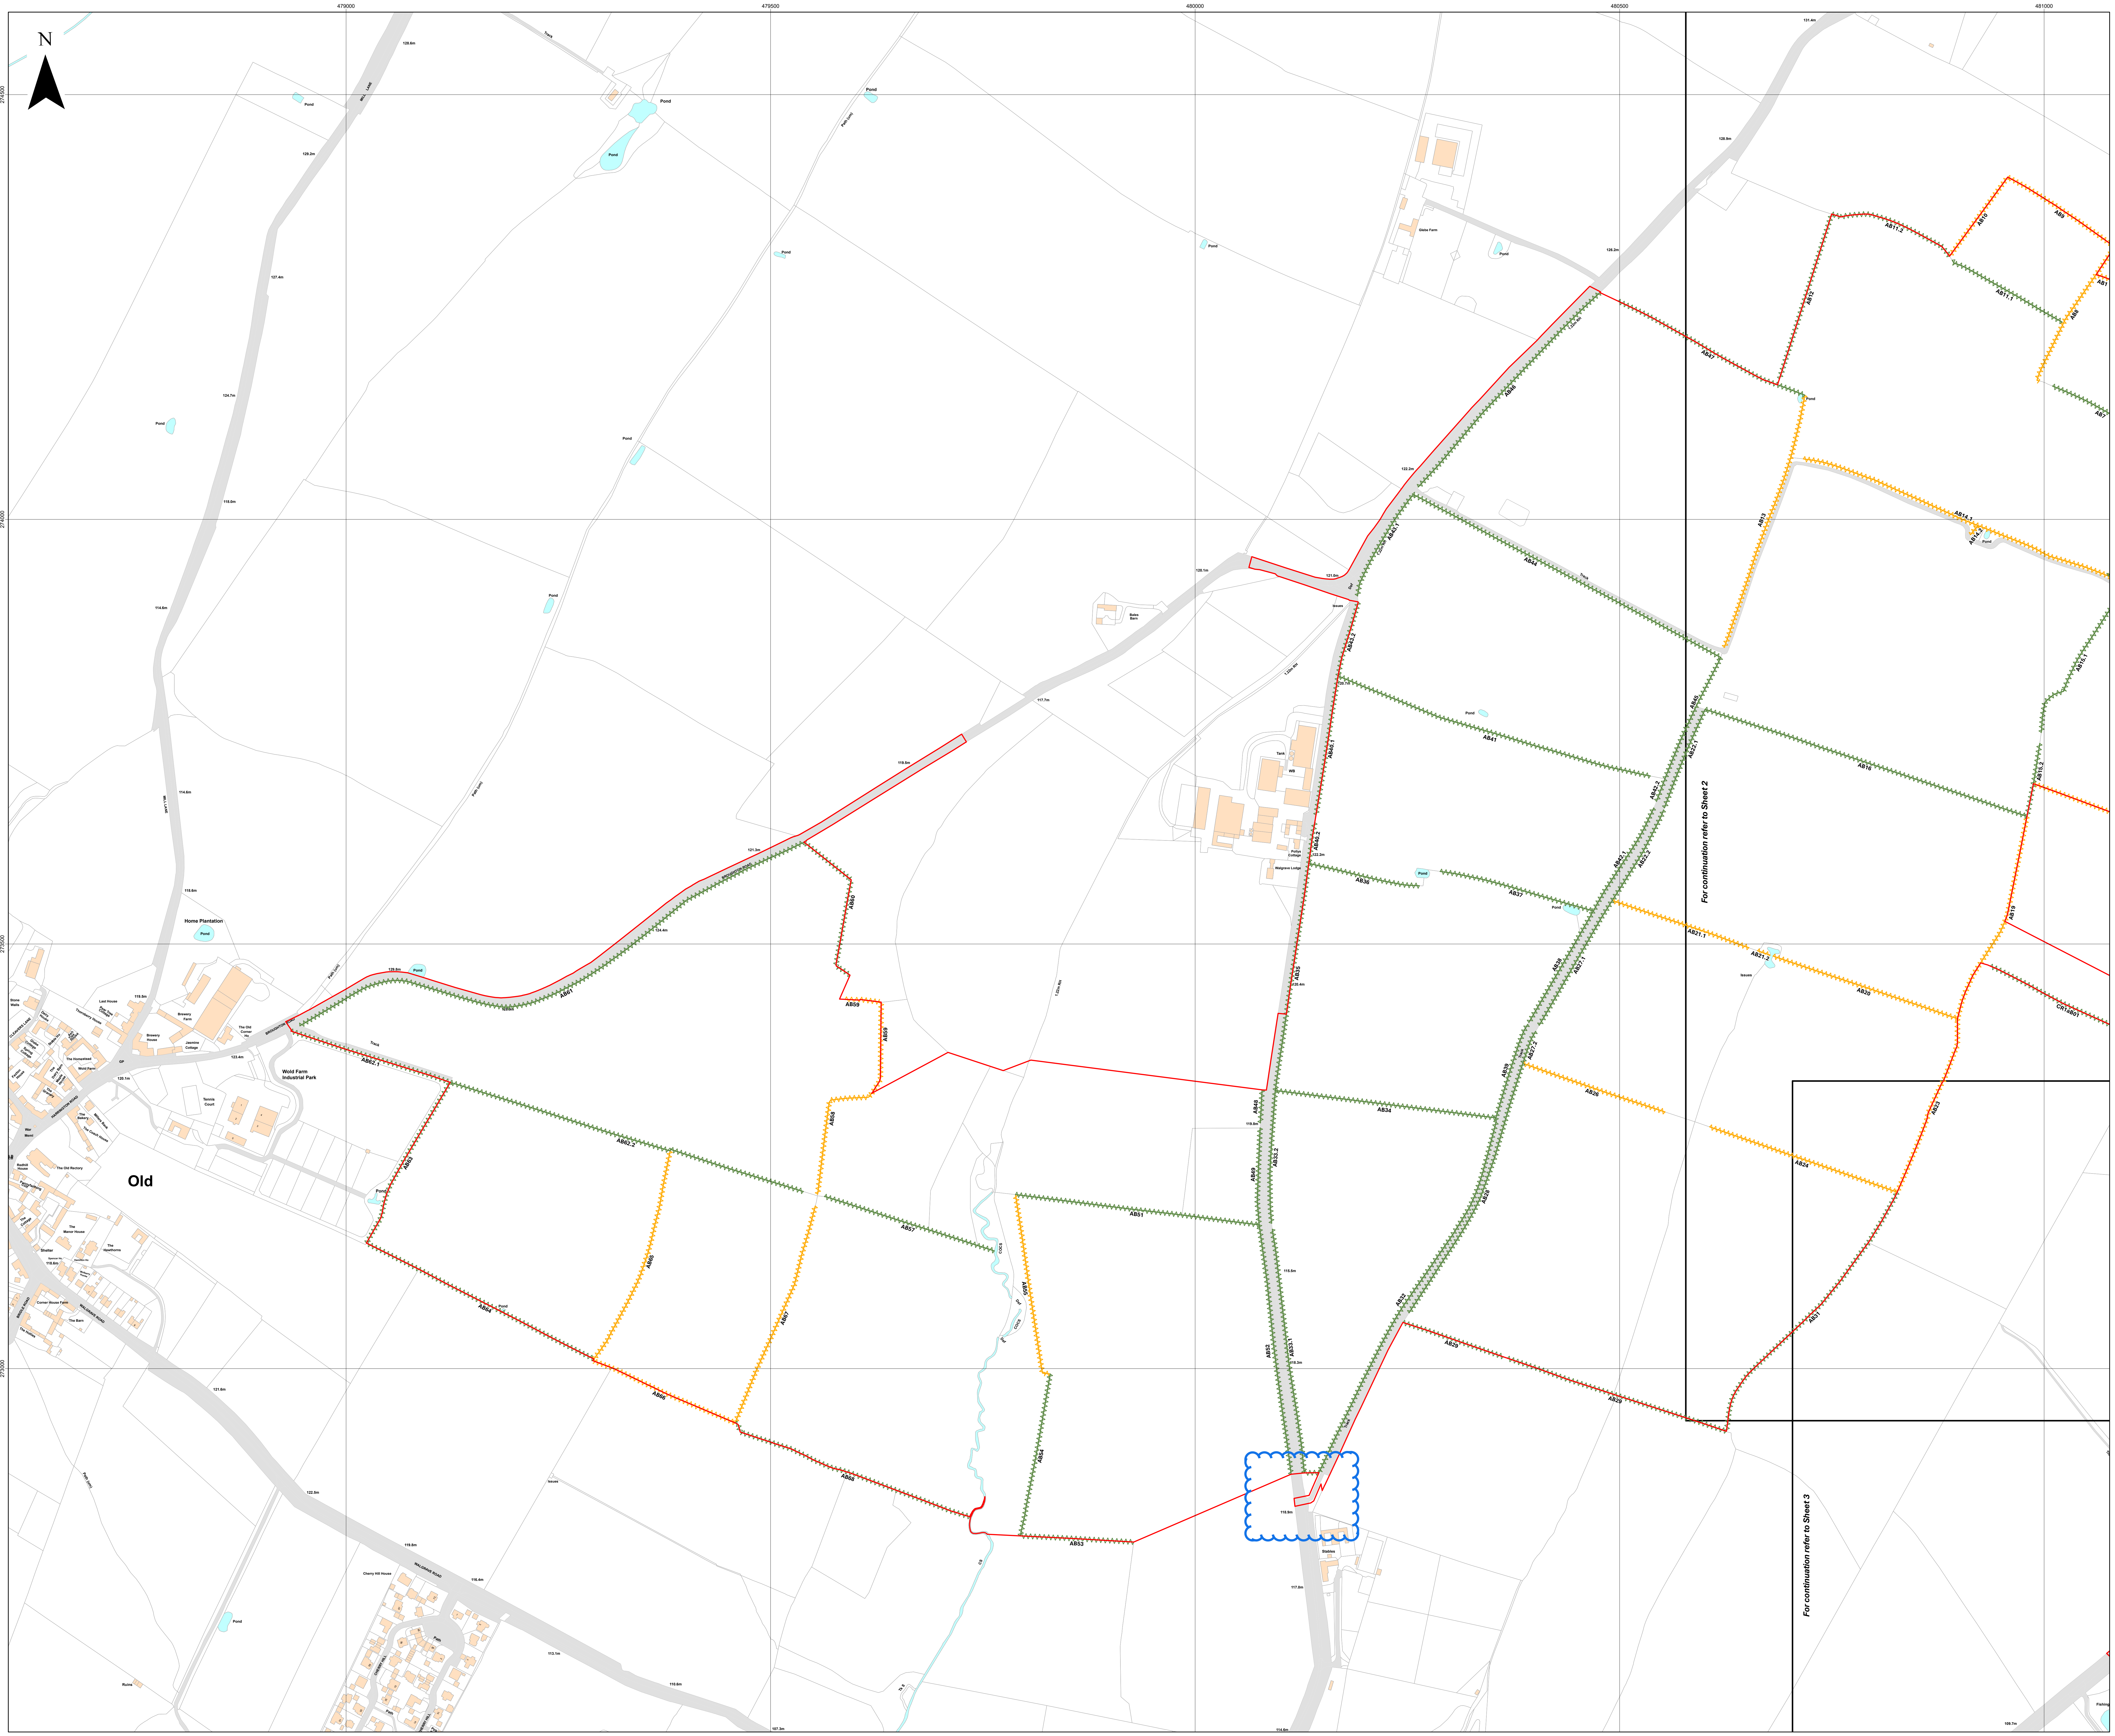
N
479000
479500
480000
480500
481000
Glebe Farm
Pond
Old
Home Plantation
Wold Farm Industrial Park
The Old Corner Ho
BROUGHTON ROAD
WALGRAVE ROAD
Cherry Hill House
Track
Path (um)
Pollys Cottage
Walgrave Lodge
Tank
WB
Issues
Stables
COCS
CS
Def
1.22m RH
131.4m
128.9m
126.2m
122.2m
121.0m
120.7m
120.4m
119.8m
118.9m
118.3m
117.0m
117.7m
119.5m
121.3m
124.4m
129.8m
128.9m
123.4m
122.5m
116.4m
115.5m
AB1
AB7
AB8
AB9
AB10
AB11.1
AB11.2
AB12
AB13
AB14.1
AB14.2
AB15.1
AB15.2
AB16
AB19
AB20
AB21.1
AB21.2
AB22.1
AB22.2
AB23
AB24
AB26
AB27.1
AB27.2
AB28
AB29
AB31
AB32
AB33.1
AB33.2
AB34
AB35
AB36
AB37
AB38
AB39
AB40.1
AB40.2
AB41
AB42.1
AB42.2
AB43.1
AB43.2
AB44
AB45
AB46
AB47
AB48
AB49
AB51
AB52
AB53
AB54
AB55
AB57
AB58
AB59
AB60
AB61
AB62.1
AB62.2
AB63
AB64
AB65
AB66
AB67
AB68
CR1aB01
For continuation refer to Sheet 2
For continuation refer to Sheet 3

Key

- 🟥 Order Limits
- ▭ Sheet Index
- Important Hedgerow
- Hedgerow

Layers: Lanpro, 2025; IGP, 2025

Base map: Reproduced from Ordnance Survey digital map data © Crown copyright 2025. All rights reserved. License number 0100031673

0 100 200 300 Meters

Scale: 1:2,500@ A0

APFP Regulation: 5(2)(q)	Application Doc No. EX3/GH2.11_B
Ref: P3535_LPR_ZZ_XX_DR_Z_0280	Date: 15/12/2025
Drawn by: BH	Checked by: JC

Important Hedgerows Plan

Sheet 1 of 18

Revision B

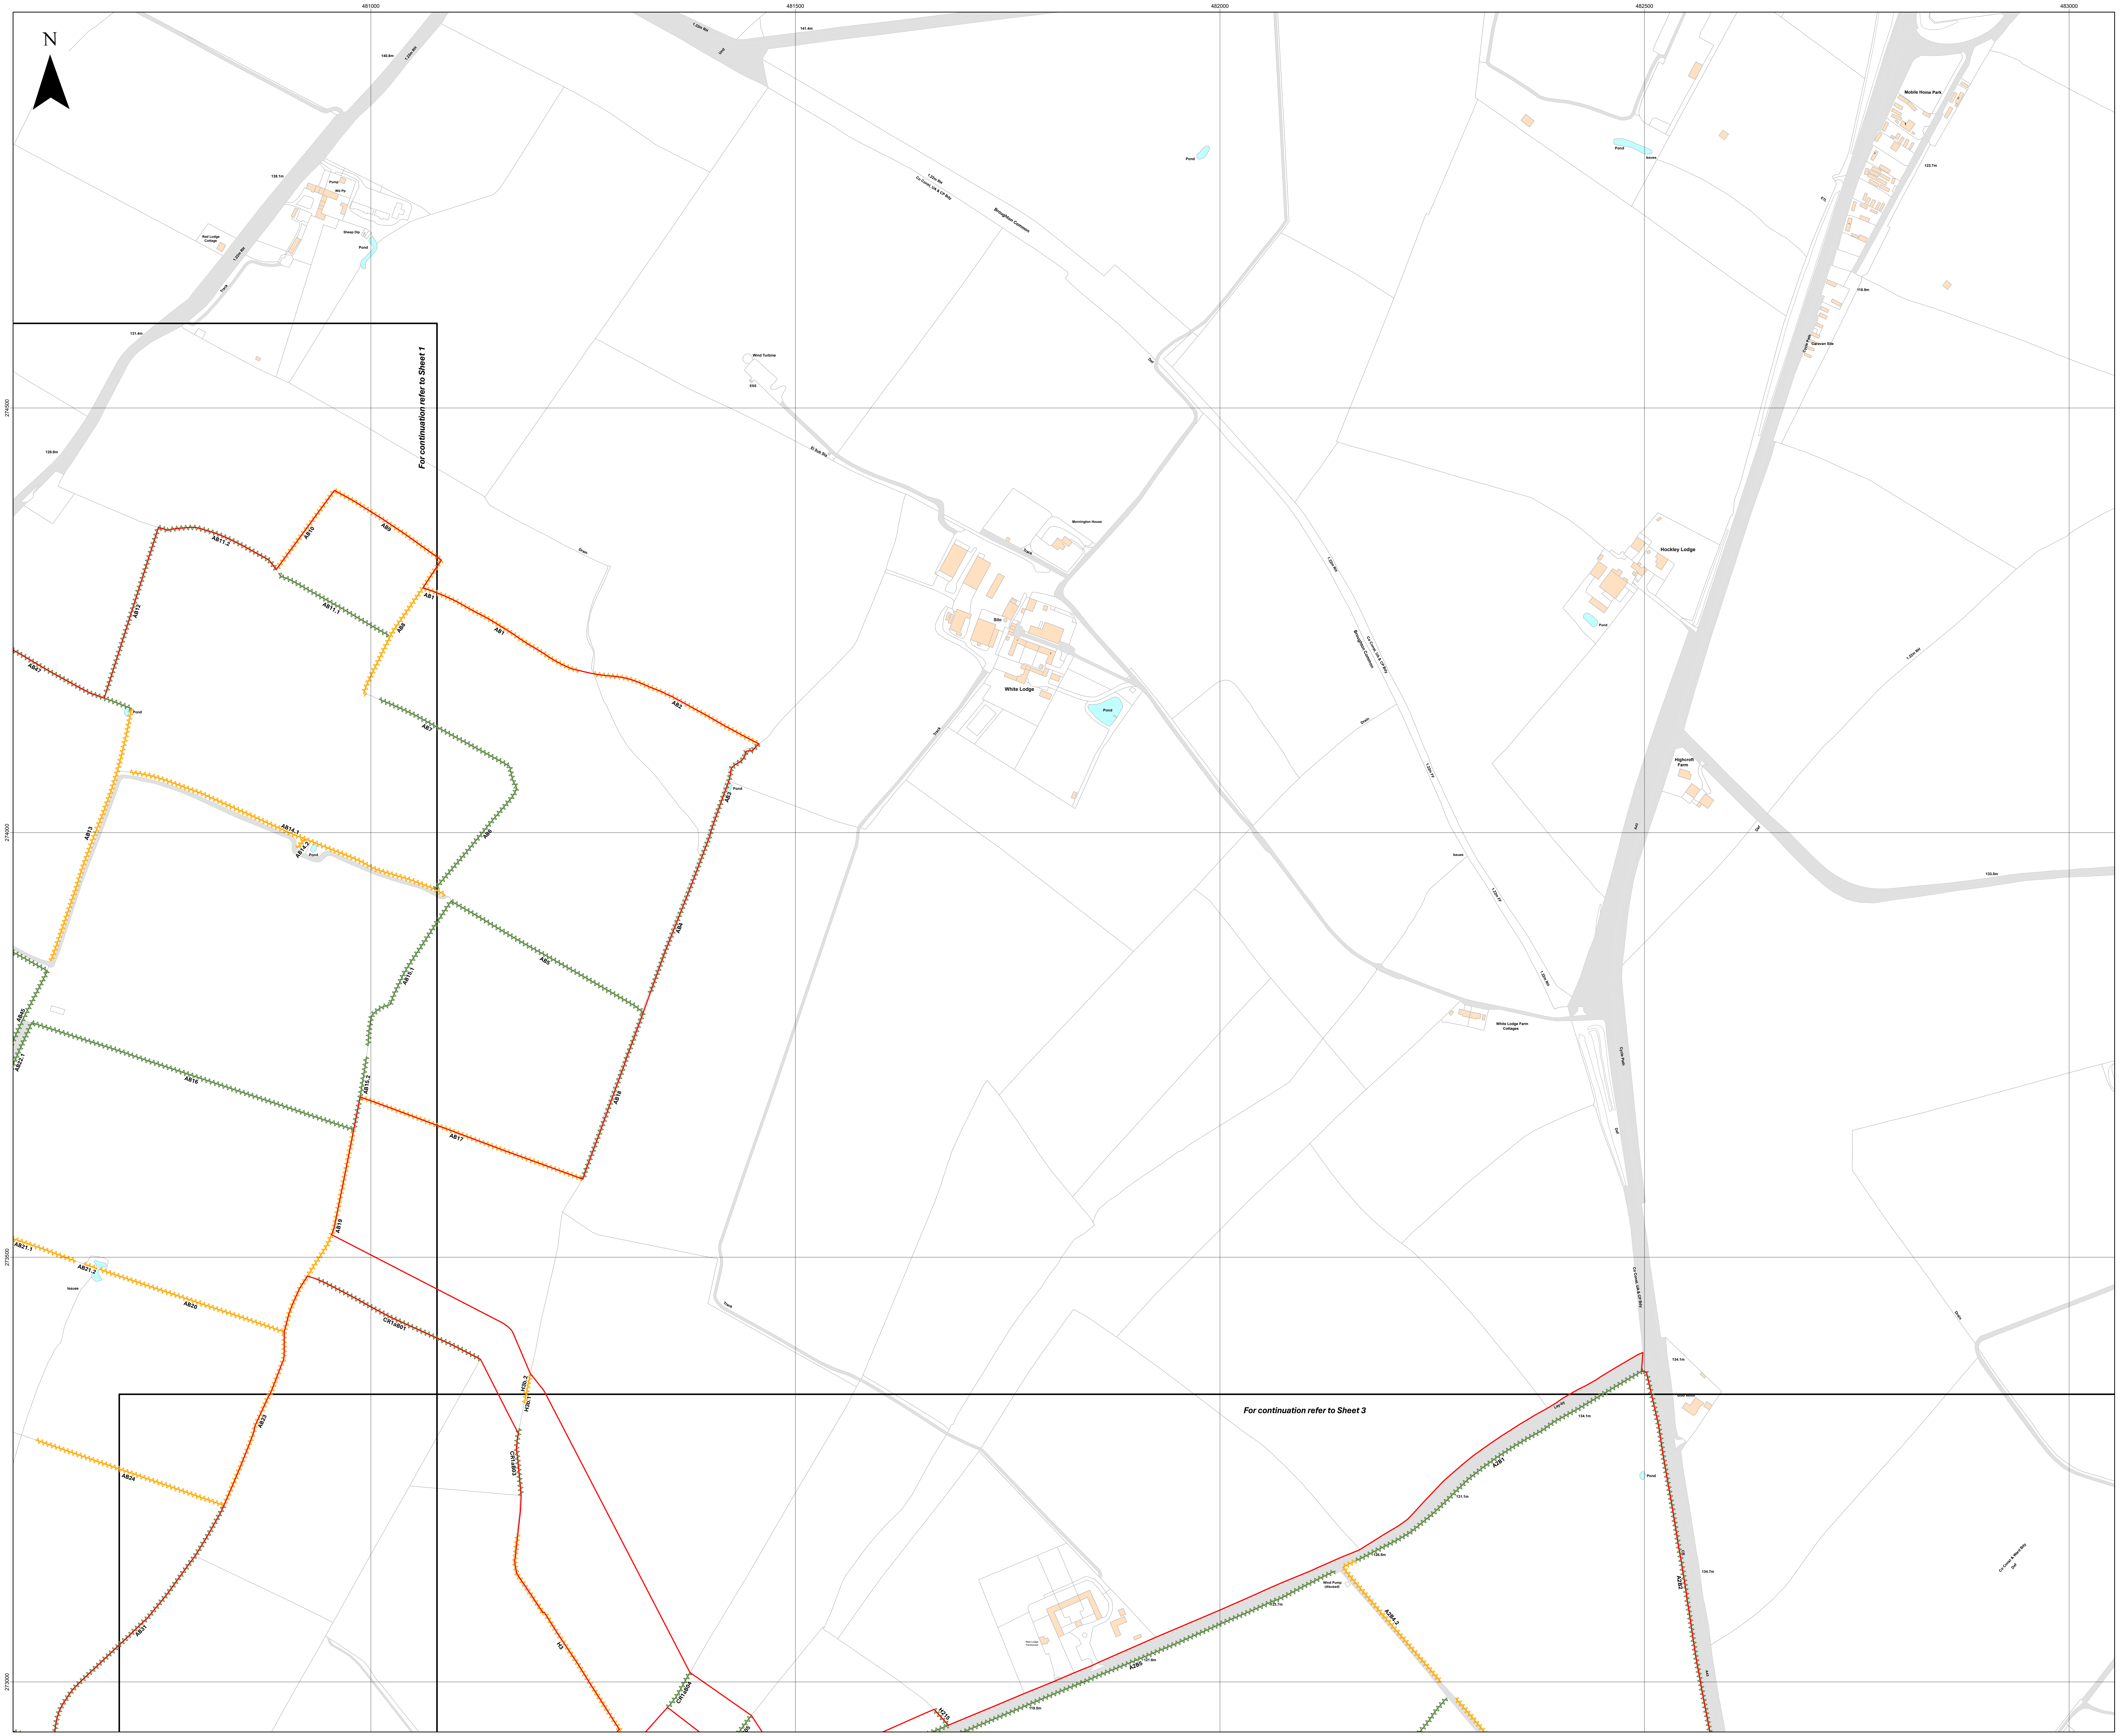
N
481000
481500
482000
482500
483000
274500
274000
273500
273000
For continuation refer to Sheet 1
For continuation refer to Sheet 3
AB1
AB2
AB3
AB4
AB5
AB6
AB7
AB8
AB9
AB10
AB11.1
AB11.2
AB12
AB13
AB14.1
AB14.2
AB15.1
AB15.2
AB16
AB17
AB18
AB19
AB20
AB21.1
AB21.2
AB22.1
AB23
AB24
AB31
AB45
AB47
CR1aB01
CR1aB03
CR1aB04
H3
H3b.1
H3b.2
H215
A2B1
A2B2
A2B4.2
A2B5
Pond
Issues
Drain
Track
Silo
White Lodge
Mornington House
Broughton Common
Co Const, UA & CP Bdy
1.22m RH
1.22m FF
Hockley Lodge
Highcroft Farm
White Lodge Farm Cottages
A43
Cycle Path
Def
Mobile Home Park
Caravan Site
ETL
123.7m
118.9m
128.9m
134.1m
134.7m
131.1m
126.5m
121.6m
119.5m
Lay-by
Wind Pump (disused)
New Lodge Farmhouse
Gibb Wood
Co Const & Ward Bdy
El Sub Sta
ESS
Wind Turbine

Key

- 🟥 Order Limits
- ⬜ Sheet Index
- Important Hedgerow
- Hedgerow

Layers: Lanpro, 2025; IGP, 2025
Base map: Reproduced from Ordnance Survey digital map data © Crown copyright 2025. All rights reserved. License number 0100031673

0 100 200 300 Meters

Scale: 1:2,500@ A0

APFP Regulation: 5(2)(q)	Application Doc No. EX3/GH2.11_B
Ref: P3535_LPR_ZZ_XX_DR_Z_0280	Date: 15/12/2025
Drawn by: BH	Checked by: JC

Important Hedgerows Plan

Sheet 2 of 18
Revision B

GREEN HILL
SOLAR FARM

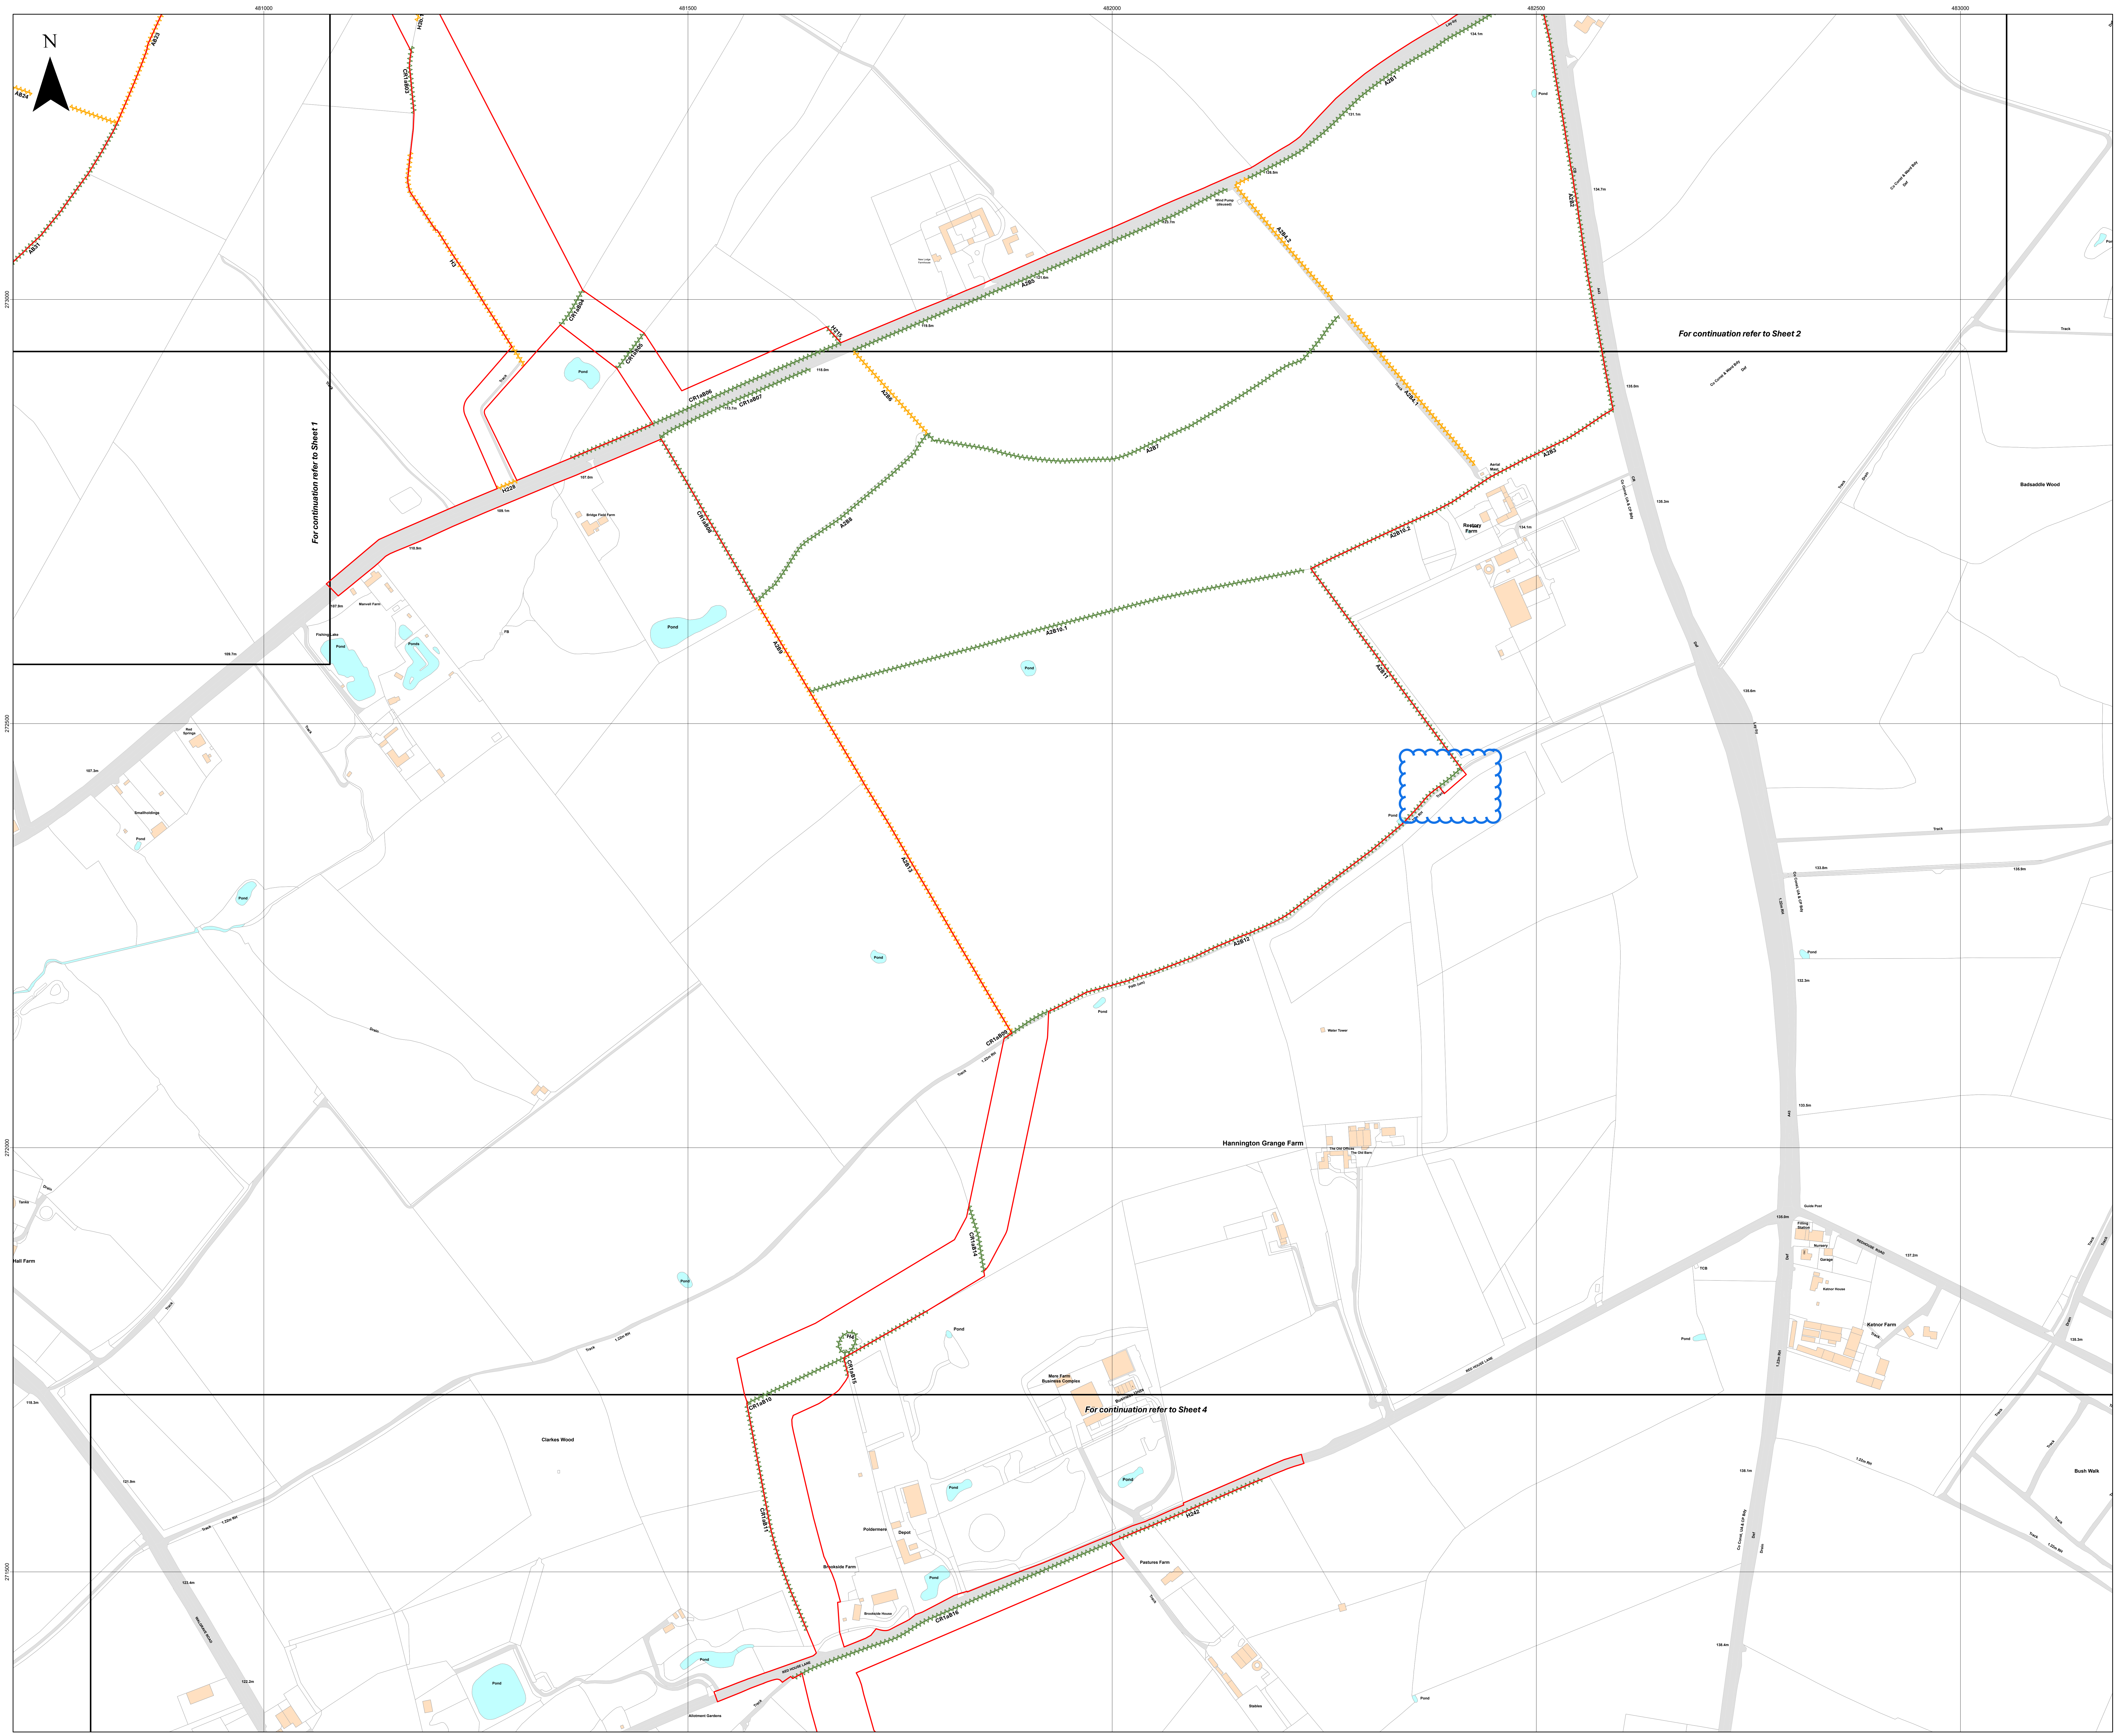
N
481000
481500
482000
482500
483000
273000
272500
272000
271500
AB23
AB24
AB31
H3b.1
CR1aB03
H3
CR1aB04
CR1aB05
H215
H228
CR1aB06
CR1aB07
CR1aB08
A2B1
A2B2
A2B3
A2B4.1
A2B4.2
A2B5
A2B6
A2B7
A2B8
A2B9
A2B10.1
A2B10.2
A2B11
A2B12
A2B13
CR1aB09
CR1aB10
CR1aB11
CR1aB14
CR1aB15
CR1aB16
H4
H242
For continuation refer to Sheet 1
For continuation refer to Sheet 2
For continuation refer to Sheet 4
Pond
Track
New Lodge Farmhouse
Wind Pump (disused)
Bridge Field Farm
Manvell Farm
Aerial Mast
Rectory Farm
Badsaddle Wood
Water Tower
Path (um)
Hannington Grange Farm
The Old Offices
The Old Barn
Mere Farm Business Complex
Business Units
Poldermere
Depot
Brookside Farm
Brookside House
Pastures Farm
Stables
Allotment Gardens
RED HOUSE LANE
Clarkes Wood
Kelmor Farm
Bush Walk
A43
CR
Co Const, UA & CP Bdy
107.0m
109.1m
110.9m
113.7m
118.0m
119.5m
121.6m
123.7m
126.5m
131.1m
134.1m
134.7m
135.0m
135.3m

Key

- ▭ Order Limits
- ▭ Sheet Index
- Important Hedgerow
- Hedgerow

Layers: Lanpro, 2025; IGP, 2025

Base map: Reproduced from Ordnance Survey digital map data © Crown copyright 2025. All rights reserved. License number 0100031673

0 100 200 300 Meters

Scale: 1:2,500@ A0

APFP Regulation: 5(2)(q)	Application Doc No. EX3/GH2.11_B
Ref: P3535_LPR_ZZ_XX_DR_Z_0280	Date: 15/12/2025
Drawn by: BH	Checked by: JC

Important Hedgerows Plan

Sheet 3 of 18

Revision B

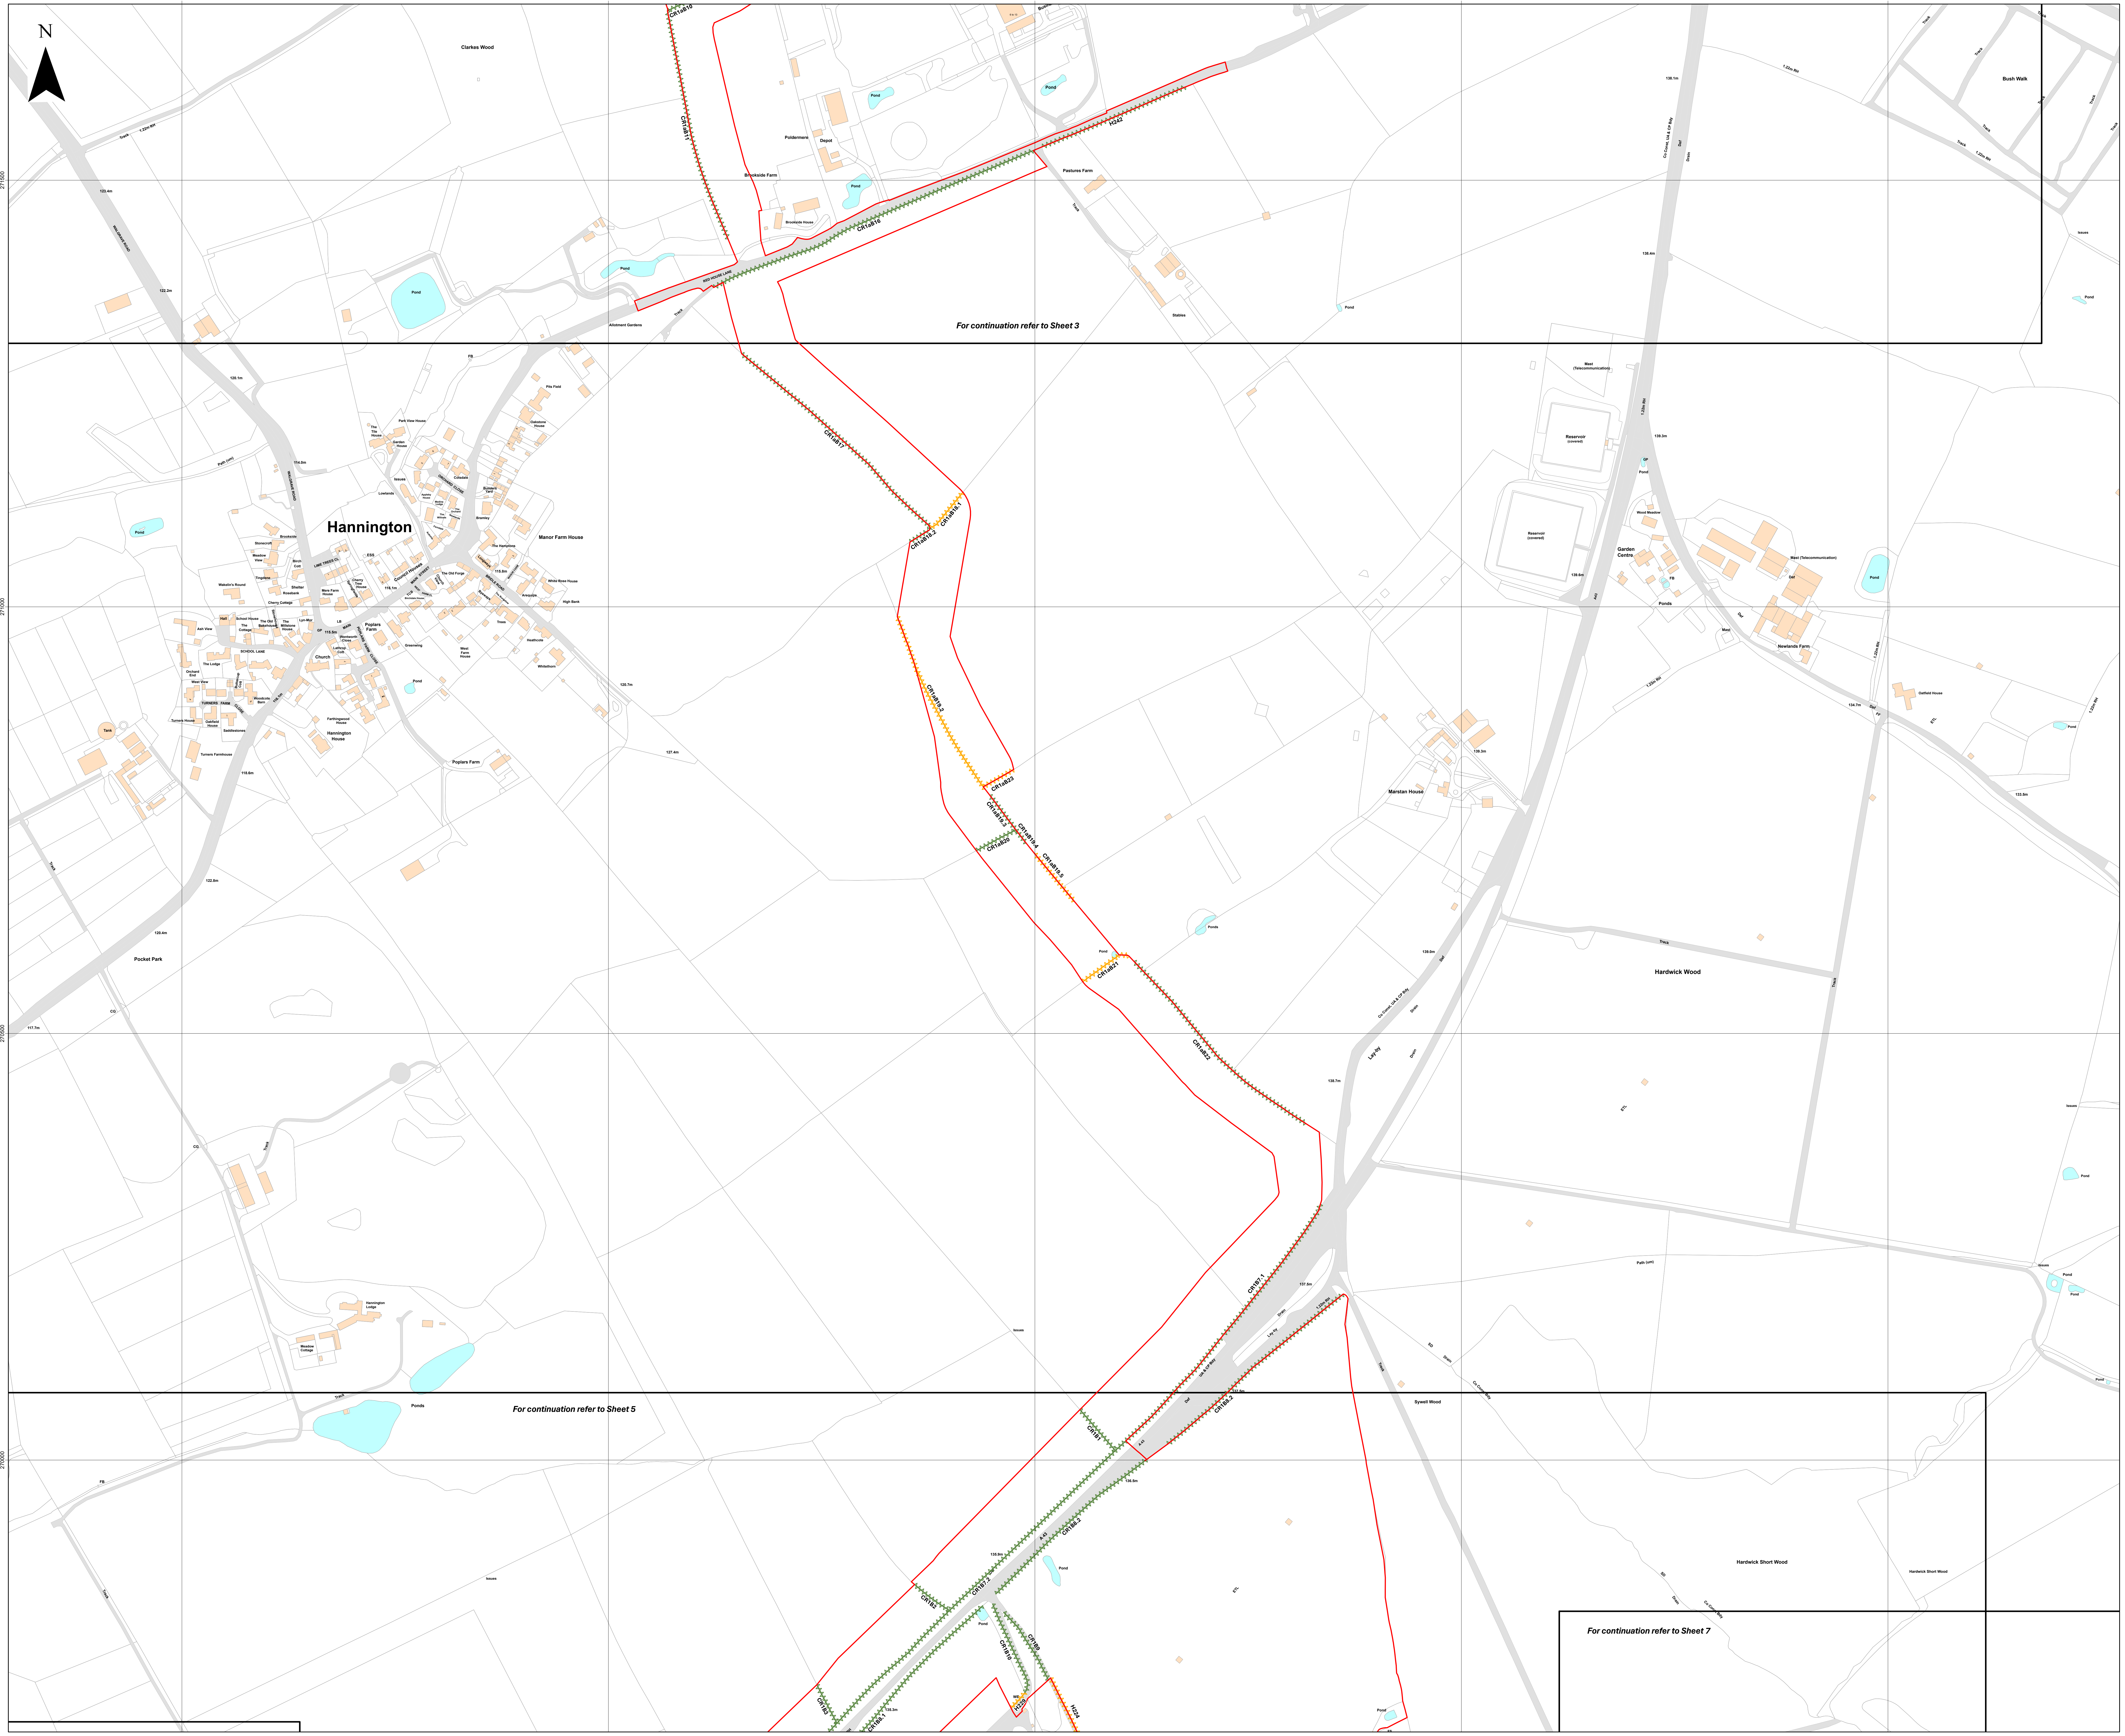
N
481000
481500
482000
482500
483000
271500
271000
270500
270000
CR1aB10
CR1aB11
CR1aB16
H242
RED HOUSE LANE
Poldermere
Depot
Brookside Farm
Brookside House
Pastures Farm
Stables
Allotment Gardens
Clarkes Wood
Pond
Track
For continuation refer to Sheet 3
CR1aB17
CR1aB18.1
CR1aB18.2
CR1aB19.2
CR1aB23
CR1aB19.3
CR1aB19.4
CR1aB19.5
CR1aB20
CR1aB21
CR1aB22
Ponds
Hannington
Manor Farm House
Poplars Farm
Church
Hannington House
Pocket Park
Hannington Lodge
Reservoir (covered)
Garden Centre
Newlands Farm
Marston House
Hardwick Wood
Bush Walk
Lay-by
CR1B7.1
CR1B7.2
CR1B8.1
CR1B8.2
CR1B1
CR1B2
CR1B3
CR1B9
CR1B10
H229
H224
A 43
Sywell Wood
Hardwick Short Wood
For continuation refer to Sheet 5
For continuation refer to Sheet 7

Island GREEN POWER

Lanpro

Key

- 🟥 Order Limits
- ☐ Sheet Index
- Important Hedgerow
- Hedgerow

Layers: Lanpro, 2025; IGP, 2025
Base map: Reproduced from Ordnance Survey digital map data © Crown copyright 2025. All rights reserved. License number 0100031673

0 100 200 300 Meters

Scale: 1:2,500@ A0

APFP Regulation: 5(2)(q)	Application Doc No. EX3/GH2.11_B
Ref: P3535_LPR_ZZ_XX_DR_Z_0280	Date: 15/12/2025
Drawn by: BH	Checked by: JC

Important Hedgerows Plan
Sheet 4 of 18
Revision B

GREEN HILL SOLAR FARM

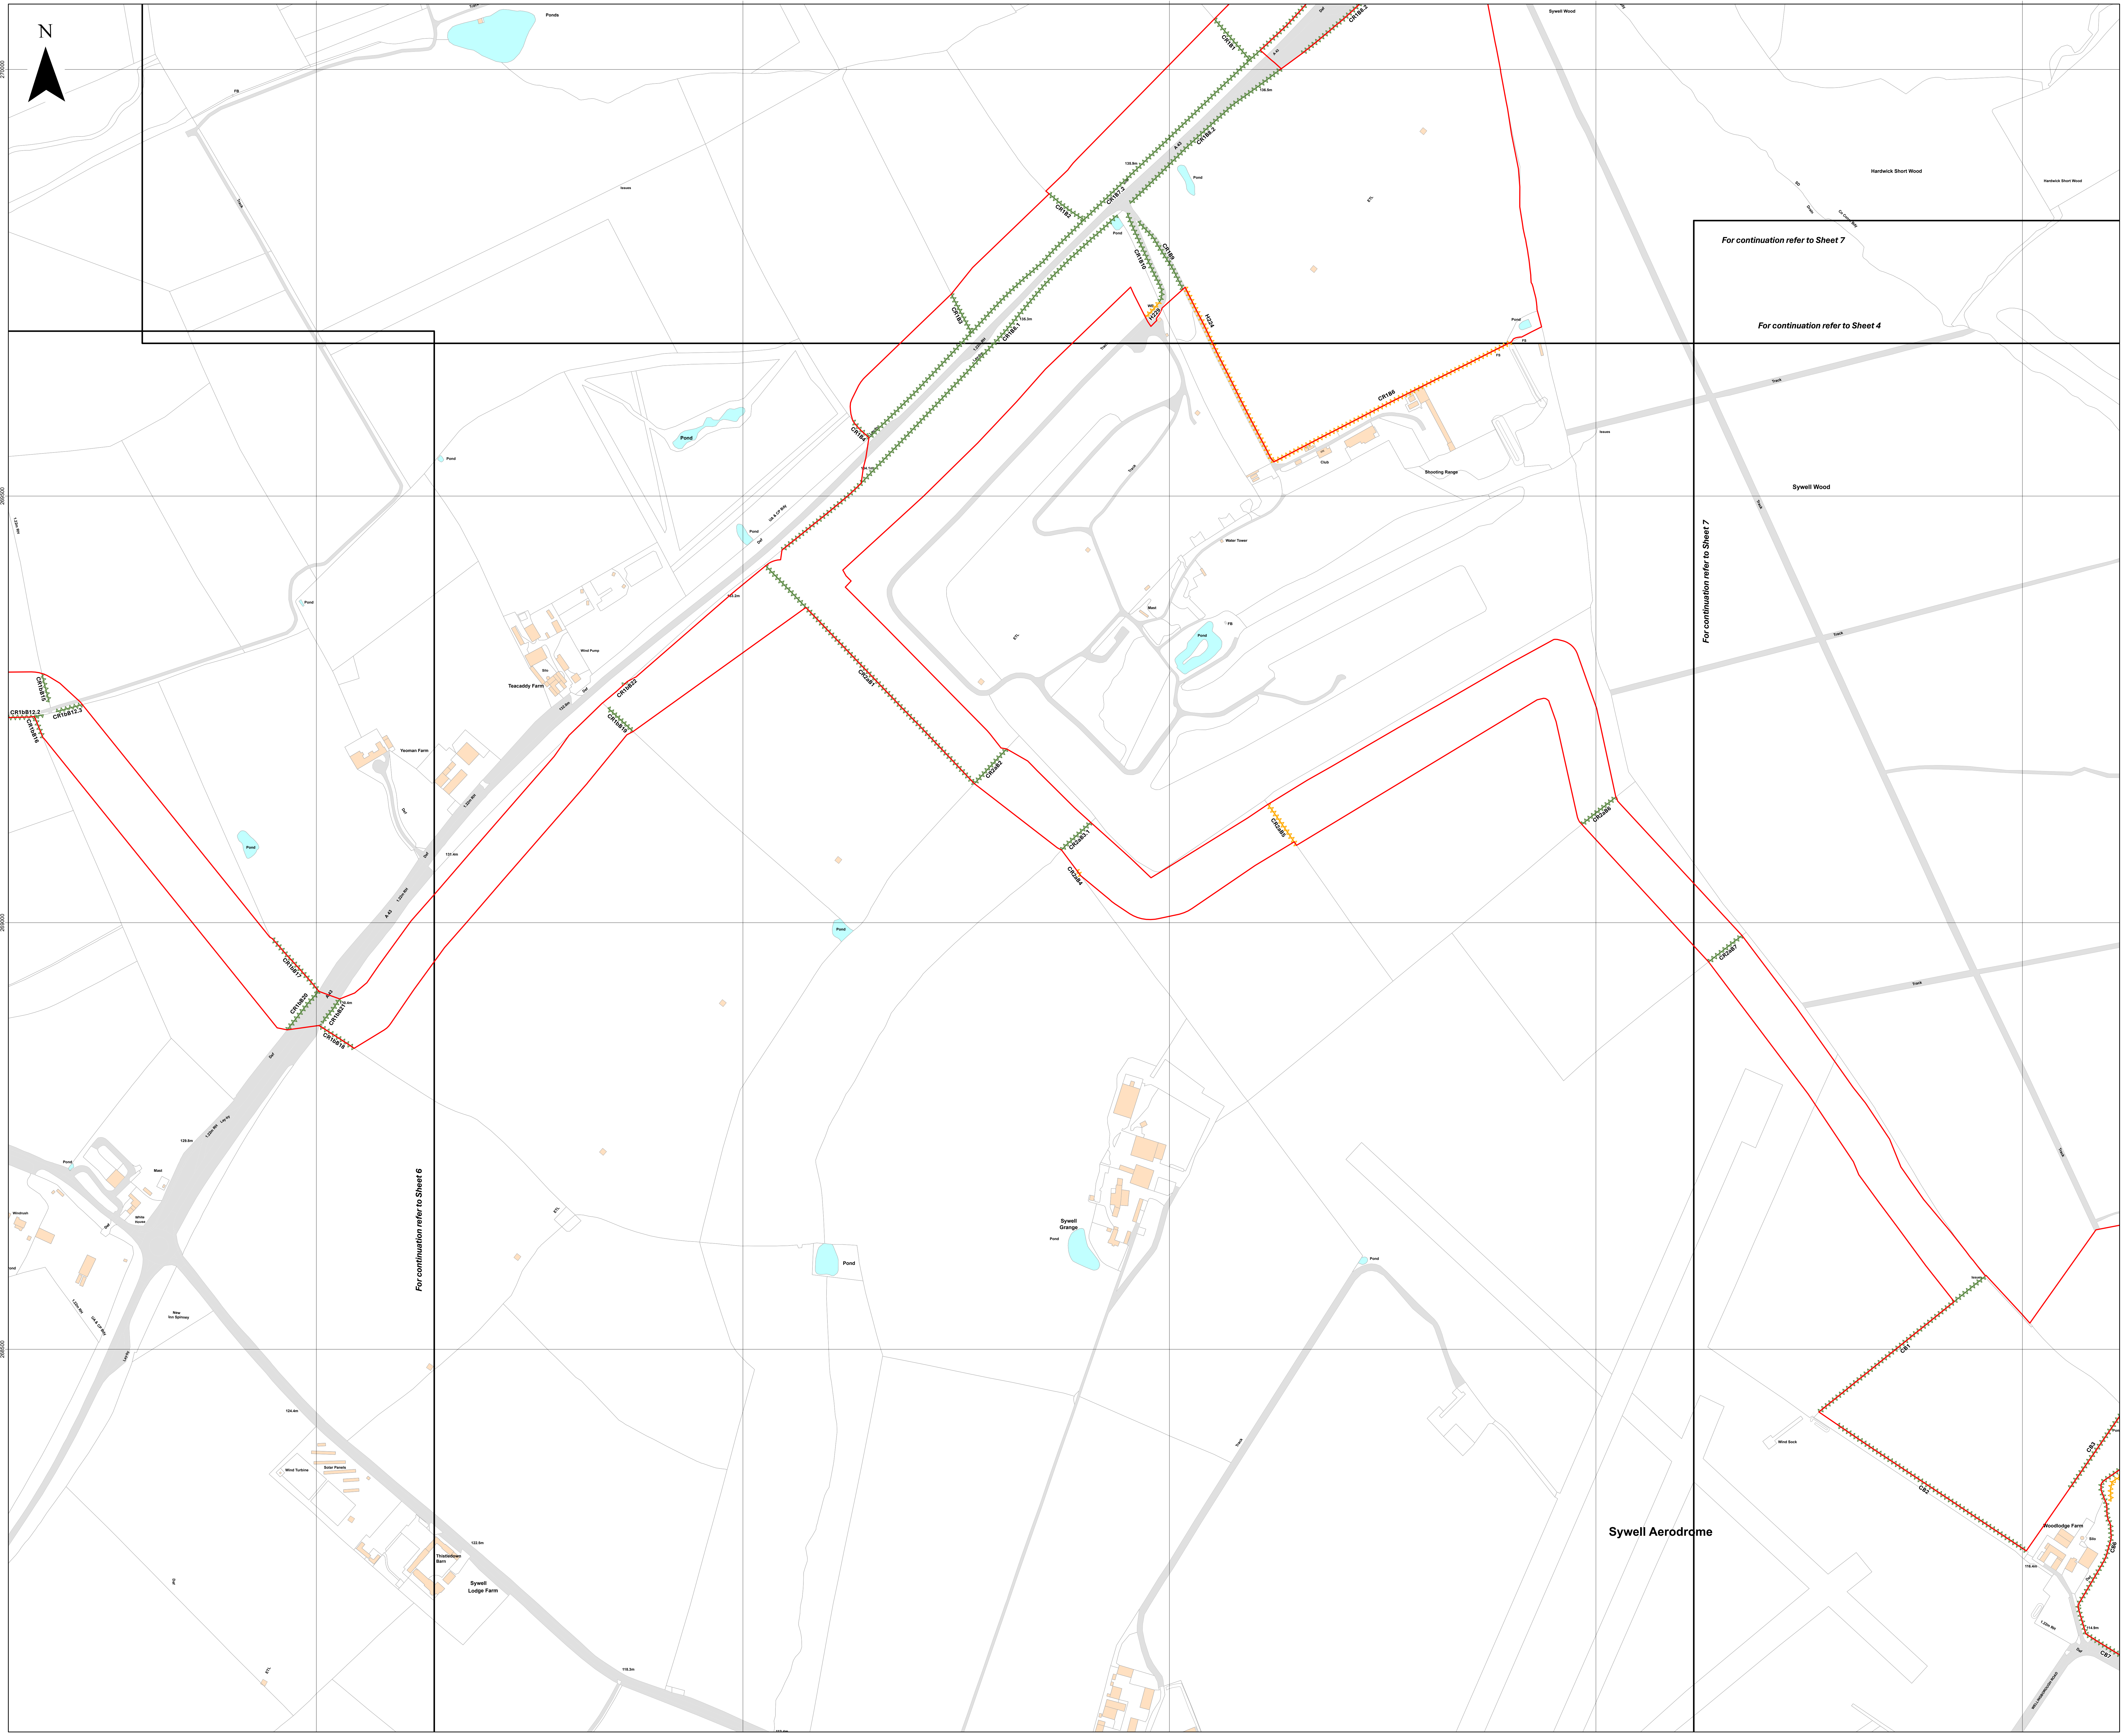
N
481000
481500
482000
482500
483000
270000
269500
269000
268500
Ponds
Pond
Sywell Wood
Hardwick Short Wood
For continuation refer to Sheet 7
For continuation refer to Sheet 4
For continuation refer to Sheet 6
CR1B1
CR1B8.2
A 43
136.5m
135.9m
CR1B7.2
CR1B2
CR1B9
CR1B10
CR1B3
CR1B8.1
135.3m
H229
H224
WB
CR1B4
CR1B6
Club
Shooting Range
Water Tower
Mast
FB
ETL
Track
Def
Lay-by
1.22m RH
UA & CP Bdy
134.1m
133.2m
132.0m
131.4m
130.4m
129.8m
CR2aB1
CR2aB2
CR2aB3.1
CR2aB4
CR2aB5
CR2aB6
CR2aB7
CR1bB15
CR1bB12.2
CR1bB12.3
CR1bB16
CR1bB17
CR1bB18
CR1bB19
CR1bB20
CR1bB21
CR1bB22
Teacaddy Farm
Wind Pump
Silo
Yeoman Farm
Sywell Grange
Sywell Aerodrome
Sywell Lodge Farm
Thistledown Barn
Wind Turbine
Solar Panels
Wind Sock
Issues
CB1
CB2
CB3
CB6
CB7
Woodlodge Farm
116.4m
114.9m
WELLINGBOROUGH ROAD

Island GREEN POWER

Lanpro

Key

- 🟥 Order Limits
- ⬜ Sheet Index
- ⋀⋀⋀⋀ Important Hedgerow
- ⋀⋀⋀⋀ Hedgerow

Layers: Lanpro, 2025; IGP, 2025

Base map: Reproduced from Ordnance Survey digital map data © Crown copyright 2025. All rights reserved. License number 0100031673

0 100 200 300 Meters

Scale: 1:2,500@ A0

APFP Regulation: 5(2)(q)	Application Doc No. EX3/GH2.11_B
Ref: P3535_LPR_ZZ_XX_DR_Z_0280	Date: 15/12/2025
Drawn by: BH	Checked by: JC

Important Hedgerows Plan

Sheet 5 of 18

Revision B

GREEN HILL SOLAR FARM

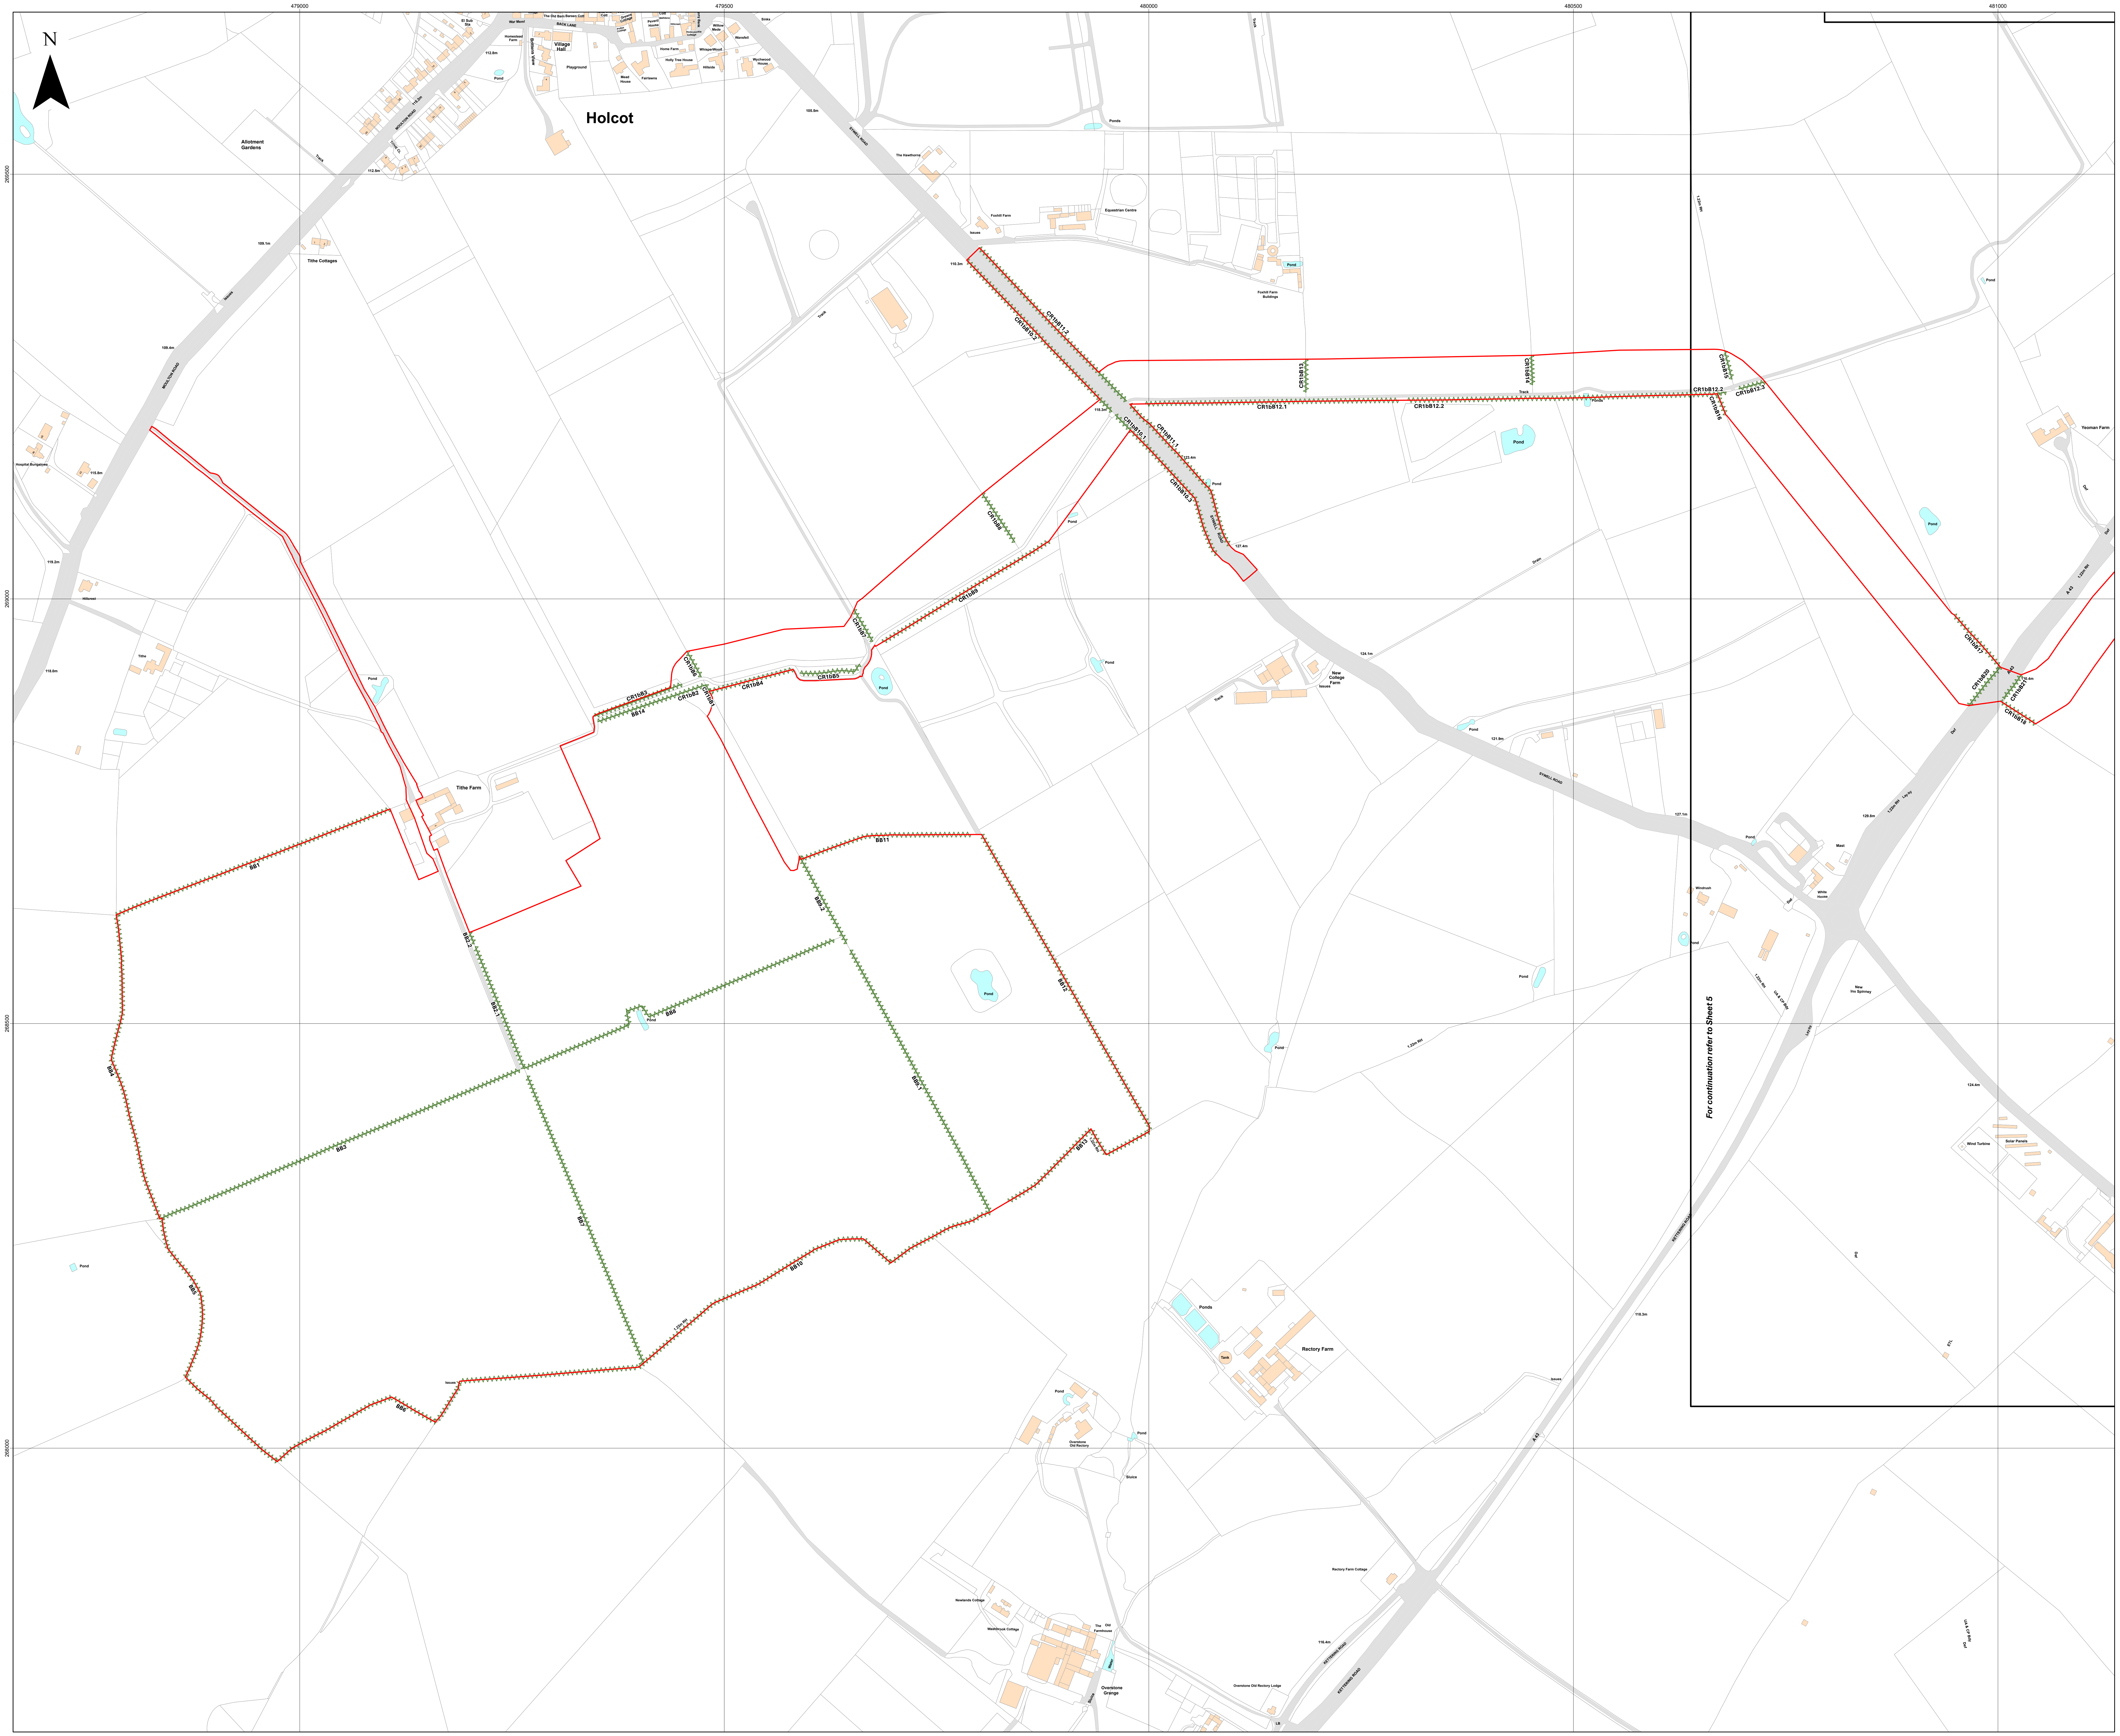
479000
479500
480000
480500
481000
N
Holcot
Allotment Gardens
Tithe Cottages
Tithe Farm
Foxhill Farm
Equestrian Centre
Foxhill Farm Buildings
Yeoman Farm
New College Farm
Issues
Rectory Farm
Ponds
Overstone Old Rectory
Sluice
Overstone Grange
Pond
Track
Drain
SYWELL ROAD
A 43
110.3m
118.3m
123.4m
127.4m
124.1m
121.9m
127.1m
129.8m
130.4m
CR1bB1
CR1bB2
CR1bB3
CR1bB4
CR1bB5
CR1bB6
CR1bB7
CR1bB8
CR1bB9
CR1bB10.1
CR1bB10.2
CR1bB10.3
CR1bB11.1
CR1bB11.2
CR1bB12.1
CR1bB12.2
CR1bB12.3
CR1bB13
CR1bB14
CR1bB15
CR1bB16
CR1bB17
CR1bB18
CR1bB20
CR1bB21
BB1
BB2.1
BB2.2
BB3
BB4
BB5
BB6
BB7
BB8
BB9.1
BB9.2
BB10
BB11
BB12
BB13
BB14
For continuation refer to Sheet 5

Island GREEN POWER

Lanpro

Key

🟥	Order Limits
▭	Sheet Index
⋀⋀⋀⋀	Important Hedgerow

Layers: Lanpro, 2025; IGP, 2025
Base map: Reproduced from Ordnance Survey digital map data © Crown copyright 2025. All rights reserved. License number 0100031673

0 100 200 300 Meters

Scale: 1:2,500@ A0

APFP Regulation: 5(2)(q)	Application Doc No. EX3/GH2.11_B
Ref: P3535_LPR_ZZ_XX_DR_Z_0280	Date: 15/12/2025
Drawn by: BH	Checked by: JC

Important Hedgerows Plan

Sheet 6 of 18
Revision B

GREEN HILL SOLAR FARM

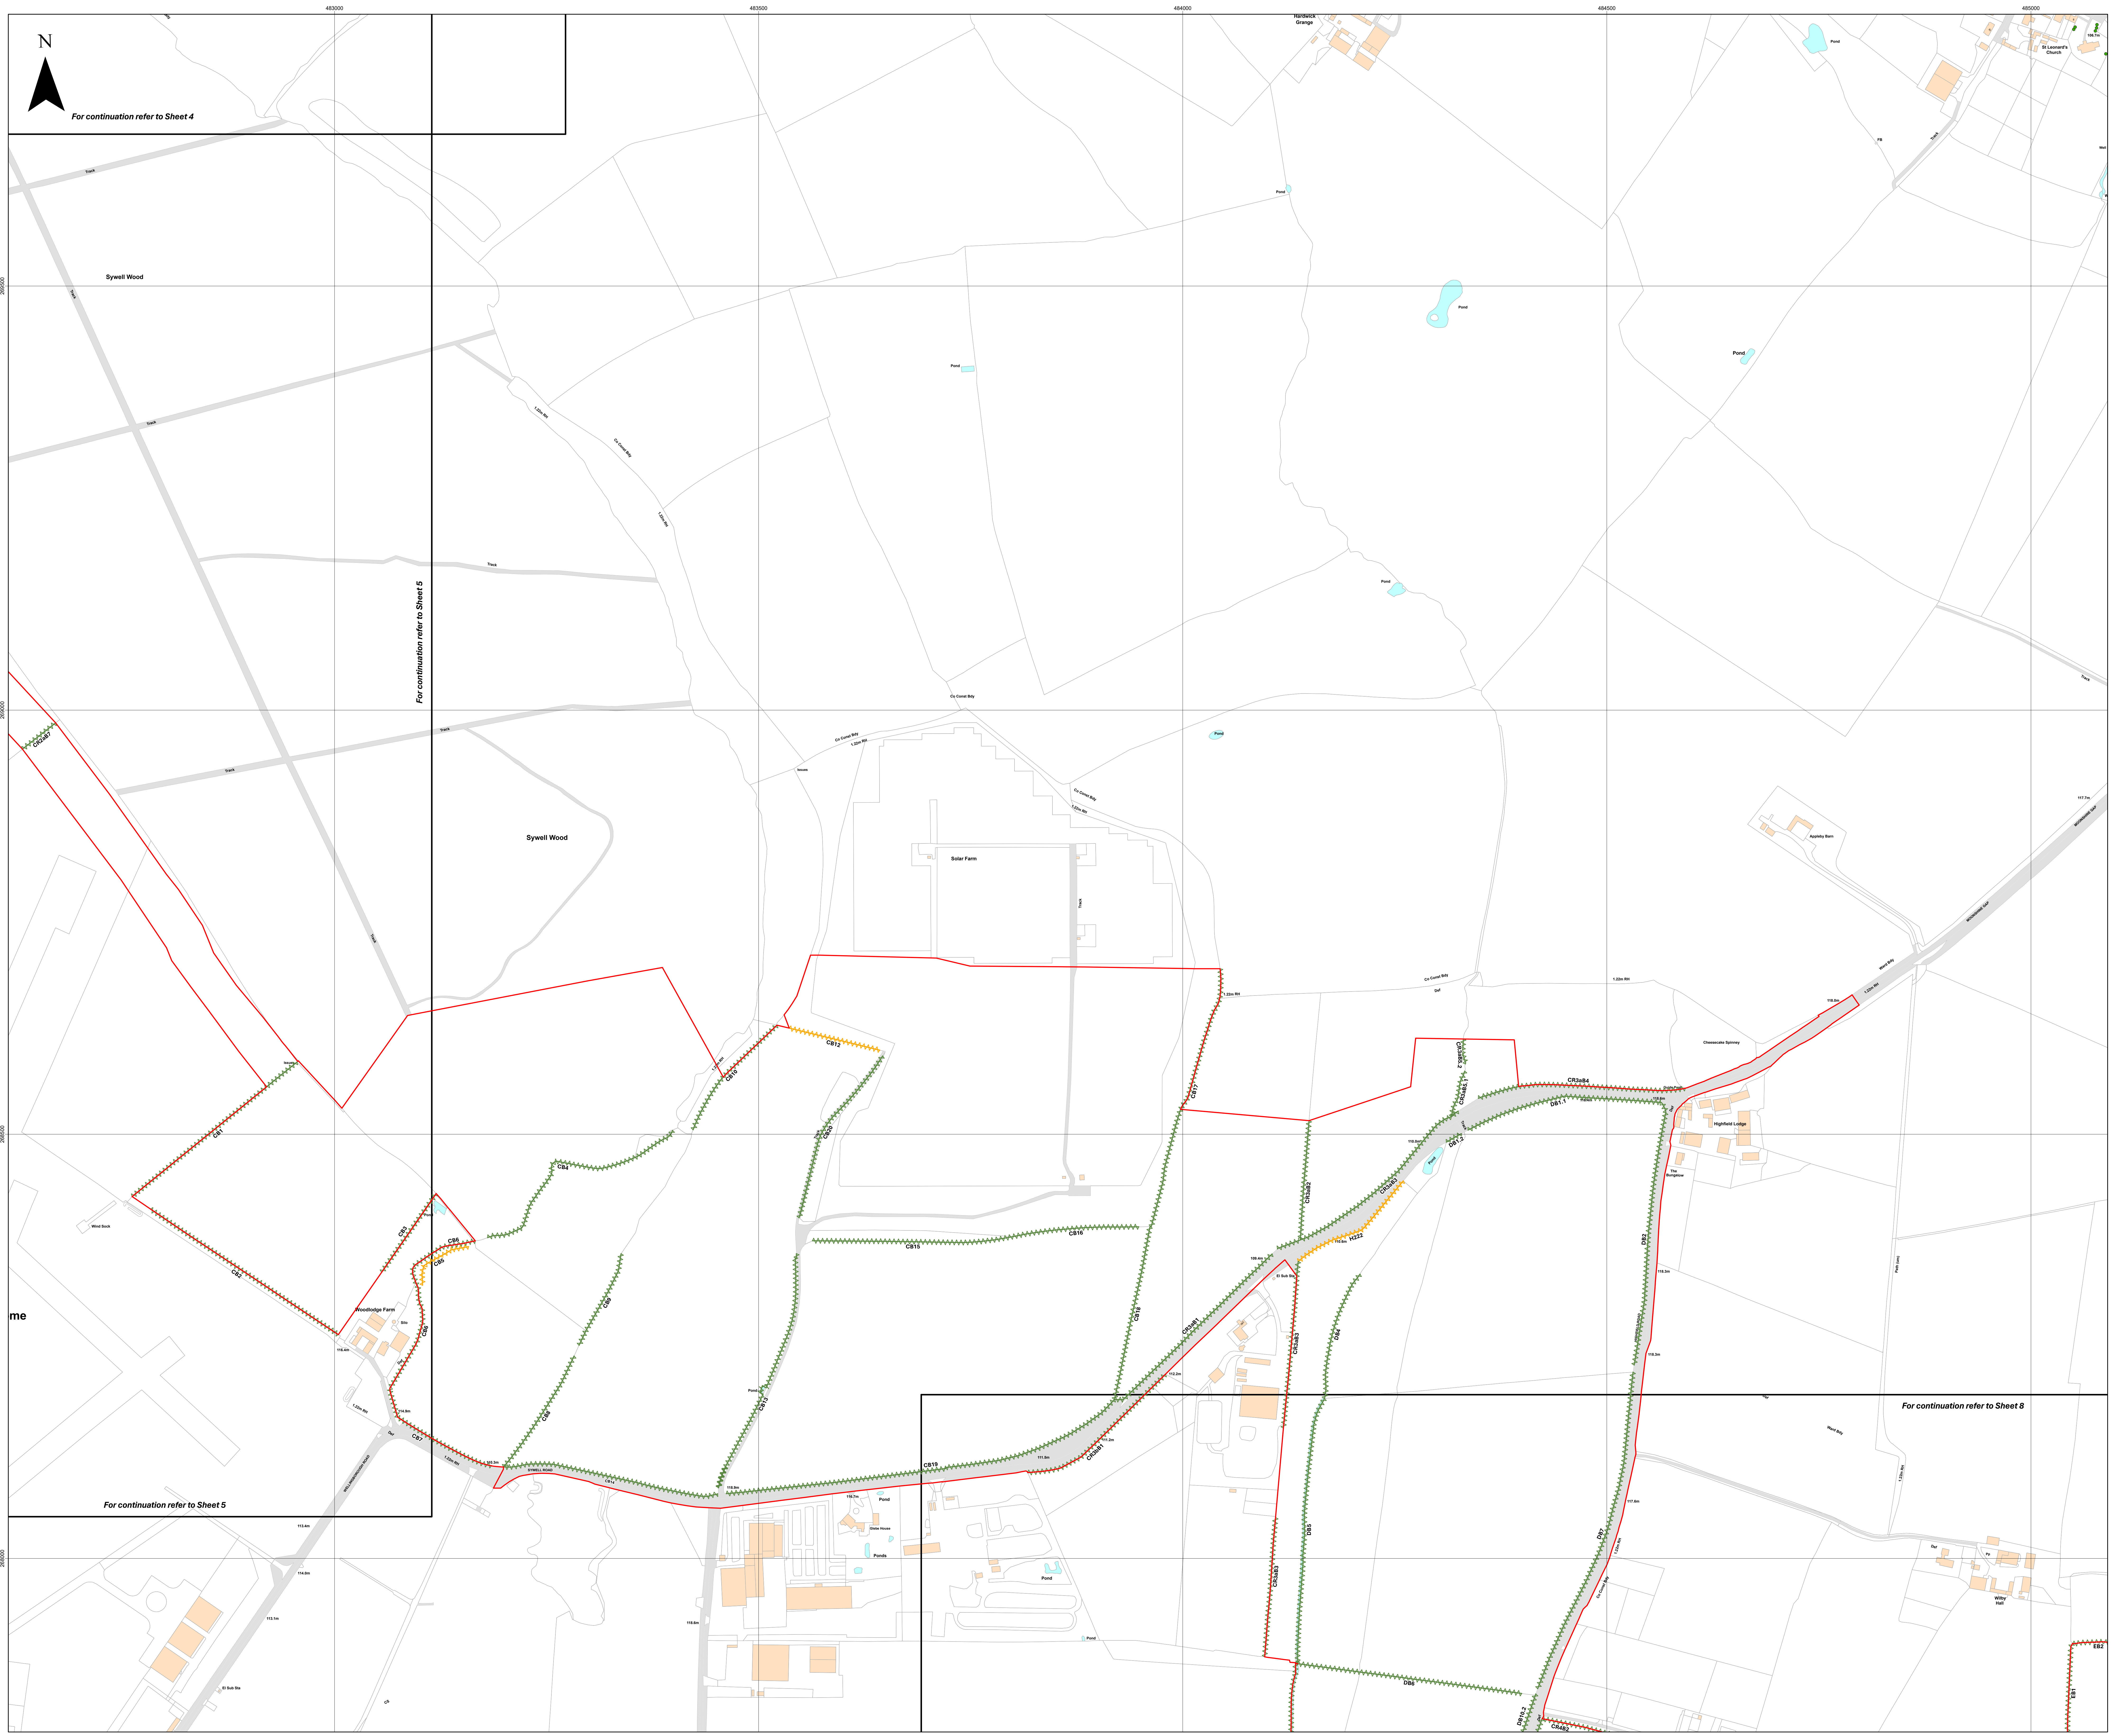
N
483000
483500
484000
484500
485000
269500
269000
268500
268000
For continuation refer to Sheet 4
For continuation refer to Sheet 5
For continuation refer to Sheet 5
For continuation refer to Sheet 8
Hardwick Grange
St Leonard's Church
Sywell Wood
Sywell Wood
Track
Solar Farm
Pond
Co Const Bdy
Def
1.22m RH
Cheesecake Spinney
Appleby Barn
Highfield Lodge
The Bungalow
Guide Post
HIGHFIELD ROAD
Woodlodge Farm
Silo
Wind Sock
Issue
WELLINGBOROUGH ROAD
SYWELL ROAD
El Sub Sta
Wilby Hall
CR3aB7
CB1
CB2
CB3
CB4
CB5
CB6
CB7
CB8
CB9
CB10
CB12
CB13
CB14
CB15
CB16
CB17
CB18
CB19
CR3aB1
CR3aB2
CR3aB3
CR3aB4
CR3aB5.1
CR3aB5.2
H222
DB1.1
DB1.2
DB2
DB3
DB4
DB5
DB6
EB1
EB2
109.4m
110.0m
110.3m
110.6m
112.2m
113.4m
114.0m
114.9m
116.4m
118.3m
118.6m
118.9m

Key

- 🟥 Order Limits
- ▭ Sheet Index
- Important Hedgerow
- Hedgerow

Tree Protection Order (TPO)

- ● Points

Layers: Lanpro, 2025; IGP, 2025

Base map: Reproduced from Ordnance Survey digital map data © Crown copyright 2025. All rights reserved. License number 0100031673

0 100 200 300 Meters

Scale: 1:2,500@ A0

APFP Regulation: 5(2)(q)	Application Doc No. EX3/GH2.11_B
Ref: P3535_LPR_ZZ_XX_DR_Z_0280	Date: 15/12/2025
Drawn by: BH	Checked by: JC

Important Hedgerows Plan

Sheet 7 of 18

Revision B

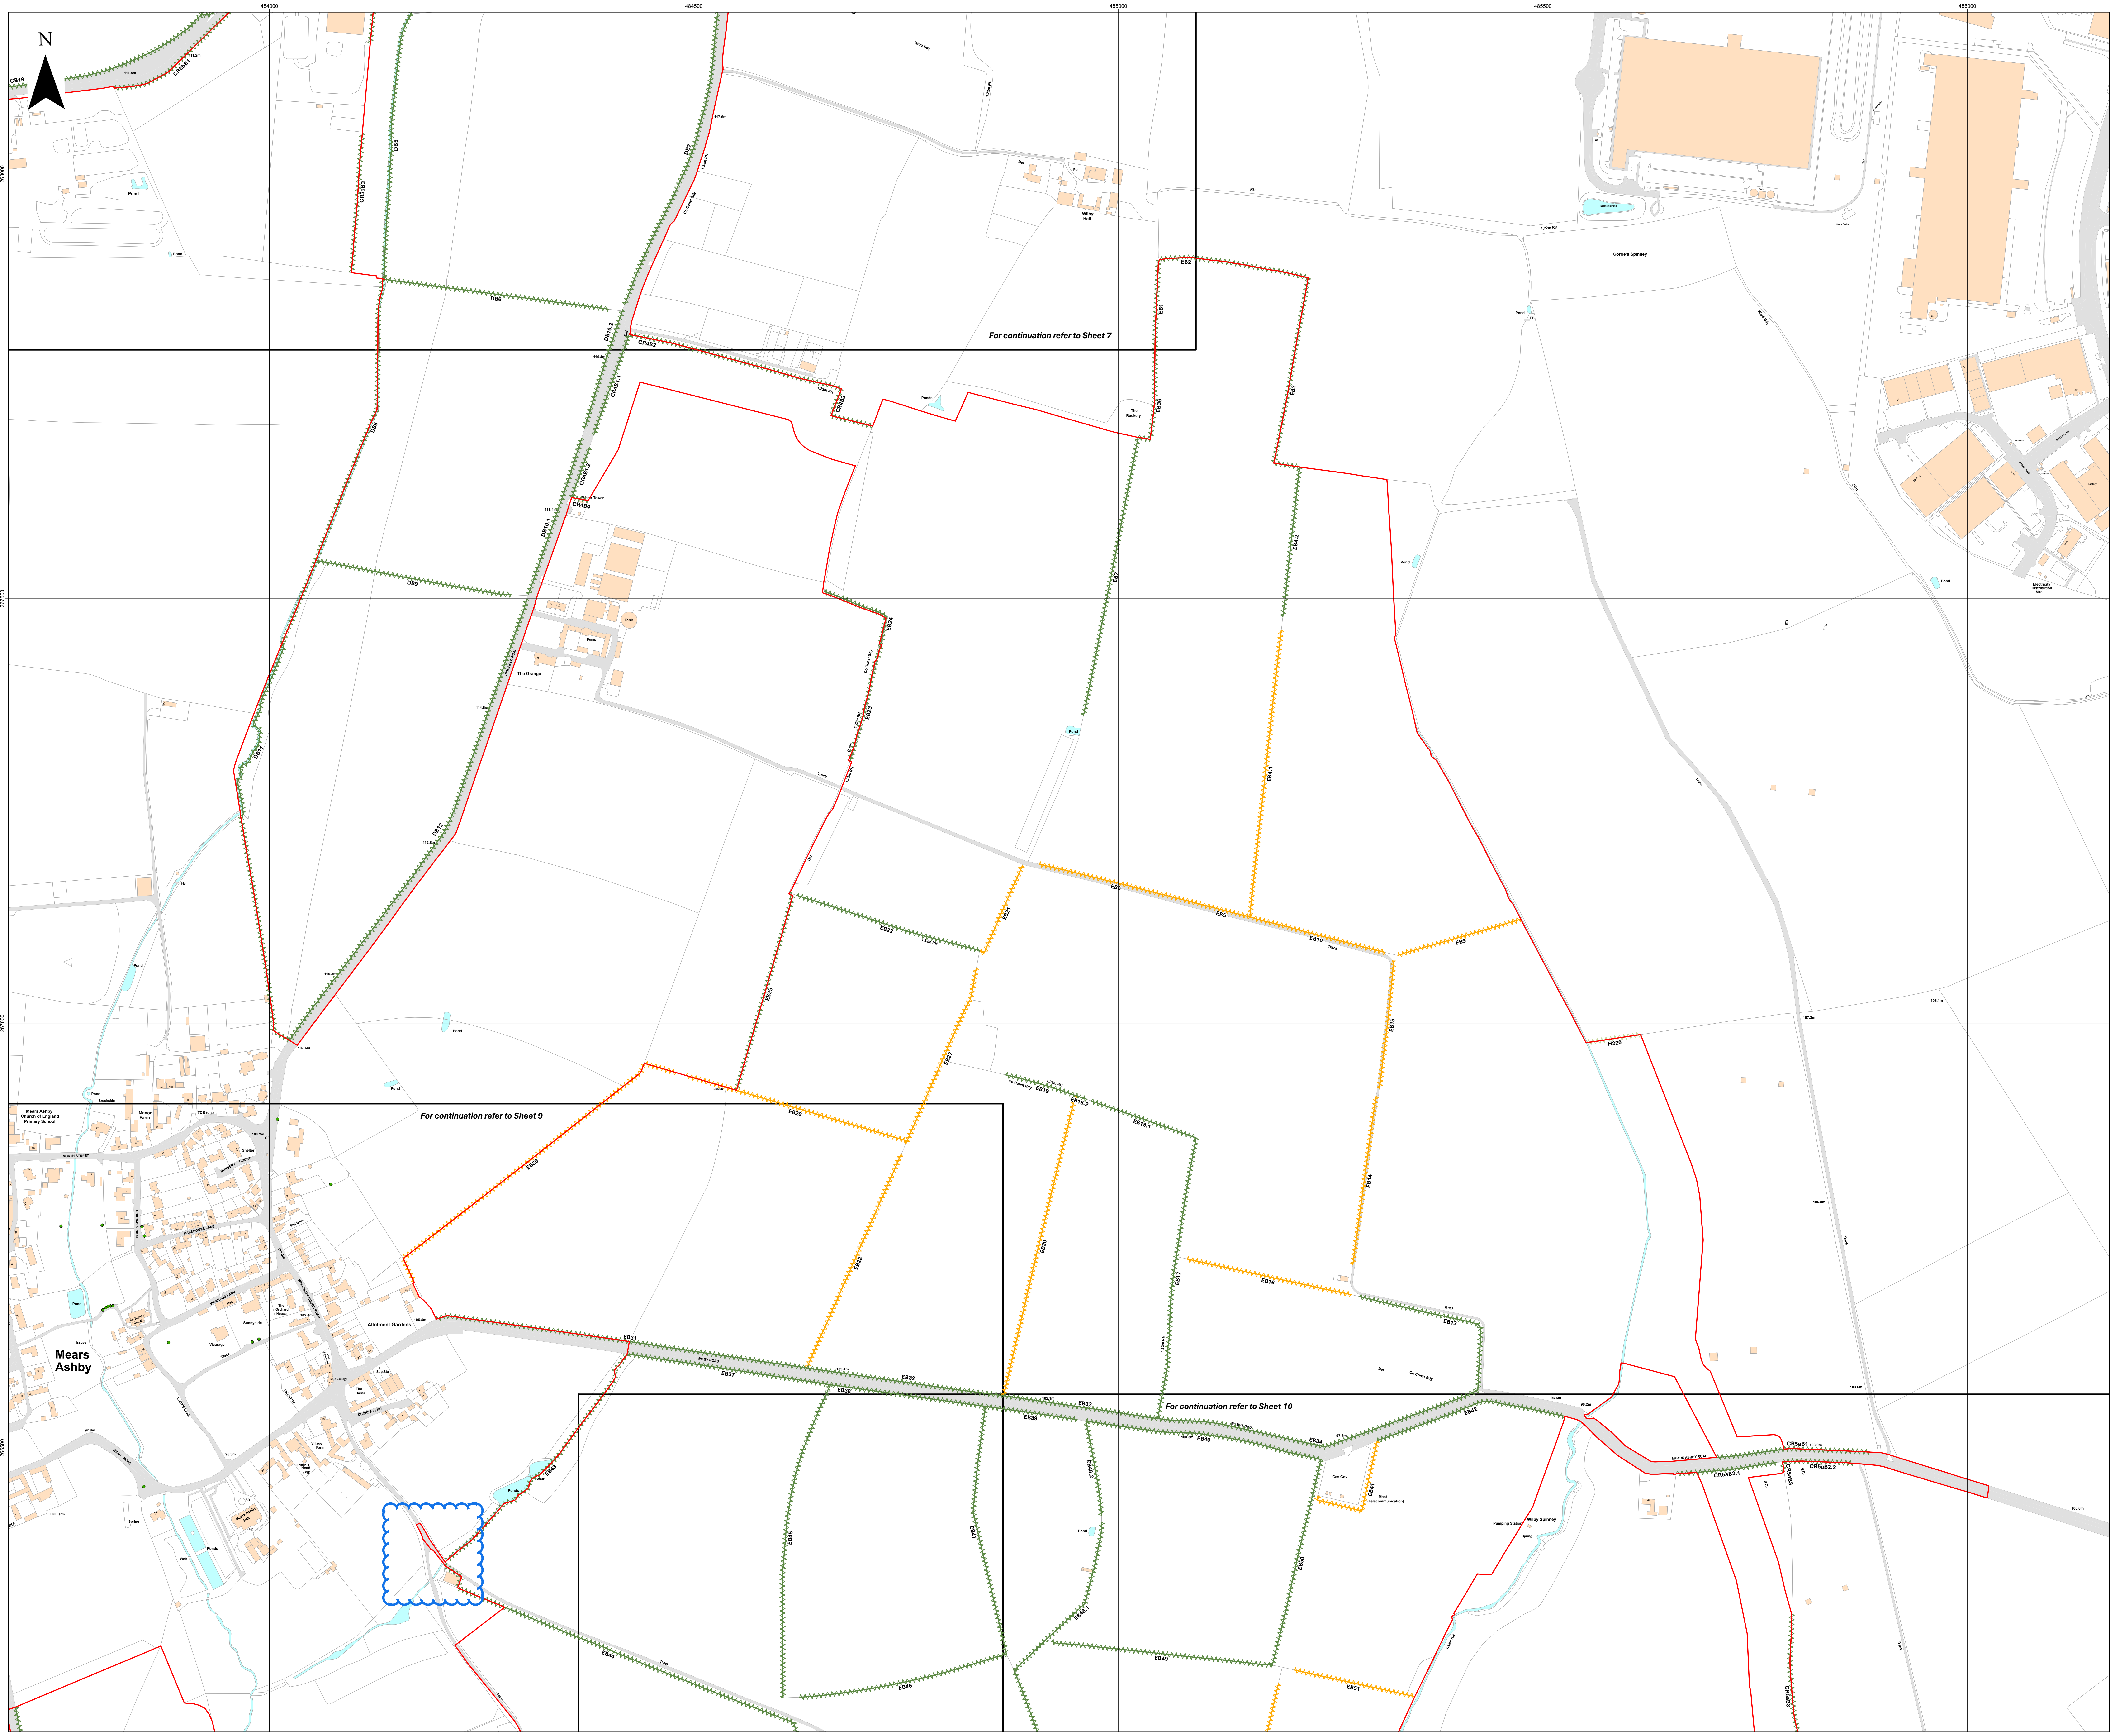
N
484000
484500
485000
485500
486000
268000
267500
267000
266500
For continuation refer to Sheet 7
For continuation refer to Sheet 9
For continuation refer to Sheet 10
Mears Ashby
Mears Ashby Church of England Primary School
Manor Farm
NORTH STREET
Allotment Gardens
The Grange
Wilby Hall
Corrie's Spinney
Wilby Spinney
Pumping Station
Electricity Distribution Site
Pond
H220
CRSaB1
CRSaB2
CRSaB2.1
CRSaB2.2
CR4B2
CR4B4
EB1
EB2
EB3
EB4.1
EB4.2
EB5
EB6
EB8
EB9
EB10
EB13
EB14
EB15
EB16
EB16.1
EB16.2
EB17
EB18
EB20
EB21
EB22
EB23
EB24
EB25
EB26
EB27
EB28
EB29
EB30
EB31
EB32
EB33
EB34
EB36
EB37
EB39
EB40
EB41
EB42
EB44
EB46
EB49
EB51
DB5
DB6
DB7
DB8
DB9
DB11
DB12
DB10.1
DB10.2
CB19

Key

- 🟥 Order Limits
- ▭ Sheet Index
- Important Hedgerow
- Potentially Important Hedgerow
- Hedgerow

Tree Protection Order (TPO)

- ● Points

Layers: Lanpro, 2025; IGP, 2025
Base map: Reproduced from Ordnance Survey digital map data © Crown copyright 2025. All rights reserved. License number 0100031673

0 100 200 300 Meters

Scale: 1:2,500@ A0

APFP Regulation: 5(2)(q)	Application Doc No. EX3/GH2.11_B
Ref: P3535_LPR_ZZ_XX_DR_Z_0280	Date: 15/12/2025
Drawn by: BH	Checked by: JC

Important Hedgerows Plan

Sheet 8 of 18
Revision B

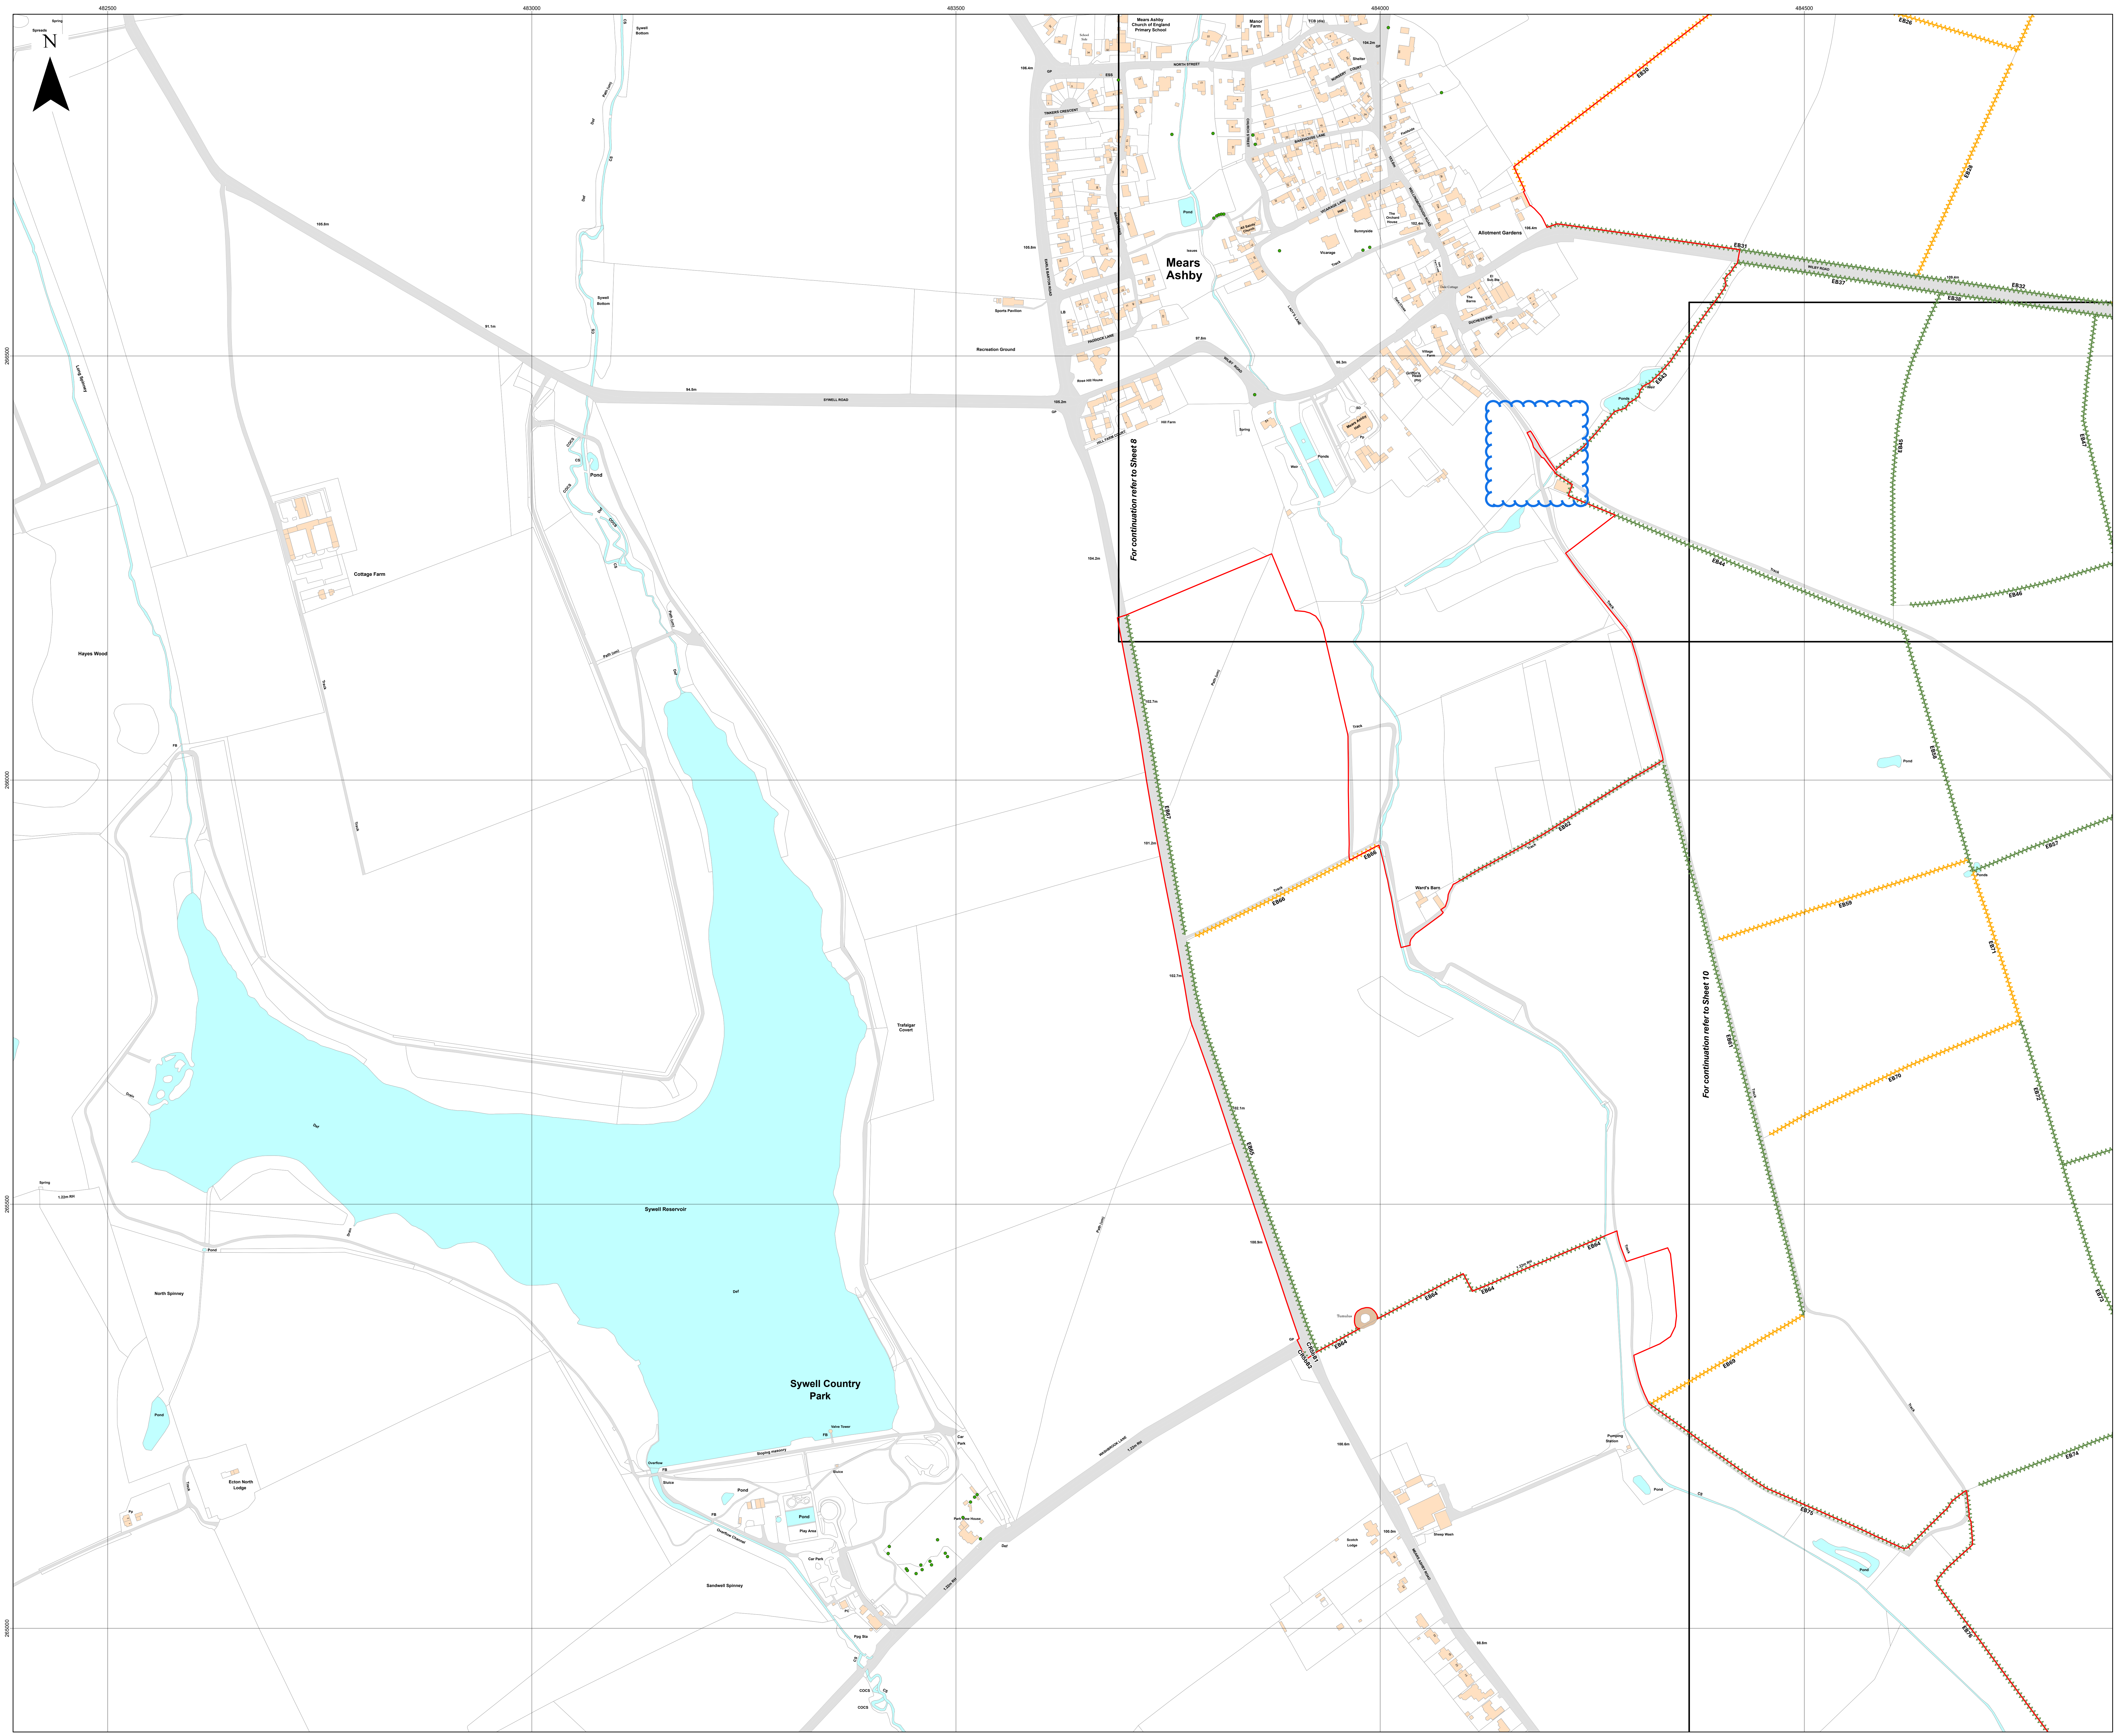
N
482500
483000
483500
484000
484500
Mears Ashby
Sywell Country Park
Sywell Reservoir
Cottage Farm
Hayes Wood
North Spinney
Ecton North Lodge
Sandwell Spinney
Trafalgar Covert
Ward's Barn
Recreation Ground
Sports Pavilion
Allotment Gardens
Pond
For continuation refer to Sheet 8
For continuation refer to Sheet 10

Key

- 🟥 Order Limits
- ▭ Sheet Index
- Important Hedgerow
- Hedgerow

Tree Protection Order (TPO)

- ● Points

Layers: Lanpro, 2025; IGP, 2025
Base map: Reproduced from Ordnance Survey digital map data © Crown copyright 2025. All rights reserved. License number 0100031673

0 100 200 300 Meters

Scale: 1:2,500@ A0

APFP Regulation: 5(2)(q)	Application Doc No. EX3/GH2.11_B
Ref: P3535_LPR_ZZ_XX_DR_Z_0280	Date: 15/12/2025
Drawn by: BH	Checked by: JC

Important Hedgerows Plan

Sheet 9 of 18
Revision B

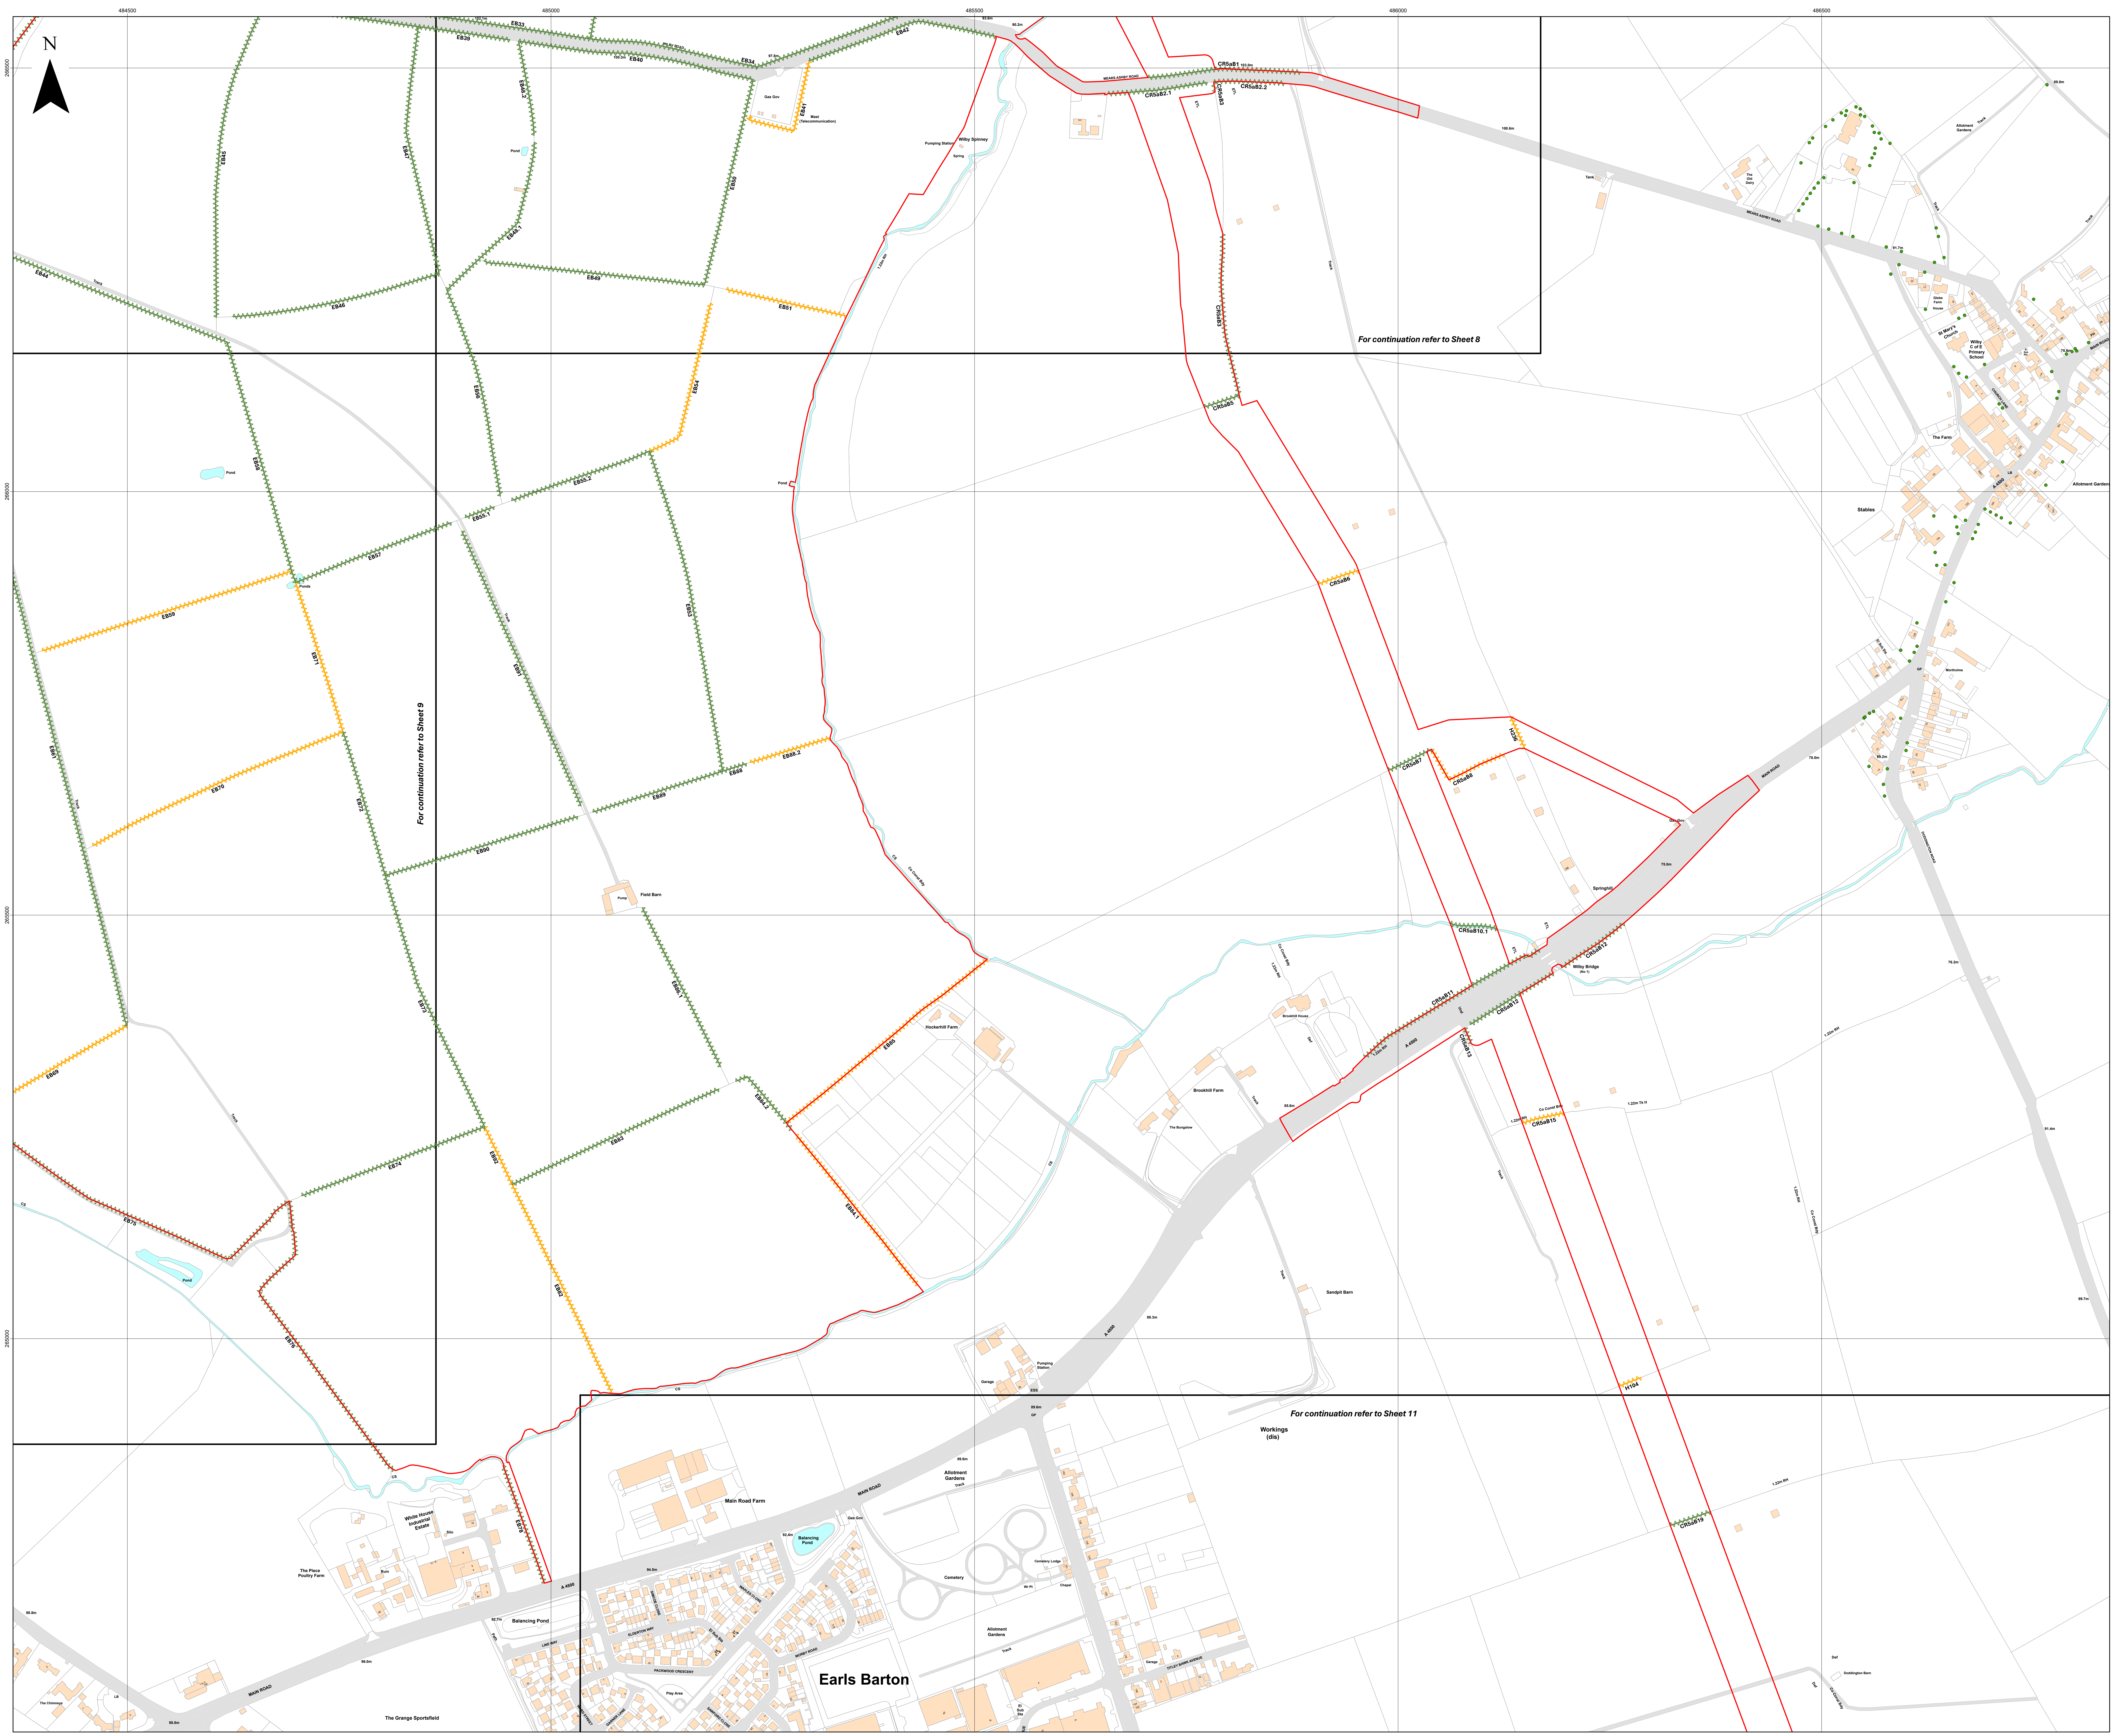
N
484500
485000
485500
486000
486500
266500
266000
265500
265000
EB33
EB34
EB39
EB40
EB41
EB42
EB44
EB45
EB46
EB47
EB48.1
EB48.2
EB49
EB50
EB51
EB53
EB54
EB55.1
EB55.2
EB56
EB57
EB58
EB59
EB61
EB69
EB70
EB71
EB72
EB73
EB74
EB75
EB76
EB78
EB82
EB83
EB84.1
EB84.2
EB85
EB86.1
EB88
EB88.2
EB89
EB90
EB91
EB92
WILBY ROAD
Gas Gov
Mast (Telecommunication)
Pond
Ponds
Track
Field Barn
Pump
Hockerhill Farm
For continuation refer to Sheet 9
White House Industrial Estate
Silo
CS
Co Const Bdy
1.22m RH
MEARS ASHBY ROAD
CR5aB1
CR5aB2.1
CR5aB2.2
CR5aB3
CR5aB5
CR5aB6
CR5aB7
CR5aB8
CR5aB10.1
CR5aB11
CR5aB12
CR5aB13
CR5aB15
CR5aB19
H236
H104
ETL
Wilby Spinney
Pumping Station
Spring
Tank
For continuation refer to Sheet 8
Springhill
Gas Gov
MAIN ROAD
Wilby Bridge (No 1)
Brookhill House
Brookhill Farm
The Bungalow
A 4500
Und
Def
Sandpit Barn
1.22m Tk H
For continuation refer to Sheet 11
Workings (dis)
Main Road Farm
Balancing Pond
Allotment Gardens
Cemetery
Garage
TITLEY BAWK AVENUE
Doddington Barn
The Place Poultry Farm
The Grange Sportsfield
Earls Barton
Stables
The Farm
Allotment Gardens
93.6m
90.2m
103.0m
100.6m
102.1m
100.3m
97.8m
78.0m
75.0m
85.6m
89.3m
89.6m
92.4m
91.4m
99.7m

Island GREEN POWER

Lanpro

Key

- 🟥 Order Limits
- ▭ Sheet Index
- Important Hedgerow
- Hedgerow

Tree Protection Order (TPO)

- ● Points

Layers: Lanpro, 2025; IGP, 2025
Base map: Reproduced from Ordnance Survey digital map data © Crown copyright 2025. All rights reserved. License number 0100031673

0 100 200 300 Meters

Scale: 1:2,500@ A0

APFP Regulation: 5(2)(q)	Application Doc No. EX3/GH2.11_B
Ref: P3535_LPR_ZZ_XX_DR_Z_0280	Date: 15/12/2025
Drawn by: BH	Checked by: JC

Important Hedgerows Plan

Sheet 10 of 18
Revision B

GREEN HILL
SOLAR FARM

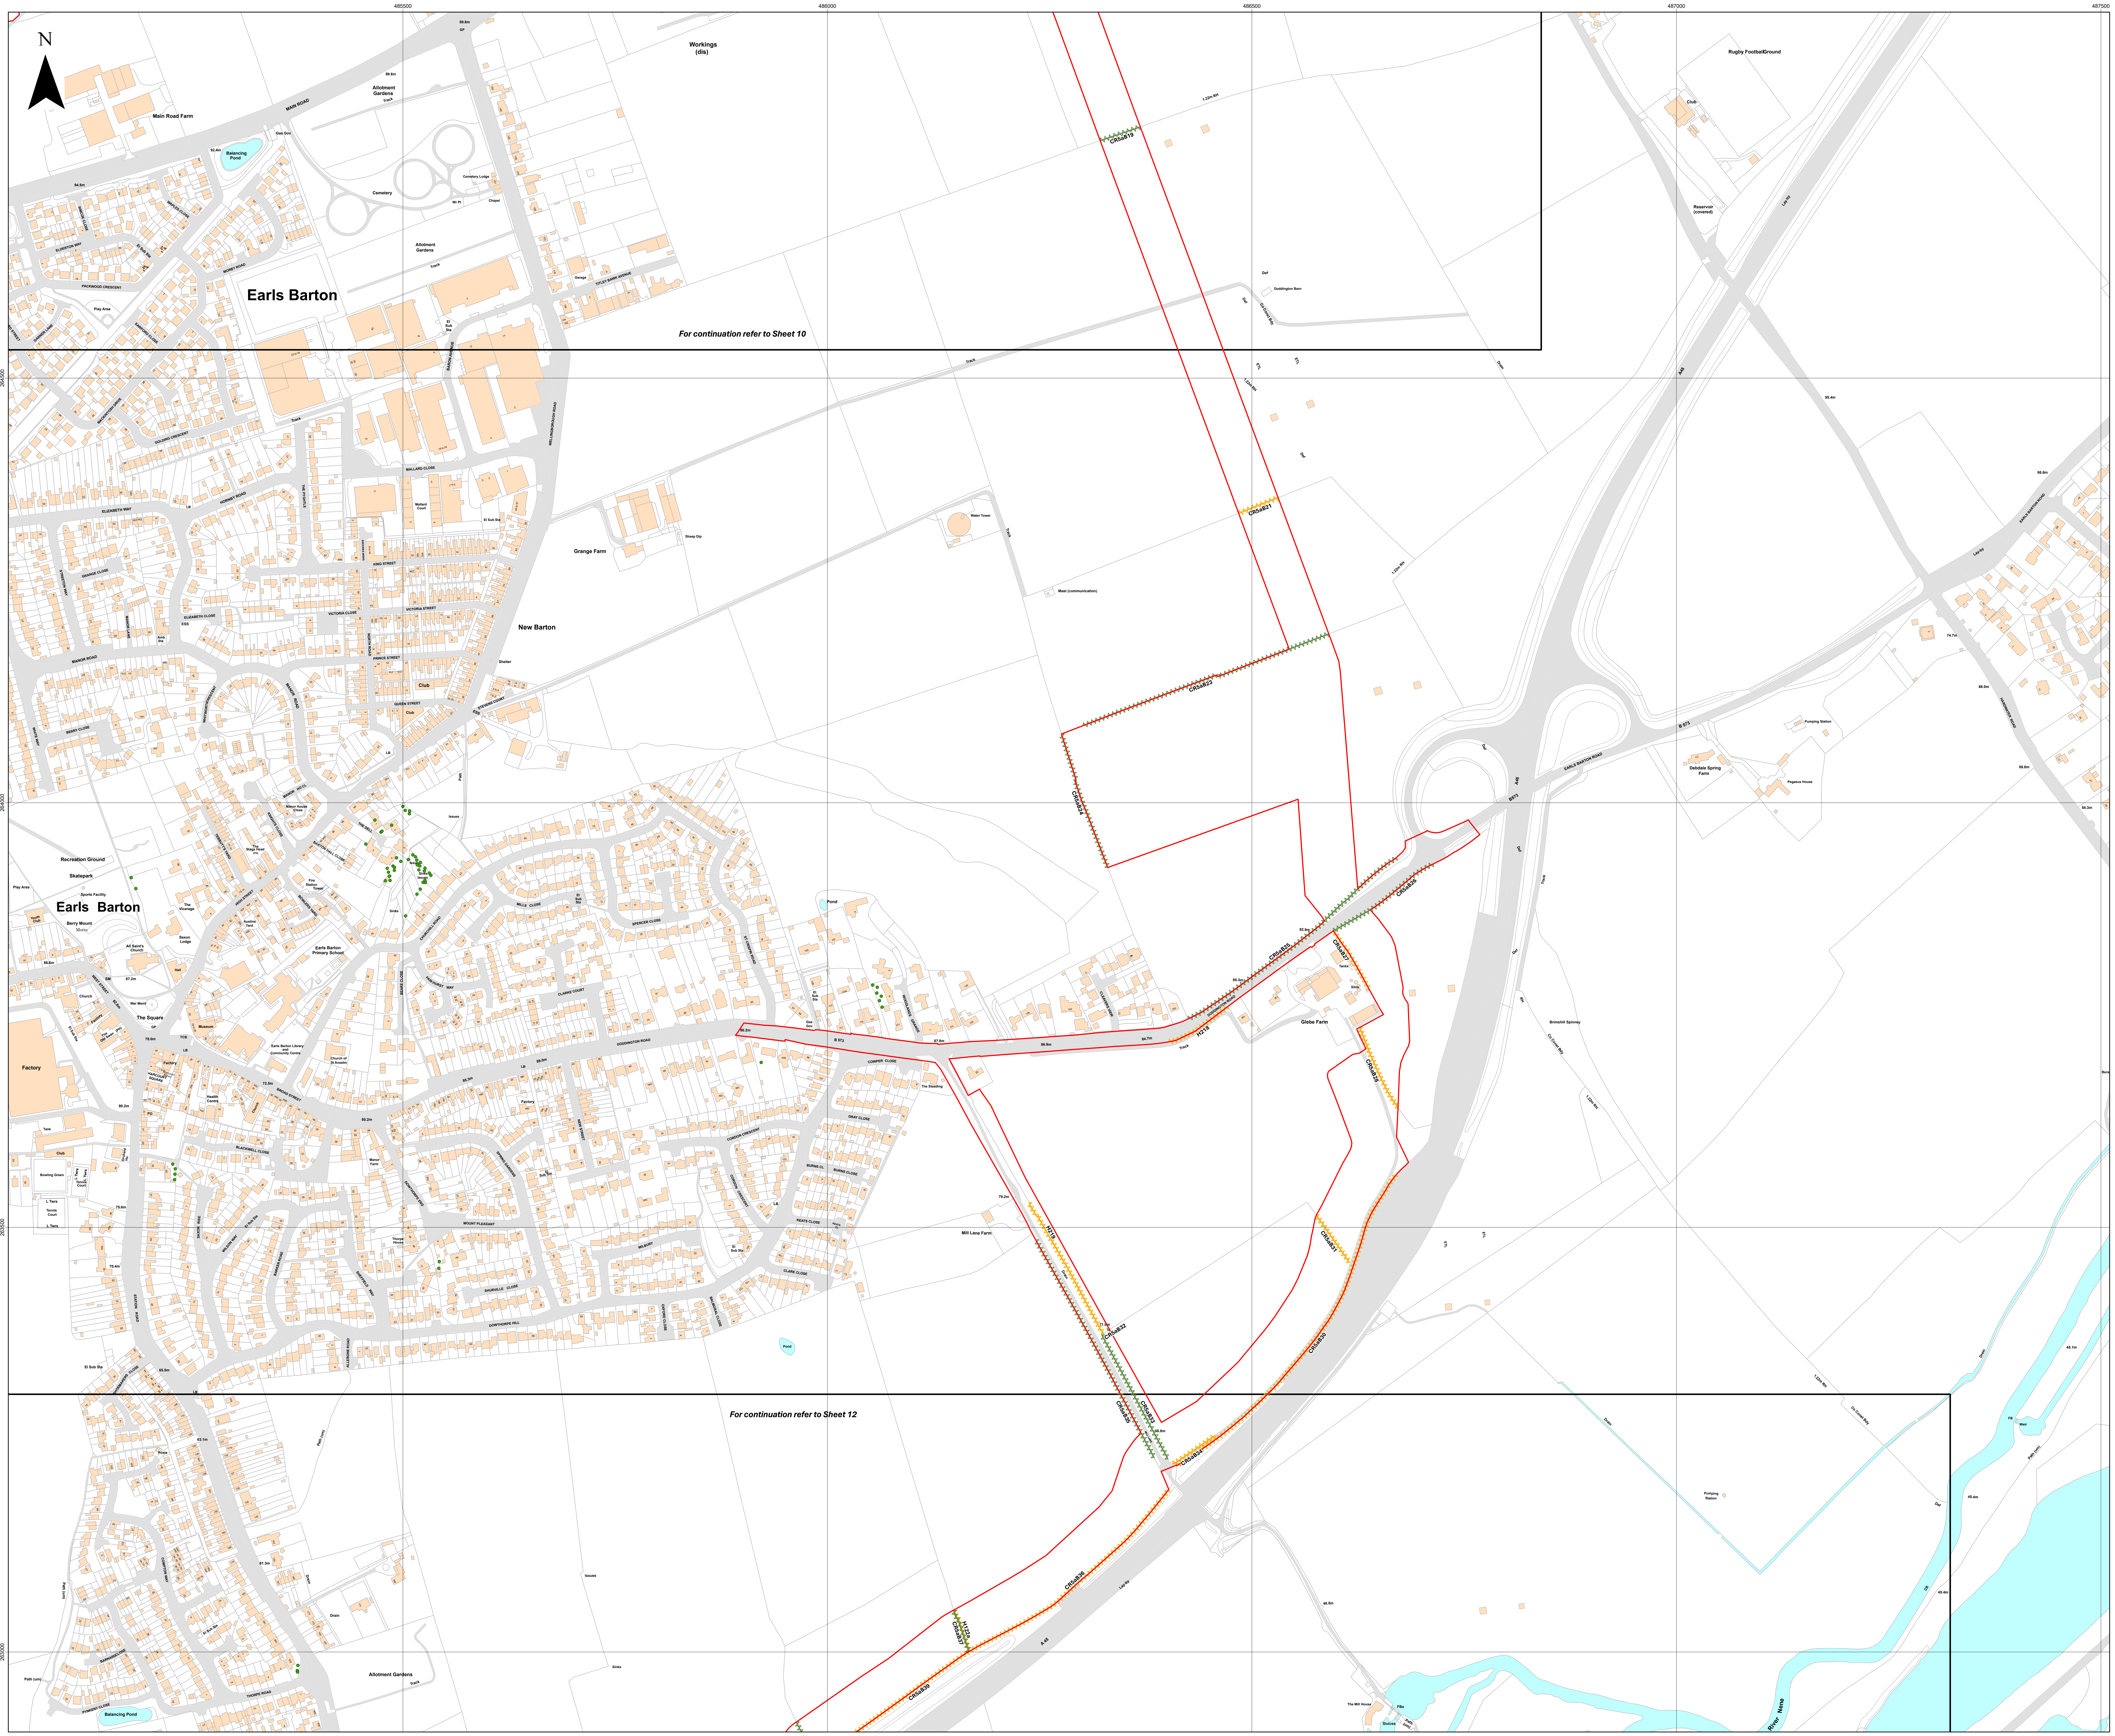
N
485500
486000
486500
487000
487500
Earls Barton
New Barton
Grange Farm
Glebe Farm
Mill Lane Farm
Mast (communication)
DODDINGTON ROAD
MILL LANE
CLEAVERS VIEW
A45
B573
Lay-by
River Nene
For continuation refer to Sheet 10
For continuation refer to Sheet 12
CR5aB19
CR5aB21
CR5aB23
CR5aB24
CR5aB25
CR5aB26
CR5aB27
CR5aB28
H218
H219
CR5aB30
CR5aB31
CR5aB32
CR5aB33
CR5aB34
CR5aB35
CR5aB36
H122a
CR5aB37
CR5aB39

Key

- 🟥 Order Limits
- ☐ Sheet Index
- ⩘⩘⩘ Important Hedgerow
- ⩘⩘⩘ Hedgerow

Tree Protection Order (TPO)

- ● Points

Layers: Lanpro, 2025; IGP, 2025
Base map: Reproduced from Ordnance Survey digital map data © Crown copyright 2025. All rights reserved. License number 0100031673

0 100 200 300 Meters

Scale: 1:2,500@ A0

APFP Regulation: 5(2)(q)	Application Doc No. EX3/GH2.11_B
Ref: P3535_LPR_ZZ_XX_DR_Z_0280	Date: 15/12/2025
Drawn by: BH	Checked by: JC

Important Hedgerows Plan

Sheet 11 of 18
Revision B

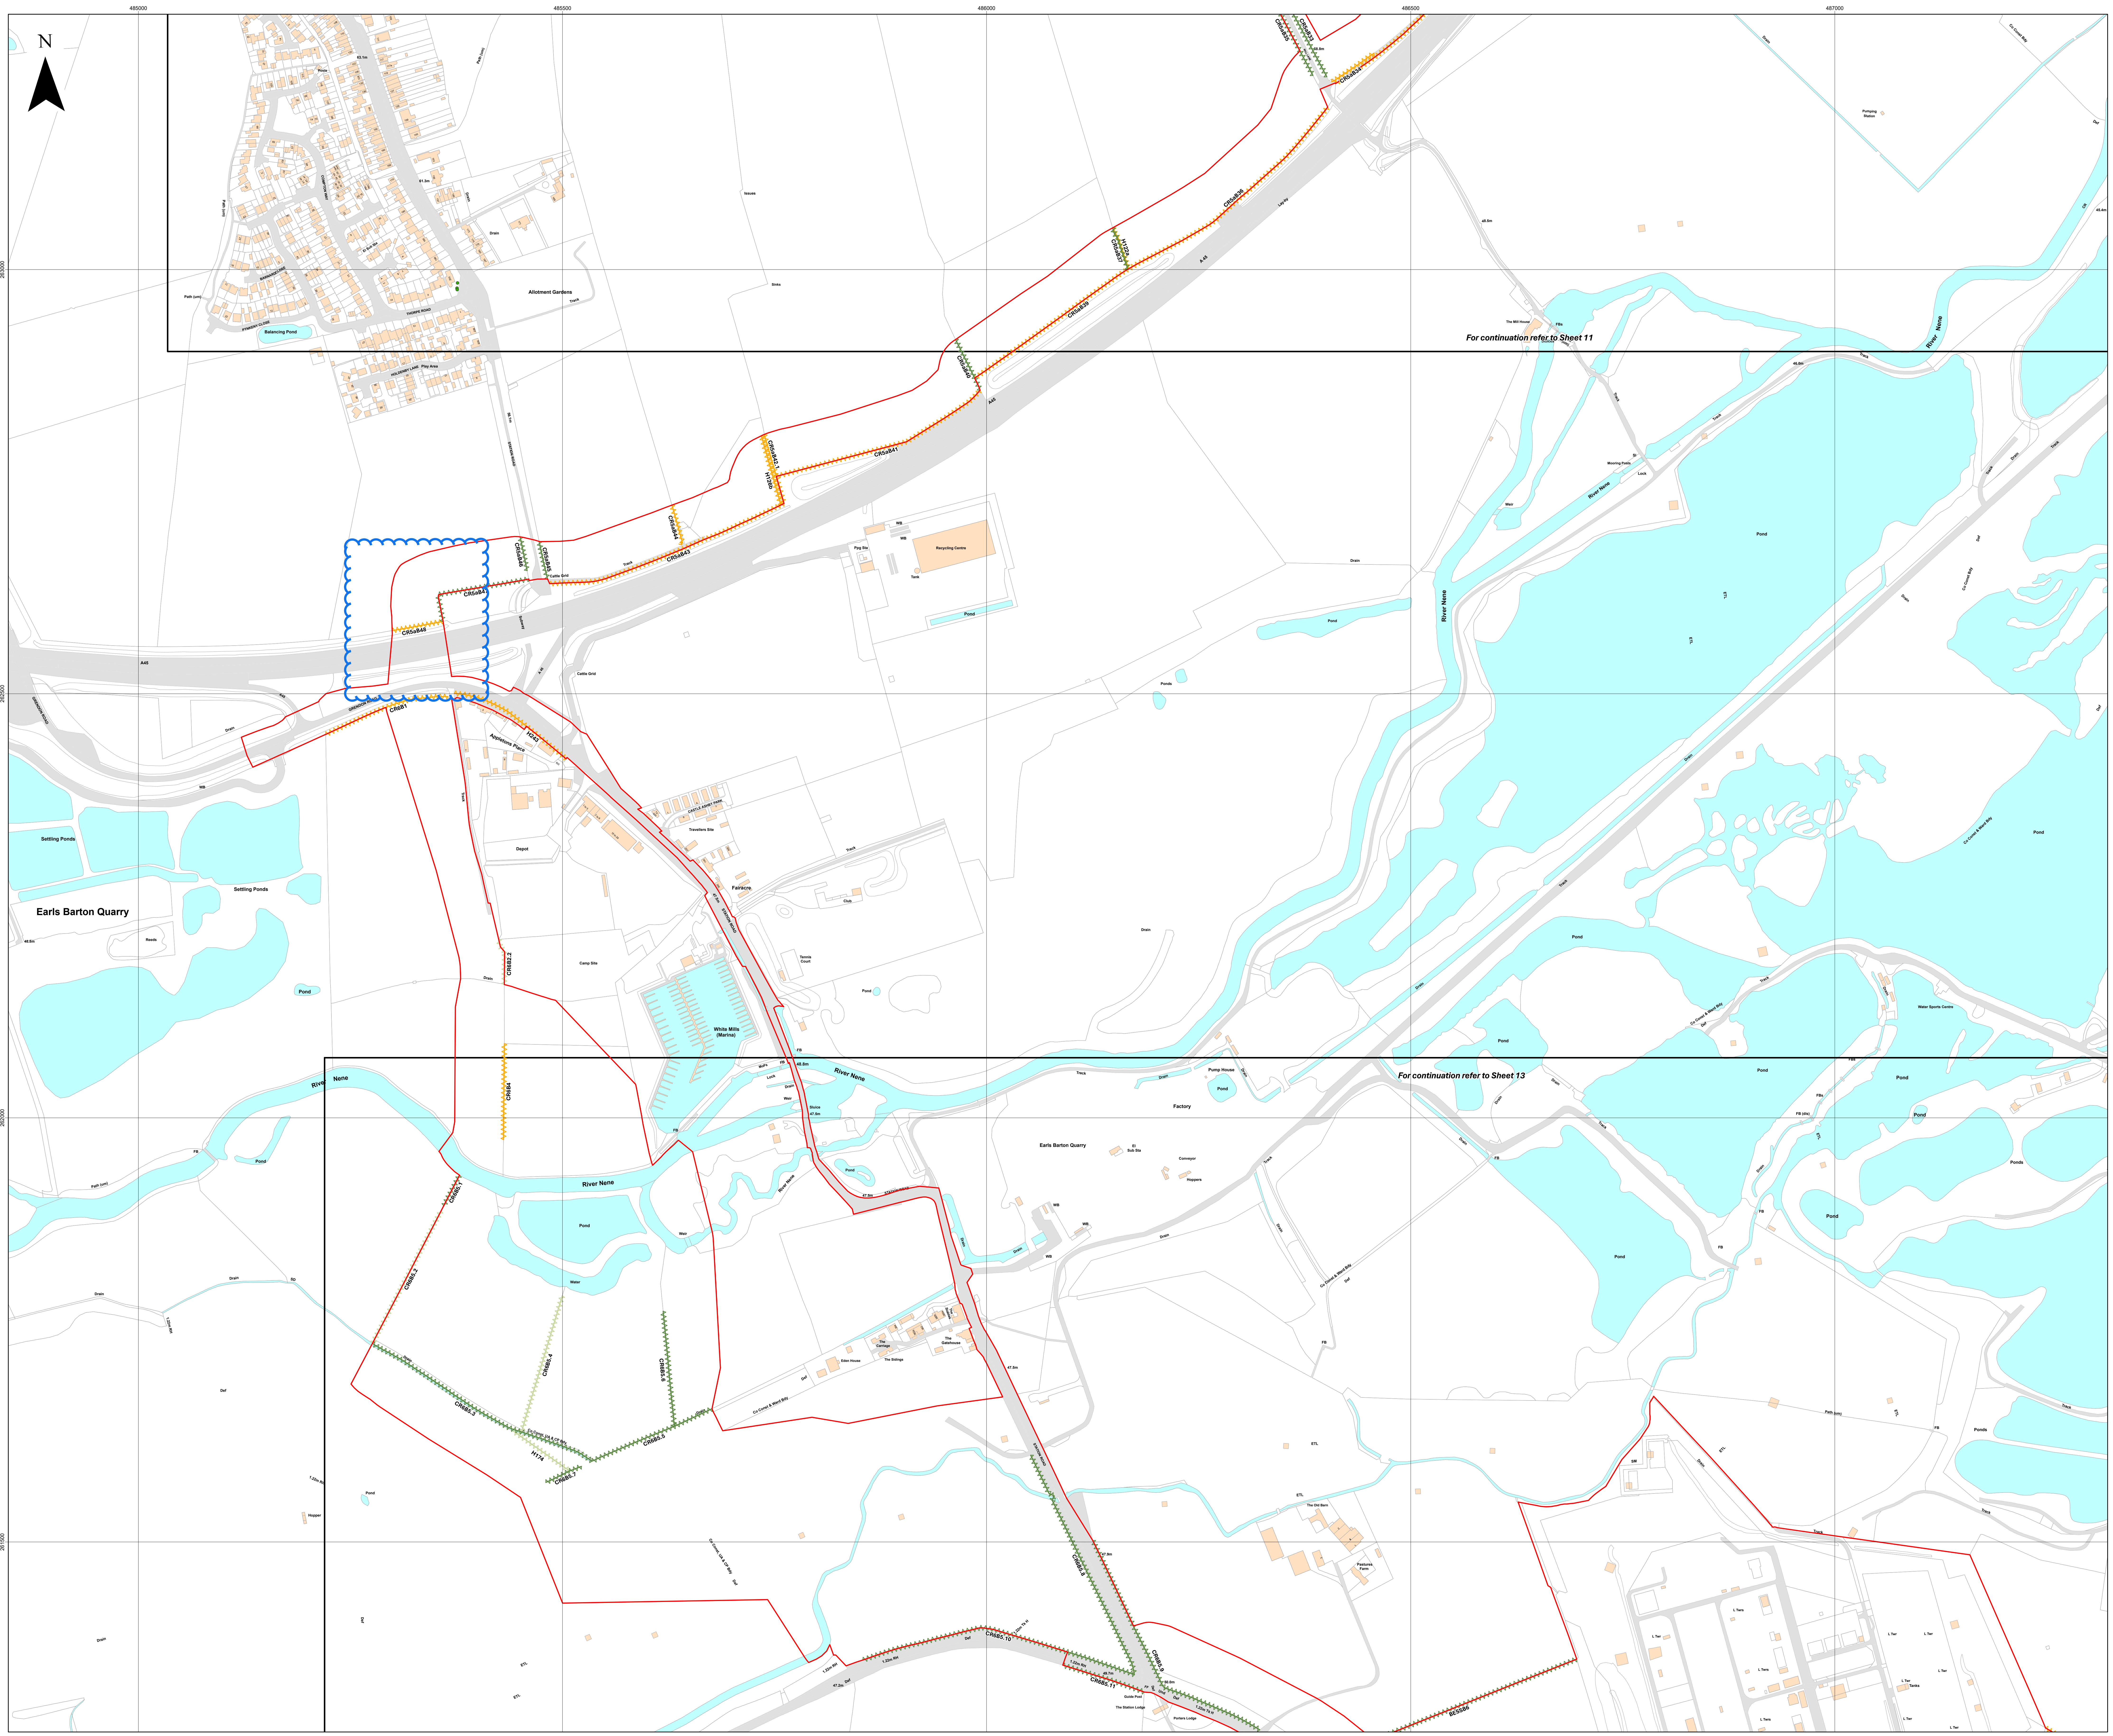
N
485000
485500
486000
486500
487000
For continuation refer to Sheet 11
For continuation refer to Sheet 13
Earls Barton Quarry
River Nene
A45
Allotment Gardens
Balancing Pond
Recycling Centre
Settling Ponds
Pond
Travellers Site
Depot
Camp Site
White Mills (Marina)
Factory

Island GREEN POWER

Lanpro

Key

- 🟥 Order Limits
- ⬜ Sheet Index
- Important Hedgerow
- Potentially Important Hedgerow
- Hedgerow

Tree Protection Order (TPO)

- ● Points

Layers: Lanpro, 2025; IGP, 2025
Base map: Reproduced from Ordnance Survey digital map data © Crown copyright 2025. All rights reserved. License number 0100031673

0 100 200 300 Meters

Scale: 1:2,500@ A0

APFP Regulation: 5(2)(q)	Application Doc No. EX3/GH2.11_B
Ref: P3535_LPR_ZZ_XX_DR_Z_0280	Date: 15/12/2025
Drawn by: BH	Checked by: JC

Important Hedgerows Plan
Sheet 12 of 18
Revision B

GREEN HILL SOLAR FARM

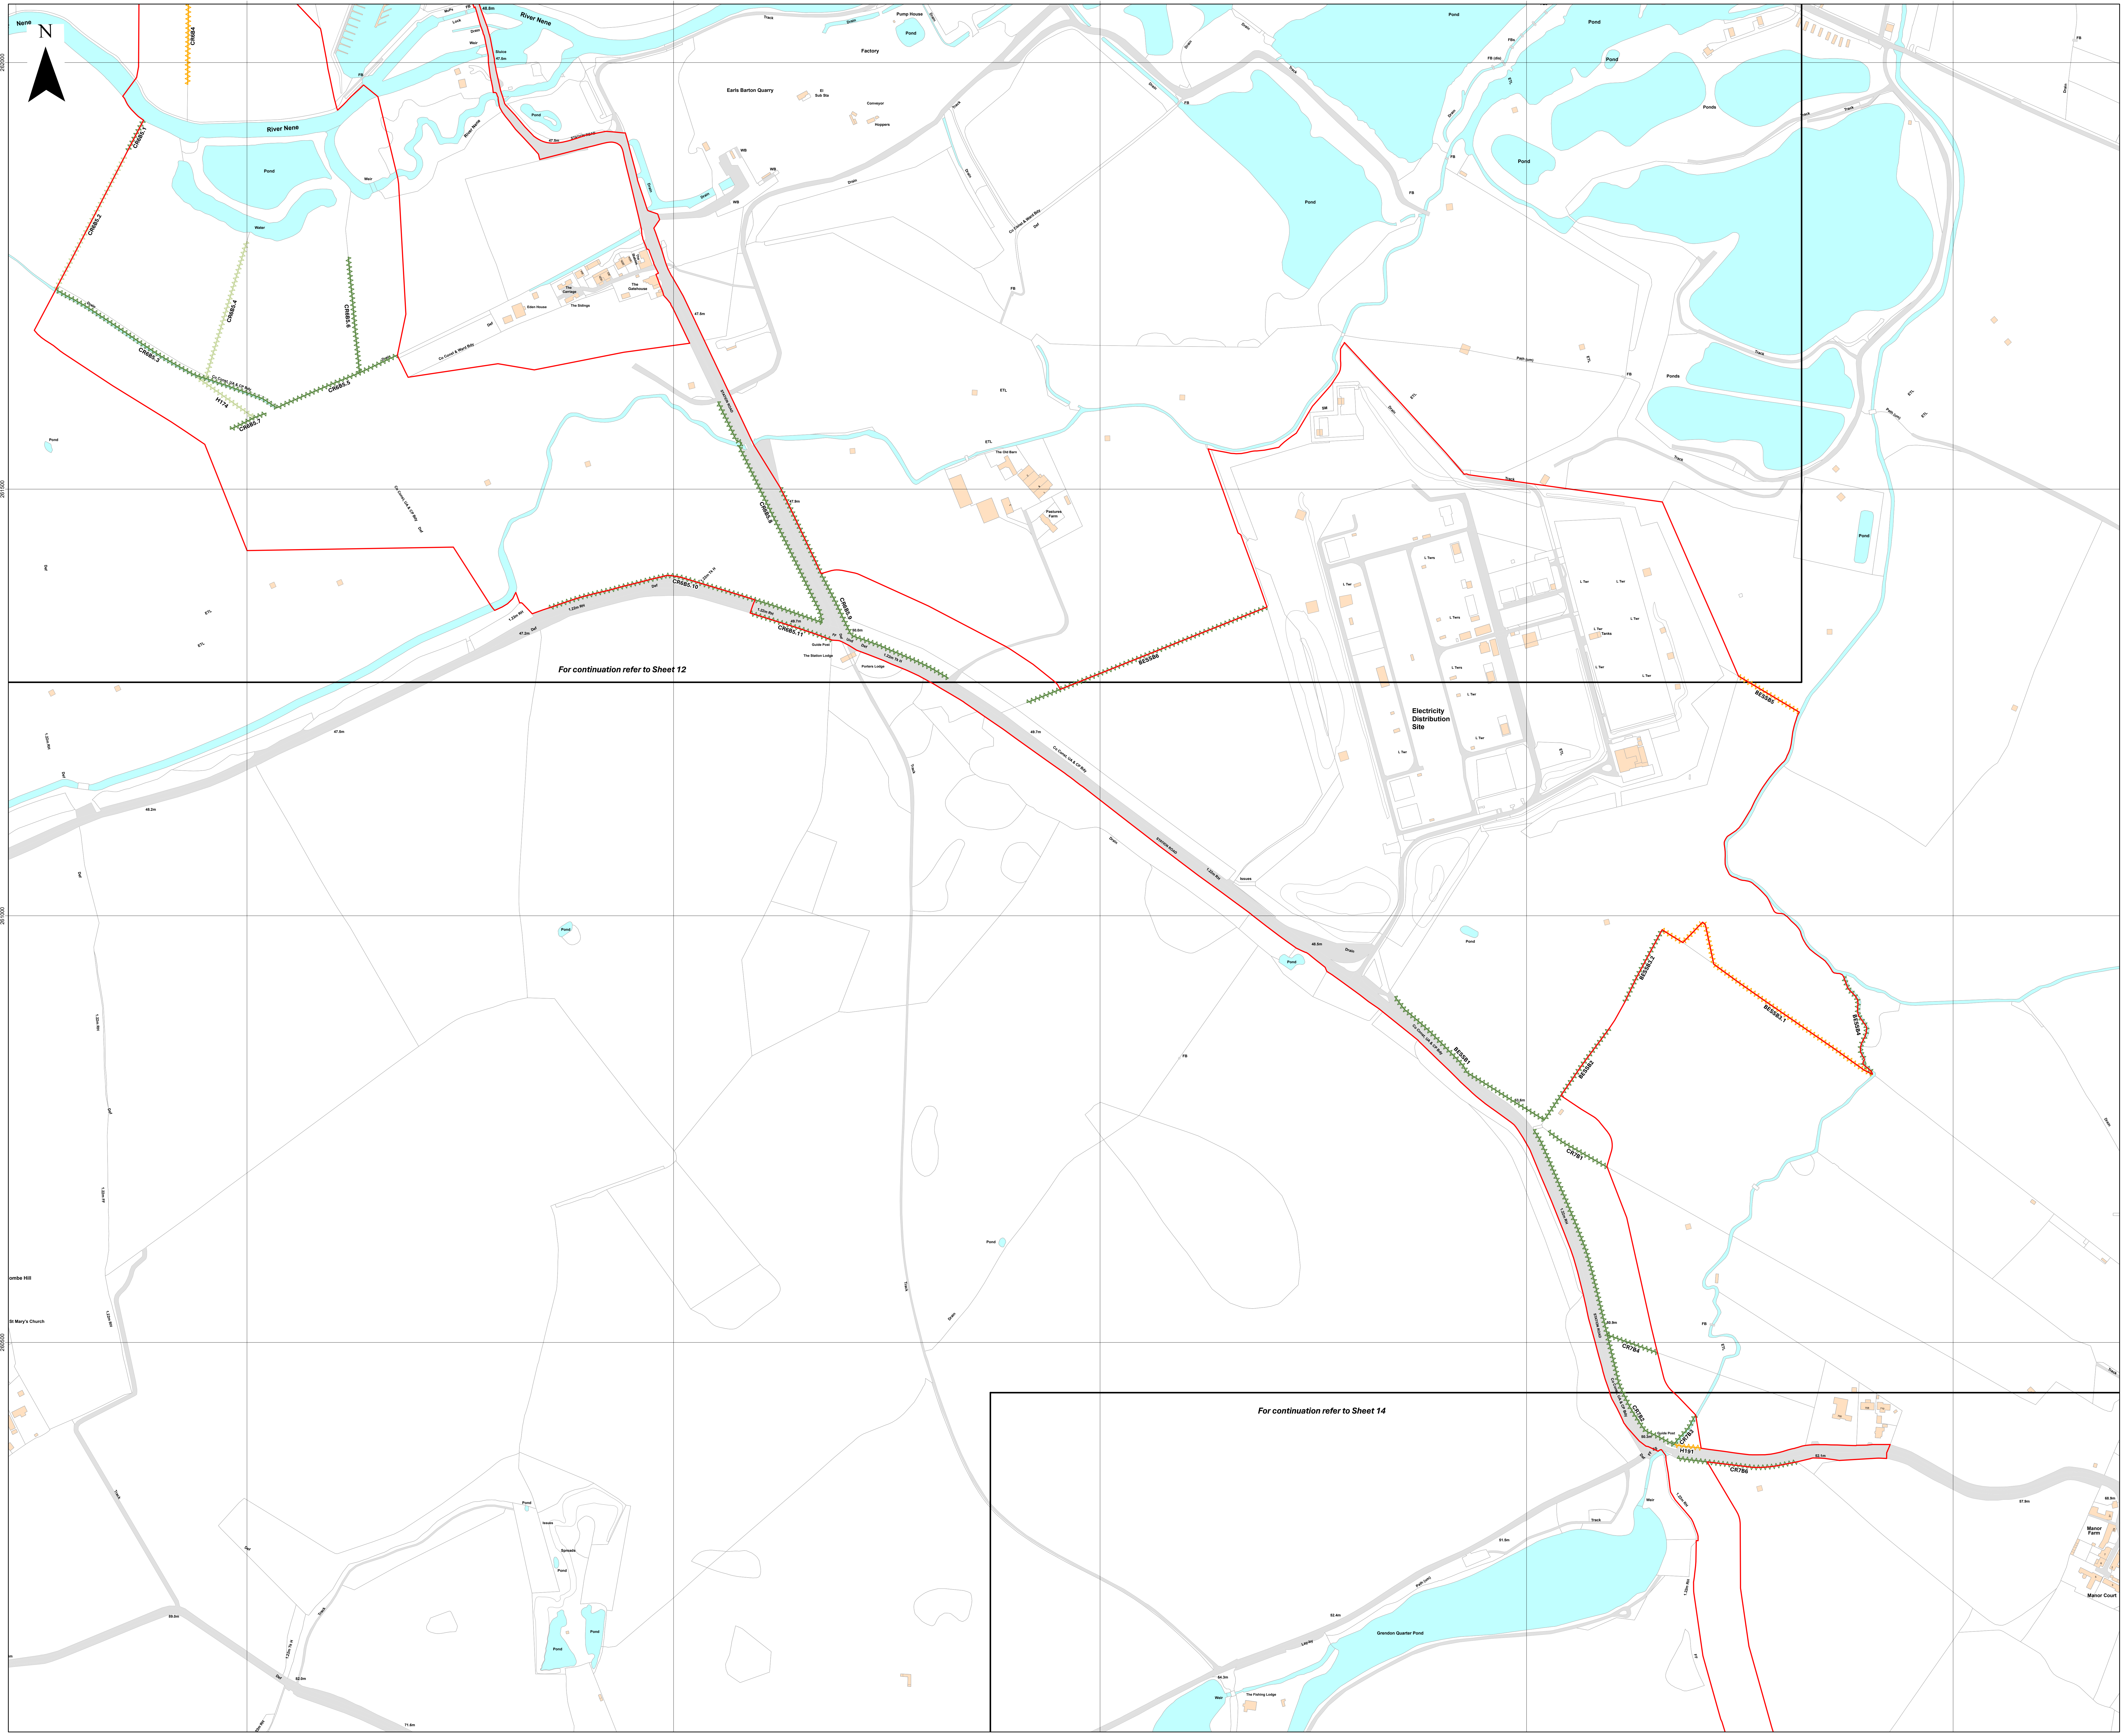
485500
486000
486500
487000
487500
262000
261500
261000
260500
N
River Nene
Pond
Water
Weir
Sluice
Factory
Earls Barton Quarry
Conveyor
Hoppers
STATION ROAD
Eden House
The Sidings
The Carriage
The Gatehouse
The Stables
The Old Barn
Pastures Farm
Electricity Distribution Site
L Twr
Tanks
Guide Post
The Station Lodge
Porters Lodge
Grendon Quarter Pond
The Fishing Lodge
Manor Farm
Manor Court
St Mary's Church
Co Const, UA & CP Bdy
CR6B4
CR6B5.1
CR6B5.2
CR6B5.3
CR6B5.4
CR6B5.5
CR6B5.6
CR6B5.7
H174
CR6B5.8
CR6B5.9
CR6B5.10
CR6B5.11
BESSB6
BESSB5
BESSB1
BESSB2
BESSB3.1
BESSB3.2
BESSB4
CR7B1
CR7B4
CR7B2
CR7B3
H191
CR7B6
For continuation refer to Sheet 12
For continuation refer to Sheet 14

Island GREEN POWER

Lanpro

Key

- 🟥 Order Limits
- ▭ Sheet Index
- Important Hedgerow
- Potentially Important Hedgerow
- Hedgerow

Layers: Lanpro, 2025; IGP, 2025

Base map: Reproduced from Ordnance Survey digital map data © Crown copyright 2025. All rights reserved. License number 0100031673

0 100 200 300 Meters

Scale: 1:2,500@ A0

APFP Regulation: 5(2)(q)	Application Doc No. EX3/GH2.11_B
Ref: P3535_LPR_ZZ_XX_DR_Z_0280	Date: 15/12/2025
Drawn by: BH	Checked by: JC

Important Hedgerows Plan

Sheet 13 of 18

Revision B

GREEN HILL SOLAR FARM

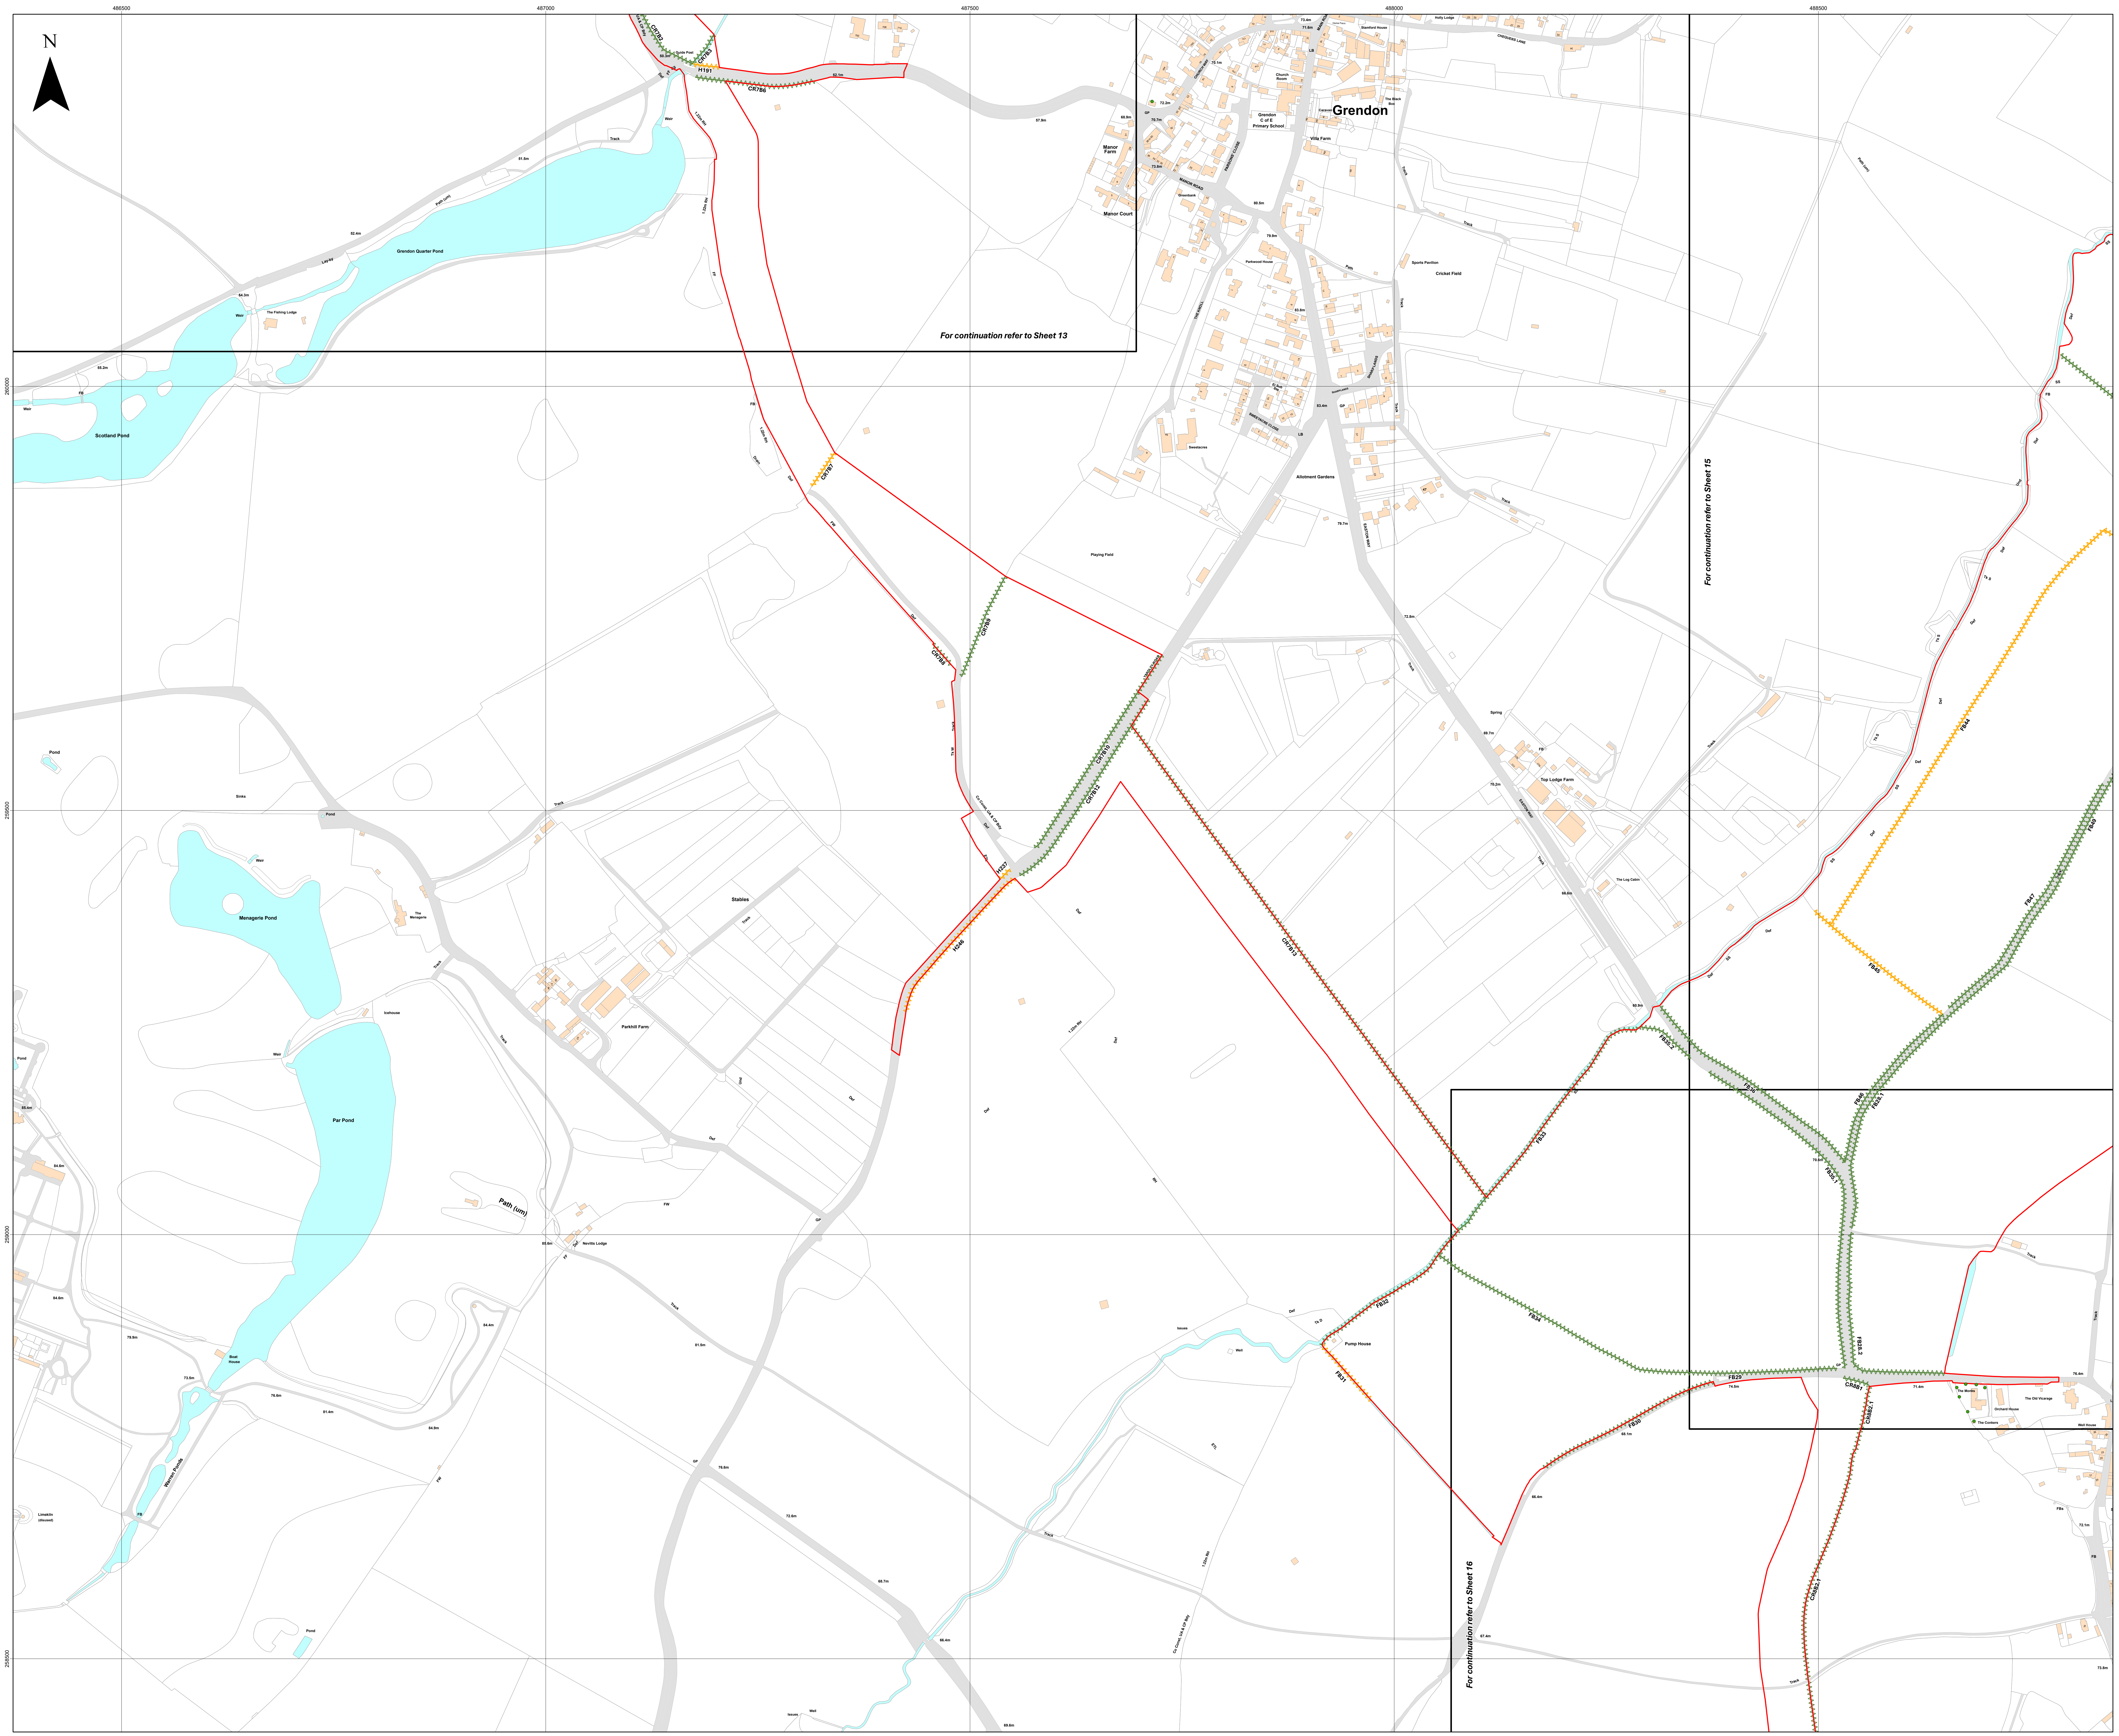
N
486500
487000
487500
488000
488500
259000
258500
258000
257500
Grendon
For continuation refer to Sheet 13
For continuation refer to Sheet 15
For continuation refer to Sheet 16
Grendon Quarter Pond
Scotland Pond
Menagerie Pond
Par Pond
Parkhill Farm
Stables
Top Lodge Farm
Playing Field
Allotment Gardens
Sports Pavilion
Cricket Field
Pump House
Nevills Lodge
The Menagerie
The Fishing Lodge
Manor Farm
Manor Court
Villa Farm
Grendon C of E Primary School
Path (um)
CR786
CR788
CR787
CR790
CR789
CR813
CR815
CR812
CR814
H191
H046
FB31
FB32
FB33
FB34
FB35
FB40
FB41
FB46
FB48
CR881
CR882

Key

- 🟥 Order Limits
- ▭ Sheet Index
- Important Hedgerow
- Hedgerow

Tree Protection Order (TPO)

- ● Points

Layers: Lanpro, 2025; IGP, 2025
Base map: Reproduced from Ordnance Survey digital map data © Crown copyright 2025. All rights reserved. License number 0100031673

0 100 200 300 Meters

Scale: 1:2,500@ A0

APFP Regulation: 5(2)(q)	Application Doc No. EX3/GH2.11_B
Ref: P3535_LPR_ZZ_XX_DR_Z_0280	Date: 15/12/2025
Drawn by: BH	Checked by: JC

Important Hedgerows Plan

Sheet 14 of 18
Revision B

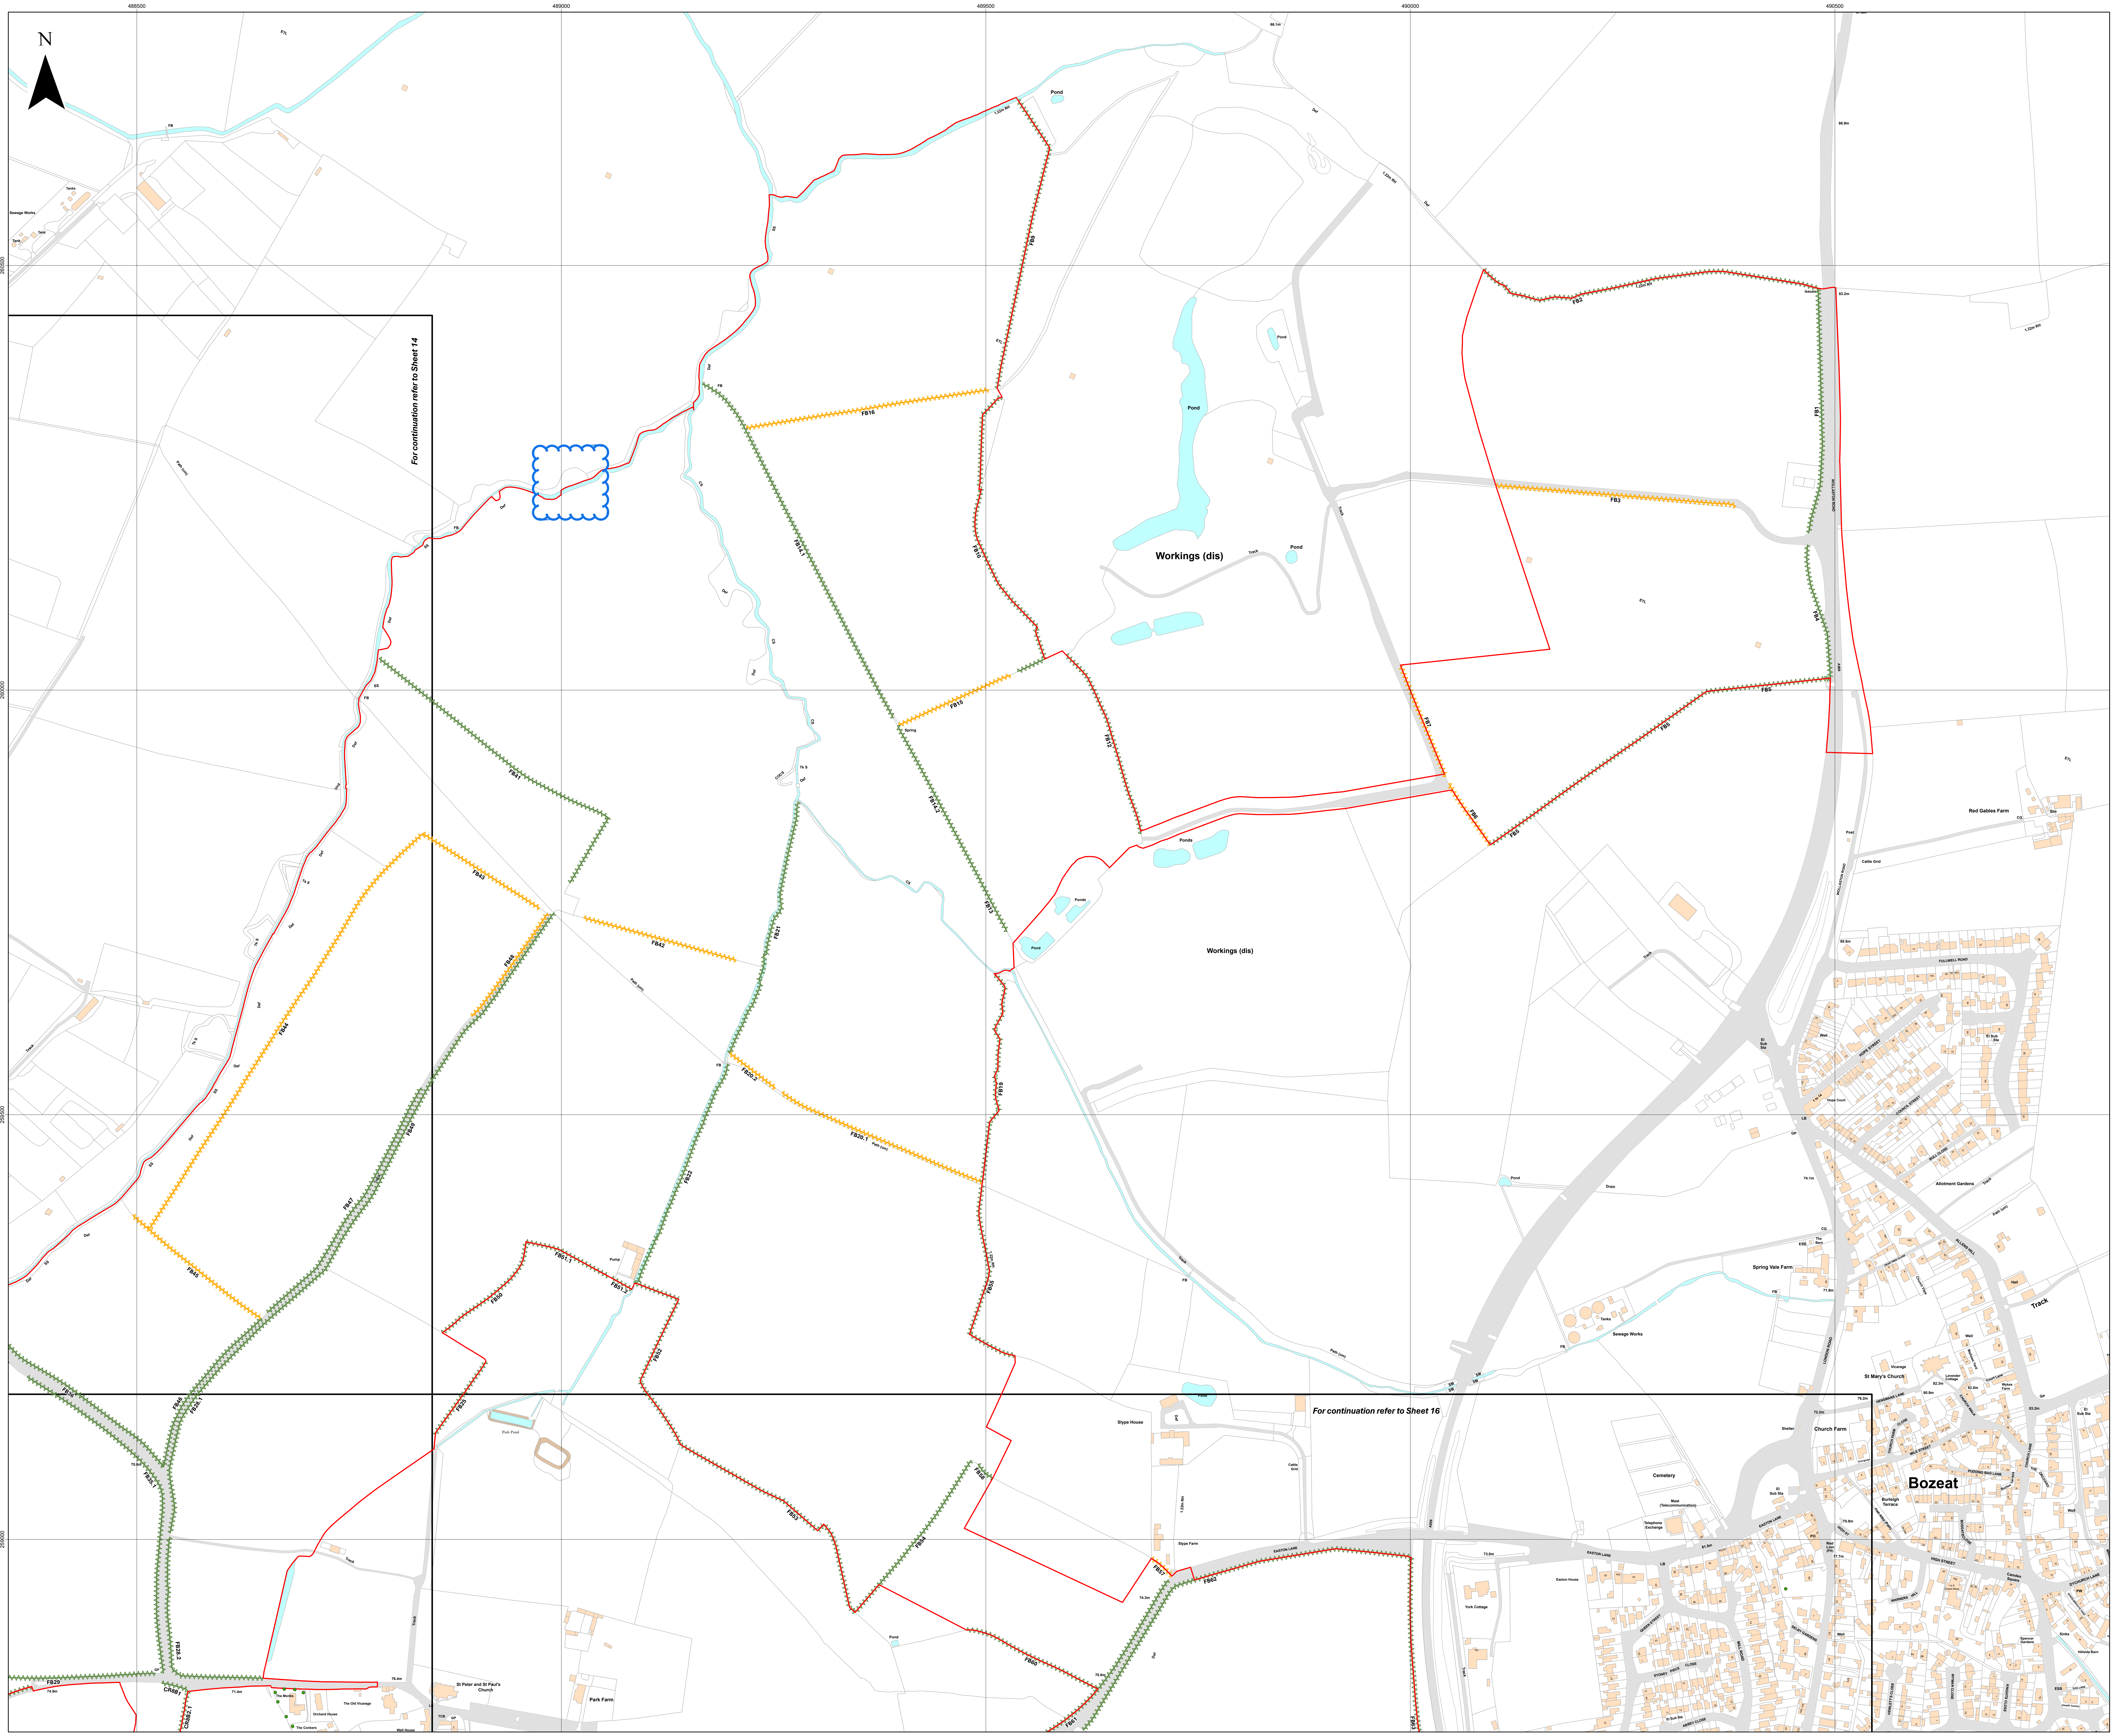
N
488500
489000
489500
490000
490500
260500
260000
259500
259000
For continuation refer to Sheet 14
For continuation refer to Sheet 16
Workings (dis)
Pond
Ponds
Bozeat
Sewage Works
Slype House
Slype Farm
Park Farm
St Peter and St Paul's Church
Fish Pond
Pump
Spring
Red Gables Farm
Spring Vale Farm
Church Farm
Cemetery
Allotment Gardens
Cattle Grid
WOLLASTON ROAD
EASTON LANE
A509
Track
Path (um)
FB1
FB2
FB3
FB4
FB5
FB6
FB7
FB10
FB12
FB13
FB14.1
FB14.2
FB15
FB16
FB19
FB20.1
FB20.2
FB21
FB22
FB25
FB28.1
FB28.2
FB29
FB35.1
FB36
FB41
FB42
FB43
FB44
FB45
FB46
FB47
FB48
FB49
FB50
FB51.1
FB51.2
FB52
FB53
FB54
FB55
FB57
FB58
FB60
FB61
FB62
FB63
CR881
CR882.1

Island GREEN POWER

Lanpro

Key

🟥	Order Limits
☐	Sheet Index
ʌʌʌʌ	Important Hedgerow
ʌʌʌʌ	Hedgerow

Tree Protection Order (TPO)

●	Points

Layers: Lanpro, 2025; IGP, 2025
Base map: Reproduced from Ordnance Survey digital map data © Crown copyright 2025. All rights reserved. License number 0100031673

0 100 200 300 Meters

Scale: 1:2,500@ A0

APFP Regulation: 5(2)(q)	Application Doc No. EX3/GH2.11_B
Ref: P3535_LPR_ZZ_XX_DR_Z_0280	Date: 15/12/2025
Drawn by: BH	Checked by: JC

Important Hedgerows Plan

Sheet 15 of 18
Revision B

GREEN HILL
SOLAR FARM

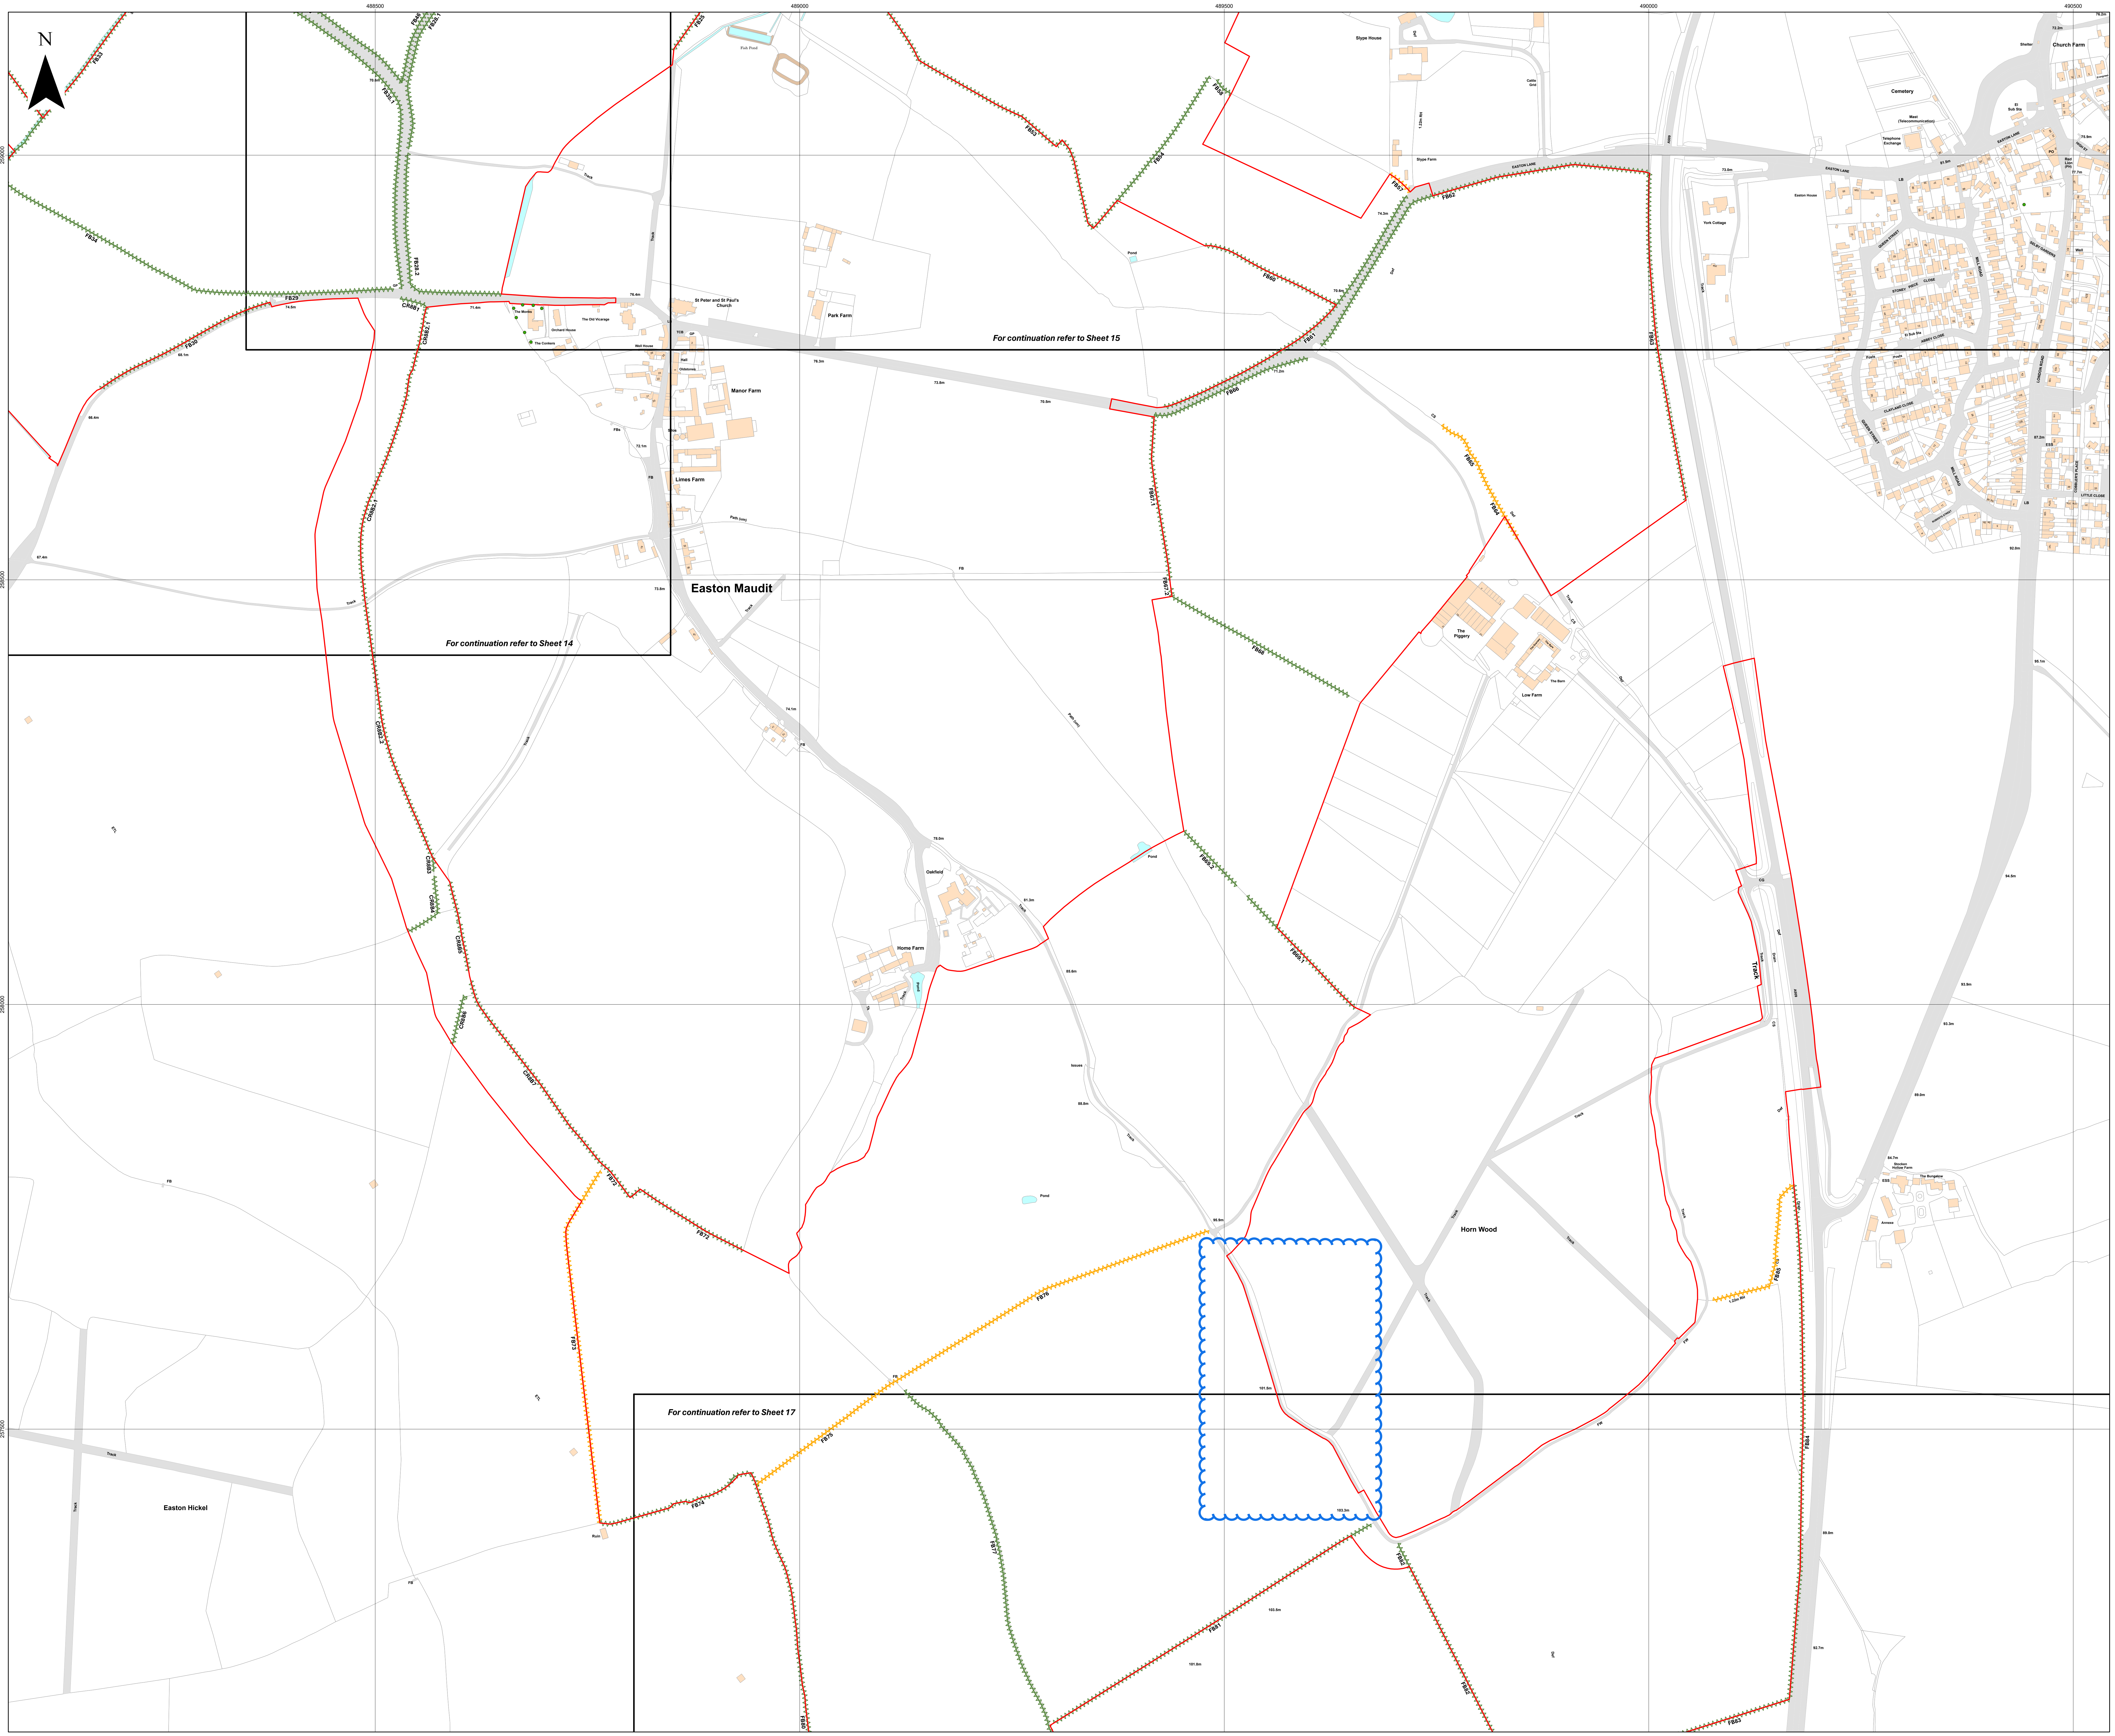

N
488500
489000
489500
490000
490500
259000
258500
258000
257500
FB33
FB34
FB29
FB30
FB46
FB28.1
FB28.2
FB35.1
CR8B1
CR8B2.1
CR8B2.2
CR8B3
CR8B4
CR8B5
CR8B6
CR8B7
FB25
FB53
FB54
FB58
FB57
FB60
FB61
FB62
FB63
FB64
FB65
FB66
FB67.1
FB67.2
FB68
FB69.1
FB69.2
FB72
FB73
FB74
FB75
FB76
FB77
FB80
FB81
FB82
FB83
FB84
FB85
For continuation refer to Sheet 14
For continuation refer to Sheet 15
For continuation refer to Sheet 17
Easton Maudit
Easton Hickel
Horn Wood
St Peter and St Paul's Church
The Monks
Orchard House
The Old Vicarage
The Conkers
Well House
Manor Farm
Limes Farm
Park Farm
Fish Pond
Slype House
Slype Farm
Oakfield
Home Farm
The Piggery
Low Farm
The Barn
Cemetery
Church Farm
York Cottage
Easton House
EASTON LANE
QUEEN STREET
MILL ROAD
STONEY PIECE CLOSE
ABBEY CLOSE
CLAYLAND CLOSE
SELBY GARDENS
LONDON ROAD
HIGH ST
LITTLE CLOSE
COBBLER'S PLACE
ROBERTS STREET
Stocken Hollow Farm
The Bungalow
Annexe
Pond
Track
Ruin
A509

Key

- 🟥 Order Limits
- ▭ Sheet Index
- Important Hedgerow
- Hedgerow

Tree Protection Order (TPO)

- ● Points

Layers: Lanpro, 2025; IGP, 2025

Base map: Reproduced from Ordnance Survey digital map data © Crown copyright 2025. All rights reserved. License number 0100031673

0 100 200 300 Meters

Scale: 1:2,500@ A0

APFP Regulation: 5(2)(q)	Application Doc No. EX3/GH2.11_B
Ref: P3535_LPR_ZZ_XX_DR_Z_0280	Date: 15/12/2025
Drawn by: BH	Checked by: JC

Important Hedgerows Plan

Sheet 16 of 18
Revision B

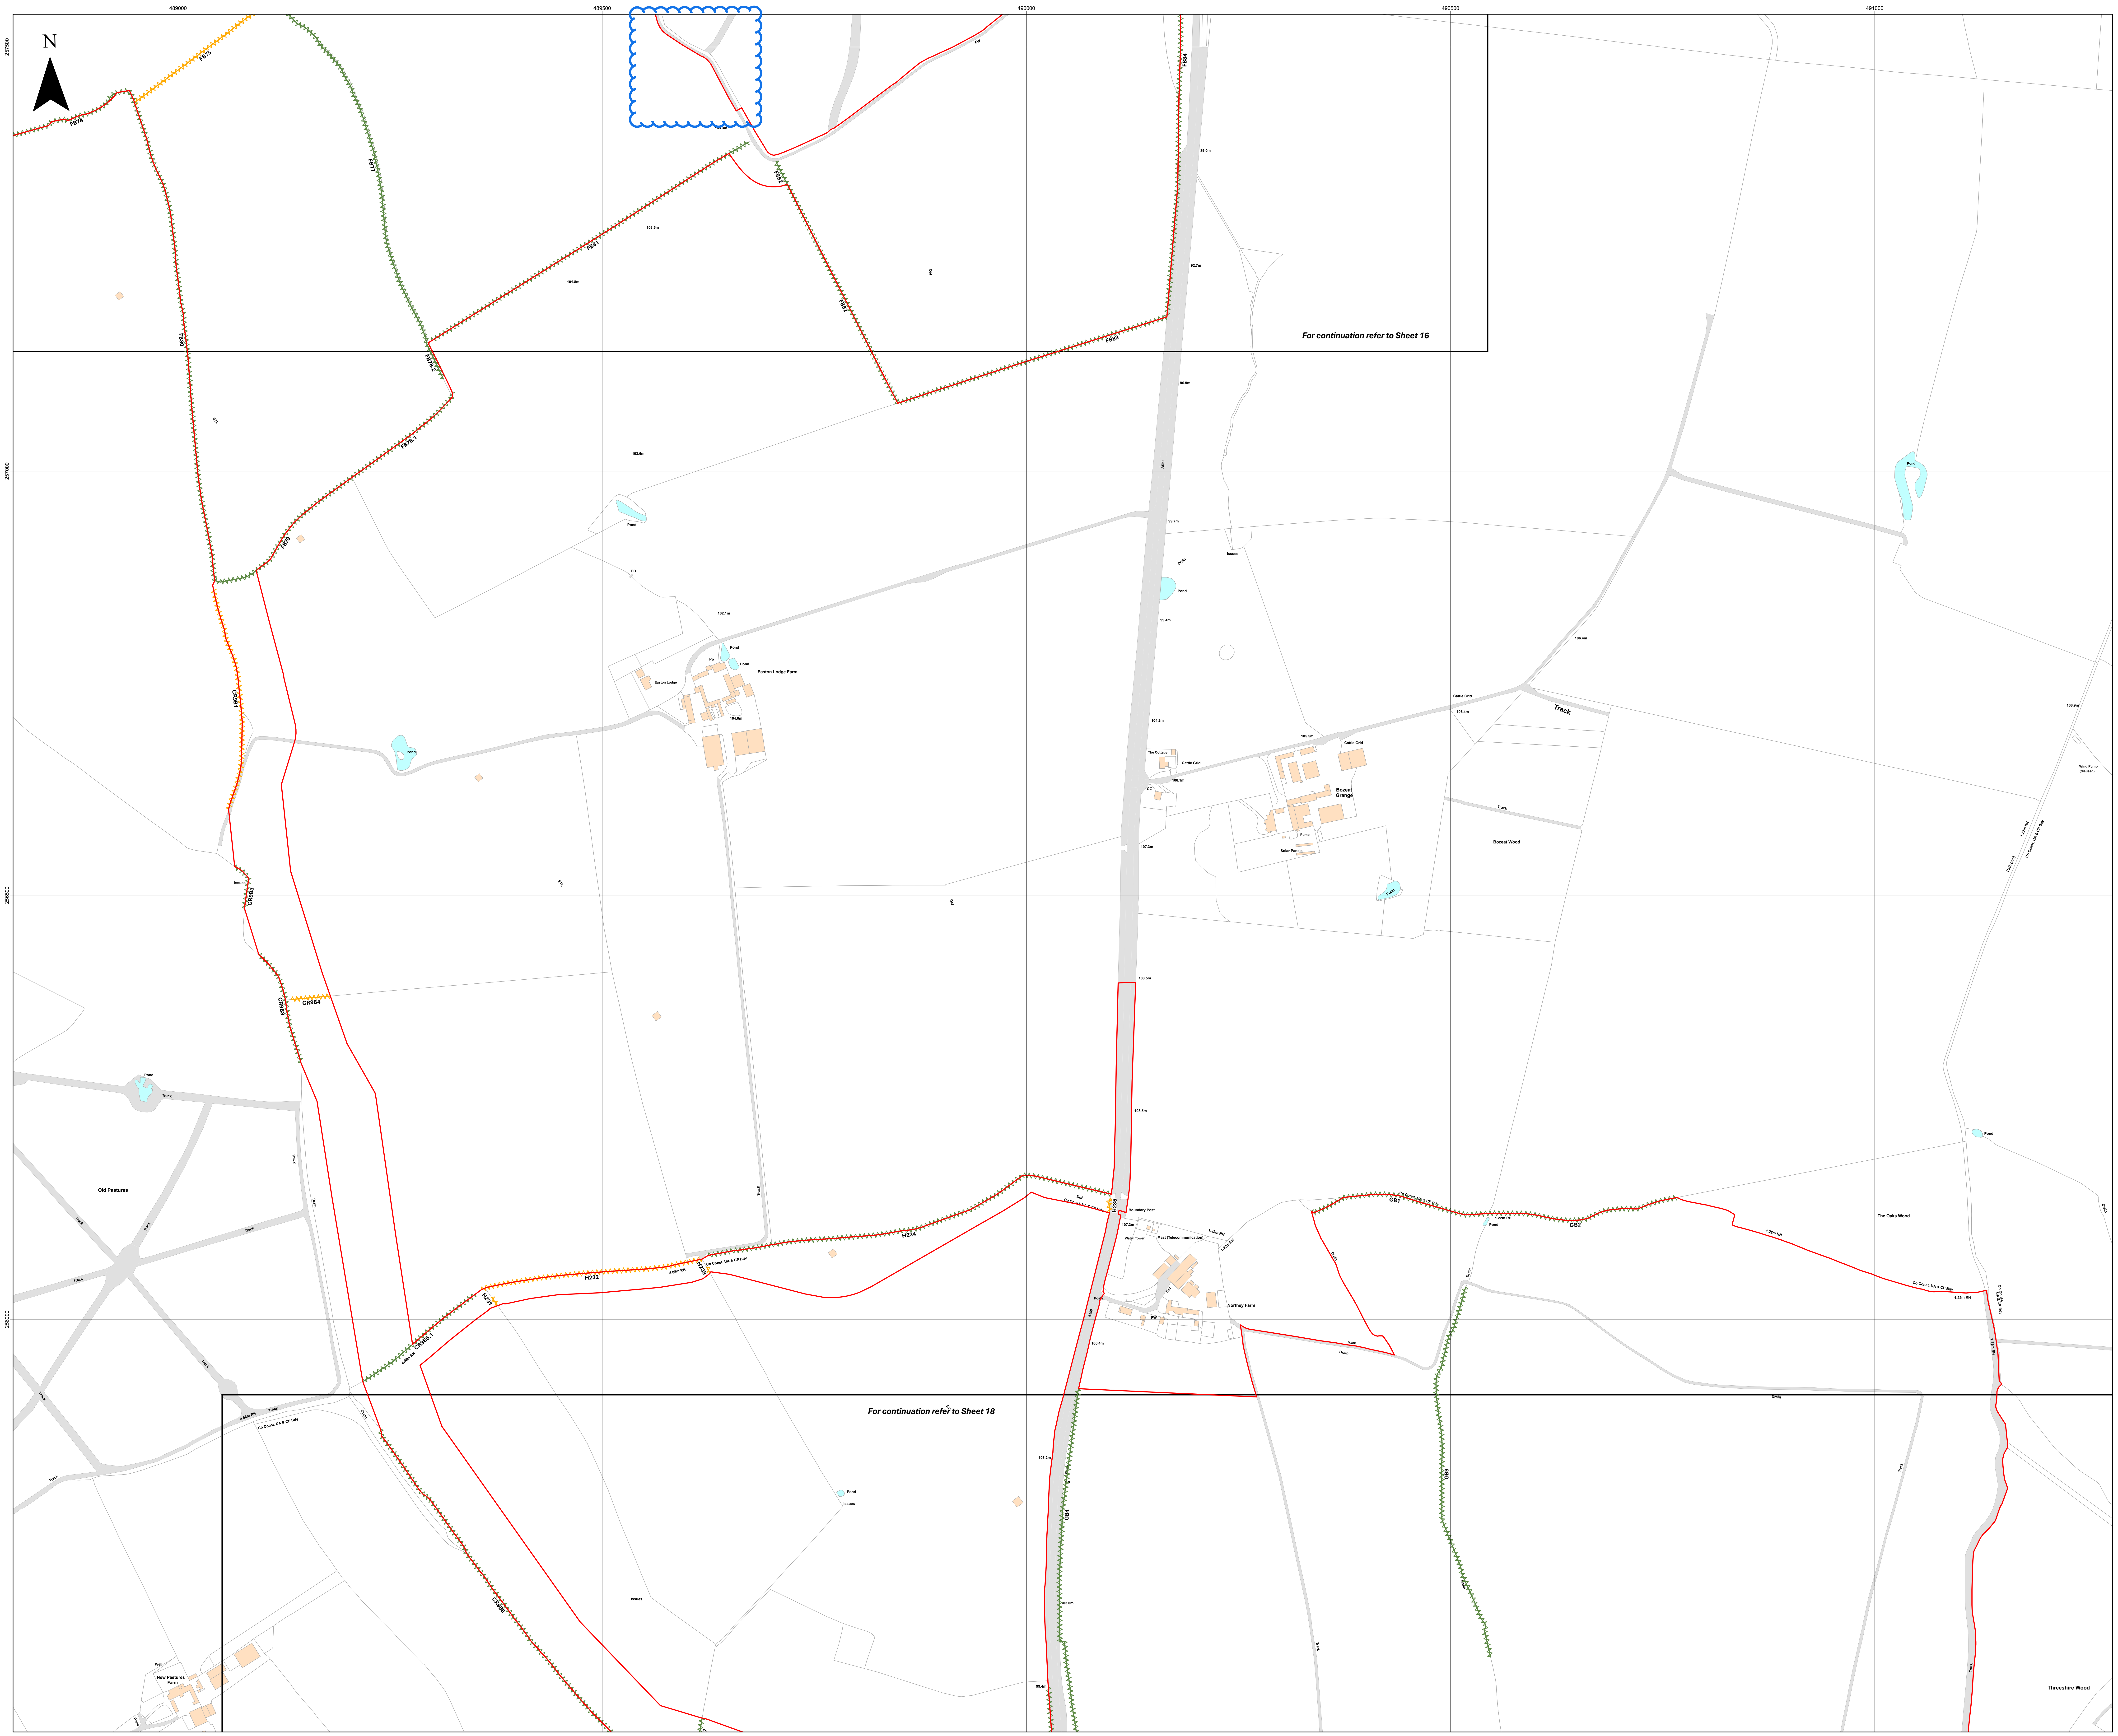
489000
489500
490000
490500
491000
257500
257000
256500
256000
N
FB74
FB75
FB77
FB80
FB81
FB82
FB83
FB84
FB78.1
FB78.2
FB79
CR9B3
CR9B4
CR9B5.1
CR9B6
H231
H232
H233
H234
H235
GB1
GB2
GB4
GB9
For continuation refer to Sheet 16
For continuation refer to Sheet 18
Easton Lodge Farm
Easton Lodge
Bozeat Grange
Bozeat Wood
The Cottage
Cattle Grid
Northey Farm
Water Tower
Mast (Telecommunication)
Boundary Post
The Oaks Wood
Old Pastures
New Pastures Farm
Pond
Track
Drain
Issues
Pump
Solar Panels
A509
Co Const, UA & CP Bdy
1.22m RH
4.88m RH

Island GREEN POWER
Lanpro

Key

- 🟥 Order Limits
- ▭ Sheet Index
- ⩘ Important Hedgerow
- ⩘ Hedgerow

Layers: Lanpro, 2025; IGP, 2025
Base map: Reproduced from Ordnance Survey digital map data © Crown copyright 2025. All rights reserved. License number 0100031673

0 100 200 300 Meters

Scale: 1:2,500@ A0

APFP Regulation: 5(2)(q)	Application Doc No. EX3/GH2.11_B
Ref: P3535_LPR_ZZ_XX_DR_Z_0280	Date: 15/12/2025
Drawn by: BH	Checked by: JC

Important Hedgerows Plan
Sheet 17 of 18
Revision B

GREEN HILL
SOLAR FARM

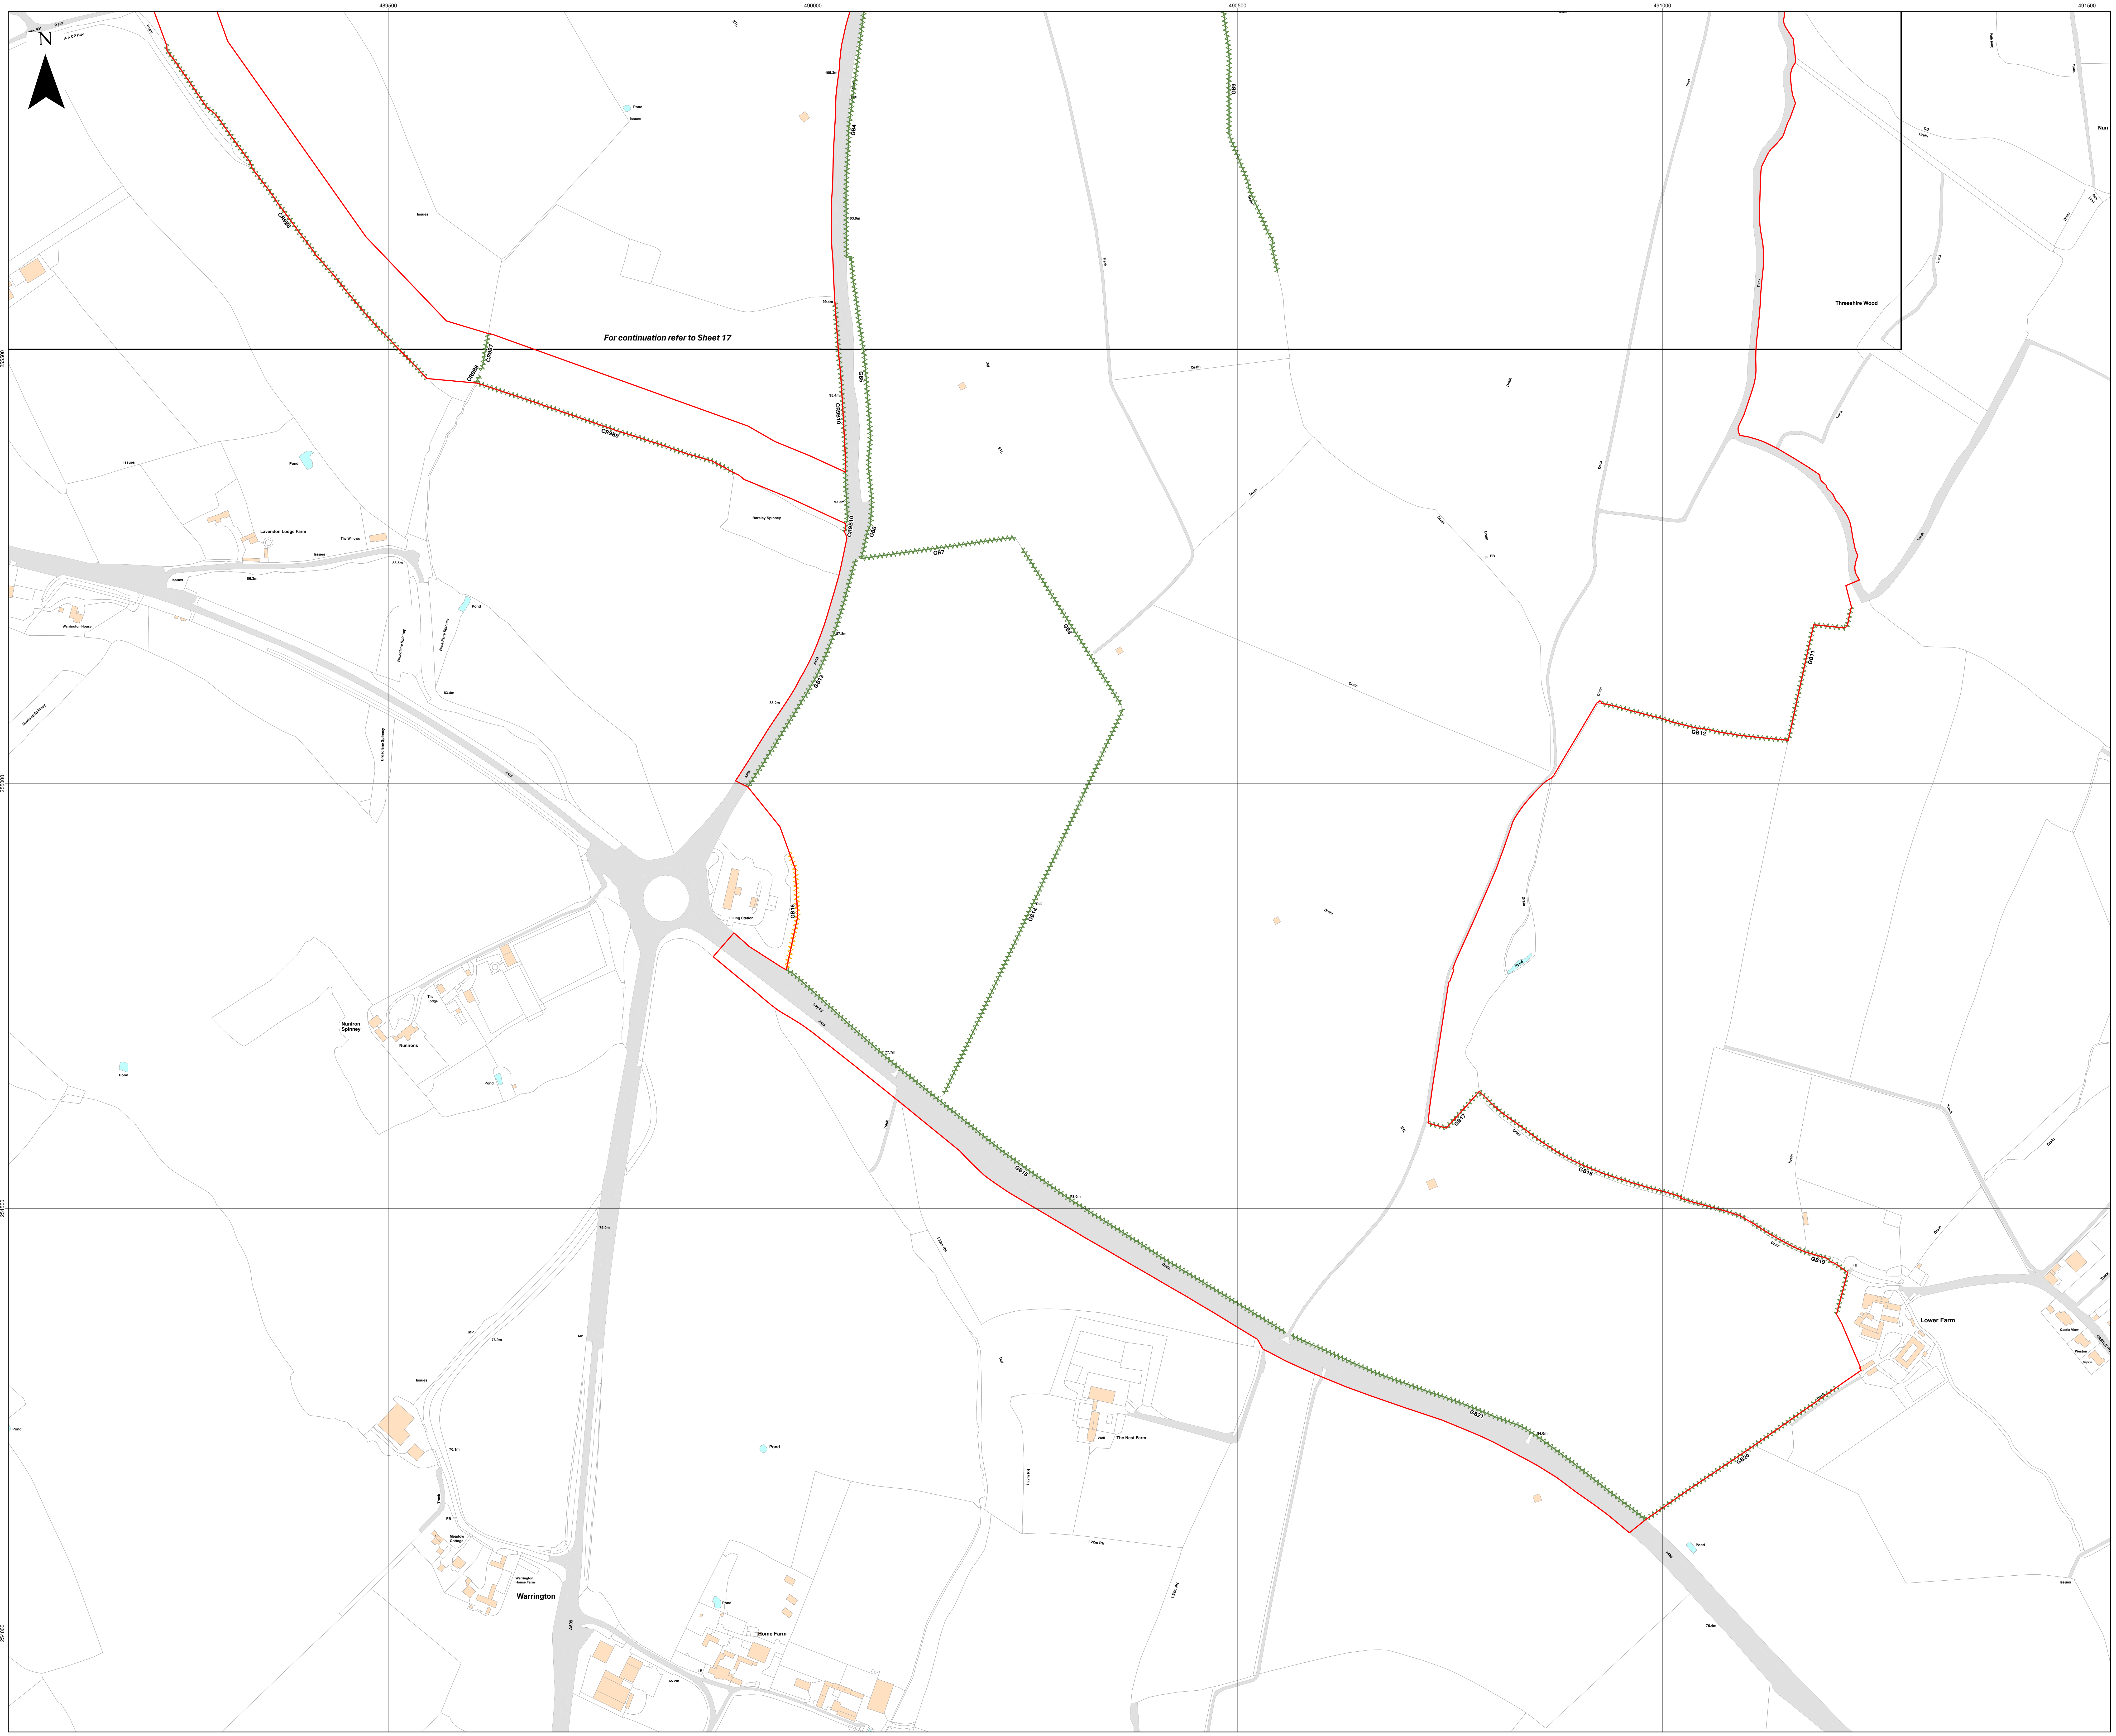
N
489500
490000
490500
491000
491500
255000
254000
For continuation refer to Sheet 17
Lavendon Lodge Farm
Threeshire Wood
Filling Station
Nunfrons Spinney
Lower Farm
The Nest Farm
Warrington
Home Farm
Pond

Island GREEN POWER

Lanpro

Key

- 🟥 Order Limits
- ▭ Sheet Index
- Important Hedgerow
- Hedgerow

Layers: Lanpro, 2025; IGP, 2025
Base map: Reproduced from Ordnance Survey digital map data © Crown copyright 2025. All rights reserved. License number 0100031673

0 100 200 300 Meters

Scale: 1:2,500@ A0

APFP Regulation: 5(2)(q)	Application Doc No. EX3/GH2.11_B
Ref: P3535_LPR_ZZ_XX_DR_Z_0280	Date: 15/12/2025
Drawn by: BH	Checked by: JC

Important Hedgerows Plan

Sheet 18 of 18
Revision B

GREEN HILL
SOLAR FARM