

Green Hill Solar Farm

EN010170

Land Plan

Revision ~~DE~~ (Tracked)

Prepared by: Bruton Knowles

Date: ~~December 2025~~ February 2026

Document Reference: ~~EX3~~ EX5/GH2.2_ DE

APFP Regulation 5(2)(i)




Schedule of Changes

Figure Reference	Page	Description of Changes	Reason for Revision
[cover]		Updated document reference to Revision E	As required for submission of Deadline 5.
All Sheets	3-21	Updated document references and annotations	As required for submission of Deadline 5.
Sheet 12	15	Reduction of plot 12-136-b Previously included land hatched grey and labelled "No Land Take"	Due diligence check of plot interests in respect of presumed subsoil interests.
Sheet 15	18	Creation of plots 15-202-a, 15-202-b, 15-202-c, and 15-202-d	Due diligence check of new HMLR plot titles
Sheet 18	21	Creation of plots 18-223-a, 18-223-b, 18-223-c, 18-223-d, 18-223-e, 18-223-f, 18-223-g, 18-223-h, and 18-223-i	Due diligence check of new HMLR plot titles

Key
 Sheet
 Order Limits

Base map: © Crown Copyright and database rights 2025 OS Licence no. AC00084986. All rights reserved.

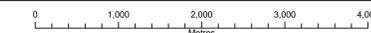


Scale: 1:30,000@A0

APFP Regulation: 5(2)(i)	Application Doc No. EX5/GH2.2_E
Ref: IGP_GH_DCO_Land_Plan	Date: 23/02/2026
Drawn by: DLG	Checked by: JB

Overview Land Plan
 Revision E
 Sheet 0







Contains OS data © Crown Copyright and database right 2025

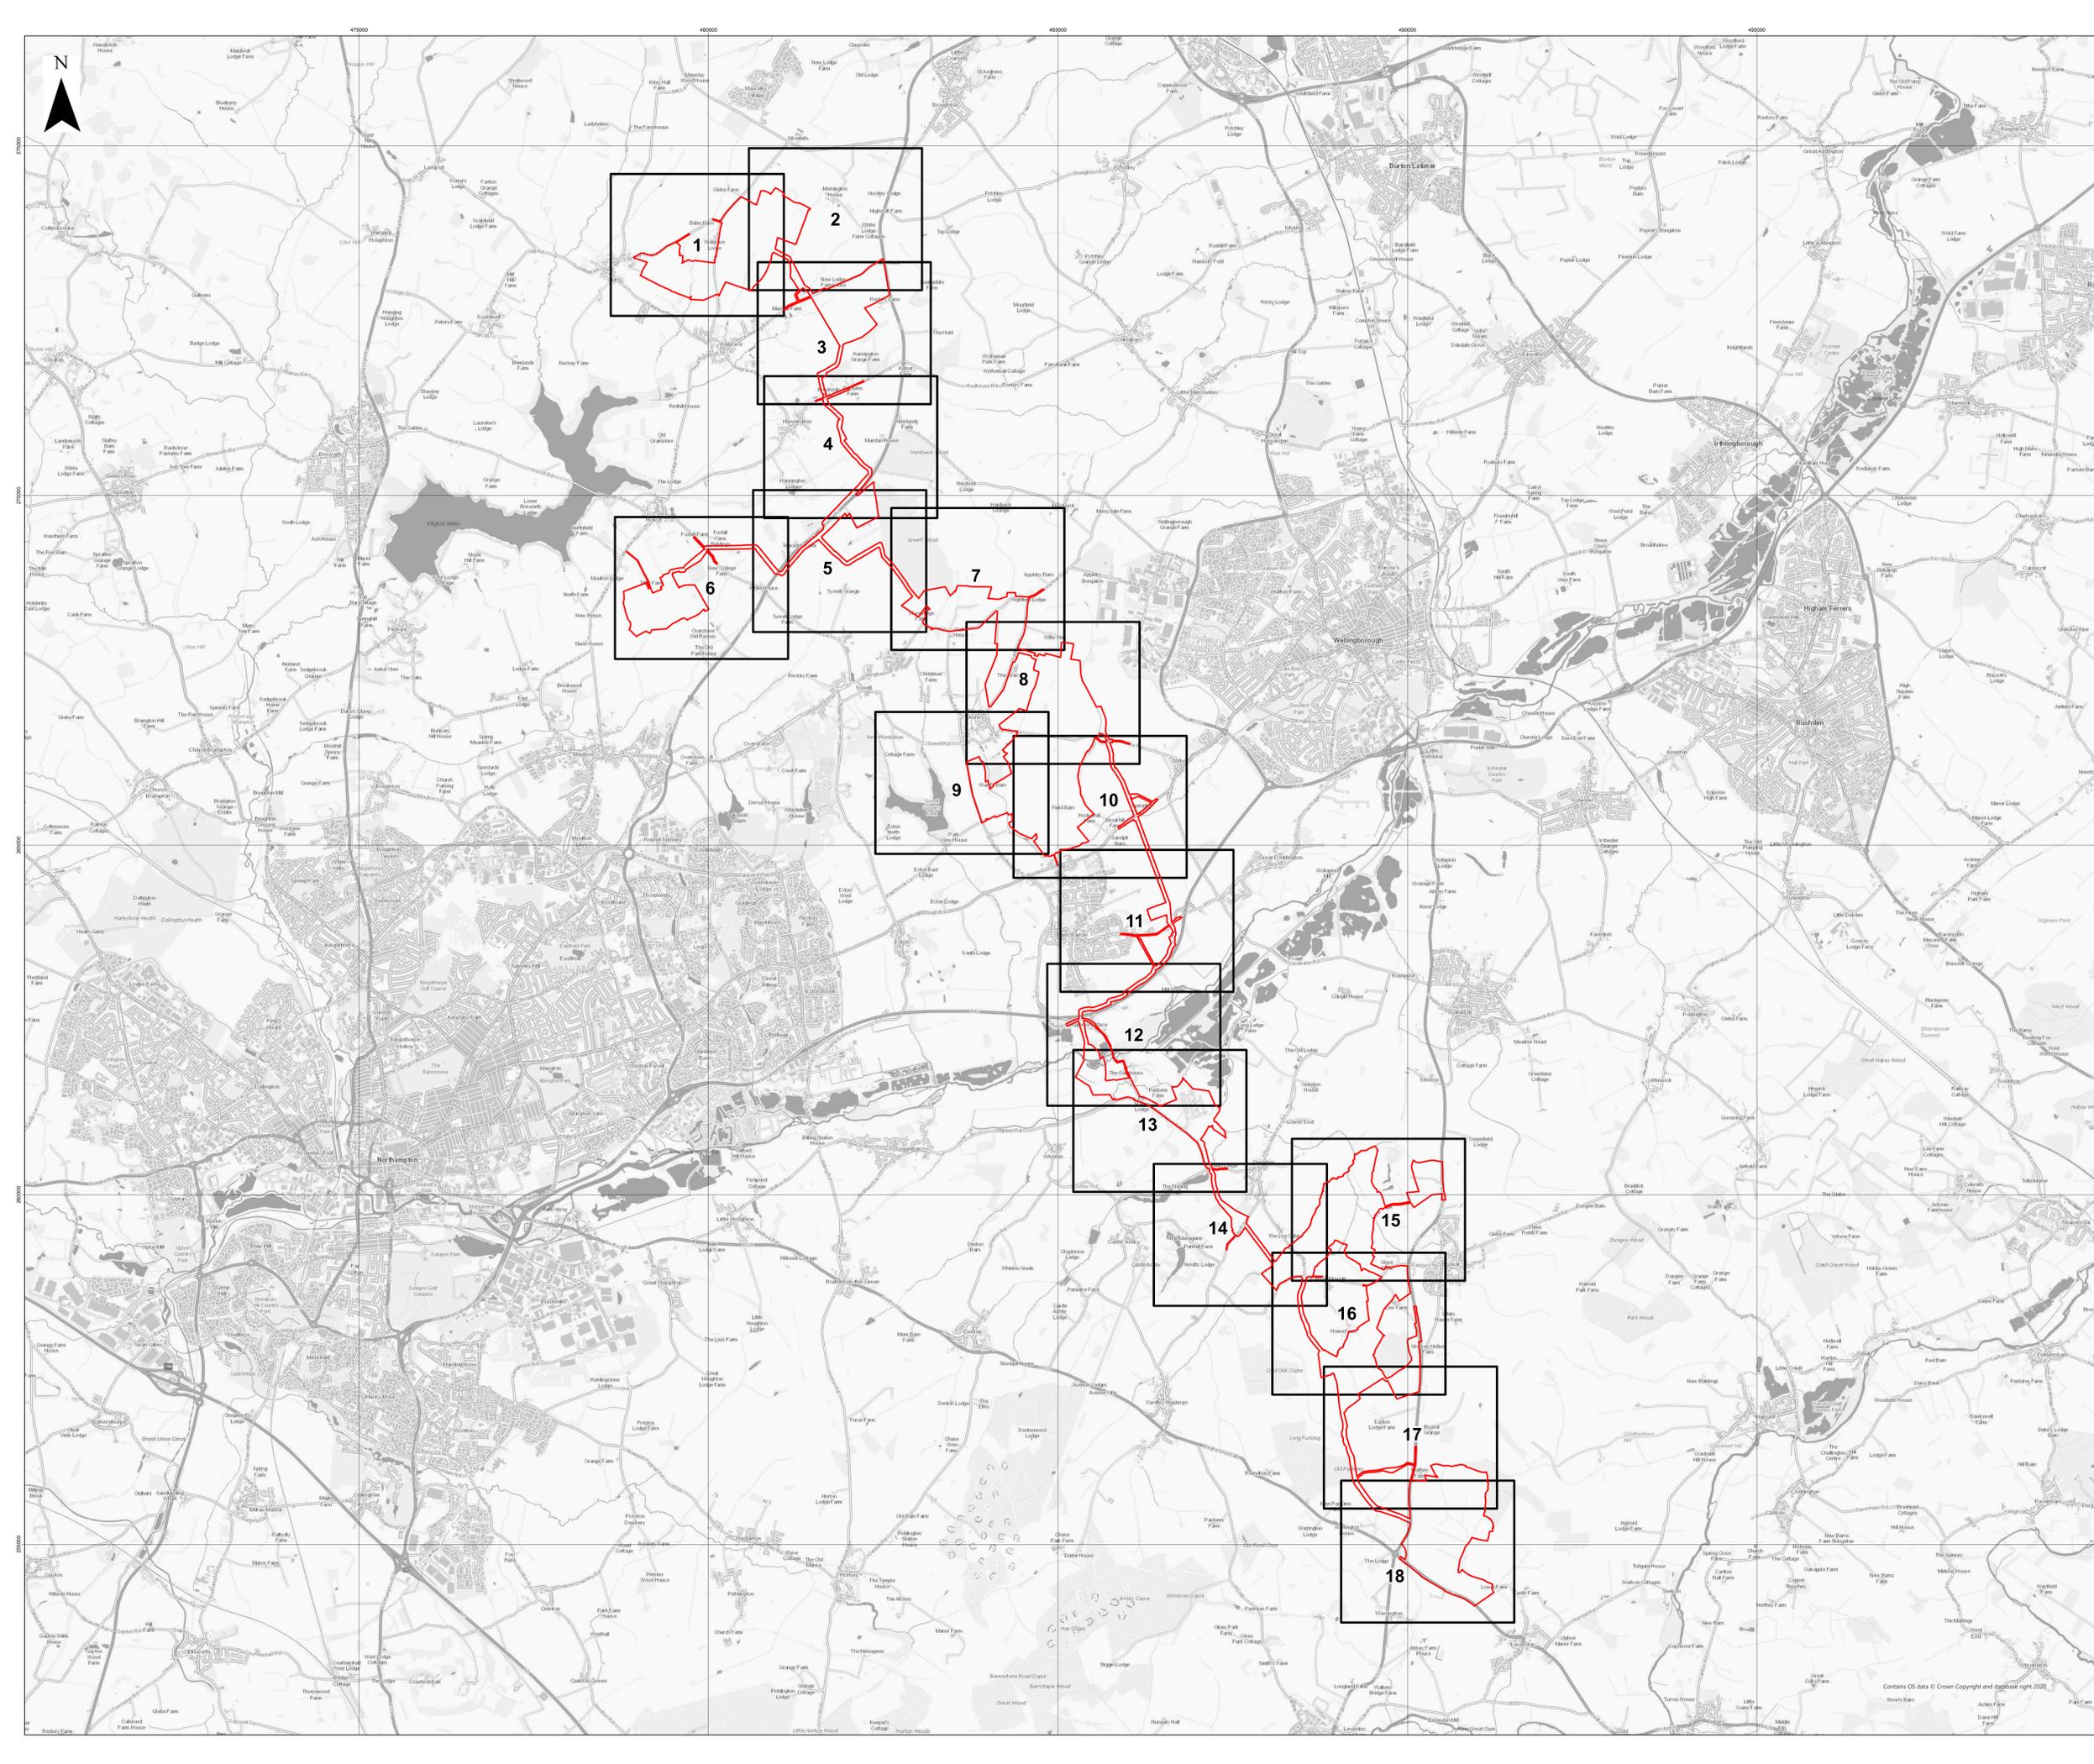




- Key**
- Order Limits
 - No Land Take
 - Freehold to be compulsorily acquired and temporary use of land and in relation to which it is proposed that easements, servitudes and other private rights will cease to have effect
 - Temporary use of land and in relation to which it is proposed to temporarily suspend easements, servitudes and other private rights
 - New rights (including restrictions) to be compulsorily acquired and temporary use of land and in relation to which it is proposed that easements, servitudes and other private rights will be suspended or cease to have effect
 - Local Authority / Parish Boundary
 - Cut Line

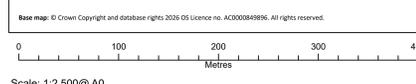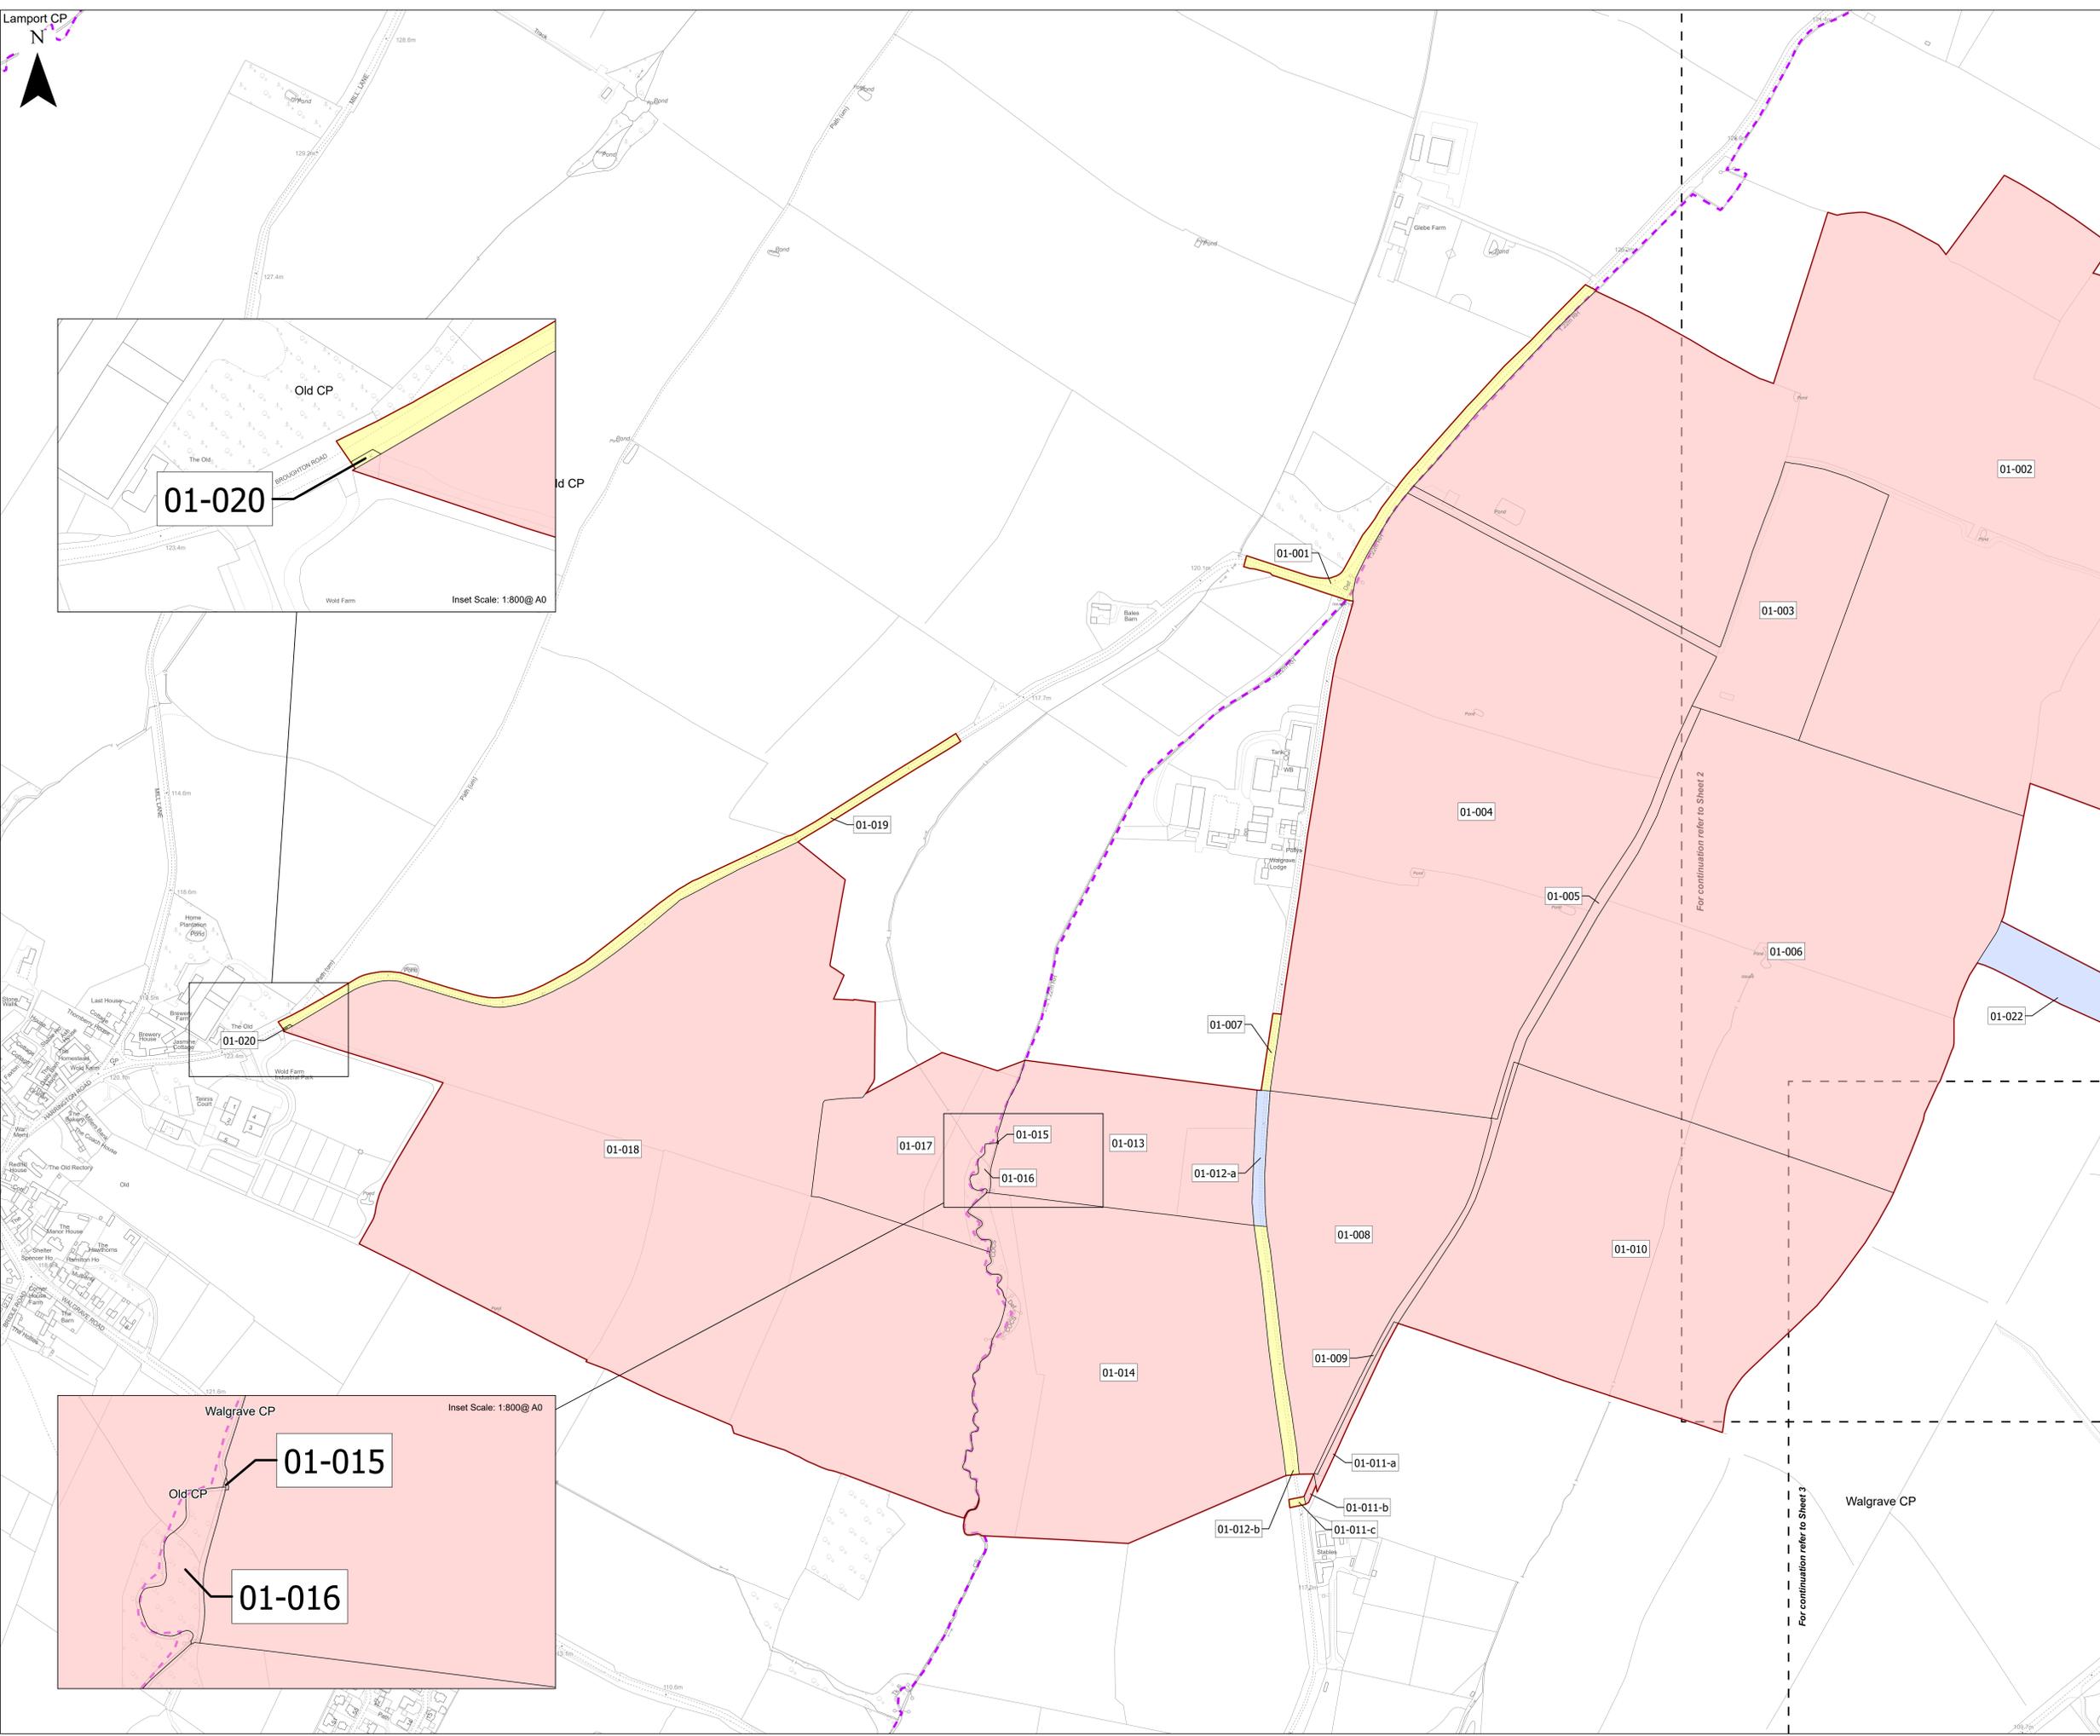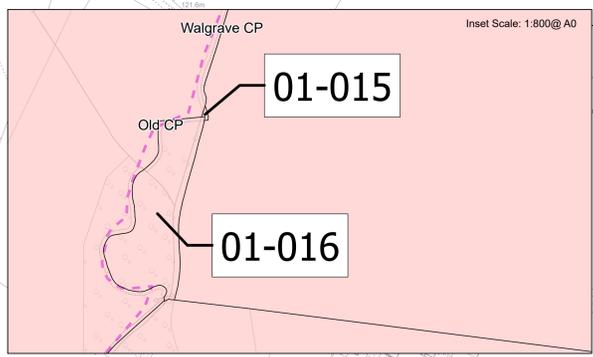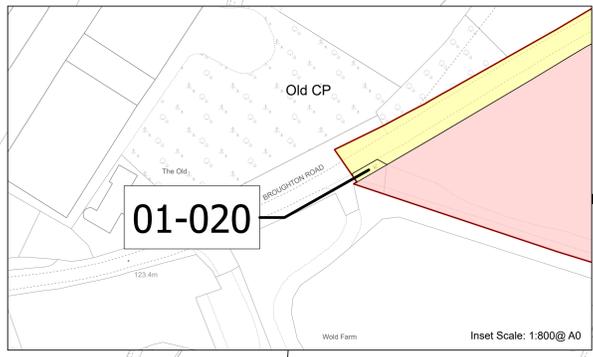

APFP Regulation: 5(2)(i)	Application Doc No. EX5/GH2.2_E
Ref: IGP_GH_DCO_Land_Plan	Date: 23/02/2026
Drawn by: DLG	Checked by: JB

Land Plan
Revision E
Sheet 1 of 18


GREEN HILL SOLAR FARM

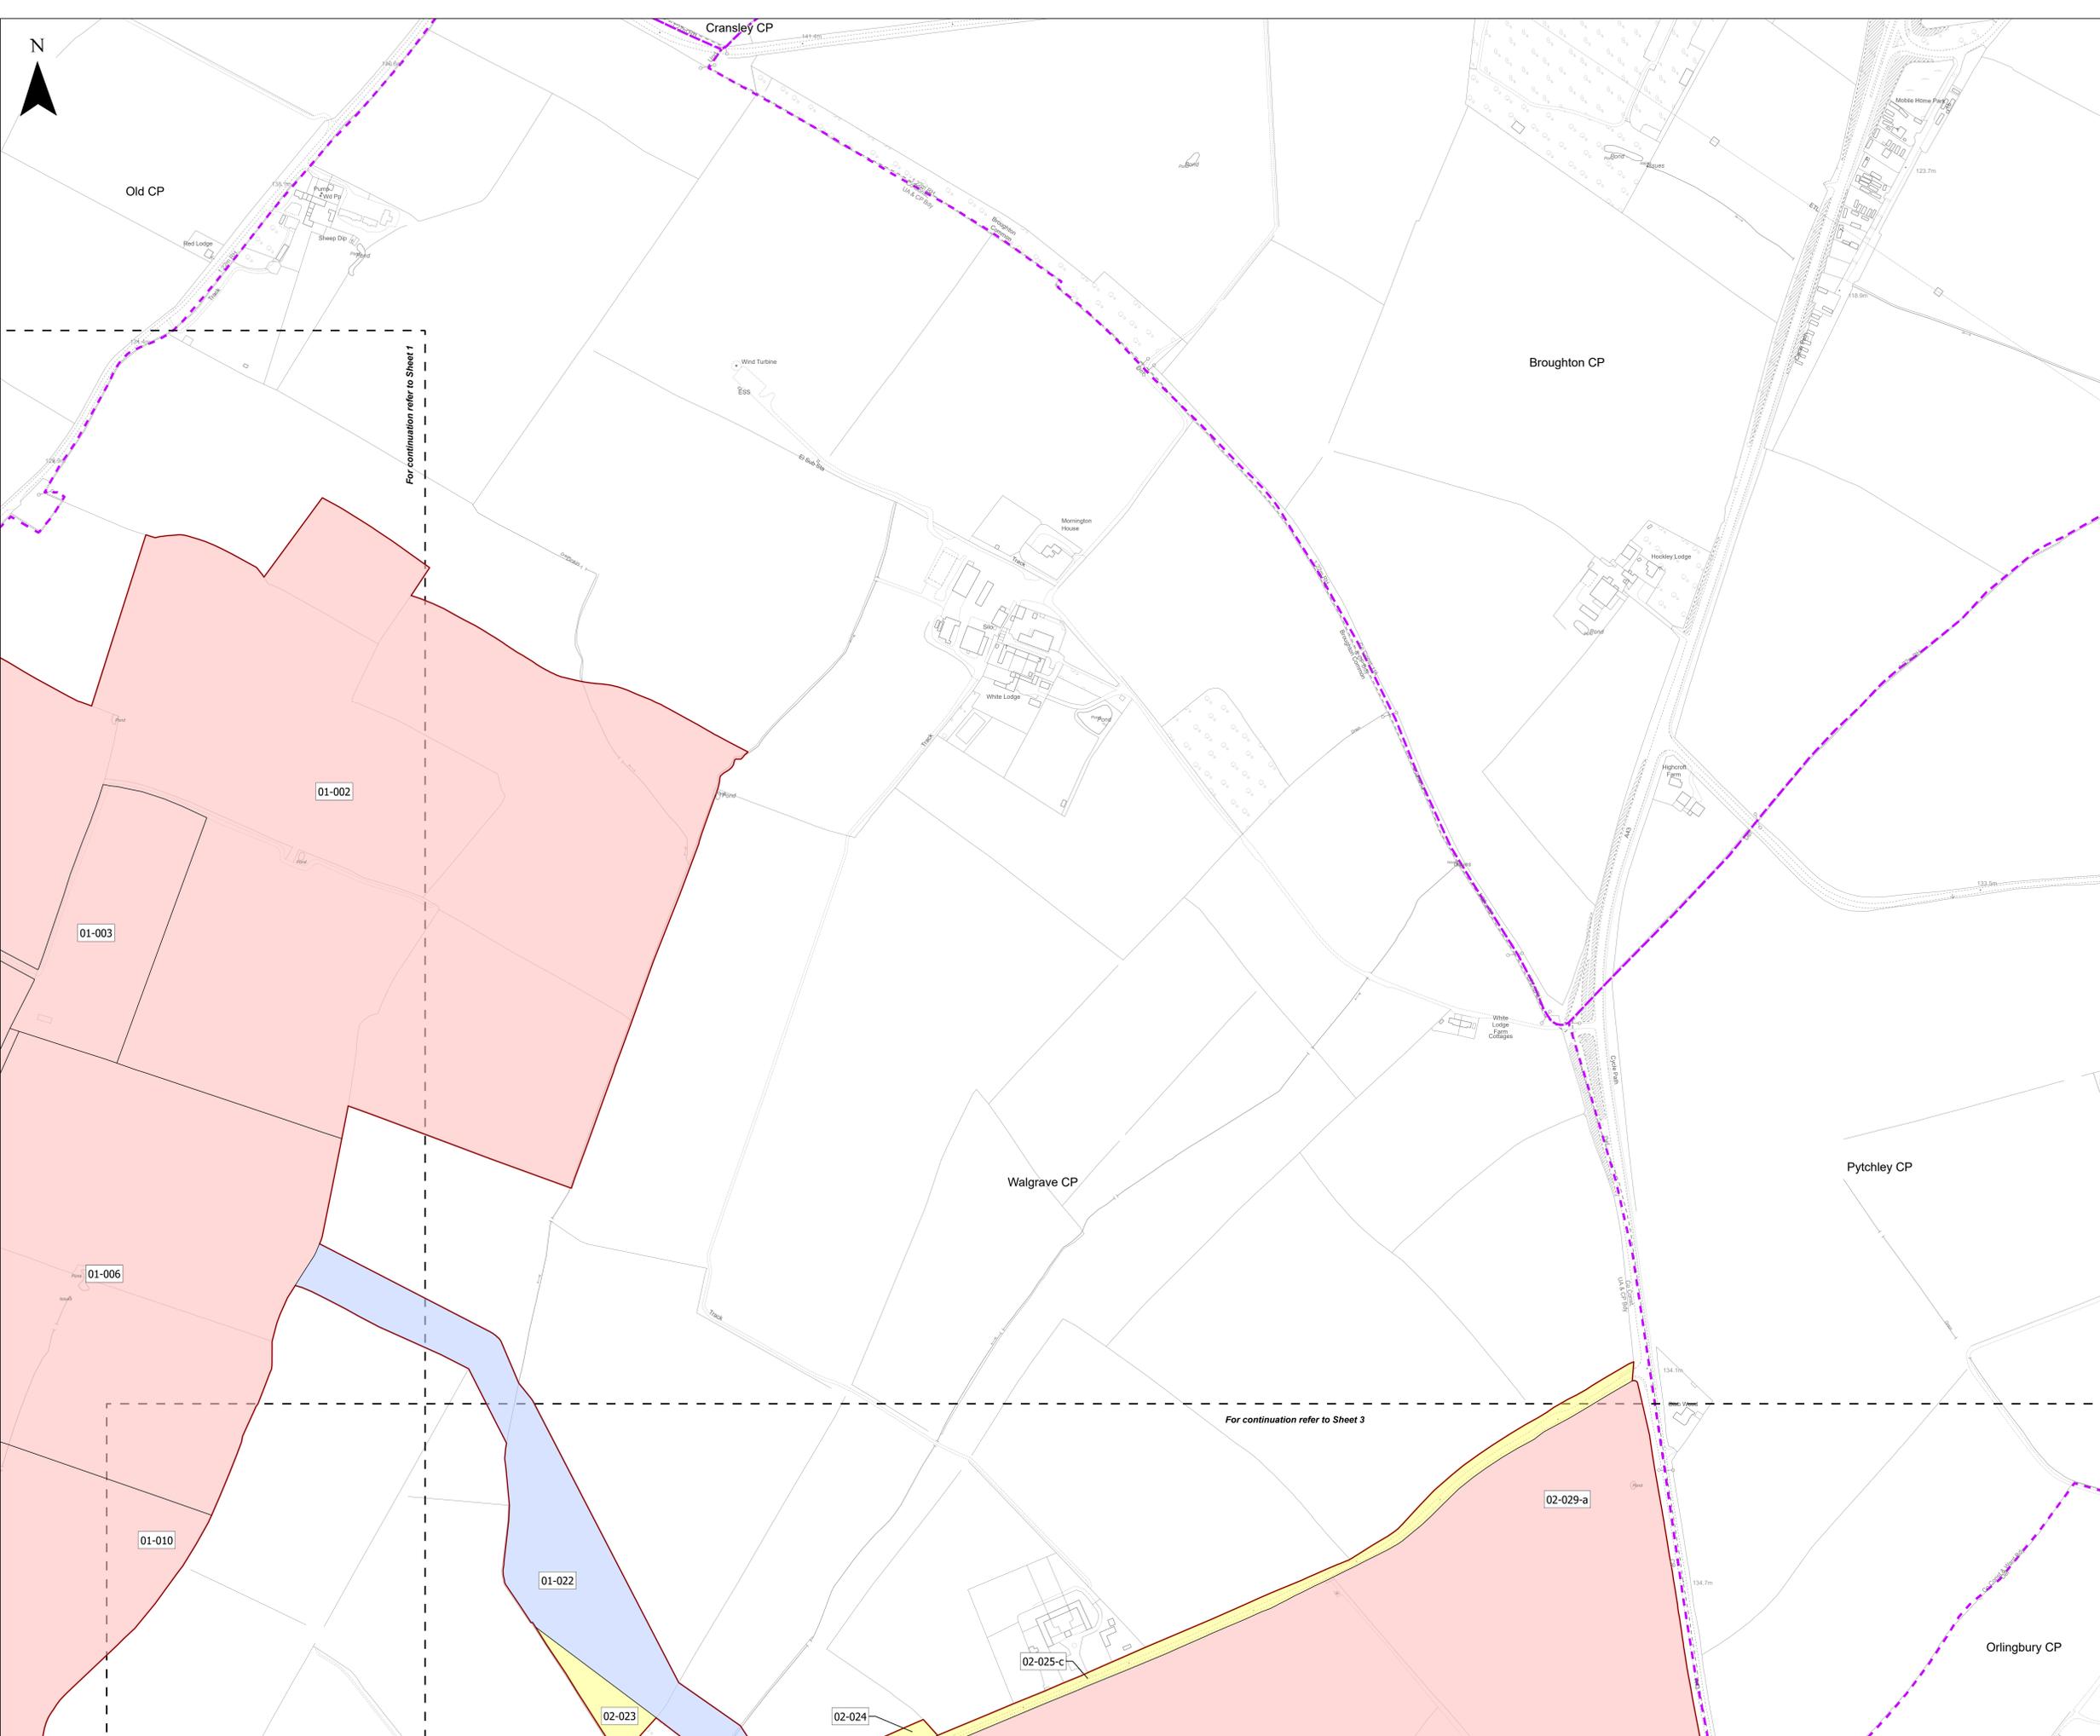

Key

-  Order Limits
-  No Land Take
-  Freehold to be compulsorily acquired and temporary use of land and in relation to which it is proposed that easements, servitudes and other private rights will cease to have effect
-  Temporary use of land and in relation to which it is proposed to temporarily suspend easements, servitudes and other private rights
-  New rights (including restrictions) to be compulsorily acquired and temporary use of land and in relation to which it is proposed that easements, servitudes and other private rights will be suspended or cease to have effect
-  Local Authority / Parish Boundary
-  Cut Line

Base map: © Crown Copyright and database rights 2025 OS Licence no. AC00084986. All rights reserved.

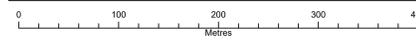

Scale: 1:2,500@ A0


APFP Regulation: 5(2)(i)	Application Doc No. EX5/GH2.2_E
Ref: IGP_GH_DCO_Land_Plan	Date: 23/02/2026
Drawn by: DLG	Checked by: JB

Land Plan
Revision E
Sheet 2 of 18



For continuation refer to Sheet 1

For continuation refer to Sheet 3

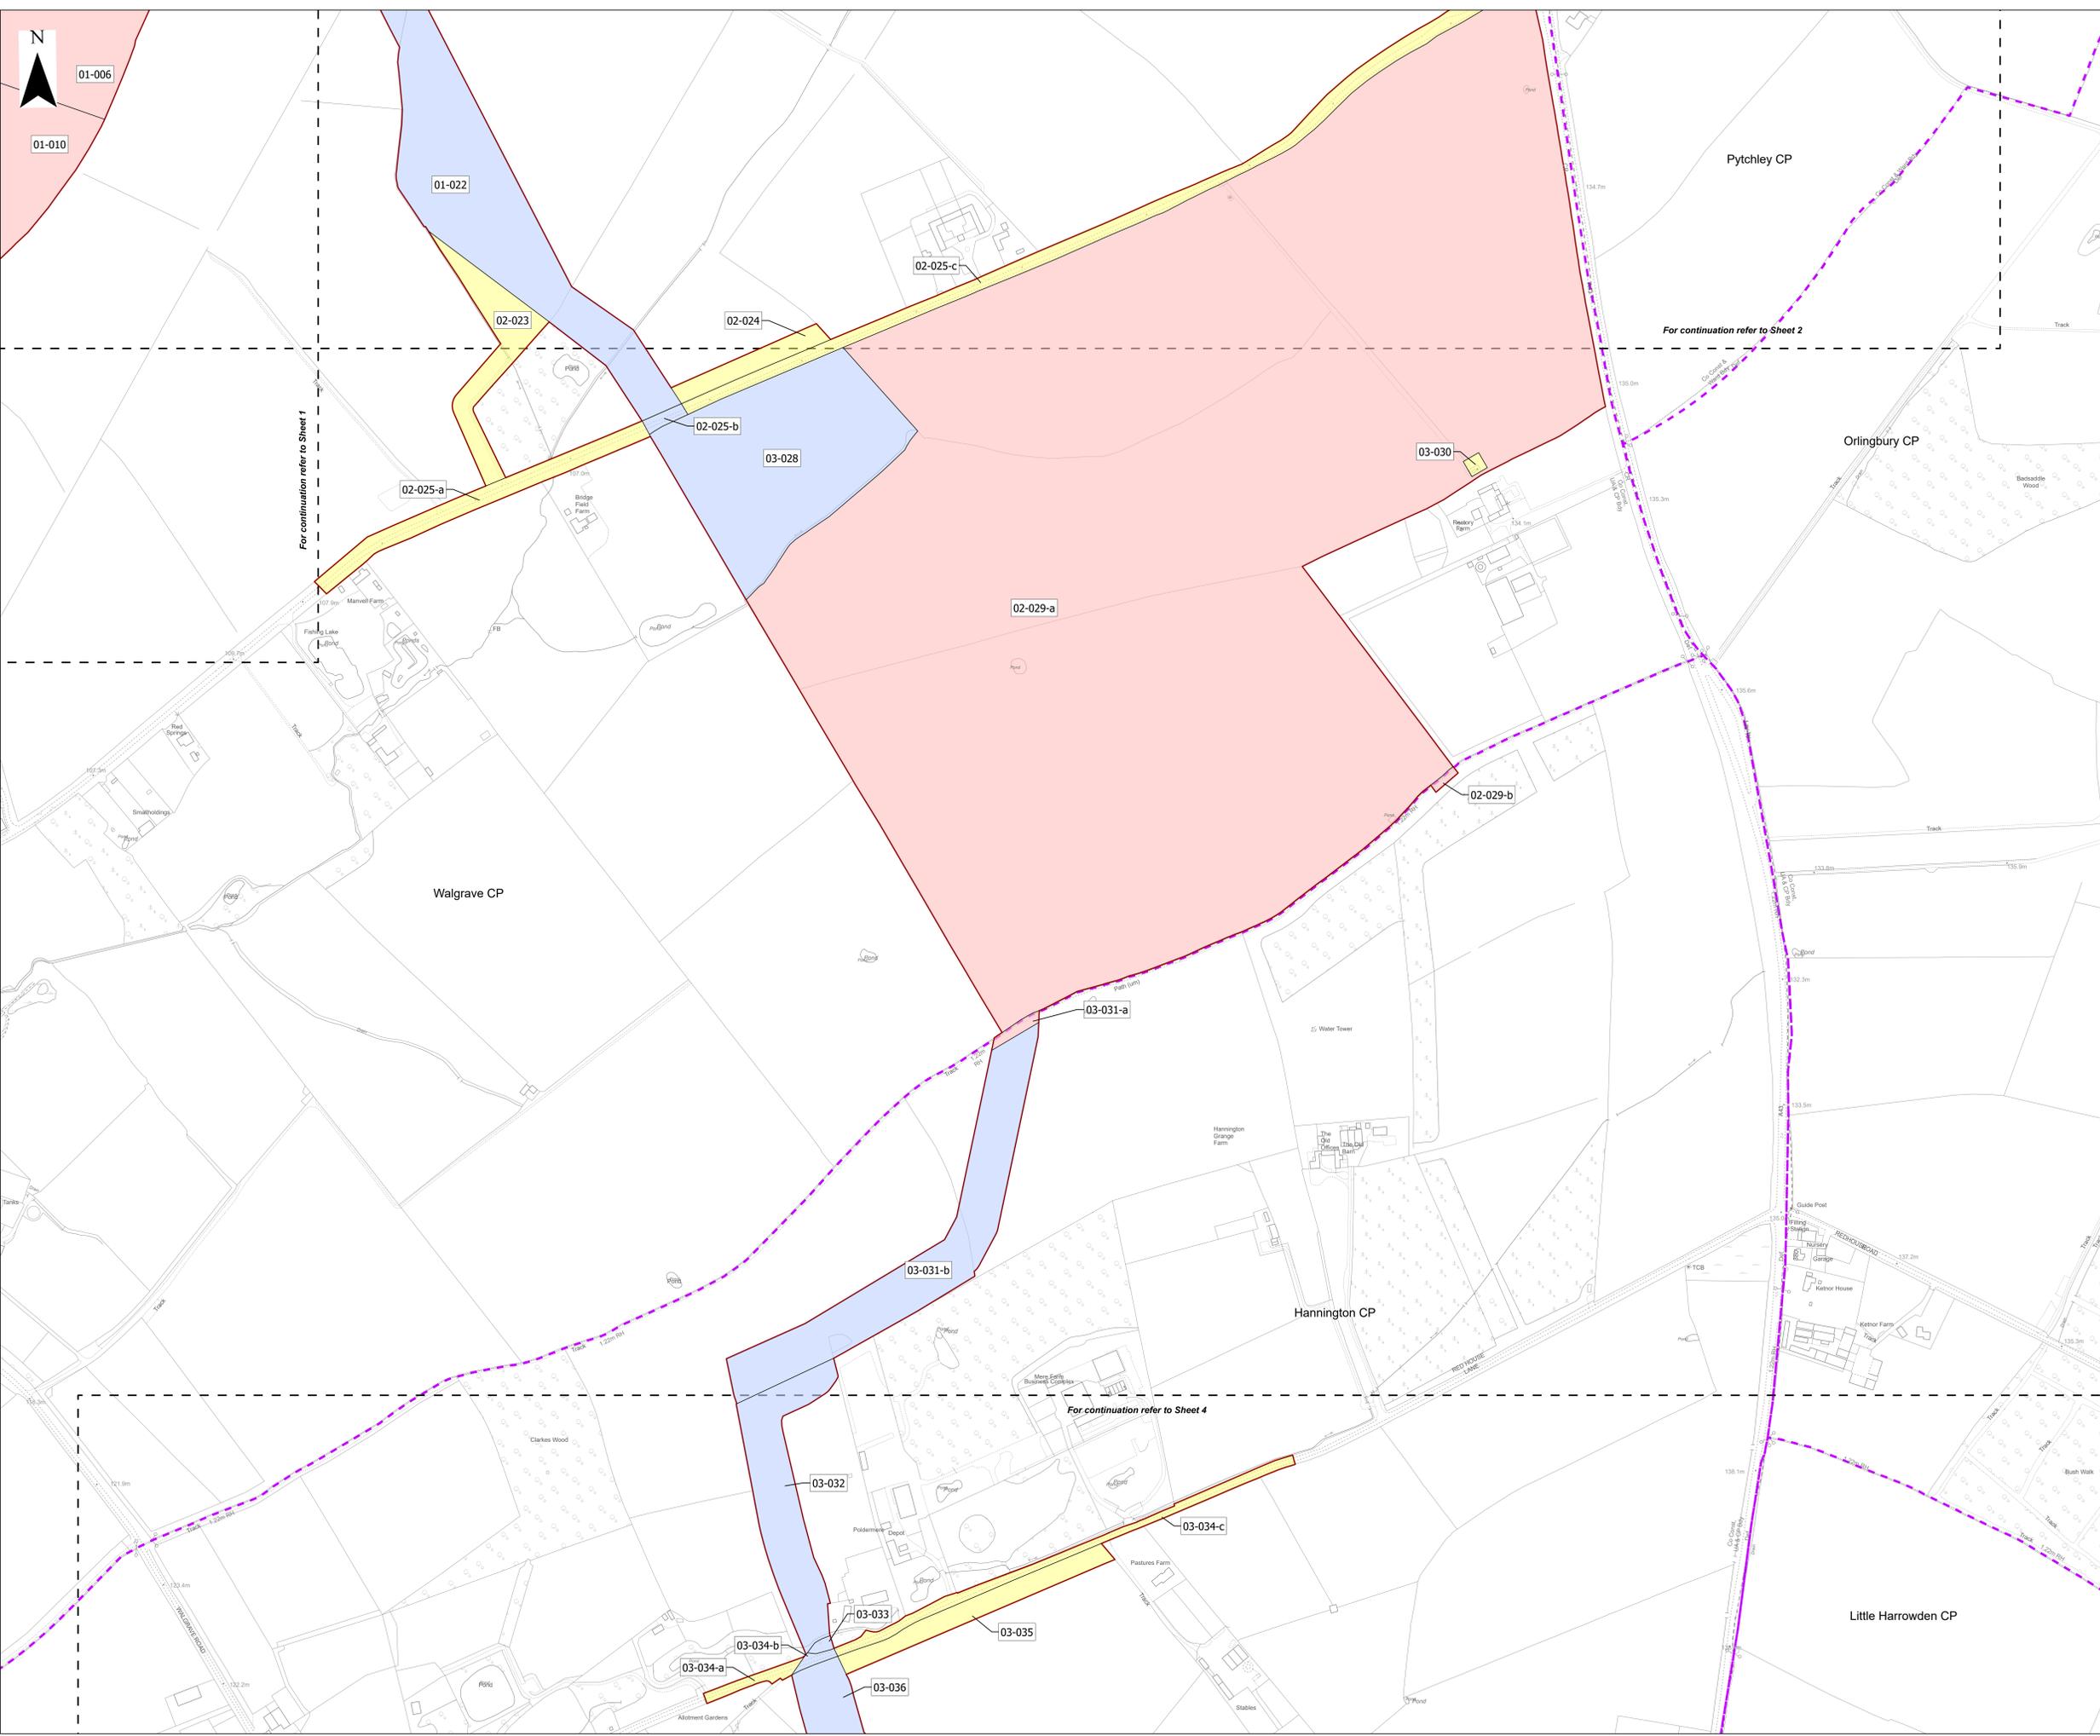

Key

- Order Limits
- No Land Take
- Freehold to be compulsorily acquired and temporary use of land and in relation to which it is proposed that easements, servitudes and other private rights will cease to have effect
- Temporary use of land and in relation to which it is proposed to temporarily suspend easements, servitudes and other private rights
- New rights (including restrictions) to be compulsorily acquired and temporary use of land and in relation to which it is proposed that easements, servitudes and other private rights will be suspended or cease to have effect
- Local Authority / Parish Boundary
- Cut Line

Base map: © Crown Copyright and database rights 2026 OS Licence No. AC00084986. All rights reserved.


0 100 200 300 400
Metres

Scale: 1:2,500@ A0

APFP Regulation: 5(2)(i)	Application Doc No. EX5/GH2.2_E
Ref: IGP_GH_DCO_Land_Plan	Date: 23/02/2026
Drawn by: DLG	Checked by: JB


Land Plan
 Revision E
 Sheet 3 of 18


GREEN HILL SOLAR FARM

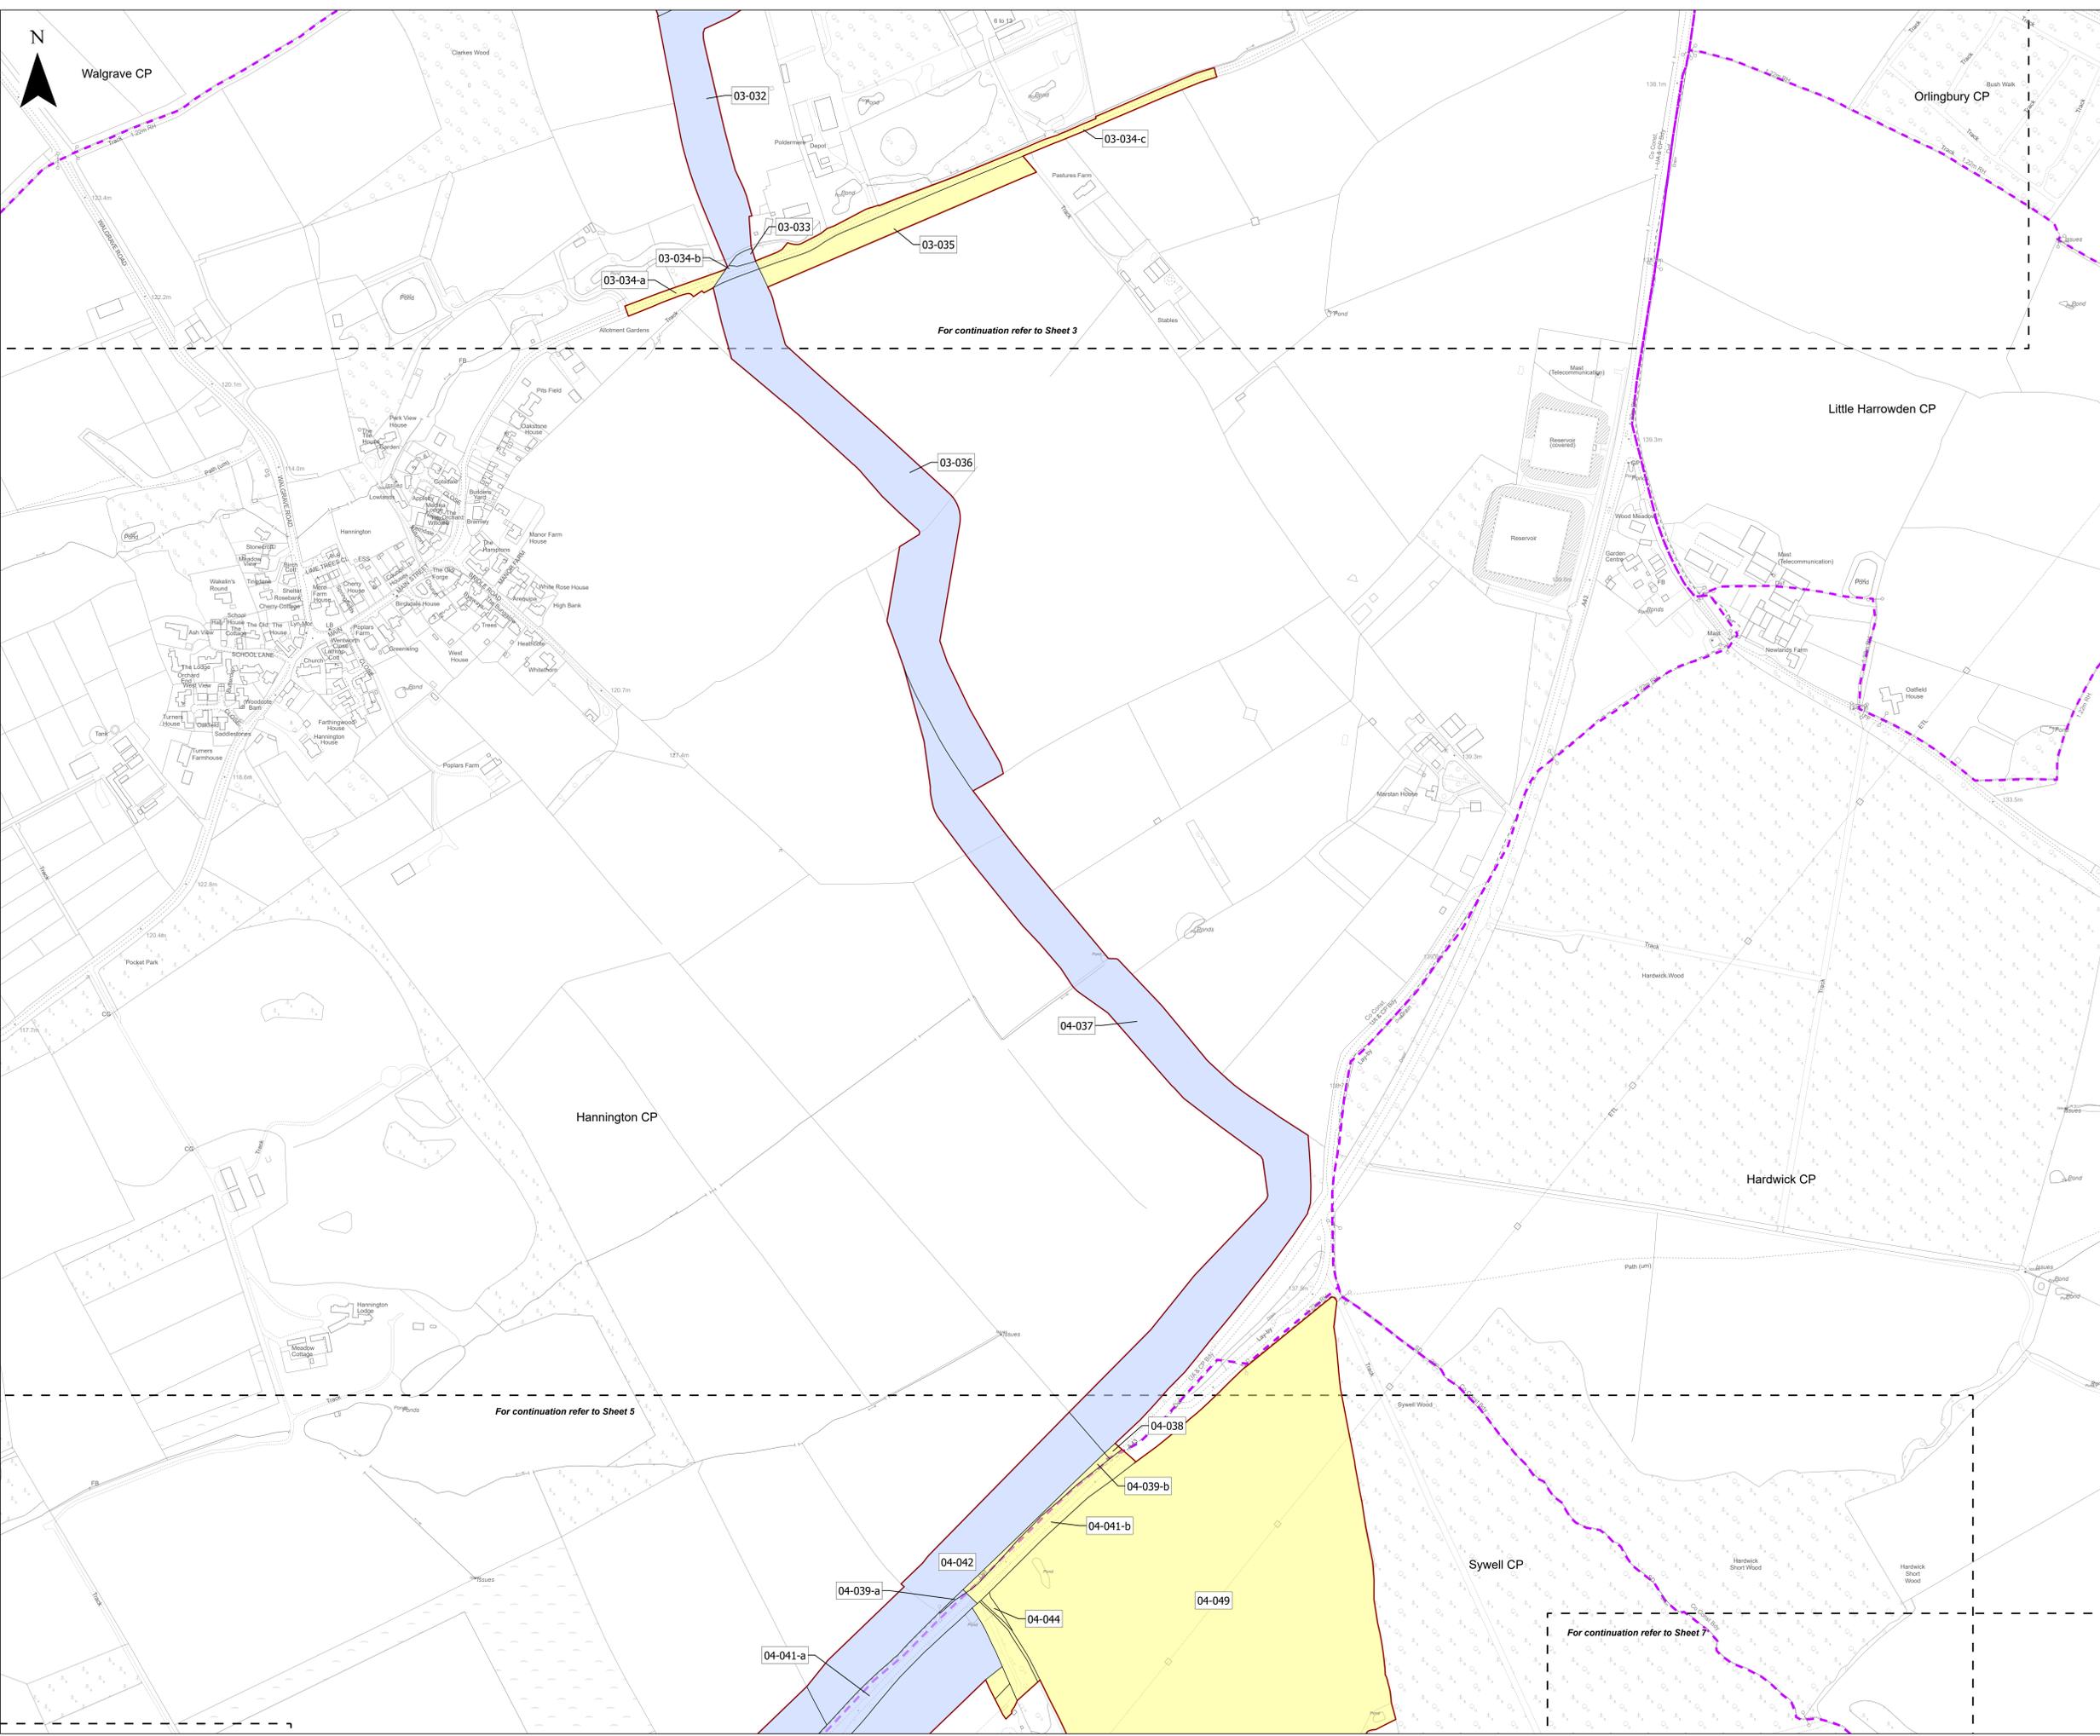

- Key**
- Order Limits
 - No Land Take
 - Freehold to be compulsorily acquired and temporary use of land and in relation to which it is proposed that easements, servitudes and other private rights will cease to have effect
 - Temporary use of land and in relation to which it is proposed to temporarily suspend easements, servitudes and other private rights
 - New rights (including restrictions) to be compulsorily acquired and temporary use of land and in relation to which it is proposed that easements, servitudes and other private rights will be suspended or cease to have effect
 - Local Authority / Parish Boundary
 - Cut Line

Base map: © Crown Copyright and database rights 2025 OS Licence no. AC000849896. All rights reserved.

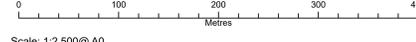


Scale: 1:2,500@A0

APFP Regulation: 5(2)(i)	Application Doc No. EX5/GH2.2_E
Ref: IGP_GH_DCO_Land_Plan	Date: 23/02/2026
Drawn by: DLG	Checked by: JB


Land Plan
Revision E
Sheet 4 of 18



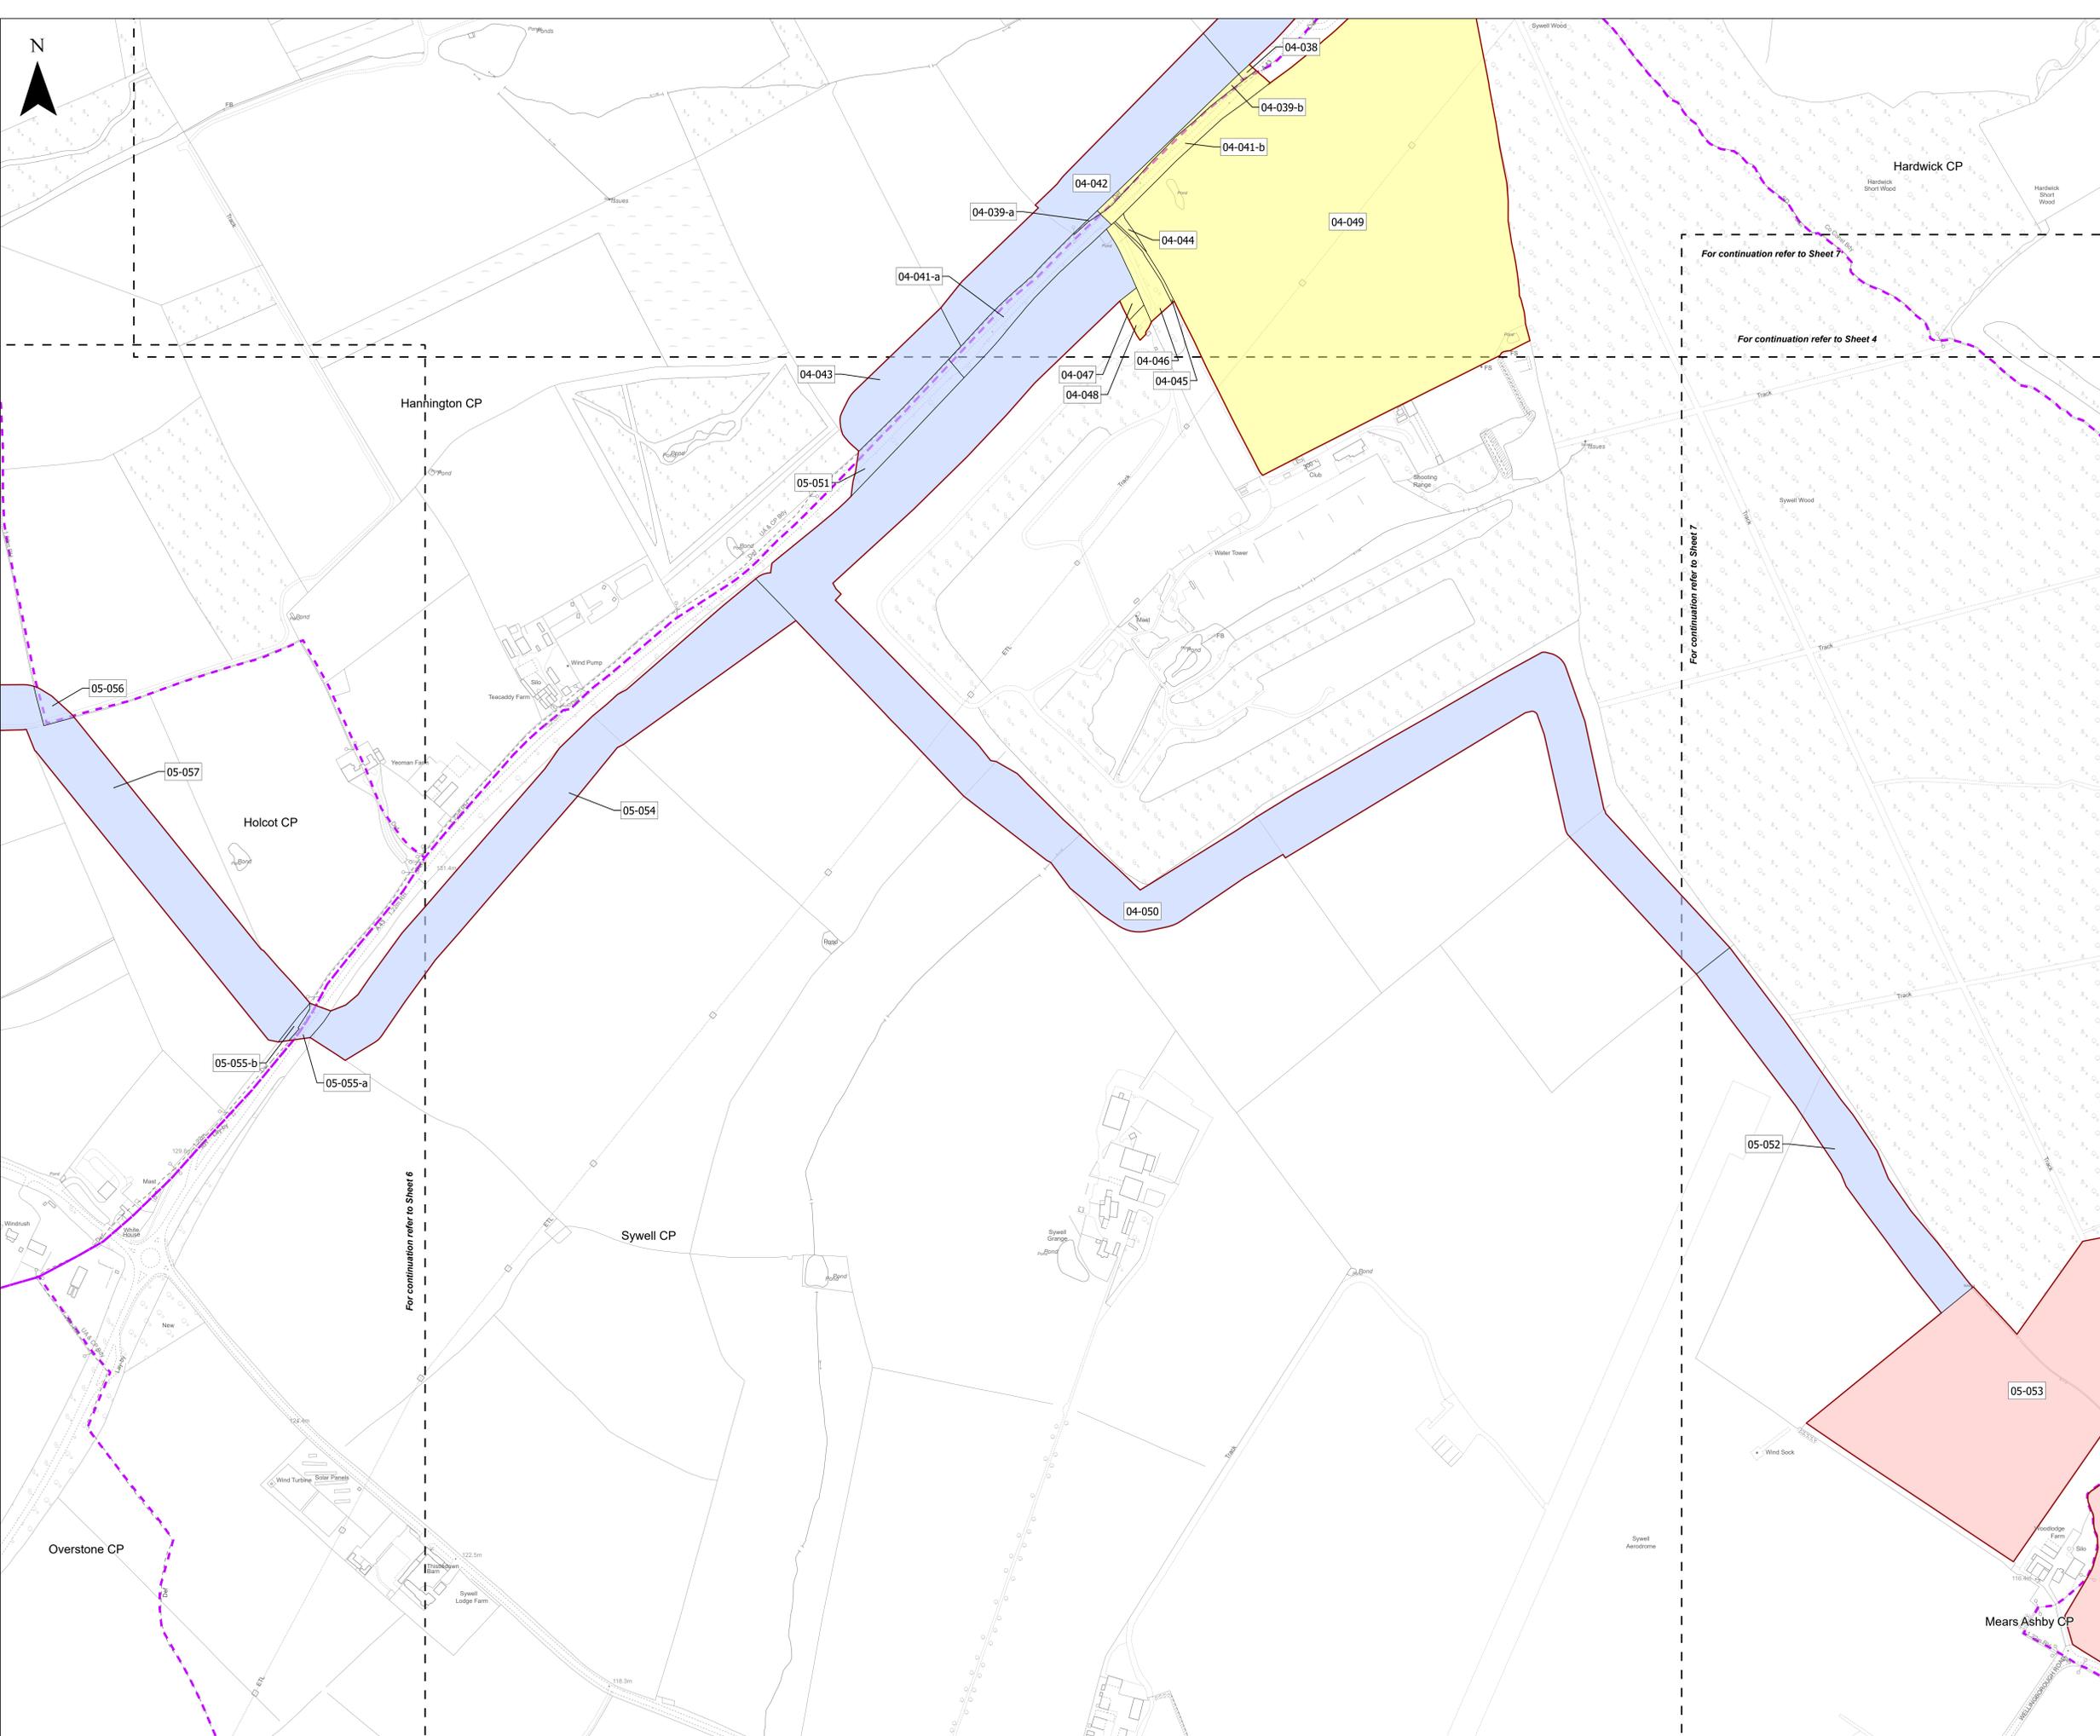

Key

- Order Limits
- No Land Take
- Freehold to be compulsorily acquired and temporary use of land and in relation to which it is proposed that easements, servitudes and other private rights will cease to have effect
- Temporary use of land and in relation to which it is proposed to temporarily suspend easements, servitudes and other private rights
- New rights (including restrictions) to be compulsorily acquired and temporary use of land and in relation to which it is proposed that easements, servitudes and other private rights will be suspended or cease to have effect
- Local Authority / Parish Boundary
- Cut Line

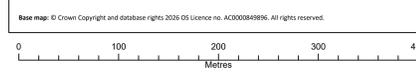


Scale: 1:2,500@ A0

APFP Regulation: 5(2)(i)	Application Doc No. EX5/GH2.2_E
Ref: IGP_GH_DCO_Land_Plan	Date: 23/02/2026
Drawn by: DLG	Checked by: JB

Land Plan
Revision E
Sheet 5 of 18




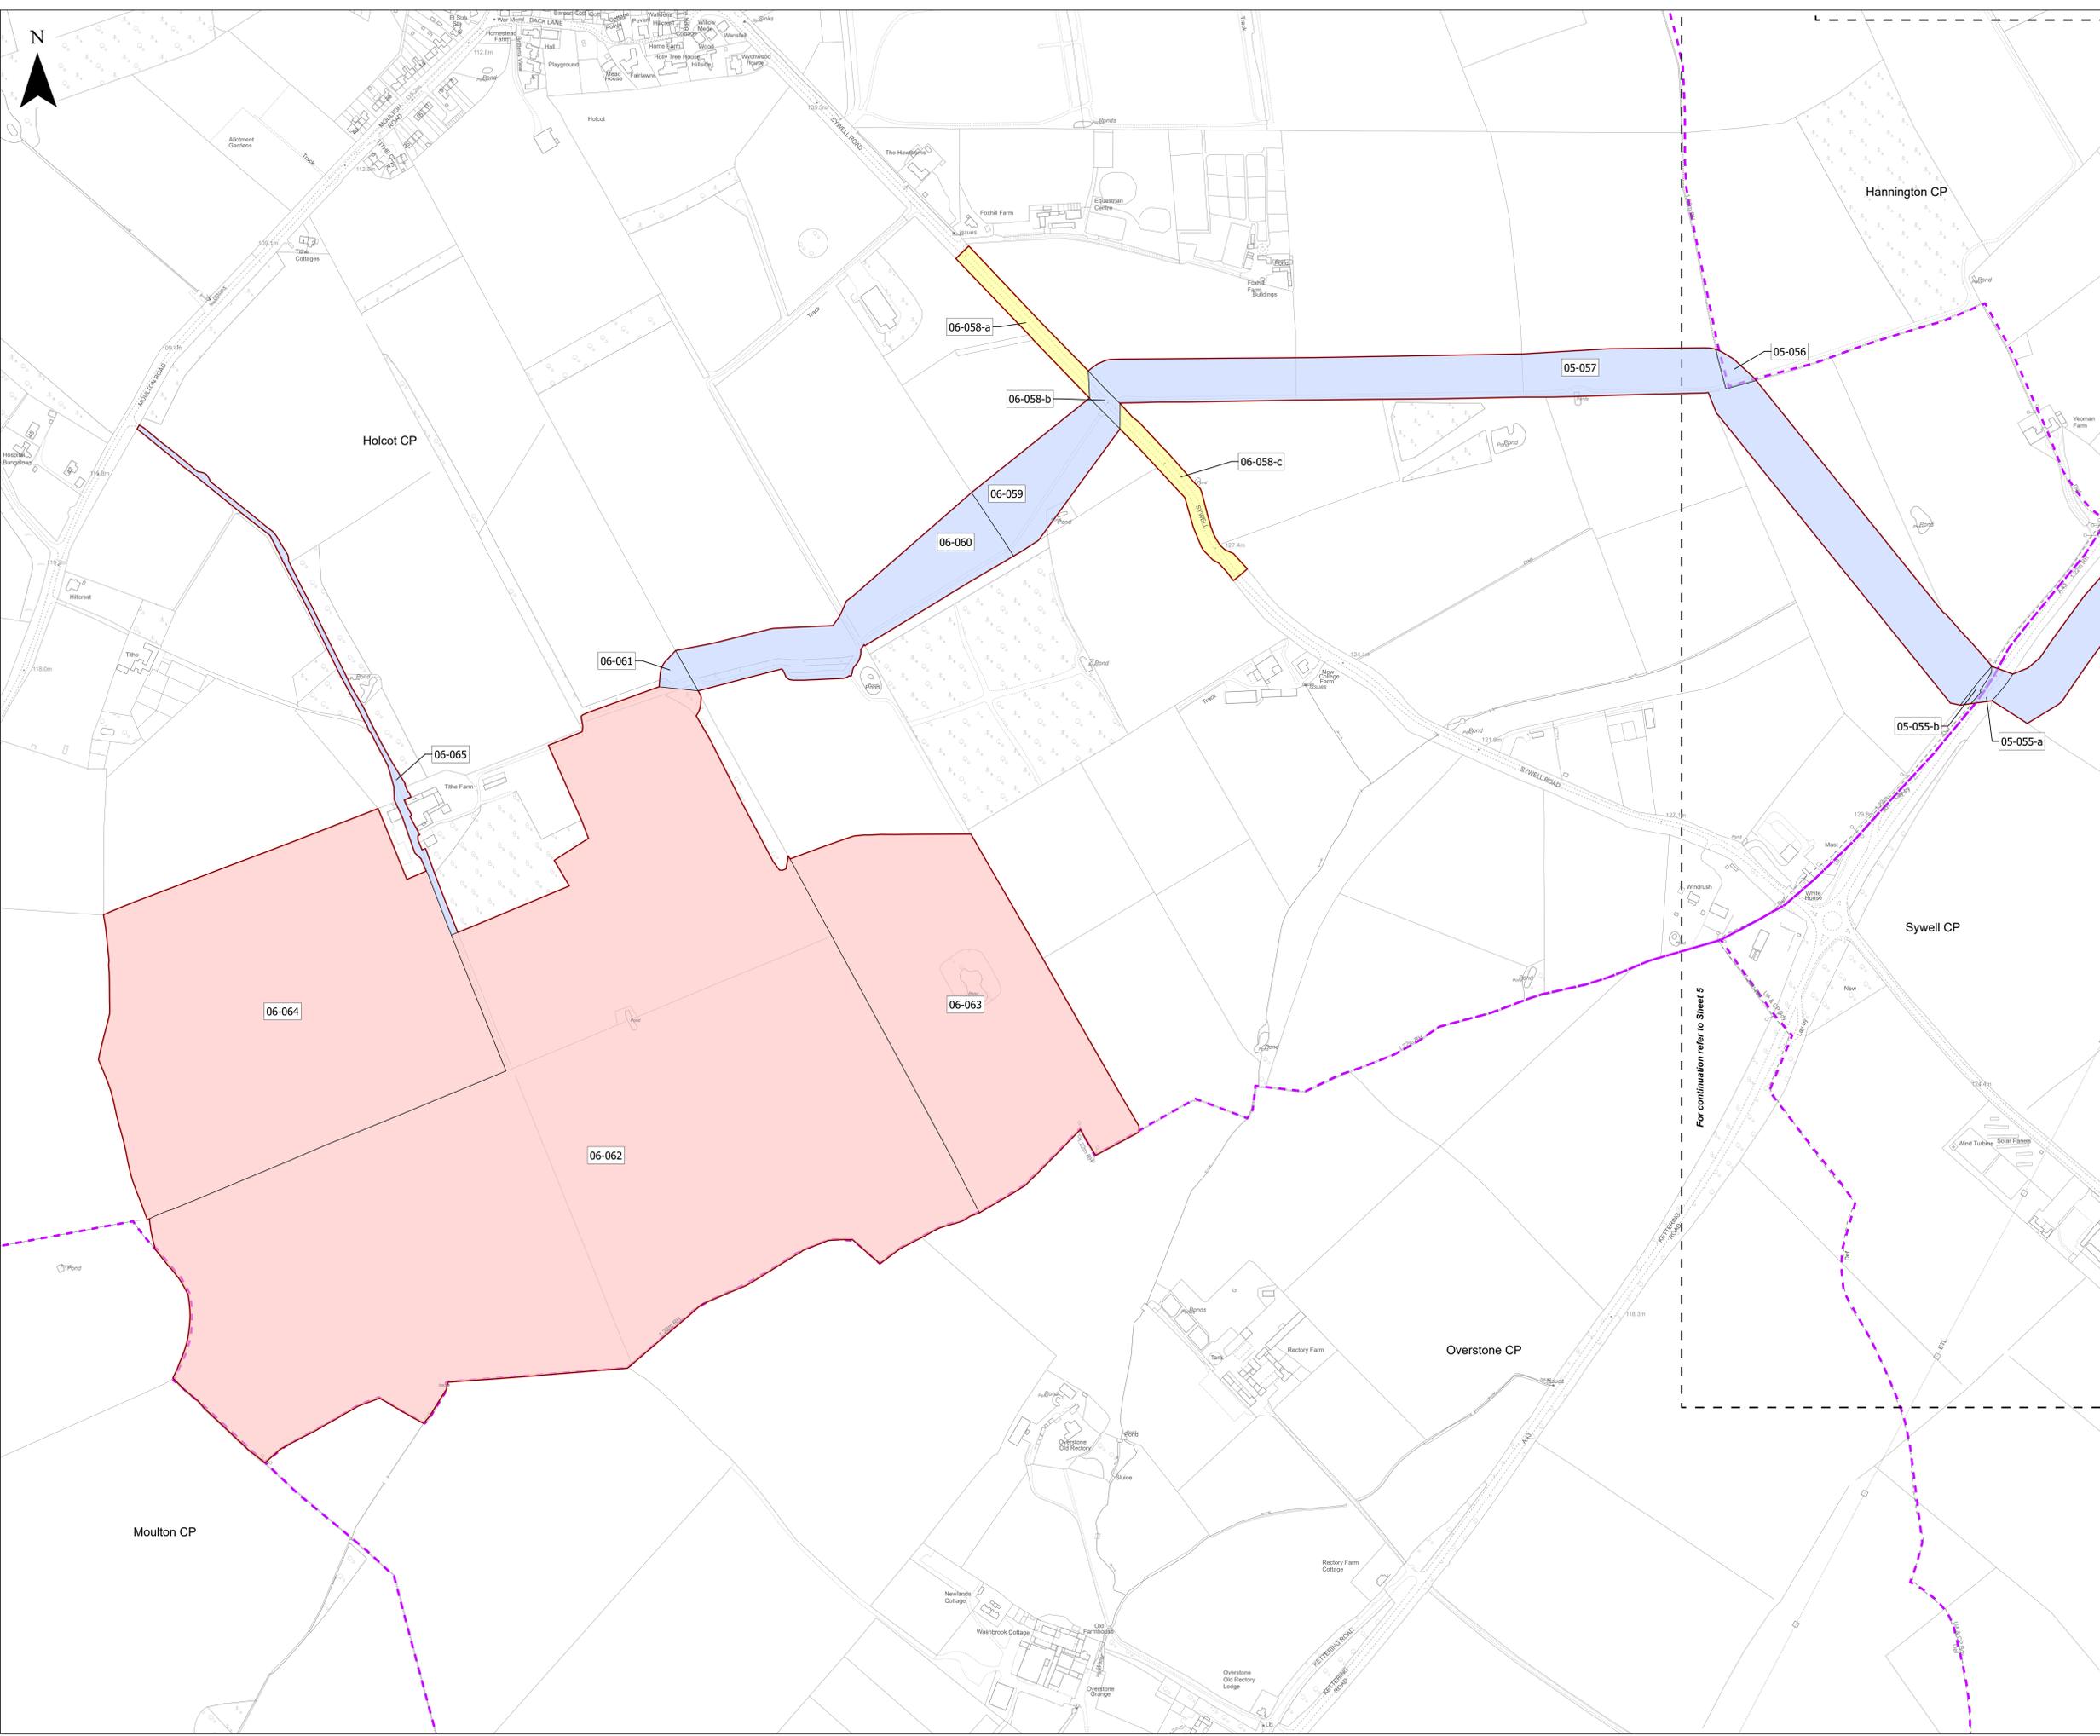

Key

-  Order Limits
-  No Land Take
-  Freehold to be compulsorily acquired and temporary use of land and in relation to which it is proposed that easements, servitudes and other private rights will cease to have effect
-  Temporary use of land and in relation to which it is proposed to temporarily suspend easements, servitudes and other private rights
-  New rights (including restrictions) to be compulsorily acquired and temporary use of land and in relation to which it is proposed that easements, servitudes and other private rights will be suspended or cease to have effect
-  Local Authority / Parish Boundary
-  Cut Line

Base map: © Crown Copyright and database rights 2025 OS Licence no. AC00084986. All rights reserved.



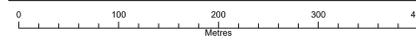


Scale: 1:2,500 @ A0

APFP Regulation: 5(2)(i)	Application Doc No. EX5/GH2.2_E
Ref: IGP_GH_DCO_Land_Plan	Date: 23/02/2026
Drawn by: DLG	Checked by: JB


Land Plan
Revision E
Sheet 6 of 18



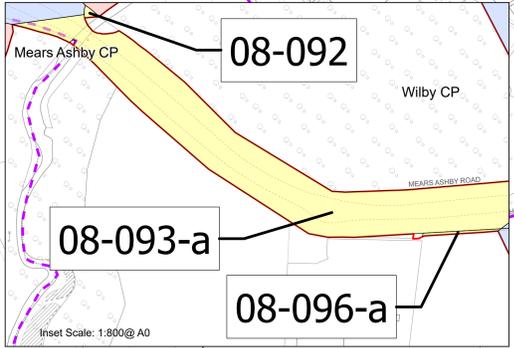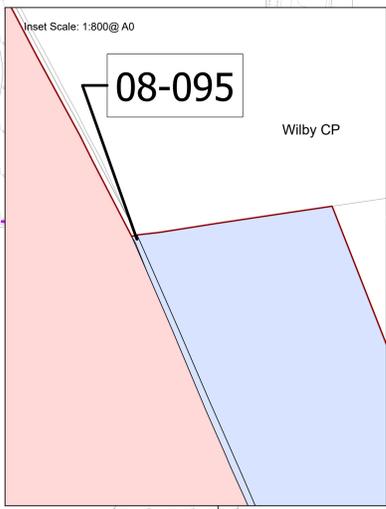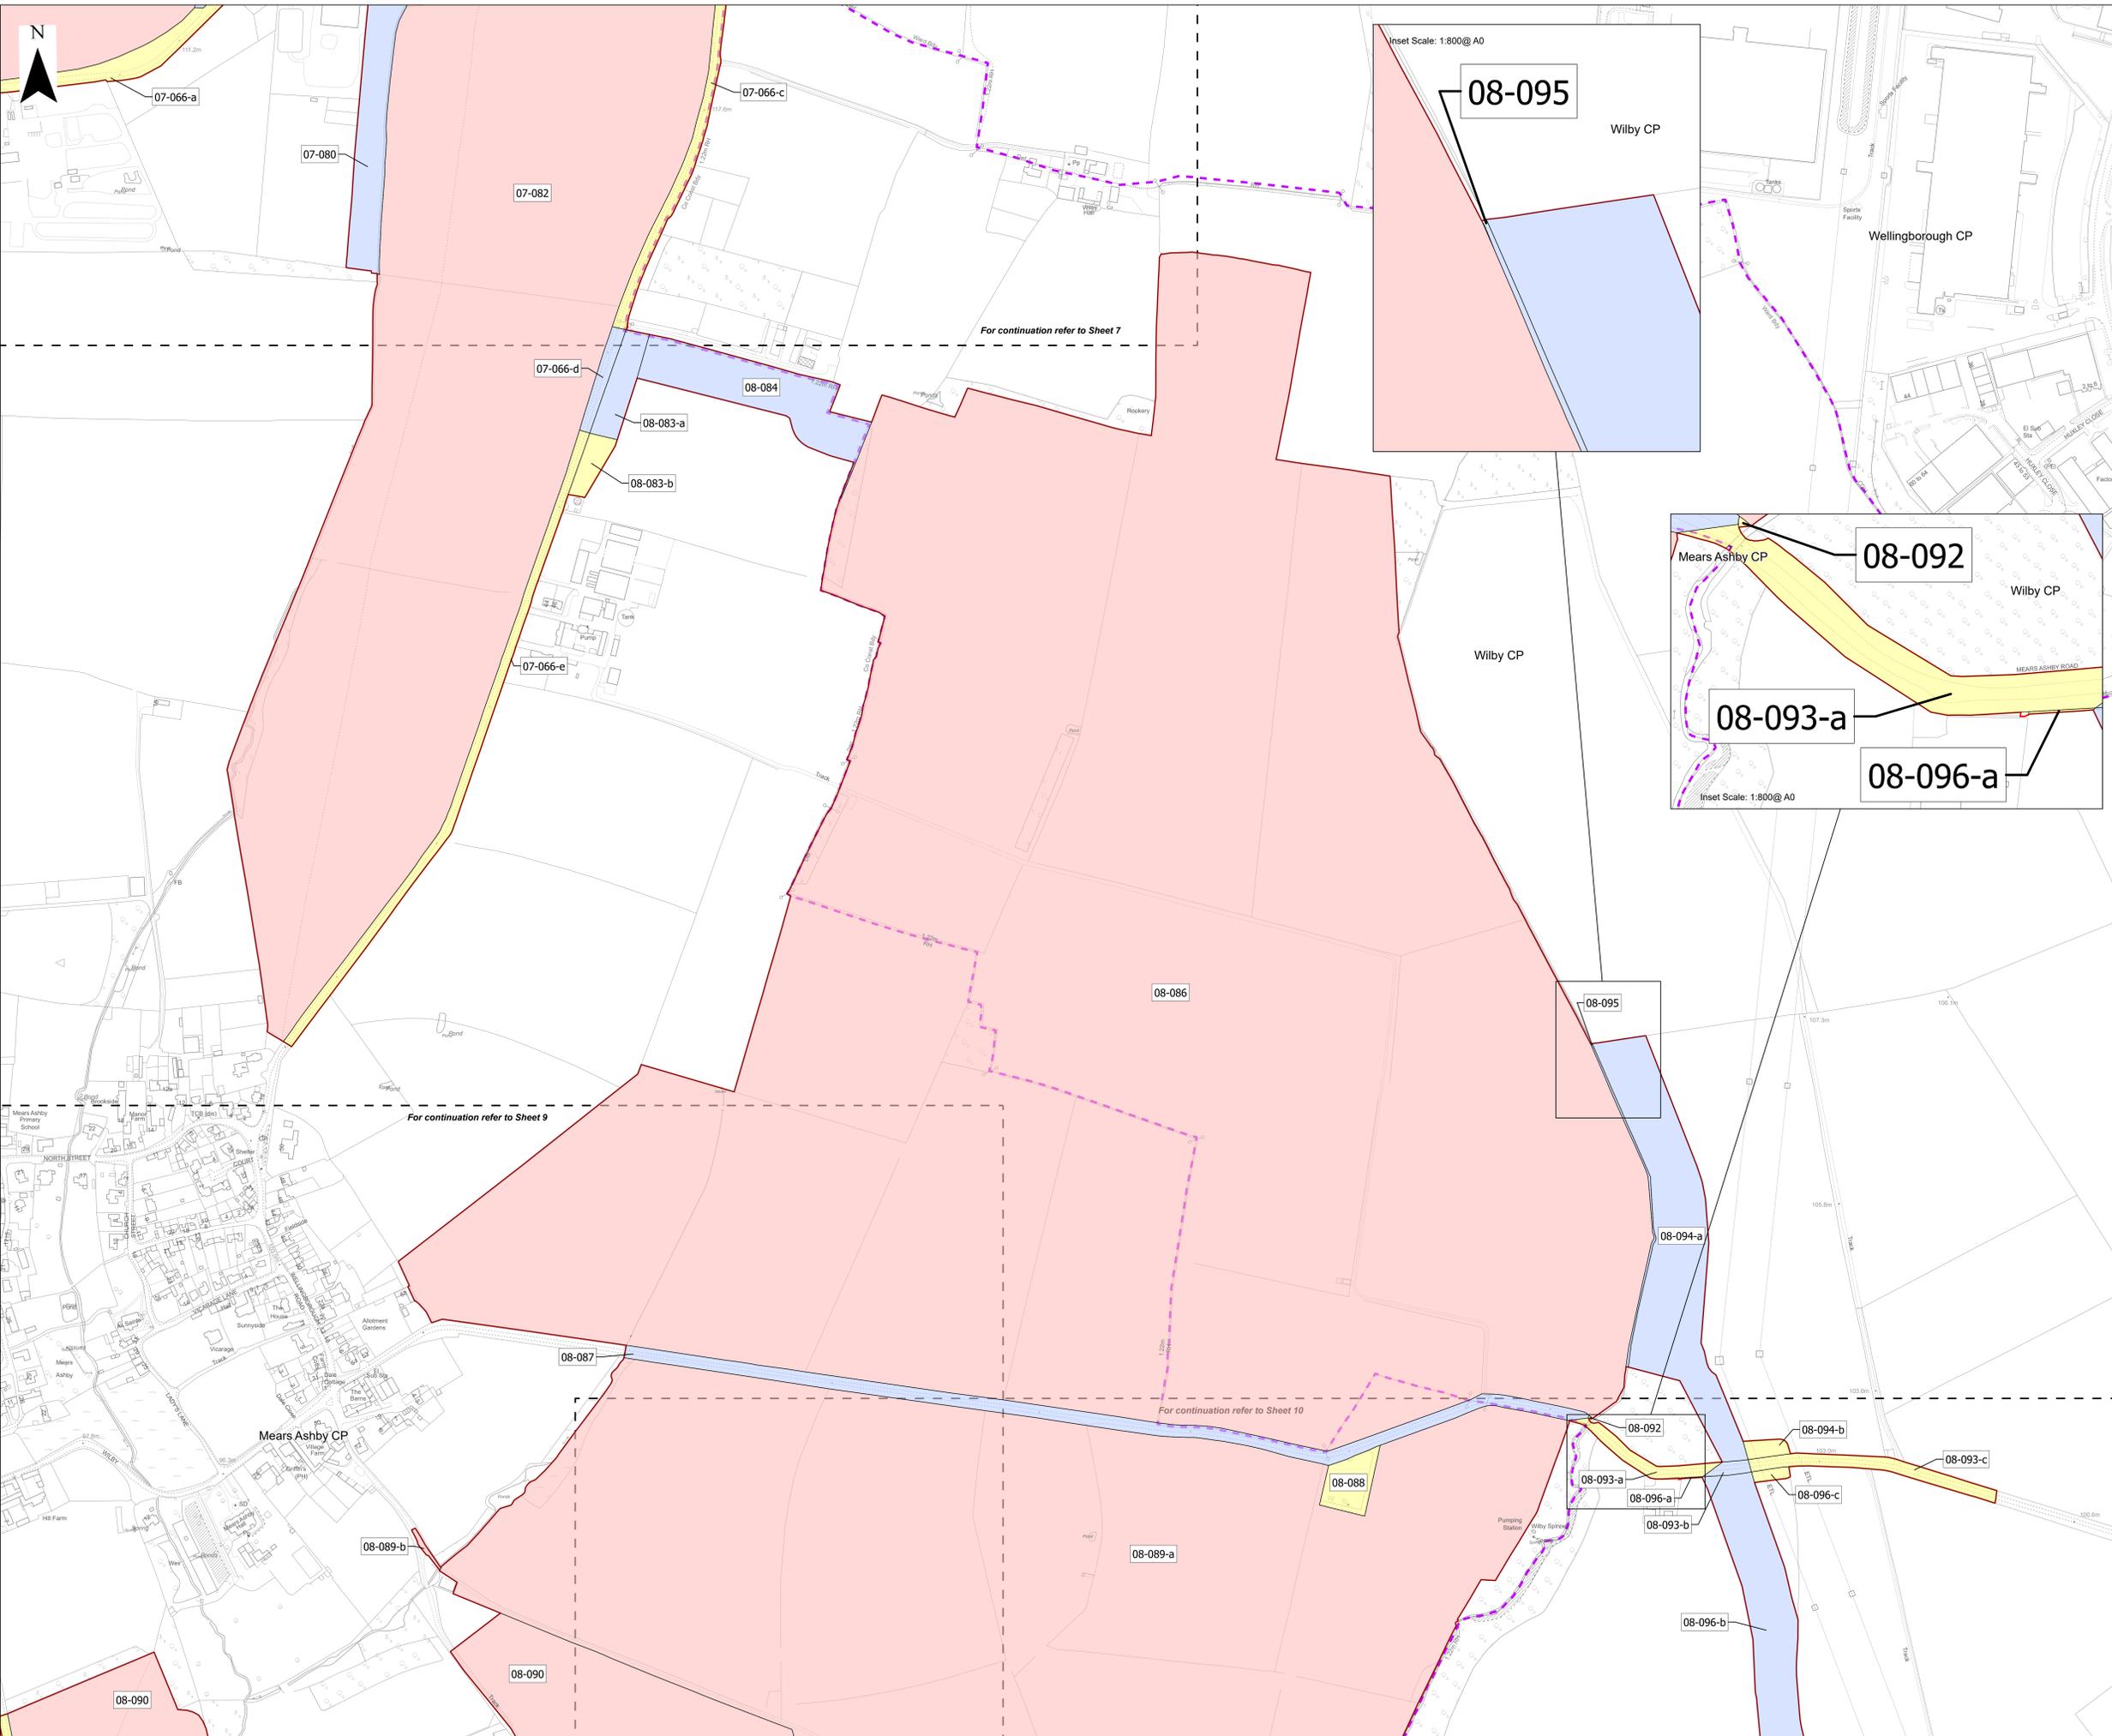


- Key**
- Order Limits
 - No Land Take
 - Freehold to be compulsorily acquired and temporary use of land and in relation to which it is proposed that easements, servitudes and other private rights will cease to have effect
 - Temporary use of land and in relation to which it is proposed to temporarily suspend easements, servitudes and other private rights
 - New rights (including restrictions) to be compulsorily acquired and temporary use of land and in relation to which it is proposed that easements, servitudes and other private rights will be suspended or cease to have effect
 - Local Authority / Parish Boundary
 - Cut Line

Base map: © Crown Copyright and database rights 2025 OS Licence no. AC000084986. All rights reserved.

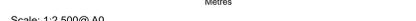


Scale: 1:2,500@A0

APFP Regulation: 5(2)(i)	Application Doc No. EX5/GH2.2_E
Ref: IGP_GH_DCO_Land_Plan	Date: 23/02/2026
Drawn by: DLG	Checked by: JB

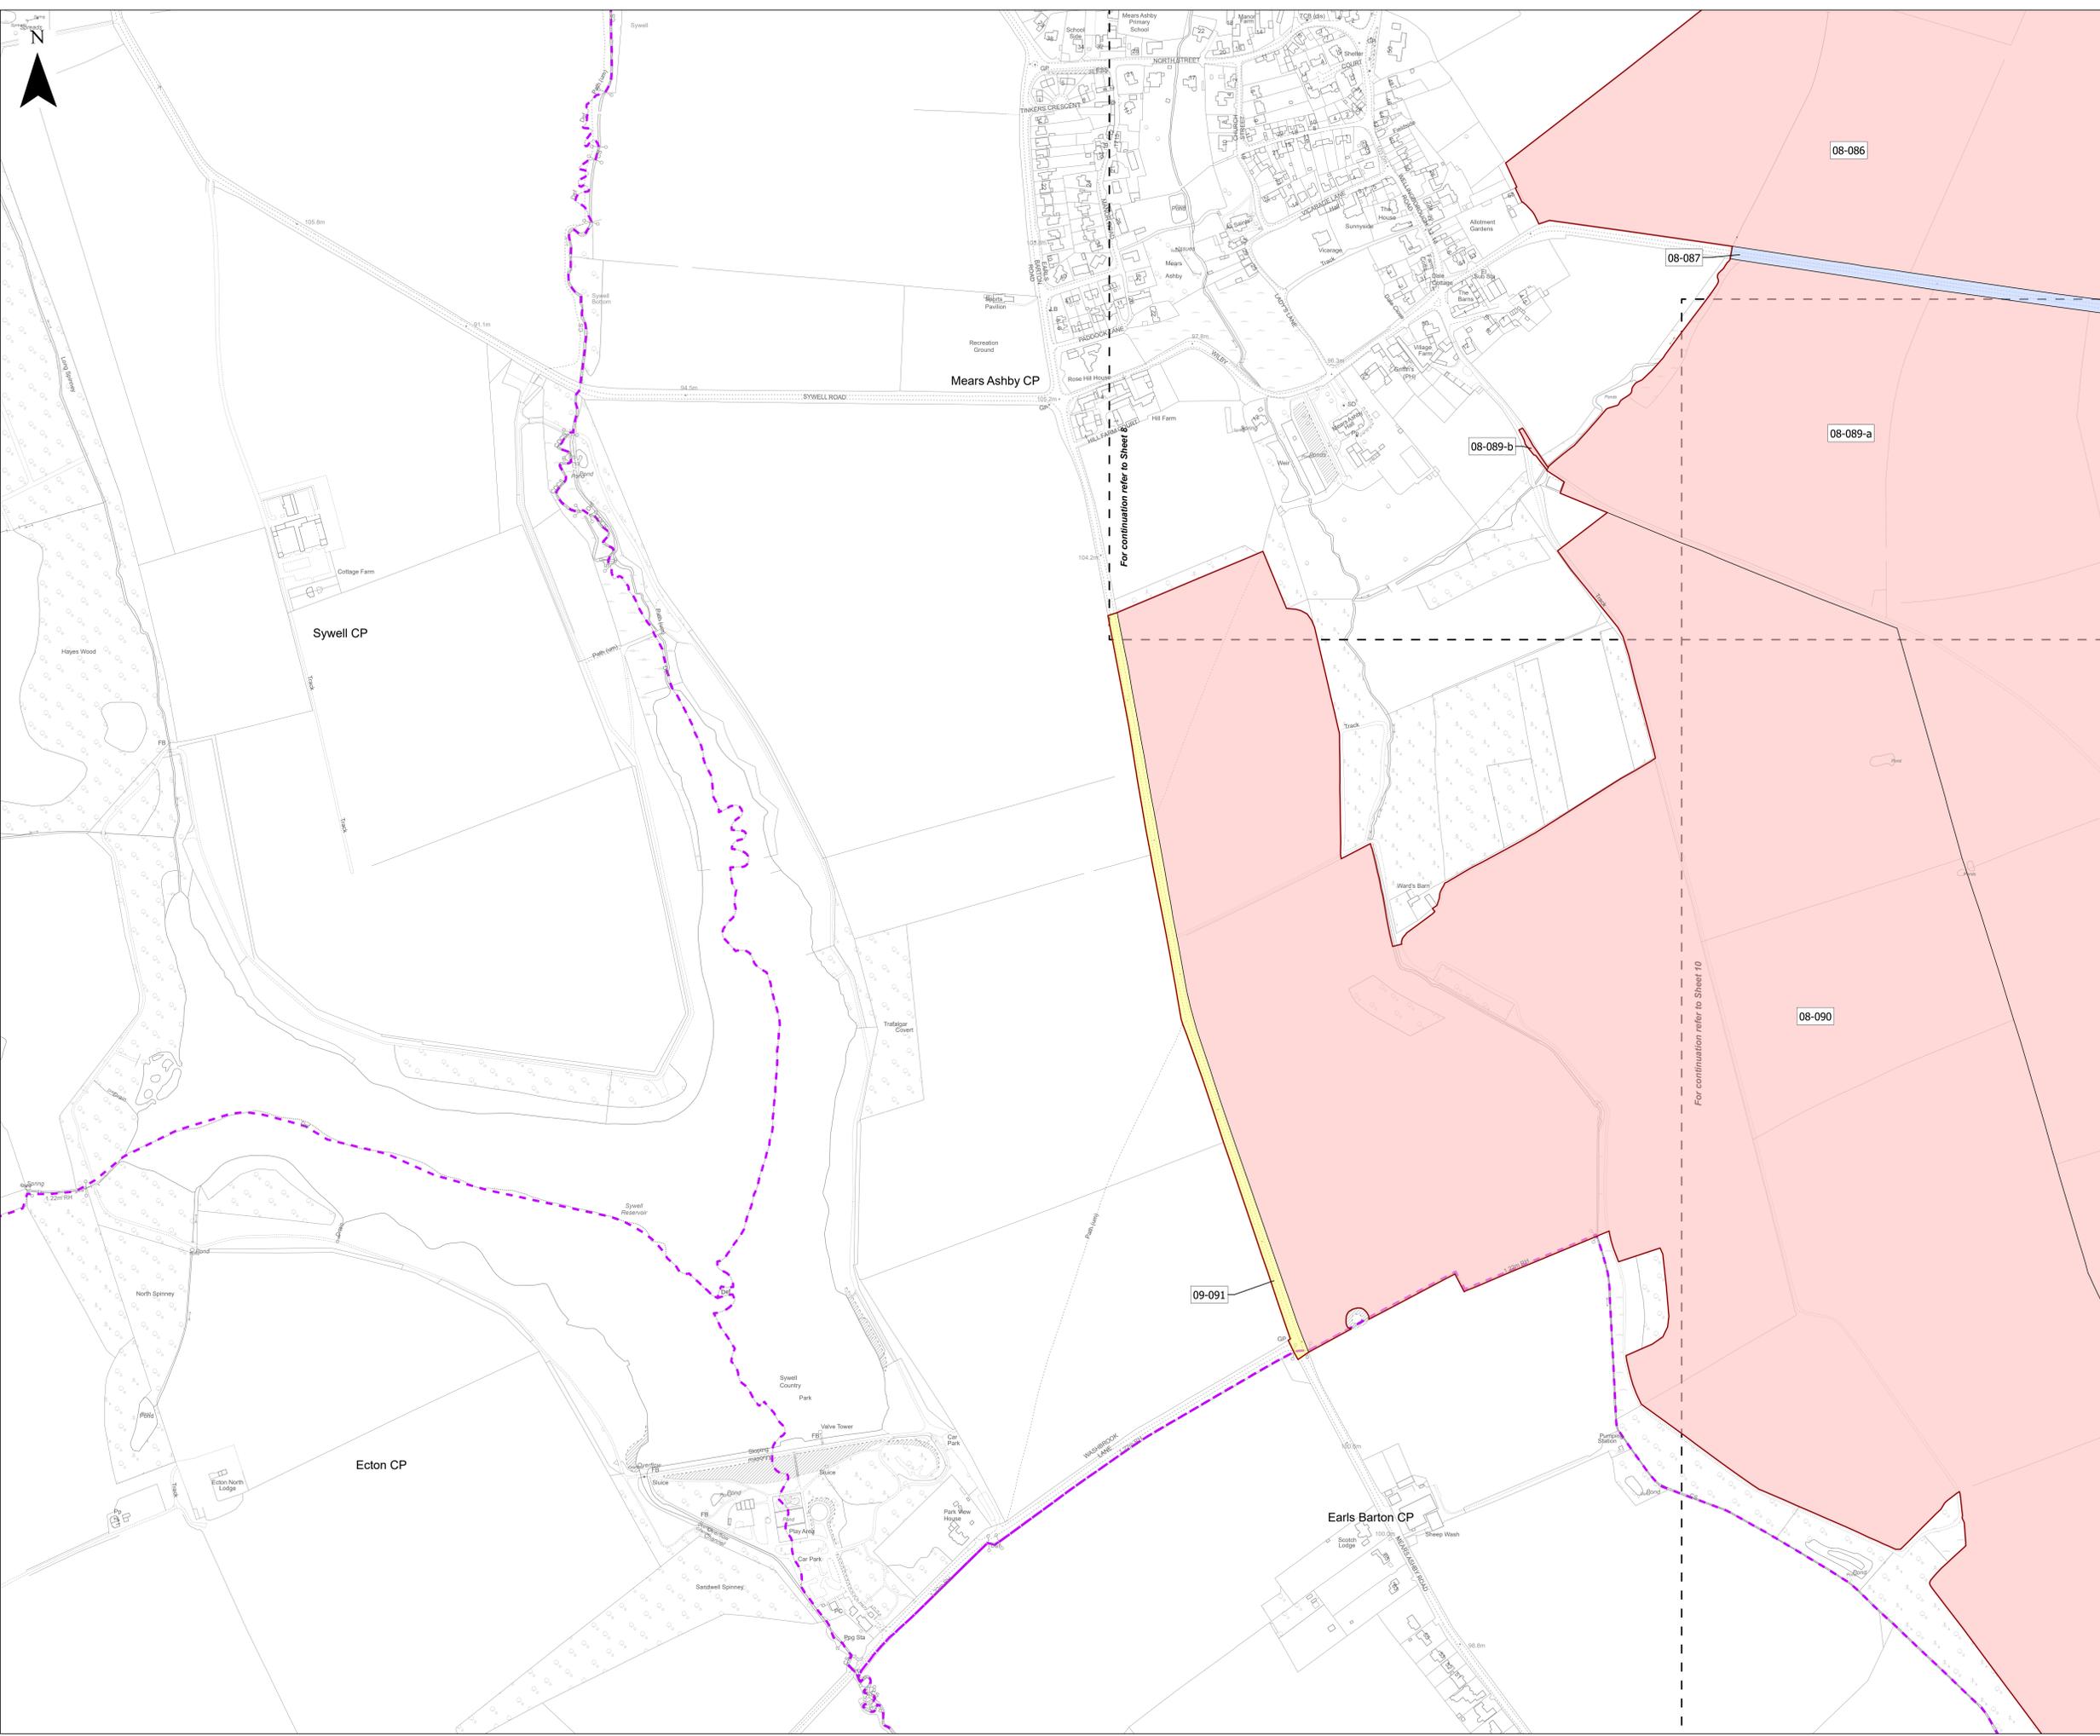

- Key**
- Order Limits
 - No Land Take
 - Freehold to be compulsorily acquired and temporary use of land and in relation to which it is proposed that easements, servitudes and other private rights will cease to have effect
 - Temporary use of land and in relation to which it is proposed to temporarily suspend easements, servitudes and other private rights
 - New rights (including restrictions) to be compulsorily acquired and temporary use of land and in relation to which it is proposed that easements, servitudes and other private rights will be suspended or cease to have effect
 - Local Authority / Parish Boundary
 - Cut Line

Base map: © Crown Copyright and database rights 2025 OS Licence no. AC00084986. All rights reserved.

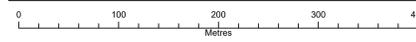


Scale: 1:2,500@ A0

APFP Regulation: 5(2)(i)	Application Doc No. EX5/GH2.2_E
Ref: IGP_GH_DCO_Land_Plan	Date: 23/02/2026
Drawn by: DLG	Checked by: JB

Land Plan
 Revision E
 Sheet 9 of 18




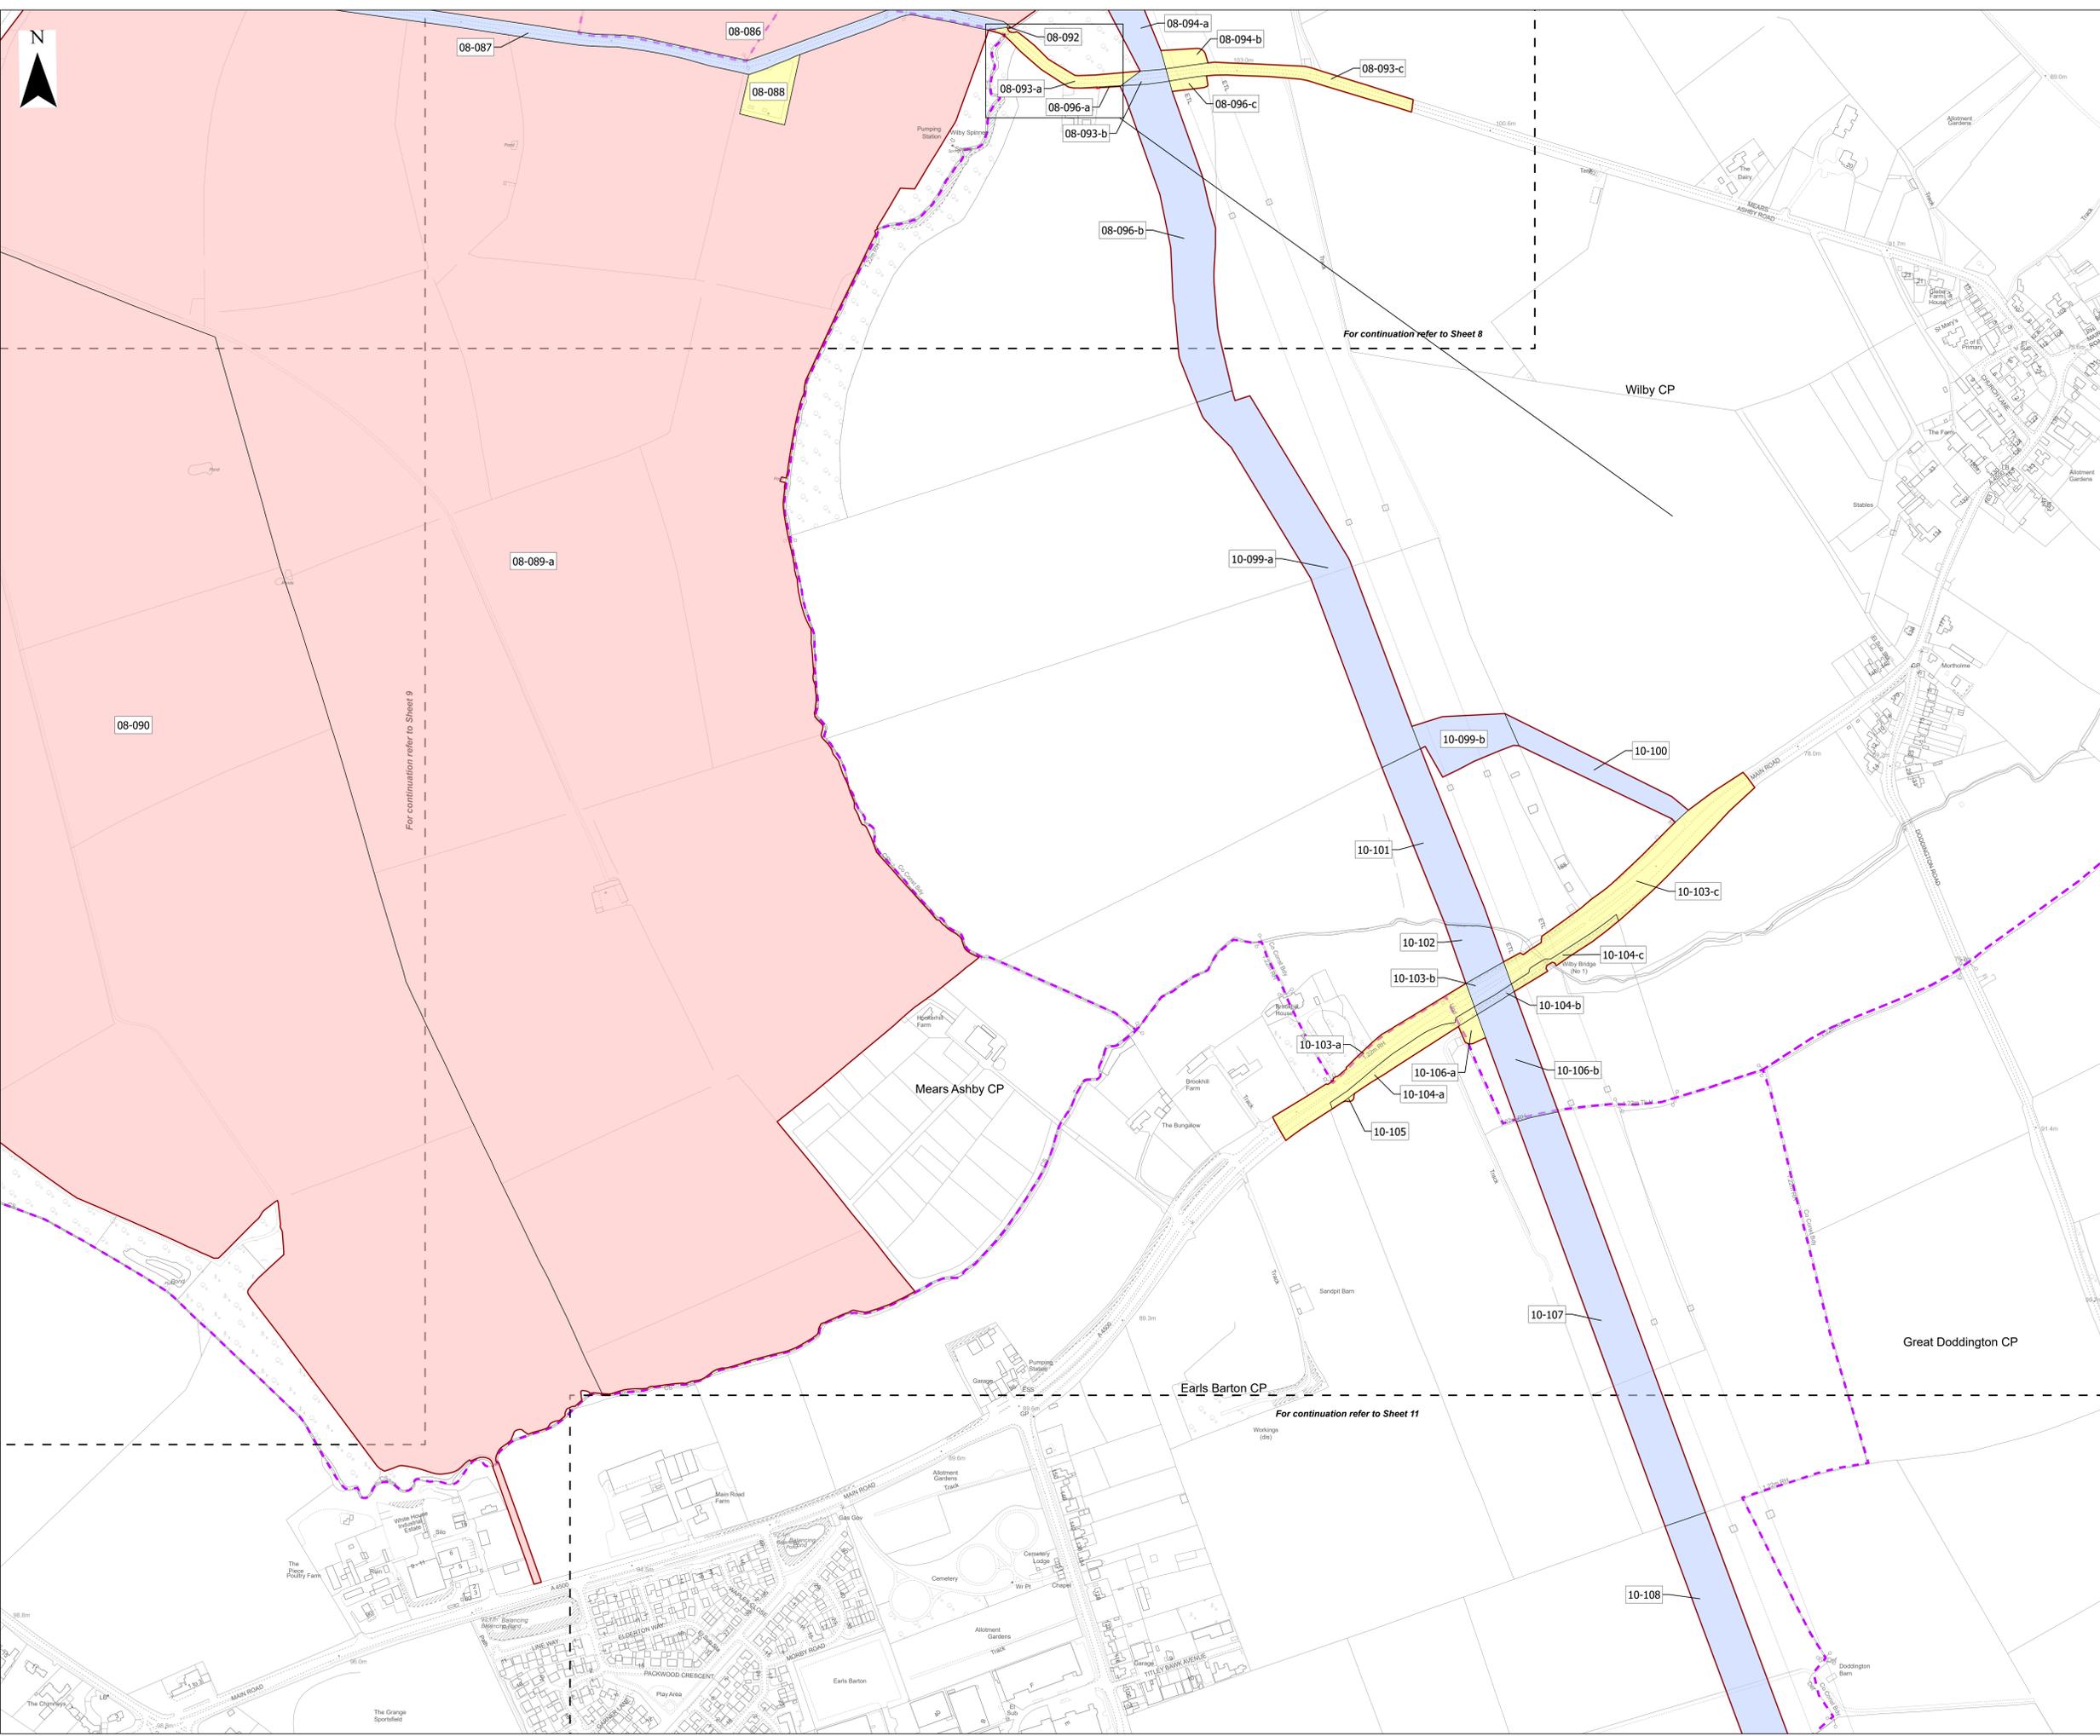

Key

- Order Limits
- No Land Take
- Freehold to be compulsorily acquired and temporary use of land and in relation to which it is proposed that easements, servitudes and other private rights will cease to have effect
- Temporary use of land and in relation to which it is proposed to temporarily suspend easements, servitudes and other private rights
- New rights (including restrictions) to be compulsorily acquired and temporary use of land and in relation to which it is proposed that easements, servitudes and other private rights will be suspended or cease to have effect
- Local Authority / Parish Boundary
- Cut Line

Base map: © Crown Copyright and database rights 2025 OS Licence no. AC00084986. All rights reserved.

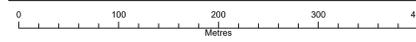


Scale: 1:2,500@A0

APFP Regulation: 5(2)(i)	Application Doc No. EX5/GH2.2_E
Ref: IGP_GH_DCO_Land_Plan	Date: 23/02/2026
Drawn by: DLG	Checked by: JB


Land Plan
Revision E
Sheet 10 of 18



- Key**
- Order Limits
 - No Land Take
 - Freehold to be compulsorily acquired and temporary use of land and in relation to which it is proposed that easements, servitudes and other private rights will cease to have effect
 - Temporary use of land and in relation to which it is proposed to temporarily suspend easements, servitudes and other private rights
 - New rights (including restrictions) to be compulsorily acquired and temporary use of land and in relation to which it is proposed that easements, servitudes and other private rights will be suspended or cease to have effect
 - Local Authority / Parish Boundary
 - Cut Line

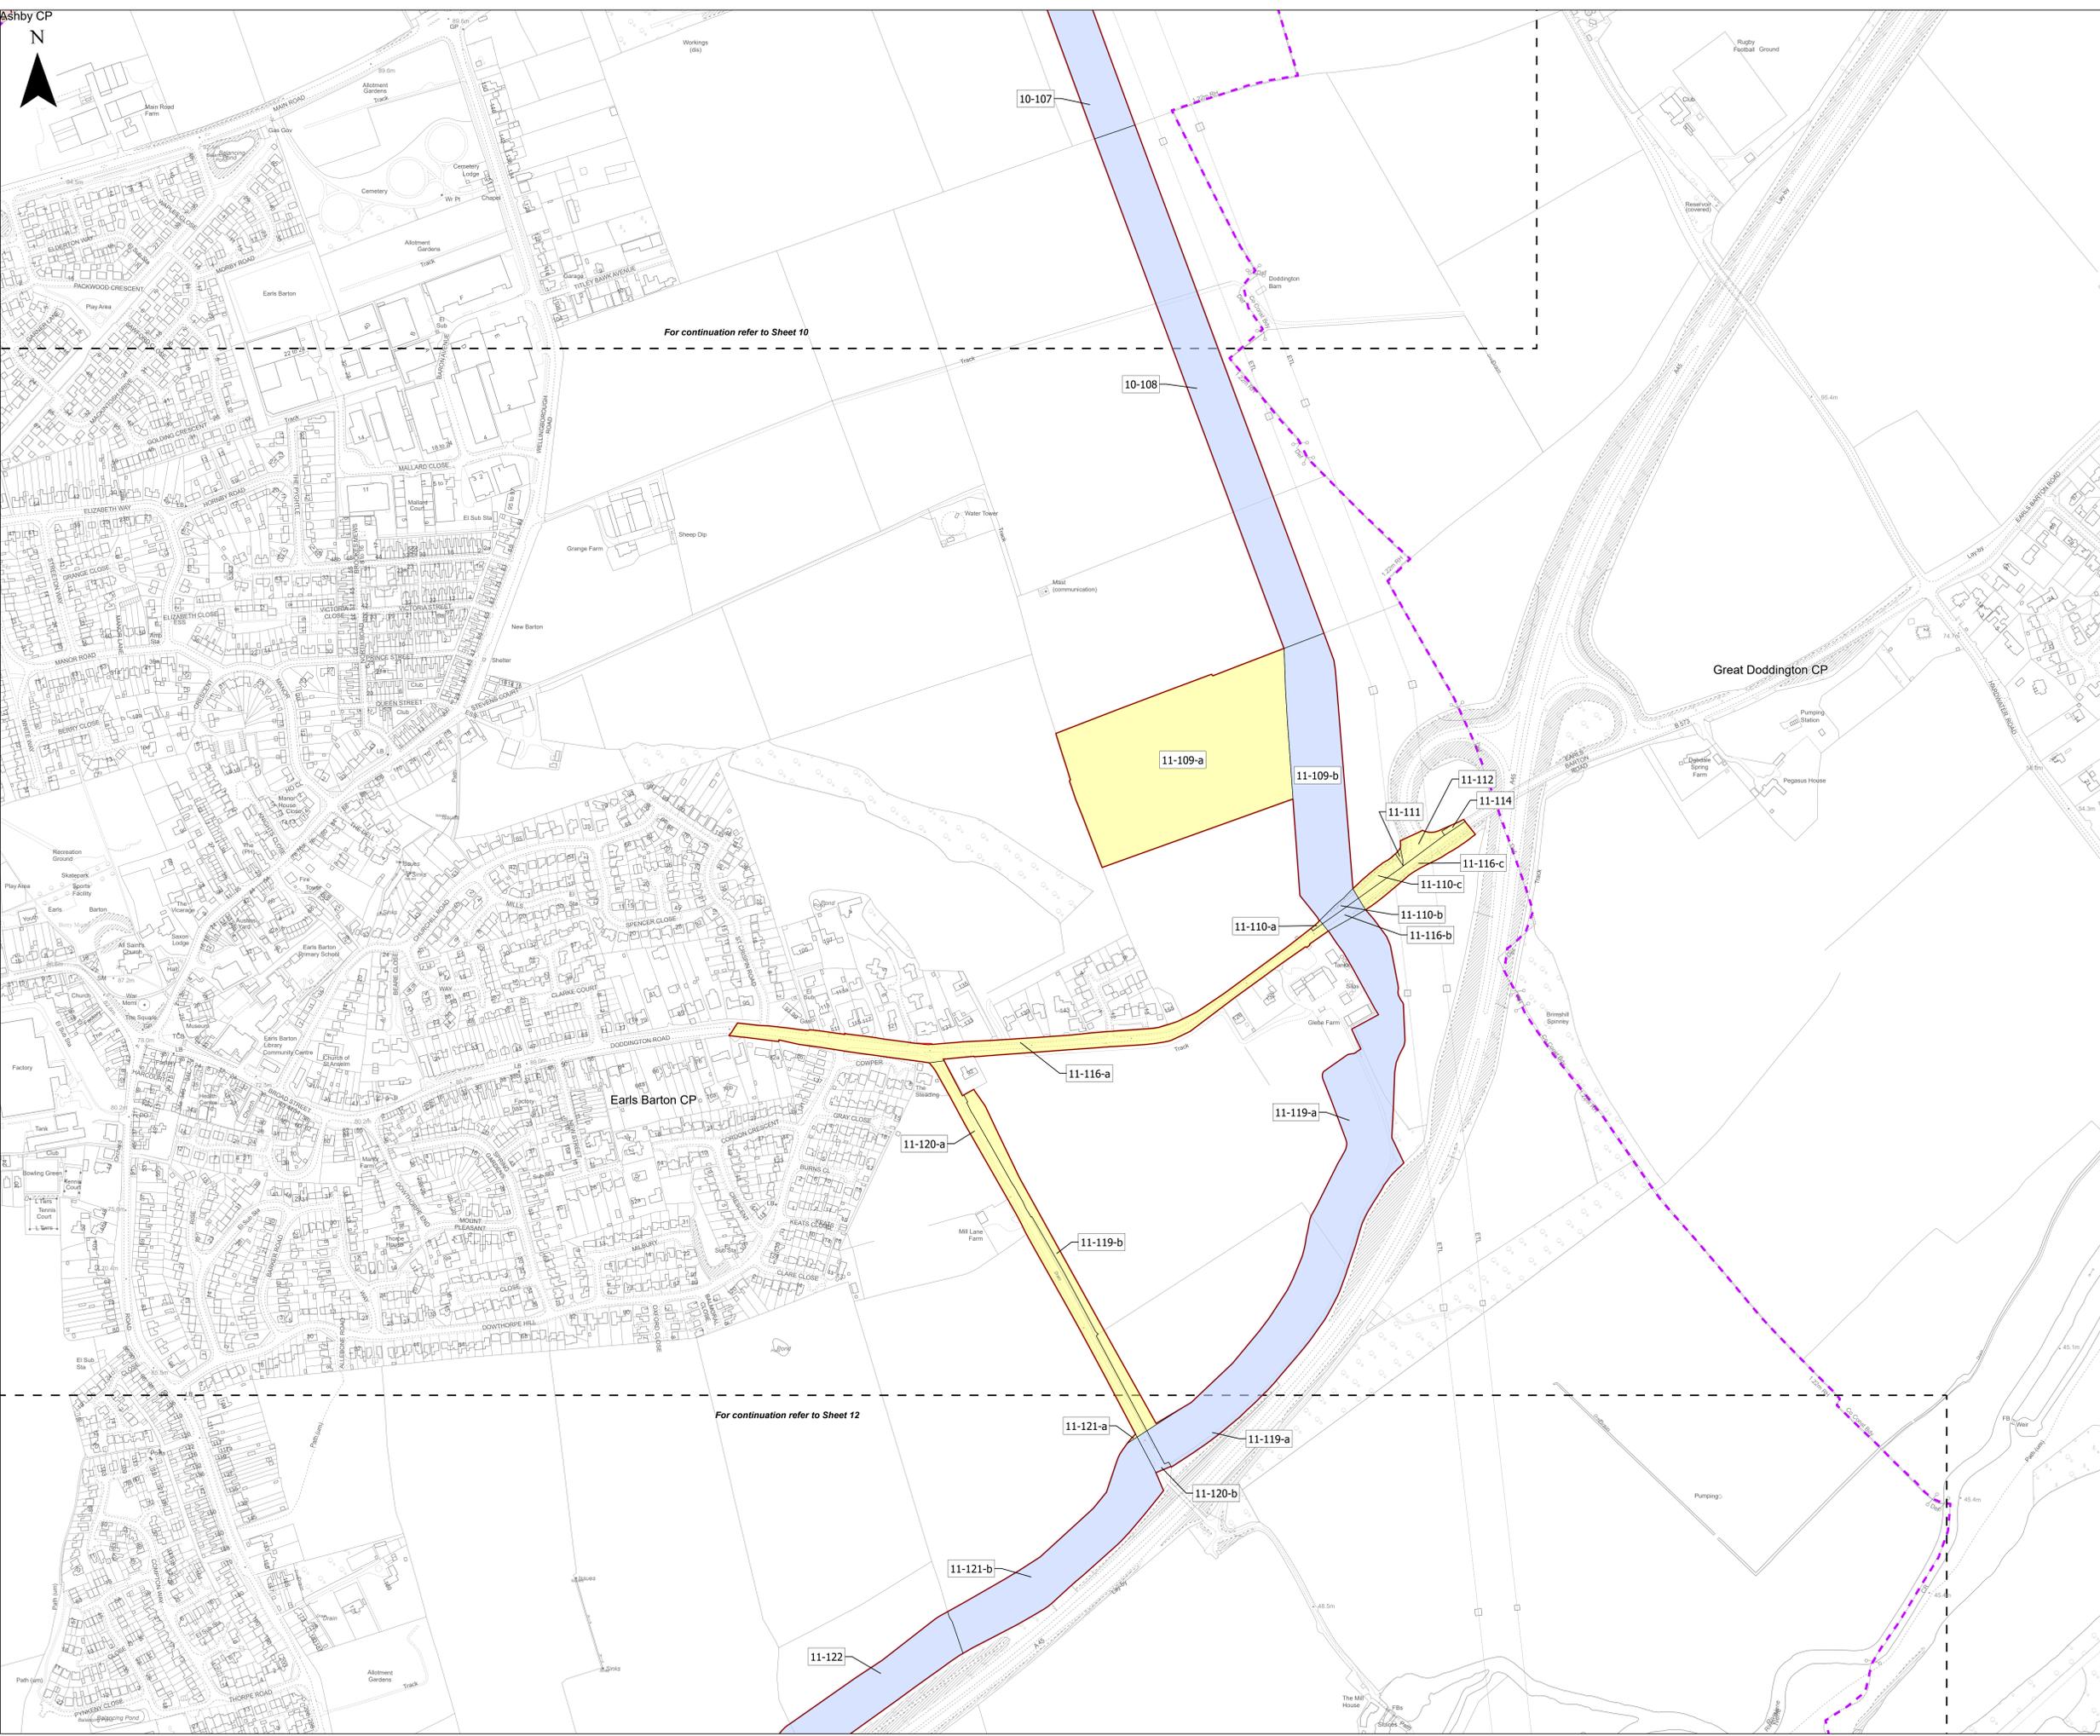

Base map: © Crown Copyright and database rights 2026 OS Licence no. AC00084986. All rights reserved.

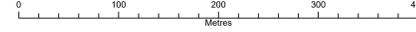

Scale: 1:2,500 @ A0





APFP Regulation: 5(2)(i)	Application Doc No. EX5/GH2.2_E
Ref: IGP_GH_DCO_Land_Plan	Date: 23/02/2026
Drawn by: DLG	Checked by: JB

Land Plan
Revision E
Sheet 11 of 18


GREEN HILL SOLAR FARM



- Key**
-  Order Limits
 -  No Land Take
 -  Freehold to be compulsorily acquired and temporary use of land and in relation to which it is proposed that easements, servitudes and other private rights will cease to have effect
 -  Temporary use of land and in relation to which it is proposed to temporarily suspend easements, servitudes and other private rights
 -  New rights (including restrictions) to be compulsorily acquired and temporary use of land and in relation to which it is proposed that easements, servitudes and other private rights will be suspended or cease to have effect
 -  Local Authority / Parish Boundary
 -  Cut Line

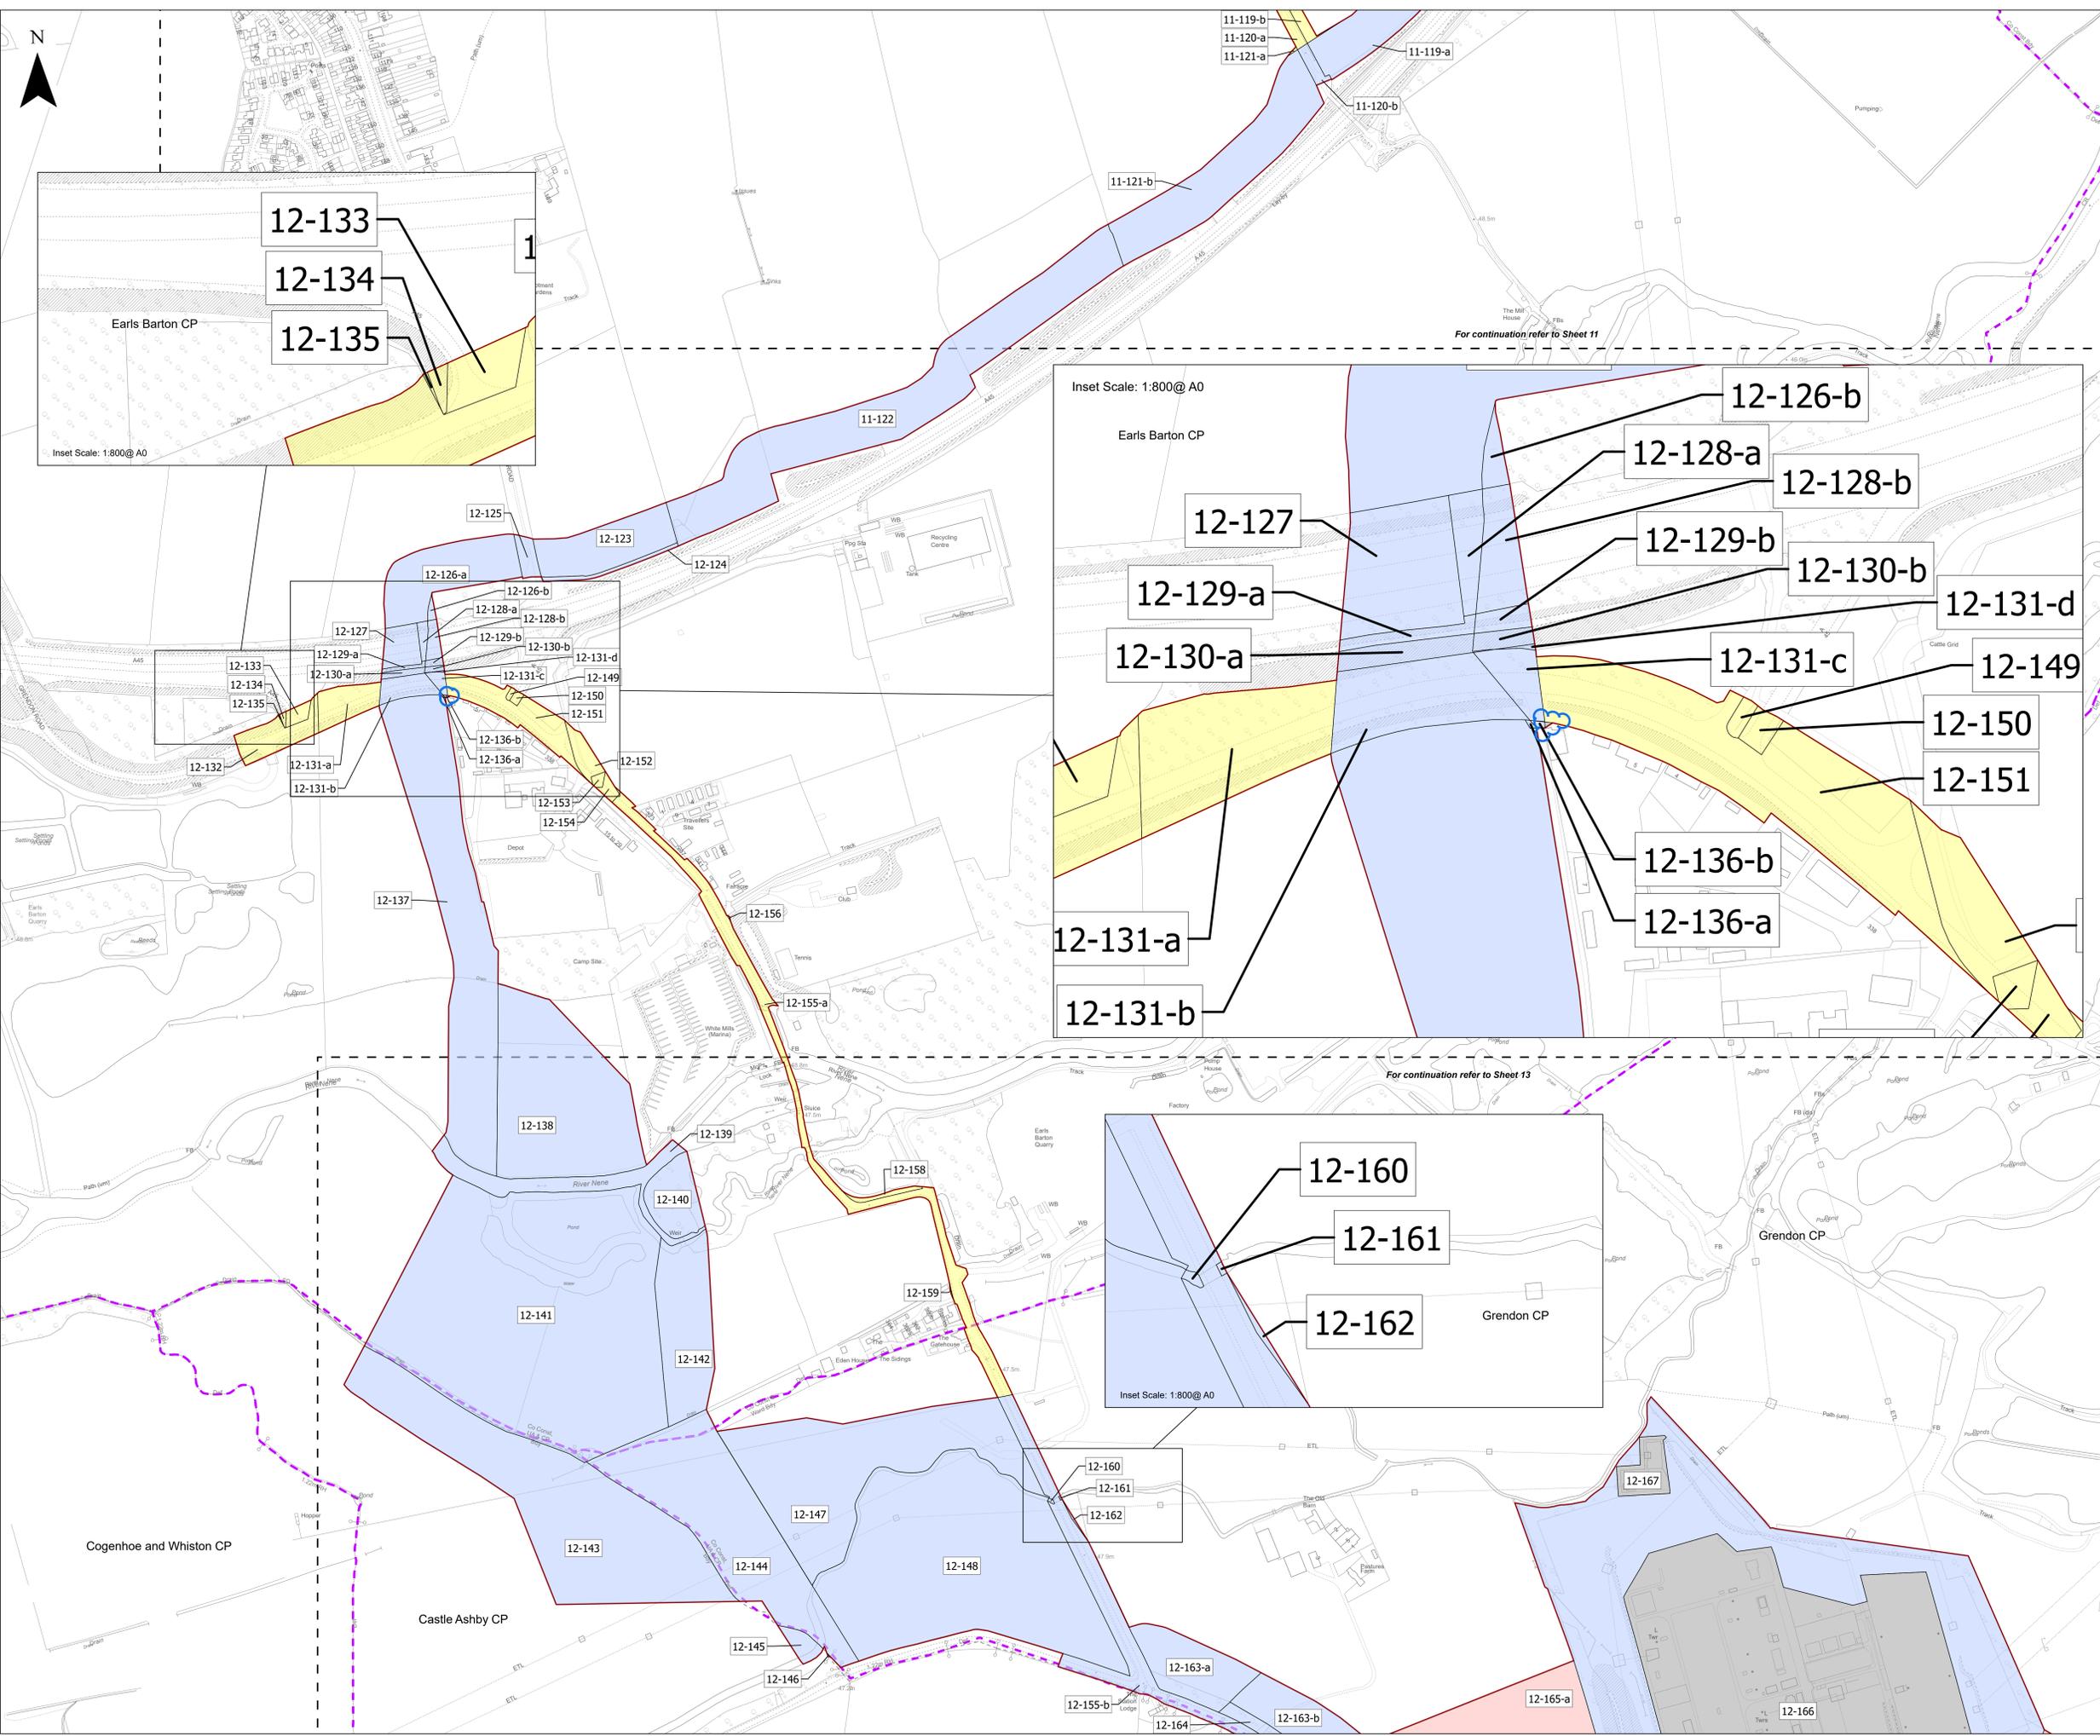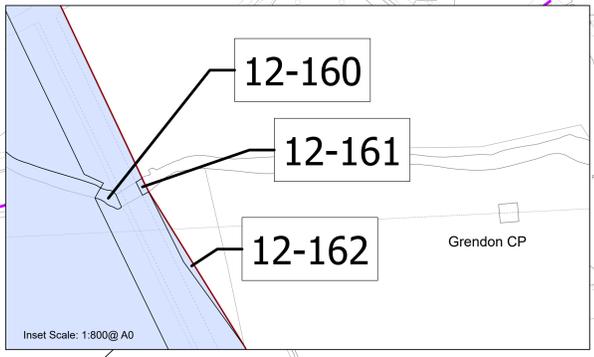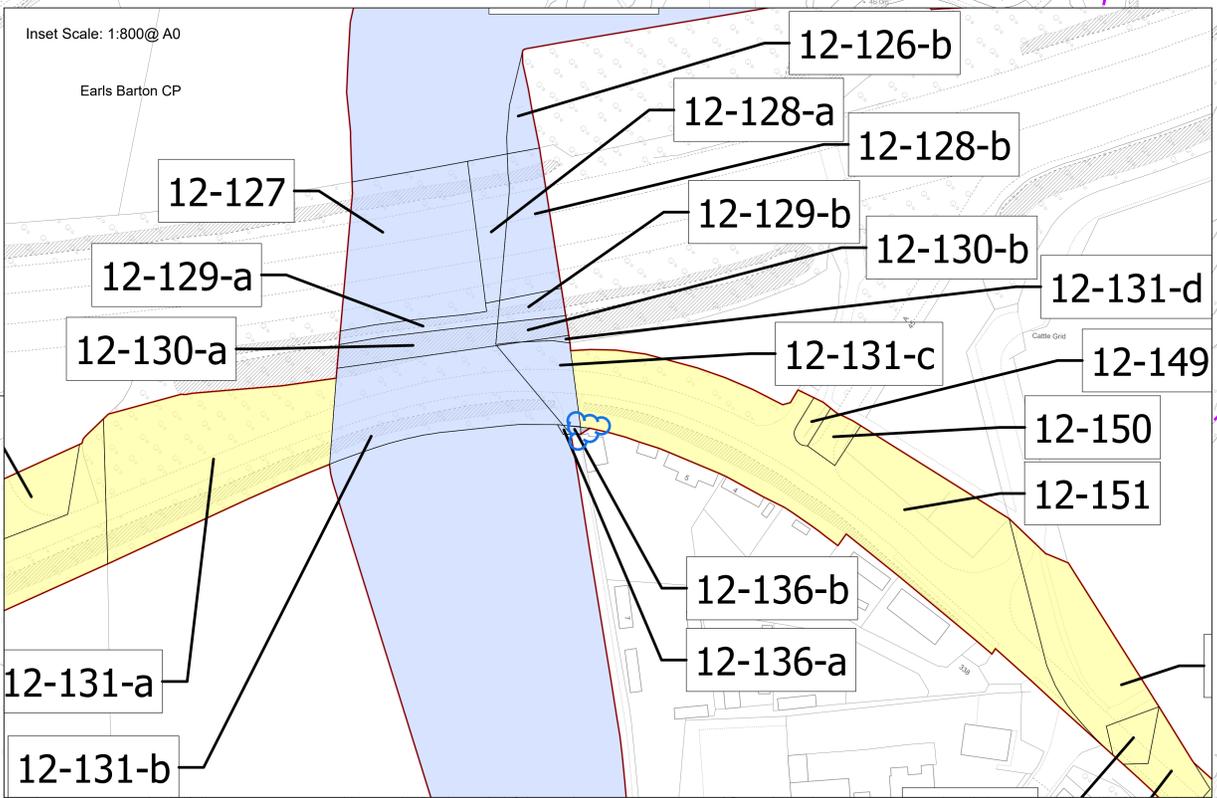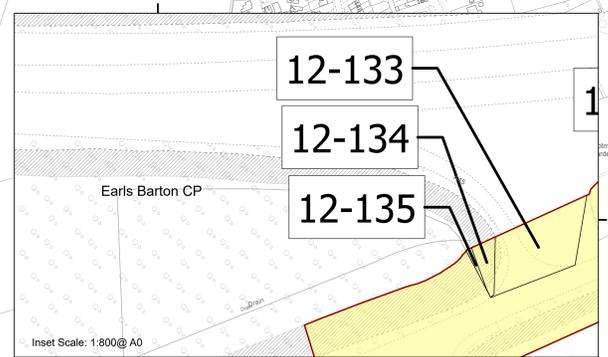

Base map: © Crown Copyright and database rights 2025 OS Licence no. AC00084986. All rights reserved.

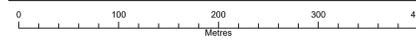

Scale: 1:2,500@A0



APFP Regulation: 5(2)(i)	Application Doc No. EX5/GH2.2_E
Ref: IGP_GH_DCO_Land_Plan	Date: 23/02/2026
Drawn by: DLG	Checked by: JB

Land Plan
Revision E
Sheet 12 of 18




Key

-  Order Limits
-  No Land Take
-  Freshhold to be compulsorily acquired and temporary use of land and in relation to which it is proposed that easements, servitudes and other private rights will cease to have effect
-  Temporary use of land and in relation to which it is proposed to temporarily suspend easements, servitudes and other private rights
-  New rights (including restrictions) to be compulsorily acquired and temporary use of land and in relation to which it is proposed that easements, servitudes and other private rights will be suspended or cease to have effect
-  Local Authority / Parish Boundary
-  Cut Line

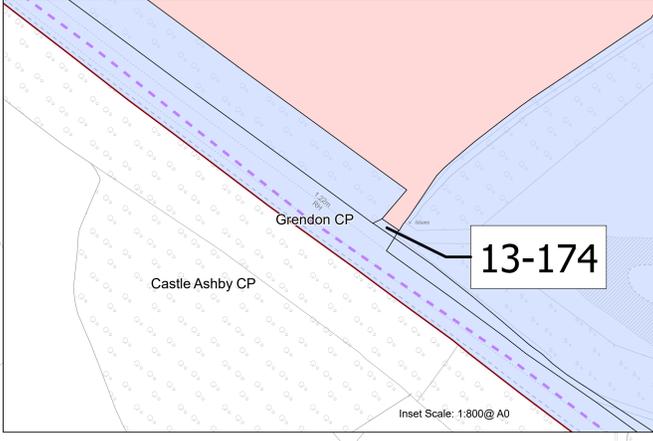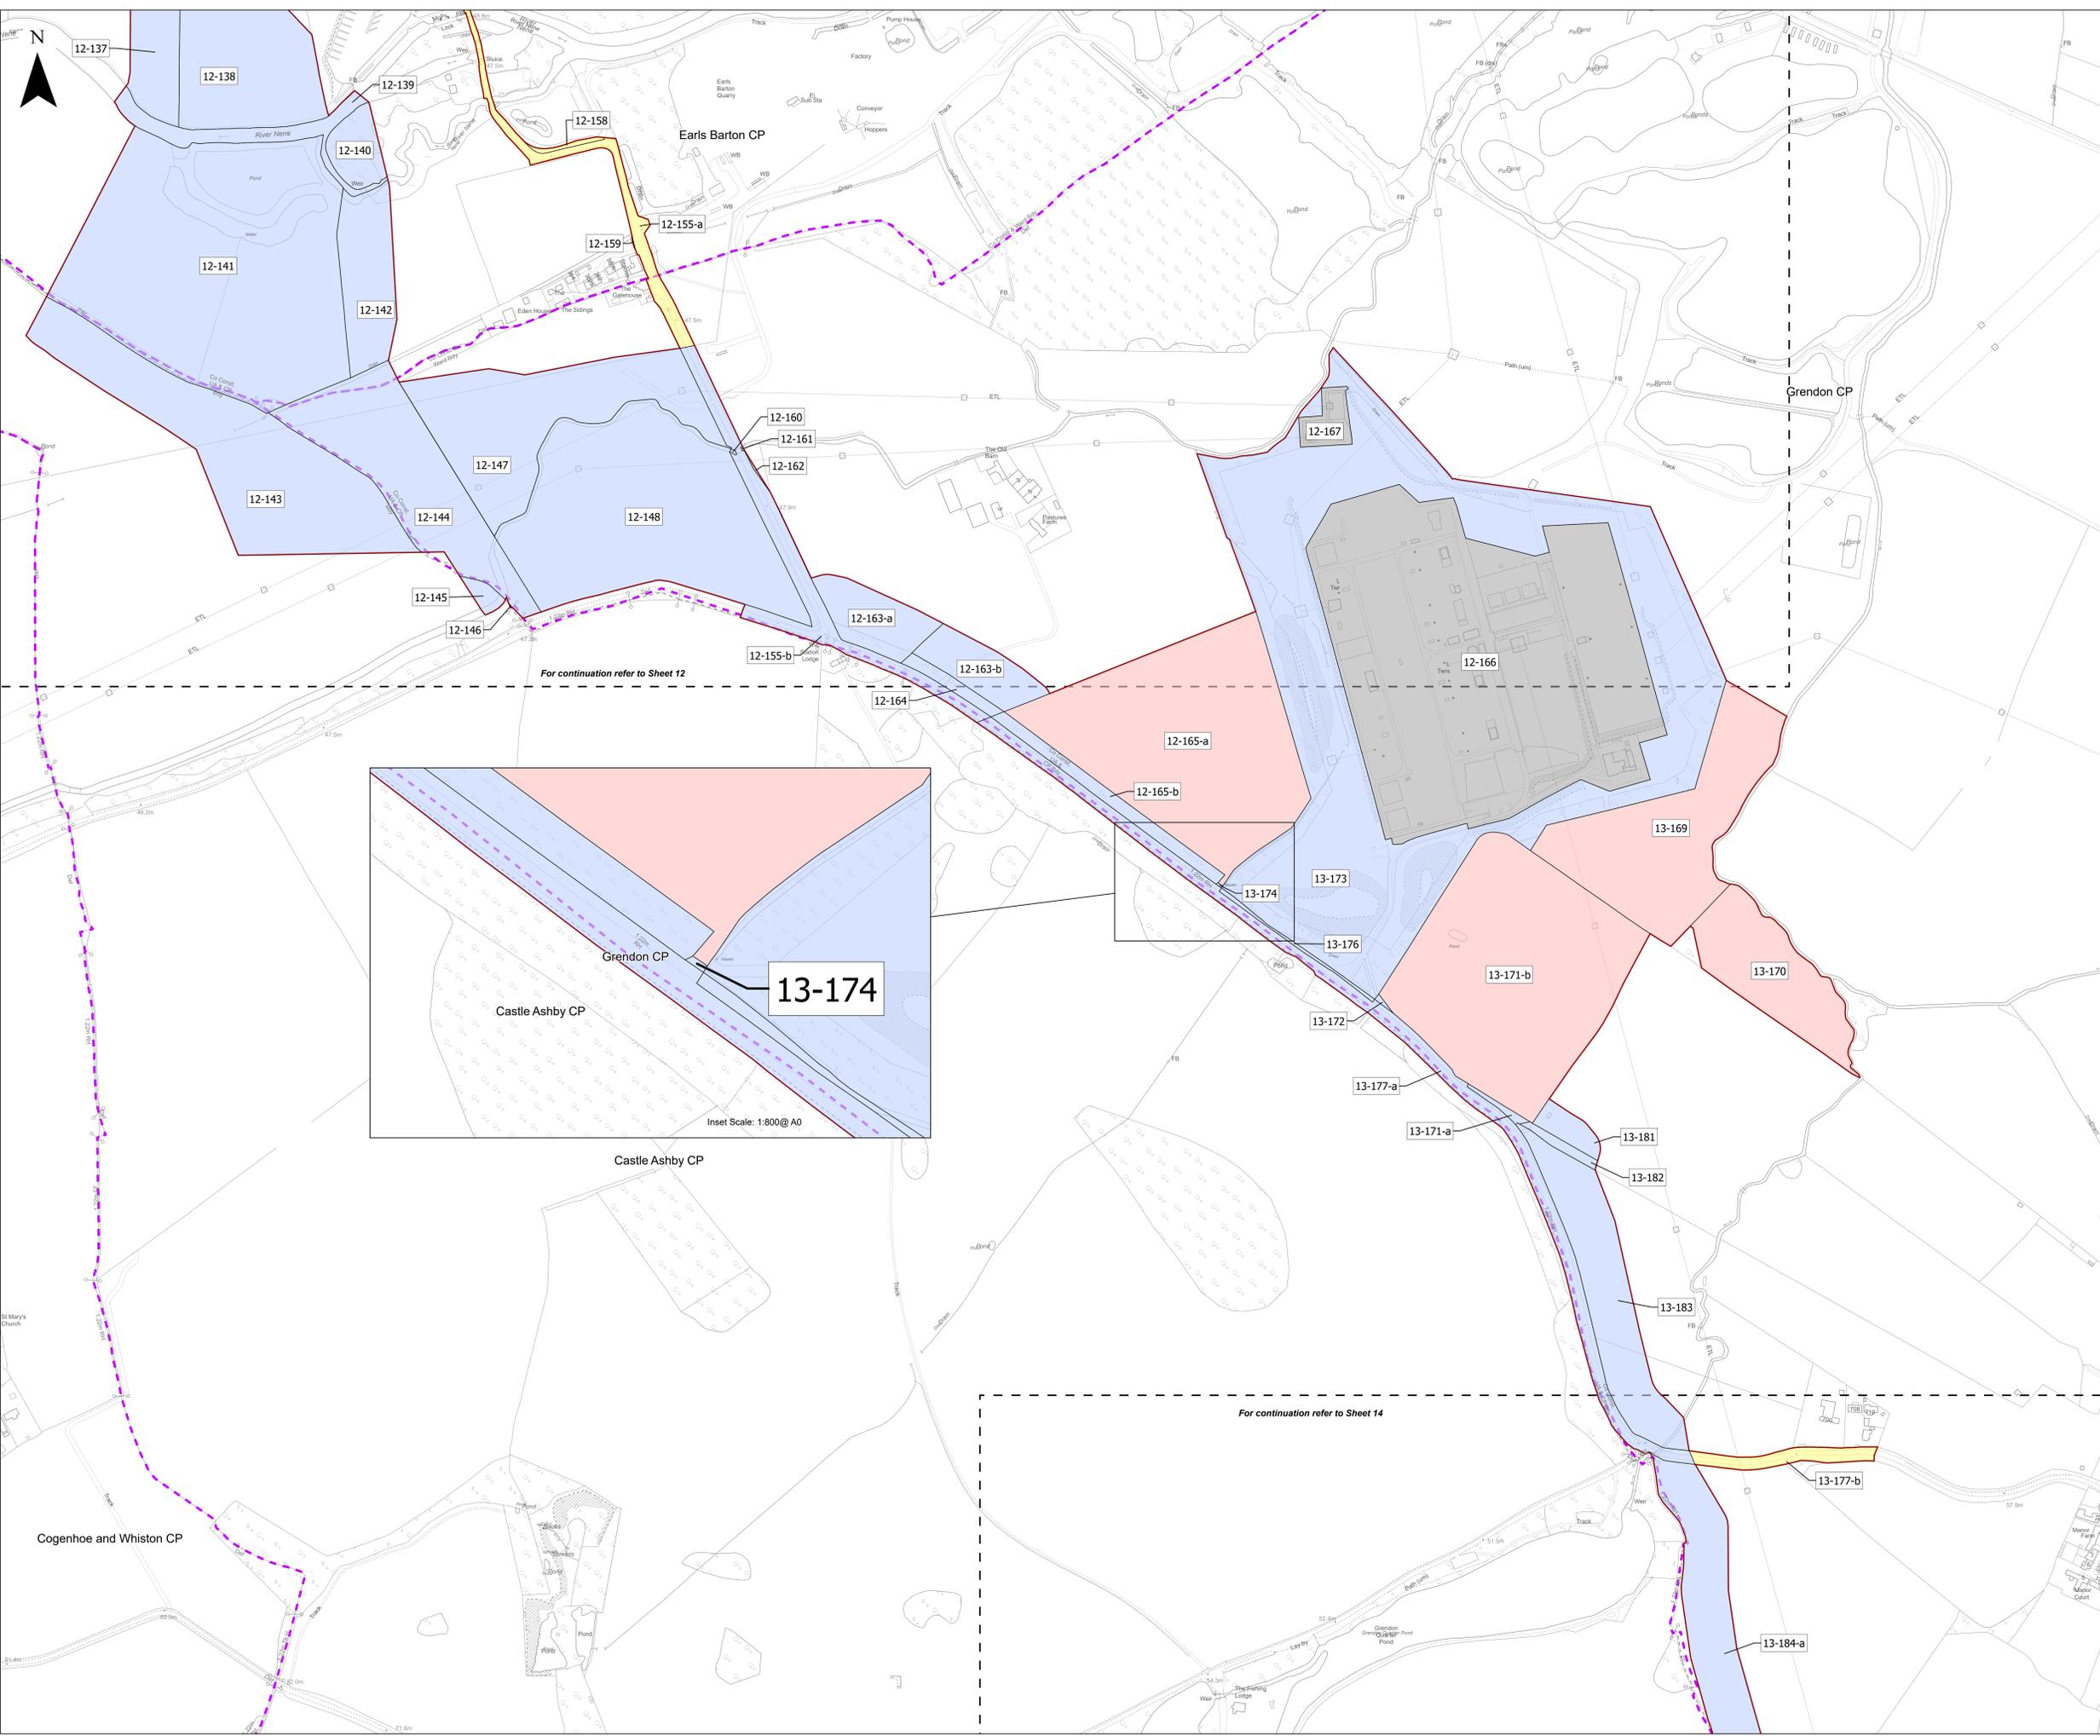

Base map: © Crown Copyright and database rights 2025 OS Licence no. AC00084986. All rights reserved.


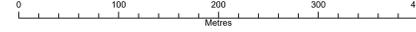


Scale: 1:2,500@A0


APFP Regulation: 5(2)(i)	Application Doc No. EX5/GH2.2_E
Ref: IGP_GH_DCO_Land_Plan	Date: 23/02/2026
Drawn by: DLG	Checked by: JB

Land Plan
Revision E
Sheet 13 of 18



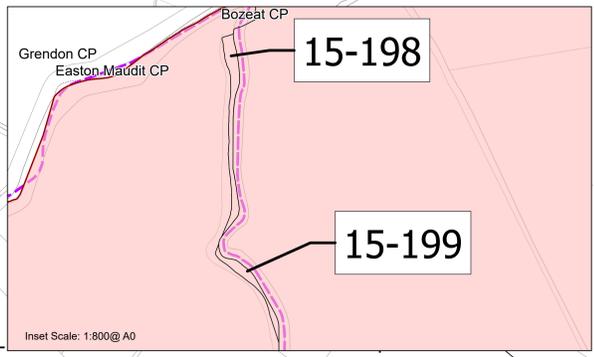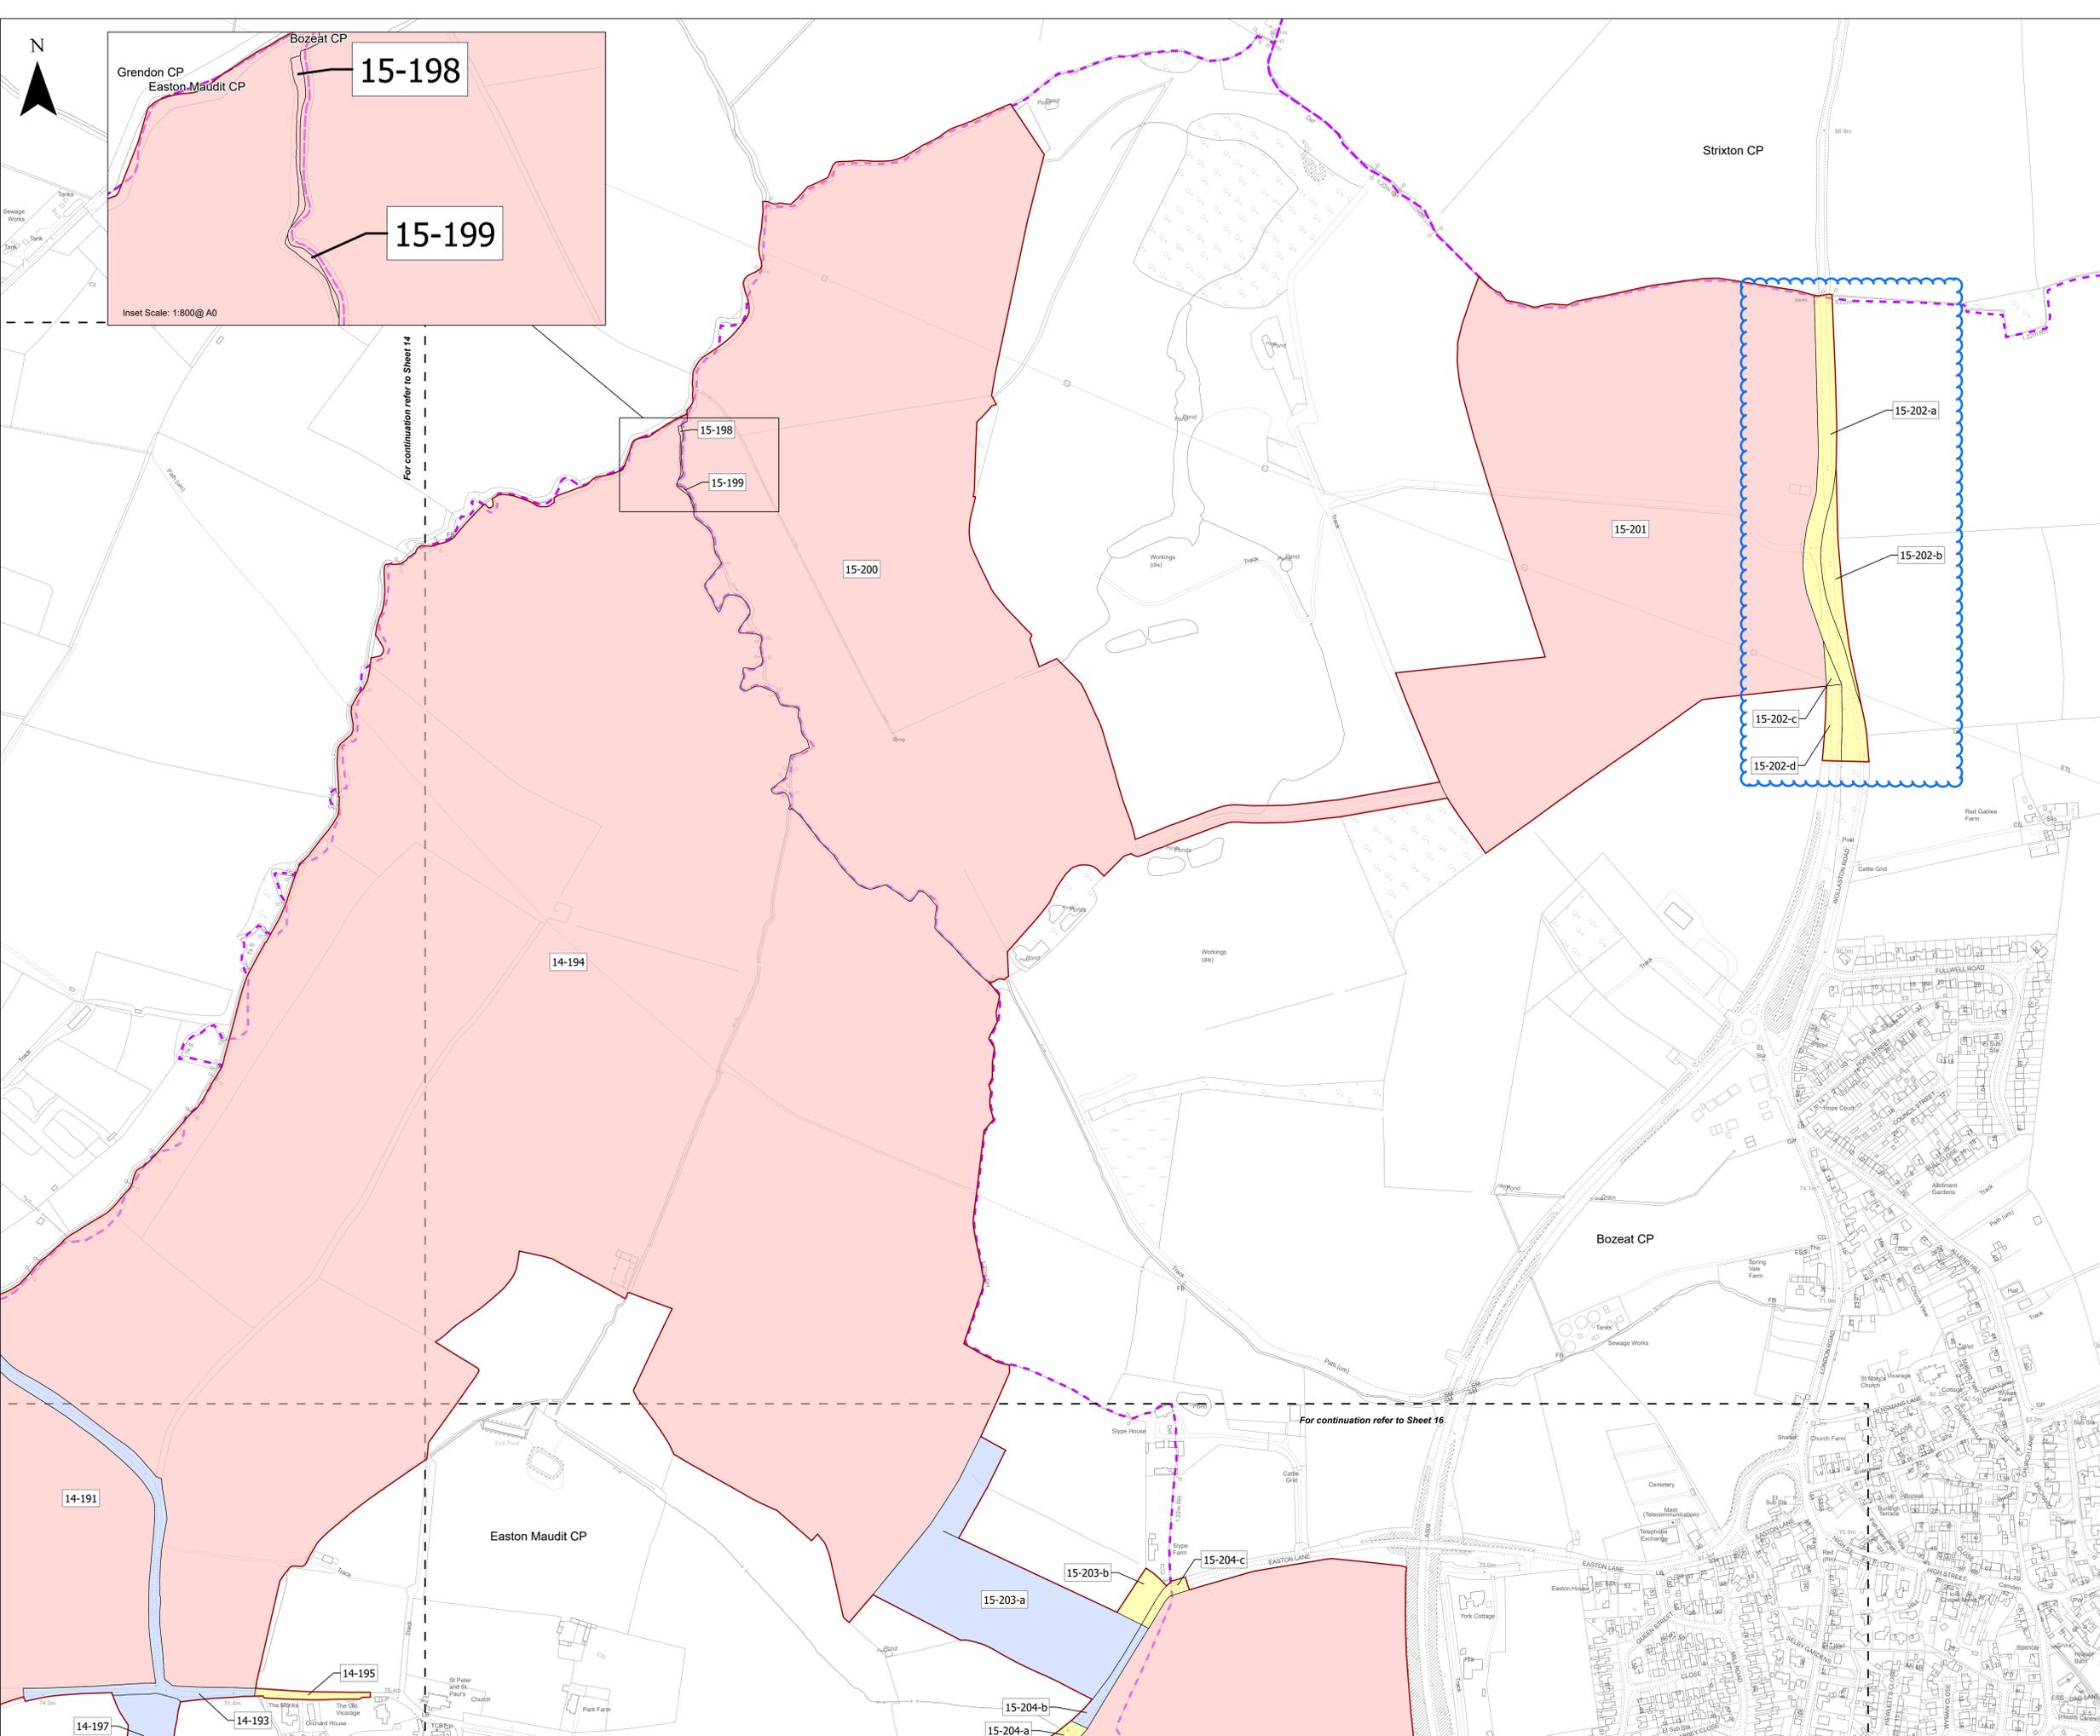

- Key**
-  Order Limits
 -  No Land Take
 -  Freehold to be compulsorily acquired and temporary use of land and in relation to which it is proposed that easements, servitudes and other private rights will cease to have effect
 -  Temporary use of land and in relation to which it is proposed to temporarily suspend easements, servitudes and other private rights
 -  New rights (including restrictions) to be compulsorily acquired and temporary use of land and in relation to which it is proposed that easements, servitudes and other private rights will be suspended or cease to have effect
 -  Local Authority / Parish Boundary
 -  Cut Line

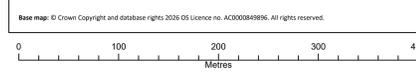


APFP Regulation: 5(2)(i)	Application Doc No. EX5/GH2.2_E
Ref: IGP_GH_DCO_Land_Plan	Date: 23/02/2026
Drawn by: DLG	Checked by: JB

Land Plan
Revision E
Sheet 15 of 18




Base map: © Crown Copyright and database rights 2025 OS Licence no. AC000084986. All rights reserved.

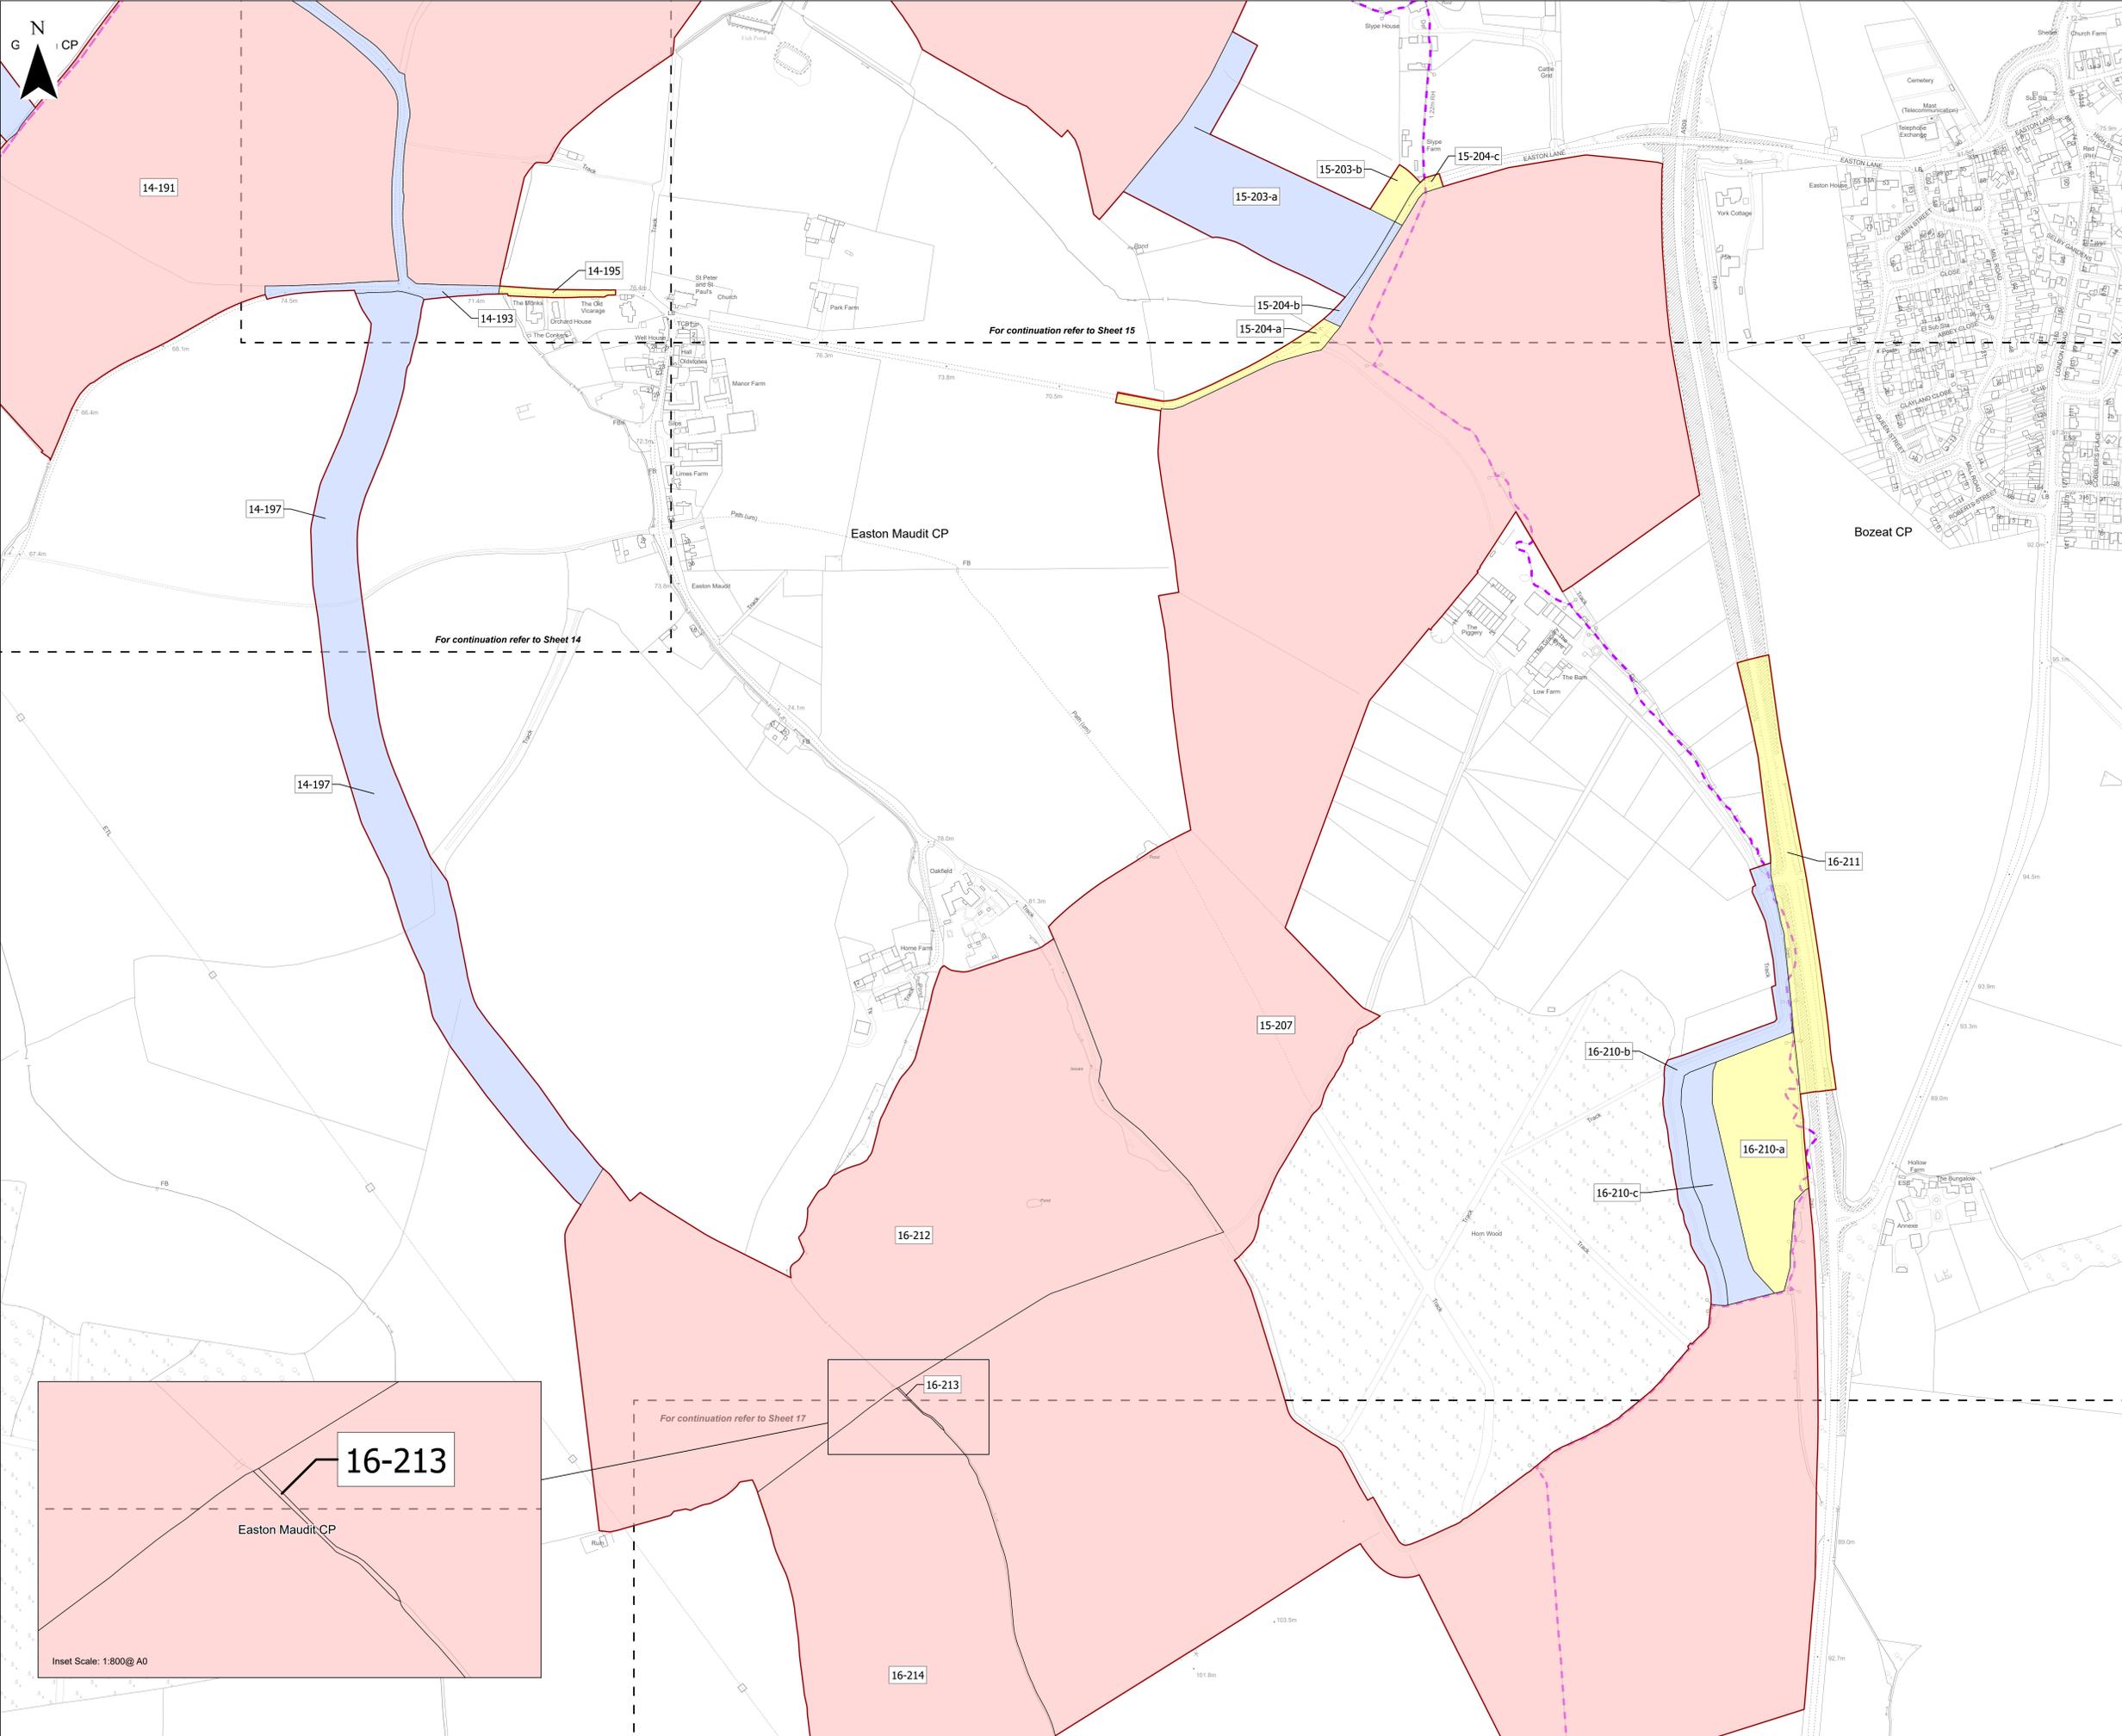


Key


- Order Limits
- No Land Take
- Freehold to be compulsorily acquired and temporary use of land and in relation to which it is proposed that easements, servitudes and other private rights will cease to have effect
- Temporary use of land and in relation to which it is proposed to temporarily suspend easements, servitudes and other private rights
- New rights (including restrictions) to be compulsorily acquired and temporary use of land and in relation to which it is proposed that easements, servitudes and other private rights will be suspended or cease to have effect
- Local Authority / Parish Boundary
- Cut Line

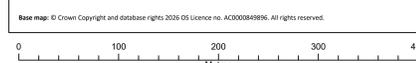

Scale: 1:2,500@ A0


APFP Regulation: 5(2)(i)	Application Doc No. EX5/GH2.2_E
Ref: IGP_GH_DCO_Land_Plan	Date: 23/02/2026
Drawn by: DLG	Checked by: JB

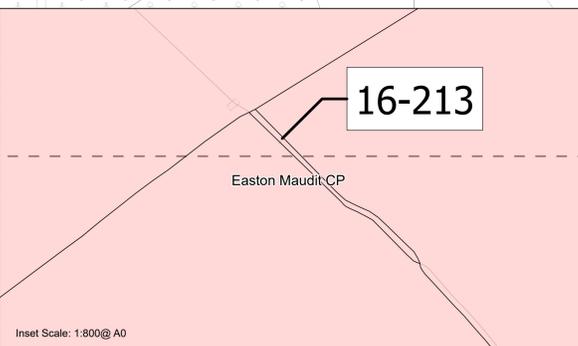

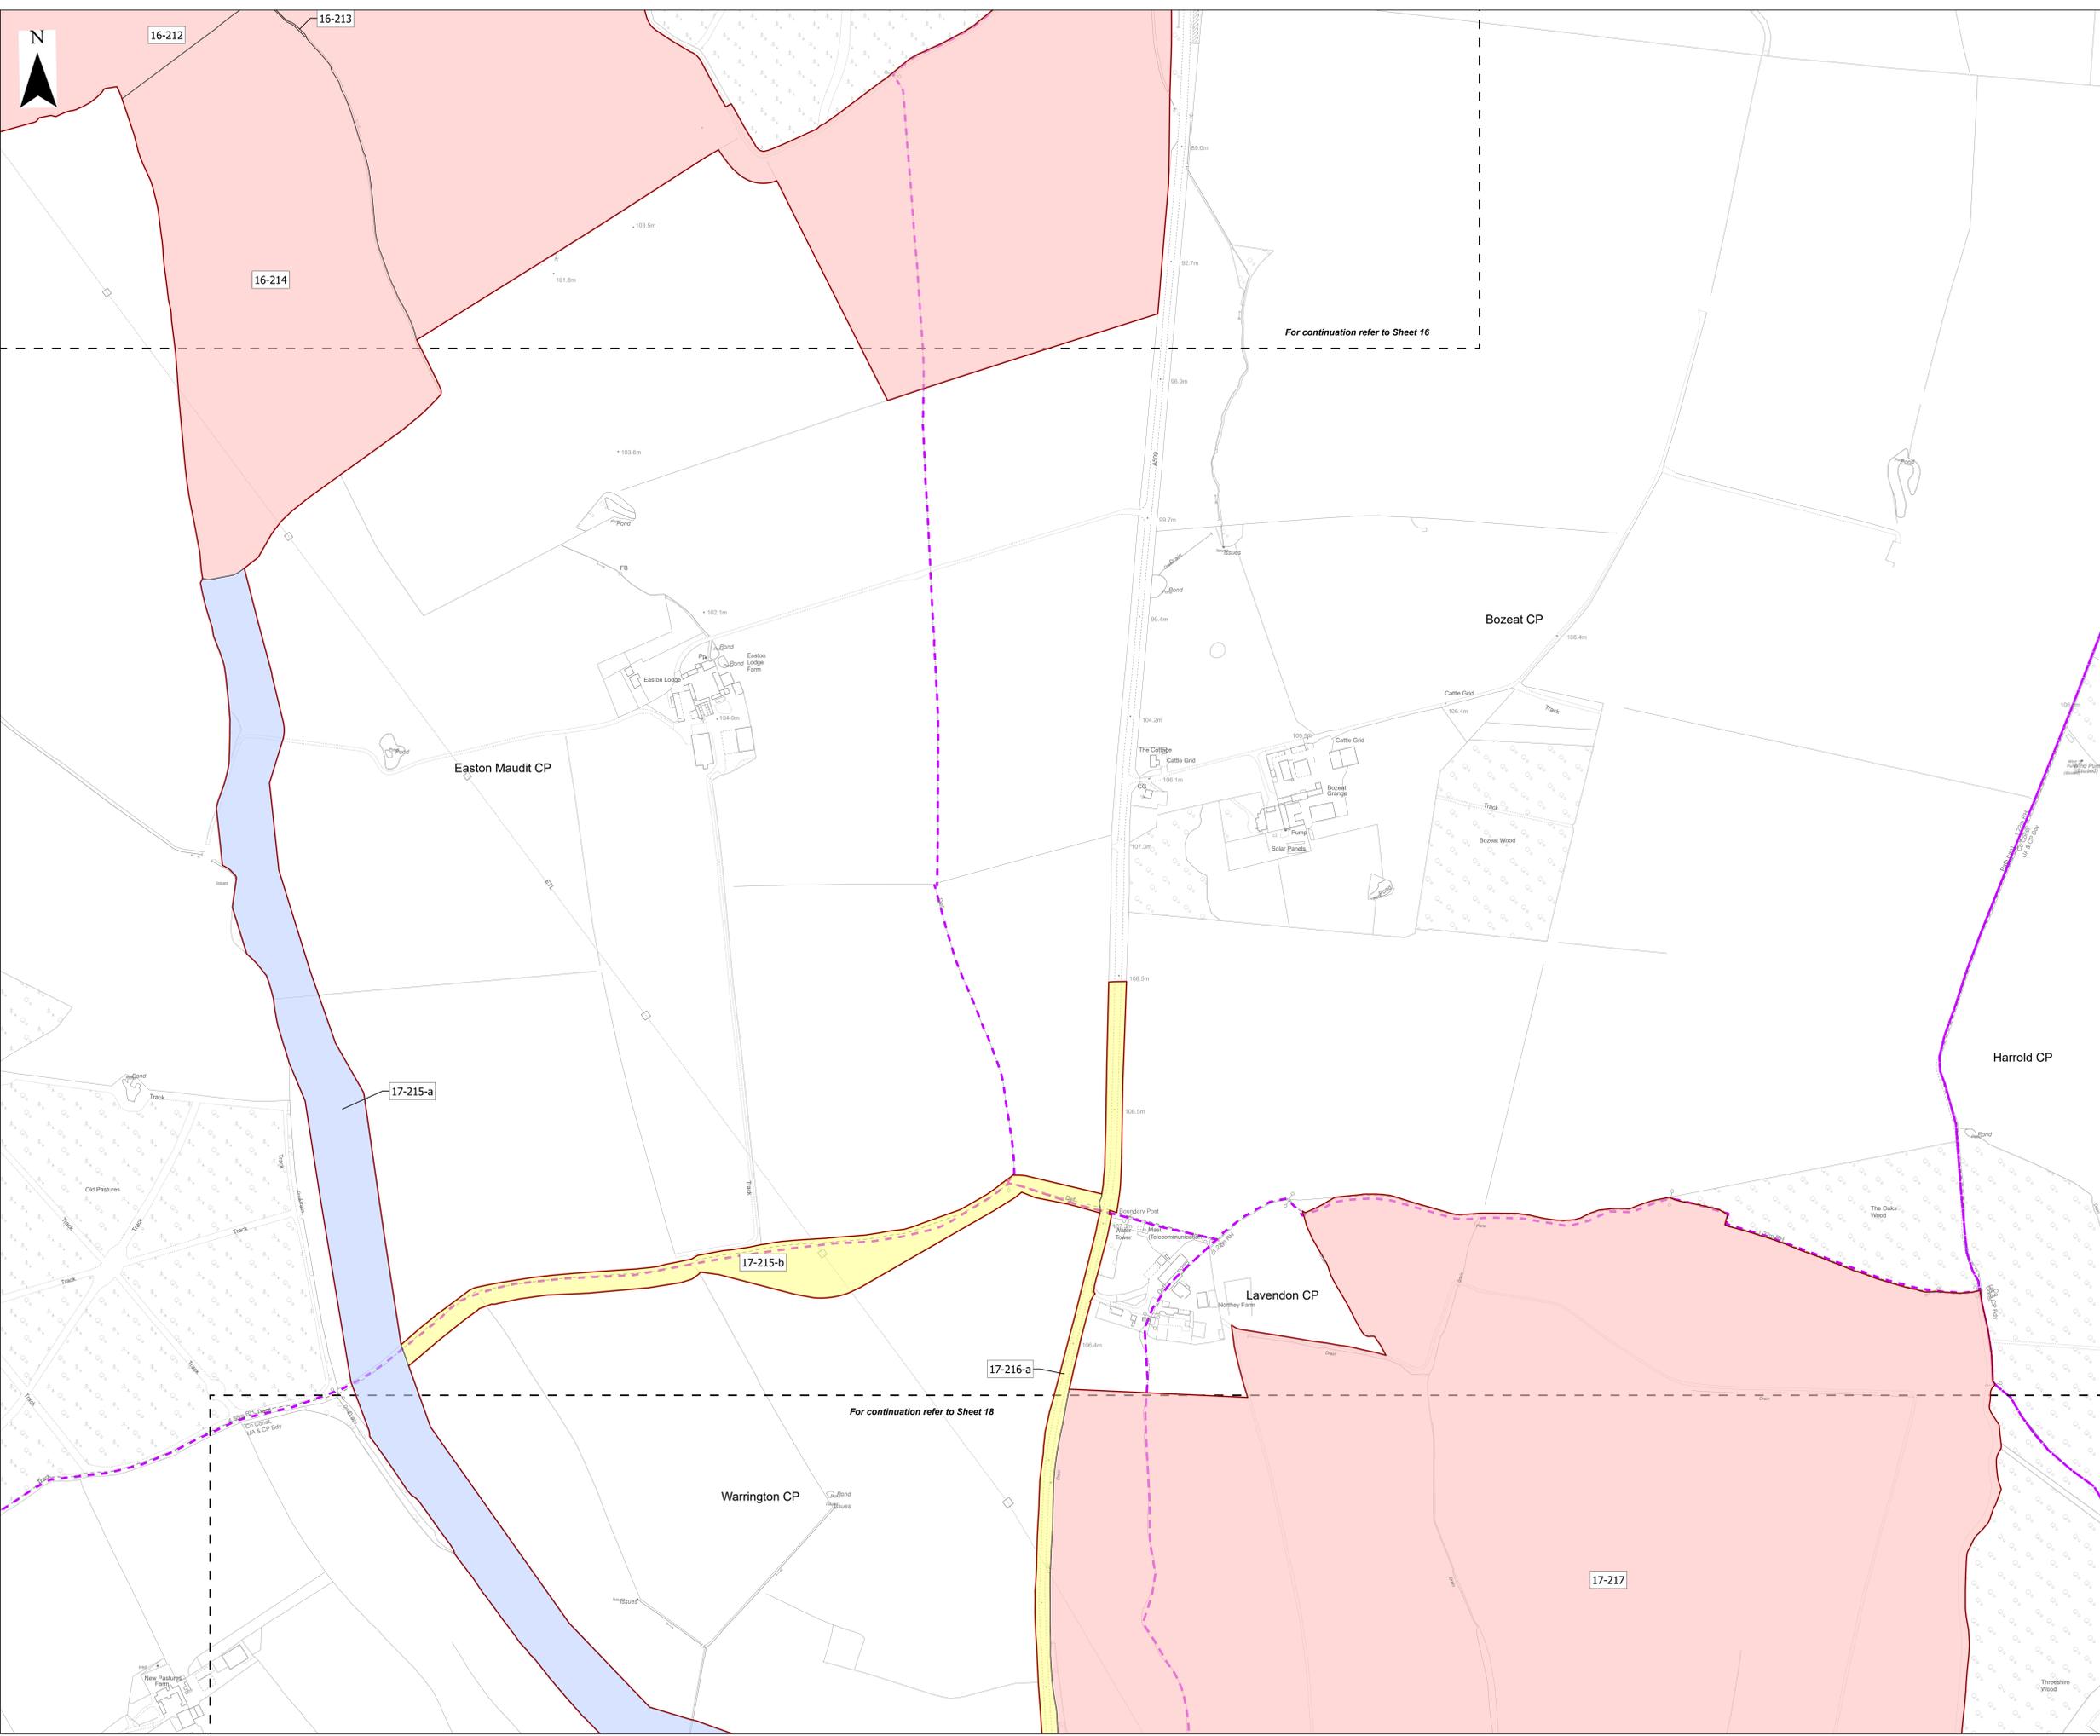

Key

- Order Limits
- No Land Take
- Freehold to be compulsorily acquired and temporary use of land and in relation to which it is proposed that easements, servitudes and other private rights will cease to have effect
- Temporary use of land and in relation to which it is proposed to temporarily suspend easements, servitudes and other private rights
- New rights (including restrictions) to be compulsorily acquired and temporary use of land and in relation to which it is proposed that easements, servitudes and other private rights will be suspended or cease to have effect
- Local Authority / Parish Boundary
- Cut Line

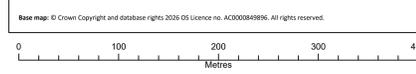


Scale: 1:2,500@ A0


APFP Regulation: 5(2)(i)	Application Doc No. EX5/GH2.2_E
Ref: IGP_GH_DCO_Land_Plan	Date: 23/02/2026
Drawn by: DLG	Checked by: JB

Land Plan
Revision E
Sheet 17 of 18

- Key**
- Order Limits
 - No Land Take
 - Freehold to be compulsorily acquired and temporary use of land and in relation to which it is proposed that easements, servitudes and other private rights will cease to have effect
 - Temporary use of land and in relation to which it is proposed to temporarily suspend easements, servitudes and other private rights
 - New rights (including restrictions) to be compulsorily acquired and temporary use of land and in relation to which it is proposed that easements, servitudes and other private rights will be suspended or cease to have effect
 - Local Authority / Parish Boundary
 - Cut Line

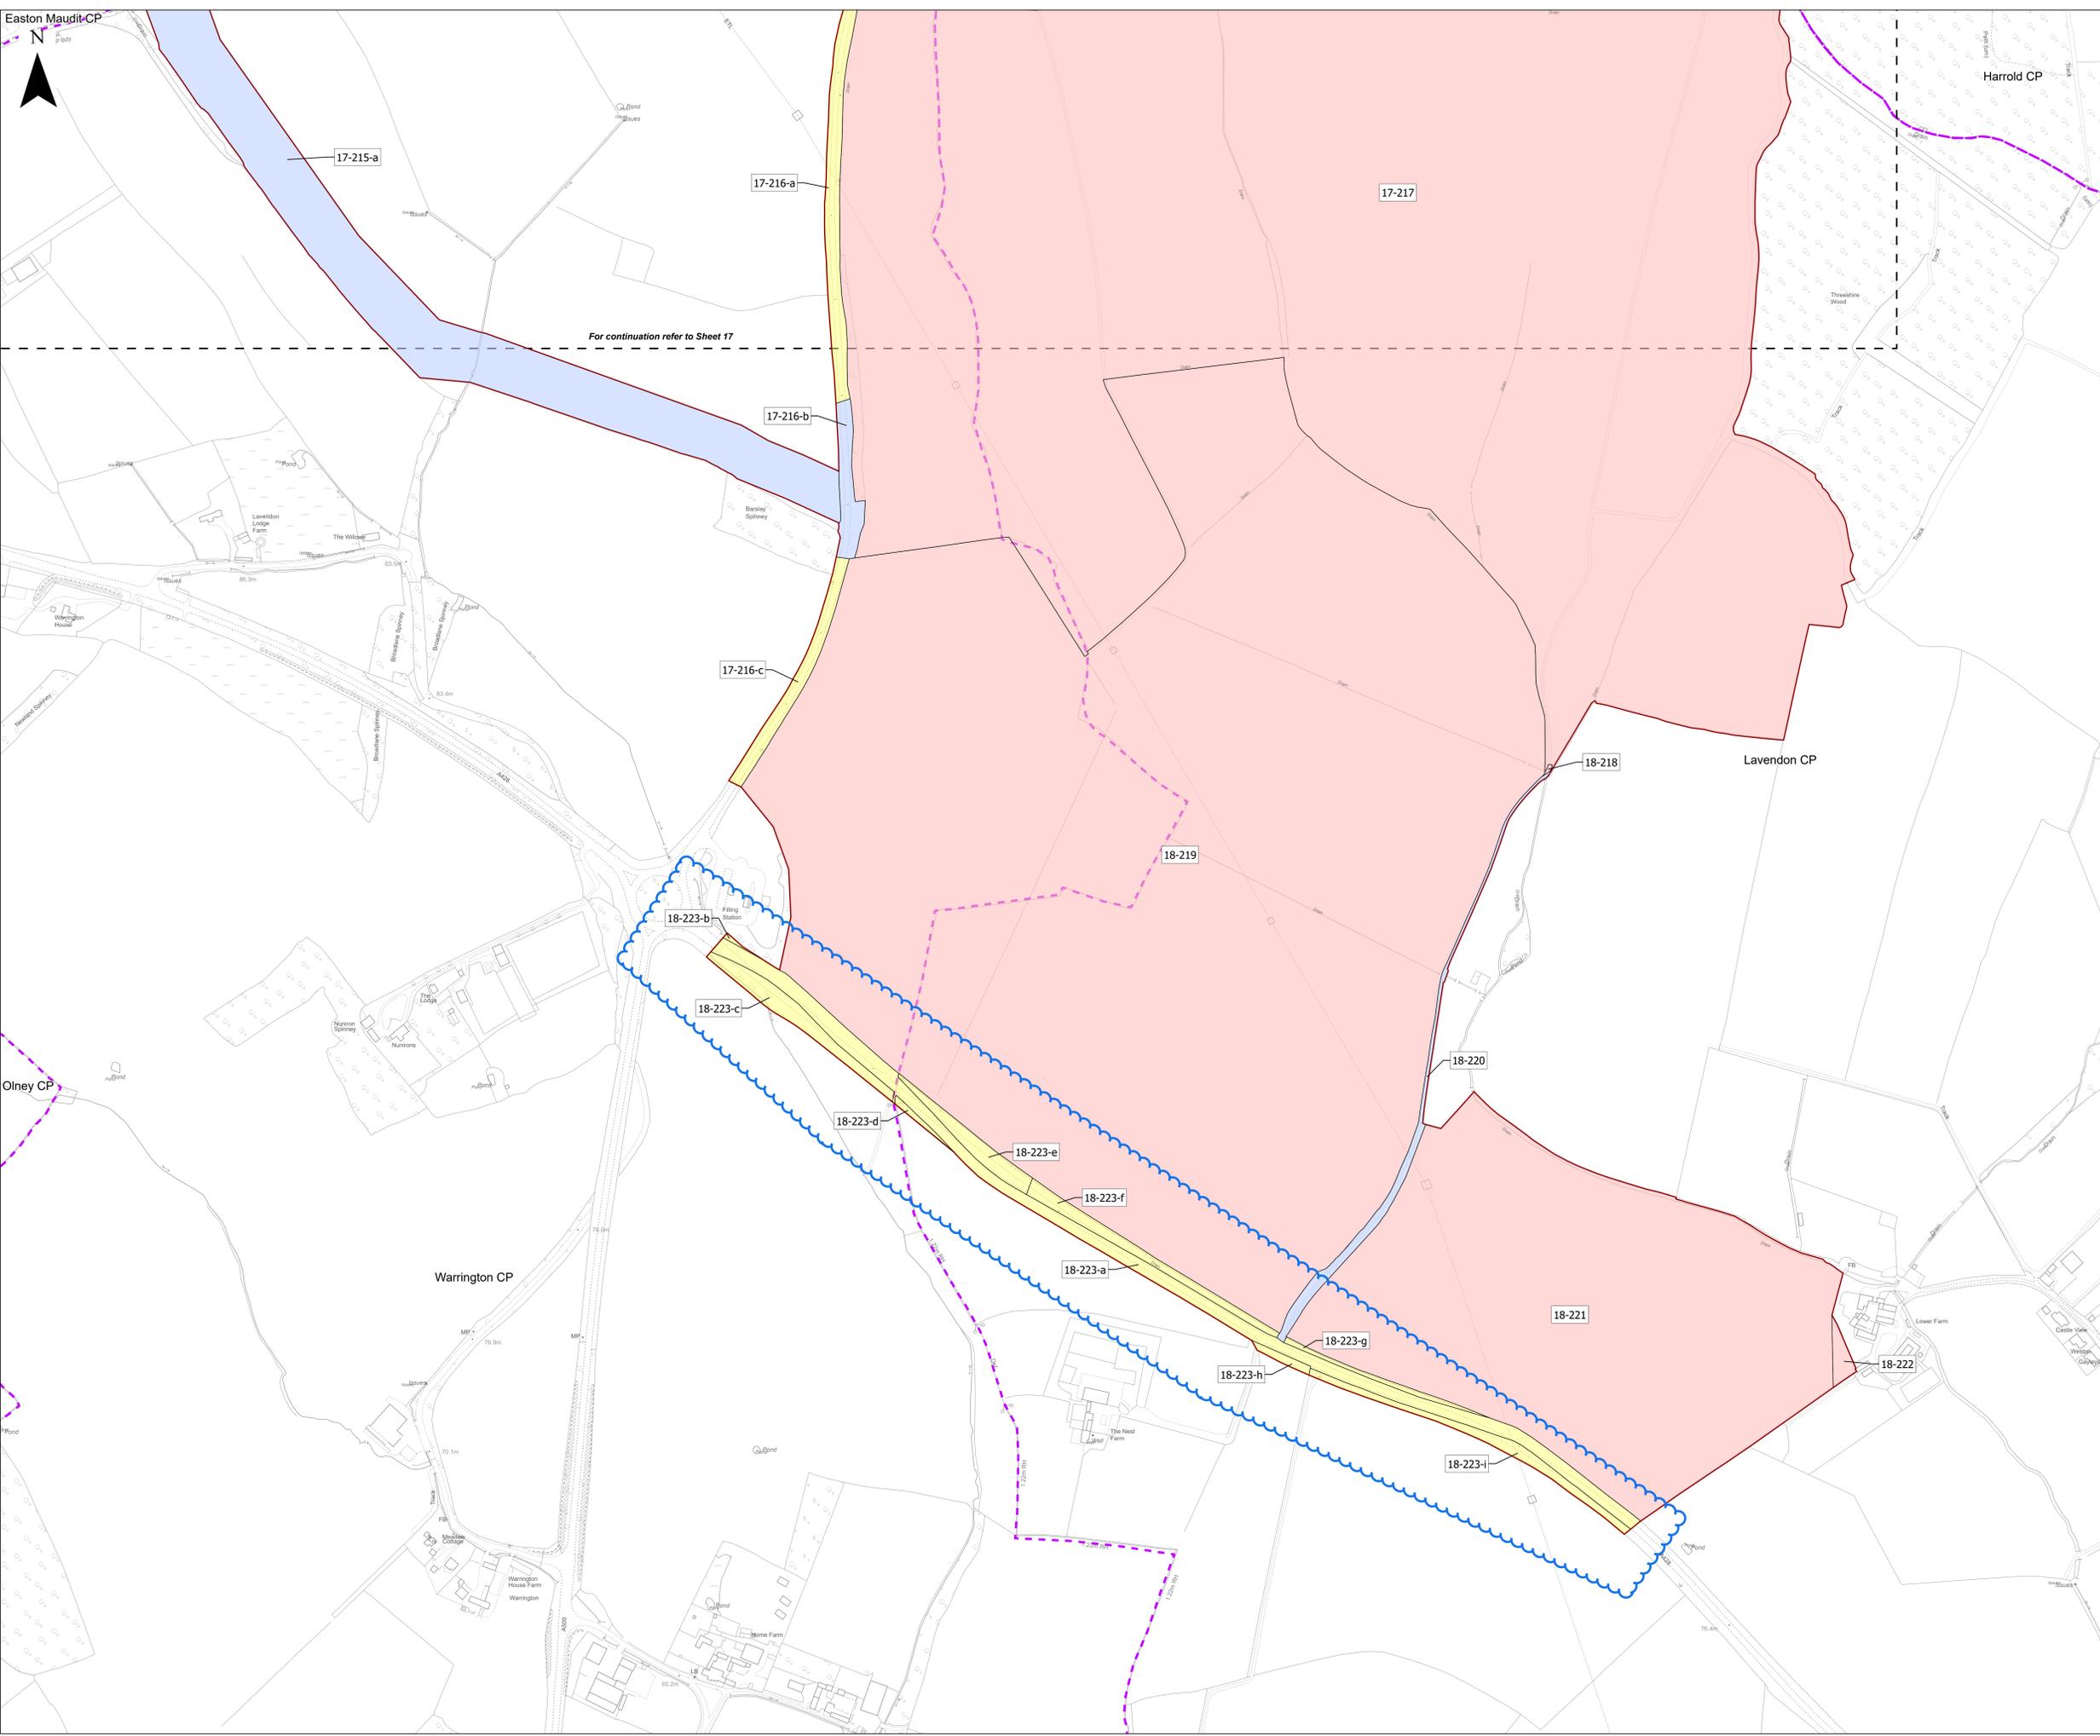

Base map: © Crown Copyright and database rights 2025 OS Licence no. AC00084986. All rights reserved.

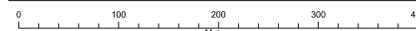

Scale: 1:2,500@A0

APFP Regulation: 5(2)(i)	Application Doc No. EX5/GH2.2_E
Ref: IGP_GH_DCO_Land_Plan	Date: 23/02/2026
Drawn by: DLG	Checked by: JB

Land Plan
Revision E
Sheet 18 of 18